



SEE SHEET 2 FOR RECORD PLANS & MATERIAL SUPPLIERS

NOTE: ANY FURTHER INFORMATION CONCERNING
FINAL QUANTITIES, AMOUNTS OR OTHER DETAILS
RELATIVE TO THIS PROJECT MAY BE FOUND IN
EITHER THE FIELD BOOKS OR THE ESTIMATE
FILE

FEDERAL AID PROJECT

BEGINNING AT A POINT APPROXIMATELY 1.193 MILES NORTHERLY
OF THE MILTON-COLCHESTER TOWN LINE AND EXTENDING
SOUTHEASTERLY 3.144 MILES.

LENGTH OF ROADWAY	16,202.80	FEET	3.069	MILES
LENGTH OF BRIDGES	397.20	FEET	0.075	MILES
LENGTH OF PROJECT	16,600.00	FEET	3.144	MILES

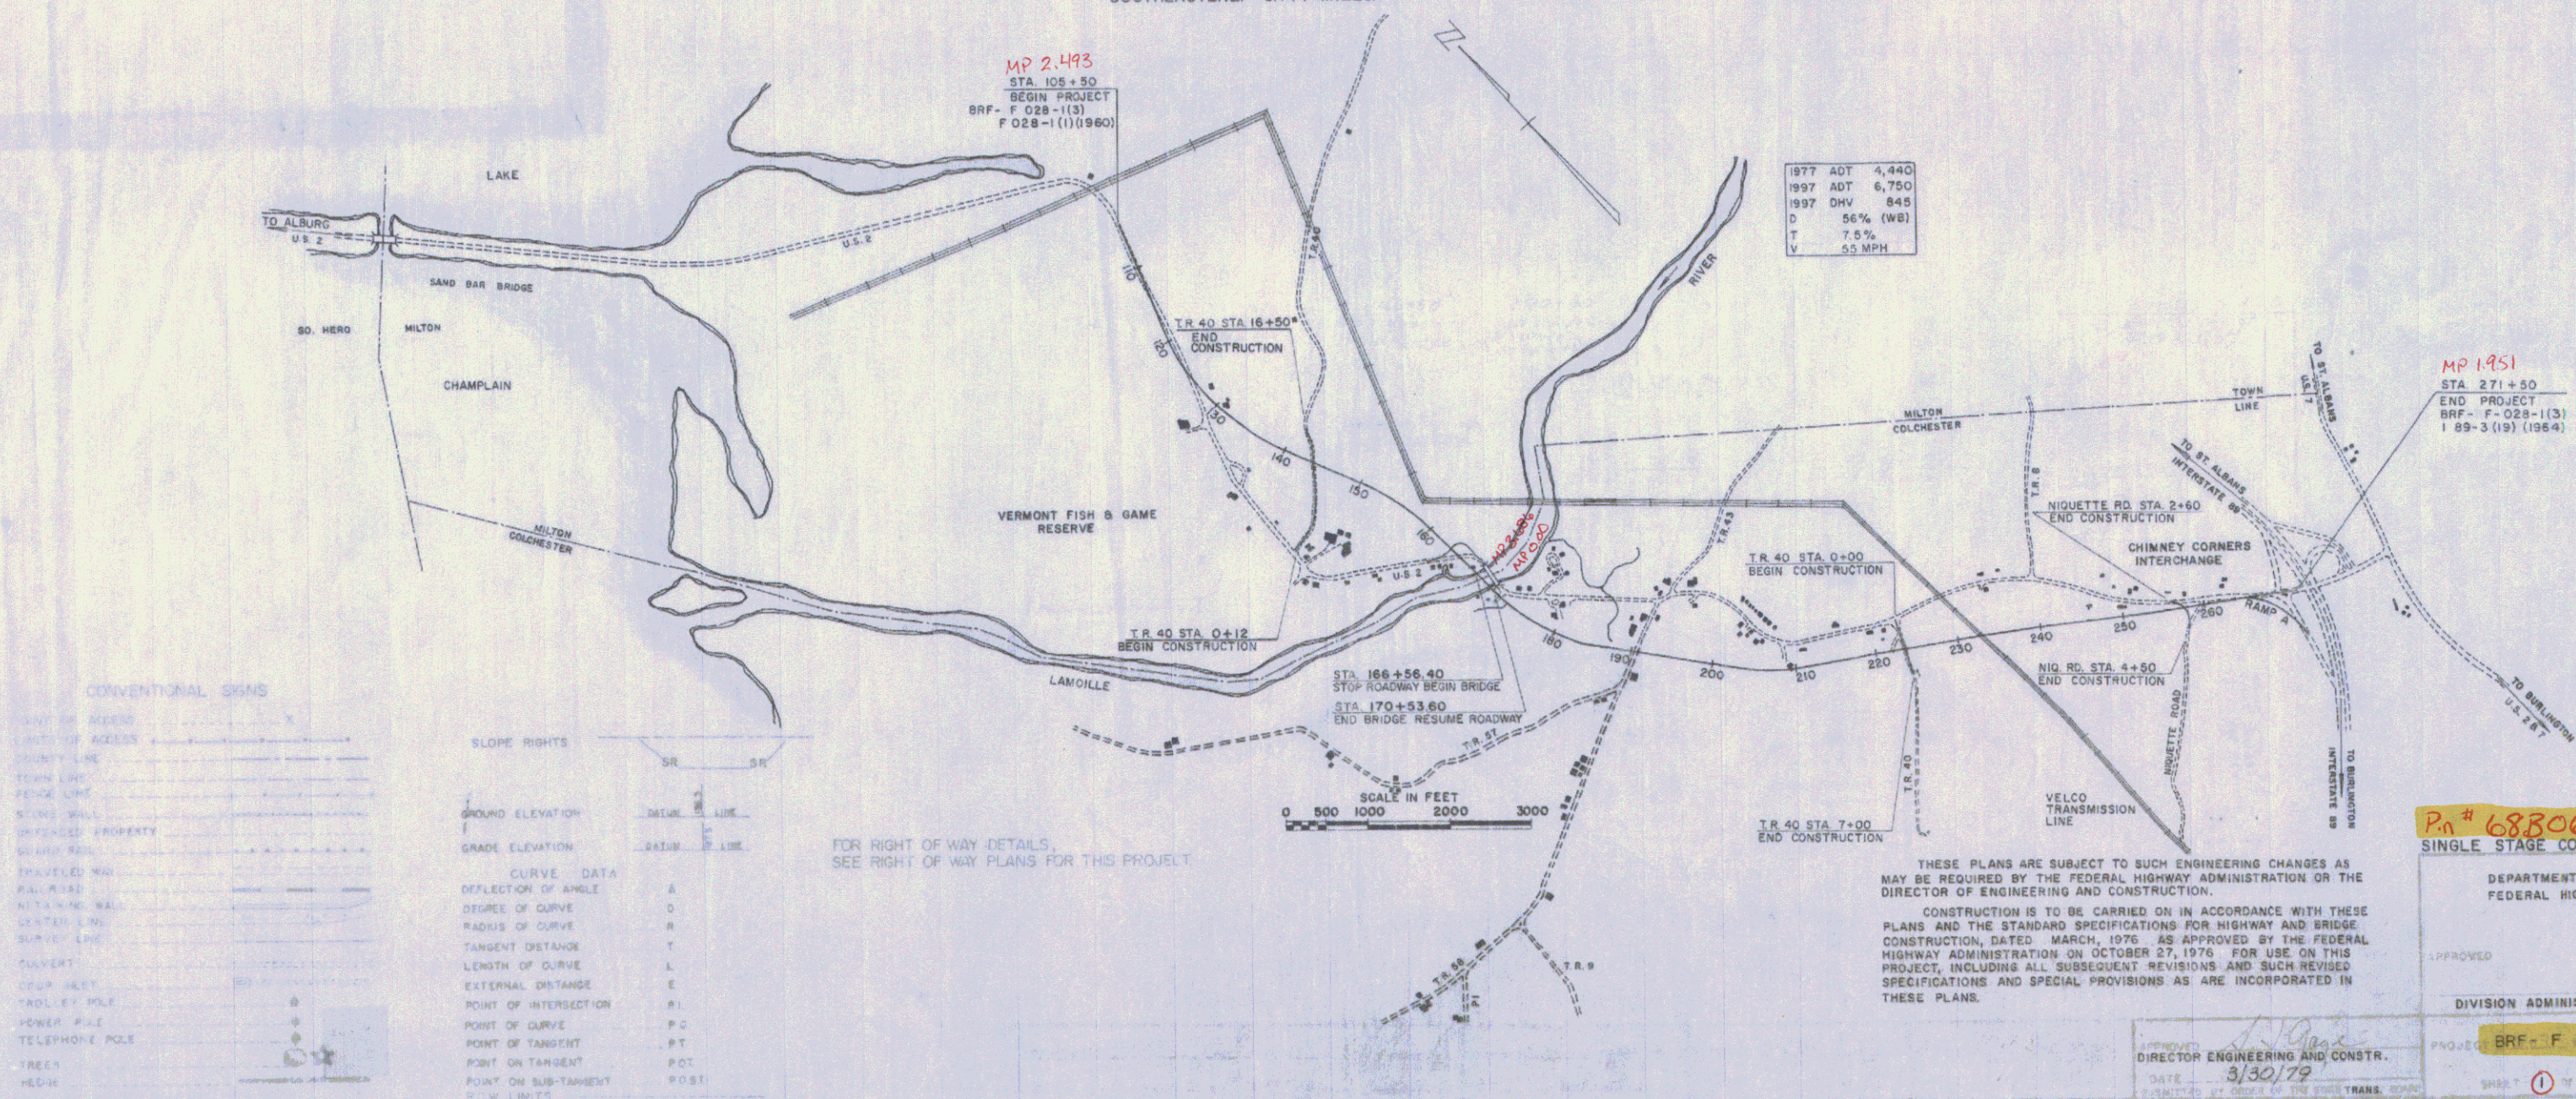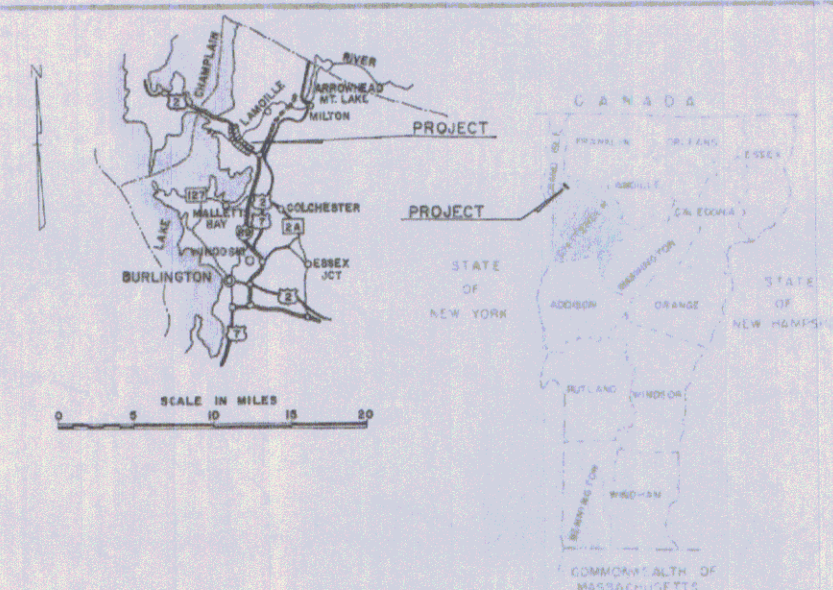

THESE PLANS ARE SUBJECT TO SUCH ENGINEERING CHANGES AS MAY BE REQUIRED BY THE FEDERAL HIGHWAY ADMINISTRATION OR THE DIRECTOR OF ENGINEERING AND CONSTRUCTION.

CONSTRUCTION IS TO BE CARRIED ON IN ACCORDANCE WITH THESE PLANS AND THE STANDARD SPECIFICATIONS FOR HIGHWAY AND BRIDGE CONSTRUCTION, DATED MARCH, 1976 AS APPROVED BY THE FEDERAL HIGHWAY ADMINISTRATION ON OCTOBER 27, 1976 FOR USE ON THIS PROJECT, INCLUDING ALL SUBSEQUENT REVISIONS AND SUCH REVISED SPECIFICATIONS AND SPECIAL PROVISIONS AS ARE INCORPORATED IN THESE PLANS.

P.n # 683069
SINGLE STAGE CONSTRUCTION

DEPARTMENT OF TRANSPORTATION
FEDERAL HIGHWAY ADMINISTRATION

APPROVED 4/01/74

DIVISION ADMINISTRATOR

BRF - F 028-1(3)

SHEET 1 OF 291 SHEETS

APPROVED *S. V. [Signature]*
DIRECTOR ENGINEERING AND CONSTR.

DATE 3/30/79

1. ADMITTED BY ORDER OF THE BOARD OF TRANS. 1/2/20