

INDEX OF SHEETS	
SHEET 1	TITLE SHEET
SHEET 2	PLAN SHEET
SHEET 3	STANDARD SHEET E-10
SHEET 4	STANDARD SHEET E-10A

STATE OF VERMONT DEPARTMENT OF HIGHWAYS



PROPOSED IMPROVEMENT

TOWN OF BERKSHIRE

FRANKLIN COUNTY

CONTRACTOR-STATE FORCES
ENGINEER-SC.BRISHAM
STARTED-14 JULY 1975
COMPLETED-9 OCTOBER 1975
ACCEPTED-20 OCTOBER 1975
BITUMINOUS CONCRETE PAVEMENT-PIKE INDUSTRIES,SWANTON,VT.

ITEM NO.	ITEM	UNIT	ORIG	FINAL
406.25	BIT. CONCRETE PAVE.	TON		20.07



NOTES: ANY FURTHER INFORMATION CONCERNING
FINAL QUANTITIES, AMOUNTS OR OTHER DETAILS
RELATIVE TO THIS PROJECT MAY BE FOUND IN
EITHER THE FIELD BOOKS OR THE ESTIMATE
FILE.

BEGINNING AT A POINT ON VT 105 0.199 MILES WESTERLY
OF THE ROAD JUNCTION OF VT.105 AND VT 118 AND EXTENDING
WESTERLY 0.004 MILES INCLUDING A RAILROAD CROSSING ON VT 105
AND TOWN HIGHWAY 5

LOCATION 1		LOCATION 2	
1975 ADT	2000	1975 ADT	275
1975 DHV	235	1975 DHV	55
D	52 %	D	50 %
V	50 MPH	V	30 MPH
T	12 %	T	5 %
1 ACCIDENT 1959-72		NO ACCIDENTS	

PROJECT DESCRIPTION THIS PROJECT CONSISTS OF
INSTALLING RAIL CROSSING PROTECTIVE DEVICES AND RESURFACING
APPROACHES TO IMPROVE CROSSINGS AT LOCATIONS 1 AND 2.

BUILT AS DESIGNED

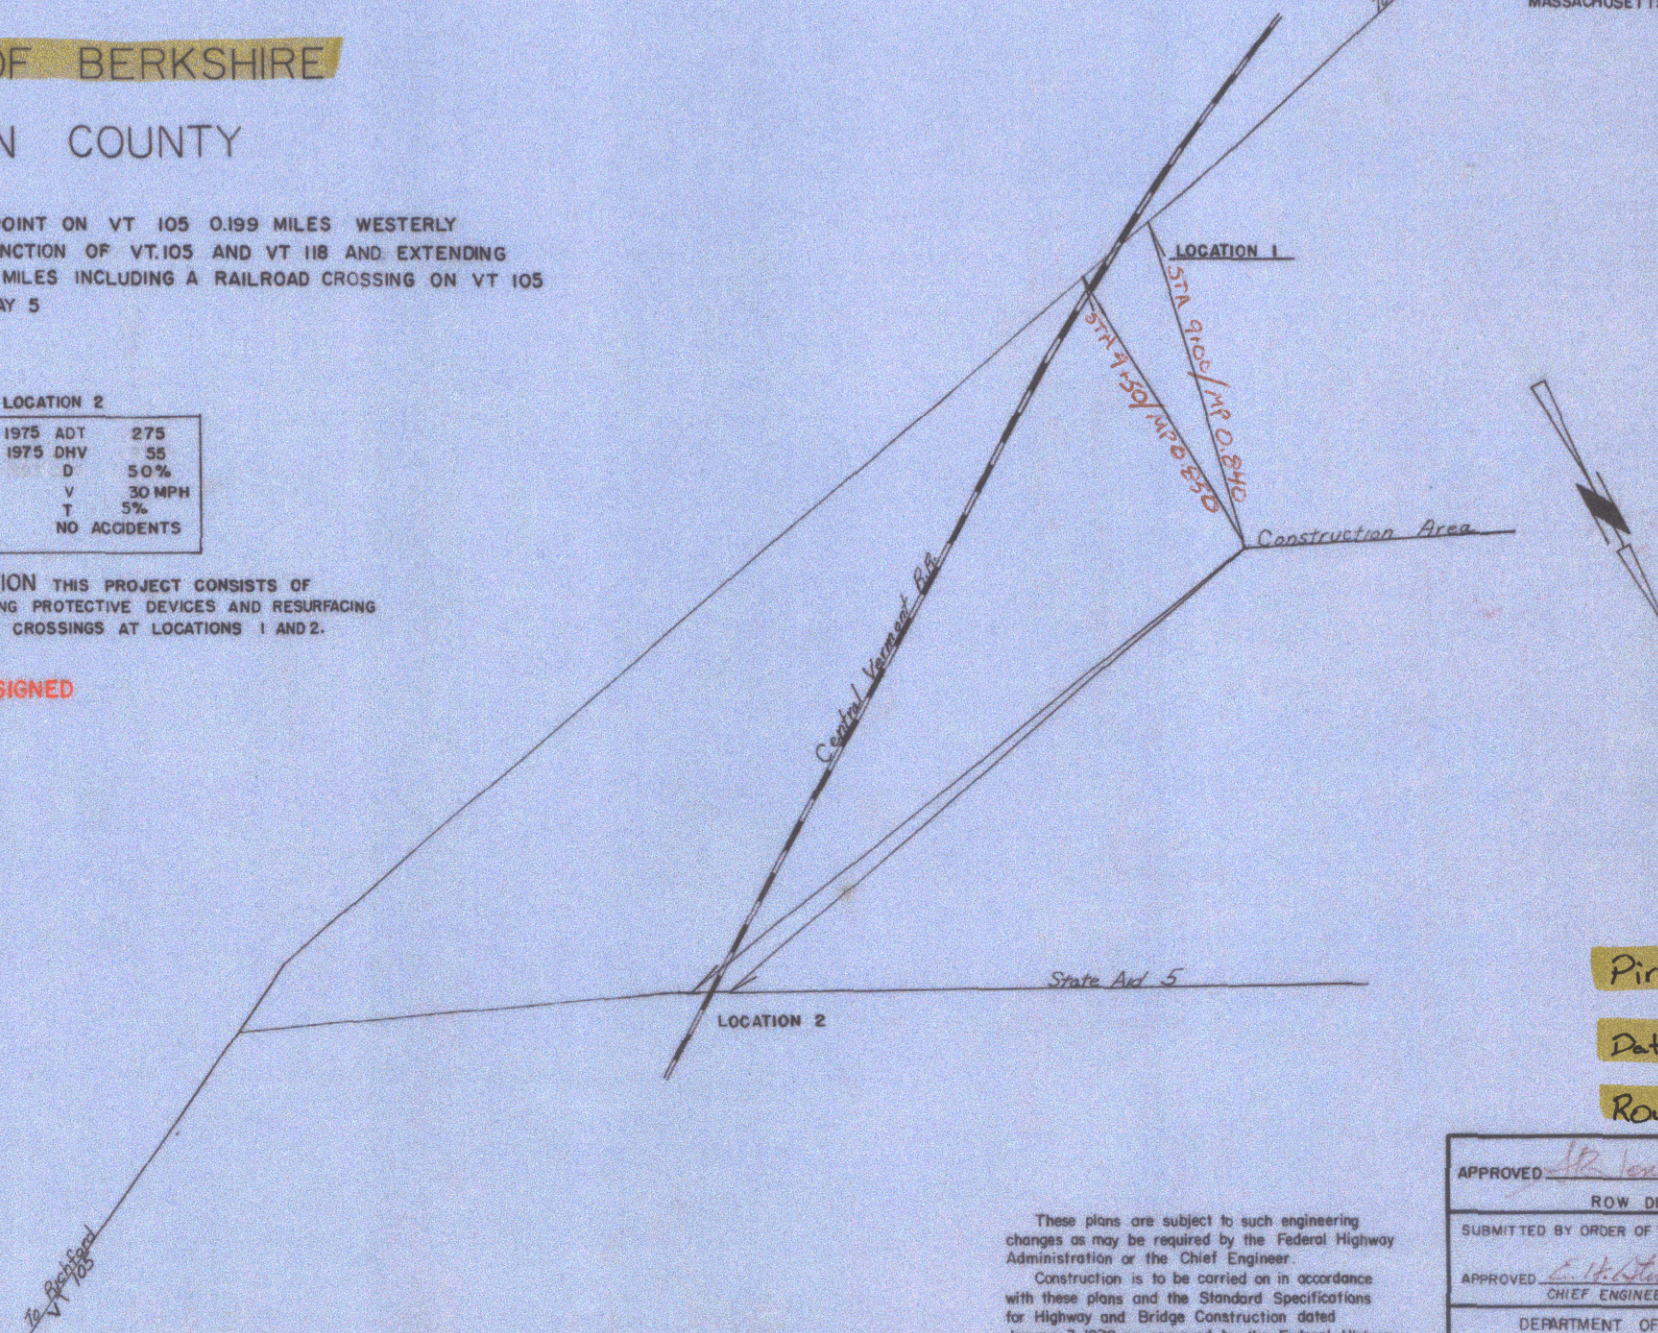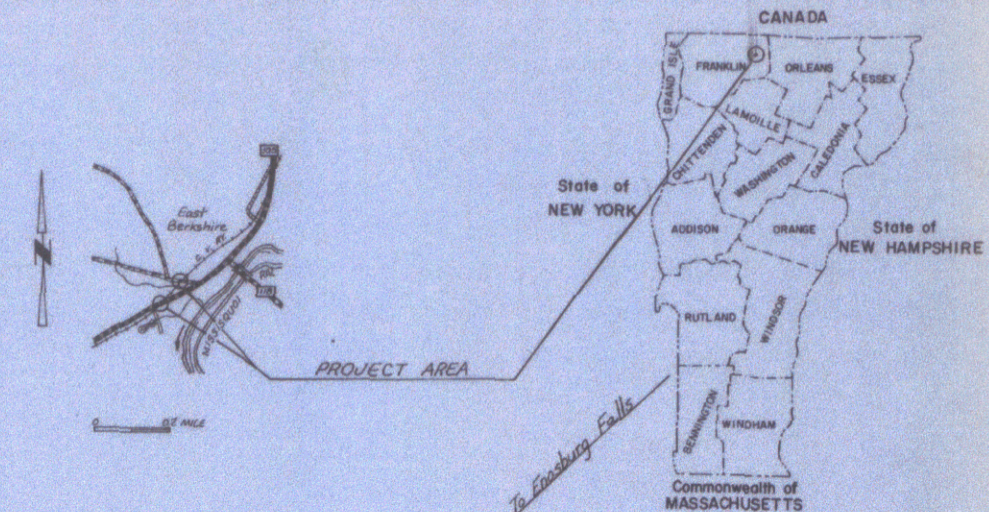

CONVENTIONAL SIGNS	
COUNTY LINE	---
TOWN LINE	---
LIMITS OF ACCESS	---X---
POINT OF ACCESS	X
FENCE LINE	---X---
STONE WALL	---X---
TRAVELED WAY	---
GUARD RAIL	---
RAILROAD	---
SURVEY LINE	---
CULVERT	---
POWER POLE	---
TELEPHONE POLE	---
TREES	---
F.A. CONST. IDENTIFICATION SIGNS	---
PROPERTY LINE	---
R.O.W. TAKING LINE	---
SLOPE RIGHTS	---
TOP OF CUT	---
TOE OF SLOPE	---

These plans are subject to such engineering
changes as may be required by the Federal Highway
Administration or the Chief Engineer.
Construction is to be carried on in accordance
with these plans and the Standard Specifications
for Highway and Bridge Construction dated
January 3, 1972 as approved by the Federal Highway
Administration on December 28, 1971 for use on
this project, including all subsequent revisions and
such revised specification and special provisions as
are incorporated in these plans.

Pin # 75R141
Date: 10/9/1975
Route VT105

APPROVED	DATE 3-18-75
ROW DIRECTOR	
SUBMITTED BY ORDER OF THE STATE HIGHWAY BOARD	
APPROVED	DATE 3-18-75
CHIEF ENGINEER	
DEPARTMENT OF TRANSPORTATION FEDERAL HIGHWAY ADMINISTRATION	
APPROVED	DATE
DIVISION ENGINEER	
PROJECT	NR 75-0005 (4)
SHEET	1 OF 1
SRS. 12/17/70	