

INDEX OF SHEETS

1. TITLE	
2-3. ALIGNMENT AND TIES	
4. TYPICAL SECTIONS	
5-7. SUMMARY OF QUANTITIES	
8-9. ITEM DETAIL AND DRAINAGE	
10-15. EARTHWORK AND GRADE	
16-31. BLANK	
32-44. R.O.W. DETAIL-MONTPELIER	
45. R.O.W. DETAIL-MIDDLESEX	
46-56. PLAN AND PROFILE	
57. GOULD HILL BRIDGE PLAN SHEET	
58-61. UTILITIES	
61A-61D. SIGN DETAIL SHEET	
62-69. BR SERIES 740 @ 157+75	
70-74. BR SERIES 750 @ 208+5.5	
75-81. BR SERIES 760 @ 227+26.75	
82. BLANK	
83. A-61 SOLID ROCK EXCAVATION	8-26-B1R
84. B-5 TYPICAL SLOPE ROUNDING	12-6-71
85. B-11 UNDERDRAIN IN SHATTERED ROCK	12-12-74R
86. C-1 CURBS, BITUMINOUS SIDEWALK	12-16-80R
87. D-2 HEADWALLS, UNDERDRAIN	12-16-76R
88. D-3 GUTTERS	4-27-73R
89. D-4 METAL END SECTIONS AND FLUSH BASINS	7-24-75R
90. D-5 DROP INLET	4-4-73R
91. D-8 DROP INLET	12-6-71
92. D-9 DROP INLET TOPS	12-6-71
93. D-10 DROP INLET TOPS	12-6-71
94. D-11 CAST IRON GRATE TYPE A	8-24-B1R
95. D-12 CAST IRON GRATE TYPE D	10-6-78R
96. D-16 CAST IRON GRATE TYPE B	11-14-72R
97. E-2 ROAD CONSTRUCTION APPROACH SIGNS	3-4-B1R
98. E-6 ON PROJECT SIGNS	4-1-B0R
99. E-7 DELINEATION AND BARRICADES	2-12-82R
100. E-7A BREAKAWAY BARRICADE	4-8-82
100A. E-13 ROUTE MARKER	2-3-82R
101. E-15 REGULATORY SIGNS	7-29-81
102. E-17 REGULATORY SIGNS	1-8-74R
103. E-20 WARNING SIGN	5-16-78R
104. E-23 GUIDE SIGNS	12-29-71
105. E-24A SIGN SUPPORTS	1-8-B1R
106. E-25 SIGN SUPPORTS	6-17-81R
107. E-29 SIGN PLACEMENT	8-25-81R
108. E-34 TRAFFIC SIGNAL DETAIL	8-23-82R
108A. E-36 VEHICLE DETECTOR LOOP	8-23-82R
109. G-1 GUARD RAIL, STEEL BEAM	12-16-80R
110. G-10 GUARD RAIL, STEEL BEAM	12-16-80R
111. G-4 MARKER POSTS	5-25-82R
112. G-11 ANCHOR FOR STEEL BEAM GUARD RAIL	5-29-79R
113. J-1 BOUNDARY MARKERS	6-27-80
114. T-1 TEMPORARY EROSION CONTROL	12-7-76R
115. T-2 TEMPORARY EROSION CONTROL	7-5-72
116. SB-R6-82 BRIDGE RAILING	6-18-82R
117. SCB-DI-75 GENERAL INFORMATION	9-14-81R
118. SCB-D6-75 BRIDGE DETAILS	1-3-79R
119. SCB-D9-71 CURTAIN WALLS	1-27-75R
120-191. CROSS SECTIONS	

RECORD PLANS
 CONTRACT DATED - FEB. 22, 1983
 CONSTRUCTION BEGAN - FEB. 25, 1983
 COMPLETED & ACCEPTED - JAN 3, 1985
 CONTRACTOR - EARTH CONSTRUCTION INC.
 RESIDENT ENGINEER - JACQUES G. COUTURE
 RECORD PLANS - JAMES F. MARSEILL

STATE OF VERMONT AGENCY OF TRANSPORTATION



PROPOSED IMPROVEMENT CITY OF MONTPELIER - TOWN OF MIDDLESEX


MATERIAL SUPPLIERS
 GRAN BACKFILL FOR STRUCTURES - ALEXANDER PIT, MONTPELIER, VT.
 SUBBASE OF GRAVEL - ALEXANDER PIT, MONTPELIER, VT.
 PLANT MIX BASE COURSE - COOLEY, BERLIN, VT.
 BITUMINOUS CONC. PAVEMENT - COOLEY, BERLIN, VT.
 CONCRETE - ANDERSON, BERLIN, VT.
 REINFORCING STEEL - PIONEER VALLEY STEEL CO., MEDFORD, MASS.
 CGMP ARCH-LANE METAL PRODUCTS, BALSTON SPA, NY.
 WATER REPELLENT - SONNEBORN BUILD. PRO., MASPEETH, NY.
 SHEET MEMBRANE WATERPROOFING - A.D. ROSSI, ST. J., V.T.
 ACCGMP - LANE METAL PRODUCTS, BALSTON SPA, NY.
 RCP - FIELD CONCRETE PIPE CO., WAUREGAN, CT.
 CGMP - LANE METAL PRODUCTS, BALSTON SPA, NY.
 CAST IRON GRATE - E.L. LEBARON, BROCKTON, MASS.
 6" UNDERDRAIN - LANE METAL PRODUCTS, BALSTON SPA, NY.
 GUARD RAIL - Q.W. HUBBEL & SONS, NEW HARTFORD, N.Y.
 ABS SEWER PIPE, SOLID WALL - ARMCO INC., MIDDLETOWN, OHIO
 SEAMLESS COPPER WATER TUBE - CERRO COPPER PRODUCTS, E. ST. LOUIS, ILL.
 DUCTILE IRON PIPE, CEMENT LINED - GRIFFIN PIPE PRODUCTS CO., FLORENCE, N.J.
 EXTENSION SERVICE BOX & CURB STOP - E.J. PRESCOTT INC., MONTPELIER, VT.
 GATE VALVE & HYDRANT - E.J. PRESCOTT INC., MONTPELIER, VT.
 PIPE INSULATION - E.J. PRESCOTT INC., MONTPELIER, VT.

COUNTY OF WASHINGTON VT. ROUTE 12 - (ELM STREET)

PROJECT MONTPELIER M 6400(8) (VT ROUTE 12) BEGINS AT A POINT ON ELM ST. IN MONTPELIER 2.101 MILES SOUTH OF THE MONTPELIER-MIDDLESEX TOWN LINE AND EXTENDS NORTHERLY 2.101 MILES. MIDDLESEX RS 0241(12) BEGINS ON VT ROUTE 12 AT THE MONTPELIER-MIDDLESEX TOWN LINE AND EXTENDS NORTHERLY 0.028 MILES.

1979 ADT = 1970 3000
 2000 ADT = 2840-4320
 2000 DHV = 400-570
 V = 40 MPH


LENGTH OF MONTPELIER PROJECT M 6400(8) 11,092.68 FT. = 2.101 MILES
 LENGTH OF MIDDLESEX PROJECT RS 0241(12) 150 FT. = 0.028 MILES
 LENGTH OF CONTRACT 11,242.68 FT. = 2.129 MILES

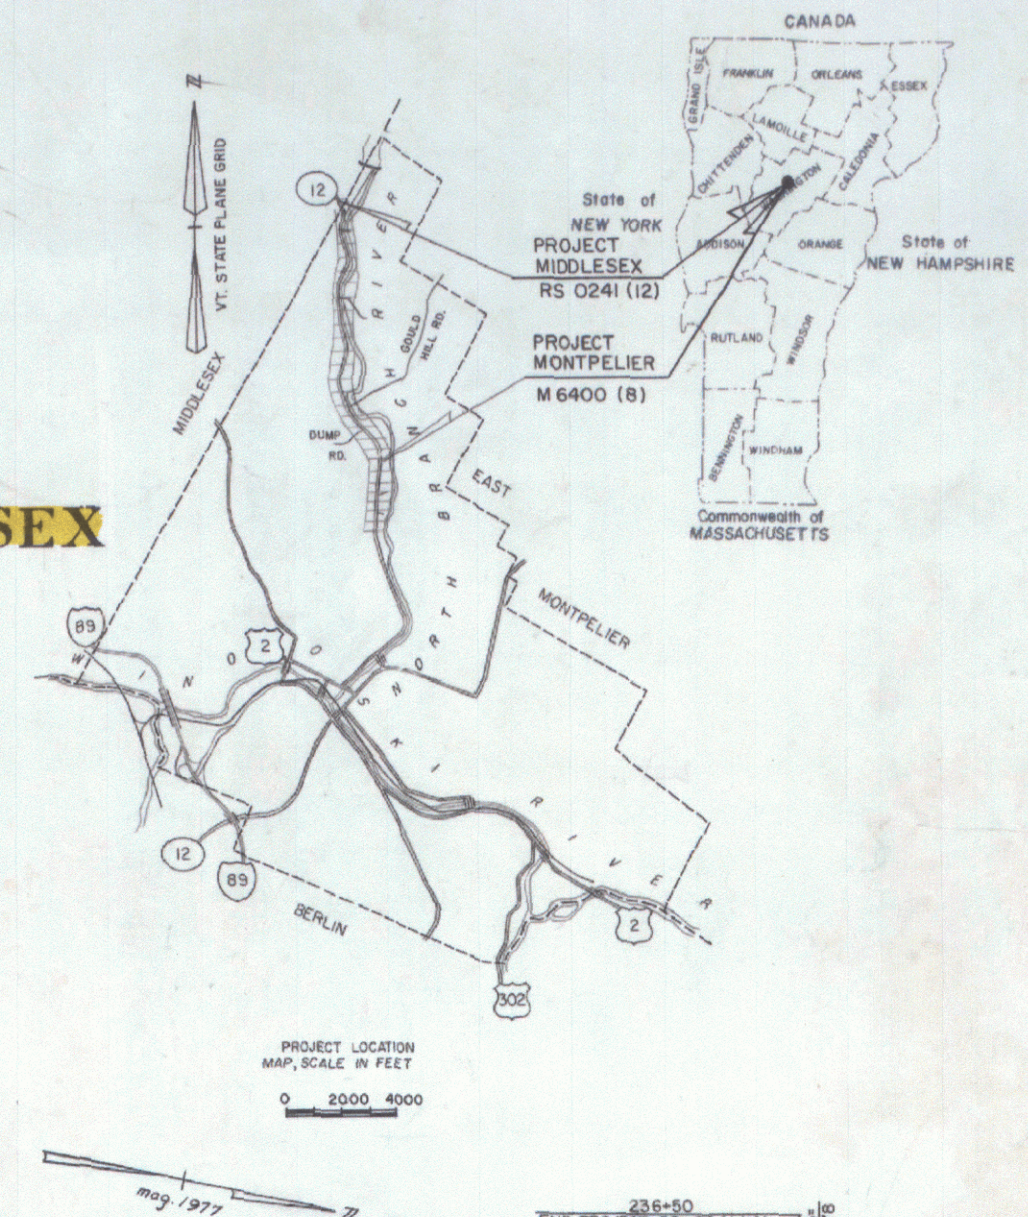

RECORD PLANS - MIDDLESEX RS 0241(12) - SEE ABOVE
 MATERIAL SUPPLIERS - MIDDLESEX RS 0241(12) - SEE ABOVE

CONVENTIONAL SIGNS

COUNTY LINE	---
TOWN LINE	---
LIMITS OF ACCESS	---
POINT OF ACCESS	X
FENCE LINE	---
STONE WALL	---
TRAVELED WAY	---
GUARD RAIL	---
RAILROAD	---
SURVEY LINE	---
CULVERT	---
POWER POLE	---
TELEPHONE POLE	---
TREES	---
CONTROL OF ACCESS	---
PROPERTY LINE	---
R.O.W. TAKING LINE	---
SLOPE RIGHTS	---
TOP OF CUT	---
TOE OF SLOPE	---

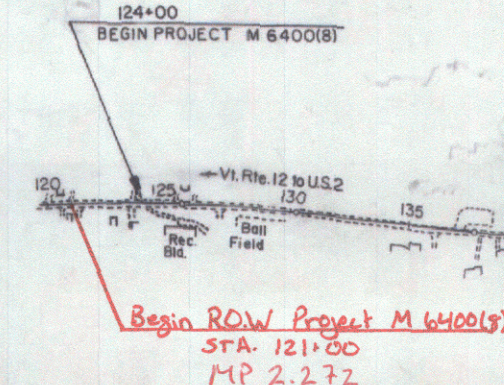

DATUM
 VERTICAL NGVD 1929
 HORIZONTAL N/A

Route VT12 under City Control
 in Montpelier

SCALE IN FEET
 0 400 800 1200 1600 2000

These plans are subject to such engineering changes as may be required by the Federal Highway Administration or the Director of Engineering and Construction.
 Construction is to be carried on in accordance with these plans and the Standard Specifications for Highway and Bridge Construction dated March, 1976, as approved by the Federal Highway Administration on October 27, 1976 for use on this project, including all subsequent revisions and such revised specifications and special provisions as are incorporated in these plans.

5/28/1985

SUBMITTED BY ORDER OF THE STATE TRANSPORTATION BOARD
 APPROVED *S. J. O'Connell* DATE *5-28-85*
 DIRECTOR OF ENGINEERING AND CONSTRUCTION
 DEPARTMENT OF TRANSPORTATION
 FEDERAL HIGHWAY ADMINISTRATION
 APPROVED _____ DATE _____
 DIVISION ADMINISTRATOR
 PROJECT M 6400(8)
 RS 0241(12)
 SHEET 1 OF 191 SHEETS

STATE OF VERMONT
AGENCY OF TRANSPORTATION
RIGHT-OF-WAY PLANS
ALPHABETICAL INDEX

GRANTOR	SHEET NO.	PARCEL NO.
A		
ALEXANDER, ROBERT C.	15,24	43
ALEXANDER, ALBERT A.	15,24	43
ALEXANDER, ALLEN B.	15,24	43
B		
BARNES, ROBERT B.	9,20	21
BROUSSEAU, FREDERICK L.	12,23	35
BROUSSEAU, PAULINE G.	12,23	35
BROWN, BURTON P.	9,20	22
BROWN, PATRICIA M.	9,20	22
BUTTERFIELD, DAVID	13,20	37
BUTTERFIELD CAROL	13,20	37
BURZYCHI, DONNA L.	14,23	41
BURZYCHI, STANLEY J.	14,23	41
BUSHEY, ROBERTA L.	15,24	43
C		
CAMPBELL, ALICE E.	15,24	43
CHOINARD, ADELARD A.	16,25	50
CHOINARD, DORINA	16,25	50
CITRINI, NELLIE B.	16,25	54
COATES, CLIFTON T.	7,19	12
COATES, PHYLLIS J.	7,19	12
CONE, HAROLD ROY	9,20	20
CONE, DOROTHY L.	9,20	20
COTA, D. EILEEN	13,23	39
CITY OF MONTPELIER	6,18	7
RECREATION DEPT.	19	

GRANTOR	SHEET NO.	PARCEL NO.
D		
DANA CORPORATION	8,19	17
DASHNER, EDITH V.	14,23	40
DEMASI, JOSEPH P.	11,21	30
DEMASI, THERESA M.	11,21	30
DONOVAN, RHODA C.	10,20	26
DUFRESNE, JOHN L.	9,20	19
DUFRESNE, BEVERLY B.	9,20	19
DUQUETTE, IDA F.	14,24	42
E		
ELDRED, ALVIN R.	11,22	31
ELDRED, ARDYS R.	11,22	31
ELDRED, ROBERT A.	12,22	33
ELDRED, CAROL M.	12,22	33
EMMONS, RICHARD A.	11,21	29
EMMONS, JANICE J.	11,21	29
F		
FIELDER, FLOYD R.	16,25	51
FIELDER, ALBERTA M.	16,25	51
FROSTICK, THOMAS	10,21	27
FROSTICK, VERONICA	10,21	27

GRANTOR	SHEET NO.	PARCEL NO.
G		
GAVIN, JAMES A.	8,19	15
GAVIN, HOLLY R.	8,19	15
GOVE, DENNIS E.	12,22	32
GOVE, NANCY E.	12,22	32
GOVE, DONALD E.	12,22	32
GOSS, ARTHUR J.	15,24	49
GOSS, JANIS P.	15,24	49
H		
HEALY, CHARLES E.	5,18	5
HEALY, CARMELITA W.	5,18	5
I		
HUNTINGTON, HENRY D.	6,19	9
J		
INTERSTATE EQUIPMENT & SUPPLIES CO. INC.	5,18	6

GRANTOR	SHEET NO.	PARCEL NO.
J		
JANEWAY, EDWARD G., JR.	10,20	25
JANEWAY, CLAUDE M.	10,20	25
JANGRAW, JOHN J.	16,25	52
JANGRAW, BETTE E.	16,25	52
JOHNSON, LINDA	8,19	14
K		
KOENEMANN, EDWARD J.	5,18	4
KOENEMANN, DONA M.	5,18	4
L		
LAGUE, INC.	17,19	55
LUPIEN, LEON	12,23	34
LUPIEN, GRACE L.	12,23	34

GRANTOR	SHEET NO.	PARCEL NO.
M		
MAGOON, WENDELL A.	16,25	53
MAGOON, LILLIAN M.	16,25	53
MATKOWSKI, GEORGE T.	7,19	13
MATKOWSKI, JEWELL E.	7,19	13
MCDONALD, ROBERT W.	15,24	47
MCDONALD, LYNN B.	15,24	47
MEARS, STEPHEN A.	15,24	48
MEARS, CRISTINE GOSS	15,24	48
MERCHANT, CAROL V.	15,24	45
MERCHANT, MICHAEL A.	15,24	45
MERRILL, BETTY W.	5,18	3
MERRILL, RAYMOND E.	5,18	3
N		
NICHOLS, CHARLES B., JR.	8,19	18
NICHOLS, HELEN A.	8,19	18
NICHOLSON, ELIZABETH L.	9,20	23
NICHOLSON, PETER A.	9,20	23
NIES, ALEXANDER	10,21	28
O		

MADE BY F. T. JORDAN DATE 12-18-81
CHECKED BY B. L. STANCLIFF DATE 12-18-81

MAY 28 1985

PROJECT MONTPELIER

NO. M 6400 (8)

SHEET 3 OF 25

STATE OF VERMONT
DEPARTMENT OF HIGHWAYS
RIGHT-OF-WAY PLANS
ALPHABETICAL INDEX

GRANTOR	SHEET NO.	PARCEL NO.
P		
PEPIN, BRENDA	5,18	2
PEPIN, ROLAND	5,18	2
PERRY, CHRISTINE BROWN	5,18 21,25	44
PHILLIPS, CAROL W.	6,18	8
PHILLIPS, CHARLES S.	6,18	8
Q		
R		
RELATION, DOROTHY M.	15,24	46
RELATION, LESLIE A.	15,24	46
ROBY, LINDA M.	13,23	36
ROBY, STEPHEN E.	13,23	36
ROOD, ROBERT C.	8,19	16
ROOD, RUTH A.	8,19	16

GRANTOR	SHEET NO.	PARCEL NO.
S		
SHIU, KAYAU	6,19	10
STATE OF VERMONT (FORMERLY FLANDERS, ROY H. & REBECCA)	5,25	1
SHIU, KAYAU - LESSOR	17,19	60
T		
THE ASSOCIATES, INC. d/b/o ALPINE ESTATES	8,19,20	17
U		
V		
W		
WOODBURY ASSOCIATES	7,19	11
WOODBURY ASSOCIATES - LESSEE	17,19	60

GRANTOR	SHEET NO.	PARCEL NO.
X		
Y		
Z		

GRANTOR	SHEET NO.	PARCEL NO.
---------	-----------	------------

GRANTOR	SHEET NO.	PARCEL NO.
---------	-----------	------------

MAY 28 1985

MADE BY: R. STANCLIFF DATE 12-18-81
CHECKED BY: E.T. JORDAN DATE 12-18-81

PROJECT: MONTPELIER
NO. M 6400 (8)
SHEET 4 OF 25

STATE OF VERMONT
AGENCY OF TRANSPORTATION
RIGHT-OF-WAY PLANS
DETAIL SHEET

TABLE OF PROJECT PROPERTY ACQUISITION

PARCEL NO.	GRANTOR	SHEET NO.	BEGINNING STATION	ENDING STATION	TAKING	REM.	RIGHTS	TITLE TAKEN	DATE	TOWN OR CITY RECORDED	BK.	PG.	REMARKS
1	STATE OF VERMONT	25						WD	11-13-81	MONTPELIER	168	408,410	FORMERLY FLANDERS, ROY H. & REBECCA A.
2	PEPIN, ROLAND & BRENDA	18	121+44 RT. 121+44 RT.	121+50 RT.			CULVERT (P) DITCH (P)	WDOE	9-24-82	MONTPELIER	173	243-4	
3	MERRILL, RAYMOND E. & BETTY W.	18	121+28 LT. 121+80 LT. 121+81 LT. 121+81 LT. 121+84 LT. 121+84 LT.	REV. 122+50 LT. REV. 122+10 LT. REV. 122+40 LT. REV. 122+40 LT.	0.01A±		DRIVE (T) CULVERT (P) DITCH (P) CULVERT (P) CULVERT (P) DITCH (P)	WDOE	8-26-82	MONTPELIER	173	189-90	280 S.F.± 14' PAVED
3A		18						OPTION		MONTPELIER			175 S.F.± TO INSTALL HEAD WALL
4	KOENEMANN, EDWARD J. & DONA M.	18	121+44 RT. 121+44 RT. REV. 121+60 RT.	121+50 RT.			CULVERT (P) DITCH (P) DRIVE (T)	WDOE	9-16-82	MONTPELIER	173	231-2	Release 8-11-82 Not recorded 22' GRAVEL
5	HEALY, CHARLES E. & CARMELITA M.	18	REV. 122+59 LT. REV. 123+62 LT.	REV. 124+00 LT.	0.01A±		DRIVE (T)	WDOE	7-8-82	MONTPELIER	173	55-6	635' S.F.± 16' GRAVEL
6A	INTERSTATE EQUIPMENT & SUPPLIES CO., INC.	18, 19	REV. 123+97 LT. REV. 124+35 LT.	REV. 125+02 LT.	0.01A±		DRIVE (T)	WDOE	7-9-82	MONTPELIER	173	99-100	515 S.F.± 18' GRAVEL
6B			REV. 126+47 LT. REV. 126+47 LT. REV. 126+47 LT. REV. 126+47 LT.	REV. 130+40 LT. REV. 130+40 LT. REV. 130+40 LT. REV. 130+40 LT.	0.08A±		SLOPE (P) 0.2TA± CONST. EASE. (T) 0.09A± DITCH (P) 0.05A± CULVERT (P)						3580 S.F.± 3850 S.F.± 1980 S.F.±
TOTAL					0.09A±								

TABLE OF REVISIONS

REVISION NO.	SHEET NO.	DESCRIPTION OF REVISION	DATE	MADE BY	APPROVED BY
1	16, 25	Parcel 54 A Citrini, Revised taking area to read; Rev. 230+62 Rt. - Rev. 230+67 Rt. 0.18 A±, All R.T. & I. As per C.O. # 5164	1-12-82	NWJ	T.P.M.
2	16, 25	Parcel 53 A Magoon, Revised taking area to read; Rev. 233+07 Rt. - Rev. 230+67 Rt. 0.03 A±, All R.T. & I. Added slope Rt. (P). As per C.O. # 5165	1-12-82	NWJ	T.P.M.
3	16, 25	Parcel 52 A Jangraw, Revised taking area to read; Rev. 218+46 Rt. - Rev. 229+10 Rt. 0.01 A±, All R.T. & I. Added slope Rt. (P). As per C.O. # 5166	1-12-82	NWJ	T.P.M.
4	16, 25	Parcel 51 A Fidler, Added slope Rt. (P). As per C.O. # 5167	1-12-82	NWJ	T.P.M.
5	14, 24	Parcel 42 A Duquette, Added slope Rt. (P). As per C.O. # 5168	1-12-82	NWJ	JOP
6	13, 23	Parcel 38 A Hess, Revised taking area to read; Rev. 199+10 Rt. - Rev. 200+89 Rt. 0.75 A±, Added slope Rt. (P). As per C.O. # 5169	1-12-82	NWJ	JOP
7	13, 23	Parcel 37 A Butterfield, Revised taking area to read; Rev. 195+58 Rt. - Rev. 199+10 Rt. 0.69 A±, Added slope Rt. (P). As per C.O. # 5170	1-12-82	NWJ	JOP
8	13, 23	Parcel 36 A Ruby, Revised taking area to read; Rev. 195+58 Rt. - Rev. 195+58 Rt. 100 S.F.±. As per C.O. # 5171	1-12-82	NWJ	JOP
9	12, 23	Parcel 35 Brauseau, Deleted parcel 35 A. Changed parcel 35 B to 35. As per C.O. # 5172	1-12-82	NWJ	JOP
10	13, 23	Parcel 33 Hess, Deleted parcel from plans Per C.O. # 5182	2-2-82	JDP	T.P.M.
11	10	Parcel 28 Nies, Change ending station ditch from 120+52 Lt. to 129+62 Lt. Per C.O. # 5197	2-2-82	JDP	T.P.M.
12	14, 24	Parcel 42 Duquette, Deleted 2 drives & added new drive at sta. 217+84 Rt. also added drain rt. at 218+00 Rt. & added rts. at 217+82 Rt. & 218+35 Rt. Per C.O. # 5200	2-11-82	JDP	T.P.M.
13	14, 24	Parcel 40 Dastin, Corrected name spelling on layout. Added right to install (T) at Rev. 209+60 Lt. - Rev. 209+75 Lt. Per C.O. # 5201	2-16-82	NWJ	T.P.M.

MADE BY: NBB DATE 12-15-81
CHECKED BY: RLS DATE 12-18-81

DR. RT. - DRAINAGE RIGHT
DIT. RT. - DITCHING RIGHT
CH. RT. - CHANNEL RIGHT
DRIVE RT. - DRIVE RIGHT
CUL. RT. - CULVERT RIGHT
D - DEMOLITION OR REMOVAL
W - WATER SOURCES

PRESENT R.O.W.
--- TAKING WITHOUT ACCESS
--- TAKING WITHOUT ACCESS ALONG PROPERTY LINES
--- TAKING WITH ACCESS
(P) PERMANENT EASEMENT
(T) TEMPORARY EASEMENT

LEGEND
--- CONST. EASE. --- CONST. EASEMENT
--- SR --- SLOPE RIGHTS
--- P --- PROPERTY LINE
--- Δ --- TOP OF CUT
--- O --- TDE OF SLOPE

APPROVED: Thomas P. Moore DATE 12-18-81
CHIEF OF PLANS & TITLES

MAY 28 1985
PROJECT MONTPELIER
NO. M 6400 (8)
SHEET 5 OF 25

STATE OF VERMONT AGENCY OF TRANSPORTATION RIGHT-OF-WAY PLANS DETAIL SHEET

TABLE OF PROJECT PROPERTY ACQUISITION

PARCEL NO.	GRANTOR	SHEET NO.	BEGINNING STATION	ENDING STATION	TAKING	REM.	RIGHTS	TITLE TAKEN	DATE	TOWN OR CITY RECORDED	BK.	PG.	REMARKS
7	CITY OF MONTPELIER	18, 19	REV. 127+17 RT. REV. 135+35 RT. REV. 136+63 RT. REV. 136+19 RT. REV. 136+35 RT. REV. 136+80 RT. REV. 136+84 RT.	REV. 136+00 RT. REV. 136+88 RT. REV. 136+90 RT.			DRIVE (T) CULVERT (P) CULVERT (P) DRIVE (T) CONST. EASE. (T) 230 S.F.± SLOPE (T) 10 S.F.± CULVERT (P)	RAW AGREE.		MONTPELIER			PAVED APPROACH PAVED APPROACH
	PHILLIPS, CHARLES S. & CAROL W.	18	REV. 125+02 LT. REV. 125+02 LT. REV. 125+47 LT. REV. 126+24 LT. REV. 126+30 LT.	REV. 126+47 LT. REV. 125+30 LT. REV. 126+47 LT. REV. 126+47 LT.	0.02 A±		SLOPE (T) 0.02 A± DRIVE (T) DRIVE (T) DITCH (P) 85 S.F.±	CAND WOOD		MONTPELIER			950 S.F.± CEDAR RAIL FENCE 935 S.F.± 10' GRAVEL 10' GRAVEL
9	HUNTINGTON, HENRY D.	19	REV. 130+40 LT. REV. 130+40 LT. REV. 130+40 LT. REV. 130+40 LT. REV. 130+65 LT. REV. 136+22 LT.	REV. 136+40 LT. REV. 136+40 LT. REV. 136+40 LT. REV. 136+09 LT. 	0.14 A±		SLOPE (P) 0.58 A± CONST. EASE. (T) 0.16 A± DITCH (P) 0.07 A± CULVERT (P) DRIVE (T)	WOOD	8-3-82	MONTPELIER	173	140-42	2845 S.F.± 24' GRAVEL
10A	SHIU, KAYAU	19	REV. 136+40 LT. REV. 136+40 LT. REV. 136+40 LT. REV. 136+84 LT.	REV. 137+40 LT. REV. 137+40 LT. REV. 137+40 LT. REV. 137+40 LT.	0.02 A±		SLOPE (T) 25 S.F.± CONST. EASE. (T) 0.02 A± CULVERT (P)	OPTION	9-9-82	MONTPELIER	176	8-10	800 S.F.± 1050 S.F.±
10B			REV. 137+40 LT. REV. 137+40 LT. REV. 137+40 LT.	REV. 137+90 LT. REV. 137+90 LT. REV. 137+90 LT.	0.01 A±		CONST. EASE. (T) 0.01 A± CULVERT (P) DRIVE (T)						400 S.F.± 500 S.F.±

PARCEL 10 CONTINUED ON NEXT SHEET

TABLE OF REVISIONS

REVISION NO.	SHEET NO.	DESCRIPTION OF REVISION	DATE	MADE BY	APPROVED BY
14	12	Parcel #34 Dupien, Added All RT. 41, 240 S.F.±, Slope (P) at Rev. 134+65 Rt. - Rev. 135+34 Rt. Per C.O. # 5203	2-16-82	NWJ	T.P.M.
15	13	Parcel # 36 Ruby, Added All RT. 41, 25 S.F.±, Slope (P) at Rev. 135+34 Rt. - Rev. 136+19 Rt. Per C.O. # 5204	2-16-82	NWJ	T.P.M.
16	13	Parcel # 37 Butterfield, Changed Slope Right (P) to All RT. 41, 300 S.F.±, Slope (P) at Rev. 135+15 Rt. - Rev. 136+24 Rt. Per C.O. # 5205	2-16-82	NWJ	T.P.M.
17	14	Parcel # 42 Duguetta, Changed Slope Right (P) to All RT. 41, 504 S.F.±, Slope (P) at Rev. 209+20 Rt. - Rev. 212+80 Rt. Per C.O. # 5206	2-16-82	NWJ	T.P.M.
18	14	Parcel # 51 Kelder, Changed Slope Right (P) to All RT. 41, 32 S.F.±, Slope (P) at Rev. 228+30 Rt. - Rev. 228+44 Rt. Per C.O. # 5207	2-17-82	NWJ	T.P.M.
19	16	Parcel # 52 Jangraw, Changed Slope Right (P) to All RT. 41, 300 S.F.±, Slope (P) at Rev. 228+44 Rt. - Rev. 229+07 Rt. Per C.O. # 5208	2-17-82	NWJ	T.P.M.
20	16	Parcel # 53 Magana, Changed Slope Right (P) to All RT. 41, 0.03 A±, 750 S.F.±, Slope (P) at Rev. 228+107 Rt. - Rev. 230+62 Rt. Per C.O. # 5209	2-17-82	NWJ	T.P.M.
21	11, 22	Parcel # 29 Emmons, Added Ditch (P) & Drainage (P) Rights at Rev. 177+71 Rt. - Rev. 177+78 Rt. Per C.O. # 5213	2-18-82	NWJ	ESP
22	22	Parcel # 30 Demasi, Changed Const. Ease. (P) to Const. Ease. (T) opposite Rev. 177+50 Lt. Per C.O. # 5214	2-18-82	NWJ	ESP
23	10, 21	Parcel # 28 Nick, Changed take area ending station from Rev. 149+89 Rt. to Rev. 149+79 Rt. Per C.O. # 5215	2-18-82	NWJ	ESP
24	12	Parcel # 32 Gove, Changed Slope (P) stations from 186+25 Rt. - 187+60 Rt. to Rev. 186+25 Rt. - Rev. 187+60 Rt.	2-18-82	NWJ	ESP
25	9, 20	Parcel # 22 B. BROWN, Added Culvert And Took CUL. Rt. (P) & DR. Rt. (P) Per Revised Design & C.O. # 5223	2-23-82	BAM	T.P.M.
26	9, 20	Parcel # 23 NICHOLSON, Changed Culvert & CUL. Rt. (P) Beginning Sta. Per C.O. # 5224	2-23-82	BAM	T.P.M.

MADE BY: NBB DATE 12-18-81
CHECKED BY: RLS DATE 12-18-81

DR. RT - DRAINAGE RIGHT
DIT. RT - DITCHING RIGHT
CH. RT - CHANNEL RIGHT
DRIVE RT - DRIVE RIGHT
CUL. RT - CULVERT RIGHT
D - DEMOLITION OR REMOVAL
W - WATER SOURCES

PRESENT R.O.W.
TAKING WITHOUT ACCESS
TAKING WITHOUT ACCESS ALONG PROPERTY LINES
TAKING WITH ACCESS
(P) PERMANENT EASEMENT
(T) TEMPORARY EASEMENT

LEGEND
CONST. EASE - CONST. EASEMENT
SR - SLOPE RIGHTS
P - PROPERTY LINE
- TOP OF CUT
- TOP OF SLOPE

APPROVED: *Thomas M. Mass* DATE:
CHIEF OF PLANS & TITLES

MAY 28 1985

PROJECT: MONTPELIER
NO. M 6400(S)
SHEET 6 OF 25

5

STATE OF VERMONT
AGENCY OF TRANSPORTATION
RIGHT-OF-WAY PLANS
DETAIL SHEET

TABLE OF PROJECT PROPERTY ACQUISITION

PARCEL NO.	GRANTOR	SHEET NO.	BEGINNING STATION	ENDING STATION	TAKING	REM.	RIGHTS	TITLE TAKEN	DATE	TOWN OR CITY RECORDED	BK.	PG.	REMARKS
100	PARCEL 10 CONTINUED FROM PREVIOUS SHEET		REV. 137+80 LT. REV. 137+80 LT. REV. 137+80 LT. REV. 137+80 LT.	REV. 141+87 LT. REV. 141+87 LT. REV. 141+87 LT. REV. 137+85 LT.	0.13 A±		SLOPE (P) 0.4 A± CONST. EASE. (T) 0.09 A± CULVERT (P) DITCH (P) 0.04 A± CULVERT (P)						4000 S.F.± 16355 S.F.± SIGN POST
100			REV. 138+60 LT. REV. 139+97 LT. REV. 140+30 LT.	REV. 141+87 LT.									600 S.F.± 3800 S.F.± 600 S.F.±
			REV. 141+87 LT. REV. 141+87 LT. REV. 141+87 LT. REV. 141+87 LT.	REV. 142+37 LT. REV. 142+37 LT. REV. 142+37 LT. REV. 142+37 LT.	0.01 A±		SLOPE (P) 0.08 A± CONST. EASE. (T) 0.01 A± DITCH (P) 250 S.F.±						
				TOTAL	0.17 A±								
11	WOODBURY ASSOCIATES	19	REV. 136+84 RT. REV. 136+85 RT. REV. 136+88 RT. REV. 136+05 RT.	REV. 138+00 RT. REV. 137+68 RT.			CULVERT & DITCH (P) CONST. EASE. (T) 0.02 A± SLOPE (T) 300 S.F.± DRIVE (T)	COND WOOD		MONTPELIER			1000 S.F.± 12' GRAVEL
12	COATES, CLIFTON T. & PHYLLIS J.	19	REV. 138+77 RT.				DRIVE (T)	REL.					14' GRAVEL
13	MATKOWSKI, GEORGE T. & JEWELL E.	19	REV. 138+85 RT. REV. 139+77 RT.	REV. 140+43 RT.			SLOPE (T) 0.02 A± DRIVE (T)	ACREE.					930 S.F.± 20' GRAVEL

TABLE OF REVISIONS

REVISION NO.	SHEET NO.	DESCRIPTION OF REVISION	DATE	MADE BY	APPROVED BY
27	10,20	Parcel #25 JANEWAY, Changed Culvert, Deleted CUL RT. (P) - DIT. RT. (P) & Revised Slope Area. Per Revised Design f Co. # 5225	2-23-82	B.R.M.	T.P.M.
28	11,22	Parcel #31 Eldred, Moved drive from Rev. 182+15 Lk. to 183+52 Lk. Added CUL. Re. (P) at Rev. 183+32 - Rev. 183+70 Lk. Per C.O. # 5250	3-22-82	NWJ	T.P.M.
29	12,22	Parcel #32 Cove, Added CUL. Re. (P) at Rev. 181+48 Re. - Rev. 181+60 Re., Added Dr. Re. (P) at Rev. 181+50 Re. Per C.O. # 5252	3-22-82	NWJ	T.P.M.
30	14,22	Parcel #31 Eldred, Added CUL. Re. (P) at Rev. 187+30 Lk. - Rev. 187+30 Lk. Added CUL. Re. (P) at Rev. 187+00 Lk. - 187+07 Lk. Changed ending Sta. to read Rev. 187+36 and running distance from 860' to 867'. Per C.O. # 5253	3-22-82	NWJ	T.P.M.
31	14,22	Parcel #30 DeMassi, Changed name spelling from DEMASSI to DeMASSI. Per C.O. # 5272	3-22-82	NWJ	T.P.M.
32	9	Parcel #22 Brown, Changed total take from 0.03 A± to 0.19 A±. Per C.O. # 5273	3-22-82	NWJ	T.P.M.
33	22	Parcel #32 Cove, Added "Save" to 24" Ash tree at Rev. 181+50 Re. Per C.O. # 5274	3-22-82	NWJ	T.P.M.
34	9	Parcel #22 Brown, Changed D.T. & Dr. (P) at Rev. 189+55 Re. to CUL, DIT., & Dr. (P). Per C.O. # 5277	3-22-82	NWJ	T.P.M.
35	9	Parcel #17 Dana Corp., Changed title taken from WD to WDOG. Per C.O. # 5279	3-22-82	NWJ	T.P.M.
36	20	Parcel #22 Brown, Changed 6" tree at Rev. 152+20 68' Re. from Ash to Butternut and added "Save" Per C.O. # 5281	3-22-82	NWJ	T.P.M.
37	9,20	Parcel #22 Brown, Added CUL. Re. (P) at Rev. 143+87 - Rev. 143+77 Re. Added Dr. Re. (P) at Rev. 143+77 Re. Per C.O. # 5215	3-22-82	NWJ	T.P.M.
38	10	Parcel #25 Janeway, Added Right to Install new waterline at Rev. 161+05 - Rev. 162+05 Lk. Per C.O. # 5290	3-22-82	NWJ	T.P.M.

MADE BY: WBB DATE: 12-17-81
CHECKED BY: RLS DATE: 12-18-81

DR. RT. - DRAINAGE RIGHT
DT. RT. - DITCHING RIGHT
CH. RT. - CHANNEL RIGHT
DRIVE RT. - DRIVE RIGHT
CUL. RT. - CULVERT RIGHT
(D) - DEMOLITION OR REMOVAL
(W) - WATER SOURCES

PRESENT R.O.W.
--- TAKING WITHOUT ACCESS
--- TAKING WITHOUT ACCESS ALONG PROPERTY LINES
--- TAKING WITH ACCESS
(P) - PERMANENT EASEMENT
(T) - TEMPORARY EASEMENT

LEGEND
--- CONST. EASE. --- CONST. EASEMENT
--- SR --- SR --- SLOPE RIGHTS
--- P --- P --- PROPERTY LINE
--- Δ --- Δ --- TOP OF CUT
--- O --- O --- TOE OF SLOPE

APPROVED: James P. [Signature] DATE: 12-18-81
CHIEF OF PLANS & TITLES

MAY 28 1985

PROJECT: MONTPELIER
NO. M 6400(8)
SHEET 7 OF 25

STATE OF VERMONT
AGENCY OF TRANSPORTATION
RIGHT-OF-WAY PLANS
DETAIL SHEET

TABLE OF PROJECT PROPERTY ACQUISITION

PARCEL NO.	GRANTOR	SHEET NO.	BEGINNING STATION	ENDING STATION	TAKING	REM.	RIGHTS	TITLE TAKEN	DATE	TOWN OR CITY RECORDED	BK.	PG.	REMARKS
14	JOHNSON, LINDA	19	REV. 140+43 RT. REV. 140+75 RT.	REV. 141+40 RT.			SLOPE (T) 0.03 A± DRIVE (T)	AGREE.					1300 S.F.± 16' GRAVEL
15	GAVIN, JAMES A. & HOLLY R.	19	REV. 141+40 RT. REV. 141+65 RT.	REV. 142+30 RT.			SLOPE (T) 0.02 A± DRIVE (T)	AGREE.					690 S.F.± 12' PAVED
16	ROOD, ROBERT C. & RUTH A.	19	REV. 142+10 RT.				DRIVE (T)	REL.					18' PAVED
17	DANA CORPORATION MORRILL, ARTHUR E. D/B/A ALPINE ESTATES	19, 20	REV. 142+37 LT. REV. 142+37 LT. REV. 142+37 LT. REV. 142+84 LT. REV. 142+97 LT.	REV. 150+10 LT. REV. 150+10 LT. REV. 150+35 LT. REV. 150+42 LT.	0.32 A±		DITCH (P) 0.09 A± SLOPE (P) 1.38 A± CONST. EASE. (T) 0.22 A± DRIVE (T) CULVERT (P)	CAND WOOD		MONTPELIER			3865 S.F.± 20' GRAVEL
18	NICHOLS, CHARLES B., JR. & HELEN A.	19, 20	REV. 144+28 RT.				DRIVE (T)	REL.					20' PAVED

TABLE OF REVISIONS

REVISION NO.	SHEET NO.	DESCRIPTION OF REVISION	DATE	MADE BY	APPROVED BY
39	19, 21	Parcel # 29 Enlarged, Added Cul. Rt. (P) at Rev. 146+38 Rt. - Rev. 146+42 Rt. Added Dr. Rt. (P) at Rev. 146+38 Rt. Added Cul. & Dr. Rt. (P) at Rev. 170+50 Rt. Per C.O. # 5327	3-22-82	NWJ	T.P.M.
40	19, 22	Parcel # 11 WOODBURY ASSOC. & Parcel # 32 COVE ET AL., Added Remove To Trees At Sta. 137+44 Rt., 138+13 Rt. & 181+43 Rt. Per C.O. # 5300	3-26-82	BAM	T.P.M.
41	13	Parcel # 37 BUTTERFIELD, Changed Total Take From 0.11 A± To 0.10 A± Per C.O. # 5305	4-6-82	BAM	T.P.M.
42	11	Parcel # 31 ELDRED, Changed Ditch Rt. (P) Ending Sta. From 182+10 Lt. To 183+32 Lt. & Ditch Rt. (P) Beginning Sta. From 182+40 Lt. To 183+70 Lt. ALL Sta. Revised. Per C.O. # 5312	4-6-82	BAM	T.P.M.
43	19, 20	Parcel # 16, 19 & 20, Added Save To Trees At Sta. 143+05 Rt., 143+27 Rt., 144+70 Rt., 144+86 Rt., 146+53 Rt., 146+88 Rt., 147+50 Rt. And Added Save To R. Mirror At Sta. 147+45 Rt. Per C.O. # 5313	4-6-82	BAM	T.P.M.
44	3, 19, 20	Parcel 17, Deleted The Assoc. Inc. From Title & added Morrill, A.E. Per C.O. # 5326	4-13-82	NWJ	T.P.M.
45	6	Parcel # 10 B, Shire: deleted slope at Sta. Rev. 137+40 Lt. To Sta. Rev. 137+70 Lt., also changed EASE. From 2.85 S.F. To 400 S.F. To agree with lay-out per C.O. # 5346	4-29-82	LRD	T.P.M.
46	18	Parcel # 9 ALPINE, Changed Cherry tree to crab and added crab. Also added save to 3 pines left of Rev. 146+100 Lt. - Rev. 146+155 Lt. Per C.O. # 5341	4-27-82	NWJ	T.P.M.
47	7	Parcel 10 D Shire, Added (P) to slope At: Also changed Const. EASE. (P) area from 0.01 A±, 400 S.F. to 0.01 A±, 600 S.F. Per C.O. # 5342	4-27-82	NWJ	T.P.M.
48	6, 7	Parcel # 10 A & D Shire, On 10 A changed take area from 0.01 A±, 450 S.F. to 0.02 A±, 800 S.F. Also changed slope area from 0.02 A±, 1000 S.F. to 28 S.F. On 10 D changed take total from 0.16 A± to 0.17 A± Per C.O. # 5348	4-27-82	NWJ	T.P.M.
49	18	Parcel # KOENIGSMANN Added "save" to 18' W of station 122+50 Rt. Per C.O. # 5343	5-12-82	Kdp	T.P.M.
50	18	Parcel # 5 HEALY Added "save" to 8' Out of Sta. 123+40 Lt. and 36' Pine at Sta. 124+00 Lt. Per C.O. # 5344	5-12-82	Kdp	T.P.M.

MADE BY: RBB DATE 12-17-81
CHECKED BY: RLS DATE 12-18-81

DR. RT. - DRAINAGE RIGHT
DIT. RT. - DITCHING RIGHT
CH. RT. - CHANNEL RIGHT
DRIVE RT. - DRIVE RIGHT
CUL. RT. - CULVERT RIGHT
⊙ - DEMOLITION OR REMOVAL
W - WATER SOURCES

PRESENT R.O.W.
--- TAKING WITHOUT ACCESS
--- TAKING WITHOUT ACCESS ALONG PROPERTY LINES
--- TAKING WITH ACCESS
(P) PERMANENT EASEMENT
(T) TEMPORARY EASEMENT

LEGEND
--- CONST. EASE. --- CONST. EASEMENT
--- SR --- SLOPE RIGHTS
P --- PROPERTY LINE
--- TOP OF CUT
--- TOE OF SLOPE

APPROVED: [Signature] DATE 12-18-81
CHIEF OF PLANS & TITLES

MAY 28 1985
PROJECT MONTPELIER
NO. M 6400(8)
SHEET 8 OF 25

STATE OF VERMONT
AGENCY OF TRANSPORTATION
RIGHT-OF-WAY PLANS
DETAIL SHEET

TABLE OF PROJECT PROPERTY ACQUISITION

PARCEL NO.	GRANTOR	SHEET NO.	BEGINNING STATION	ENDING STATION	TAKING	REM.	RIGHTS	TITLE TAKEN	DATE	TOWN OR CITY RECORDED	BK.	PG.	REMARKS
19	DUFRESNE, JOHN L. & BEVERLY B.	20	REV. 144+55 RT.				DRIVE (T)	RELEASE					20' PAVED
20	CONE, HAROLD ROY & DOROTHY L.	20	REV. 146+32 RT. REV. 147+27 RT.				DRIVE (T) DRIVE (T)	RELEASE					12' PAVED 16' PAVED
21	BARNES, ROBERT B.	20	REV. 147+86 RT. REV. 148+46 RT.	REV. 148+60 RT.			DRIVE (T) CONST. EASE. (T) (40 S.E.±)	AGREE.					16' PAVED
22 A	BROWN, BURTON P. & PATRICIA M.	20, 21	REV. 150+05 RT. REV. 148+60 RT. REV. 148+60 RT. REV. 148+75 RT. REV. 148+75 RT. REV. 149+95 RT. REV. 133+47 RT. REV. 154+37 RT. REV. 148+87 RT. REV. 148+97 RT. REV. 152+45 RT.	REV. 154+40 RT. REV. 151+92 RT. REV. 154+93 RT. REV. 148+75 RT. REV. 155+00 RT. REV. 154+81 RT. REV. 148+97 RT.	0.08 A±	CONST. EASE. (T) (0.07 A±) SLOPE (T) (0.40 A±) CUL. (P) ✓ DR. (P) ✓ CUL., DIT. & DR. (P) ✓ DRIVE (T) CONST. EASE. (T) (0.03 A±) CUL. (P) ✓ DR. (P) ✓ DRIVE (T)	WOOE 8-11-82	MONTPELIER	173	163-64	3500 S.E.± 3100 S.E.±		
22 B			REV. 155+00 RT. REV. 155+00 RT. REV. 155+40 RT. REV. 157+75 RT. REV. 157+60 RT. REV. 158+04 RT.	REV. 159+18 RT. REV. 159+45 RT. REV. 160+05 RT. REV. 160+00 RT. REV. 158+04 RT.	0.05 A±	SLOPE (T) (0.14 A±) CONST. EASE. (T) (0.14 A±) CUL. (P) ✓ CUL. (P) ✓ DR. (P) ✓						1100 S.E.± (TO REMOVE 8" VCP) 2300 S.E.±	
				TOTAL	0.13 A±								
23	NICHOLSON, PETER A. & ELIZABETH L.	20	REV. 150+65 LT. REV. 150+35 LT. REV. 153+73 LT. REV. 153+55 LT. REV. 155+38 LT.	REV. 151+20 LT. REV. 152+10 LT. REV. 155+62 LT. REV. 155+65 LT. REV. 155+60 LT.			SLOPE (T) (75 S.E.±) CONST. EASE. (T) (0.02 A±) SLOPE (T) (0.07 A±) CONST. EASE. (T) (0.03 A±) CUL. (P) ✓	WOOE 9-10-83	MONTPELIER	173	215-6	850 S.E.± 3050 S.E.± 1500 S.E.±	

TABLE OF REVISIONS

REVISION NO.	SHEET NO.	DESCRIPTION OF REVISION	DATE	MADE BY	APPROVED BY
51	8, 20	Parcel # 22 Brown Eliminate drive rights at stations 152+45 RT. and 155+00 RT. Combine into one drive right to reflect new drive design. Decreased Slope area and changed ending sta. for slope between sta. Rev. 148+60 RT. ~ Rev. 154+93 RT. Added in Remarks column opposite Const. Eas. 0.03 Rev. 154+37 RT. ~ Rev. 154+81 RT. (to Remove 8" V.C.P.) Per C.O. # 5358	5-12-82	Kep	
52	18	PARCELS # 3 & 4 Merrill & Koenenman Added culvert information on layout for culvert at sta. 121+44 L. Per C.O. # 5357	5-13-82	Kep	
53	4, 21, 25	Parcel # 42 DUGUETTE, Revised Drive at Sta. 217+84 RT. Added Drive 1 Drive at Sta. 219+00 RT. ~ 220+00 RT. Reduced Take Area To 0.1182 Revised Slope (T) STA. Rev. 217+85 RT. ~ Rev. 220+00 RT. And Area To 0.1182 Revised Beginning Sta. Of Slope (P) To Rev. 220+00 RT. Revised Beginning STA. CUL. (P) To Rev. 217+58 RT. Added DIT. (P) Rev. 218+00 RT. ~ Rev. 218+15 RT. Per Revised Design C.O. # 5406	6-2-82	B.A.M.	T.R.M.
54	4, 17, 18	Added Parcel # 60 Per C.O. # 5410	6-2-82	B.A.M.	T.R.M.
55	25	Parcel # 51 Fielder - retained cellar drain Per C.O. # 5411	6-7-82	B.A.M.	JOP
56	5, 18	Parcel # 3 Merrill Add cul. (P) at sta. 121+81 LT. & ditch (P) from sta. 121+81 LT. ~ 122+10 LT. Per C.O. # 5435	6-14-82	JOP	T.R.M.
57	11, 22	Parcel # 31 Eldred Added drive (T) & cul. (P) at sta. Rev. 140+70 LT. Per C.O. # 5434	6-14-82	JOP	T.R.M.
58	16, 15	Parcel 540 CITRINI, Revised Drive At MILL RD. 52+00 LT. Moved To MILL RD. 51+30 LT. Per Revised Design C.O. # 5437	6-22-82	B.A.M.	ETH
59	9, 20	Parcel # 22 Brown Added Drive At STA. 152+45 RT. Per C.O. # 5449	6-23-82	B.A.M.	JOP
60	18, 19, 6	Parcel # 7 CITY OF MONT. DELETED REC. DEPT. FROM TITLE & CHANGED TITLE TAKEN TO AGREE. PER C.O. # 5457	6-23-82	B.A.M.	JOP
61	10, 21	Parcel # 26 DONOVAN, Added Trees & EASE TO LANDSCAPE (T) AT STA. Rev. 159+75 RT. ~ 161+60 RT. Per Revised Design & C.O. # 5456	6-24-82	B.A.M.	T.R.M.
62	5, 18	Parcel # 3 Merrill, Added Cul. (P) at sta. 121+44 LT. Per C.O. # 5461	6-28-82	JOP	T.R.M.

MADE BY: N.W.J. DATE: 11-18-81
CHECKED BY: R.L.S. DATE: 11-18-81

DR. RT. - DRAINAGE RIGHT
DIT. RT. - DITCHING RIGHT
CH. RT. - CHANNEL RIGHT
DRIVE RT. - DRIVE RIGHT
CUL. RT. - CULVERT RIGHT
D - DEMOLITION OR REMOVAL
W - WATER SOURCES

PRESENT R.O.W.
--- TAKING WITHOUT ACCESS
--- TAKING WITHOUT ACCESS ALONG PROPERTY LINES
--- TAKING WITH ACCESS
(P) PERMANENT EASEMENT
(T) TEMPORARY EASEMENT

LEGEND
--- CONST. EASE. --- CONST. EASEMENT
SR --- SR --- SLOPE RIGHTS
P --- P --- PROPERTY LINE
--- TOP OF CUT
--- TDE OF SLOPE

APPROVED: _____ DATE: _____
CHIEF OF PLANS & TITLES

MAY 28 1985
PROJECT MONTPELIER
NO. M 6400 (8)
SHEET 9 OF 25

STATE OF VERMONT
AGENCY OF TRANSPORTATION
RIGHT-OF-WAY PLANS
DETAIL SHEET

TABLE OF PROJECT PROPERTY ACQUISITION

PARCEL NO.	GRANTOR	SHEET NO.	BEGINNING STATION	ENDING STATION	TAKING	REM.	RIGHTS	TITLE TAKEN	DATE	TOWN OR CITY RECORDED	BK.	PG.	REMARKS
24	DELETED												FORMERLY CITY OF MONTPELIER
25	JANEWAY, EDWARD JR. & CLAUDE M.	20,21	REV. 160+78 LT. REV. 156+10 LT. REV. 156+13 LT. REV. 160+30 LT. REV. 160+30 LT. REV. 161+05 LT.	REV. 161+77 LT. REV. 158+00 LT. REV. 157+92 LT. REV. 161+77 LT. REV. 161+77 LT. REV. 162+05 LT.	0.01 A±		SLOPE (T) (0.08 A±) CONST. EASE. (T) (0.06 A±) SLOPE (T) (0.04 A±) CONST. EASE. (T) (0.02 A±) RIGHT TO INSTALL	COND WOOL		MONTPELIER			280 S.E± 3450 S.E± 2800 S.E± 1750 S.E± 900 S.E± WATERLINE
26	DONOVAN, RHODA C.	20,21	REV. 157+81 RT. REV. 159+18 RT. REV. 159+65 RT. REV. 160+90 RT. REV. 160+94 LT. REV. 161+40 RT. REV. 161+50 RT. REV. 161+90 RT. REV. 162+92 RT. REV. 159+75 RT.	REV. 160+78 RT. REV. 161+40 RT. REV. 159+76 RT. REV. 159+16 RT. REV. 161+00 RT. REV. 163+40 RT. REV. 161+83 LT. REV. 162+26 RT. REV. 163+97 RT. REV. 161+60 RT.	0.05 A±		SLOPE (T) (0.05 A±) CUL. (P) (50 S.E±) DIT. (P) (50 S.E±) DRIVE (T) (0.15 A±) ALL R.T. & L. SLOPE (P) (0.15 A±) ALL R.T. & L. CUL. (P) (0.02 A±) DR. (P) (0.02 A±) CONST. EASE. (T) (0.02 A±) EASE TO LANDSCAPE (T)	WOOL	11-3-82	MONTPELIER	173	323-24	2050 S.E± 2200 S.E± WATERLINE WATERLINE 930 S.E±
27	FROSTICK, THOMAS & VERONICA	21	REV. 161+77 LT. REV. 161+77 LT. REV. 162+30 LT. REV. 162+70 LT. REV. 162+92 LT. REV. 162+92 LT. REV. 163+15 LT. REV. 162+92 LT.	REV. 163+58 LT. REV. 162+92 LT. REV. 162+30 RT. REV. 163+58 LT. REV. 163+58 LT. REV. 163+58 LT. REV. 163+58 LT. REV. 163+58 LT.	0.02 A±		SLOPE (T) (0.03 A±) ALL R.T. & L. DRIVE (T) (280 S.E±) DIT. (P) (350 S.E±) CUL. (P) (0.05 A±) CONST. EASE. (T) (0.05 A±) SLOPE (P) (0.05 A±)	WOOL	11-12-82	MONTPELIER	173	241-42	820 S.E± 1435 S.E± CELLAR DRAIN 2000 S.E±
28	NIES, ALEXANDER	21	REV. 163+58 LT. REV. 163+58 LT. REV. 163+58 LT. REV. 163+58 LT. REV. 163+91 LT. REV. 164+00 LT. REV. 164+35 LT.	REV. 169+83 RT. REV. 169+62 LT. REV. 169+30 LT. REV. 163+85 LT. REV. 163+02 LT. REV. 163+02 LT. REV. 164+41 LT.	0.44 A±		SLOPE (P) (1.39 A±) CONST. EASE. (T) (0.15 A±) DIT. (P) (1.25 S.E±) DRIVE (T) (0.06 A±) DIT. (P) (0.06 A±) CUL. (P)	COND WOOL		MONTPELIER			2725 S.E

TABLE OF REVISIONS

REVISION NO.	SHEET NO.	DESCRIPTION OF REVISION	DATE	MADE BY	APPROVED BY
63	18	Parcel # 24 Deleted. Changed line to remove all sta. 121+05 RT. 121+05 RT. to free up sta. 121+05 RT. and added stone fill to cul. at sta. 121+05 RT. An. Co. # 5462 & 5463	7-1-82	JAP	J.F.M.
64	21	Parcel # 29A Added a second 3/4" copper waterline inside the 6" sewer at Rev. 172+74 RT. ~ 173+09 LT. Per Co. # 5467	7-13-82	DEM.	
65	5,18	Parcel # 29A Added Ditch RT. (P) RT. STA 121+44 RT. ~ 121+50 RT. Per Co. # 5477	7-19-82	DEM.	
66	5,18	Parcel # 4, Koenemann Added Ditch RT. (P) RT. STA 121+44 RT. ~ 121+50 RT. Per Co. # 5478	7-19-82	DEM.	
67	18	Parcel # 2 DEPIN, Added Remove To 40" Pine Rt. Surv. Sta. 121+25 Rt. Per Revised Design Co. # 5504	8-19-82	B.A.M.	
68	12,22	Corrected Equations on sheets to agree with Design Co. # 5528	8-30-82	S.G.M.	
69	10,21	Parcel # 21, FROSTICK, REVISED SLOPE RIGHTS Per Co. # 5548	9-15-82	DEM.	
70	11,22	Parcel # 31 ELDRED, Deleted Drive i Drive Rt. (T) At Sta. 183+12 LT. Added Drives i Drive Rt. (T) At Sta. 181+35 LT. & Rev. 185+25 LT. Per Revised Design Co. # 5553	9-20-82	B.A.M.	
71	5,18	Parcel # 31 MERRILL, Added Parcel # 3A Per Co. # 6291	10-12-84	B.A.M.	JAP

MADE BY: R.W.J. DATE: 11-18-81
CHECKED BY: R.L.S. DATE: 11-18-81

DR. RT. - DRAINAGE RIGHT
DIT. RT. - DITCHING RIGHT
CH. RT. - CHANNEL RIGHT
DRIVE RT. - DRIVE RIGHT
CUL. RT. - CULVERT RIGHT
(D) - DEMOLITION OR REMOVAL
(W) - WATER SOURCES

PRESENT R.O.W.
TAKING WITHOUT ACCESS
TAKING WITHOUT ACCESS ALONG PROPERTY LINES
TAKING WITH ACCESS
(P) - PERMANENT EASEMENT
(T) - TEMPORARY EASEMENT

LEGEND
CONST. EASE - CONST. EASEMENT
SR - SR - SLOPE RIGHTS
P - P - PROPERTY LINE
A - A - TOP OF CUT
O - O - TOE OF SLOPE

APPROVED: CHIEF OF PLANS & TITLES DATE:

MAY 28 1985

PROJECT MONTPELIER

NO. M 6400 (8)

SHEET 10 OF 25

STATE OF VERMONT
AGENCY OF TRANSPORTATION
RIGHT-OF-WAY PLANS
DETAIL SHEET

TABLE OF PROJECT PROPERTY ACQUISITION

PARCEL NO.	GRANTOR	SHEET NO.	BEGINNING STATION	ENDING STATION	TAKING	REM.	RIGHTS	TITLE TAKEN	DATE	TOWN OR CITY RECORDED	BK.	PG.	REMARKS	
29A	ENMONS, RICHARD A. & JANICE J.	21,22	REV. 164+48 RT. REV. 171+30 RT. REV. 172+60 RT. REV. 166+38 RT. REV. 166+38 RT. REV. 170+50 RT.	REV. 165+62 RT. REV. 173+15 LT. REV. 166+42 RT.	0.07 A±		DRIVE (T) ALL R. T. & L. CUL. (P) DR. (P) CUL. & DR. (P)	COND WOODE		MONTPELIER			2875 S.F. WATERLINE	
29B			REV. 173+00 RT. REV. 173+00 RT. REV. 173+15 RT. REV. 173+62 RT. REV. 173+65 RT. REV. 176+52 RT. REV. 178+71 RT.	REV. 180+56 RT. REV. 180+30 RT. REV. 176+95 RT. REV. 173+66 RT. REV. 173+68 RT. REV. 178+78 RT.	0.15 A±		CONST. EASE. (T) SLOPE (T) CUL. (P) DIT. (P) DR. (P) DRIVE (T) CUL., DIT. & DR. (P)	(0.14 A±) (0.09 A±)					3950 S.F.	
				TOTAL	0.22 A±									
30	DeMASI, P. JOSEPH & THERESA M.	21,22	REV. 169+25 LT. REV. 169+30 LT. REV. 169+58 LT. REV. 169+55 LT. REV. 171+78 LT. REV. 172+00 LT. REV. 172+00 LT. REV. 173+54 LT. REV. 173+57 LT. REV. 176+52 LT. REV. 178+56 LT. REV. 180+02 LT. REV. 180+27 LT.	REV. 180+56 LT. REV. 180+56 LT. REV. 172+00 LT. REV. 171+78 LT. REV. 170+02 LT. REV. 172+21 LT. REV. 180+56 LT. REV. 173+60 LT. REV. 173+60 LT. REV. 178+63 LT. REV. 180+50 LT.	0.36 A±		CONST. EASE. (T) SLOPE (P) DIT. (P) CUL. (P) CUL. (P) SLOPE (T) DRIVE (T) DIT. (P) CUL. (P) DRIVE (T) CUL. (P) CUL. (P) DRIVE (T)	(0.26 A±) (0.17 A±) (0.03 A±)	COND WOODE	MONTPELIER			1150 S.F.	
31	ELDRED, ALVIN R. & ARDYS R.	22	REV. 180+56 LT. REV. 180+56 LT. REV. 180+56 LT. REV. 180+56 LT. REV. 182+35 LT. REV. 183+70 LT. REV. 184+50 LT. REV. 183+00 LT. 183+61 LT. REV. 182+10 RT. REV. 182+70 RT. REV. 187+30 LT. REV. 183+32 LT. REV. 190+70 LT. REV. 190+70 LT. REV. 185+25 LT.	REV. 183+36 LT. 190+97 LT. REV. 184+50 LT. REV. 183+32 LT. 190+90 LT. 190+93 LT. REV. 187+07 LT. REV. 182+23 LT. REV. 182+90 LT. REV. 188+30 LT. REV. 183+70 LT.	0.35 A±		CONST. EASE. (T) SLOPE (T) DIT. (P) DRIVE (T) DIT. (P) SLOPE (P) CUL. (P) CUL. (P) ALL R. T. & L. ALL R. T. & L. CUL. (P) CUL. (P) DRIVE (T) CULVERT (P) DRIVE (T)	(0.26 A±) (0.16 A±) (0.03 A±) (0.08 A±) (1.74 A±)	WOODE	10-26-82	MONTPELIER	173	307-08	1380 S.F. 3600 S.F. WATERLINE WATERLINE

TABLE OF REVISIONS

REVISION NO.	SHEET NO.	DESCRIPTION OF REVISION	DATE	MADE BY	APPROVED BY

MADE BY: N.W.J. DATE 11-19-81
CHECKED BY: R.L.S. DATE 11-19-81

DR. RT. — DRAINAGE RIGHT
DIT. RT. — DITCHING RIGHT
CH. RT. — CHANNEL RIGHT
DRIVE RT. — DRIVE RIGHT
CUL. RT. — CULVERT RIGHT
D — DEMOLITION OR
REMOVAL
W — WATER SOURCES

_____ PRESENT R.O.W.
 --- /// --- TAKING WITHOUT ACCESS
 --- P --- TAKING WITHOUT ACCESS ALONG PROPERTY LINES
 L
 _____ TAKING WITH ACCESS
 (P) PERMANENT EASEMENT
 (T) TEMPORARY EASEMENT

LEGEND

-----CONST. EASE-----	CONST. EASEMENT
-----SR-----SR-----	SLOPE RIGHTS
-----P-----P----- L L	PROPERTY LINE
---△-----△-----△-----	TOP OF CUT
---○-----○-----○-----	TOE OF SLOPE

APPROVED _____ DATE _____
CHIEF OF PLANS & TITLES

MAY 28 1985

PROJECT MONTPELIER

NO. M 6400 (8)

SHEET 11 OF 25

STATE OF VERMONT
AGENCY OF TRANSPORTATION
RIGHT-OF-WAY PLANS
DETAIL SHEET

TABLE OF PROJECT PROPERTY ACQUISITION

PARCEL NO.	GRANTOR	SHEET NO.	BEGINNING STATION	ENDING STATION	TAKING	REM.	RIGHTS	TITLE TAKEN	DATE	TOWN OR CITY RECORDED	BK.	PG.	REMARKS
32 A	GOVE, DENNIS E. & NANCY E. GOVE, DONALD E.	22, 23	REV. 180+56 RT. REV. 181+22 RT. REV. 184+17 RT.	REV. 182+00 RT.	0.01 A±		DRIVE (T) DRIVE (T)	W.D.D.E.	7-22-82	MONTPELIER	173	117, 118	580 S.E±
32 B			REV. 185+40 RT. REV. 185+65 RT. REV. 186+25 RT. REV. 186+88 RT. 191+70 RT. REV. 193+65 RT. REV. 188+45 RT. REV. 188+50 RT.	REV. 193+86 RT. 189+95 RT. REV. 187+60 RT. REV. 186+95 RT. REV. 193+86 RT. REV. 193+86 RT. REV. 188+50 RT.	0.35 A±		CONST. EASE. (T) (0.03 A±) SLOPE (T) (70 S.E±) DIT. (P) CONST. EASE. (T) (0.03 A±) SLOPE (T) (40 S.E±) CUL. (P) DR. (P)					1100 S.E± 1330 S.E±	
				TOTAL	0.36 A±								
33	ELDRÉD, ROBERT A. & CAROL M.	22, 23	190+90 LT. 190+85 LT. 190+92 LT. REV. 194+03 LT.	REV. 193+80 LT. REV. 193+95 LT. 192+55 LT.			DIT. (P) (0.03 A±) SLOPE (T) (0.06 A±) CONST. EASE. (T) (0.03 A±) DRIVE (T)	W.D.D.E.	8-4-82	MONTPELIER	173	153-154	1450 S.E± 2500 S.E± 1400 S.E±
34 A	LUPIN, LEON A. & GRACE L.	23	REV. 193+86 RT. REV. 194+65 RT.	REV. 195+34 RT. REV. 195+34 RT.	0.08 A±	A.T.	ALL R. T. & L.	WD	10-1-82	MONTPELIER	173	285-66	2520 S.E± 200 S.E±
34 B			REV. 193+86 RT.	REV. 195+34 RT.	0.08 A±		ALL R. T. & L.						3625 S.E± ELM STREET
				TOTAL	0.14 A±								
35	BROUSSEAU, FREDERICK L. & PAULINE G.	23	REV. 194+15 LT. REV. 194+24 LT. REV. 194+35 LT. REV. 194+54 LT. REV. 194+55 LT.	REV. 194+81 LT. REV. 194+88 LT. REV. 195+74 LT. REV. 194+61 LT.			SLOPE (T) (0.01 A±) CONST. EASE. (T) (0.01 A±) DRIVE (T) DIT. (P) (130 S.E±) CUL. (P)	COND. W.D.D.E.		MONTPELIER			650 S.E± 650 S.E±

TABLE OF REVISIONS

REVISION NO.	SHEET NO.	DESCRIPTION OF REVISION	DATE	MADE BY	APPROVED BY

MADE BY: NWJ DATE 11-20-81
CHECKED BY: RLS DATE 11-23-81

DR. RT. — DRAINAGE RIGHT
DIT. RT. — DITCHING RIGHT
CH. RT. — CHANNEL RIGHT
DRIVE RT. — DRIVE RIGHT
CUL. RT. — CULVERT RIGHT
⬡ — DEMOLITION OR
REMOVAL
⬢ — WATER SOURCES

-----	PRESENT	R. O. W.
---//---	TAKING WITHOUT ACCESS	
---// P L ---//---	TAKING WITHOUT ACCESS ALONG PROPERTY LINES	
-----	TAKING WITH ACCESS	
(P)	PERMANENT EASEMENT	
(T)	TEMPORARY EASEMENT	

LEGEND

-----CONST. EASE-----	CONST. EASEMENT
-----SR-----SR-----	SLOPE RIGHTS
-----P-----P-----	PROPERTY LINE
-----Δ-----Δ-----Δ-----	TOP OF CUT
-----○-----○-----○-----	TOE OF SLOPE

APPROVED: [Signature] DATE: 10-1-78
CHIEF OF PLANS & TITLES

MAY 27 1985

PROJECT MONTPELIER

NO. M 6400 (8)

SHEET 12 OF 25

STATE OF VERMONT
AGENCY OF TRANSPORTATION
RIGHT-OF-WAY PLANS
DETAIL SHEET

TABLE OF PROJECT PROPERTY ACQUISITION

PARCEL NO.	GRANTOR	SHEET NO.	BEGINNING STATION	ENDING STATION	TAKING	REM.	RIGHTS	TITLE TAKEN	DATE	TOWN OR CITY RECORDED	BK.	PG.	REMARKS
36 A	ROBY, STEPHEN E. & LINDA M.	23	REV. 195+34 RT. REV. 195+34 RT.	REV. 195+58 RT. REV. 195+58 RT.			ALL R. T. & I. ALL R. T. & I.	SLOPE (P)	WOODE	MONTPELIER			100 SF± 25 SF±
36 B			REV. 194+79 LT. REV. 195+10 LT.	REV. 195+55 LT. REV. 195+55 LT.			SLOPE (T) DRIVE (T)	(0.01 A±)					445 SF±
37 A	BUTTERFIELD, DAVID & CAROL M.	23	REV. 195+58 RT. REV. 195+85 RT.	REV. 199+60 RT. REV. 199+60 RT.	0.09 A±		ALL R. T. & I. ALL R. T. & I.	SLOPE (P)	WOODE	9-9-82 MONTPELIER	173	211-2	4000 SF± 300 SF±
37 B			REV. 196+50 LT. REV. 195+55 LT. REV. 197+48 LT. REV. 198+35 LT. REV. 199+40 LT.	REV. 199+60 LT. REV. 199+30 LT. REV. 199+60 LT. TOTAL	0.01 A± 0.10 A±		SLOPE (T) DRIVE (T) DIT. (P) CUL. (P)	(0.03 A±) (260 SF±)					450 SF± 1150 SF±
38 A	DELETED												FORMERLY HESS, R.N. & J.W.
38 B													
39 A	COTA, D. EILEEN	23	REV. 200+89 RT. REV. 200+89 RT.	REV. 203+04 RT. REV. 203+03 RT.			SLOPE (T) CONST. EASE (T)	(0.07 A±) (0.06 A±)	AGREE.				3180 SF± 2640 SF±
39 B			REV. 201+90 LT. REV. 203+22 LT. REV. 201+20 LT. REV. 203+14 LT. REV. 203+32 LT.	REV. 203+65 LT. REV. 203+67 LT.			SLOPE (T) DRIVE (T)	(0.01 A±)					560 SF± PINED CEDAR RAIL FENCE CEDAR RAIL FENCE CEDAR RAIL FENCE

TABLE OF REVISIONS

REVISION NO.	SHEET NO.	DESCRIPTION OF REVISION	DATE	MADE BY	APPROVED BY

MADE BY: N.W.J. DATE 11-20-81
CHECKED BY: R.L.S. DATE 11-23-81

DR. RT. — DRAINAGE RIGHT
DIT. RT. — DITCHING RIGHT
CH. RT. — CHANNEL RIGHT
DRIVE RT. — DRIVE RIGHT
CUL. RT. — CULVERT RIGHT
D — DEMOLITION OR
REMOVAL
W — WATER SOURCES

-----	PRESENT	R.O.W.
---/---/---	TAKING	WITHOUT ACCESS
---/---/---	P L	TAKING WITHOUT ACCESS ALONG PROPERTY LINES
-----	TAKING	WITH ACCESS
{P}	PERMANENT	EASEMENT
{T}	TEMPORARY	EASEMENT

LEGEND

-----CONST. EASE-----	CONST. EASEMENT
-----SR-----SR-----	SLOPE RIGHTS
-----P-----P-----	PROPERTY LINE
-----Δ-----Δ-----Δ-----	TOP OF CUT
-----○-----○-----○-----	TOE OF SLOPE

APPROVED _____ DATE _____
CHIEF OF PLANS & TITLES

MAY 27 1985

PROJECT MONTPELIER
NO. M 6400 (8)
SHEET 13 OF 13

STATE OF VERMONT
AGENCY OF TRANSPORTATION
RIGHT-OF-WAY PLANS
DETAIL SHEET

TABLE OF PROJECT PROPERTY ACQUISITION

PARCEL NO.	GRANTOR	SHEET NO.	BEGINNING STATION	ENDING STATION	TAKING	REM.	RIGHTS	TITLE TAKEN	DATE	TOWN OR CITY RECORDED	BLK.	PG.	REMARKS
40 A	DASHNER, EDITH V.	23,24	REV. 204+00 RT. REV. 203+55 RT. REV. 203+55 RT. REV. 204+08 RT. REV. 204+50 RT. REV. 204+72 RT. REV. 208+30 RT.	REV. 208+56 RT. REV. 208+30 RT. REV. 203+77 LT. REV. 208+30 RT. REV. 208+76 RT.	0.09 A±		SLOPE (T) ALL R. T. & I. DRIVE (T) CONST. EASE (T) CUL. & DIT. (P) CH. (P)	(0.07 A±) (0.09 A±) (0.03 A±)	WDOE 7-8-82	MONTPELIER	173	93-4	3300 S.E± 3100 S.E± SEWER LINE PAVED 3950 S.E± 1250 S.E±
40 B			REV. 203+65 LT. REV. 203+81 LT. REV. 204+80 LT.	REV. 203+75 LT. REV. 204+73 LT.			SLOPE (T) DRIVE (T) RIGHT TO INSTALL (T)	(90 S.E±)					PAVED FLAP VALVE TO CELLAR DRAIN
41	BURZYCHI, STANLEY J. & DONNA L.	23,24	REV. 206+38 LT. REV. 207+48 LT. REV. 208+15 LT. REV. 208+30 LT.	REV. 208+55 LT. REV. 202+58 LT.			DRIVE (T) DRIVE (T) CONST. EASE (T) CH. (P)	(0.02 A±) (0.02 A±)	WDOE	MONTPELIER	173	173-74	PAVED PAVED 975 S.E± 760 S.E±
42 A	DUQUETTE, IDA E	24,25	REV. 208+54 RT. REV. 215+34 RT. REV. 216+23 RT. REV. 209+20 RT.	REV. 215+50 RT. REV. 215+90 RT. REV. 212+80 RT.	0.72 A±		SLOPE (T) DRIVE (T) ALL R. T. & I.	(300 S.E±) SLOPE (P)	WDOE 10/18/82	MONTPELIER	173	295-98	2500 S.E±
42 B			REV. 217+00 RT. REV. 217+85 RT. REV. 217+84 RT. REV. 220+00 RT. REV. 220+35 RT. REV. 222+96 RT. REV. 217+58 RT. REV. 218+00 RT. REV. 218+00 RT. REV. 218+00 RT.	REV. 226+46 RT. REV. 220+00 RT. REV. 226+46 RT. REV. 226+46 RT. REV. 218+00 RT. REV. 218+35 RT. REV. 218+15 RT. REV. 220+00 RT.	0.11 A±		SLOPE (T) DRIVE (T) SLOPE (P) CONST. EASE (T) DR. (P) CUL. (P) DR. (P) DIT. (P) DRIVE (T)	(0.11 A±) (0.11 A±) (0.14 A±)					
42C			REV. 226+90 RT. TOTAL	REV. 227+34 RT. TOTAL	0.06 A± 0.89 A±		ALL R. T. & I.						2825 S.E±

7 acquired as easement taking

TABLE OF REVISIONS

REVISION NO.	SHEET NO.	DESCRIPTION OF REVISION	DATE	MADE BY	APPROVED BY

MADE BY: NWJ DATE 11-24-81
CHECKED BY: RLS DATE 11-24-81

DR. RT. — DRAINAGE RIGHT
DIT. RT. — DITCHING RIGHT
CH. RT. — CHANNEL RIGHT
DRIVE RT. — DRIVE RIGHT
CUL. RT. — CULVERT RIGHT
D — DEMOLITION OR
REMOVAL
W — WATER SOURCES

-----	PRESENT R.O.W.
---//---	TAKING WITHOUT ACCESS
---// P L---	TAKING WITHOUT ACCESS ALONG PROPERTY LINES
-----	TAKING WITH ACCESS
(P)	PERMANENT EASEMENT
(T)	TEMPORARY EASEMENT

LEGEND

-----	CONST. EASE	-----	CONST. EASEMENT
-----SR-----	SR	-----	SLOPE RIGHTS
-----P _L -----	P _L	-----	PROPERTY LINE
-----Δ-----	Δ	-----	TOP OF CUT
-----○-----	○	-----	TOE OF SLOPE

APPROVED [Signature] DATE 11-18-62
CHIEF OF PLANS & TITLES

MAY 27 1985

PROJECT MONTPELIER

NO. M 6400 (8)

SHEET 14 OF 25

STATE OF VERMONT
AGENCY OF TRANSPORTATION
RIGHT-OF-WAY PLANS
DETAIL SHEET

TABLE OF PROJECT PROPERTY ACQUISITION

PARCEL NO.	GRANTOR	SHEET NO.	BEGINNING STATION	ENDING STATION	TAKING	REM.	RIGHTS	TITLE TAKEN	DATE	TOWN OR CITY RECORDED	BK.	PG.	REMARKS	
43	ALEXANDER, ROBERT C. ALEXANDER, ALBERT A. ALEXANDER, ALLEN B. CAMPBELL, ALICE E. BUSHEY, ROBERTA L.	24	REV. 208+52 LT. REV. 208+54 LT. REV. 209+10 LT.	REV. 210+40 LT. REV. 208+97 LT. REV. 210+00 LT.			CONST. EASE. (T) 0.05 A± CHANNEL (P) 0.02 A± SLOPE (T) 0.02 A±	COND WDOE		MONTPELIER			2355 S.F.± 700 S.F.± 900 S.F.±	
44	PERRY, CHRISTINE BROWN	21-25	REV. 161+00RT	WILL RD. 52+00RT			ALL R.T. & I.		QCD	7-29-82	MONTPELIER	160	478-480	FLOWAGE RTS. IN NORTH BRANCH RIVER
45	MERCHANT, MICHAEL A. & CAROL V.	24	REV. 211+38 LT.	REV. 212+40 LT.			SLOPE (T) 0.02 A±	AGREE.					735 S.F.±	
46	RELATION, LESLIE A. & DOROTHY M.	24	REV. 212+40 LT.	REV. 213+33 LT.			SLOPE (T) 300 S.F.±	AGREE.						
47	MCDONALD, ROBERT W. & LYNN B.	24	REV. 214+72 LT. REV. 213+33 LT. REV. 214+47 LT. REV. 214+60 LT. REV. 214+60 LT. REV. 214+70 LT. REV. 214+72 LT.	REV. 216+47 LT. REV. 214+35 LT. REV. 216+45 LT. REV. 216+20 LT. REV. 216+45 LT.	0.03 A±		SLOPE (T) 300 S.F.± DRIVE (T). SLOPE (P) 0.34 A± CONST. EASE. (T) 0.04 A± CUL. (P) DIT. (P) 0.02 A±	WDOE	8-12-82	MONTPELIER	173	171-72	1100 S.F.± PAVED 1600 S.F.± 865 S.F.±	
48	WEARS, STEPHEN A. & CHRISTINE GOSS	24	REV. 216+45 LT. REV. 216+14 LT. REV. 216+18 LT. REV. 216+45 LT. REV. 219+28 LT. REV. 219+50 LT.	REV. 219+79 LT. REV. 219+88 LT. REV. 219+85 LT. REV. 219+81 LT. REV. 219+72 LT.	0.04 A±		CONST. EASE. (T) 0.08 A± SLOPE (P) 0.56 A± DIT. (P) 0.04 A± CUL. (P) DRIVE (T)	WDOE	8-11-82	MONTPELIER	173	165-66	1950 S.F.± 3700 S.F.± 1680 S.F.±	
49	GOSS, ARTHUR J. & JANIS P.	24, 25	REV. 219+79 LT. REV. 219+85 LT. REV. 222+50 LT. REV. 222+96 LT. REV. 223+52 LT. REV. 219+81 LT.	REV. 221+45 LT. REV. 223+50 LT. REV. 223+50 LT. REV. 221+40 LT.			SLOPE (T) 0.03 A± CONST. EASE. (T) 0.07 A± SLOPE (T) 200 S.F.± CUL. (P) ✓ DRIVE (T) DIT. (P) ✓ 0.02 A±	WDOE	7-28-82	MONTPELIER	173	131, 132	1285 S.F.± 3200 S.F.± PAVED 795 S.F.±	

TABLE OF REVISIONS

REVISION NO.	SHEET NO.	DESCRIPTION OF REVISION	DATE	MADE BY	APPROVED BY

MADE BY: J. PATERSON DATE NOV. 23, 1981

CHECKED BY: R. STANCLIFF DATE NOV. 23, 1981

DR. RT. — DRAINAGE RIGHT
DIT. RT. — DITCHING RIGHT
CH. RT. — CHANNEL RIGHT
DRIVE RT. — DRIVE RIGHT
CUL. RT. — CULVERT RIGHT
D — DEMOLITION OR
REMOVAL
W — WATER SOURCES

-----	PRESENT	R.O.W.
---//---//---	TAKING WITHOUT ACCESS	
---// P L---//---	TAKING WITHOUT ACCESS ALONG PROPERTY LINES	
-----	TAKING WITH ACCESS	
(P)	PERMANENT EASEMENT	
(T)	TEMPERARY EASEMENT	

LEGEND

-----CONST EASE-----	CONST EASEMENT
-----SR-----SR-----	SLOPE RIGHTS
-----P-----P-----	PROPERTY LINE
-----△-----△-----△-----	TOP OF CUT
-----○-----○-----○-----	TOE OF SLOPE

APPROVED Thomas C. Mayo DATE 12-18-8
CHIEF OF PLANS & TITLES

MAY 27 1985

PROJECT MONTPELIER
NO. M 6400 (8)
SHEET (15) OF 16

STATE OF VERMONT
AGENCY OF TRANSPORTATION
RIGHT-OF-WAY PLANS
DETAIL SHEET

TABLE OF PROJECT PROPERTY ACQUISITION

PARCEL NO.	GRANTOR	SHEET NO.	BEGINNING STATION	ENDING STATION	TAKING	REM.	RIGHTS	TITLE TAKEN	DATE	TOWN OR CITY RECORDED	BK.	PG.	REMARKS
50	CHOINARD, ADELARD A. & DORINA	25	REV 226+90 RT.	REV 227+34 RT.	0.06 A±			WDOE.	1-28-84	MONTPELIER	179	413-14	2625 S.F.±
51A	FIELDER, FLOYD R. & ALBERTA W.	25	REV 227+18 RT. REV 228+30 RT.	REV 228+48 RT. REV 228+46 RT.	0.12 A±		ALL R.T. & L. SLOPE (P) DRIVE (T) ALL R.T. & L.	COND WDOE		MONTPELIER			32 S.F.± WATERLINE
52A	JANGRAW, JOHN J. & BETTE E.	25	REV 228+46 RT. REV 228+46 RT. REV 228+55 LT. REV 228+70 LT.	REV 229+10 RT. REV 229+07 RT.	0.01 A±		ALL R.T. & L. ALL R.T. & L. SLOPE (P) DRIVE (T) CUL. (P)	WDOE	8-3-82	MONTPELIER	173	137-38	600 S.F.± 300 S.F.± PAVED
53A	MAGOON, WENDELL A. & LILLIAN W.	25	REV 229+07 RT. REV 229+07 RT. REV 229+14 LT. REV 229+25 LT. REV 229+40 LT. REV 230+00 LT. REV 230+57 LT. REV 230+62 LT.	REV 230+67 RT. REV 230+62 RT. REV 230+87 LT. REV 231+56 LT. REV 230+82 LT. REV 230+94 LT. TOTAL	0.03 A± 0.02 A± 0.05 A±		ALL R.T. & L. ALL R.T. & L. SLOPE (P) SLOPE (T) DRIVE (T) DRIVE (T) CUL. (P) DIT. (P)	COND WDOE		MONTPELIER			1500 S.F.± 750 S.F.± 700 S.F.± 2300 S.F.±
54A	CITRINI, NELLIE	25	REV 230+62 RT.	MILL RD. 52+00 RT.	0.18 A±		ALL R.T. & L.	WDOE	7-20-82	MONTPELIER	173	113-114	3180 S.F.± WATERLINE
			REV 233+53 RT. REV 235+15 RT. MILL RD. 51+50 LT. REV 235+05 RT.	REV 234+41 RT. REV 235+72 RT. REV 235+40 RT. TOTAL	0.07 A± 0.25 A±		SLOPE (T) DRIVE (T) ALL R.T. & L.						

TABLE OF REVISIONS

REVISION NO.	SHEET NO.	DESCRIPTION OF REVISION	DATE	MADE BY	APPROV BY

MADE BY: J. PATERSON DATE NOV. 23, 1981
CHECKED BY: R. STANCLIFF DATE NOV. 23, 1981

DR. RT — DRAINAGE RIGHT
DIT. RT — DITCHING RIGHT
CH. RT — CHANNEL RIGHT
DRIVE RT — DRIVE RIGHT
CUL. RT — CULVERT RIGHT
⬡ — DEMOLITION OR
REMOVAL
W — WATER SOURCES

-----	PRESENT R.O.W.
/// -- ///	TAKING WITHOUT ACCESS
/// ^P _L ///	TAKING WITHOUT ACCESS ALONG PROPERTY LINES
-----	TAKING WITH ACCESS
(P)	PERMANENT EASEMENT
(T)	TEMPORARY EASEMENT

LEGEND

-----CONST. EASE-----	CONST. EASEMENT
-----SR-----SR-----	SLOPE RIGHTS
-----P-----P-----	PROPERTY LINE
-----△-----△-----△-----	TOP OF CUT
-----○-----○-----○-----	TOE OF SLOPE

APPROVED Thomas P. Meyer DATE 12-18-81
CHIEF OF PLANS & TILES

MAY 27 1985

PROJECT MONTPELIER

NO. M 6400 (8)

SHEET (16) OF 25

STATE OF VERMONT
AGENCY OF TRANSPORTATION
RIGHT-OF-WAY PLANS
DETAIL SHEET

TABLE OF PROJECT PROPERTY ACQUISITION

PARCEL NO.	GRANTOR	SHEET NO.	BEGINNING STATION	ENDING STATION	TAKING	REM.	RIGHTS	TITLE TAKEN	DATE	TOWN OR CITY RECORDED	BK.	PG.	REMARKS
55A	LAQUE, INC.	19	REV. 137+40 LT.	REV. 137+90 LT.			ALL R, T & I	WDOE	9-7-82	MONTPELIER	173	209-10	50' R.O.W.
55B			REV. 141+87 LT.	REV. 142+37 LT.			ALL R, T & I						50' R.O.W.
56	NEW ENGLAND TELEPHONE & TELEGRAPH CO.												UTILITY
57	MONTPELIER CABLE T.V., INC.												UTILITY
58	GREEN MOUNTAIN POWER CORP.												UTILITY
59	CITY OF MONTPELIER PUBLIC WORKS DEPT.												UTILITY
60	SHUJ, KAIJU - LESSOR WOODBURY ASSOCIATES - LESSEE	19	REV. 137+00 LT. REV. 137+00 LT. REV. 137+00 LT. REV. 137+00 LT.	REV. 138+50 LT. REV. 137+40 LT. REV. 138+50 LT. REV. 138+50 LT.	0.03 Ac		CULVERT (P) SLOPE (T) CONST. EASE (T)	OPTION (300 S.F.) (0.03 Ac)	9-9-82	MONTPELIER	176	11-13	(1350 S.F.) (1500 S.F.)

TABLE OF REVISIONS

REVISION NO.	SHEET NO.	DESCRIPTION OF REVISION	DATE	MADE BY	APPROVED BY

MADE BY: NBB DATE 12-17-81
CHECKED BY: RLS DATE 12-18-81

DR. RT. — DRAINAGE RIGHT
DIT. RT. — DITCHING RIGHT
CH. RT. — CHANNEL RIGHT
DRIVE RT. — DRIVE RIGHT
CUL. RT. — CULVERT RIGHT
⬡ — DEMOLITION OR
REMOVAL
⬢ — WATER SOURCES

-----	PRESENT	R.O.W.
---/---/---	TAKING WITHOUT ACCESS	
---/---/---	TAKING WITHOUT ACCESS ALONG PROPERTY LINES	
-----	TAKING WITH ACCESS	
(P)	PERMANENT EASEMENT	
(T)	TEMPORARY EASEMENT	

LEGEND

---	CONST. EASE	---	CONST. EASEMENT
---	SR	---	SLOPE RIGHTS
---	P	---	PROPERTY LINE
---	Δ	---	TOP OF CUT
---	○	---	TOE OF SLOPE


APPROVED Thomas J. Moore DATE 12-18-81
CHIEF OF PLANS & MAPS

MAY 27 1985

PROJECT MONTPELIER
NO. M 6400 (8)
SHEET (17) OF 21


PLAN	DATE	BY	CHKD	APP'D
NOTE BOOK				
No.				


PROFILE	DATE	BY	CHKD	APP'D
NOTE BOOK				
No.				

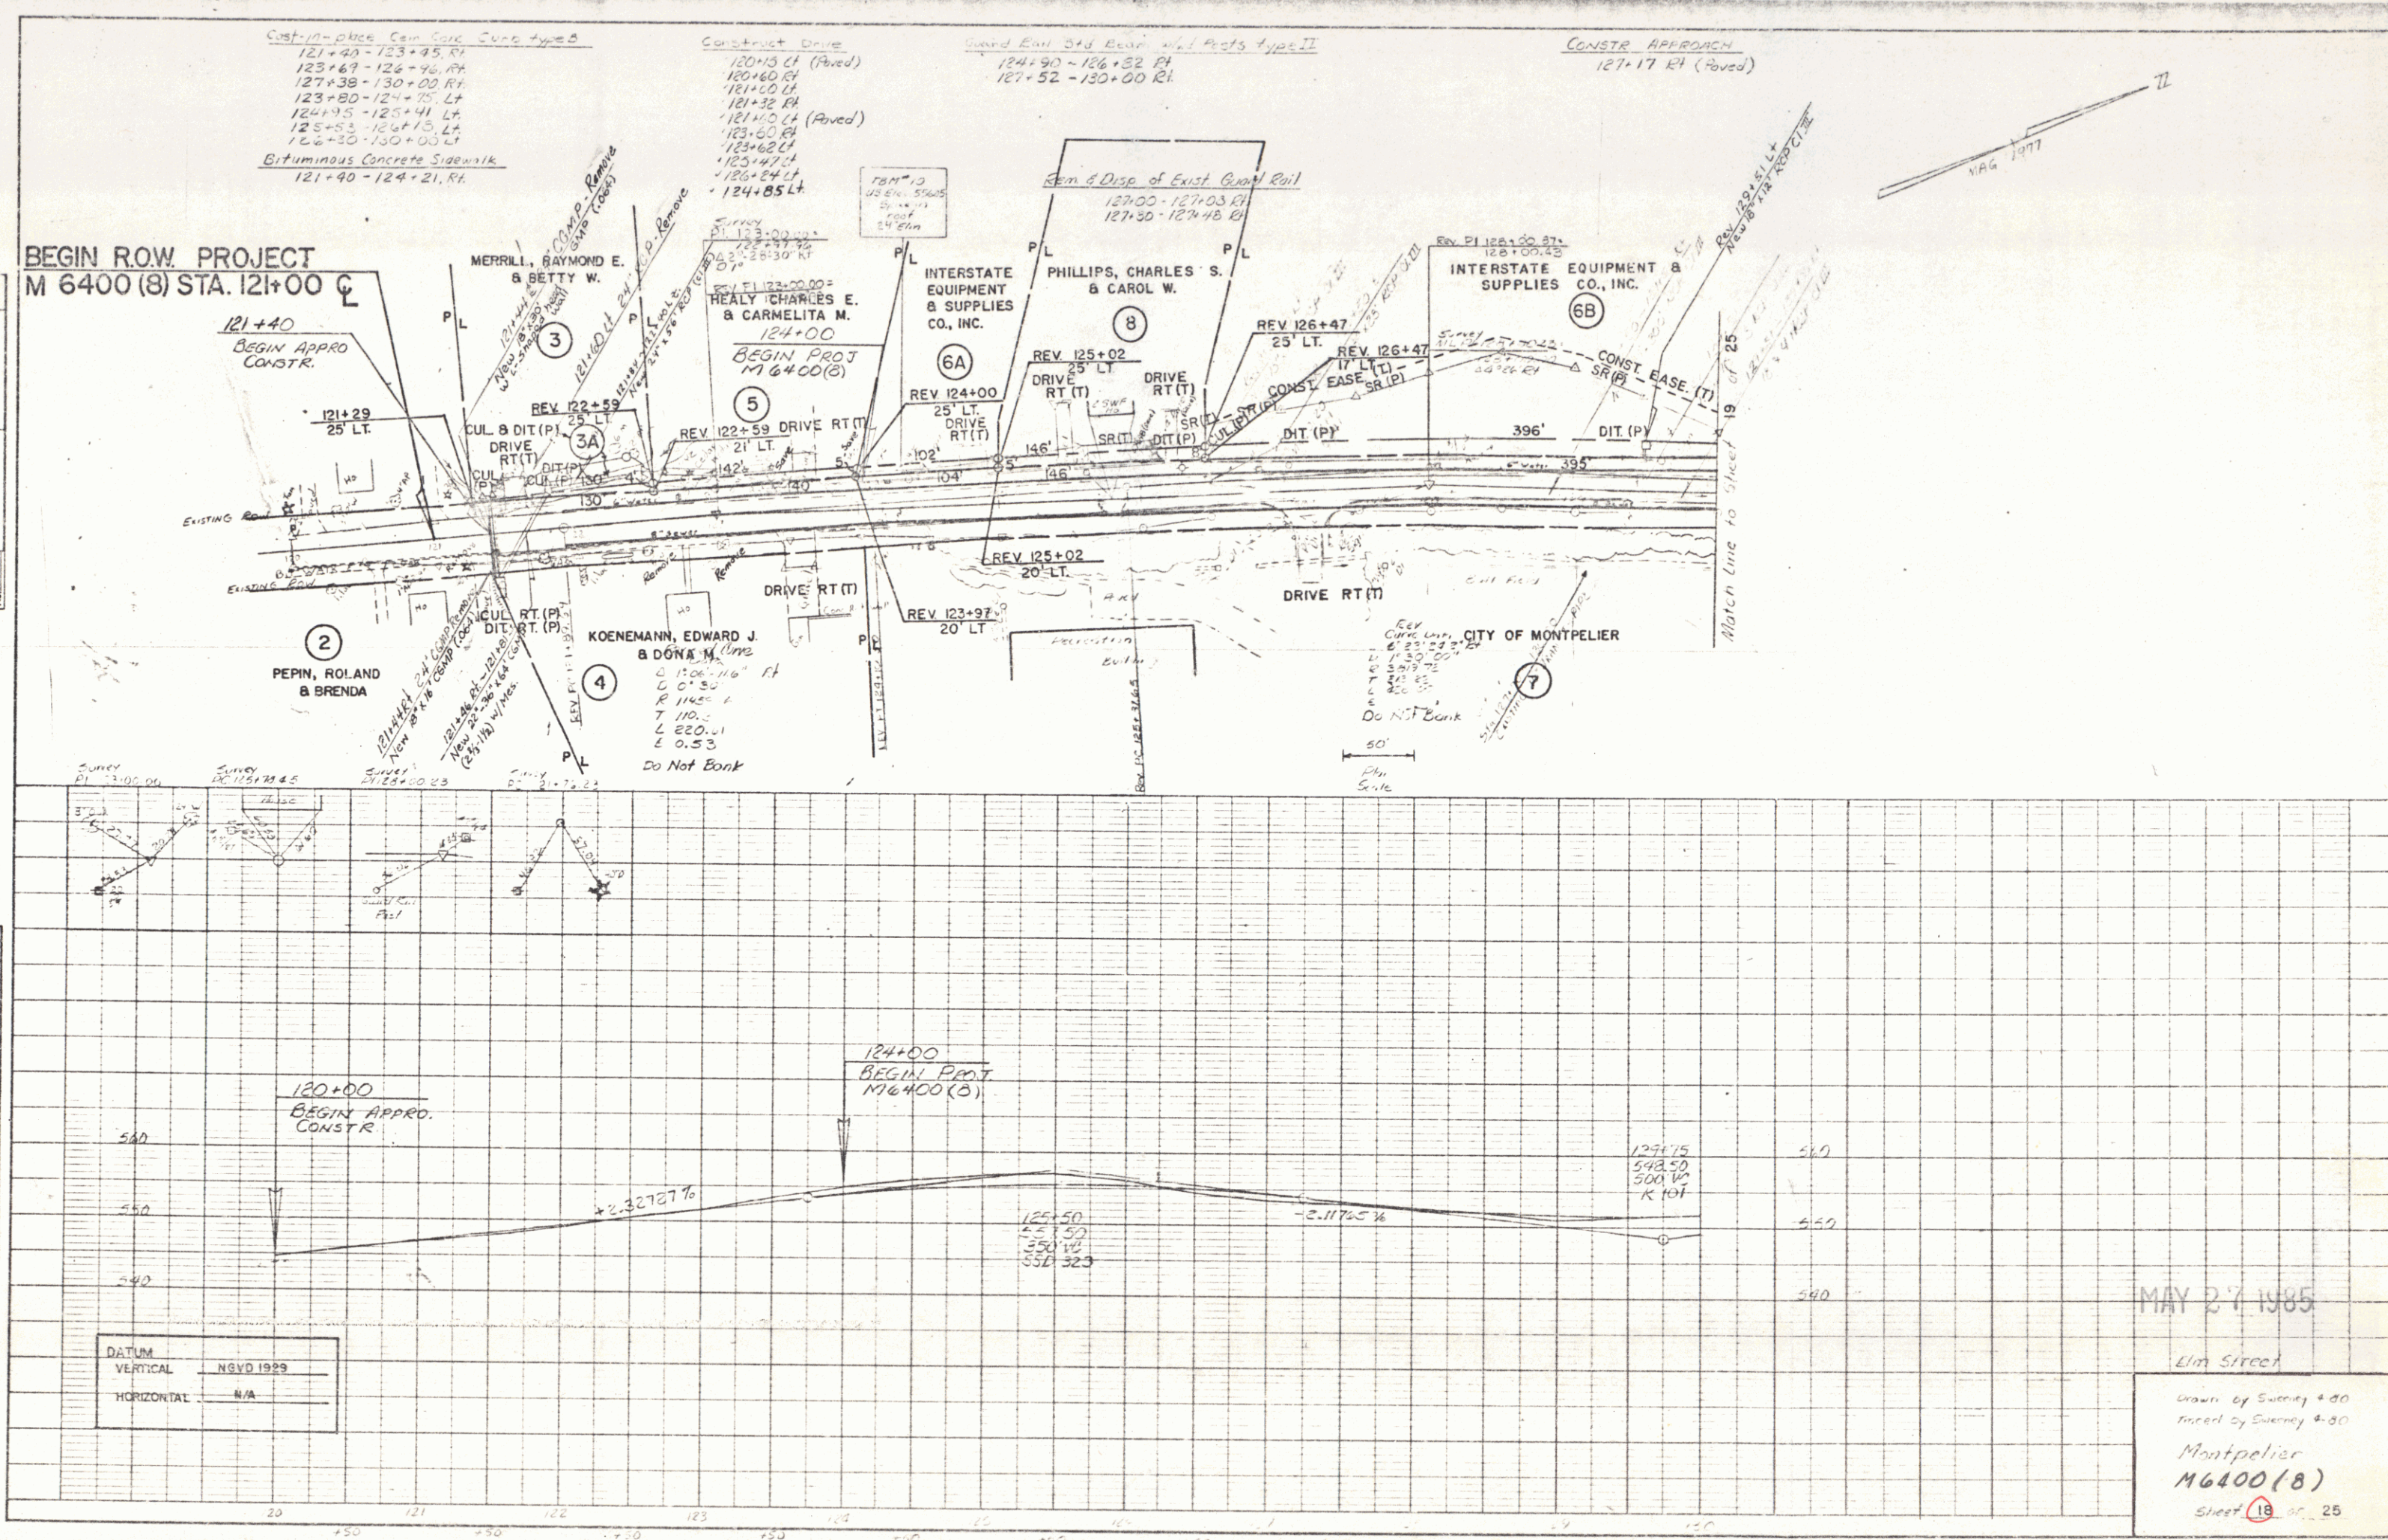

PLAN	DATE	BY	CHKD
1			
2			
PROFILE	DATE	BY	CHKD
1			
2			
3			
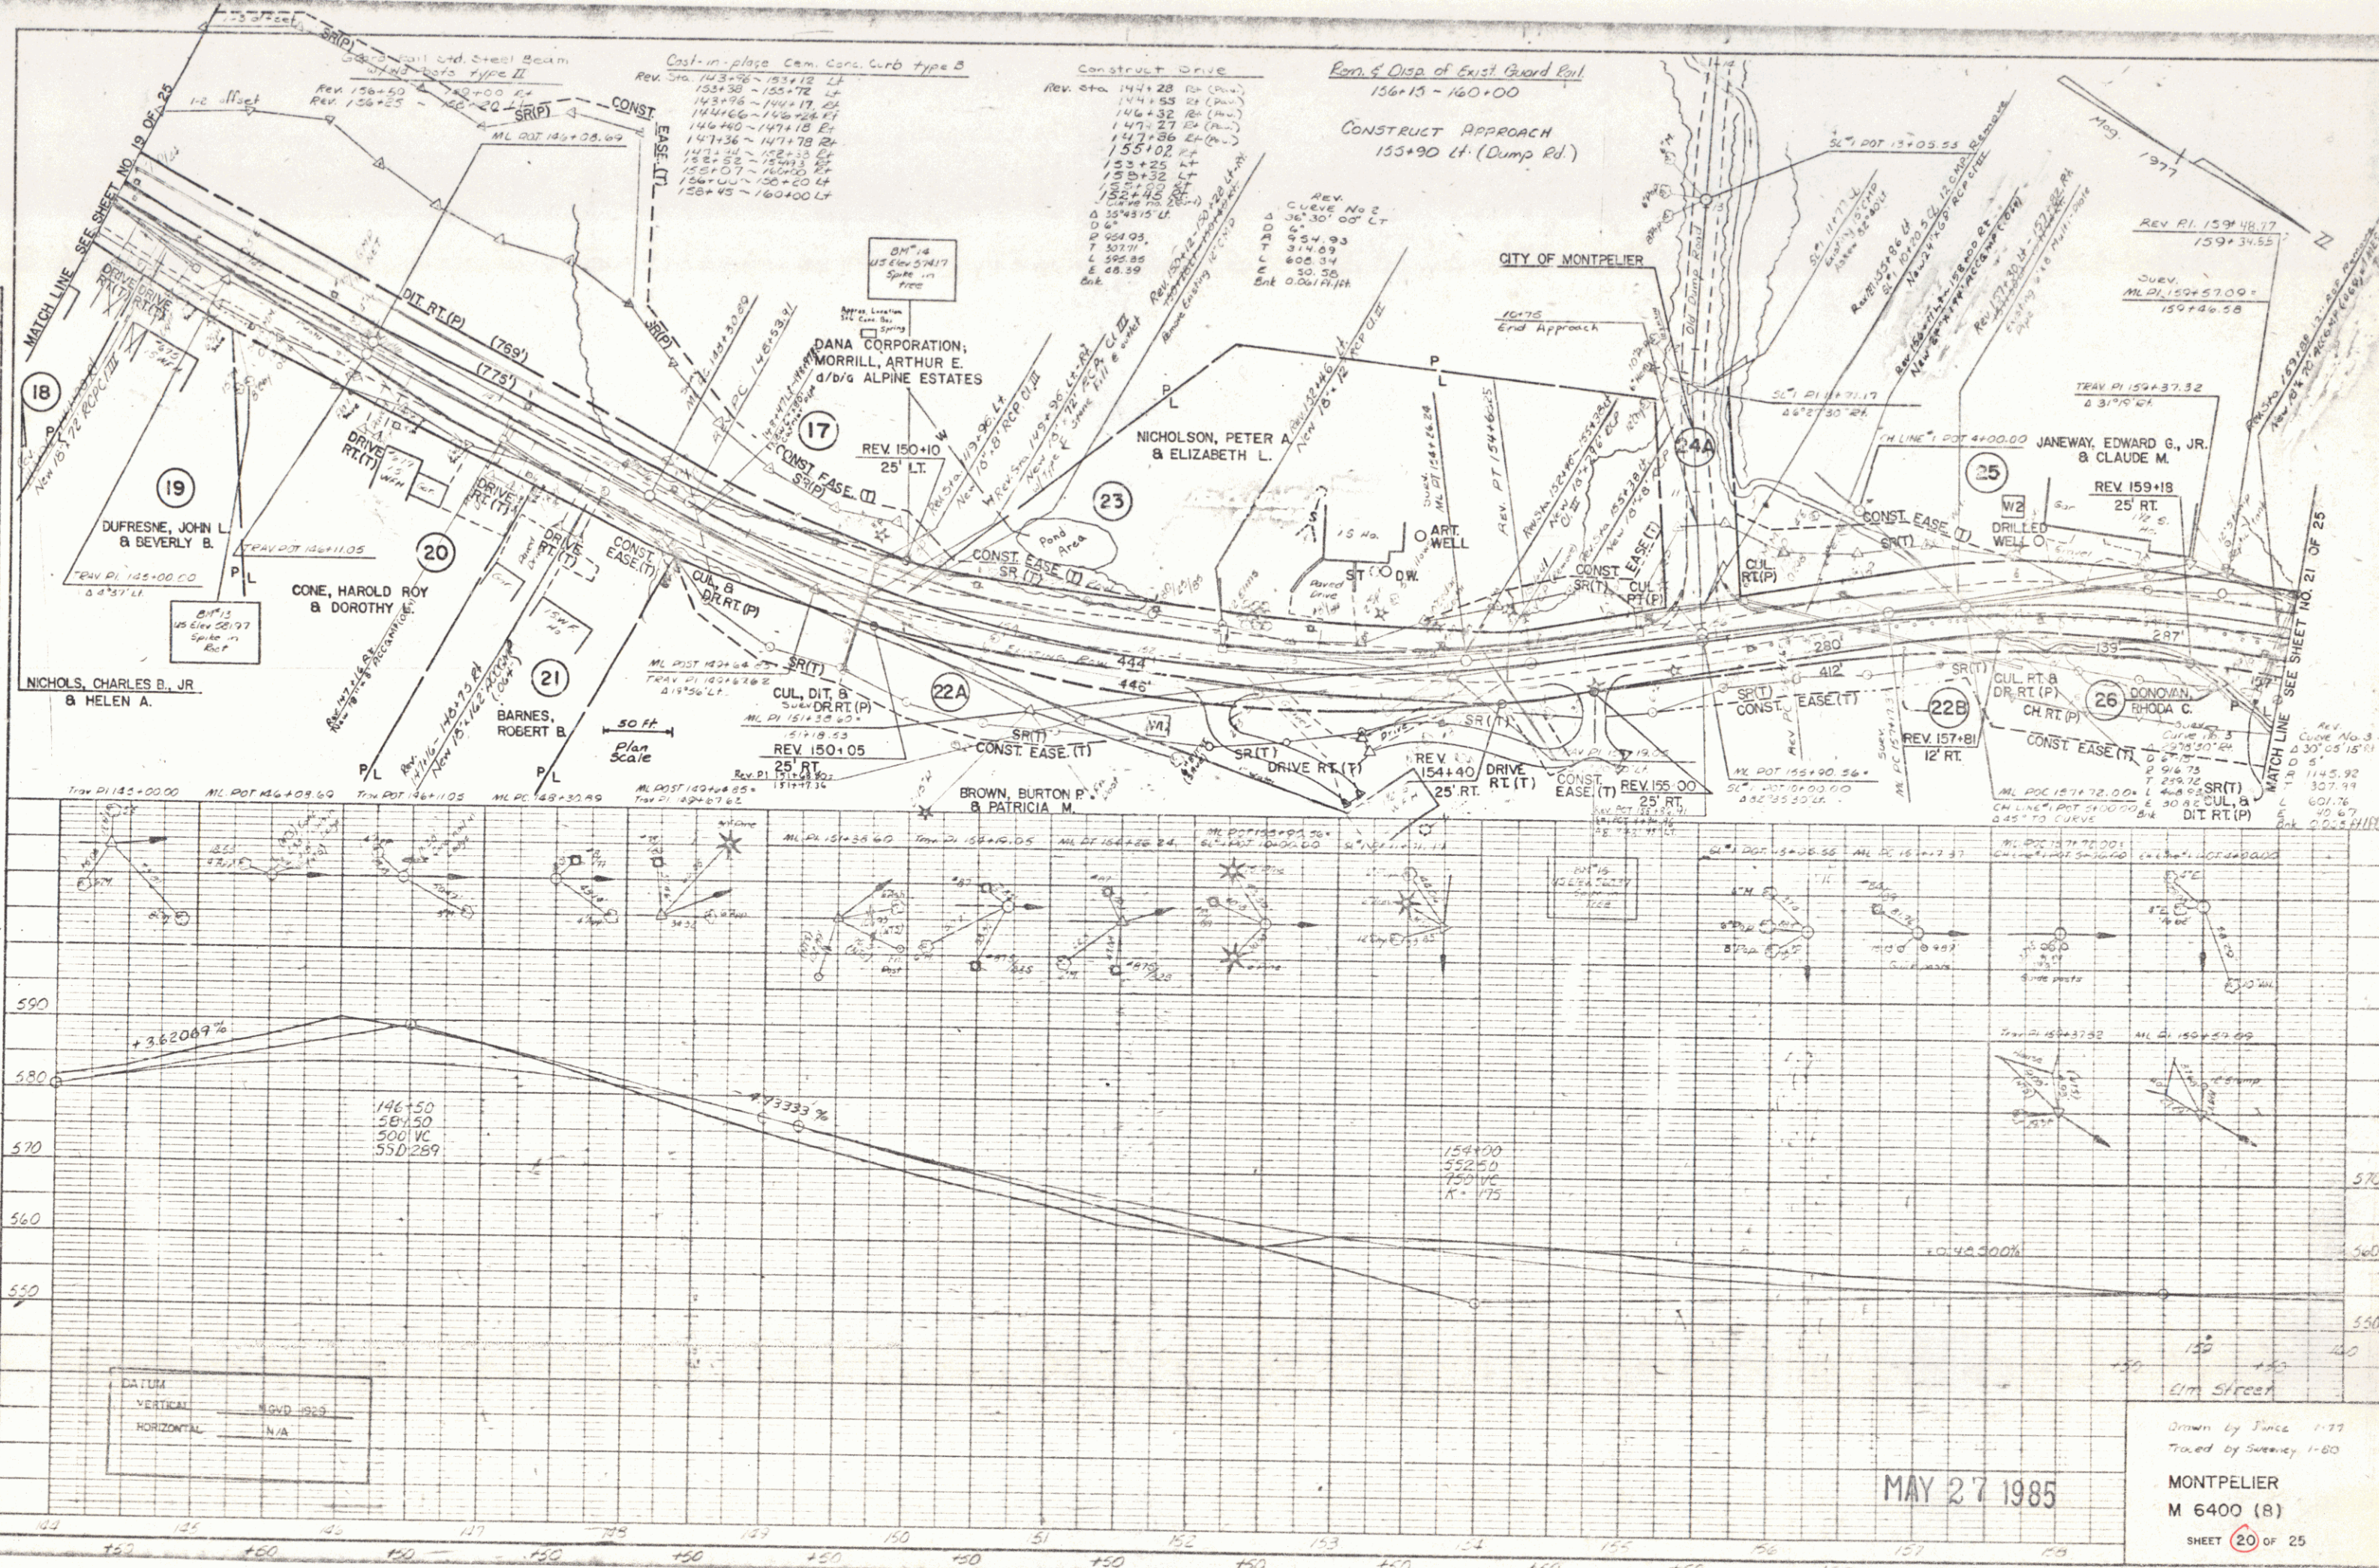

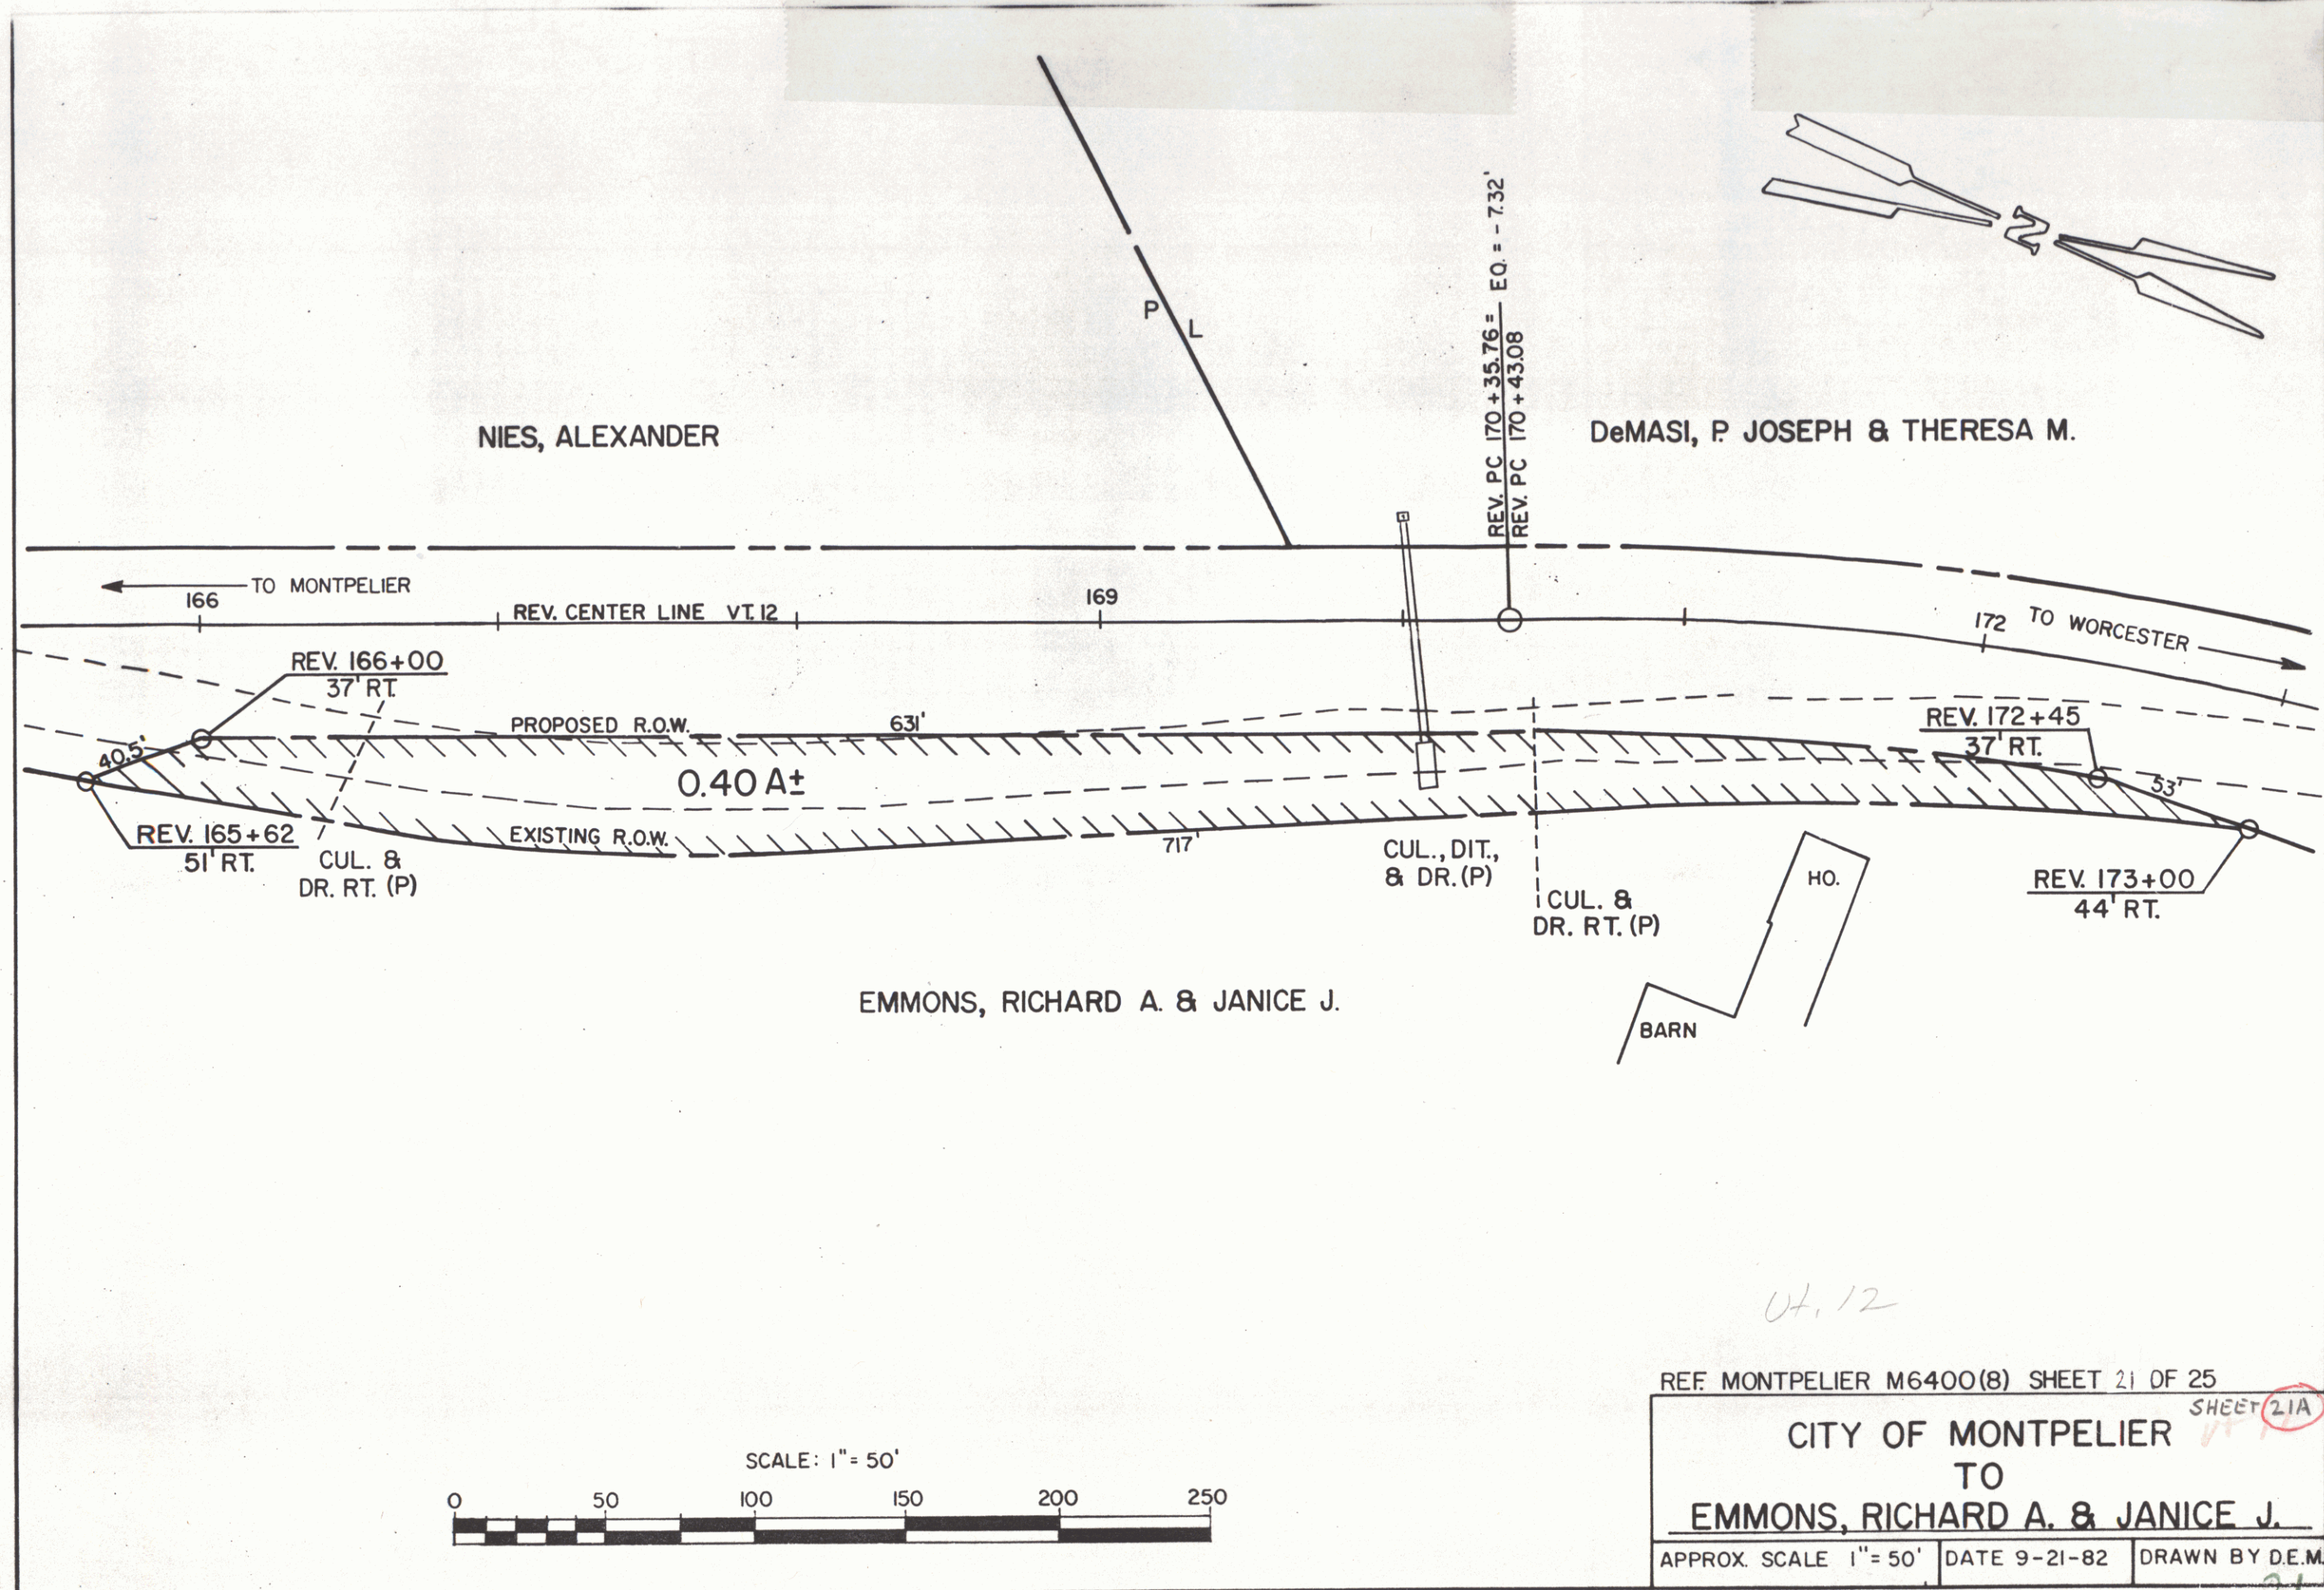

04.12


REF. MONTPELIER M6400(8) SHEET 21 OF 25


CITY OF MONTPELIER TO EMMONS, RICHARD A. & JANICE J.		
APPROX. SCALE 1"=50'	DATE 9-21-82	DRAWN BY D.E.M.

24 21



PLAN
 SHEET NO. 21 OF 25

PROFILE
 SHEET NO. 21 OF 25

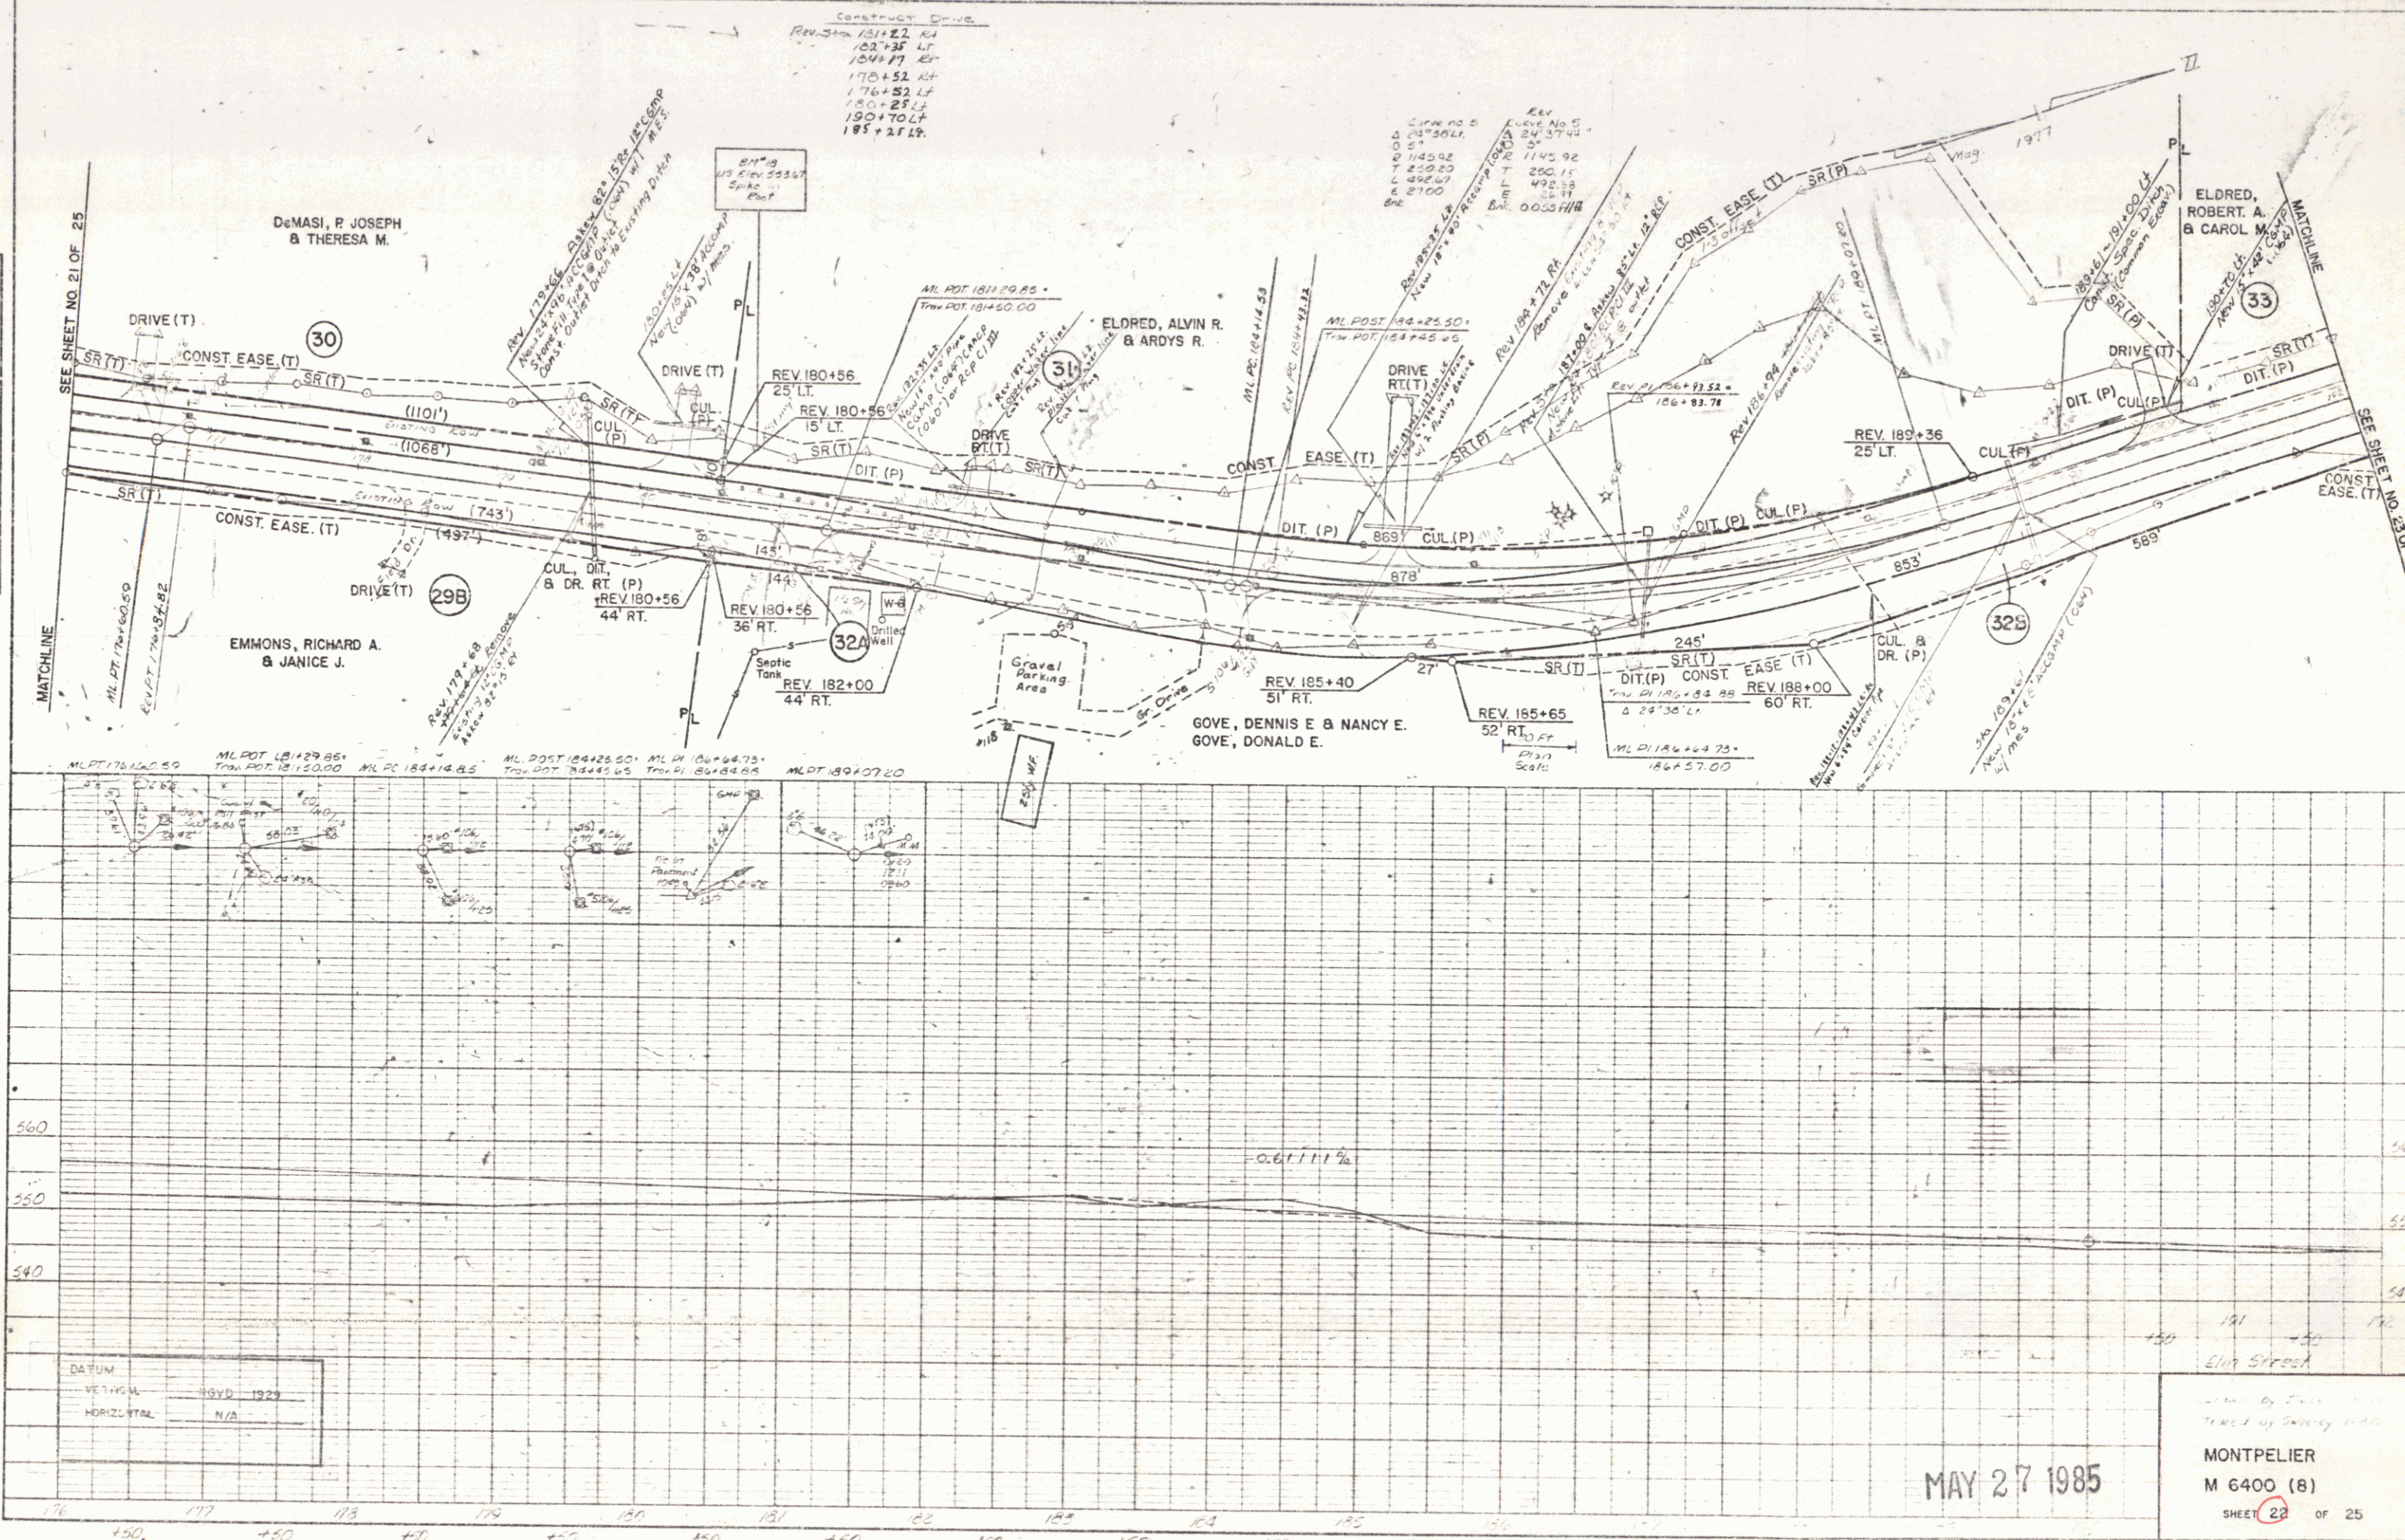

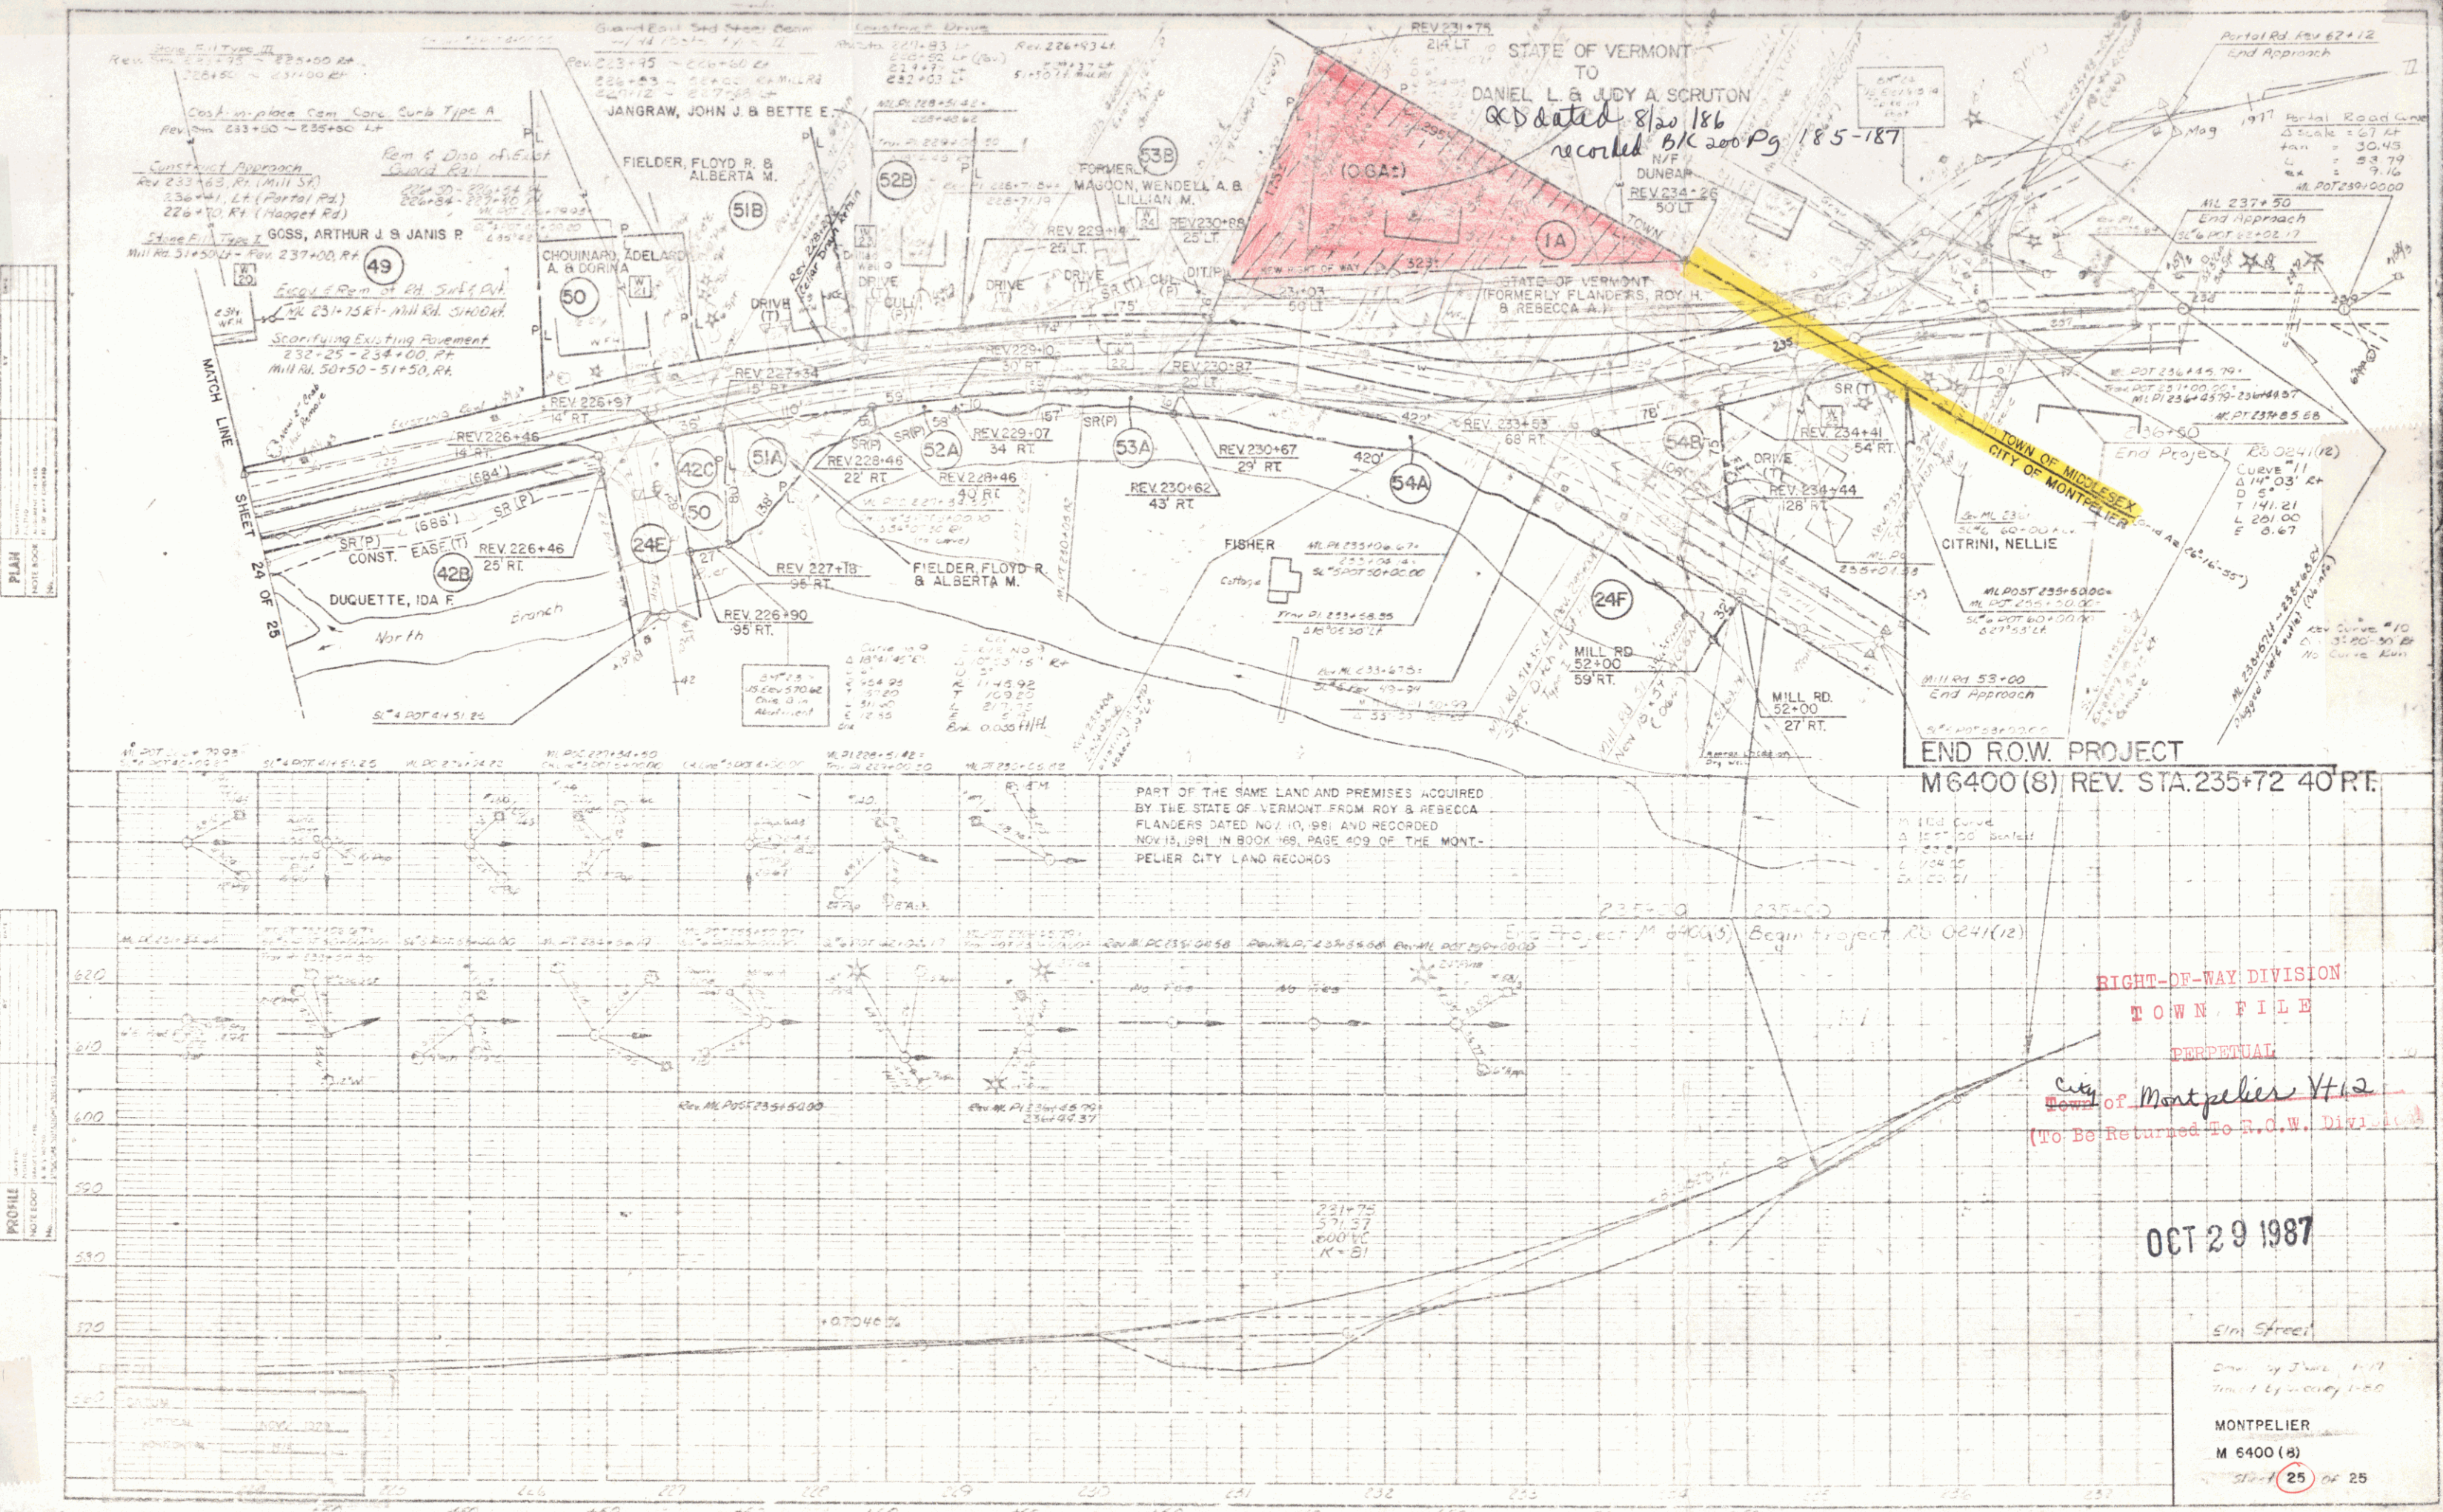

PART OF THE SAME LAND AND PREMISES ACQUIRED
BY THE STATE OF VERMONT FROM ROY AND REBECCA
FLANDERS DATED NOVEMBER 10, 1981 AND RECORDED
NOVEMBER 13, 1981 IN BOOK 168, PAGE 409 OF THE
MONTPELIER CITY LAND RECORDS.

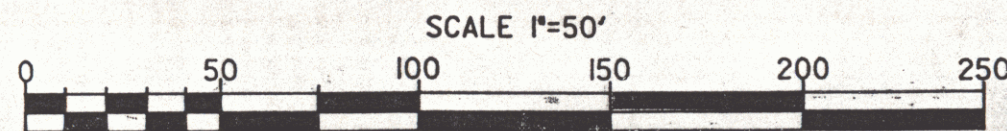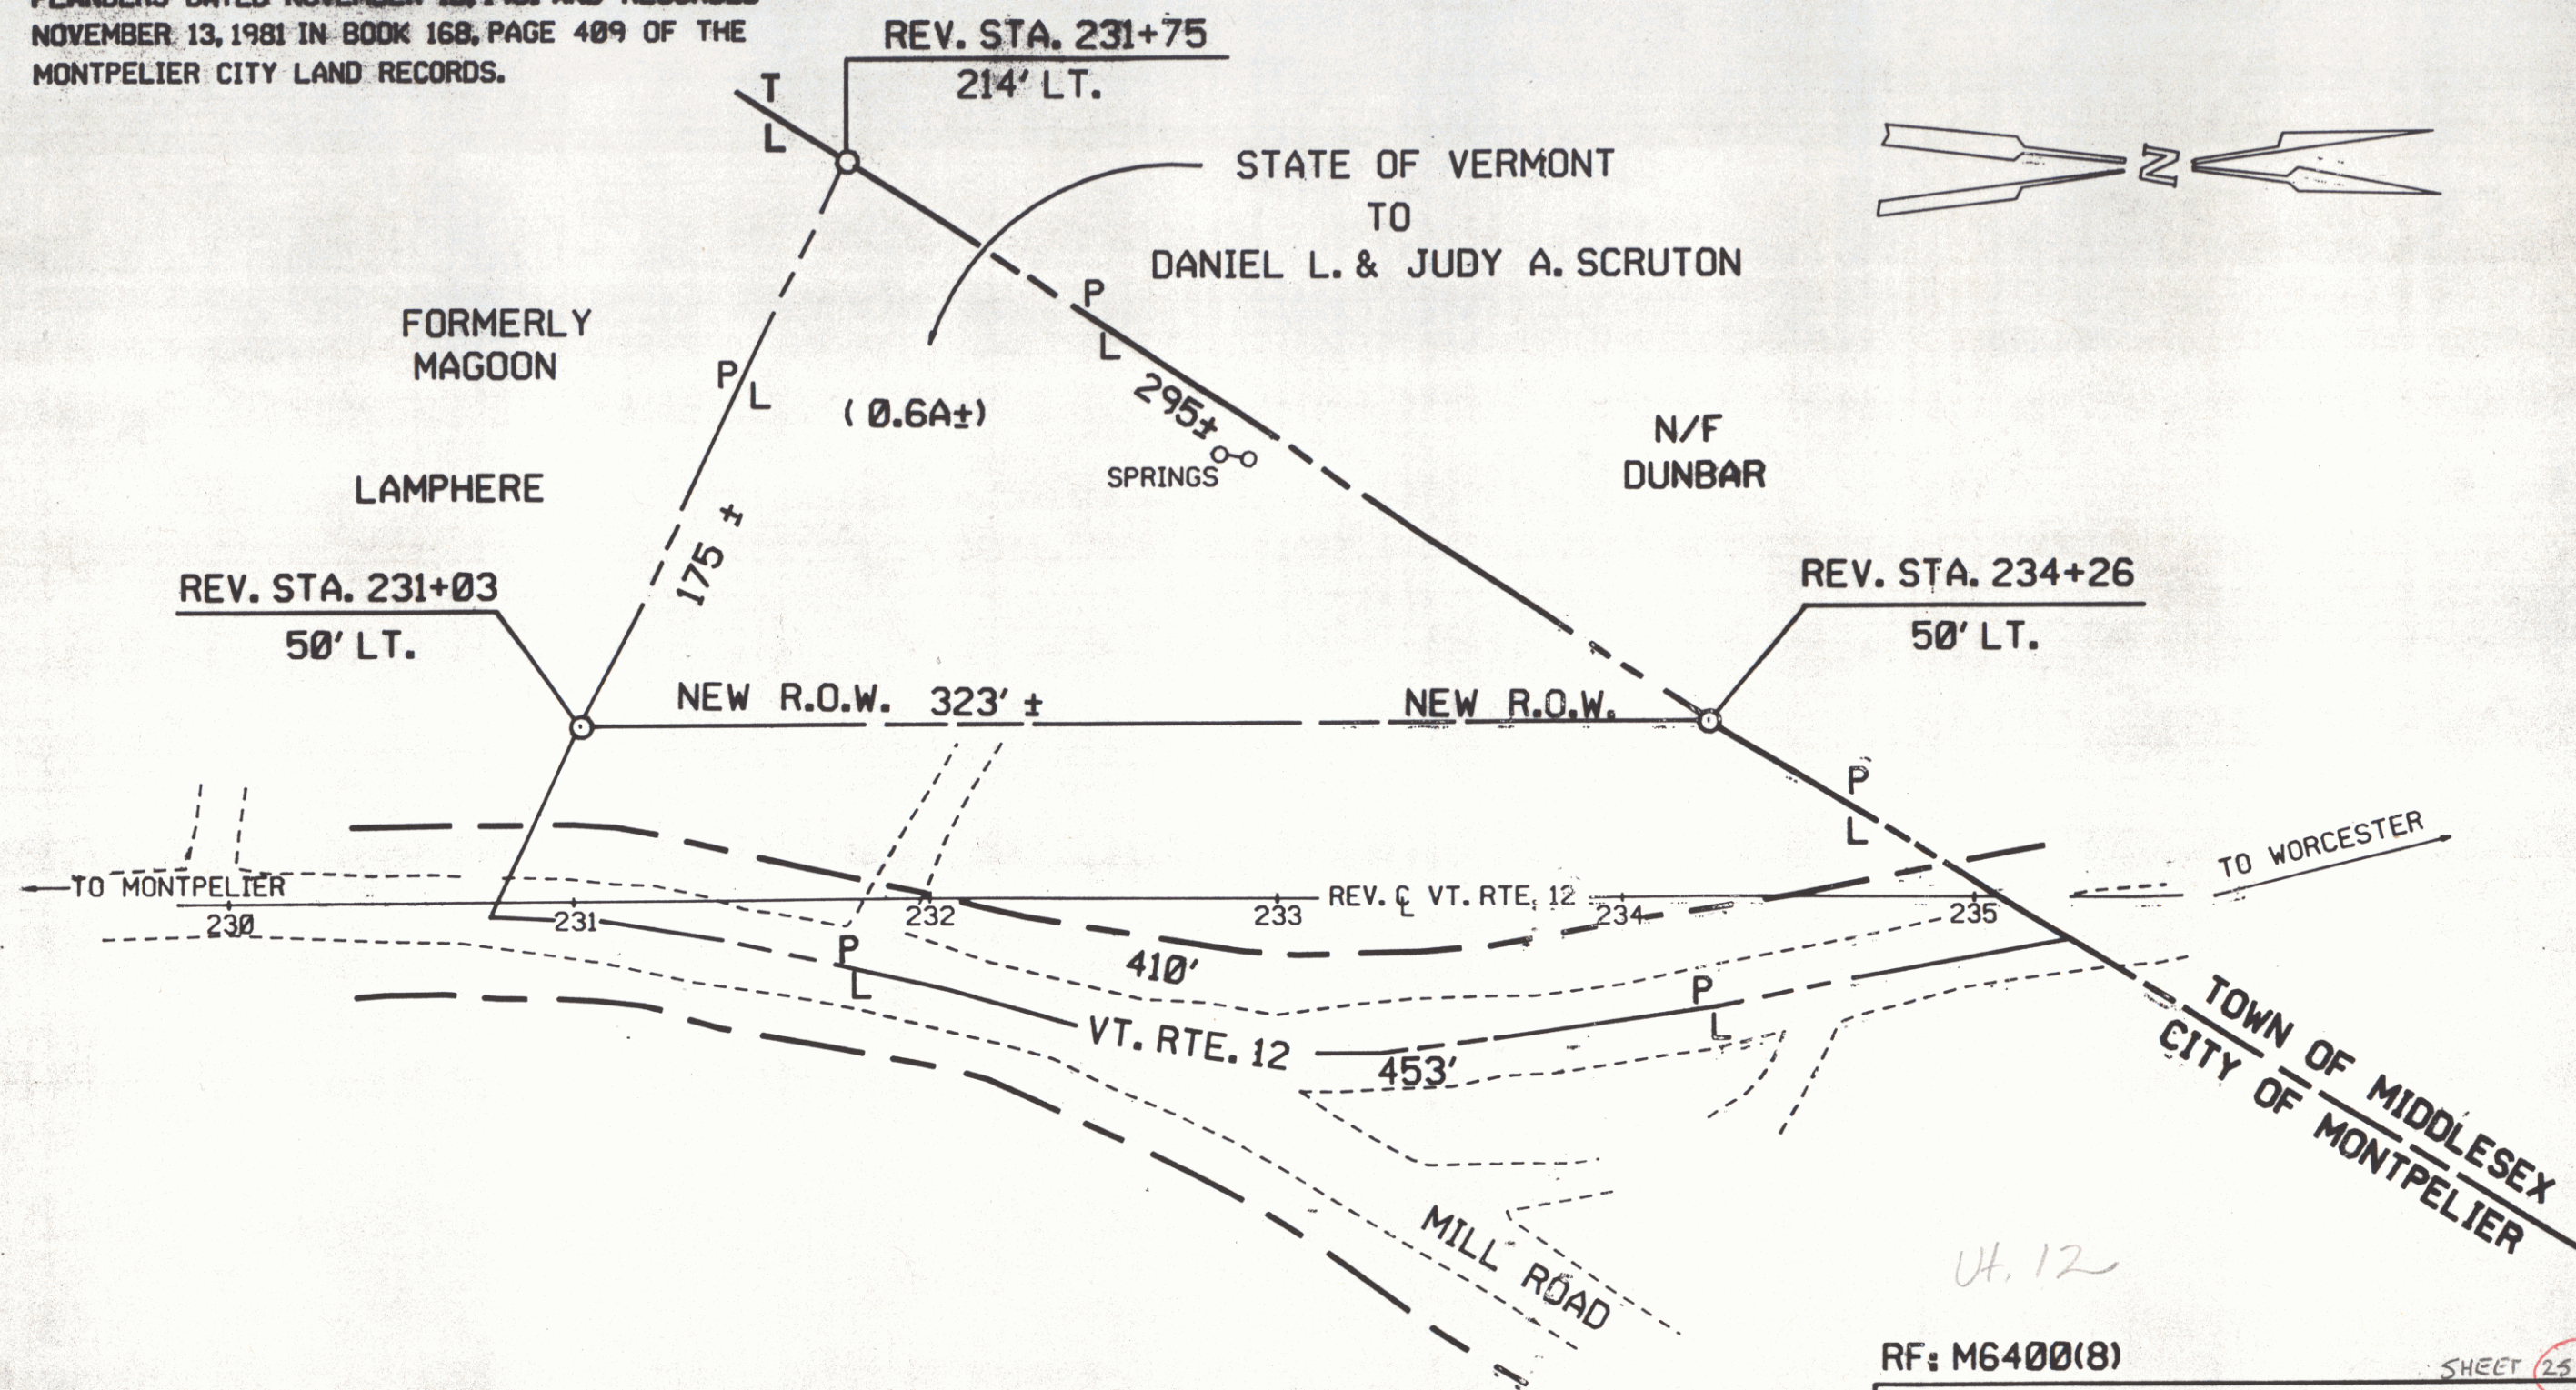


RF: M6400(8)

SHEET 25A

STATE OF VERMONT
AGENCY OF TRANSPORTATION

CITY OF MONTPELIER

APPROX. SCALE 1"=50' DATE 7-28-86 DRAWN BY M.J.R.

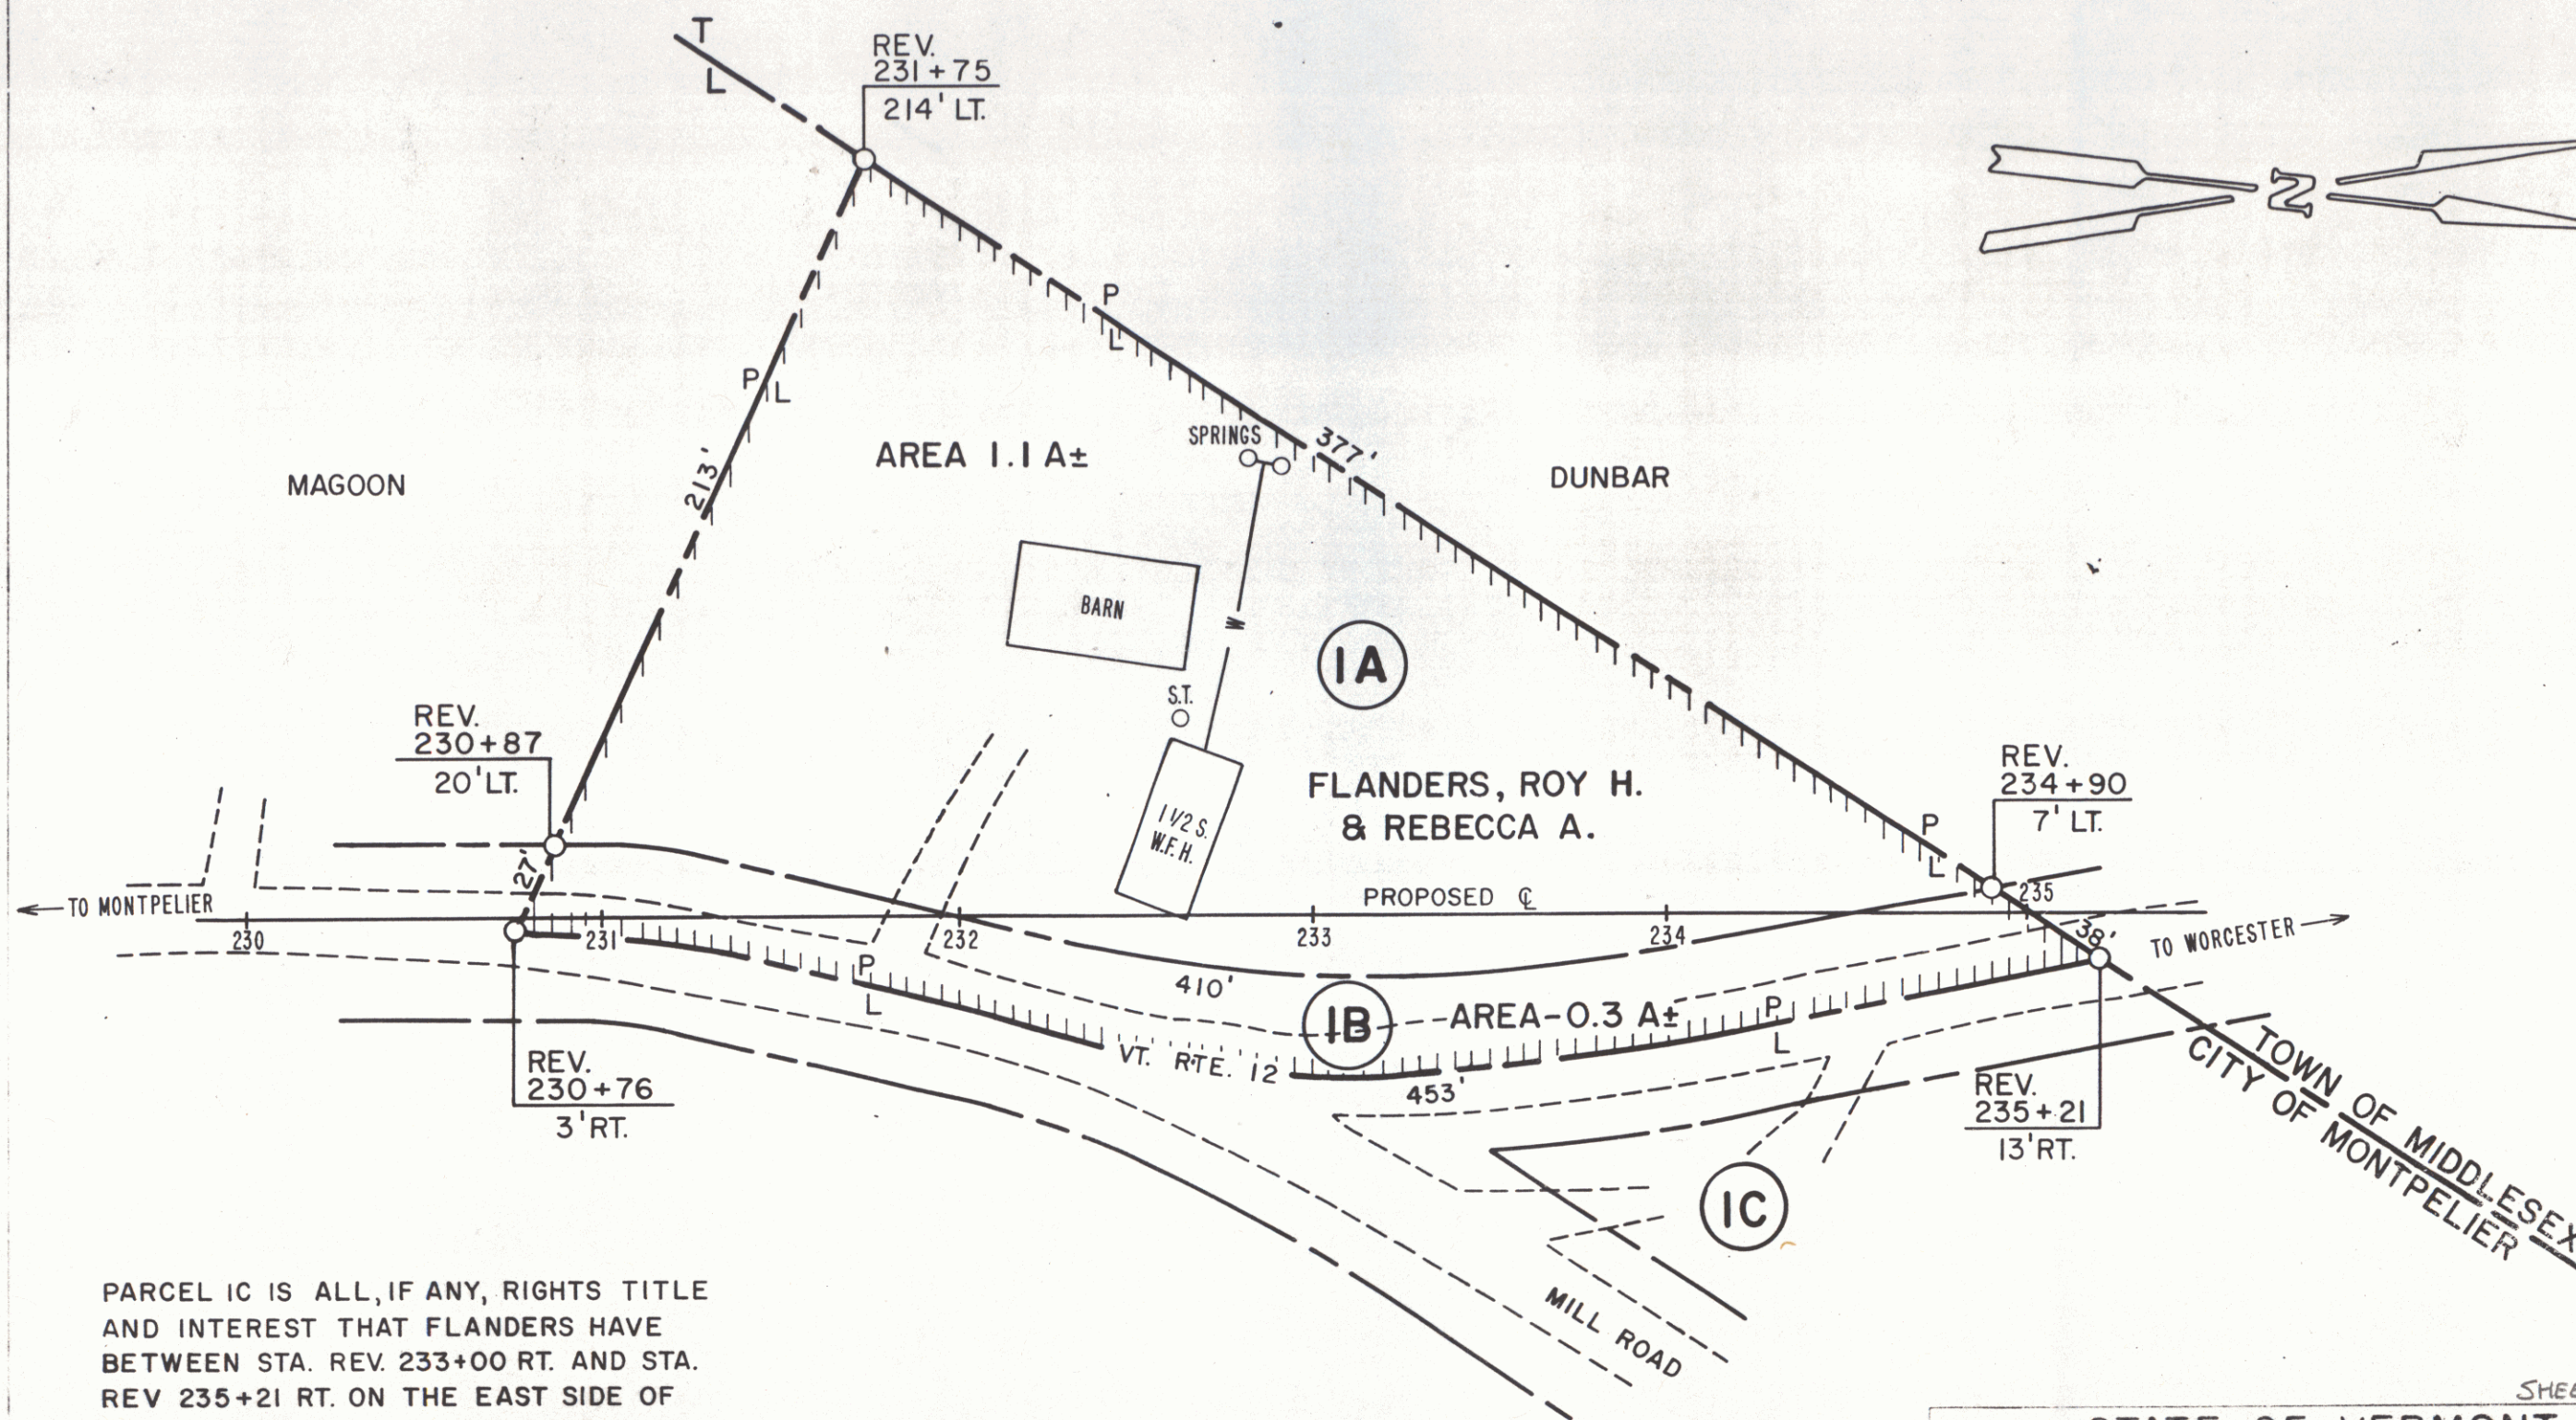

PARCEL IC IS ALL, IF ANY, RIGHTS TITLE AND INTEREST THAT FLANDERS HAVE BETWEEN STA. REV. 233+00 RT. AND STA. REV. 235+21 RT. ON THE EAST SIDE OF ROUTE 12 INCLUDING THE EXISTING HWY EASEMENT.

SCALE: 1" = 50'



STATE OF VERMONT AGENCY OF TRANSPORTATION			
CITY OF MONTPELIER			
PROJECT		M 6400 (8)	
APPROX. A.E.	50'	DATE	7/20/81
DRAWN BY		B.A.M.	
		27	