
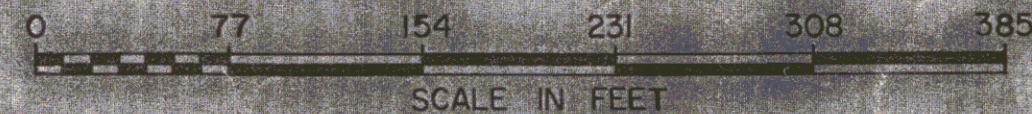


MP0617

POOR ORIGINAL COPY

WELCH TO ST. OF VT BY
VD ON 11/11/75 IN BK 48/263
AND AGREEMENT ON 5/9/75
IN 48/132

LA VANWAY TO ST. OF VT
BY VD ON 10/22/75 IN
BK 48/260-61 AND
AGREEMENT ON 5/9/75
IN BK 48/133

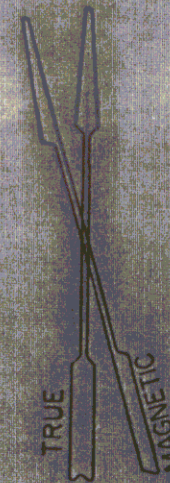

SHEET 13A

STATE OF VERMONT
DEPT. OF HIGHWAYS

Town of Duxbury

PROJECT Duxbury-Moretown RS 0213 (13)

APPROX. SCALE 1" = 77'

DATE 3-28-75

DRAWN BY ROD S.