


STATE OF VERMONT
AGENCY OF TRANSPORTATION



FEDERAL AID PRIMARY

PROPOSED IMPROVEMENT
TOWN OF DANVILLE
COUNTY OF CALEDONIA
U. S. ROUTE 2

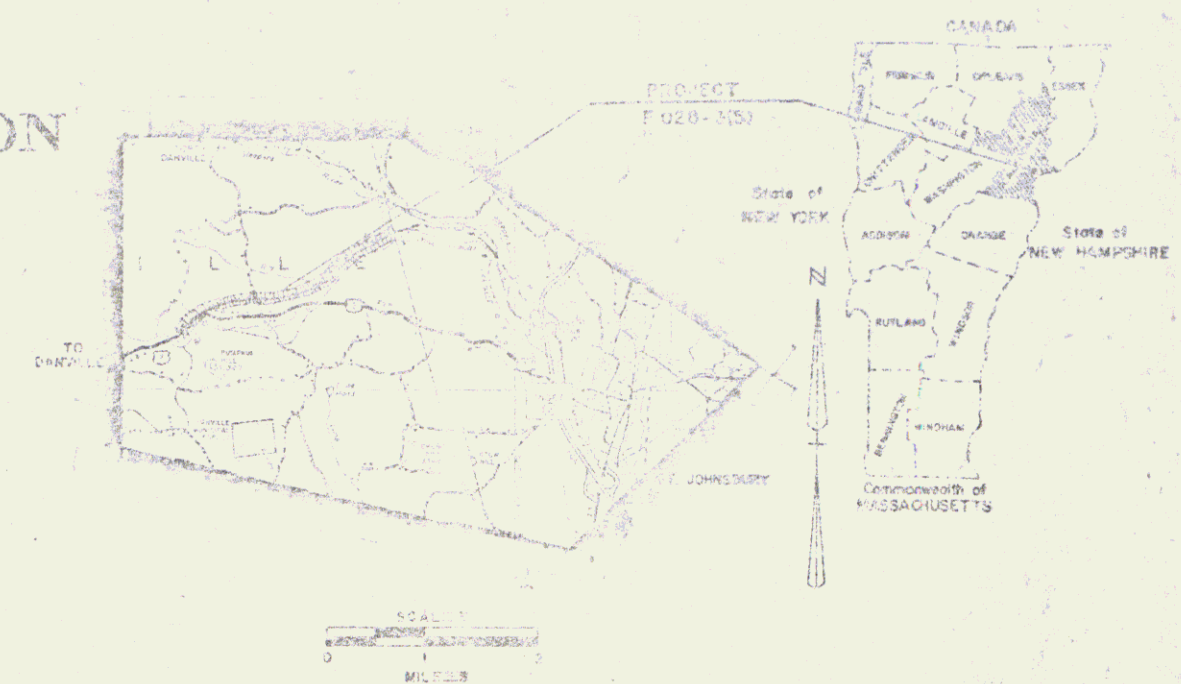

R.O.W. PLANS

BEGINNING AT A POINT ON U.S.2 APPROXIMATELY 6.840 MILES
EASTERLY OF THE CAROT-DANVILLE TOWN LINE AND EXTENDING
EASTERLY 2.729 MILES ON RELOCATION TO THE DANVILLE-
ST. JOHNSBURY TOWN LINE

LENGTH OF ROADWAY 14,408.80 FEET = 2.729 MILES
LENGTH OF PROJECT 14,506.88 FEET = 2.729 MILES
THIS PROJECT INCLUDES GRADING, DRAINAGE, SUBBASE, AND PAVEMENT
FOR A U.S. HIGHWAY ON NEW LOCATION
LENGTH OF R.O.W. PROJECT 14,830.80 FEET = 2.810 MILES

DESIGN SPEED
1971 AADT = 3540
2003 AADT = 9560
2003 TRV = 770
D = 52%
T = 75%
V = 60 MPH

RIGHT-OF-WAY DIVISION
TOWN FILE
PERPETUAL

Town of _____
(To Be Returned To R.O.W. Division)

MP 9.13

STA. 1717+20

END PROJECT F028-3(5) BEGIN PROJECT F028-3(5)

END R.O.W. PROJECT

F 028-3 (5) STA. 1717+50 (120' LT.)

CONVENTIONAL SIGNS

- COUNTY LINE
- TOWN LINE
- LIGHTS OF ACCESS
- POINT OF ACCESS
- FENCE LINE
- STONE WALL
- TRAVELED WAY
- GUARD RAIL
- RAILROAD
- SURVEY LINE
- CULVERT
- POWER POLE
- TELEPHONE POLE
- TAGES
- CONTROL OF ACCESS
- PROPERTY LINE
- R.O.W. TAILING LINE
- SHORE RIGHTS
- TOP OF CUT
- TOP OF SLOPE

BEGIN R.O.W. PROJECT

F 028-3 (5) STA. 1569+00 (33' RT.)

BEGIN MAINT. AGREE. AREA NO. 5

END RELINQUISHMENT NO. III

STA. FRONT. RD. 49+32 E

BEGIN RELINQUISHMENT NO. II

STA. FRONT. RD. 48+00 E

END MAINT. AGREE. AREA NO. I

STA. 1574+65 95' LT.

END MAINT. AGREE. AREA NO. 3

BEGIN RELINQUISHMENT NO. I

STA. REV. U.S. 2 CORN. 11+75 E

BEGIN MAINT. AGREE. AREA NO. 3

STA. REV. U.S. 2 CORN. 10+12 E

BEGIN MAINT. AGREE. AREA NO. 1

STA. 1574+60 12' LT.

BEGIN MAINT. AGREE. AREA NO. 4

STA. SPUR 60+12 E

END RELINQUISHMENT NO. I

BEGIN MAINT. AGREE. AREA NO. 4

STA. SPUR 60+12 E

END RELINQUISHMENT NO. II

STA. TH. 41 26+87 E

END MAINT. AGREE. AREA NO. 2

BEGIN RELINQUISHMENT NO. II

STA. TH. 41 25+90 E

END MAINT. AGREE. AREA NO. 5

BEGIN RELINQUISHMENT NO. II

STA. FRONT. RD. 50+35 E

END RELINQUISHMENT NO. IV

STA. FRONT. RD. 59+00 E

END MAINT. AGREE. AREA NO. 2

STA. TH. 41 25+90 E

END MAINT. AGREE. AREA NO. 2

STA. TH. 41 25+90 E

END MAINT. AGREE. AREA NO. 2

STA. TH. 41 25+90 E

END MAINT. AGREE. AREA NO. 2

STA. TH. 41 25+90 E

Pin # 76D068

SEP 12 1986

5/25/82

APPROVED BY _____

SUBMITTED BY _____

DEPARTMENT OF TRANSPORTATION

FEDERAL HIGHWAY ADMINISTRATION

DANVILLE

FEY F 028-3(5)

SHEET 1 OF 38

STATE OF VERMONT
AGENCY OF TRANSPORTATION
RIGHT-OF-WAY PLANS
DETAIL SHEET

TABLE OF PROJECT PROPERTY ACQUISITION

PARCEL NO.	GRANTOR	SHEET NO.	BEGINNING STATION	ENDING STATION	TAKING	REM.	RIGHTS	TITLE TAKEN	DATE	TOWN OR CITY RECORDED	BK.	PG.	REMARKS	
1A	COLGROVE, JOHN E. & KAREN J.	16	1569+00 RT 1571+65 RT 1573+22 RT 1573+90 RT 1569+00 RT	1577+50 RT 1572+65 RT 1579+94 RT	0.78 A±		CONST. EASE. (T) DRIVE (T) DRAINAGE (P)	(360 S.F.)	W.D.	8-22-83	DANVILLE	64	321-329	NON-LIMITED ACCESS 14" GRAVEL M.P. 6.84 DRIVE PERMIT DATE.
1B		16	1579+23 RT 1579+23 RT 1579+76 RT	1579+98 RT 1579+94 RT	0.01 A±		CHANNEL (P) DRAINAGE (P)	(0.04 A±)						(624 S.F.) (1500 S.F.)
1C		16	1579+27 RT	1580+07 RT TOTAL	0.04 A± 0.83 A±	30.40 A±	ALL R. T. & I.							(1850 S.F.) HWY. EASE. US 2
2	GAGETTA, ERNANDO J. & LIBIA C.	16	1573+00 LI 1570+76 LI 1571+50 LI 1572+32 LI 1572+70 LI 1572+90 LI 1572+85 LI 1571+65 LI 1573+00 LI	1574+21 LI 1572+90 LI 1574+05 LI 1574+21 LI	0.05 A±		DRIVE (T) DRIVE (T) DRIVE (T) CULVERT (P) DRAINAGE (P) SLOPE (T)	(0.01 A±)	W.D.	11-16-83	DANVILLE	65	68-90	(2165 S.F.) NON-LIMITED ACCESS 14" GRAVEL M.P. 6.15 DRIVE PERMIT DATE. DRIVE 14" GRAVEL M.P. 6.77 DRIVE PERMIT DATE. 14" GRAVEL M.P. 6.78 DRIVE PERMIT DATE. (540 S.F.) STONE WALL
3A	THE CALEDONIA NATIONAL BANK OF DANVILLE	16, 17	1575+09 LI 1582+20 LI 1582+40 LI 1580+80 RT 1589+60 RT 1580+20 RT REV. US 2 CONNL. 13+50 LI 1582+50 LI ± 1583+75 RT 1588+25 LI 1575+18 LI 1581+10 RT	1589+57 LI 1586+05 LI 1585+80 LI 1581+10 RT 1581+05 RT 1584+30 RT ± 1585+55 RT 1589+10 LI 1589+57 LI 1586+88 RT	6.20 A±		CONST. EASE. (T) SLOPE (P) ALL R. T. & I. CONST. EASE. (T) CONST. EASE. (T)	(0.08 A±) (0.07 A±) (0.02 A±) (400 S.F.)	W.D.	10-24-83	DANVILLE	65	30-32	NON-LIMITED ACCESS (3700 S.F.) (2889 S.F.) SPLIT RAIL FENCE SIGN BOX CEDAR RAIL FENCE DRIVE 64" PAVED M.P. 0.068 DRIVE PERMIT DATE. WATERLINE (875 S.F.)
(CONT.)														

(CONT.)

TABLE OF REVISIONS

REVISION NO.	SHEET NO.	DESCRIPTION OF REVISION	DATE	MADE BY	APPROVED BY
1	16, 17	PARCEL #26 PARCELS, Added Parcel #26. ALL to detail sheet 15A. All R.T. ±. In spring at STA. 1614+45 LI. + WATERLINE 14" x 65 LI. ± 1614+40 RT. Added detail sheet 15B. PER C.O. # 5502	8-13-82	DEM	T.P.M.
2	7, 16	PARCEL #5 PLATE, REVISED PROPERTY LINES + DETAIL SHEET PER C.O. # 5556	9-23-82	DEM	ENP
3	7, 16	PARCEL #6 PLATE, REVISED PROPERTY LINES + DETAIL SHEET PER C.O. # 5557	9-23-82	DEM	ENP
4	6, 7, 9, 12, 14, 15A	Added (12) TRACKWAY STATIONS on detail sheet. Detail 21A Manual Construct Approach (10) to RT. Caledonia Perimeter Co. 5653	11-30-82	DEM	R.L.S.
5	1, 9, 10, 11, 20, B	PARCEL #11 S. FERRARI DELETED PARCELS 11B-11E (Added to Parcel #4) PER C.O. # 5683	1-4-83	DEM	RB
6	1, 9, 10, 11, 20, B	PARCEL #4 K. FERRARI, CHANGED PARCEL #4 TO 12 ADJACENT PARCELS 11A-11D (FROM PARCEL #11) PER C.O. # 5684	1-4-83	DEM	RB
7	4, 12, 14	ADDED 14" DRIVE PERMIT #3 A DRIVES PER C.O. # 5689	1-5-83	DEM	RB
8	7, 16	PARCEL #6 MECHANISTIC, CORRECTED SPELLING OF PROPERTY OWNERS NAME PER C.O. # 5703	1-13-83	DEM	R.L.S.
9	7	PARCEL #4 FERRARI, CHANGED TOTAL OF REMAINDER FROM 0.75 AC TO 0.75 AC PER C.O. # 5736	2-2-83	S.A.M.	R.L.S.
10	14, D	PARCEL #19 BECONNETT, CHANGED REM. AREA FROM 1677 ± TO 1717 ± TOTAL FROM 96 AC TO 66 AC ± TOTAL FROM 17.9 AC TO 16.9 AC. Revisited Property Line On GrandPlan Per C.O. # 5774	3-3-83	S.A.M.	R.L.S.
11	11, 12, 16, 20, B	PARCEL #13 VANDER, Added PARCELS 13-14 ± 13P WITH ADJACENT FROM 15C-15H PER C.O. # 5779	3-22-83	DEM	R.L.S.
12	13, 20, B	PARCELS CHOMMIS, Added PARCELS 15C-15H WITH ADJACENT FROM 15A-15B PER C.O. # 5775	3-22-83	DEM	R.L.S.
13	1, 11, 12, 14, 15, 20, B	REVISED RECONSTRUCTION #1 FROM T.P.M. RELATION TO existing #12. Added Point from PARCELS No. 3, 4, & 5 PER C.O. # 5786	3-22-83	DEM	R.L.S.
14	13, C	PARCEL #14 REVISITING BRK, REVISED RT. REMAINDER FROM 2289 S.F. TO 27,224 S.F. + REVISED TOTAL REMAINDER FROM 31.70 AC TO 36.10 AC PER C.O. # 5802	3-22-83	DEM	R.L.S.
15	11, 12, C	PARCEL #13 VANDER, REVISED REMAINDER FROM 2289 S.F. TO 27,224 S.F. + REVISED TOTAL REMAINDER FROM 31.70 AC TO 36.10 AC PER C.O. # 5803	3-22-83	DEM	R.L.S.

MADE BY: SAM DATE: 5/10/82
CHECKED BY: JDP DATE: 5/10/82

DR. RT. — DRAINAGE RIGHT
DIT. RT. — DITCHING RIGHT
CH. RT. — CHANNEL RIGHT
DRIVE RT. — DRIVE RIGHT
CUL. RT. — CULVERT RIGHT
Ⓢ — DEMOLITION OR REMOVAL
W — WATER SOURCES

PRESENT R.O.W.
— — — — — TAKING WITHOUT ACCESS
— — — — — TAKING WITHOUT ACCESS ALONG PROPERTY LINES
— — — — — TAKING WITH ACCESS
(P) — PERMANENT EASEMENT
(T) — TEMPORARY EASEMENT

LEGEND
— — — — — CONST. EASE.
— — — — — CONST. EASEMENT
— — — — — SLOPE RIGHTS
— — — — — PROPERTY LINE
— — — — — TOP OF CUT
— — — — — TOP OF SLOPE

APPROVED: Thomas R. May DATE: 5-25-82
CHIEF OF PLANS & TITLES

PROJECT: DANVILLE
NO. F 028-3 (5)
SHEET: (6) OF 38

SEP 12 1986

STATE OF VERMONT
AGENCY OF TRANSPORTATION
RIGHT-OF-WAY PLANS
DETAIL SHEET

TABLE OF PROJECT PROPERTY ACQUISITION

PARCEL NO.	GRANTOR	SHEET NO.	BEGINNING STATION	ENDING STATION	TAKING	REM.	RIGHTS	TITLE TAKEN	DATE	TOWN OR CITY RECORDED	BK	PG.	REMARKS
3B		15	1579+36 RT.	REV. US 2 CONN. 14+00 & TOTAL	0.18 A±		ALL R.T. & L.						HWY. EASE. US 2
4A	PENOFF, KENNETH E. & VIRGINIA A.	19	1625+85 RT.	1626+43 RT.	0.05 A±				WD.	12-16-83	DANVILLE	65	380-162 (2064 SE±)
4B		19,20	FRONT RD. 48+37 RT. FRONT RD. 48+45 RT. FRONT RD. 48+50 RT. FRONT RD. 48+60 RT.	1626+27 RT. TH41 21+70 LT. TH41 21+50 LT. TH41 21+50 LT.	0.55 A±		CONST. EASE. (T) SLOPE (T)	(0.03 A±) (0.12 A±)					NON-LIMITED ACCESS (1500 S.E.±)
4C		19	1625+44 RT.	1626+43 RT.	0.03 A±		ALL R.T. & L.						(3625 SE±) HWY. EASE. TH41
4D		19	FRONT RD. 48+00 &	1625+73 RT.	0.11 A±		ALL R.T. & L.						HWY. EASE. TH41 NON-LIMITED ACCESS
4E		19	1617+32 LT. ±	1618+75 RT. ± TOTAL	0.79 A±	0.35 A±	ALL R.T. & L.						WATERLINE
5A	BLAKE, CAROLYN D. WELSON, DIANE BLACK NOZWAY	16	1579+94 RT. 1579+94 RT. REV. US 2 CONN. 12+25 RT. REV. US 2 CONN. 12+40 RT. REV. US 2 CONN. 12+40 RT. REV. US 2 CONN. 12+40 RT.	REV. US 2 CONN. 12+67 RT. REV. US 2 CONN. 12+74 RT. REV. US 2 CONN. 12+68 RT. REV. US 2 CONN. 12+68 RT.	0.02 A±	1.50 A±	CONST. EASE. (T) SLOPE (T) ALL R.T. & L. EASE TO REMOVE (T) DRIVE (T)	(0.03 A±) (156 SE±)	WD	10-24-83	DANVILLE	64	521-23 (864 SE±) NON-LIMITED ACCESS (1100 SE±)
5B		16	1579+98 RT.	REV. US 2 CONN. 12+60 & TOTAL	0.06 A±		ALL R.T. & L.						CAMP & CONC. SLAB CAMP & CONC. SLAB 14" GRAVEL M.P. 0045 DRIVE PERMIT DATE: (2500 S.E.±) HWY. EASE. US 2 NON-LIMITED ACCESS
6A	MENUSTIK, GLORIA W.	16	REV. US 2 CONN. 12+62 RT. REV. US 2 CONN. 12+42 RT. REV. US 2 CONN. 12+68 RT. REV. US 2 CONN. 12+68 RT.	REV. US 2 CONN. 14+00 RT. REV. US 2 CONN. 12+75 RT. REV. US 2 CONN. 13+05 RT. REV. US 2 CONN. 14+00 RT.	0.03 A±	2.00 A±	SLOPE (T) CONST. EASE. (T)	(20 S.E.±) (170 S.E.±)	WD.	9-2-82	DANVILLE	64	338-40 (1096 SE±) NON-LIMITED ACCESS
6B		16	REV. US 2 CONN. 12+60 C	REV. US 2 CONN. 14+00 & TOTAL	0.08 A±	2.00 A±	ALL R.T. & L.						(1300 SE±) HWY. EASE. US 2 NON-LIMITED ACCESS

TABLE OF REVISIONS

REVISION NO.	SHEET NO.	DESCRIPTION OF REVISION	DATE	MADE BY	APPROVED BY
16	16, 17	PARCEL #3 BETZOLD, ADDED WATERLINE STA. 1582+00 LT. ~ 1583+50 LT. AND STA. 1583+00 RT. ~ 1584+30 RT.; ADDED WATERLINE & EASE AT STA. 1582+00 & PER C.O. #5805.	9-5-83	M.W.H.	R.L.S.
17	8, 17	PARCEL #7 BISSSELL, ADDED DRIVE AT STA. 1584+50 RT. 14 GRAVEL PER C.O. #5856	4-13-83	DEM	R.L.S.
18	19, 8	PARCEL #26 PARKER, ADDED WATER LINE BETWEEN PARKER RESIDENCE AND W6-B PER C.O. #5885	5-20-83	M.W.H.	JOP
19	6, 17	PARCEL #3 BETZOLD, CHANGED NAMES FROM BETZOLD, STANLEY A. + Phyllis W. TO CALEDONIA NATIONAL BANK OF DANVILLE PER C.O. #5944	7-12-83	M.W.H.	RS
20	12, 19, 20	PARCEL #14 ELAY, ADDED NAME OF NORMAN R. ELAY, HUSBAND, PER C.O. #5945	7-13-83	M.W.H.	RS
21	14, 19, 20	PARCEL #19 BOWHART & 10 HUTCHINS REVISED RD. PL. TO CENTER OF RIVER; REVISED TAKE TO ADJ. + ADDED CHAN. RT. (P) AT STA. 1644+00 ~ 1647+00 TO PARCEL 20 PER C.O. #6004	9-9-83	DEM	LWB
22	8, 17	PARCEL #4 BE-ANGRE, REVISED DRIVE AT 1576+50 LT. FROM 14" TO 16" PER C.O. #6001	9-18-83	DEM	LWB
23	7, 16	PARCEL #5 BLANK, ADDED "ALL R.T. & L." TO SHED & CONC. SLAB CHANGED "SHED" TO "CAMP" MOVED TEMP. EASE TO REMOVE CAMP & SLAB PER C.O. #6008	1-16-83	DEM	LWB
24	14, 19, 20	PARCEL #13 WANCE "D" CHANGED END STA. TO 30+86 & ENDING STA. TO 34+45 LT. Change area of slope from 0.104 to 0.304 "E" change begin from 32+75 LT. to 32+48 LT. & end sta. from 39+00 LT. to 34+86 LT. delete slope from (P) to (T) change slope sta. begin 34+55 LT. to end sta. 38+20 LT. & increased area to 0.11 A± "K" change end sta. from 35+74 LT. to 35+42 LT. & decreased area from 0.42 A± to 0.70 A± changed total from 22.35 A± taking to 22.13 A± & remain from 195.20 A± to 195.02 A± Per C.O. #6033	10-6-83	JOP	LWB
25	15, 19, 20	PARCEL 21 TOWN OF DAN. 210 change end sta. from 35+74 to 35+42 LT. & take from 0.02 A± to 0.01 A± total take change from 43.1 A± to 42.1 A± C.O. #6035	10-6-83	JOP	LWB

MADE BY: B.A.M. DATE: 5/11/82
CHECKED BY: JOP DATE: 5/11/82

DR. RT. - DRAINAGE RIGHT
DIT. RT. - DITCHING RIGHT
CH. RT. - CHANNEL RIGHT
DRIVE RT. - DRIVE RIGHT
CUL. RT. - CULVERT RIGHT
(D) - DEMOLITION OR REMOVAL
(W) - WATER SOURCES

PRESENT R.O.W.
--- TAKING WITHOUT ACCESS
--- TAKING WITHOUT ACCESS ALONG PROPERTY LINES
--- TAKING WITH ACCESS
(P) PERMANENT EASEMENT
(T) TEMPORARY EASEMENT

LEGEND
--- CONST. EASE. --- CONST. EASEMENT
--- SR --- SLOPE RIGHTS
--- P --- PROPERTY LINE
--- Δ --- TOP OF CUT
--- ○ --- TOE OF SLOPE

APPROVED: Thomas P. [Signature] DATE: 5-25-82
CHIEF OF PLANS & TITLES

PROJECT: DANVILLE
NO. F 028-3(5)
SHEET (7) OF 38

STATE OF VERMONT
AGENCY OF TRANSPORTATION
RIGHT-OF-WAY PLANS
DETAIL SHEET

TABLE OF PROJECT PROPERTY ACQUISITION

PARCEL NO.	GRANTOR	SHEET NO.	BEGINNING STATION	ENDING STATION	TAKING	REM.	RIGHTS	TITLE TAKEN	DATE	TOWN OR CITY RECORDED	BK.	PG.	REMARKS
7	BISSELL, RANDALL & JANICE A.	17	1586+08 RT 1588+50 RT	1589+23 RT	0.21 A±	1.30 A±			W.D.	10-15-83	DANVILLE	64	479-80 NON-LIMITED ACCESS 14' GRAVEL DRIVE W.P. 7.09 DRIVE PERMIT DATE:
8	GILMOUS, R. DOUGLAS	17	1586+08 RT 1589+50 RT 1590+15 RT 1591+80 RT 1592+65 RT 1593+00 RT 1594+05 RT 1594+85 RT 1599+57 RT 1589+23 RT	1596+36 RT 1590+40 RT 1592+32 RT 1595+50 RT 1594+30 RT RELOC US 2 2+50 LT 1595+94 LT RELOC US 2 2+50 LT	4.90 A±		DITCH (P) DRAINAGE (P) CONST. EASE. (T) (0.04 A±) CONST. EASE. (T) (250 SF±) CONST. EASE. (T) (0.05 A±) SLOPE (P) (0.01 A±) CONST. EASE. (T) (0.03 A±) SLOPE (T) (0.04 A±)	W.D.		DANVILLE			NON-LIMITED ACCESS (1600 SF±) (2000 SF±) (585 SF±) (1500 SF±) (1650 SF±)
				TOTAL	4.90 A±	4.90 A±							
9A	BELANGER, RAYMOND E. & GIOVANNI	17, 18	1595+91 LT 1596+50 LT	1597+00 LT	0.24 A±		DRIVE (I)		W.D.		DANVILLE		NON-LIMITED ACCESS 16' GRAVEL W.P. 07.29 DRIVE PERMIT DATE:
9B		17, 18	1596+36 RT 1596+50 LT 1598+00 LT 1598+30 LT 1598+55 LT 1599+80 LT 1600+75 LT 1601+35 LT 1595+94 LT	1601+57 LT 1598+30 LT 1601+35 LT 1599+40 LT 1600+35 LT 1601+35 LT 1601+56 LT 1601+57 LT	1.00 A±		DRIVE (T) CHURCH (P) CONST. EASE. (T) (0.07 A±) SLOPE (P) (0.03 A±) SLOPE (T) (280 SF±) SLOPE (T) (154 SF±) CHANNEL (P) (400 SF±)						(3200 SF±) (1350 SF±)
9C		17	RELOC US 2 2+50 LT	RELOC US 2 3+92 LT	0.01 A±								(578 SF±) NON-LIMITED ACCESS
9D		17, 18	RELOC US 2 2+50 LT	1599+55 RT	0.13 A±		ALL R.T. & I.						HWY EASE US 2 NON-LIMITED ACCESS
9E		17, 18	RELOC US 2 3+92 LT	1601+40 RT TOTAL	0.16 A± 2.34 A±	84.80 A±	ALL R.T. & I.						HWY EASE US 2

TABLE OF REVISIONS

REVISION NO.	SHEET NO.	DESCRIPTION OF REVISION	DATE	MADE BY	APPROVED BY
26	12, 21	PARCEL #13 VANCE, DELETED PARCEL #13 H, ADDED DENE RT. Formerly under 15H to 15W. Revised TOTAL TAKEN, ADDED TO TOTAL TAKEN. POSSIBLE TO TAKE IN FRONTAGE RD. PER. CO. # 6029	10-18-83	DEM	LWB
27	15A, 14, 21, 22	PARCEL #27 VANCE, ADDED PARCEL 27 + FORMER LEASE LOT LINE RT STA. 1632+17 173' RT ~ 1632+25 120' LT. Revised AFFECTED RUNNING DISTANCES PER. CO. # 6045	10-20-83	DEM	LWB
28	11, 21, 8, 12	PARCEL #13 VANCE, REVISED LIMITED ACCESS LINE AT STA. 1632+17. ~ 1640+50 LT. Revised TAKEN AREA 158 005' & ADDED IT TO REMAINDER (1146.15 A±) PER. CO. # 6055	11-01-83	DEM	LWB
29	10, 11	PARCEL #12 CLARK, Revised Drive Loc. From 27+00 LT. To 27+50 LT. Per. CO. # 6061	11-2-83	B.A.M.	HB
30	11, 20, 21	PARCEL #12 VANCE, PARCEL #13A ADDED Drive (RT. 42 STA. 1641+25 LT. RT. PER. REV. DEN. I. CO. # 6034 & 6067. ADDED Drive (RT. PARCEL 13B RT. STA. 1633+17 LT. ~ 1633+00 LT. Drive (RT. 42 STA. 1640+50 LT. ~ 1641+30 LT. TITLE Taken By Release Per. Revised Design: I. CO. # 6066	11-2-83	B.A.M.	HB
31	9, 18	PARCEL #10 McCUSKER, REVISED 2000 SF± FROM REMAINDER TO TAKE COLUMN & REVISED TOTAL. ADDED "ACQUIRED UNECONOMIC REMAINDER" & DELETED SLOPE RTS. & CONST. EASE. PER. CO. # 6076	11-5-83	DEM	LWB
32	13, 23, 14	PARCEL #17 HENATH, REVISED 12,000 SF± FROM REMAINDER TO TAKE COLUMN & ADDED TOTAL. ADDED "ACQUIRED UNECONOMIC REMAINDER", DELETED DRAINAGE RTS. PER. CO. # 6097	11-5-83	DEM	LWB
33	14, 25, 24	PARCEL #14 BOWNETT, REVISED 1030 AT FROM REMAINDER TO TAKE COLUMN & ADDED "ACQUIRED UNECONOMIC REMAINDER", DELETED TOTAL PER. CO. # 6098 Plans Given to Dept. 12-19-83	12-5-83	DEM	LWB
34	19, 18, 8	PARCEL #18 ST. OF VT. LESSOR LAMOLLE VALLEY - LESSEE, REVISED TAKING I. REL. PER. CO. # 6228	6-19-84	B.A.M.	LWB
35	15A, 11	PARCEL #26 PARKER, ADDED 16A + REVISED LOCATION OF SPRING RT. & WATER LINE + ADDED 411 RT. - I. AT STA. 1617+40 PER. CO. # 6260	8-7-84	DEM	LWB

MADE BY: B.A.M. DATE: 5/11/82
CHECKED BY: J.D.P. DATE: 5/11/82

DR. RT. - DRAINAGE RIGHT
DIT. RT. - DITCHING RIGHT
CH. RT. - CHANNEL RIGHT
DRIVE RT. - DRIVE RIGHT
CHUR. RT. - CHURCH RIGHT
DEM. - DEMOLITION OR REMOVAL
W - WATER SOURCES

PRESENT R.O.W.
--- TAKING WITHOUT ACCESS
--- TAKING WITHOUT ACCESS ALONG PROPERTY LINES
--- TAKING WITH ACCESS
(P) - PERMANENT EASEMENT
(T) - TEMPORARY EASEMENT

LEGEND
--- CONST. EASE. --- CONST. EASEMENT
--- SLOPE RIGHTS
--- PROPERTY LINE
--- TOP OF CUT
--- TOP OF SLOPE

APPROVED: Thomas B. Moore DATE: 5-25-82
CHIEF OF PLANS & FILES

SEP 12 1986

PROJECT: DANVILLE
NO. F 028-3 (5)
SHEET 8 OF 33

STATE OF VERMONT
AGENCY OF TRANSPORTATION
RIGHT-OF-WAY PLANS
DETAIL SHEET

TABLE OF PROJECT PROPERTY ACQUISITION

PARCEL NO.	GRANTOR	SHEET NO.	BEGINNING STATION	ENDING STATION	TAKING	REM.	RIGHTS	TITLE TAKEN	DATE	TOWN OR CITY RECORDED	DK.	PG.	REMARKS
10A	McGUSKER, JAMES J. JR.	18	1601 + 40 RT. 1601 + 57 LT. 1605 + 14 RT.	1611 + 88 LT. 1612 + 20 LT. 1611 + 10 RT.	5.40 A± 20.80 A±	2.90 A±		CORREC. W.D.	1-4-84	DANVILLE	85	229-31	ACQUIRED UNECONOMY REMAINDER
10B		18	1601 + 37 RT.	1605 + 14 RT.	0.14 A±		ALL R. T. & I.						HWY. EASE. US 2
10C		18	RELOC. US 2 9+22 LT. RELOC. US 2 11+25 LT. RELOC. US 2 11+90 LT. RELOC. US 2 14+10 LT. RELOC. US 2 14+35 LT. RELOC. US 2 14+35 LT. RELOC. US 2 14+50 LT. RELOC. US 2 14+60 LT.	RELOC. US 2 17+55 LT. RELOC. US 2 15+10 LT. RELOC. US 2 13+60 LT. RELOC. US 2 14+90 LT. RELOC. US 2 14+50 LT. RELOC. US 2 14+50 LT.	0.48 A± 20.62 A±	2.90 A±	ALL R. T. & I. CONST. EASE. (T) SLOPE (P) SLOPE (P) DRIVE (T) CULVERT (P) CULVERT (P)	(0.08 A±) (0.04 A±) (0.01 A±)					HWY. EASE. US 2 NOW - LIMITED ACCESS (3700 S.E±) (1705 S.E±) (646 S.E±) 14" GRAVEL W.P. 00.56 DRIVE PERMIT DATE-
11A	FENOFF, STEVE E. & JOANNE M.	18, 19	1611 + 10 RT. 1611 + 40 RT. 1614 + 05 LT. 1614 + 65 LT. 1618 + 40 RT. 1611 + 10 RT.	1618 + 55 RT. 1612 + 55 RT. 1615 + 60 RT. 1618 + 55 RT.	3.20 A± 12.80 A±		CONST. EASE. (T) ALL R. T. & I. ALL R. T. & I. DRAINAGE (P)	(0.01 A±)	W.D.	DANVILLE			(420 S.E±) SPRING WATERLINE
11B	DELETED												NOW PARCEL 4A
11C	DELETED												NOW PARCEL 4B

(CON'T.)

TABLE OF REVISIONS

REVISION NO.	SHEET NO.	DESCRIPTION OF REVISION	DATE	MADE BY	APPROVED BY

MADE BY: B.A.M. DATE 5/12/82
CHECKED BY: J.D.P. DATE 5/12/82

DR. RT. -- DRAINAGE RIGHT
DIT. RT. -- DITCHING RIGHT
CH. RT. -- CHANNEL RIGHT
DRIVE RT. -- DRIVE RIGHT
CUL. RT. -- CULVERT RIGHT
D -- DEMOLITION OR
REMOVAL
W -- WATER SOURCES

-----	PRESENT R.O.W.
---//---	TAKING WITHOUT ACCESS
---// P L---	TAKING WITHOUT ACCESS ALONG PROPERTY LINES
-----	TAKING WITH ACCESS
(P)	PERMANENT EASEMENT
(T)	TEMPORARY EASEMENT

LEGEND

-----CONST EASE-----	CONST'EASEMENT
-----SR-----SR-----	SLOPE RIGHTS
-----P-----P-----	PROPERTY LINE
-----△-----△-----△-----	TOP OF CUT
-----○-----○-----○-----	TOE OF SLOPE

APPROVED Thomas E. Mayo DATE 5-25-82
CHIEF OF PLANS & TITLES

SEP 12 1986

PROJECT DANVILLE

NO. F 028-3 (5)

SHEET 9 OF 38

STATE OF VERMONT
AGENCY OF TRANSPORTATION
RIGHT-OF-WAY PLANS
DETAIL SHEET

TABLE OF PROJECT PROPERTY ACQUISITION

PARCEL NO.	GRANTOR	SHEET NO.	BEGINNING STATION	ENDING STATION	TAKING	REM.	RIGHTS	TITLE TAKEN	DATE	TOWN OR CITY RECORDED	BK.	PG.	REMARKS
11D	DELETED												NOW PARCEL 4C
11E	DELETED												NOW PARCEL 4D
12A	CLARK, DAVID T & JOAN B.	16, 19	1614+44 LI 1619+50 RL 1612+20 LI 1618+55 RL 1619+20 LT	1626+54 LT TH 41 28+20 LI 1625+15 RL 1619+70 LT	5.12 A±	22.40 A± 2.20 A±	DRAINAGE (P) CONST. EASE. (T)	W.D. (0.02 A±)	12-1-83	DAYVILLE	85	129-131	(736 S.F.±)
12B		19	1626+10 LI 1625+70 LI 1625+80 LI TH 41 27+00 LI TH 41 27+95 LI TH 41 27+50 LI	TH 41 28+20 LI TH 41 28+63 LI TH 41 28+55 LI	0.10 A±		CONST. EASE. (T) SLOPE (T) DRAINAGE (?) DRIVE (T)	(0.05 A±) (0.08 A±)					NOW - LIMITED ACCESS (2200 S.F.±) (3600 S.F.±) SUGAR HOUSE
12C		19	1625+15 RL	1626+85 LI	0.16 A±		ALL R. T. & I.						HWY. EASE. TH. 41
12D		19	FRONT RD. 46+00 E	1625+44 RL	0.10 A±		ALL R. T. & I.						HWY. EASE. TH. 41 NOW - LIMITED ACCESS
12E		19	1626+54 LI	1626+85 LI TOTAL	0.01 A± 5.49 A±	24.60 A±	ALL R. T. & I.						(285 S.F.±) HWY. EASE. TH. 41 NOW - LIMITED ACCESS
13A	WANCE, WENDALL O. WANCE, VELMA M.	19, 21	1626+27 RL 1628+70 LT ±	1632+73 RL 1630+95 RL ±	2.49 A±		ALL R. T. & I.	W.D.		DAYVILLE			WATERLINE

(CONT.)

TABLE OF REVISIONS

REVISION NO.	SHEET NO.	DESCRIPTION OF REVISION	DATE	MADE BY	APPROVED BY

DR. RT. - DRAINAGE RIGHT
DT. RT. - DITCHING RIGHT
CH. RT. - CHANNEL RIGHT
DRIVE RT. - DRIVE RIGHT
CL. RT. - CULVERT RIGHT
(U) - DEMOLITION OR
REMOVAL
(W) - WATER SOURCES

-----	PRESENT	R.O.W.
---//---//---	TAKING	WITHOUT ACCESS
---//---//---	<u>P</u>	
---	<u>L</u>	
---	TAKING	WITHOUT ACCESS ALONG PROPERTY LINES
-----	TAKING	WITH ACCESS
(P)	PERMANENT	EASEMENT
(T)	TEMPORARY	EASEMENT

LEGEND

---	CONST EASE	CONSTEASEMENT
---SR---	SR---	SLOPE RIGHTS
---P---	---P---	PROPERTY LINE
---△---	---△---	TOP OF CUT
---○---	---○---	TOE OF SLOPE

APPROVED Thomas E. Meyer DATE 5-25-82
CHIEF OF PLANS & TITLES

SEP 12 1986
PROJECT DANVILLE
NO. F 028 - 3 (5)
SHEET 10 OF 3

STATE OF VERMONT
AGENCY OF TRANSPORTATION
RIGHT-OF-WAY PLANS
DETAIL SHEET

TABLE OF PROJECT PROPERTY ACQUISITION

PARCEL NO.	GRANTOR	SHEET NO.	BEGINNING STATION	ENDING STATION	TAKING	REM.	RIGHTS	TITLE TAKEN	DATE	TOWN OR CITY RECORDED	BK.	PG.	REMARKS
13B		21, 22	1632+86 LI 1634+10 LI 1634+35 LI 1649+50 LI 1648+50 RI 1659+00 LI TH 4128+20 LI FRONT RD. 50+23 RT. 1632+75 LI 1640+50 LI	1659+62 LI 1635+55 LI 1635+25 LI 1649+70 RI 1659+64 LI 1659+54 RI 1633+00 LI 1641+50 LI	14.05 Ac	145.97 Ac 49.54 Ac	CONST. EASE. (T) SLOPE (P) DRAINAGE (P) CONST. EASE. (T) DRAINAGE (P) DRIVE (T) DRIVE (T)	(0.02 Ac) (335 S.F.) (325 S.F.) RELEASE RELEASE				(1100 S.F.)	
13C		18, 20, 21	FRONT RD. 50+23 RT. TH 4113+25 RT. TH 4113+00 RT. TH 4118+50 RI FRONT RD. 54+10 RI FRONT RD. 57+05 RT. 1630+85 RT. FRONT RD. 57+18 RT. FRONT RD. 55+45 RT.	FRONT RD. 59+00 RT. TH 4118+50 RT. FRONT RD. 59+10 RT. FRONT RD. 54+85 RT. FRONT RD. 58+35 RT. FRONT RD. 56+15 RT. FRONT RD. 57+68 RT. FRONT RD. 55+85 RT.	1.70 Ac		SLOPE (T) CONST. EASE. (T) SLOPE (P) CULVERT & DRAINAGE (P) CONST. EASE. (T) ALL R. T. & I. ALL R. T. & I. SLOPE (P)	(0.20 Ac) (0.35 Ac) (0.50 Ac) (0.01 Ac) (80 S.F.)				NON-LIMITED ACCESS WATERLINE WATERLINE	
13D		19, 20	1626+65 LI TH 4128+20 LI TH 4128+55 LI TH 4128+40 RT. TH 4128+45 LI	TH 4130+86 LI TH 4134+45 LI TH 4138+30 LI TH 4128+45 LI TH 4128+47 LI	0.22 Ac		SLOPE (T) CONST. EASE. (T) ALL R. T. & I.	(0.30 Ac) (0.19 Ac)					NON-LIMITED ACCESS WATERLINE WATERLINE
13E		20	TH 4139+00 RT. TH 4129+45 RT. TH 4129+00 RT. TH 4132+40 RT. TH 4132+50 RT.	TH 4133+80 RT. TH 4134+80 RT. TH 4134+91 RT. TH 4132+50 RT.	0.12 Ac		CONST. EASE. (T) SLOPE (P) CULVERT (P) DRAINAGE (P)	(0.12 Ac) (0.16 Ac)					NON-LIMITED ACCESS
13F		20	TH 4132+48 LI TH 4134+55 LI TH 4136+50 LI TH 4137+85 LI	TH 4136+86 LI TH 4138+20 LI TH 4138+10 LI	0.20 Ac		SLOPE (T) CULVERT (P) SLOPE (T)	(0.11 Ac) (60 S.F.)					NON-LIMITED ACCESS
13G		20	TH 4136+33 RT. TH 4125+70 RT. TH 4135+90 RT. TH 4136+50 RT. TH 4135+25 RT.	TH 4139+00 RT. TH 4135+30 RT. TH 4138+15 RT.	0.05 Ac		CONST. EASE. (T) SLOPE (P) CULVERT & DRAINAGE (P) DRIVE (T)	(0.06 Ac) (0.07 Ac)					(2100 S.F.) NON-LIMITED ACCESS (2700 S.F.) (3230 S.F.)
(CONT.)													

TABLE OF REVISIONS

REVISION NO.	SHEET NO.	DESCRIPTION OF REVISION	DATE	MADE BY	APPROVED BY

MADE BY: B.A.W. DATE 5/17/82
CHECKED BY: J.D.P. DATE 5/17/82

DR. RT. — DRAINAGE RIGHT
 DIT. RT. — DITCHING RIGHT
 CH. RT. — CHANNEL RIGHT
 DRIVE RT. — DRIVE RIGHT
 CUL. RT. — CULVERT RIGHT
 (D) — DEMOLITION OR
 REMOVAL
 (W) — WATER SOURCES

-----	PRESENT	R.O.W.
---/---	TAKING	WITHOUT ACCESS
---/--- P ---/---	TAKING	WITHOUT ACCESS ALONG PROPERTY LINES
-----	TAKING	WITH ACCESS
(P)	PERMANENT	EASEMENT
(T)	TEMPORARY	EASEMENT

LEGEND

-----CONST EASE-----	CONST EASEMENT
-----SR-----SR-----	SLOPE RIGHTS
-----P-----P-----	PROPERTY LINE
-----△-----△-----△-----	TOP OF CUT
-----○-----○-----○-----	TOE OF SLOPE

APPROVED Thomas P. Meyer DATE 5-25-82
CHIEF OF PLANS & TITLES

SEP 12 1986

PROJECT DANVILLE

NO. F 028 - 3 (5)

SHEET (11) OF 38

STATE OF VERMONT
AGENCY OF TRANSPORTATION
RIGHT-OF-WAY PLANS
DETAIL SHEET

TABLE OF PROJECT PROPERTY ACQUISITION

PARCEL NO.	GRANTOR	SHEET NO.	BEGINNING STATION	ENDING STATION	TAKING	REM.	RIGHTS	TITLE TAKEN	DATE	TOWN OR CITY RECORDED	BK.	PG.	REMARKS
13H	PARCEL 13 CONTINUED FROM PREVIOUS SHEET DELETED												
13I	VANCE, WENDALL O. & VELISA M.	21	1632+45 LI	1633+31 RT	0.28 Ac		ALL R T & I.						HWY EASE TH 40
13J		19	1626+23 LI	1627+12 LI	0.08 Ac		ALL R T & I.						(3300 SF±) HWY EASE TH 41
13K		19, 20	1625+65 LI TH 4128+32 RT± TH 4130+72 LI	TH 4135+42 LI TH 4128+40 RT± TH 4131+80 LI	0.70 Ac		ALL R T & I. ALL R T & I. DITCH (P)						HWY EASE TH 41 NON-LIMITED ACCESS WATERLINE
13L		20	TH 4134+91 RT	TH 4139+00 RT	0.48 Ac		ALL R T & I.						HWY EASE TH 40 NON-LIMITED ACCESS
13M		20	TH 4116+50 LI	TH 4113+00 R	0.21 Ac		ALL R T & I.						HWY EASE US 2 NON-LIMITED ACCESS
13N		21	1632+80 RT FRONT RD 57+88 RT FRONT RD 58+50 LI SPUR 61+76 RT TH 4119+50 RT TH 4121+00 RT	FRONT RD 59+00 LI FRONT RD 58+30 LI± FRONT RD 58+50 LI TH 4113+00 RT	0.28 Ac		ALL R T & I. ALL R T & I. DRIVE (T) CULVERT, DITCH & DRAINAGE (P) CULVERT, & DRAINAGE (P)						HWY EASE TH 40 NON-LIMITED ACCESS WATERLINE
13-O		19, 20			1.10 Ac								
13P		20	SPUR 61+76 RT TOTAL	TH 4116+50 LI TOTAL	0.09 Ac 22.04 Ac	195.51 Ac	ALL R T & I.						(3700 SF±) HWY EASE U.S. RTE. 2
14A	BLAY, HAZEL M. & NORMAN R.	19, 20	TH 4119+76 LI TH 4118+35 LI TH 4118+50 LI TH 4118+55 LI TH 4121+00 LI 1617+32 LI± TH 4121+50 LI	TH 4121+50 LI TH 4121+73 LI TH 4121+73 LI TH 4121+73 LI 1618+75 RT± TH 4119+76 LI	0.20 Ac		COMST. EASE (T) (0.08 Ac) DITCH (P) SLOPE (T) (0.14 Ac) CULVERT (P) ALL R T & I.	W.D.	10-6-83	DANVILLE	84	451-53	NON-LIMITED ACCESS (3700 SF±) WATERLINE
14B		20	SPUR 61+76 RT SPUR 62+13 RT TOTAL	SPUR 62+50 RT TOTAL	0.04 Ac 0.24 Ac	2.60 Ac	ALL R T & I. DRIVE (T)						(1850 SF±) HWY EASE US 2 NON-LIMITED ACCESS 14" GRAVEL MP 0.98 DRIVE PERMIT DATE:

TABLE OF REVISIONS

REVISION NO.	SHEET NO.	DESCRIPTION OF REVISION	DATE	MADE BY	APPROVED BY

MADE BY: RAM DATE 5/18/82
CHECKED BY: JDP DATE 5/18/82

DR. RT. -- DRAINAGE RIGHT
DIT. RT. -- DITCHING RIGHT
CH. RT. -- CHANNEL RIGHT
DRIVE RT. -- DRIVE RIGHT
CUL. RT. -- CULVERT RIGHT
D -- DEMOLITION OR
REMOVAL
W -- WATER SOURCES

-----	PRESENT	R.O.W.
---//---	TAKING	WITHOUT ACCESS
---// ^P _L ---	TAKING	WITHOUT ACCESS ALONG PROPERTY LINES
-----	TAKING	WITH ACCESS
{ P }	PERMANENT	EASEMENT
{ T }	TEMPORARY	EASEMENT

LEGEND

-----CONST.EASE-----	CONST. EASEMENT
-----SR-----SR-----	SLOPE RIGHTS
-----P _L -----P _L -----	PROPERTY LINE
-----Δ-----Δ-----Δ-----	TOP OF CUT
-----○-----○-----○-----	TOE OF SLOPE

APPROVED Thom F. May DATE 5-25-82
CHIEF OF PLANS & TITLES

SEP 12 1986

PROJECT DANVILLE

NO. F 028 - 3 (5)

SHEET 12 OF 38

STATE OF VERMONT
AGENCY OF TRANSPORTATION
RIGHT-OF-WAY PLANS
DETAIL SHEET

TABLE OF PROJECT PROPERTY ACQUISITION

[illegible]

TABLE OF REVISIONS

REVISION NO.	SHEET NO.	DESCRIPTION OF REVISION	DATE	MADE BY	APPROVED BY

DR RT - DRAINAGE RIGHT
DI RT - DITCHING RIGHT
CH RT - CHANNEL RIGHT
DRIVE RT - DRIVE RIGHT
CUL RT - CULVERT RIGHT
(D) - DEMOLITION OR
REMOVAL
(W) - WATER SOURCES

-----	PRESENT	R.O.W.
---//---//---	TAKING WITHOUT ACCESS	
---// P L---	TAKING WITHOUT ACCESS ALONG PROPERTY LINES	
-----	TAKING WITH ACCESS	
(P)	PERMANENT EASEMENT	
(T)	TEMPORARY EASEMENT	

LEGEND

-----CONST EASE-----	CONST EASEMENT
-----SR-----SR-----	SLOPE RIGHTS
-----P-----P-----	PROPERTY LINE
-----Δ-----Δ-----Δ-----	TOP OF CUT
-----○-----○-----○-----	TOE OF SLOPE

APPROVED Thomas P. Mayo DATE 5-25-82
CHIEF OF PLANS & TILES

SEP 12 1986

PROJECT DANVILLE

NO F 028-3(5)

SHEET 13 OF 38

STATE OF VERMONT
AGENCY OF TRANSPORTATION
RIGHT-OF-WAY PLANS
DETAIL SHEET

TABLE OF PROJECT PROPERTY ACQUISITION

[illegible]

TABLE OF REVISIONS

REVISION NO.	SHEET NO.	DESCRIPTION OF REVISION	DATE	MADE BY	APPROVED BY

MADE BY: B.A.M. DATE 5-18-82
CHECKED BY: J.O.P. DATE 5-18-82

DR. RT - DRAINAGE RIGHT
DIT. RT - DITCHING RIGHT
CH. RT - CHANNEL RIGHT
DRIVE RT - DRIVE RIGHT
CUL. RT - CULVERT RIGHT
D - DEMOLITION OR
REMOVAL
W - WATER SOURCES

-----	PRESENT R.O.W.
/// ----- ///	TAKING WITHOUT ACCESS
/// $\frac{P}{L}$ ----- ///	TAKING WITHOUT ACCESS ALONG PROPERTY LINES
-----	TAKING WITH ACCESS
(P)	PERMANENT EASEMENT
(T)	TEMPORARY EASEMENT

LEGEND

-----CONST EASE-----	CONST EASEMENT
-----SR-----SR-----	SLOPE RIGHTS
-----P-----P-----	PROPERTY LINE
-----△-----△-----△-----	TOP OF CUT
-----○-----○-----○-----	TOE OF SLOPE

APPROVED Thomas R. Meyer DATE 5-25-82
CHIEF OF PLANS & INT. S.

PROJECT DANVILLE
NO. F028-3(5)
SHEET 14 OF 38

SEP 12 1986

STATE OF VERMONT
AGENCY OF TRANSPORTATION
RIGHT-OF-WAY PLANS
DETAIL SHEET

TABLE OF PROJECT PROPERTY ACQUISITION

PARCEL NO.	GRANTOR	SHEET NO.	BEGINNING STATION	ENDING STATION	TAKING	REM.	RIGHTS	TITLE TAKEN	DATE	TOWN OR CITY RECORDED	BK.	PG.	REMARKS
21C		19	FR. RD. 48+00 LT.	1825+73 RT.	0.21 A±		ALL R.T. & I.						NON LIMITED ACCESS HWY. EASE. TH 4
21D		19, 20	1826+54 LT.	TH 41 35+74 LT.	0.71 A±		ALL R.T. & I.						NON LIMITED ACCESS HWY. EASE. TH 4
21E		20	TH 41 34+91 RT.	TH 41 39+00 RT.	0.48 A±		ALL R.T. & I.						NON LIMITED ACCESS HWY. EASE. TH 4
21F		21	1632+45 LT.	1633+31 RT.	0.28 A±		ALL R.T. & I.						HWY. EASE. TH 40
21G		21	1632+80 RT.	FR. RD. 59+00 LT.	0.28 A±		ALL R.T. & I.						NON LIMITED ACCESS HWY. EASE. TH 4
				TOTAL	2.41 A±								
22	MATTE, MADELINE	17, 18	1590+40 RT. 1594+85 LT.± RELOC. US 26+12 RT. RELOC. US 25+15 RT.	1587+27 RT.±			DRAINAGE (P) ALL R.T. & I. DRAINAGE (P)	W.D.	12-19-83	DANVILLE	95	174-175	WATERLINE DRIVE
23	KING, SHIRLEY A. FRYE, MARY E.	18	RELOC. US 28+58 RT. RELOC. US 28+58 RT.	RELOC. US 28+80 RT. RELOC. US 29+34 RT.			CULVERT & DRAINAGE (P) DITCH (P)	W.D.O.E. (0.08 A±)		DANVILLE			(3972 SE±)
24	NEW ENGLAND TEL & TEL CO.												UTILITY
25	CENTRAL VERMONT PUBLIC SERVICE CORP.												UTILITY
26	PARKER, LESLIE A. & SHIRLEY A. PARKER, LOUIA H. (LIFE ESTATE)	18, 19	1614+65 LT. 1614+65 LT.±	1615+60 RT.±			ALL R.T. & I. ALL R.T. & I.	W.D.		DANVILLE			SPRING WATERLINE
26A		19	1617+40 RT.±				ALL R.T. & I.	W.D.					SPRING & WATERLINE
27A	UNIVERSITY OF VERMONT & STATE AGRICULTURAL COLLEGE	21	1632+20 RT.±	1632+73 RT.±			ALL R.T. & I.	W.D.O.E.		DANVILLE			OIL, GAS, & MINERAL RTS. (0.16 A±)
27B		21	1632+17 RT.±	FR. RD. 56+00 RT.±			ALL R.T. & I.						OIL, GAS, & MINERAL RTS. (0.21 A±)
27C		21	1632+45 LT.±	1633+31 RT.±			ALL R.T. & I.						OIL, GAS, & MINERAL RTS. (0.28 A±)
27D		21	1632+80 RT.±	FR. RD. 59+00 LT.±			ALL R.T. & I.						OIL, GAS, & MINERAL RTS. (0.28 A±)
27E		21, 22	1632+96 LT.±	1659+67 LT.±			ALL R.T. & I.						OIL, GAS, & MINERAL RTS. (14.10 A±)

TABLE OF REVISIONS

REVISION NO.	SHEET NO.	DESCRIPTION OF REVISION	DATE	MADE BY	APPROVED BY

MADE BY: B.A.M. DATE 5-20-82
CHECKED BY: J.D.P. DATE 5-20-82

DR. RT. — DRAINAGE RIGHT
DIT. RT. — DITCHING RIGHT
CH. RT. — CHANNEL RIGHT
DVE. RT. — DRIVE RIGHT
CL. RT. — CLVERT RIGHT
D — DEMOLITION OR
REMOVAL
W — WATER SOURCES

-----	PRESENT R.O.W.
---//---	TAKING WITHOUT ACCESS
---// P L---	TAKING WITHOUT ACCESS ALONG PROPERTY LINES
-----	TAKING WITH ACCESS
(P)	PERMANENT EASEMENT
(T)	TEMPORARY EASEMENT

LEGEND

---	CONST EASE	---	CONST EASEMENT
---	SR	---	SLOPE RIGHTS
---	P	---	PROPERTY LINE
---	Δ	---	TOP OF CUT
---	○	---	TOE OF SLOPE

APPROVED Thomas P. Mayo DATE 3-25-82
CHIEF OF PLANS & FILES

SEP 12 1986
PROJECT DANVILLE
NO. F028-3(5)
SHEET 15A OF 38

STATE OF VERMONT
AGENCY OF TRANSPORTATION
RIGHT-OF-WAY PLANS
DETAIL SHEET

TABLE OF PROJECT PROPERTY ACQUISITION

PARCEL NO.	GRANTOR	SHEET NO.	BEGINNING STATION	ENDING STATION	TAKING	REM	RIGHTS	TITLE TAKEN	DATE	TOWN OR CITY RECORDED	BK.	PG.	REMARKS
	RELINQUISHMENT NO. I	16-20	REV U.S. 2 11+75 CL	SPUR 60+26 CL									OLD U.S. 2
	RELINQUISHMENT NO. II	19, 20	T.H. 41 26+87 CL	T.H. 41 39+00 CL									RELOC. T.H. 41
	RELINQUISHMENT NO. III	19	FR. RD. 48+00 CL	FR. RD. 49+32 CL									FRONTAGE RD. & T.H. 41
	RELINQUISHMENT NO. IV	19, 21	FR. RD. 50+35 CL	FR. RD. 59+00 CL									FRONTAGE RD. & T.H. 41
	MAINTENANCE AGREEMENT AREA NO. 1	16	1574+00 LT.	1574+65 LT.									T.H. 39
	MAINTENANCE AGREEMENT AREA NO. 2	19	T.H. 41 25+90 CL	T.H. 41 26+87 CL									RELOC. T.H. 41
	MAINTENANCE AGREEMENT AREA NO. 3	16	REV U.S. 2 10+12 CL	REV U.S. 2 11+75 CL									RELOC. U.S. 2
	MAINTENANCE AGREEMENT AREA NO. 4	20	SPUR 60+86 CL	SPUR 60+12 CL									RELOC. U.S. 2
	MAINTENANCE AGREEMENT AREA NO. 5	19	FR. RD. 49+32 CL	FR. RD. 50+35 CL									FRONTAGE RD. & T.H. 41

TABLE OF REVISIONS

REVISION NO.	SHEET NO.	DESCRIPTION OF REVISION	DATE	MADE BY	APPROVED BY

MADE BY: D.E.W. DATE 8-12-82
CHECKED BY: F.J.W. DATE 8-12-82

DR. RT. -- DRAINAGE RIGHT
DIT. RT. -- DITCHING RIGHT
CH. RT. -- CHANNEL RIGHT
DRIVE RT. -- DRIVE RIGHT
CUL. RT. -- CULVERT RIGHT
⬡ -- DEMOLITION OR
REMOVAL
⬢ -- WATER SOURCES

_____	PRESENT	R.O.W.
---/---/---	TAKING	WITHOUT ACCESS
---/---/--- P L	TAKING	WITHOUT ACCESS ALONG PROPERTY LINES
_____	TAKING	WITH ACCESS
(P)	PERMANENT	EASEMENT
(T)	TEMPORARY	EASEMENT


LEGEND

-----CONST. EASE-----	CONST. EASEMENT
-----SR-----SR-----	SLOPE RIGHTS
-----P-----P-----	PROPERTY LINE
-----Δ-----Δ-----Δ-----	TOP OF CUT
-----○-----○-----○-----	TOE OF SLOPE

APPROVED Thomas P. Mayo DATE 8-12-82
CHIEF OF PLANS & FILES

SEP 12 1986

PROJECT DANVILLE
NO. F028-3(5)
SHEET (15B) OF 38

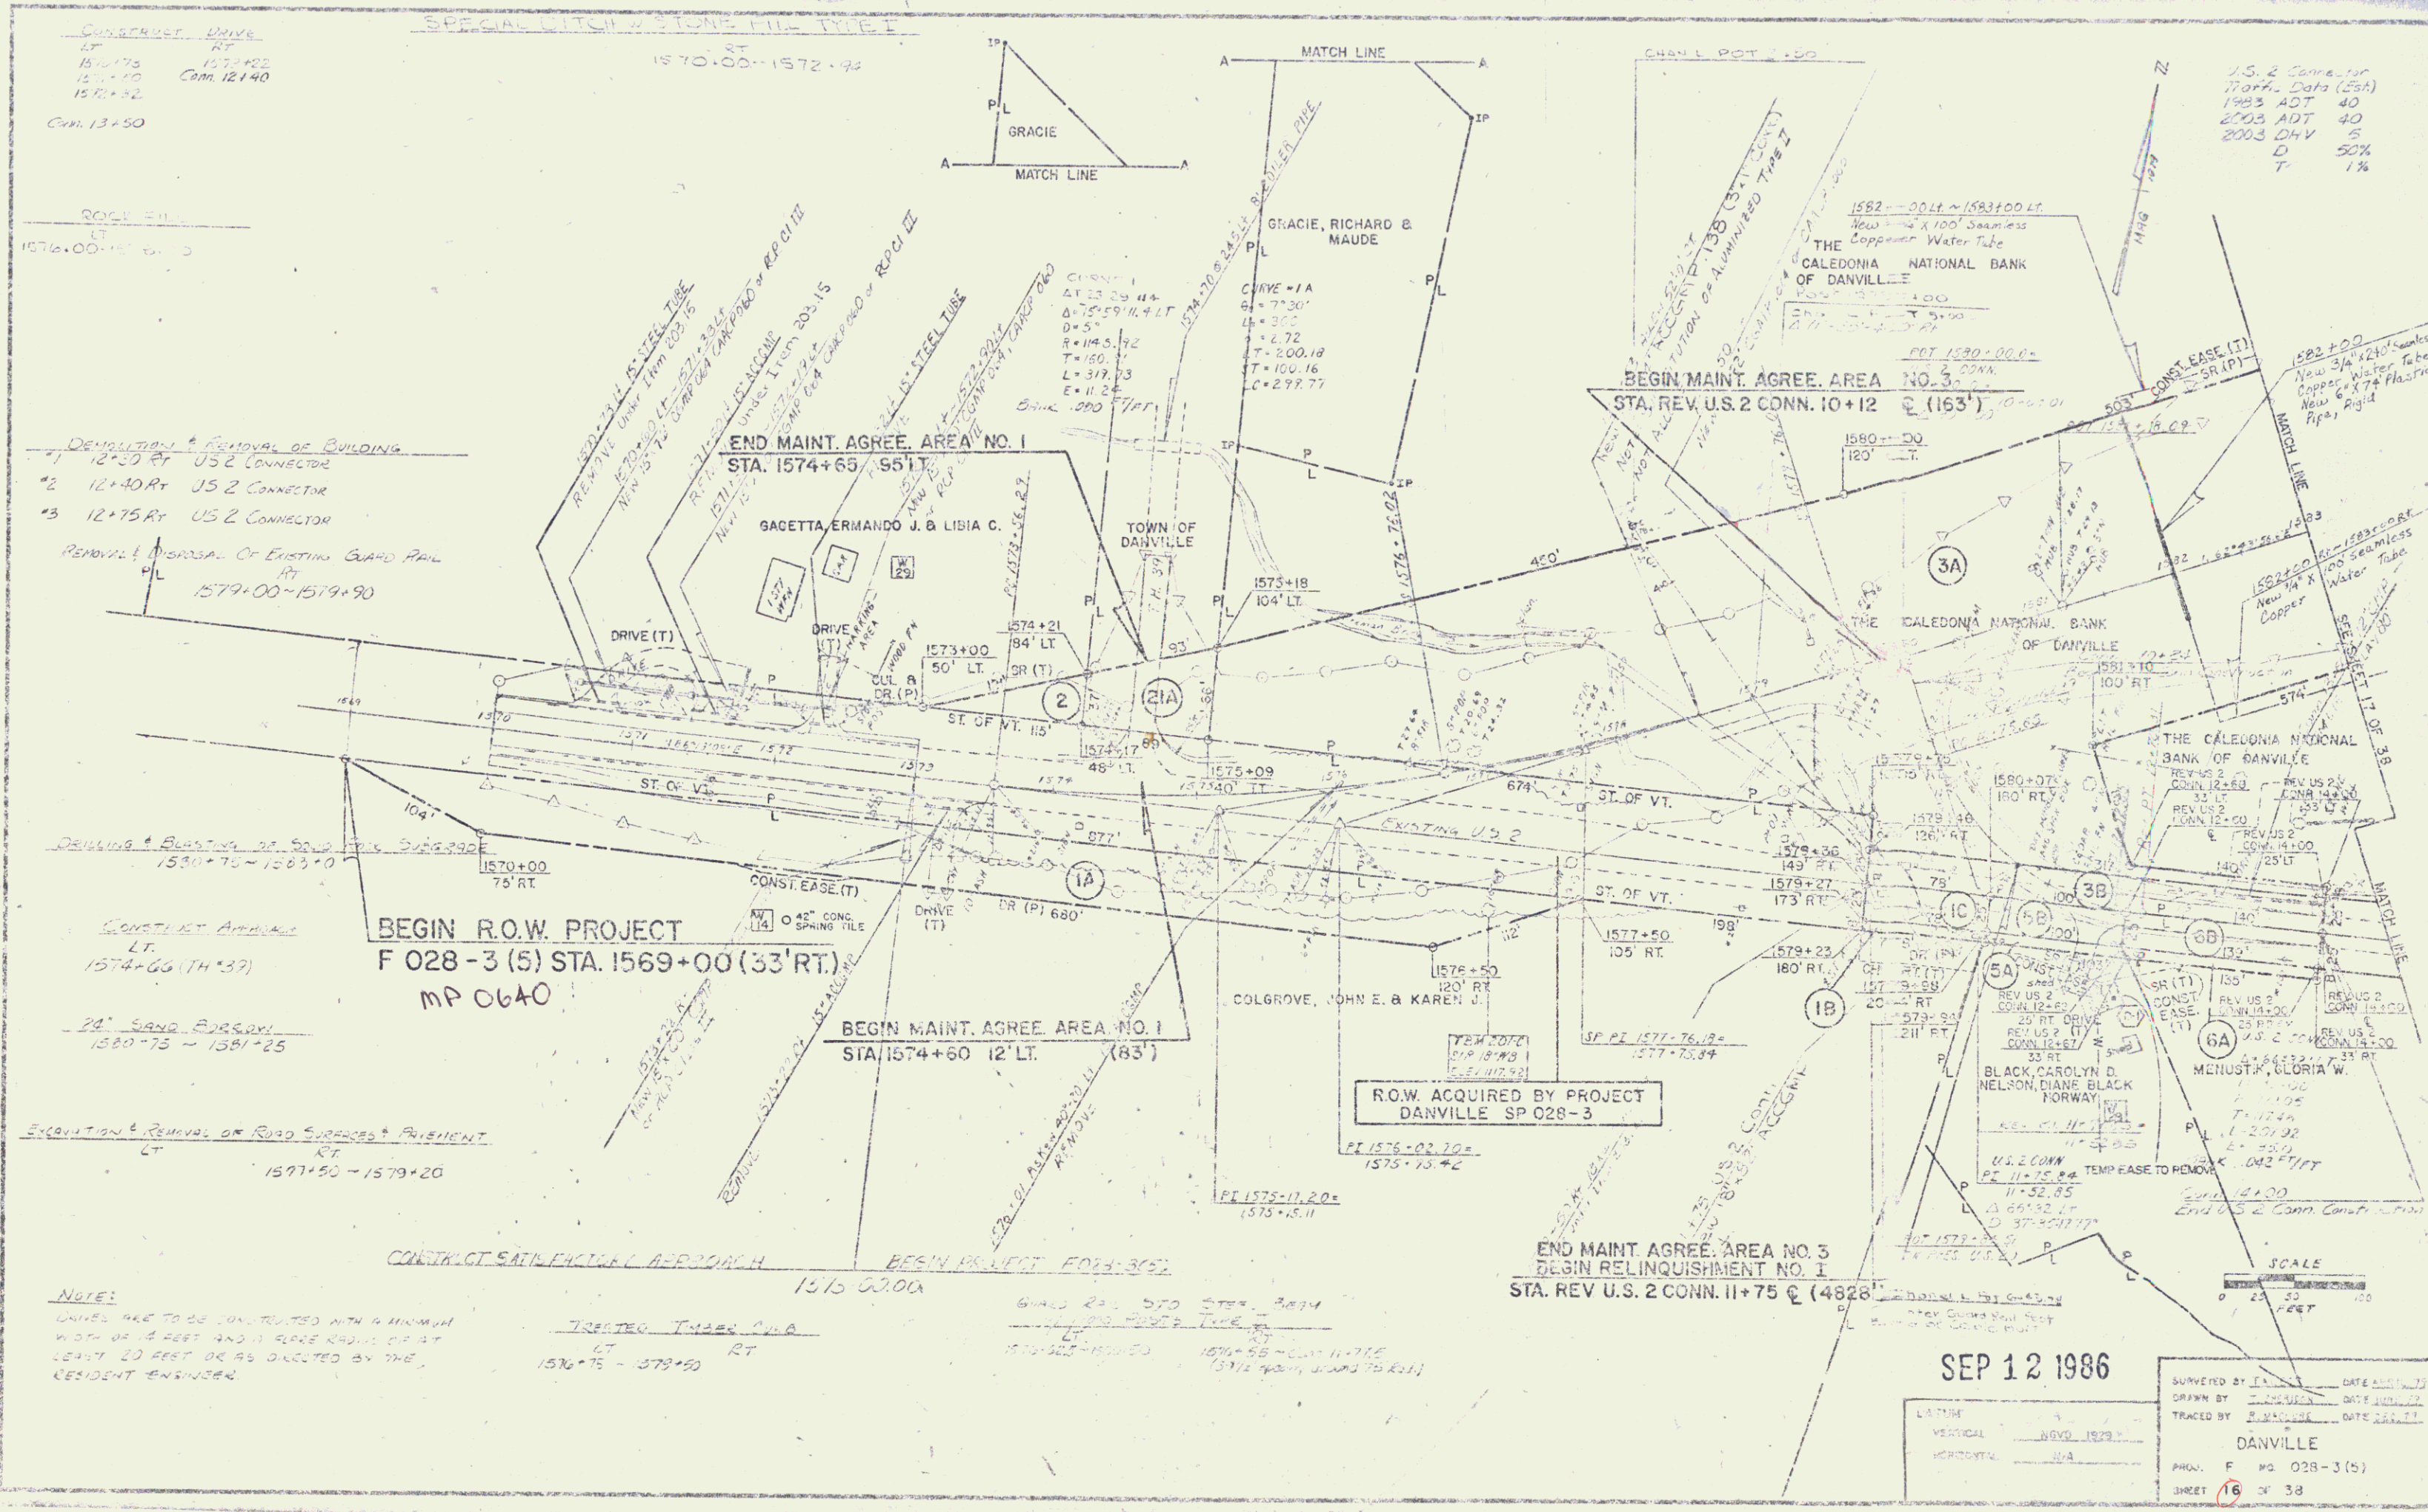

U.S. 2 Connector
1700' ADT (55%)
1983 ADT 40
2003 ADT 40
2003 OHV 5
D 50%
T 1%

SEP 12 1986

SURVEYED BY J. L. [illegible] DATE 8/1/86
DRAWN BY J. L. [illegible] DATE 8/1/86
TRACED BY J. L. [illegible] DATE 8/1/86
DANVILLE
PROJ. F 028-3 (5)
SHEET 16 OF 38

PART OF LAND CONVEYED TO THE STATE OF VERMONT
BY JAMES J. MCCUSKER, JR. BY CORRECTIVE WD DATED
JAN. 4, 1984 AND RECORDED IN BK. 65 PG. 229-231 IN
THE TOWN OF DANVILLE LAND RECORDS.

M.P. 0712

STATE OF VERMONT
TO
RICHARD CLARK

N/F
BELANGER

N/F
BELANGER

N/F
VANCE

N/F
CLARK

(20.8A±)

1601+57
140' LT.

1612+89
140' LT.

1600

1605

1032±

1610

1615

← TO DANVILLE

TO ST. JOHNSBURY →

(NO LEGAL ACCESS)

SCALE 1" = 200'





REF. F 028-3 (5) SHEET B OF F

STATE OF VERMONT
AGENCY OF TRANSPORTATION

TOWN OF DANVILLE (18A)


SCALE 1" = 200' DATE 5-3-89 DRAWN BY A.S.J.

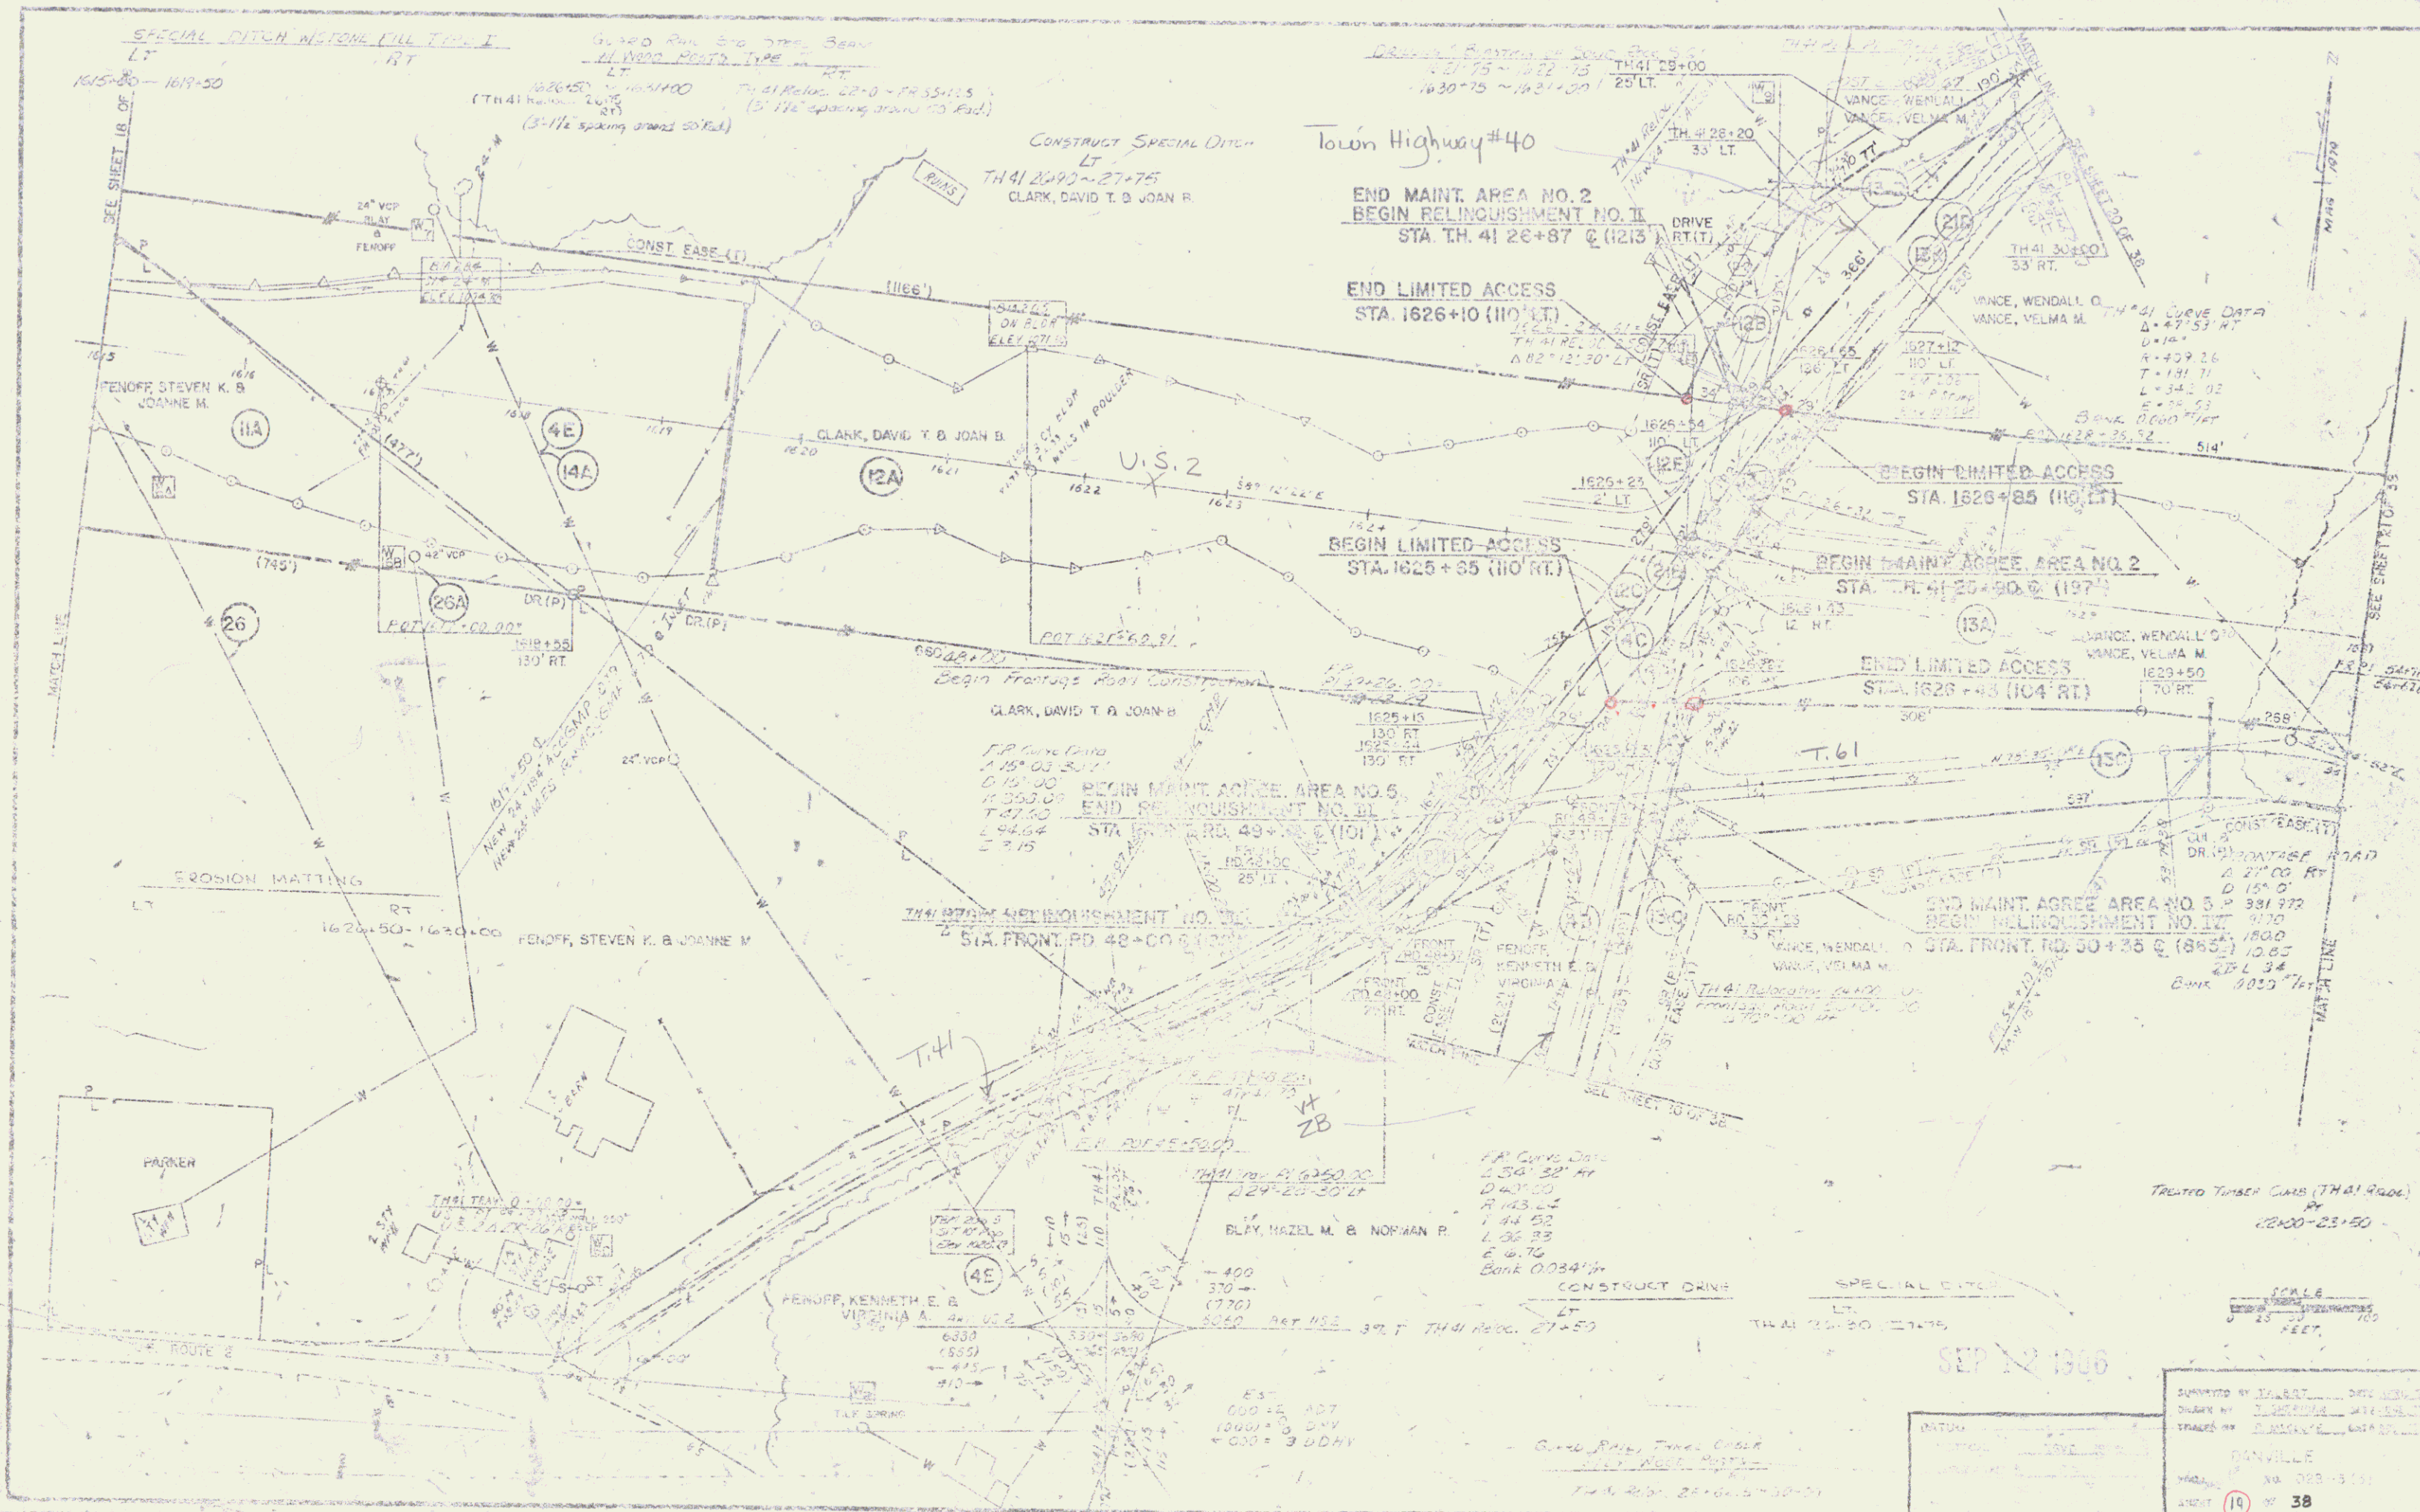


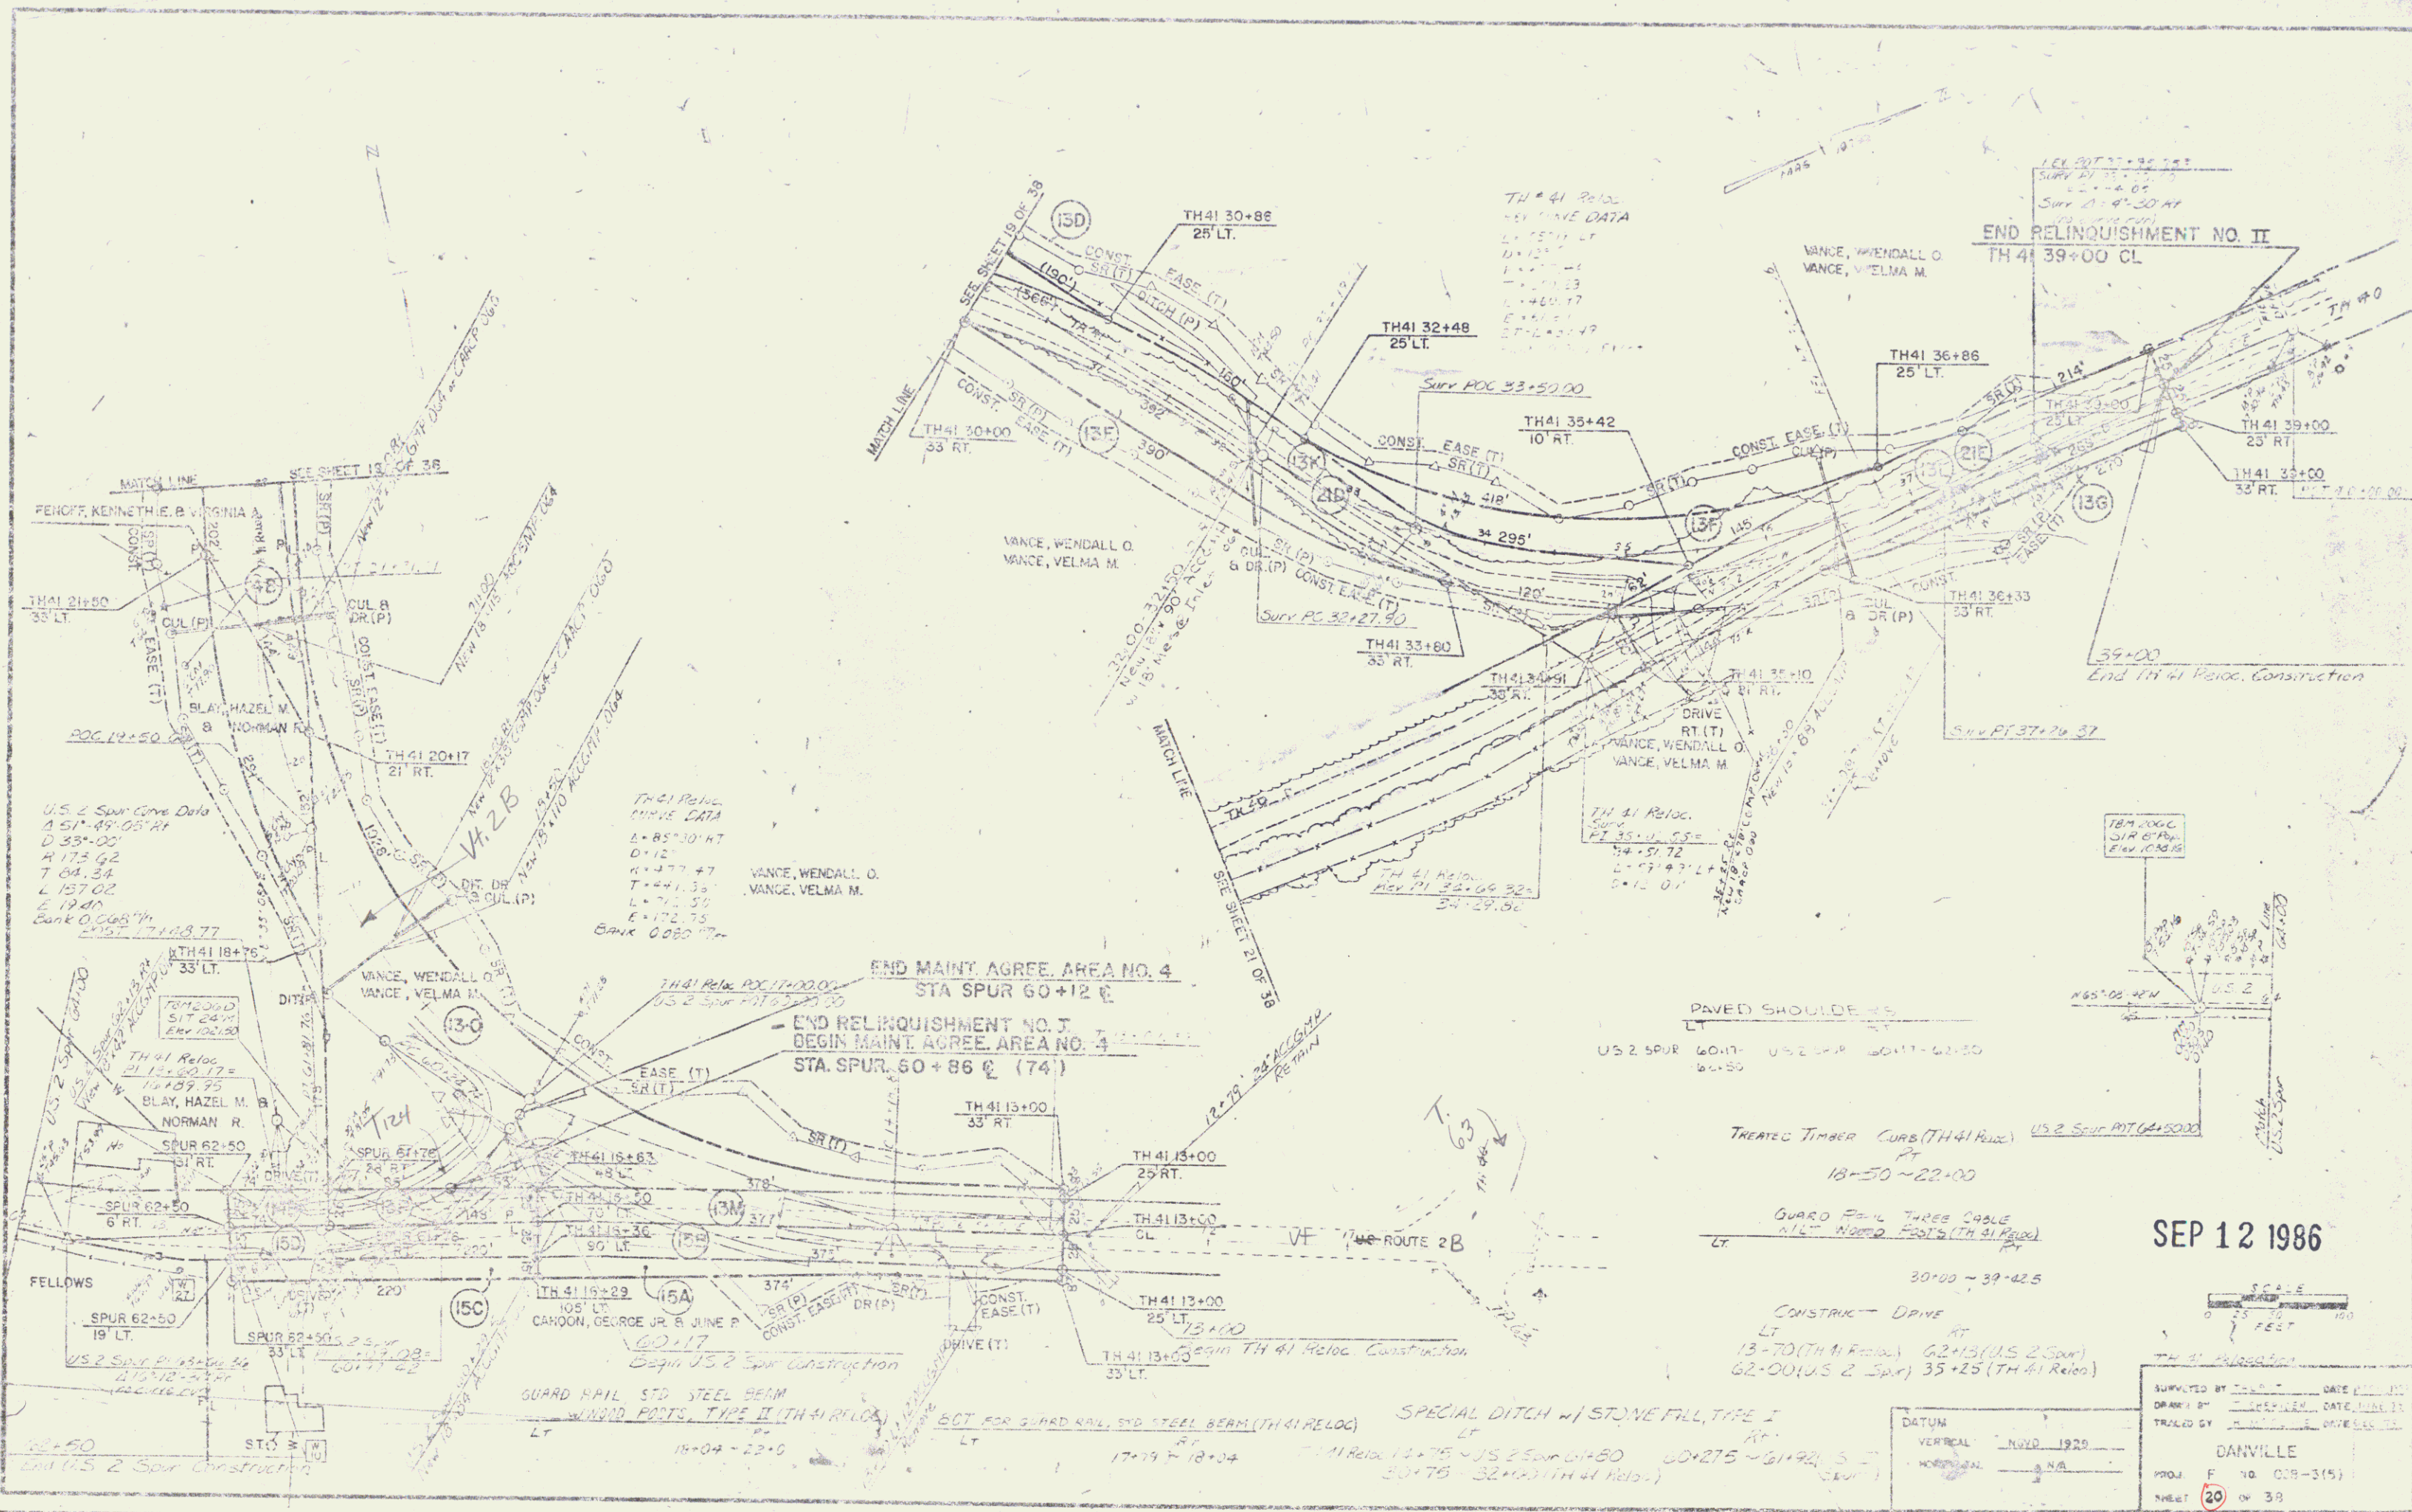


SEP 12 1986

SURVEYED BY	DATE
DRAWN BY	DATE
TRACED BY	DATE
DANVILLE	
PROJ. F 10. 028-3(5)	
SHEET 20 OF 38	

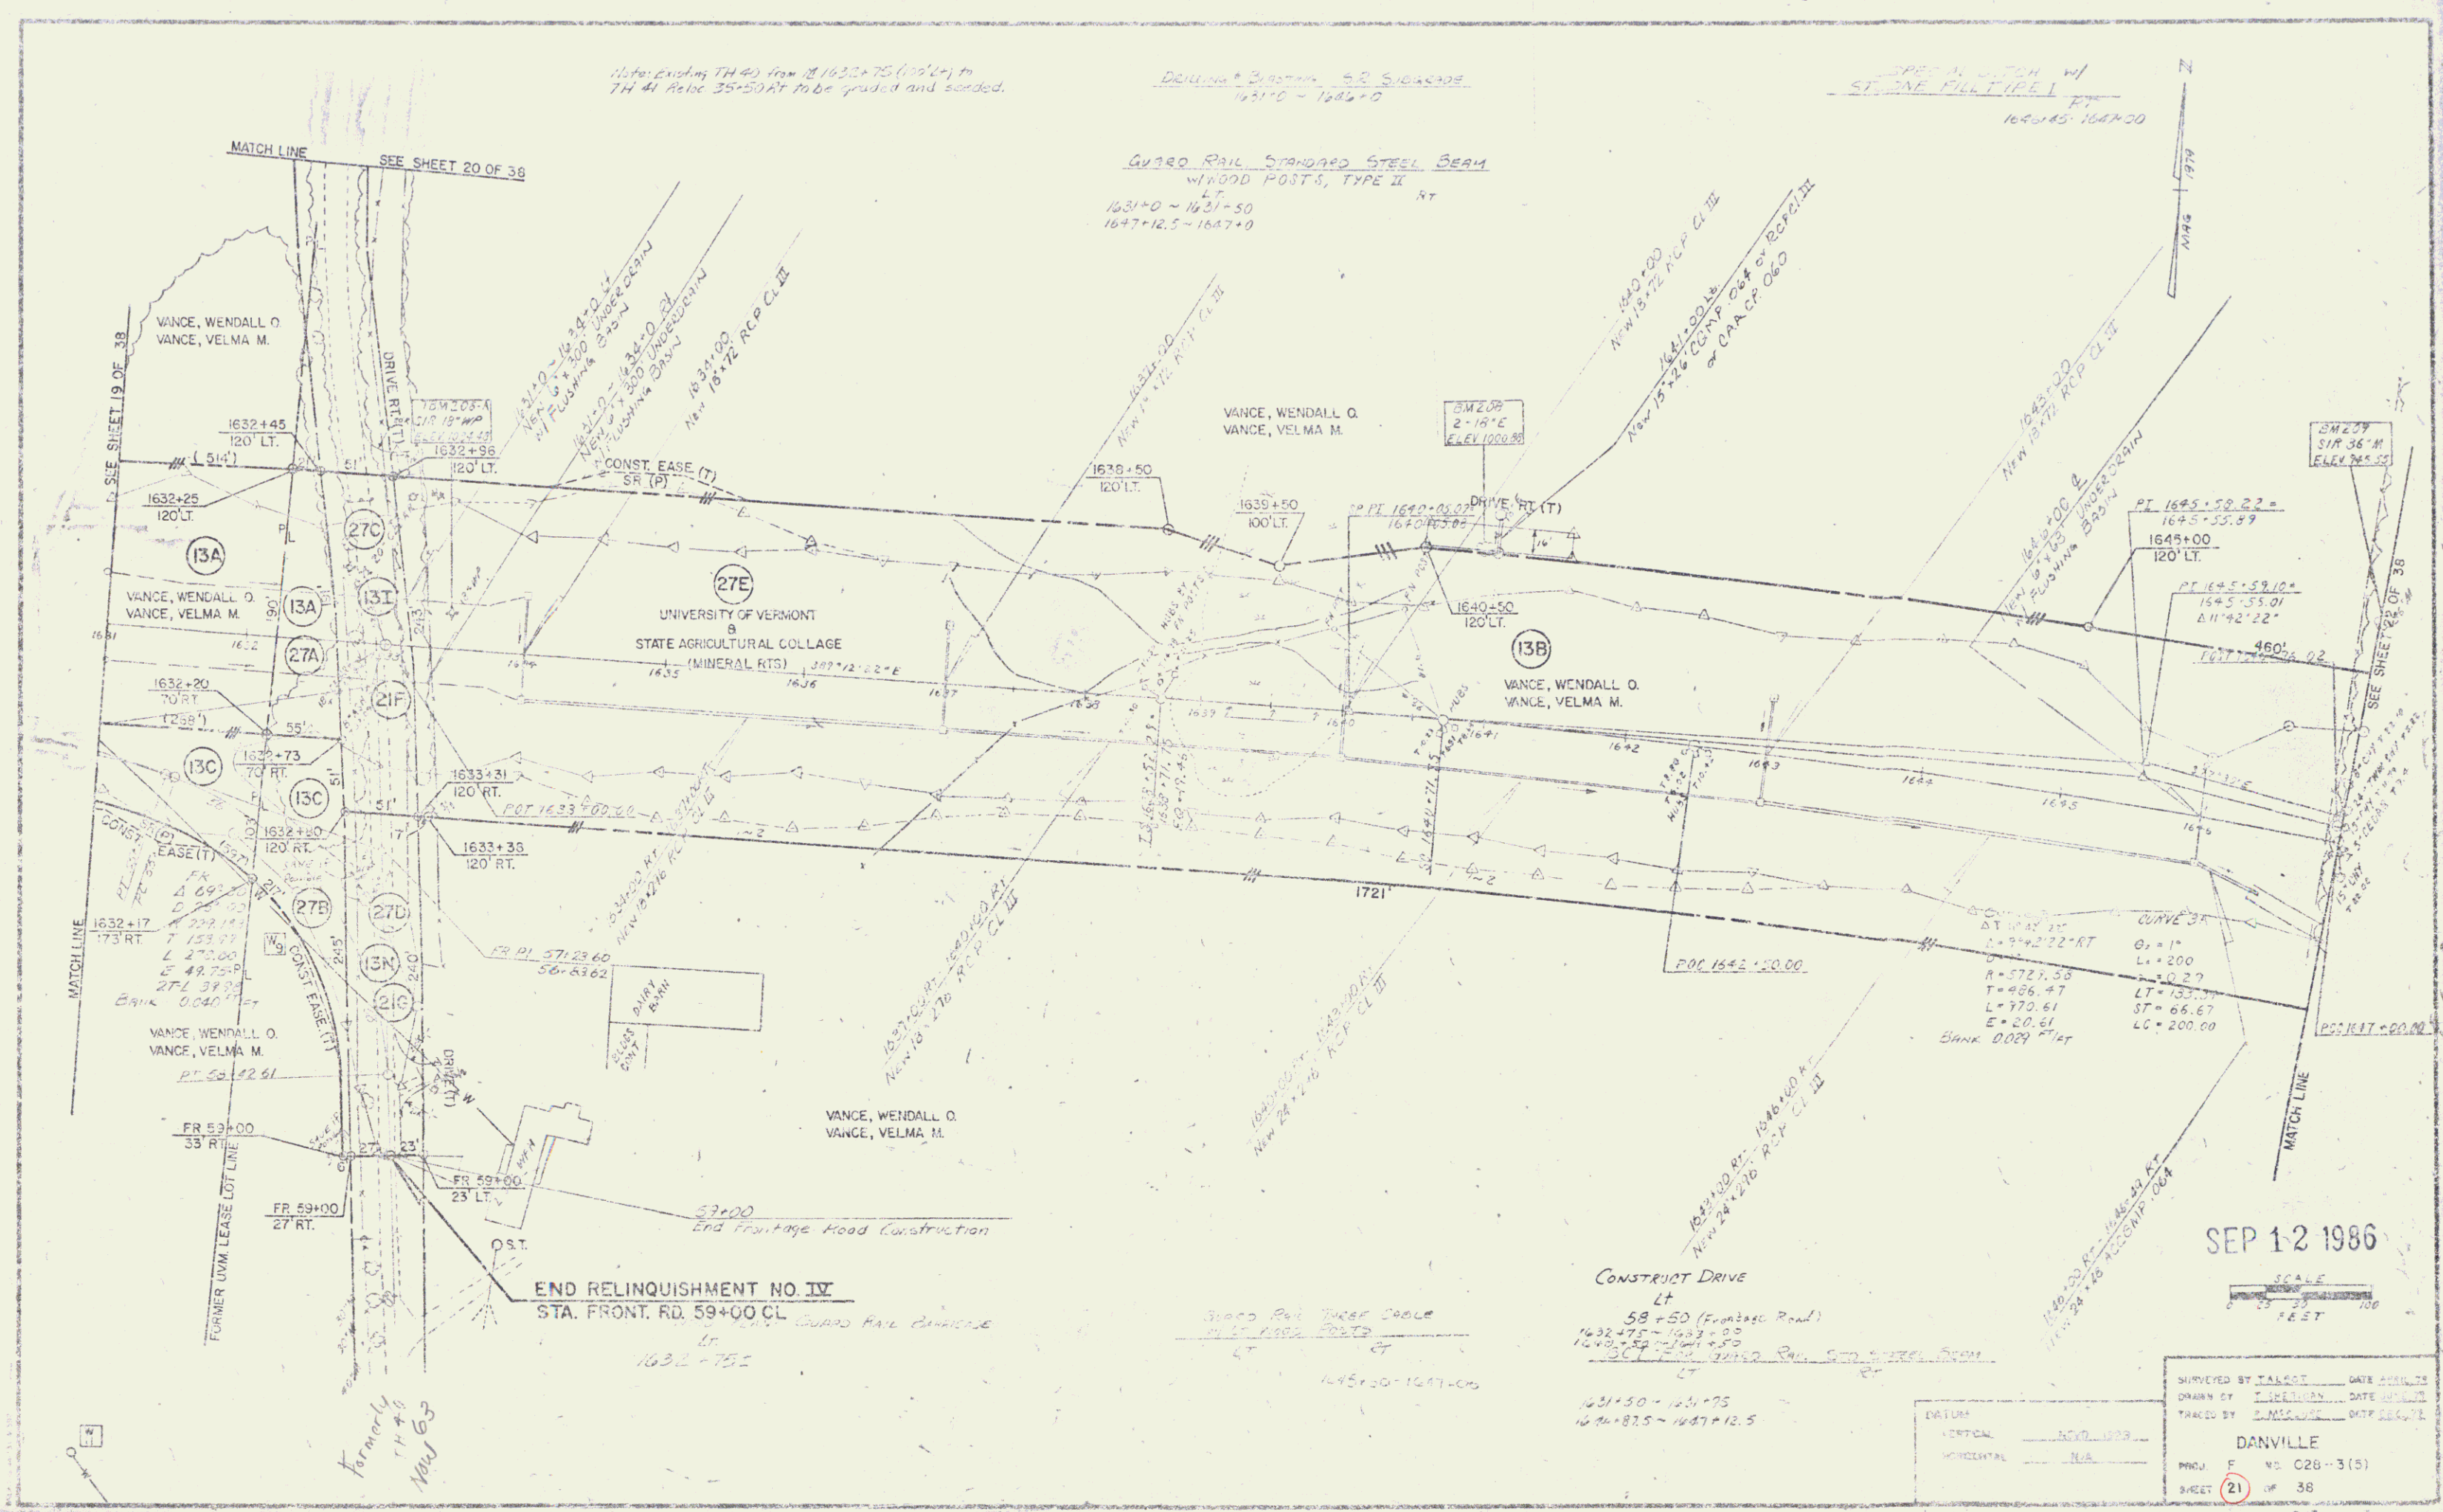

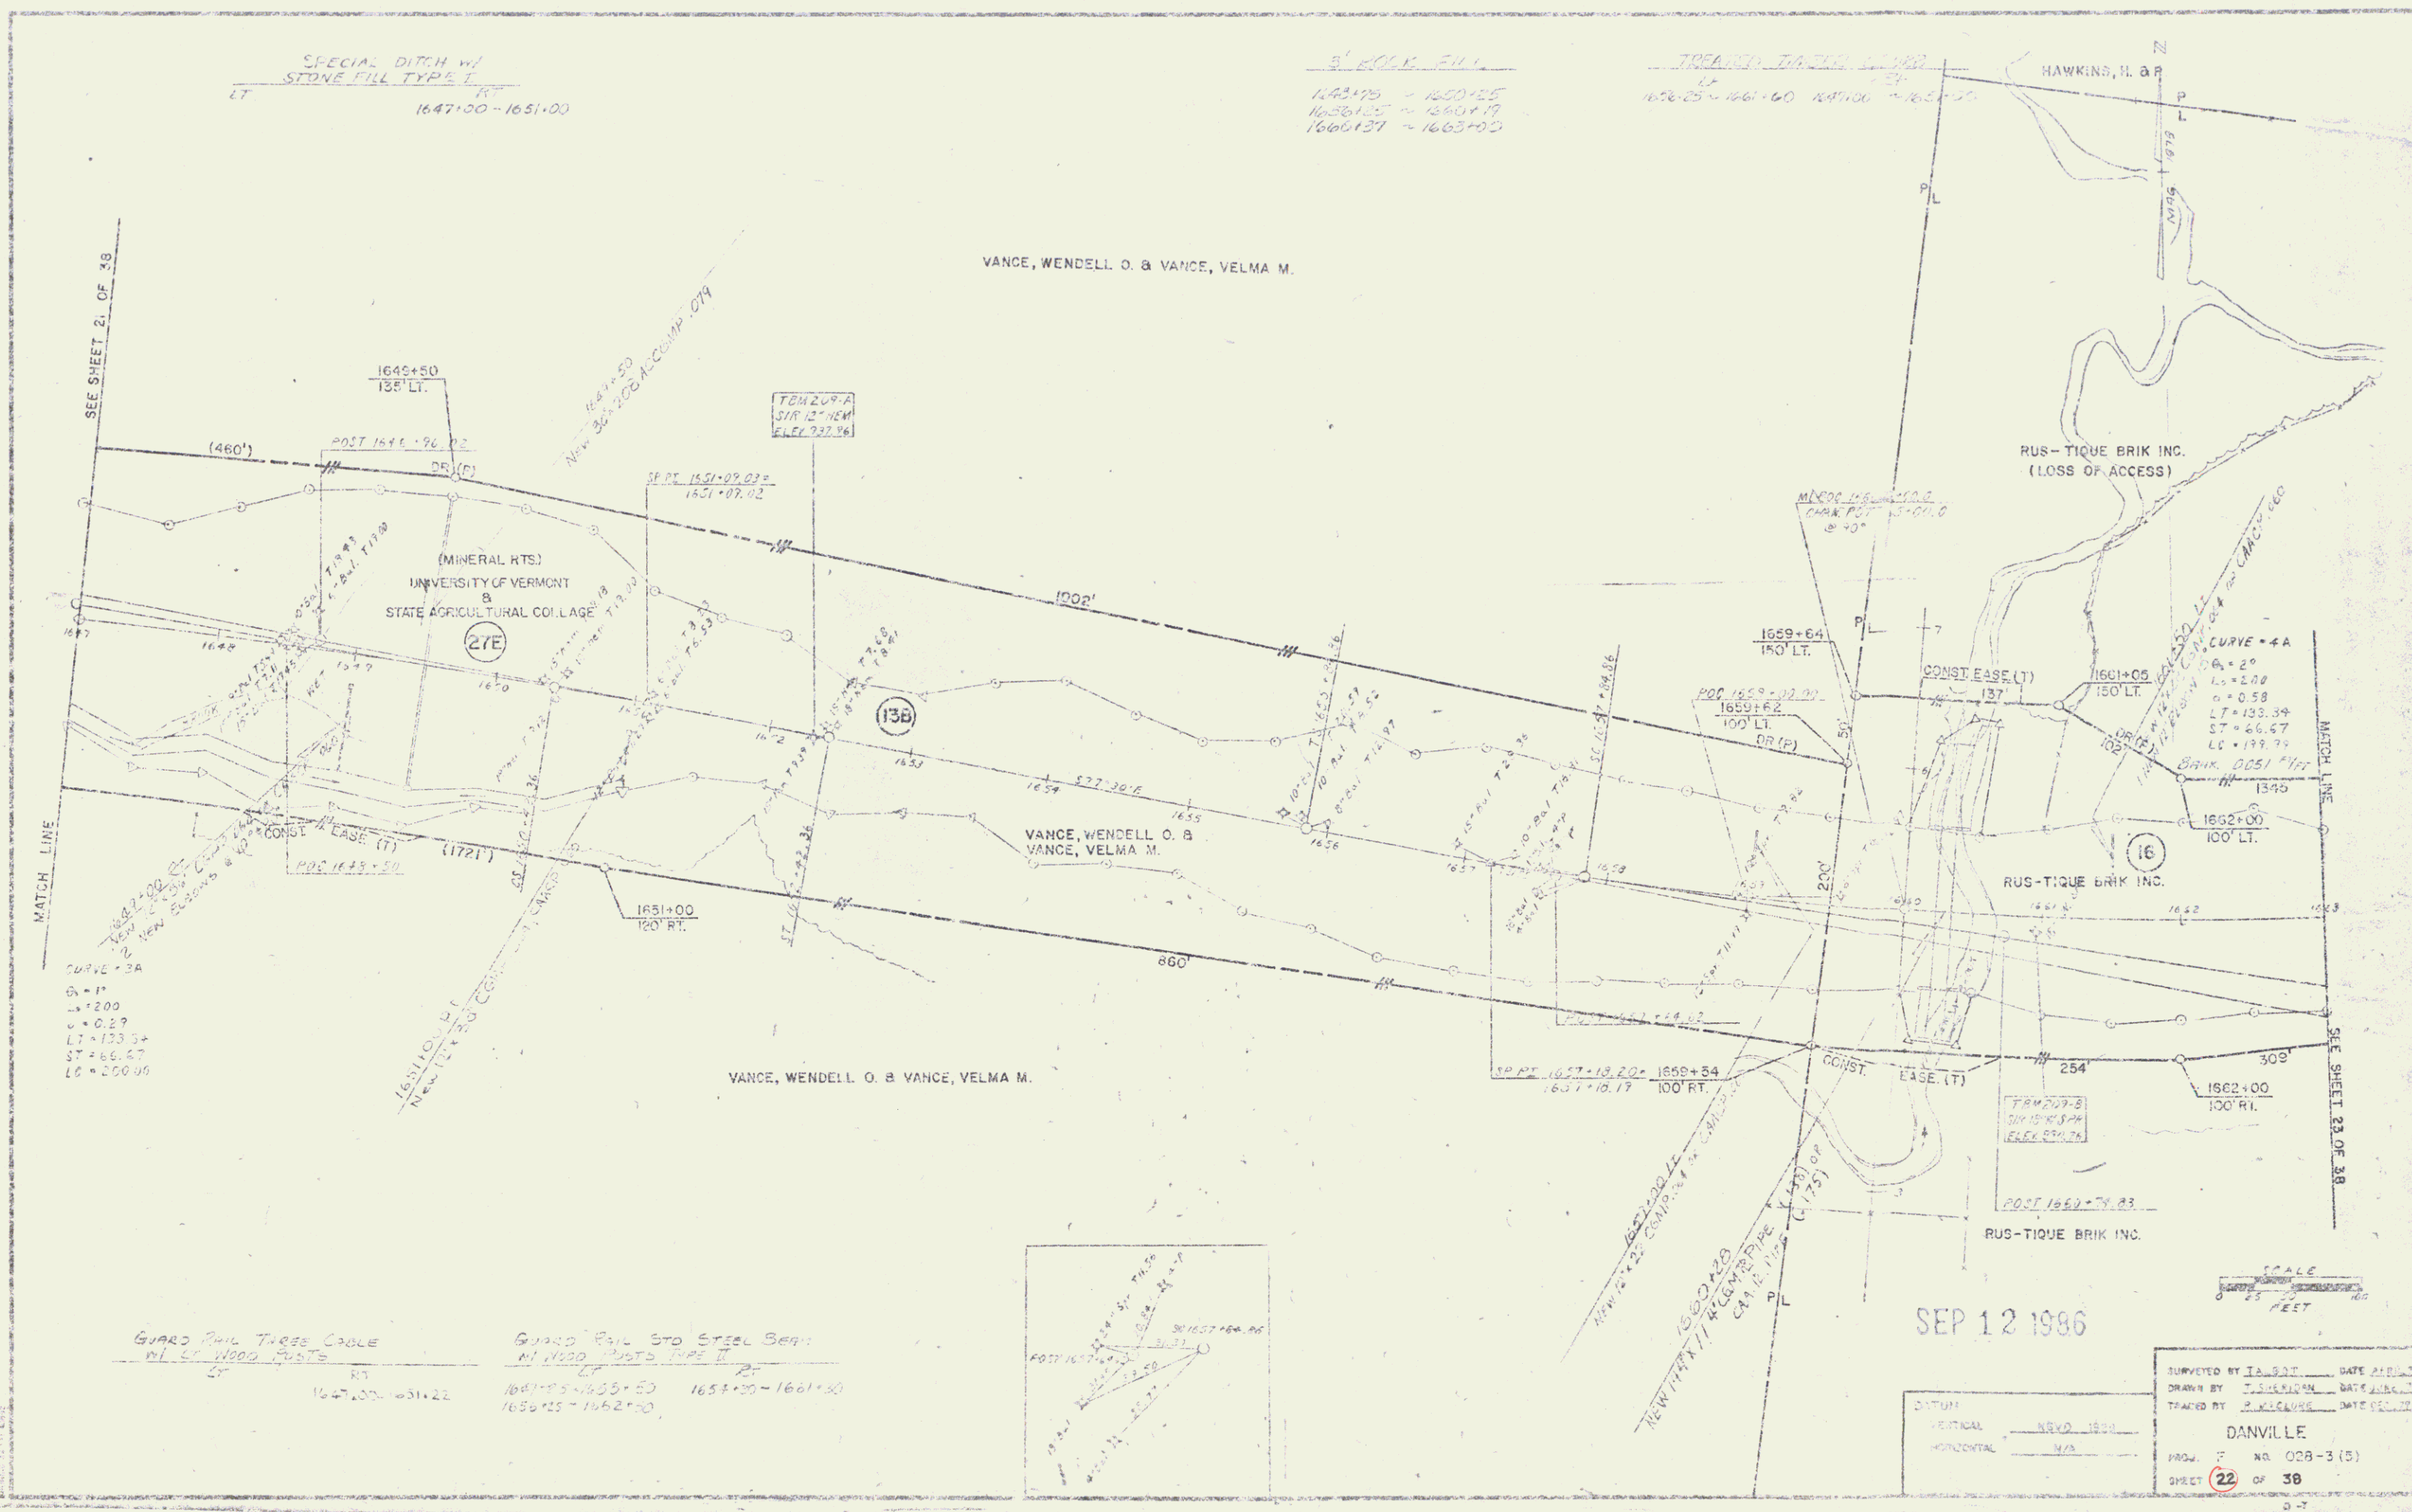

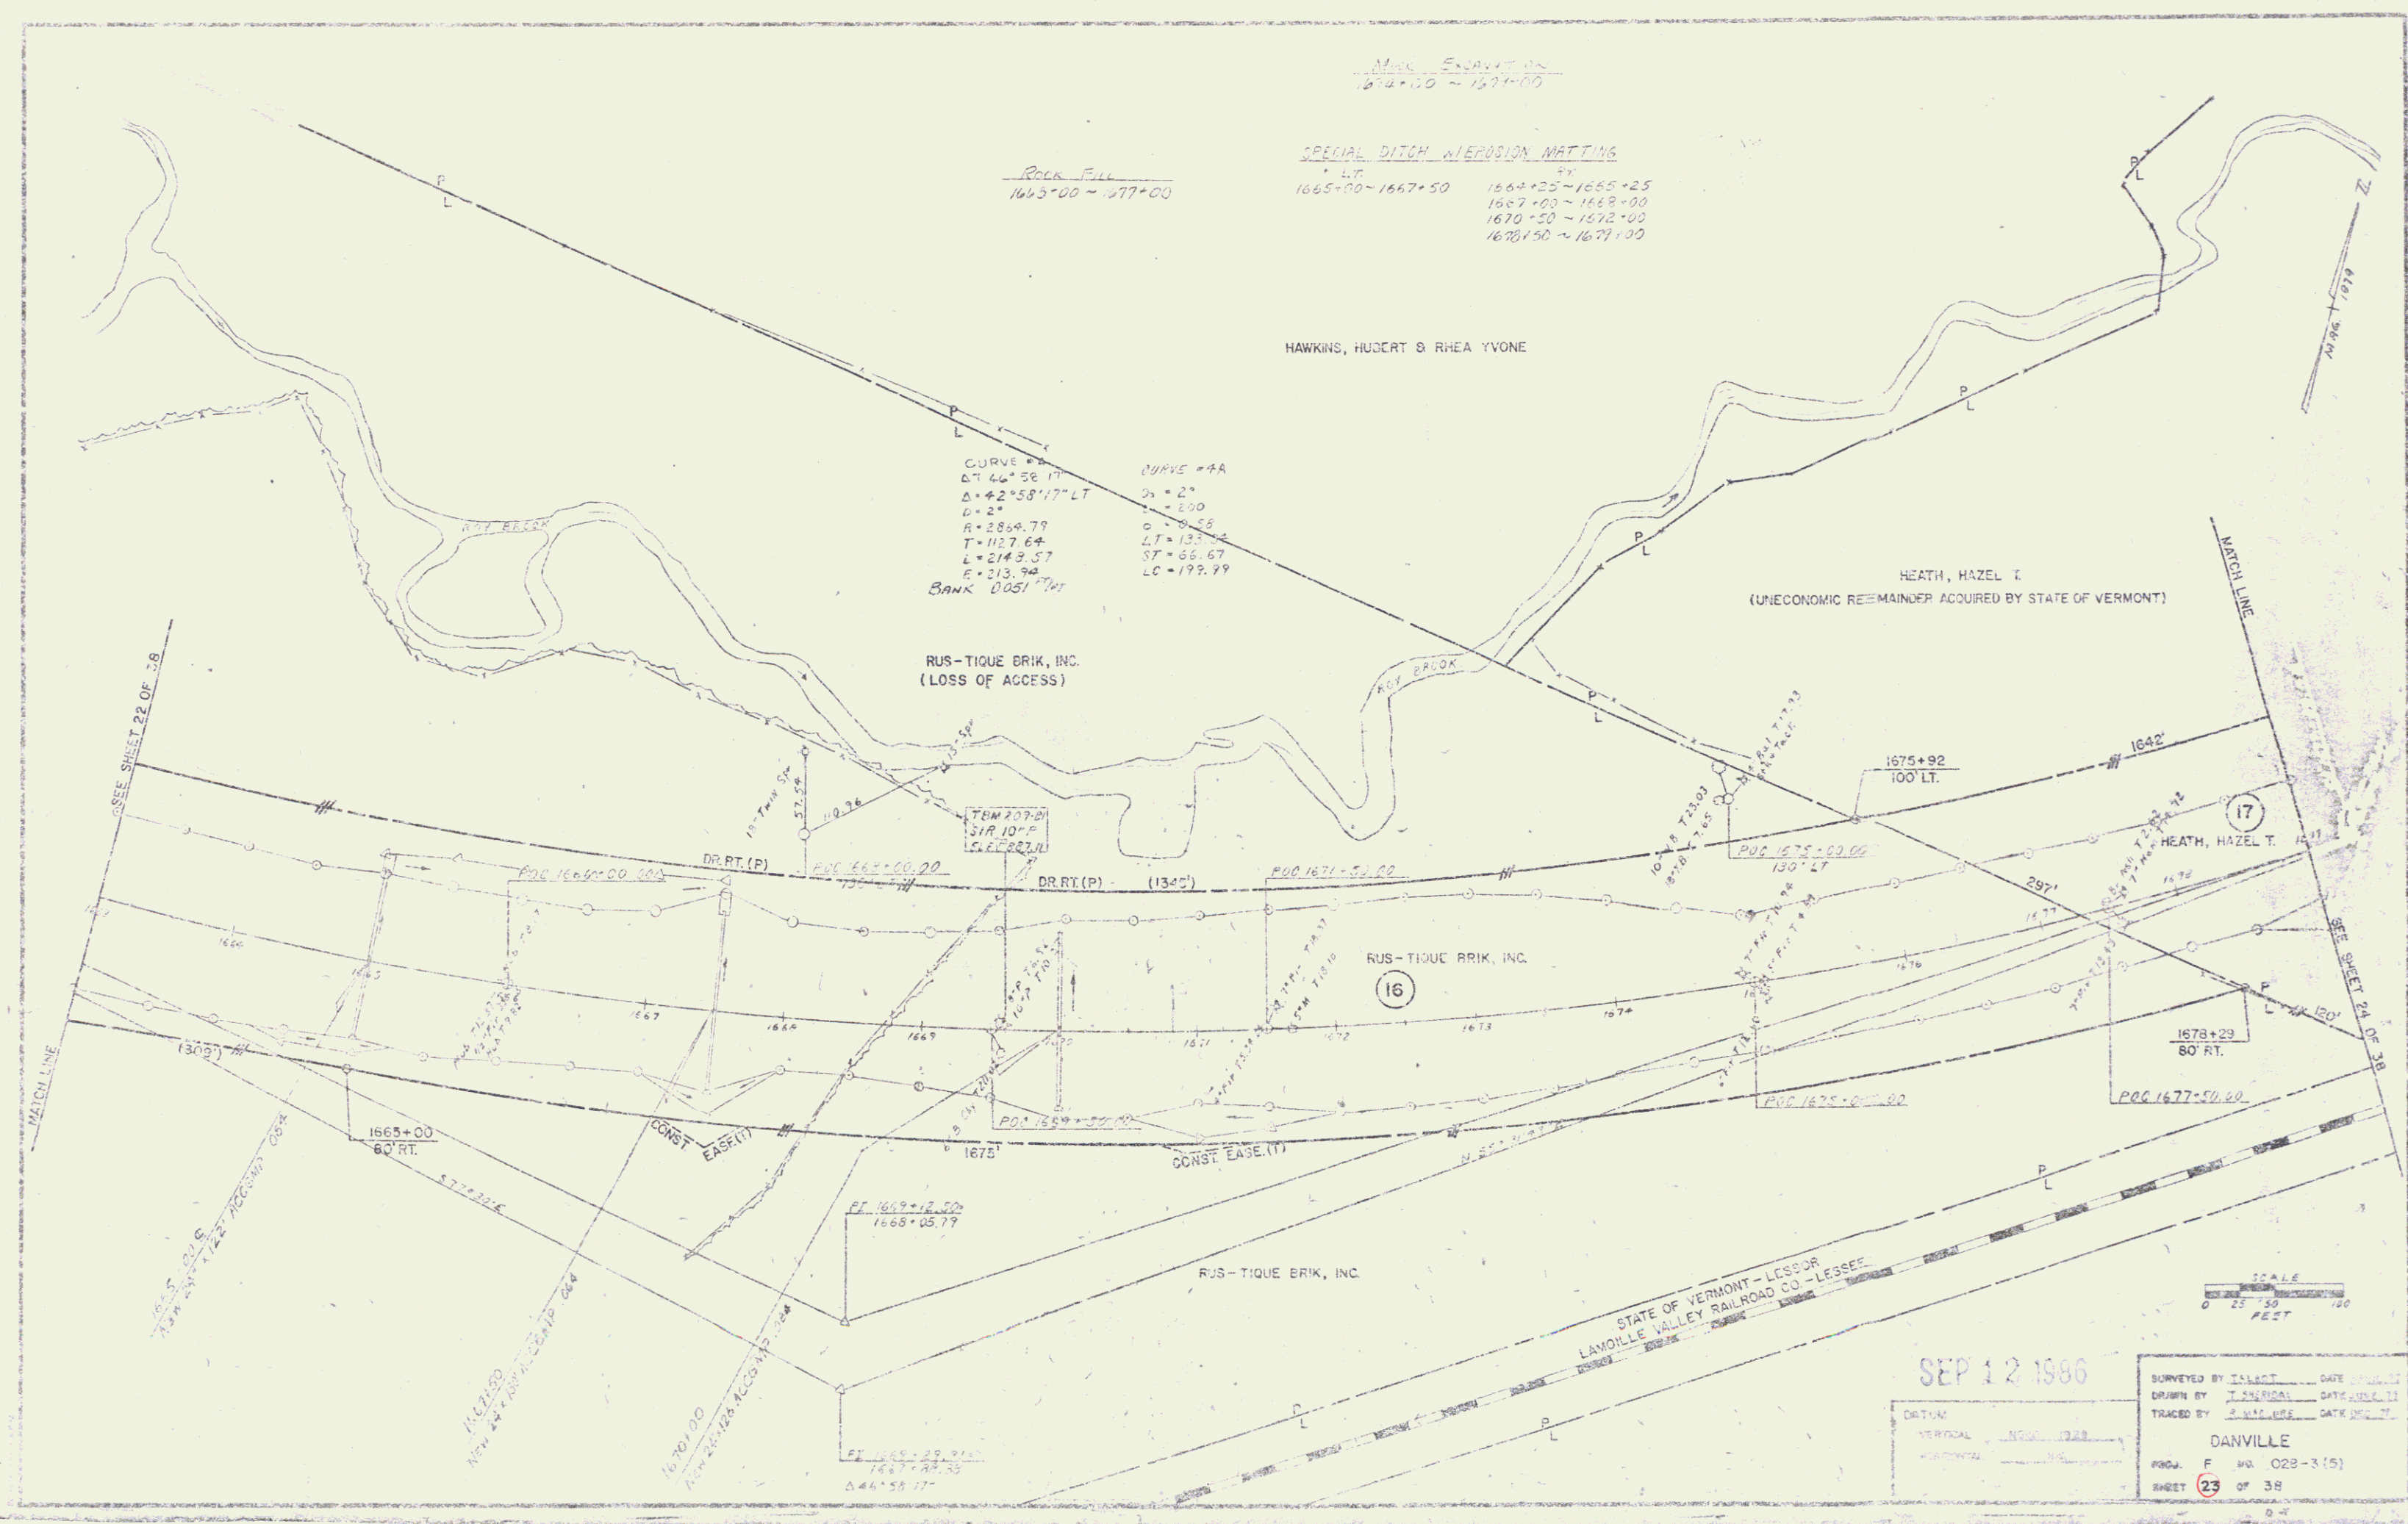

Rock Fill
1643+00 ~ 1677+00

SPECIAL DITCH WIDENING MATTING
L.T.
1665+00 ~ 1667+50
1664+25 ~ 1665+25
1667+00 ~ 1668+00
1670+20 ~ 1672+00
1678+50 ~ 1679+00

CURVE #4A
ΔT 46° 58' 17"
Δ 42° 58' 17" LT
D = 2"
R = 2864.79
T = 1127.64
L = 2149.57
E = 213.94
BANK 0.051' W/T
CURVE #4A
D = 2"
R = 2864.79
T = 1127.64
L = 2149.57
E = 213.94
BANK 0.051' W/T

HAWKINS, HUDERT & RHEA YVONE

RUS-TIQUE BRIK, INC.
(LOSS OF ACCESS)

HEATH, HAZEL T.
(UNECONOMIC REMAINDER ACQUIRED BY STATE OF VERMONT)


RUS-TIQUE BRIK, INC.
(16)

HEATH, HAZEL T.
(17)

STATE OF VERMONT - LESSOR
LAMOILLE VALLEY RAILROAD CO - LESSEE

SEP 12 1986


SURVEYED BY: J. S. J. DATE: 1986
DRAWN BY: T. S. J. DATE: 1986
TRACED BY: P. S. J. DATE: 1986
DANVILLE
F. S. J. 028-3 (5)
SHEET 23 OF 38

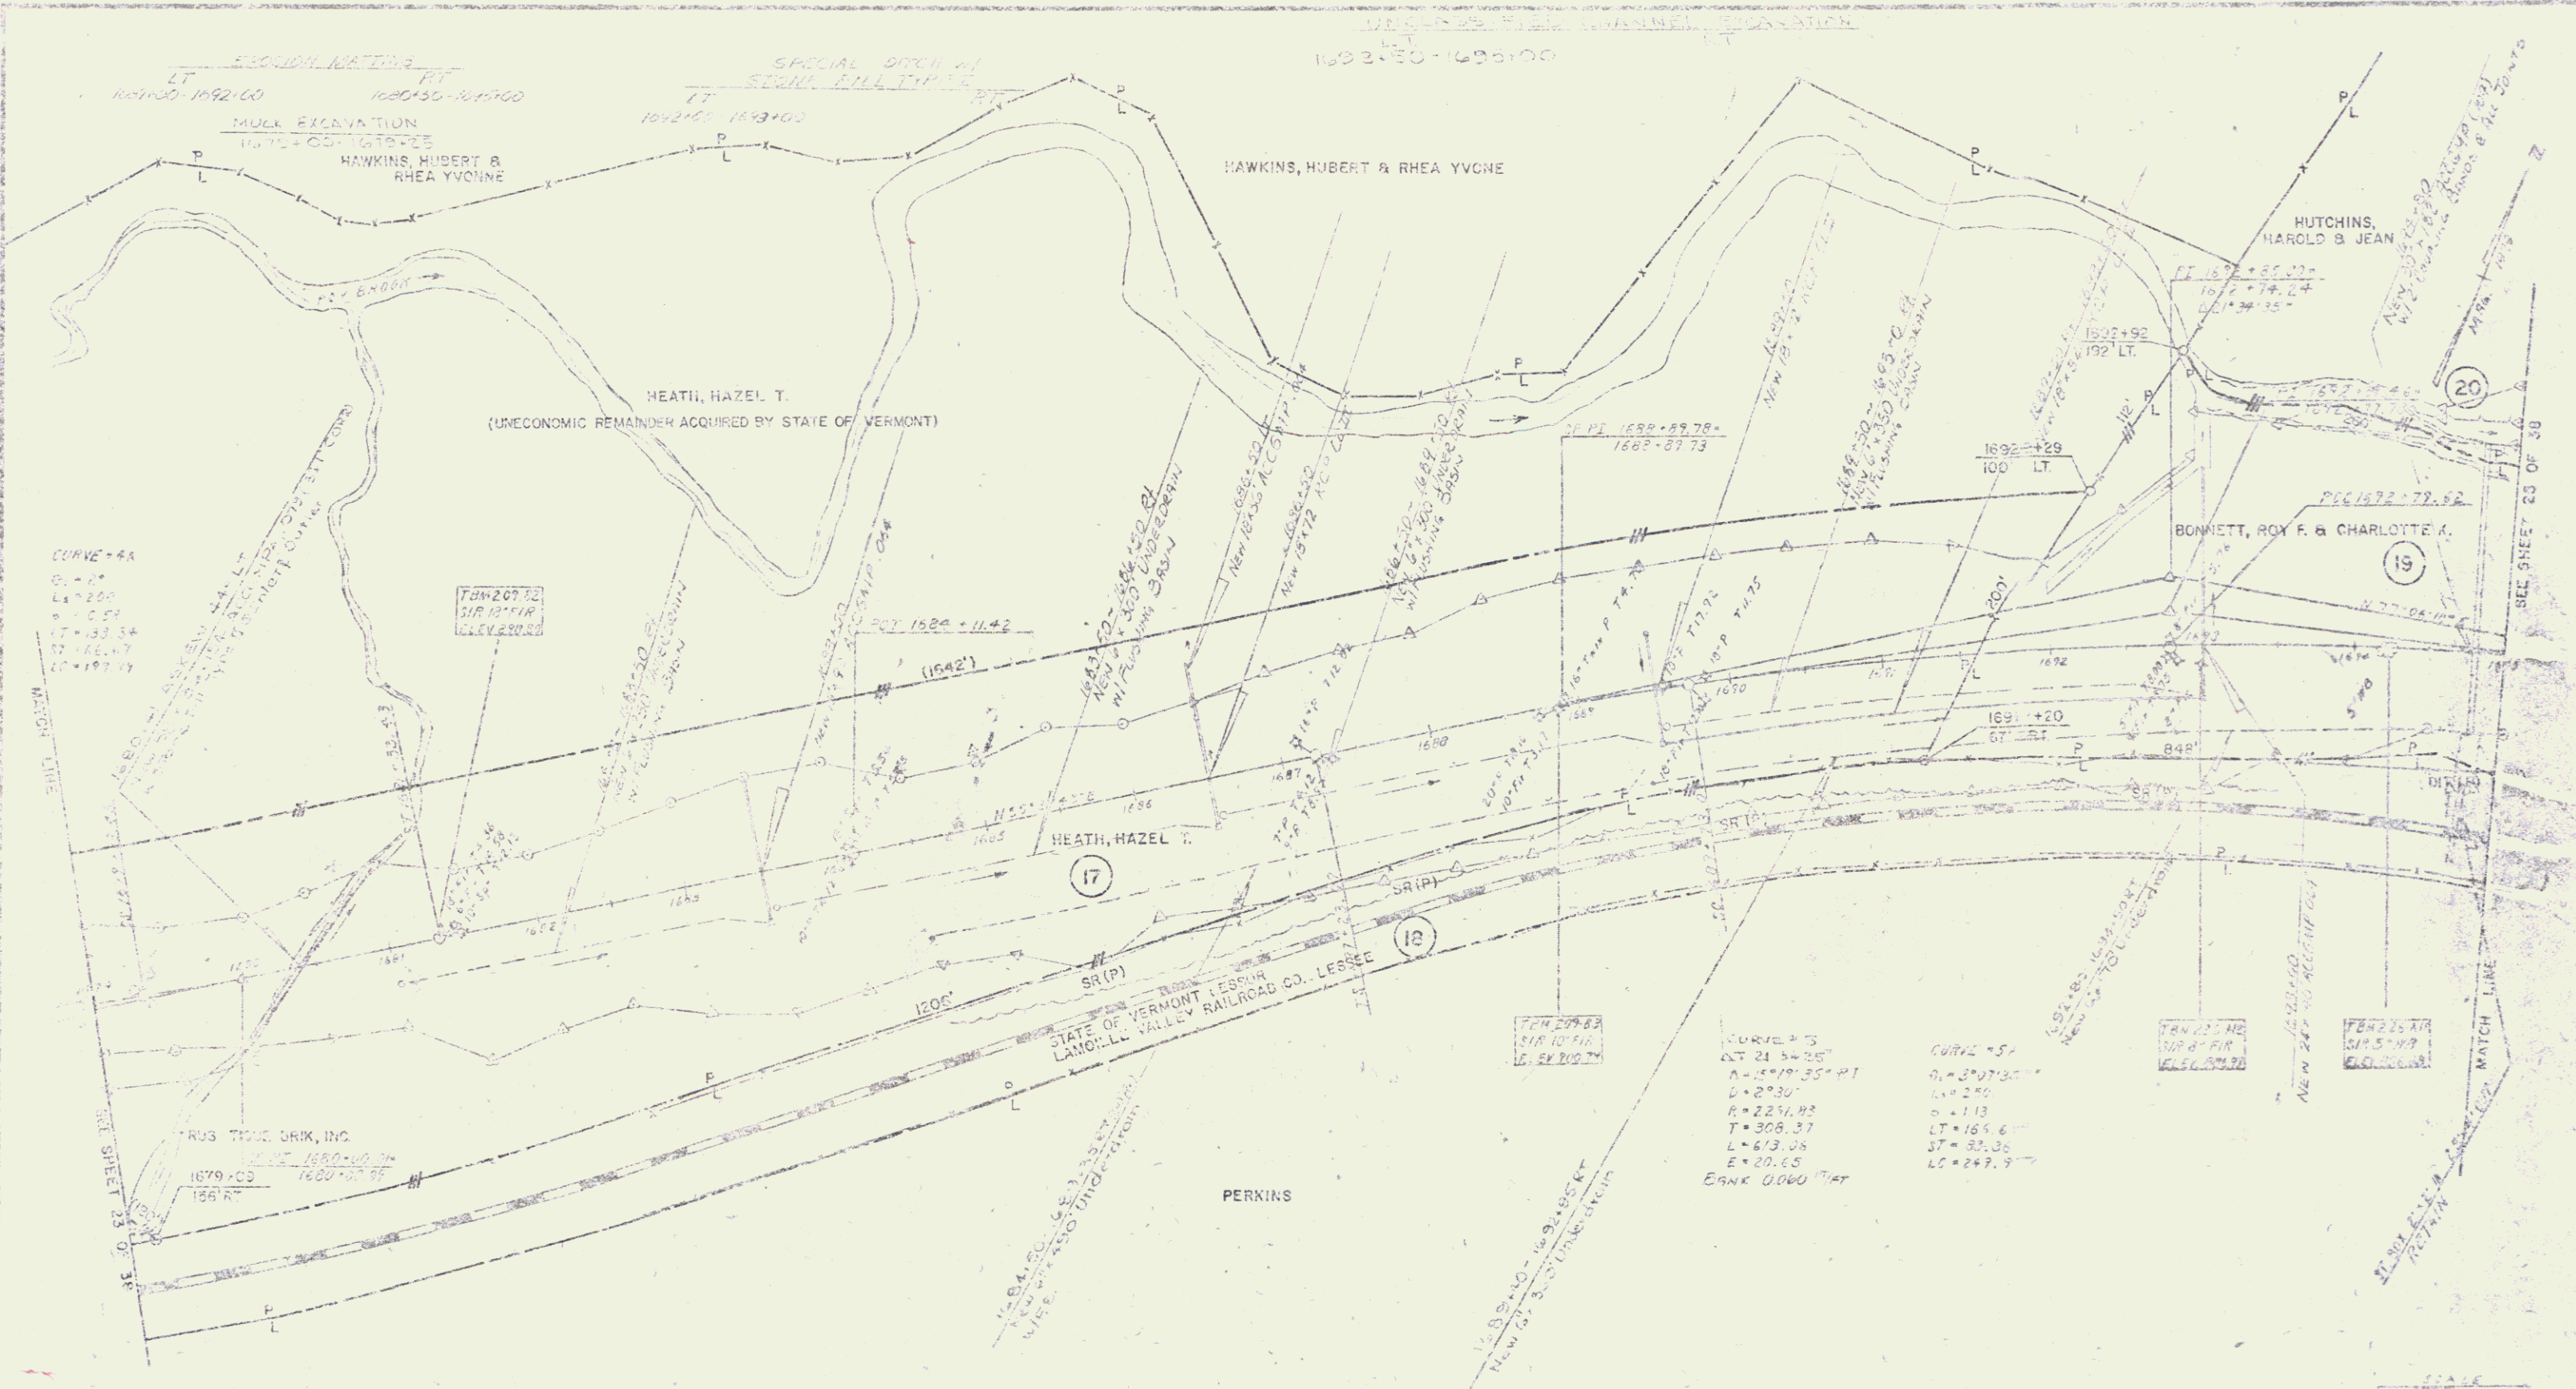

SEP 12 1986

DESIGNED BY	DATE
DRAWN BY	DATE
CHECKED BY	DATE
DANVILLE	
F 10 028-3 (5)	
SHEET 24 OF 30	



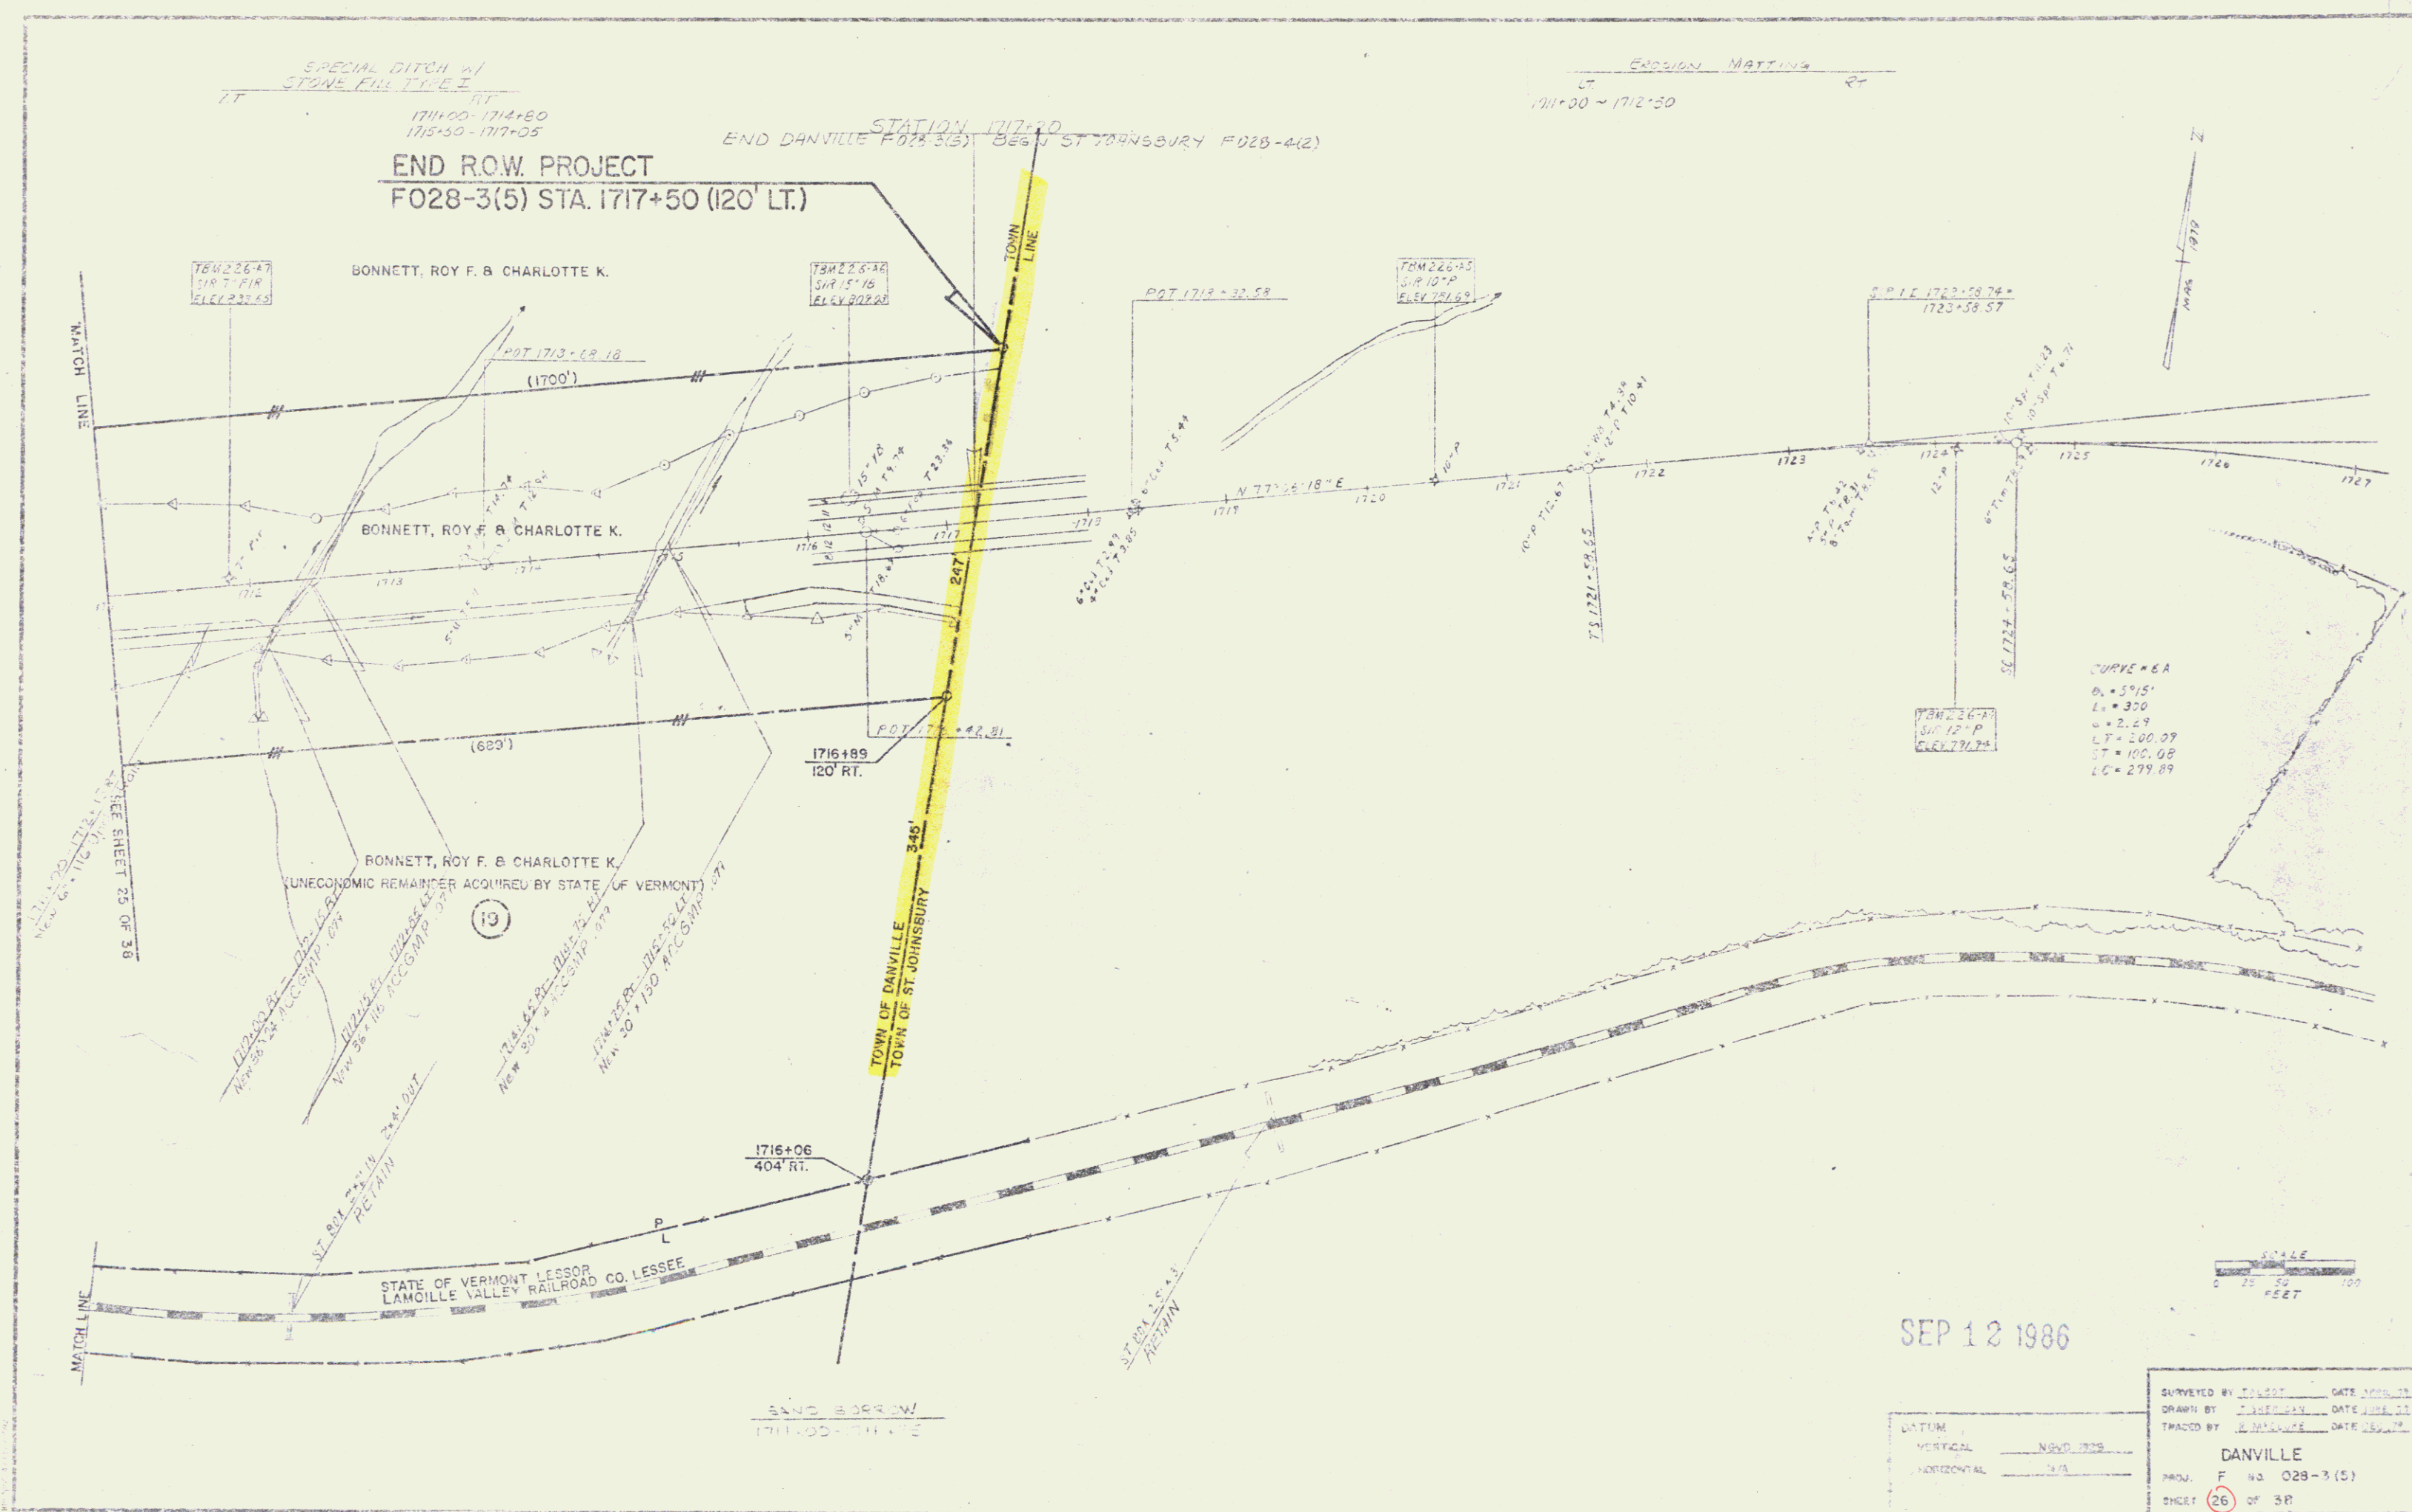

SEP 12 1986

SURVEYED BY J. L. G. DATE APR. 85	
DRAWN BY J. L. G. DATE JUNE 85	
TRACED BY J. L. G. DATE JUNE 85	
PROJECT DANVILLE	
F028-3(5)	
SHEET 26 OF 38	

24