

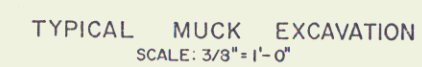



PLAN	NUMBERED	OF	2
NOTE BOOK	NOTED		
NO	ALIGNED CHECKED		
	PL. IN WAY CHECKED		

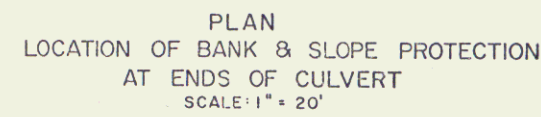

1426 150 1427
MIDDLEBURY
Proj. E014-3(11)
Sheet 14 of 182

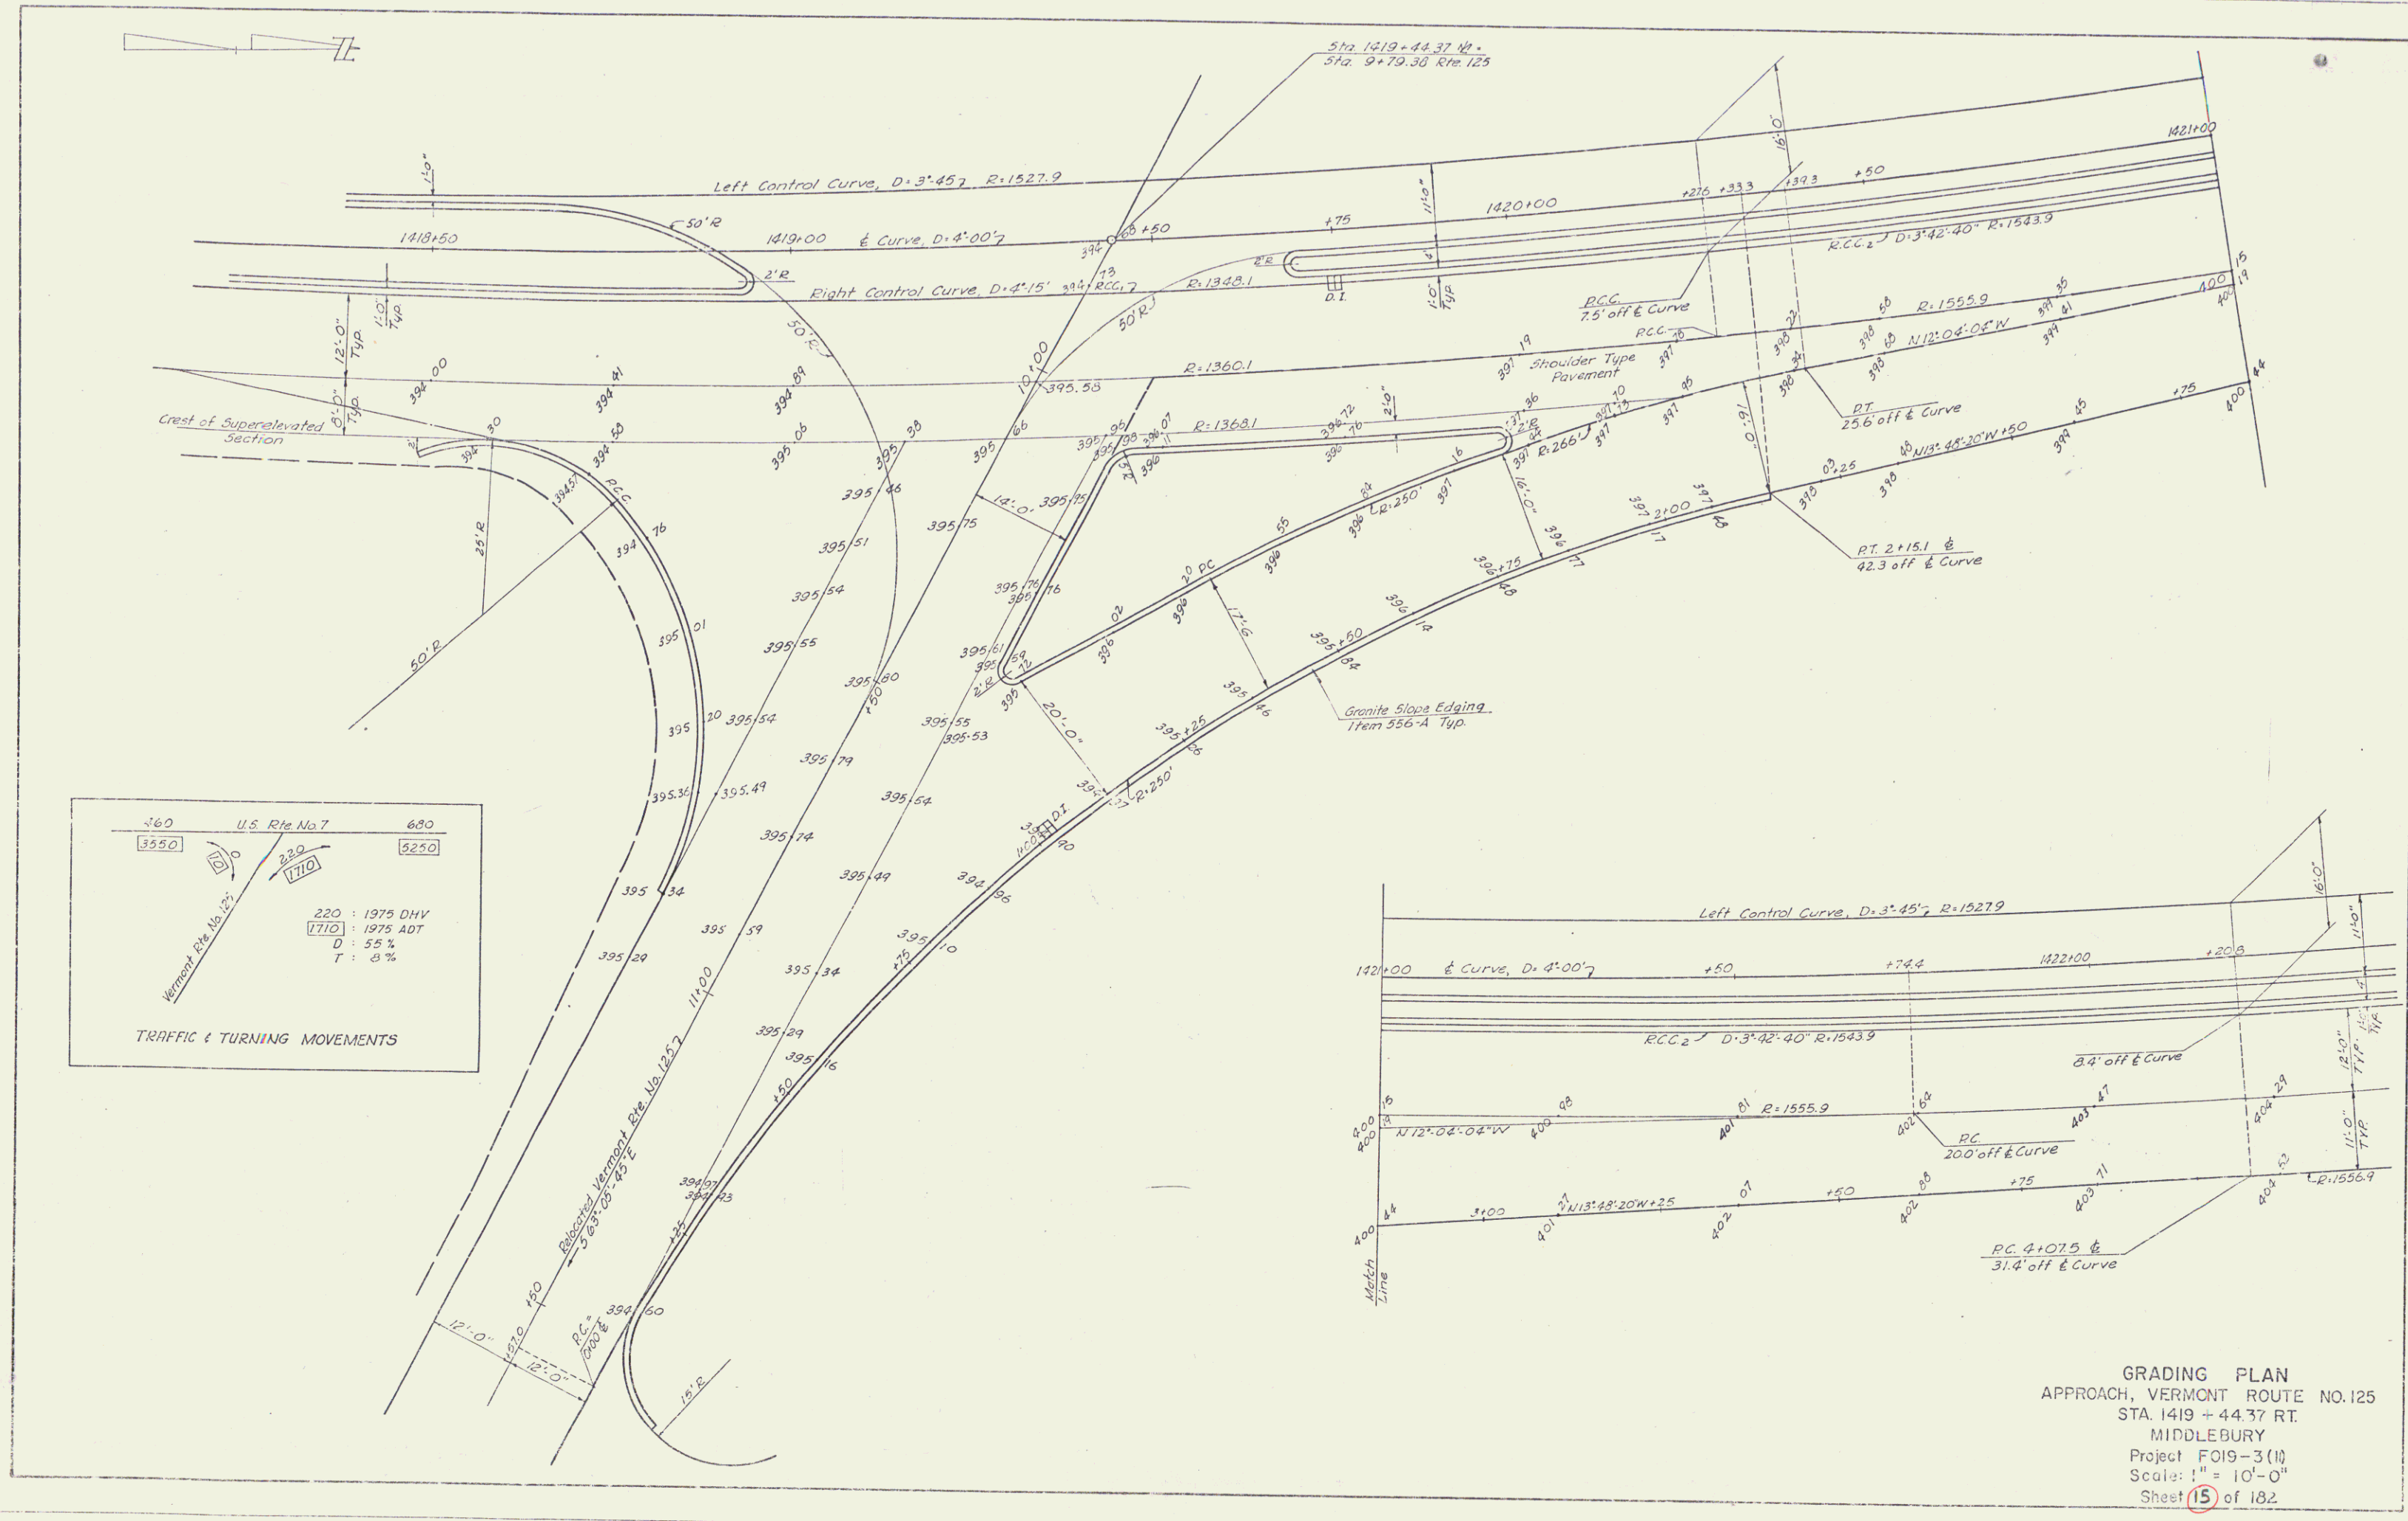

GRADING PLAN
APPROACH, VERMONT ROUTE NO. 125
STA. 1419 + 44.37 RT.
MIDDLEBURY
Project F019-3(1)
Scale: 1" = 10'-0"
Sheet 15 of 18.2

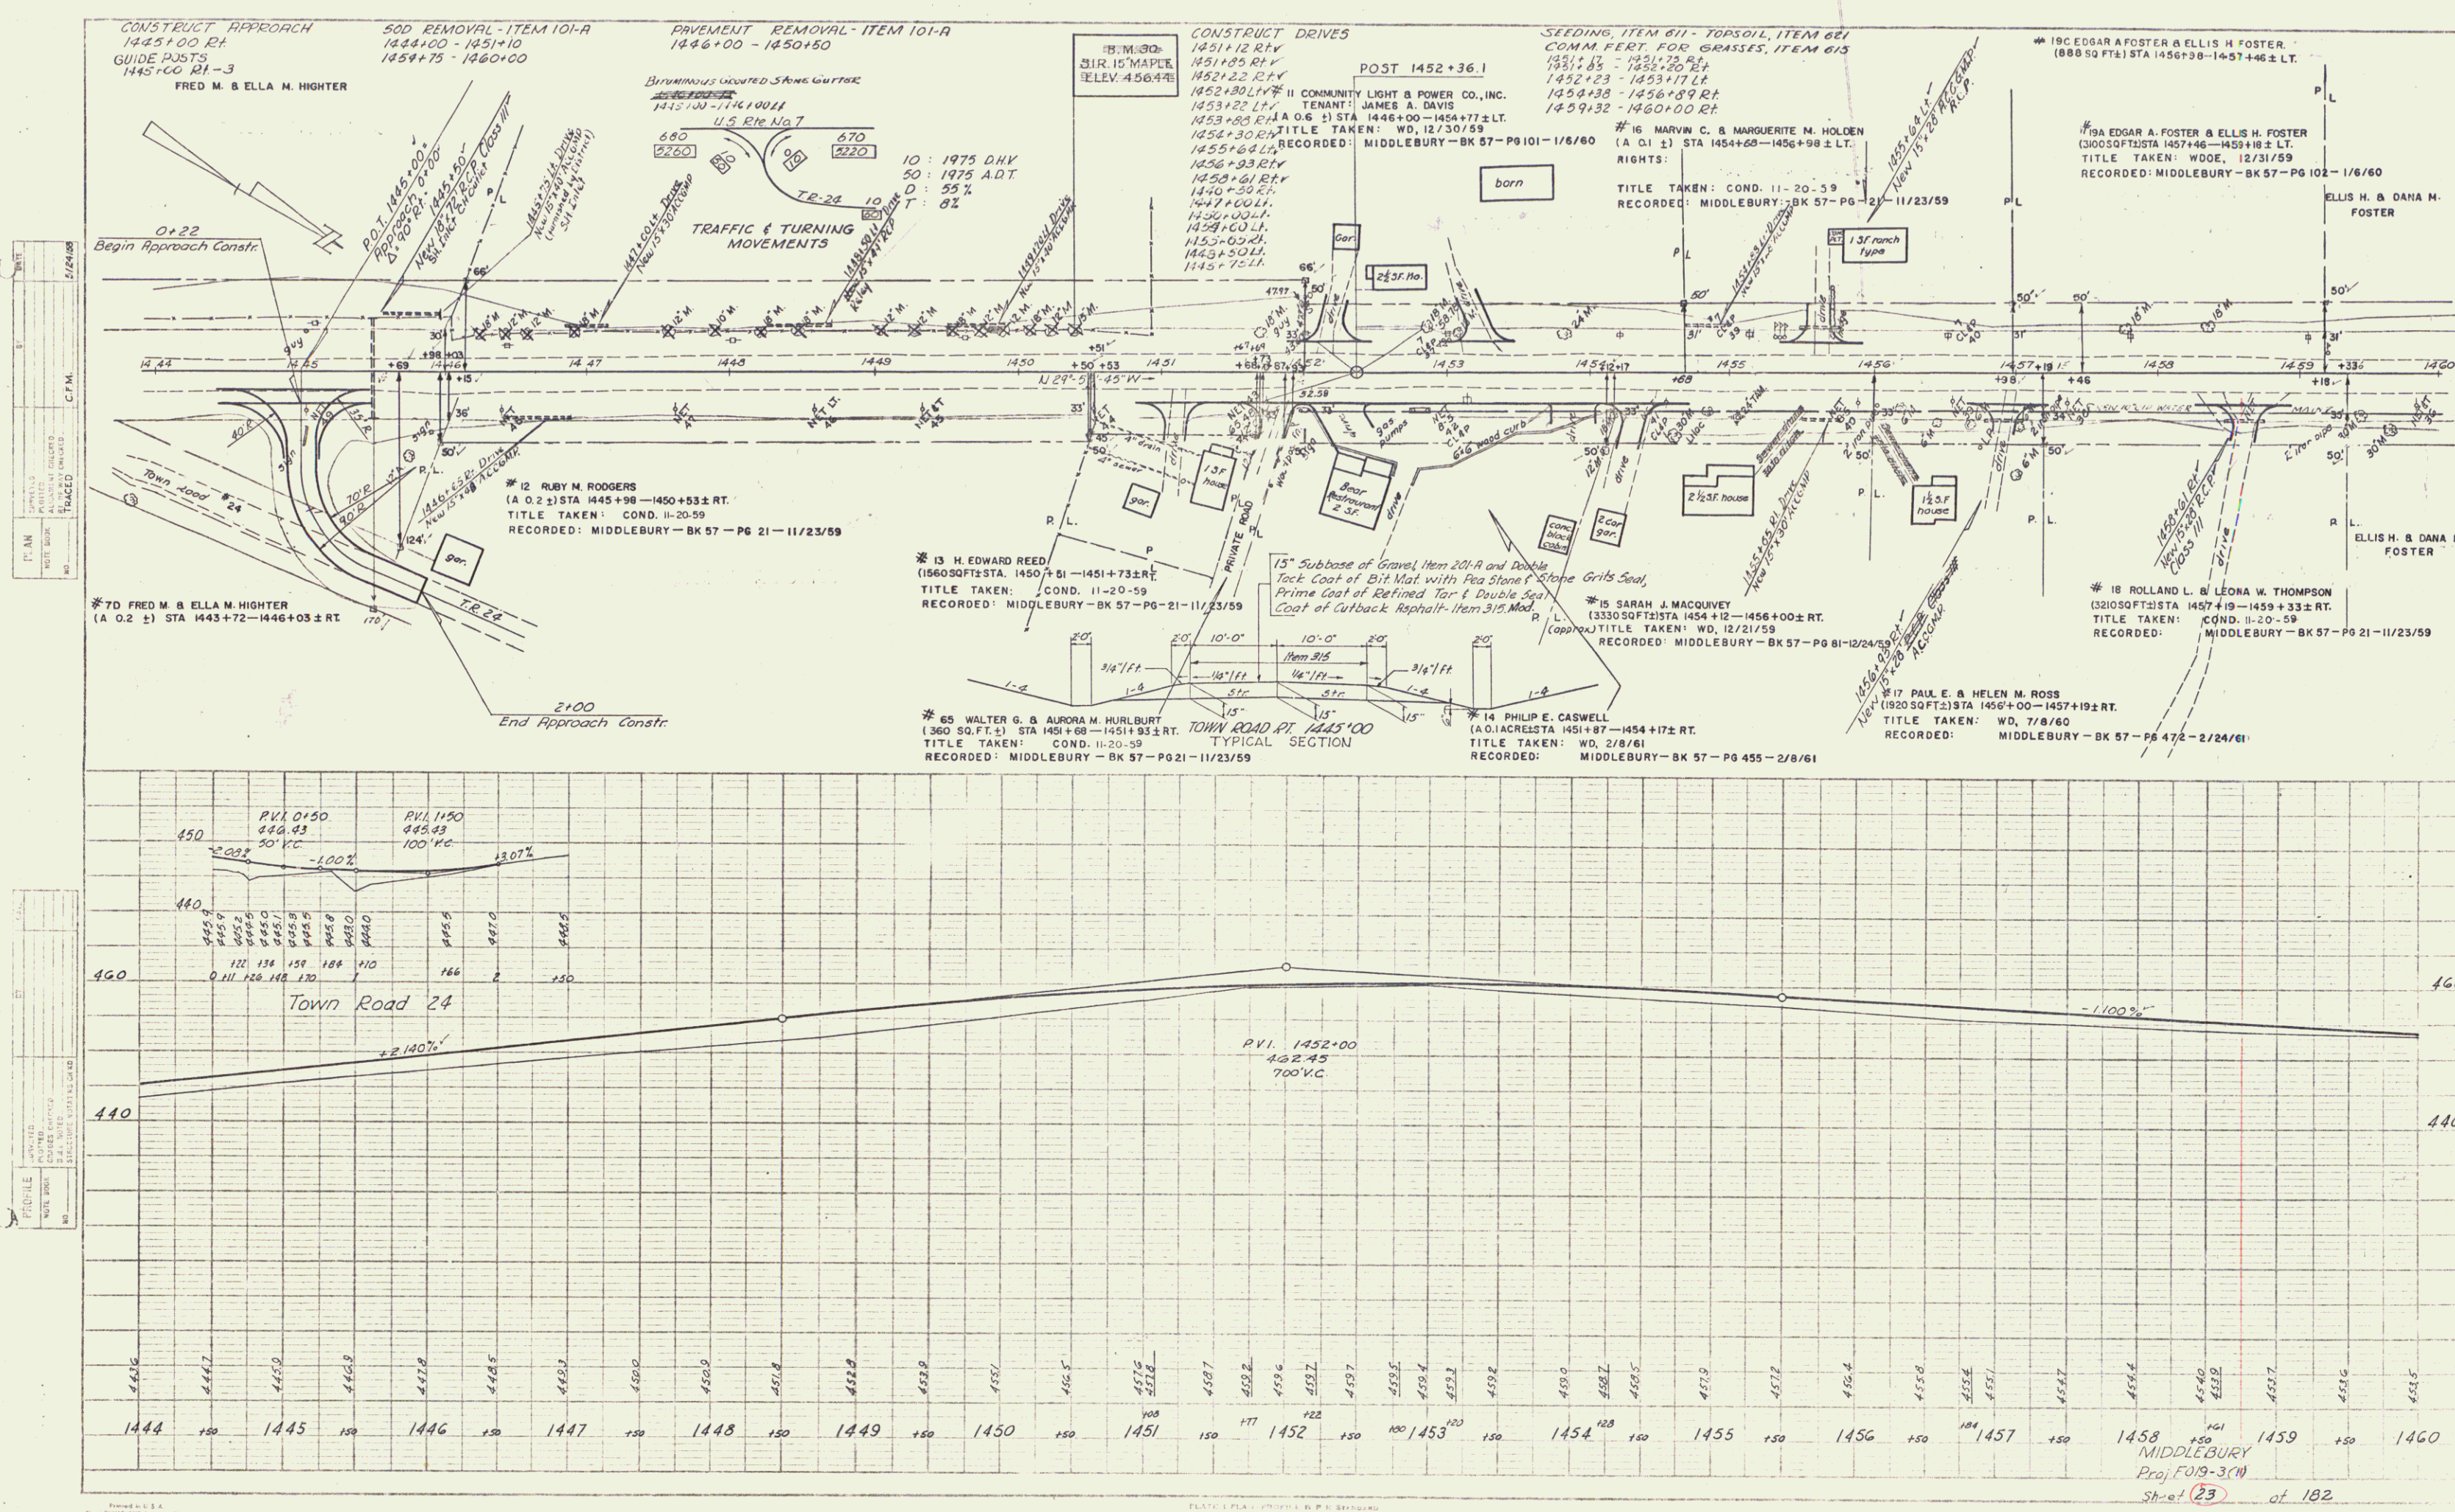


APR 25 1977





PLAN	DATE	BY	CHKD	APPD	REV
1	11/23/59	W. B. BENT	W. B. BENT	W. B. BENT	1
2	11/23/59	W. B. BENT	W. B. BENT	W. B. BENT	1
3	11/23/59	W. B. BENT	W. B. BENT	W. B. BENT	1
4	11/23/59	W. B. BENT	W. B. BENT	W. B. BENT	1
5	11/23/59	W. B. BENT	W. B. BENT	W. B. BENT	1
6	11/23/59	W. B. BENT	W. B. BENT	W. B. BENT	1
7	11/23/59	W. B. BENT	W. B. BENT	W. B. BENT	1
8	11/23/59	W. B. BENT	W. B. BENT	W. B. BENT	1
9	11/23/59	W. B. BENT	W. B. BENT	W. B. BENT	1
10	11/23/59	W. B. BENT	W. B. BENT	W. B. BENT	1

PROFILE	DATE	BY	CHKD	APPD	REV
1	11/23/59	W. B. BENT	W. B. BENT	W. B. BENT	1
2	11/23/59	W. B. BENT	W. B. BENT	W. B. BENT	1
3	11/23/59	W. B. BENT	W. B. BENT	W. B. BENT	1
4	11/23/59	W. B. BENT	W. B. BENT	W. B. BENT	1
5	11/23/59	W. B. BENT	W. B. BENT	W. B. BENT	1
6	11/23/59	W. B. BENT	W. B. BENT	W. B. BENT	1
7	11/23/59	W. B. BENT	W. B. BENT	W. B. BENT	1
8	11/23/59	W. B. BENT	W. B. BENT	W. B. BENT	1
9	11/23/59	W. B. BENT	W. B. BENT	W. B. BENT	1
10	11/23/59	W. B. BENT	W. B. BENT	W. B. BENT	1

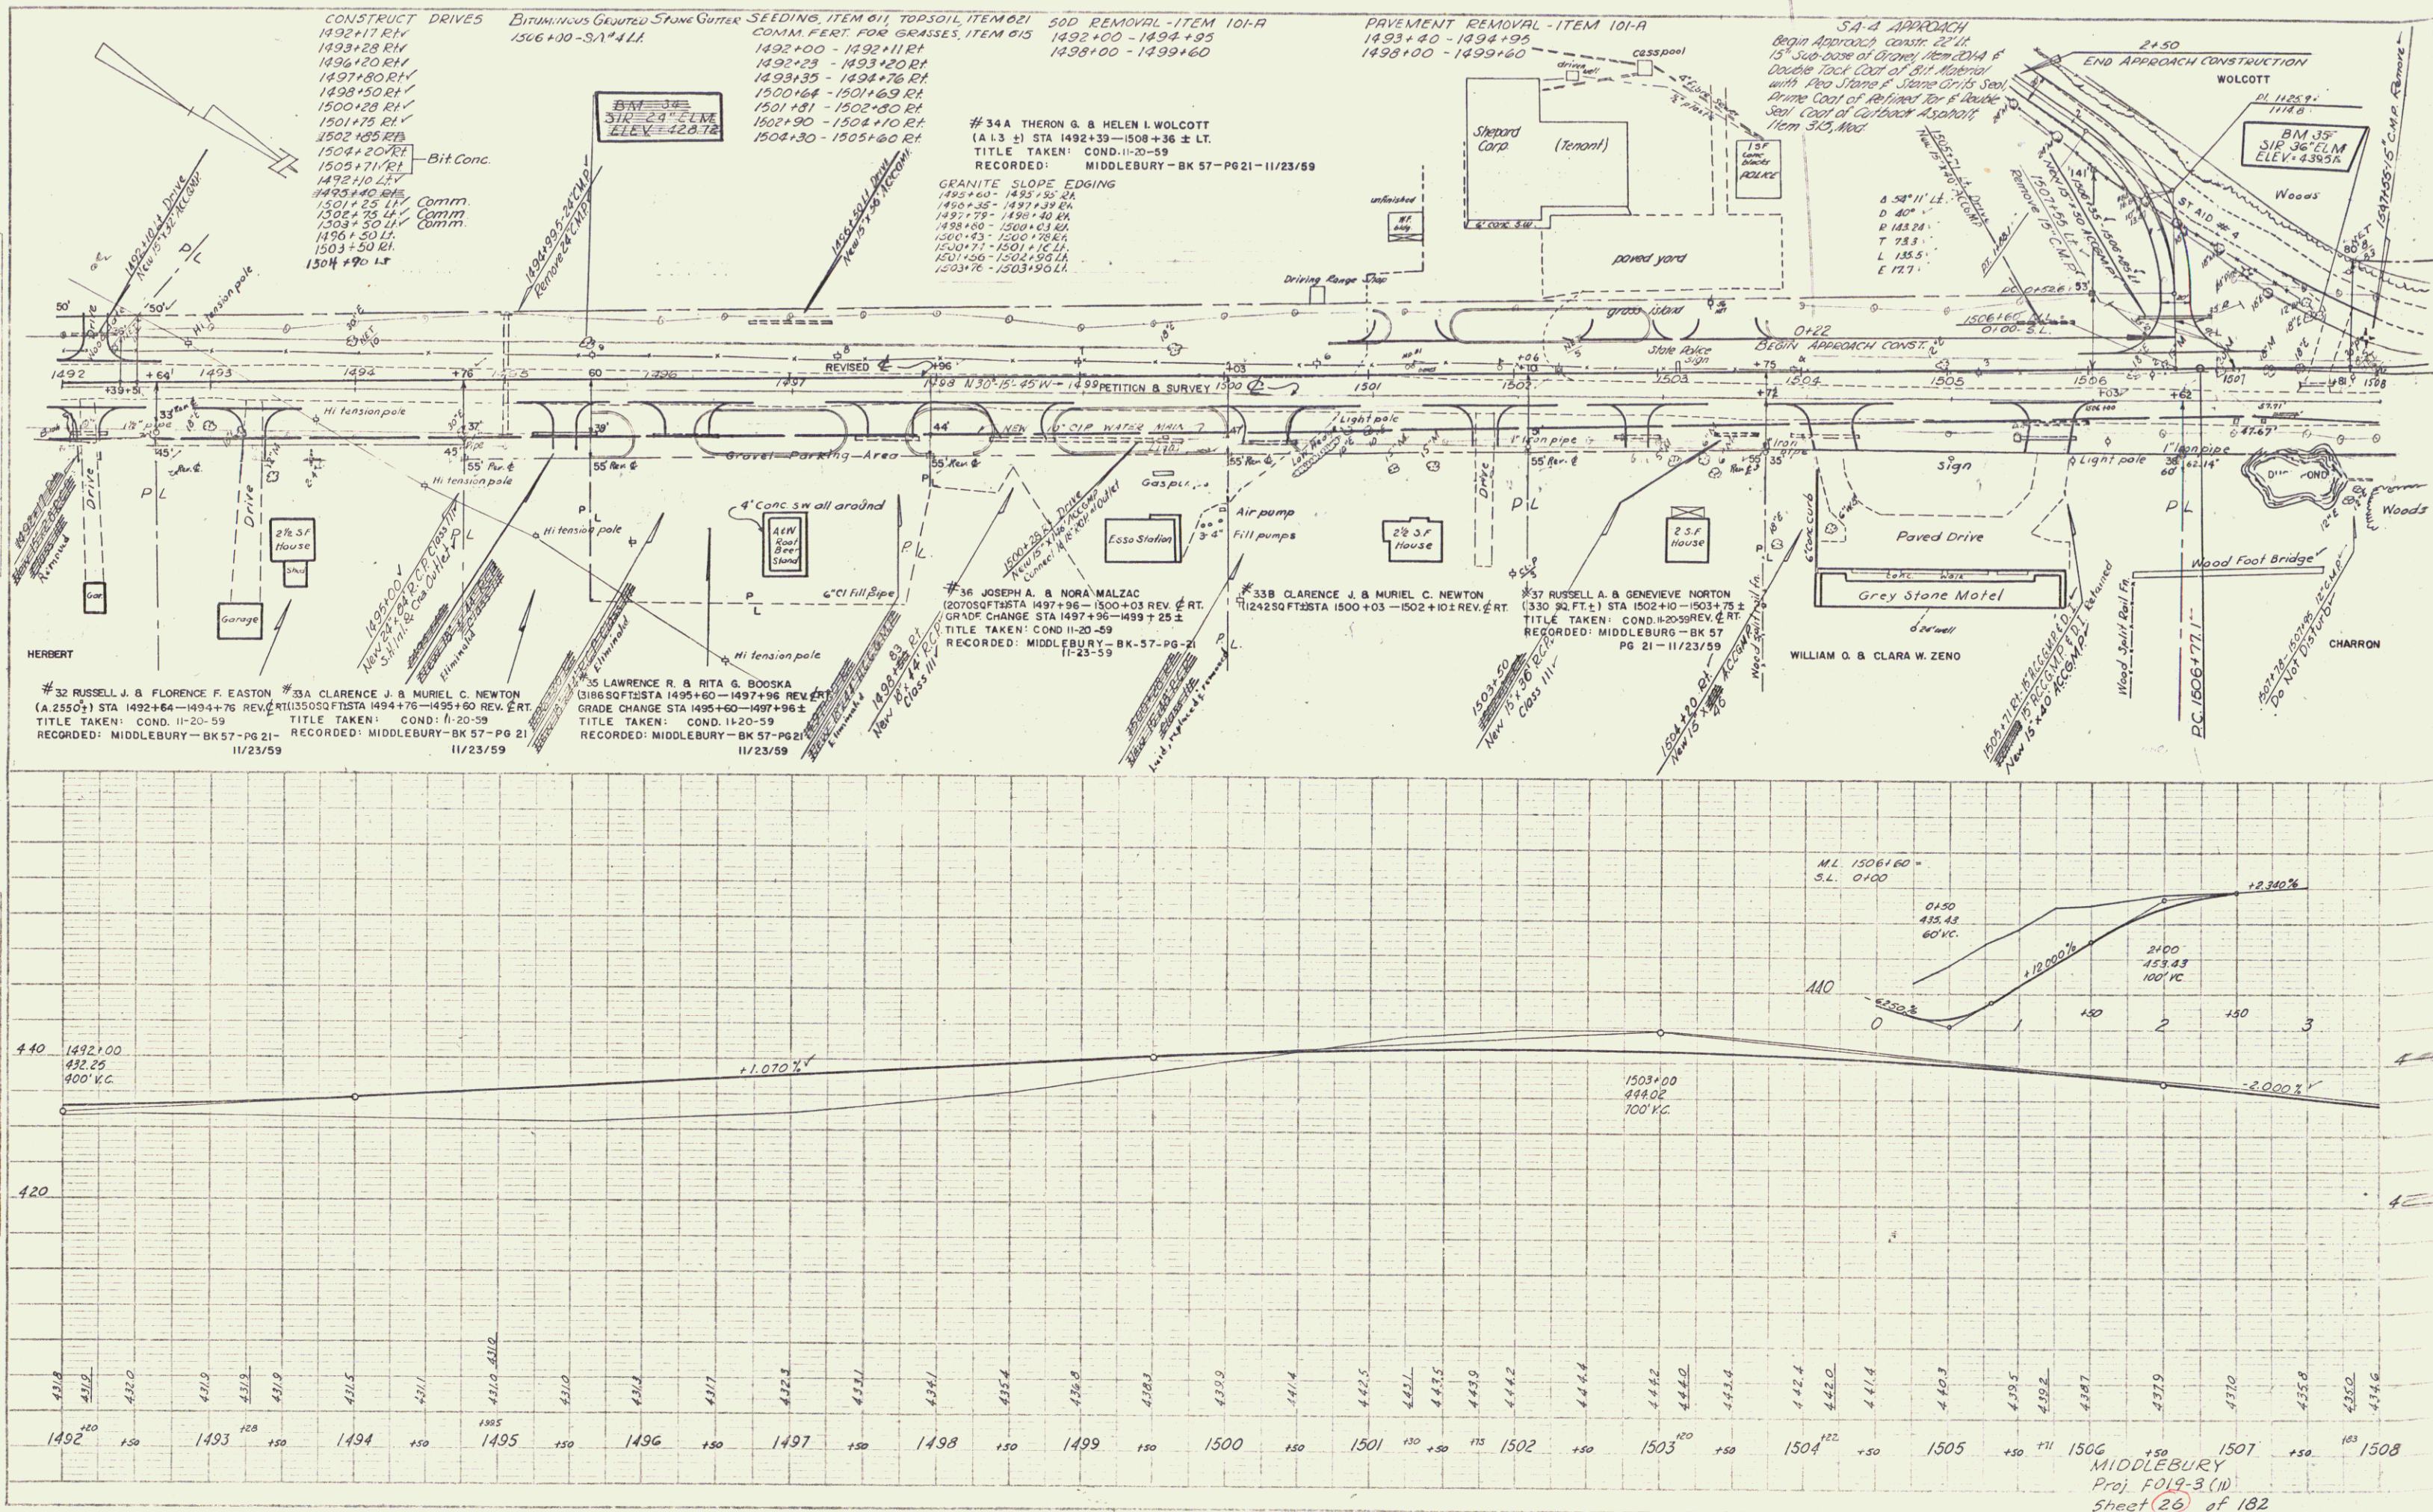

10
APR 25 1977



PLAN
DATE 5/58
BY J. H. BROWN
CHECKED BY J. H. BROWN
TRACED BY J. H. BROWN

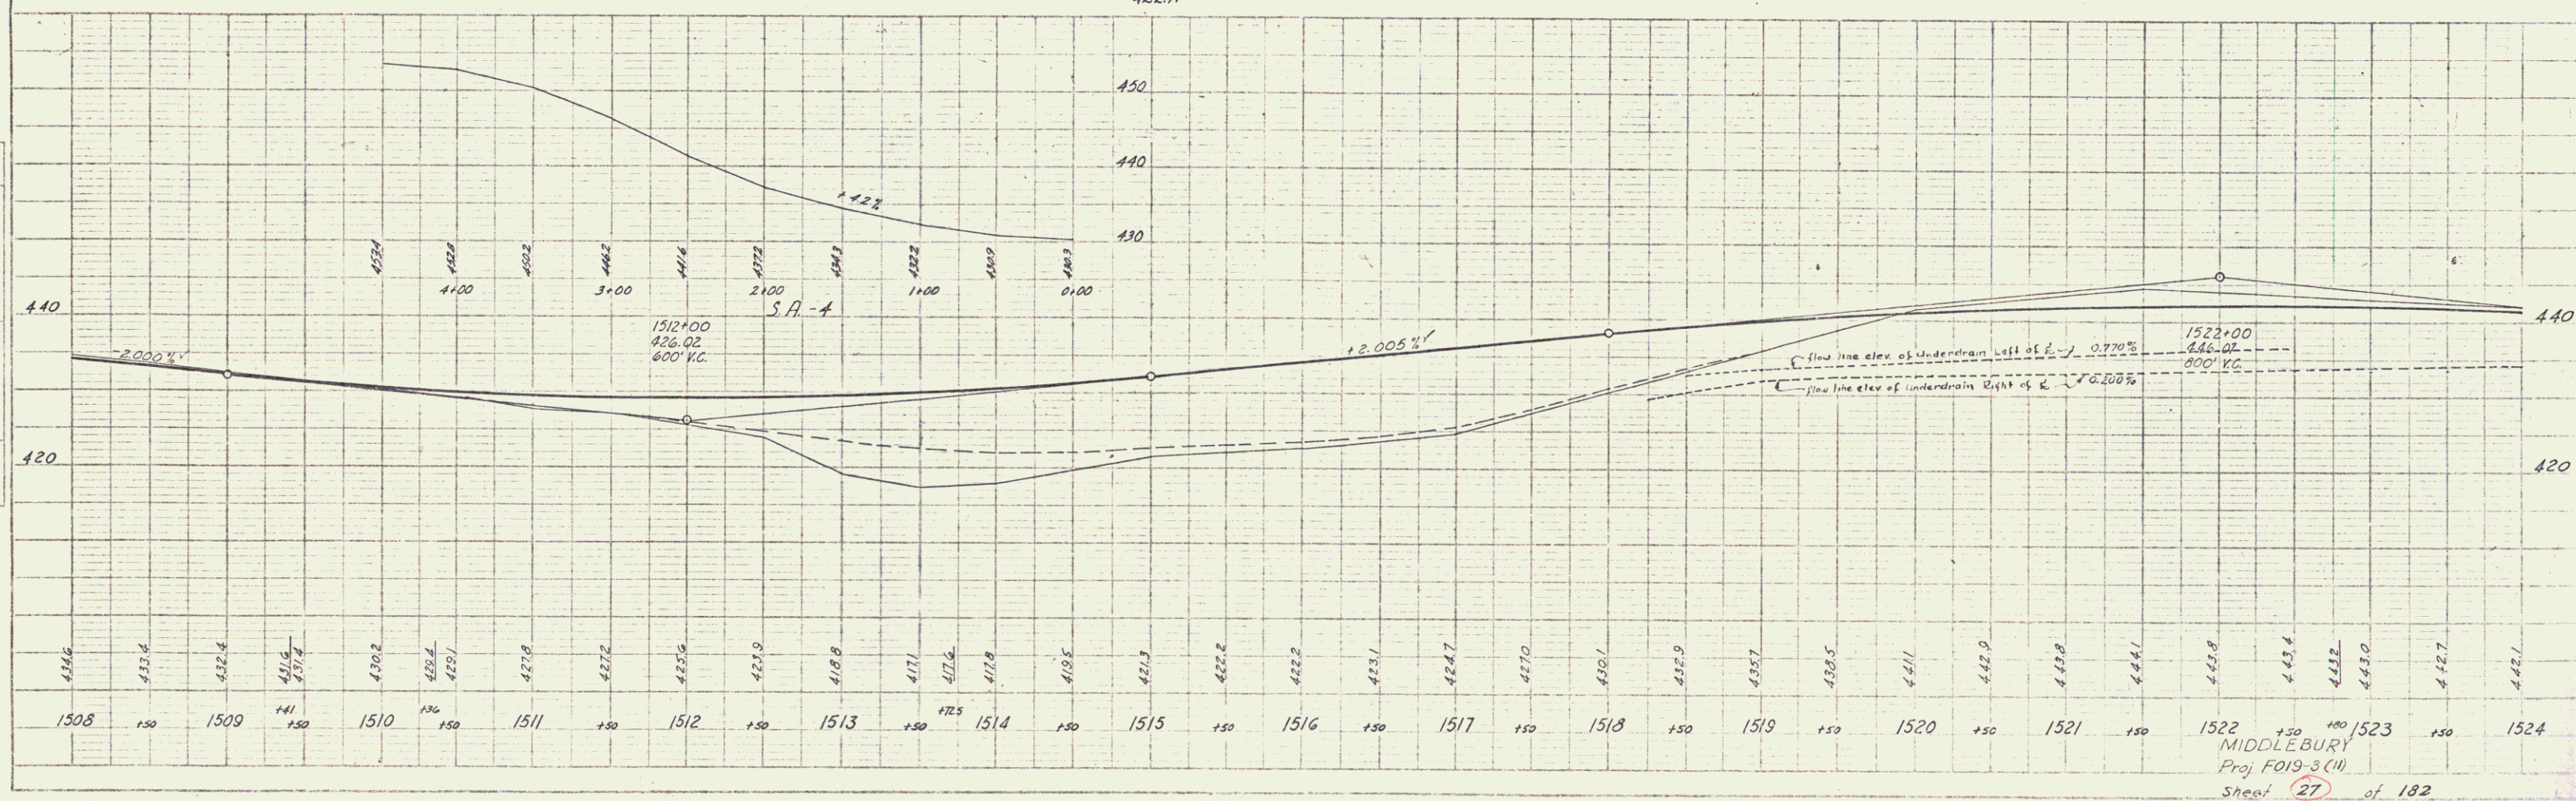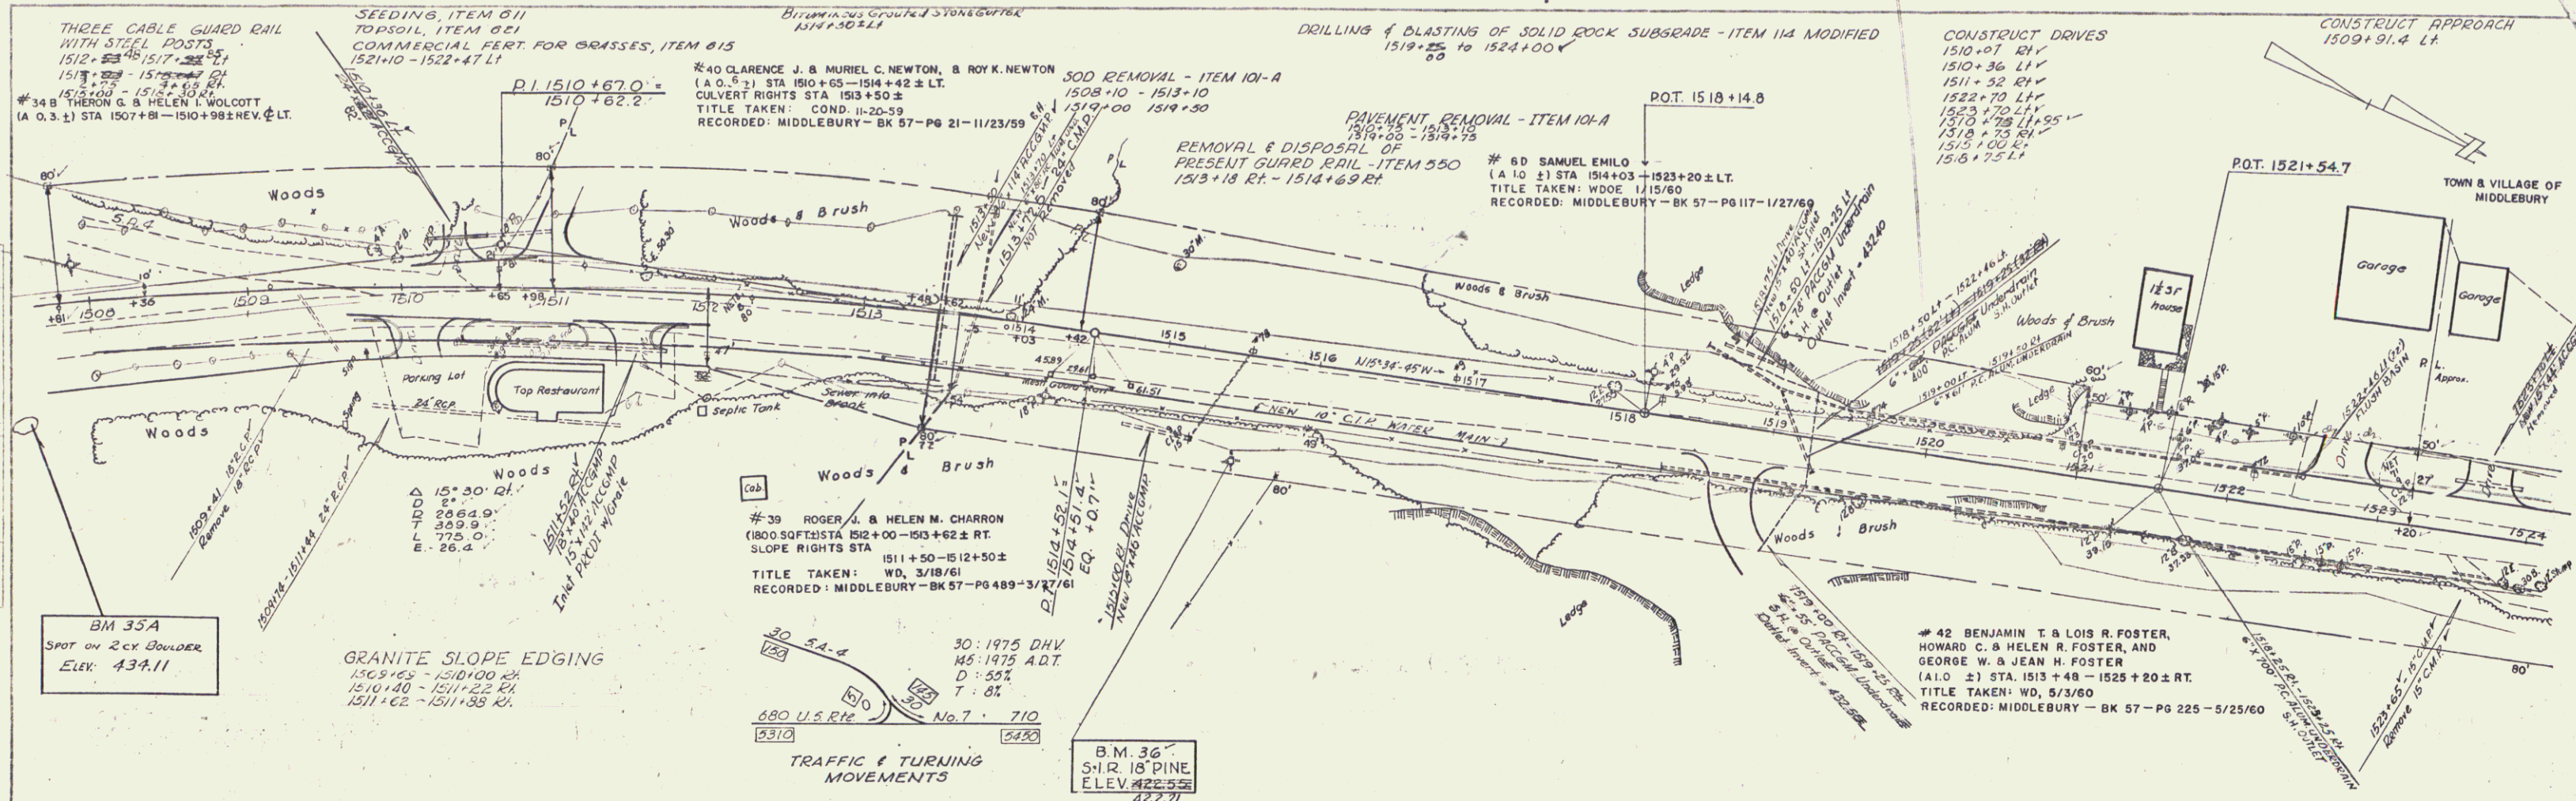

PROF.
DATE 5/58
BY J. H. BROWN
CHECKED BY J. H. BROWN
TRACED BY J. H. BROWN

MIDDLEBURY
Proj F019-3 (11)
Sheet 27 of 182

APR 25 1977



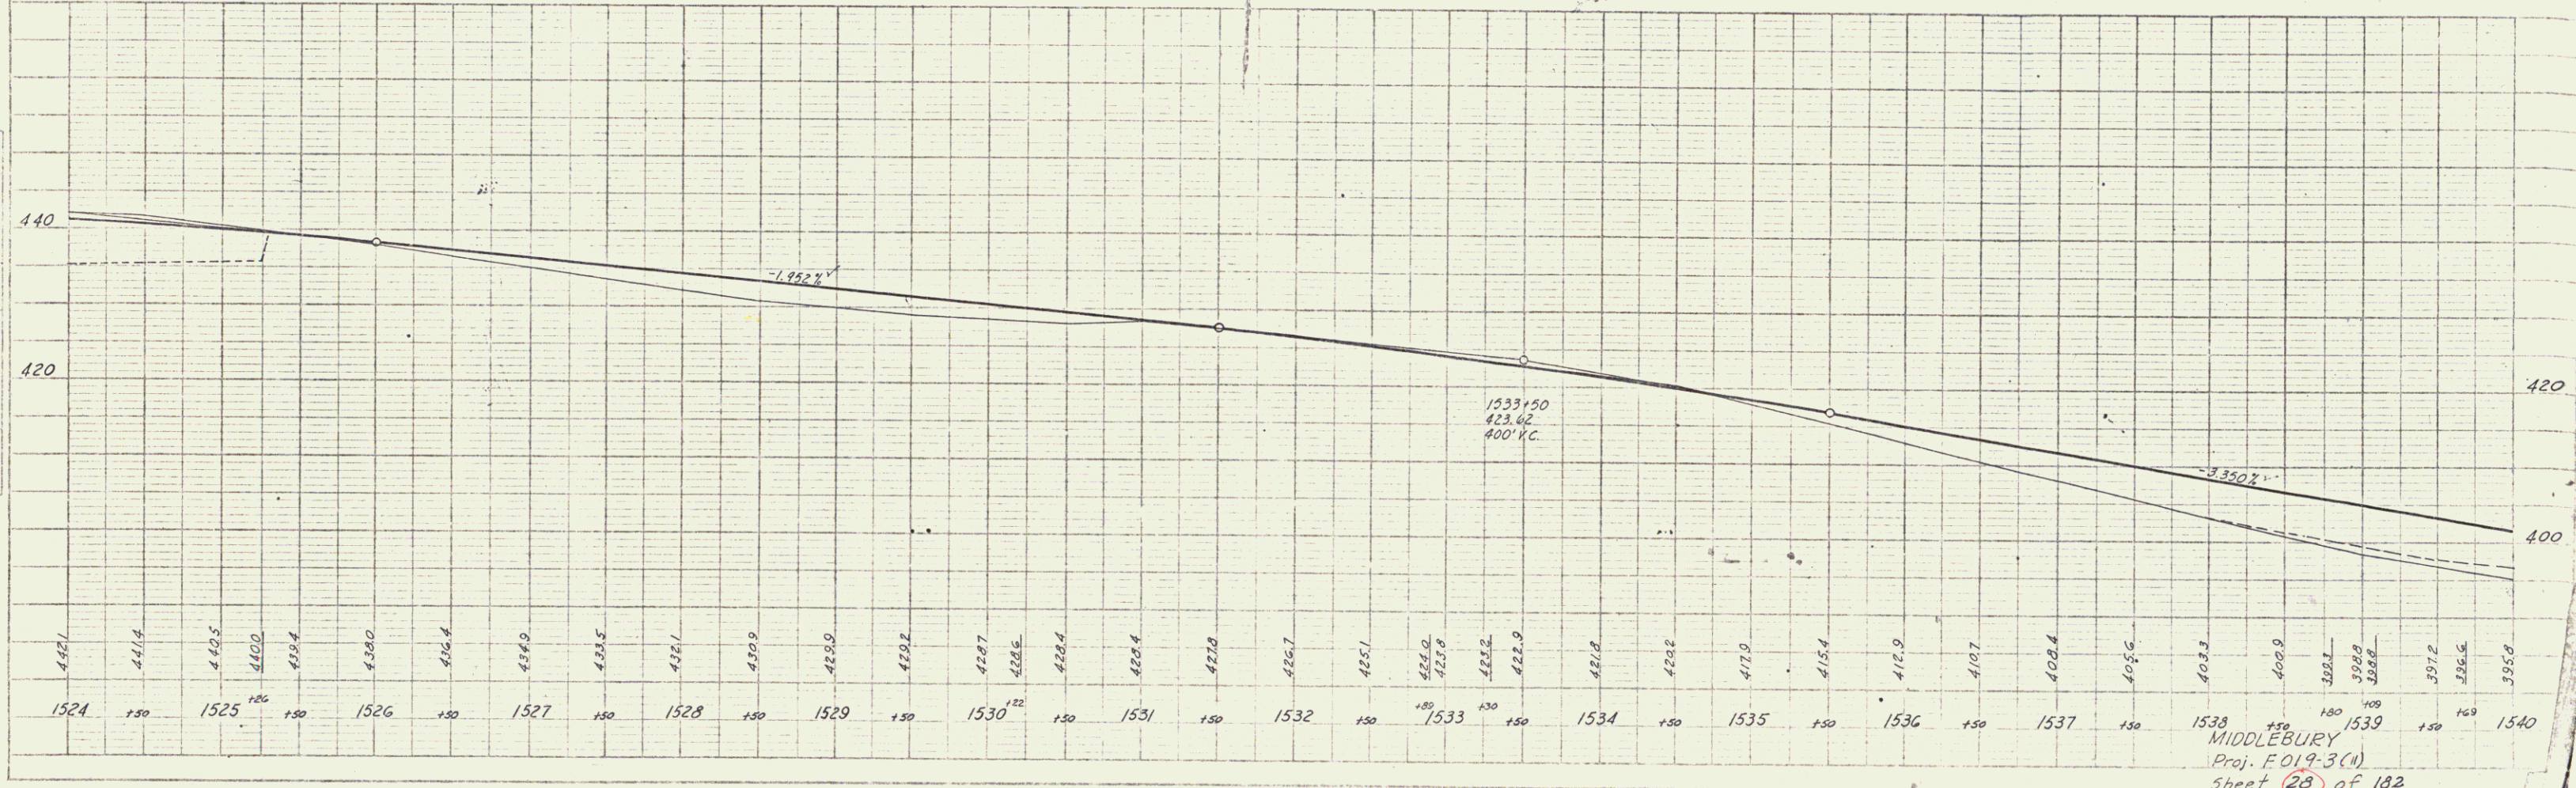
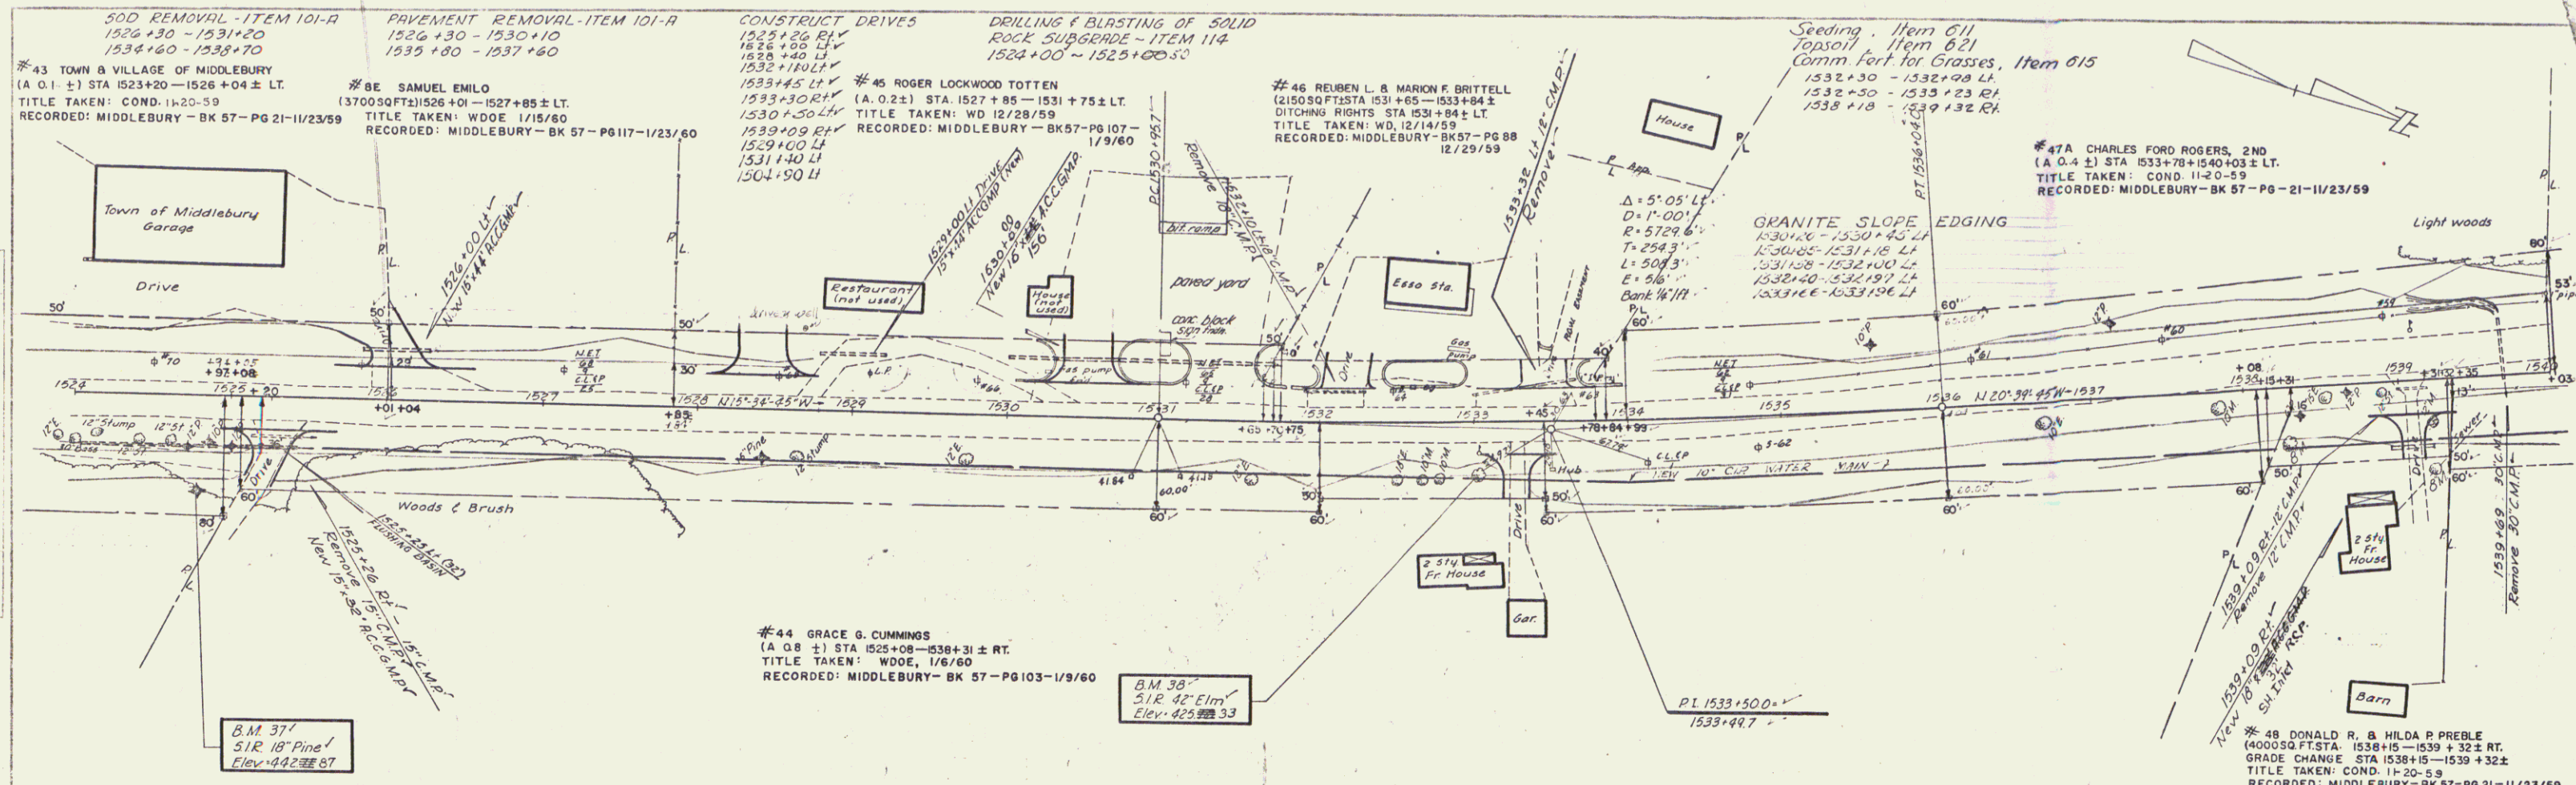


PLAN
DATE
BY
CHECKED
DATE
BY
T.D.B.
5-18

PROFILE
DATE
BY
CHECKED
DATE
BY
NO.

MIDDLEBURY
Proj. F019-3(1)
Sheet 28 of 182

12
APR 25 1977

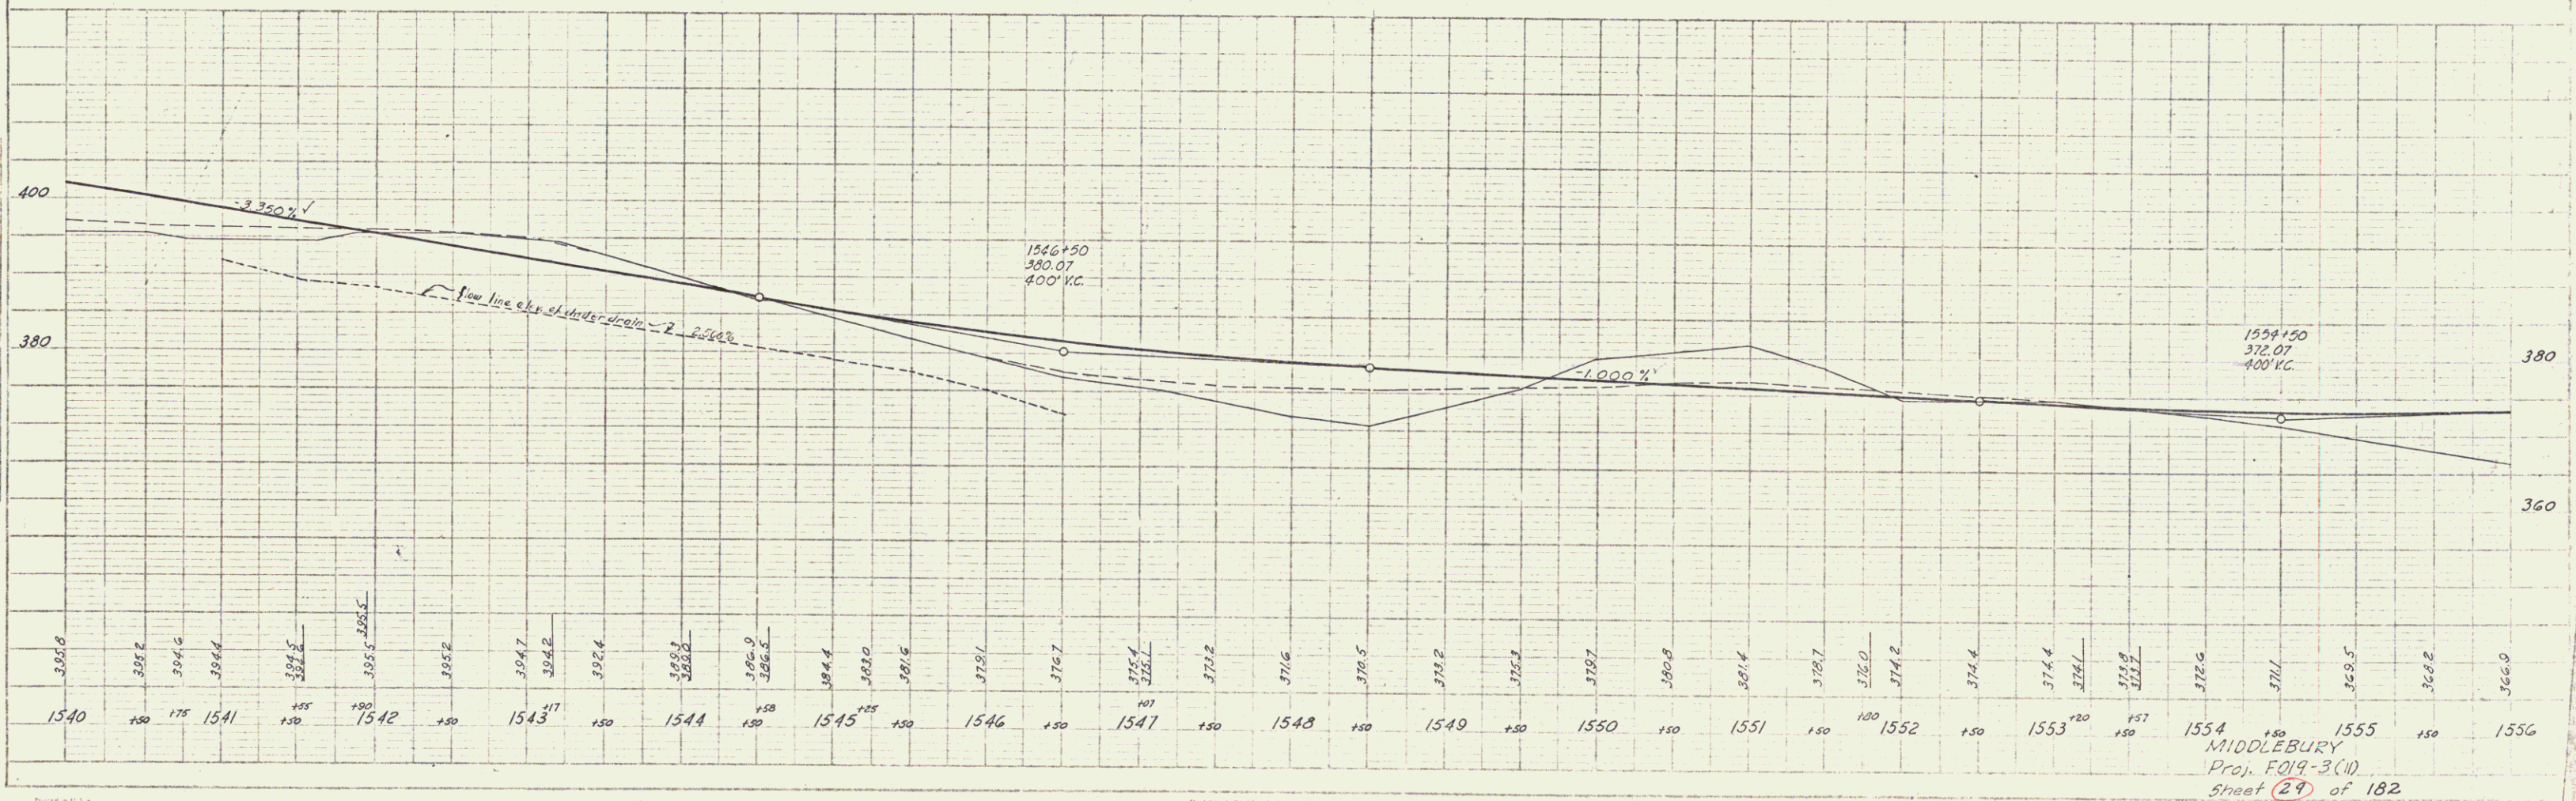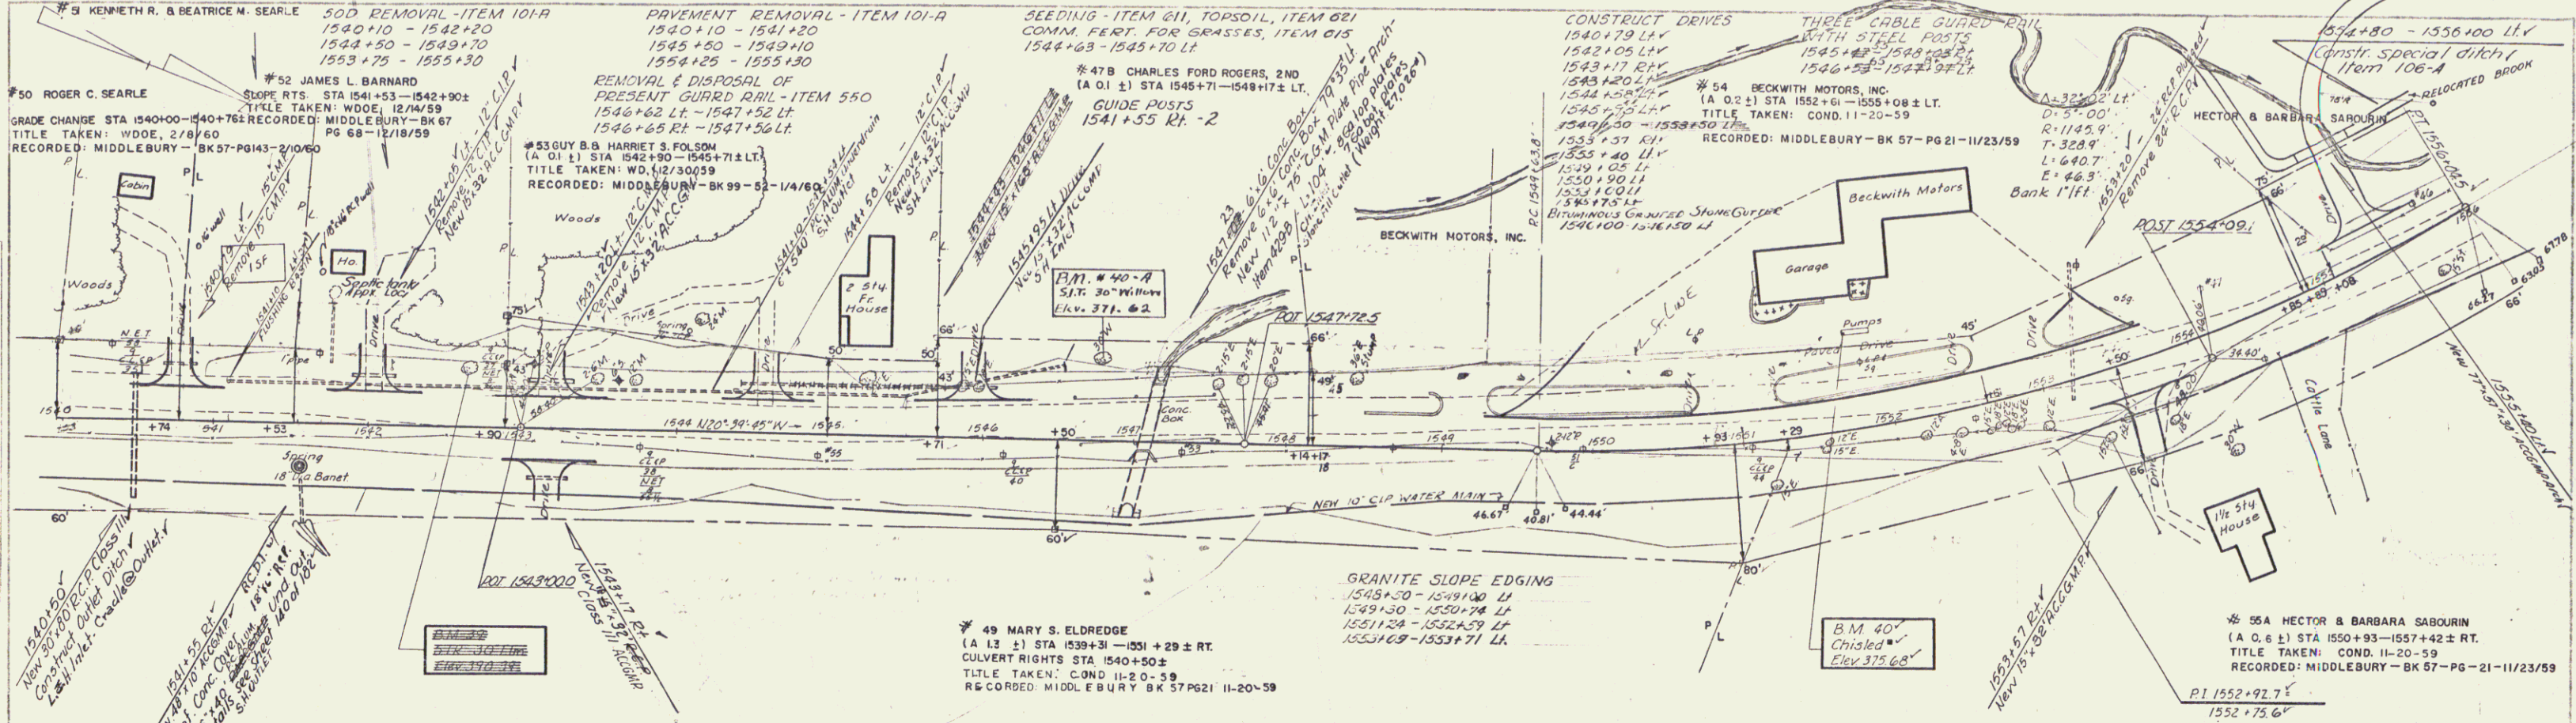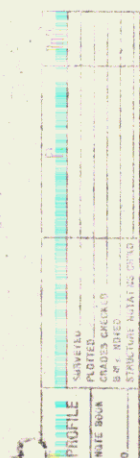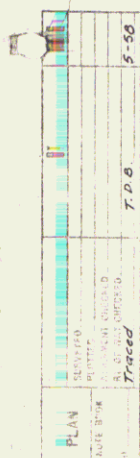

REMOVAL & DISPOSAL OF
PRESENT GUARD RAIL - ITEM 550
1571+26 - 1571+56 Lf & Rt.

500 REMOVAL - ITEM 101-A
1572+90 - 1573+70
1573+25 - 1573+10

#63A LENA G. & RALPH D. MYHRE
(A.O. 40) STA 1569+26 - 1573+40 ± LT.
DRAINAGE & DITCHING RIGHTS STA 1572+00 ±
GRADE CHANGE STA 1572+00 - 1573+50 ±
SLOPE RIGHTS STA 1573+40 - 1576+70 ± LT.
TITLE TAKEN: COND. 11-20-59
RECORDED: MIDDLEBURY - BK 57 -
PG 21-11/23/59

#63B LENA G. & RALPH D. MYHRE
(800 SQ FT) 1576+70 - 1577+34 ± RT.

PAVEMENT REMOVAL - ITEM 101-A
1572+90 - 1573+70
1573+75 - 1581+00
1577+20 - 1578+03 RICHARD & JEANETTE HEITMAN

CONSTRUCT APPROACH
1572+00 ± RT.

CONSTRUCT DRIVES
1573+05 Lf 100
1575+15 Lf 1
1579+36 Rt 1
1579+100 Lf 1
1579+100 Rt 1

SEEDING, ITEM 611 TOPSOIL, ITEM 621
COMM. FERT. FOR GRASSES, ITEM 615
1579+37 - 1581+20 Rt.

GUIDE POSTS
1573+50 Lf - 2
1573+80 Lf - 2
1576+75 Lf - 2
1578+30 - 1579+10 Lf - 7

