


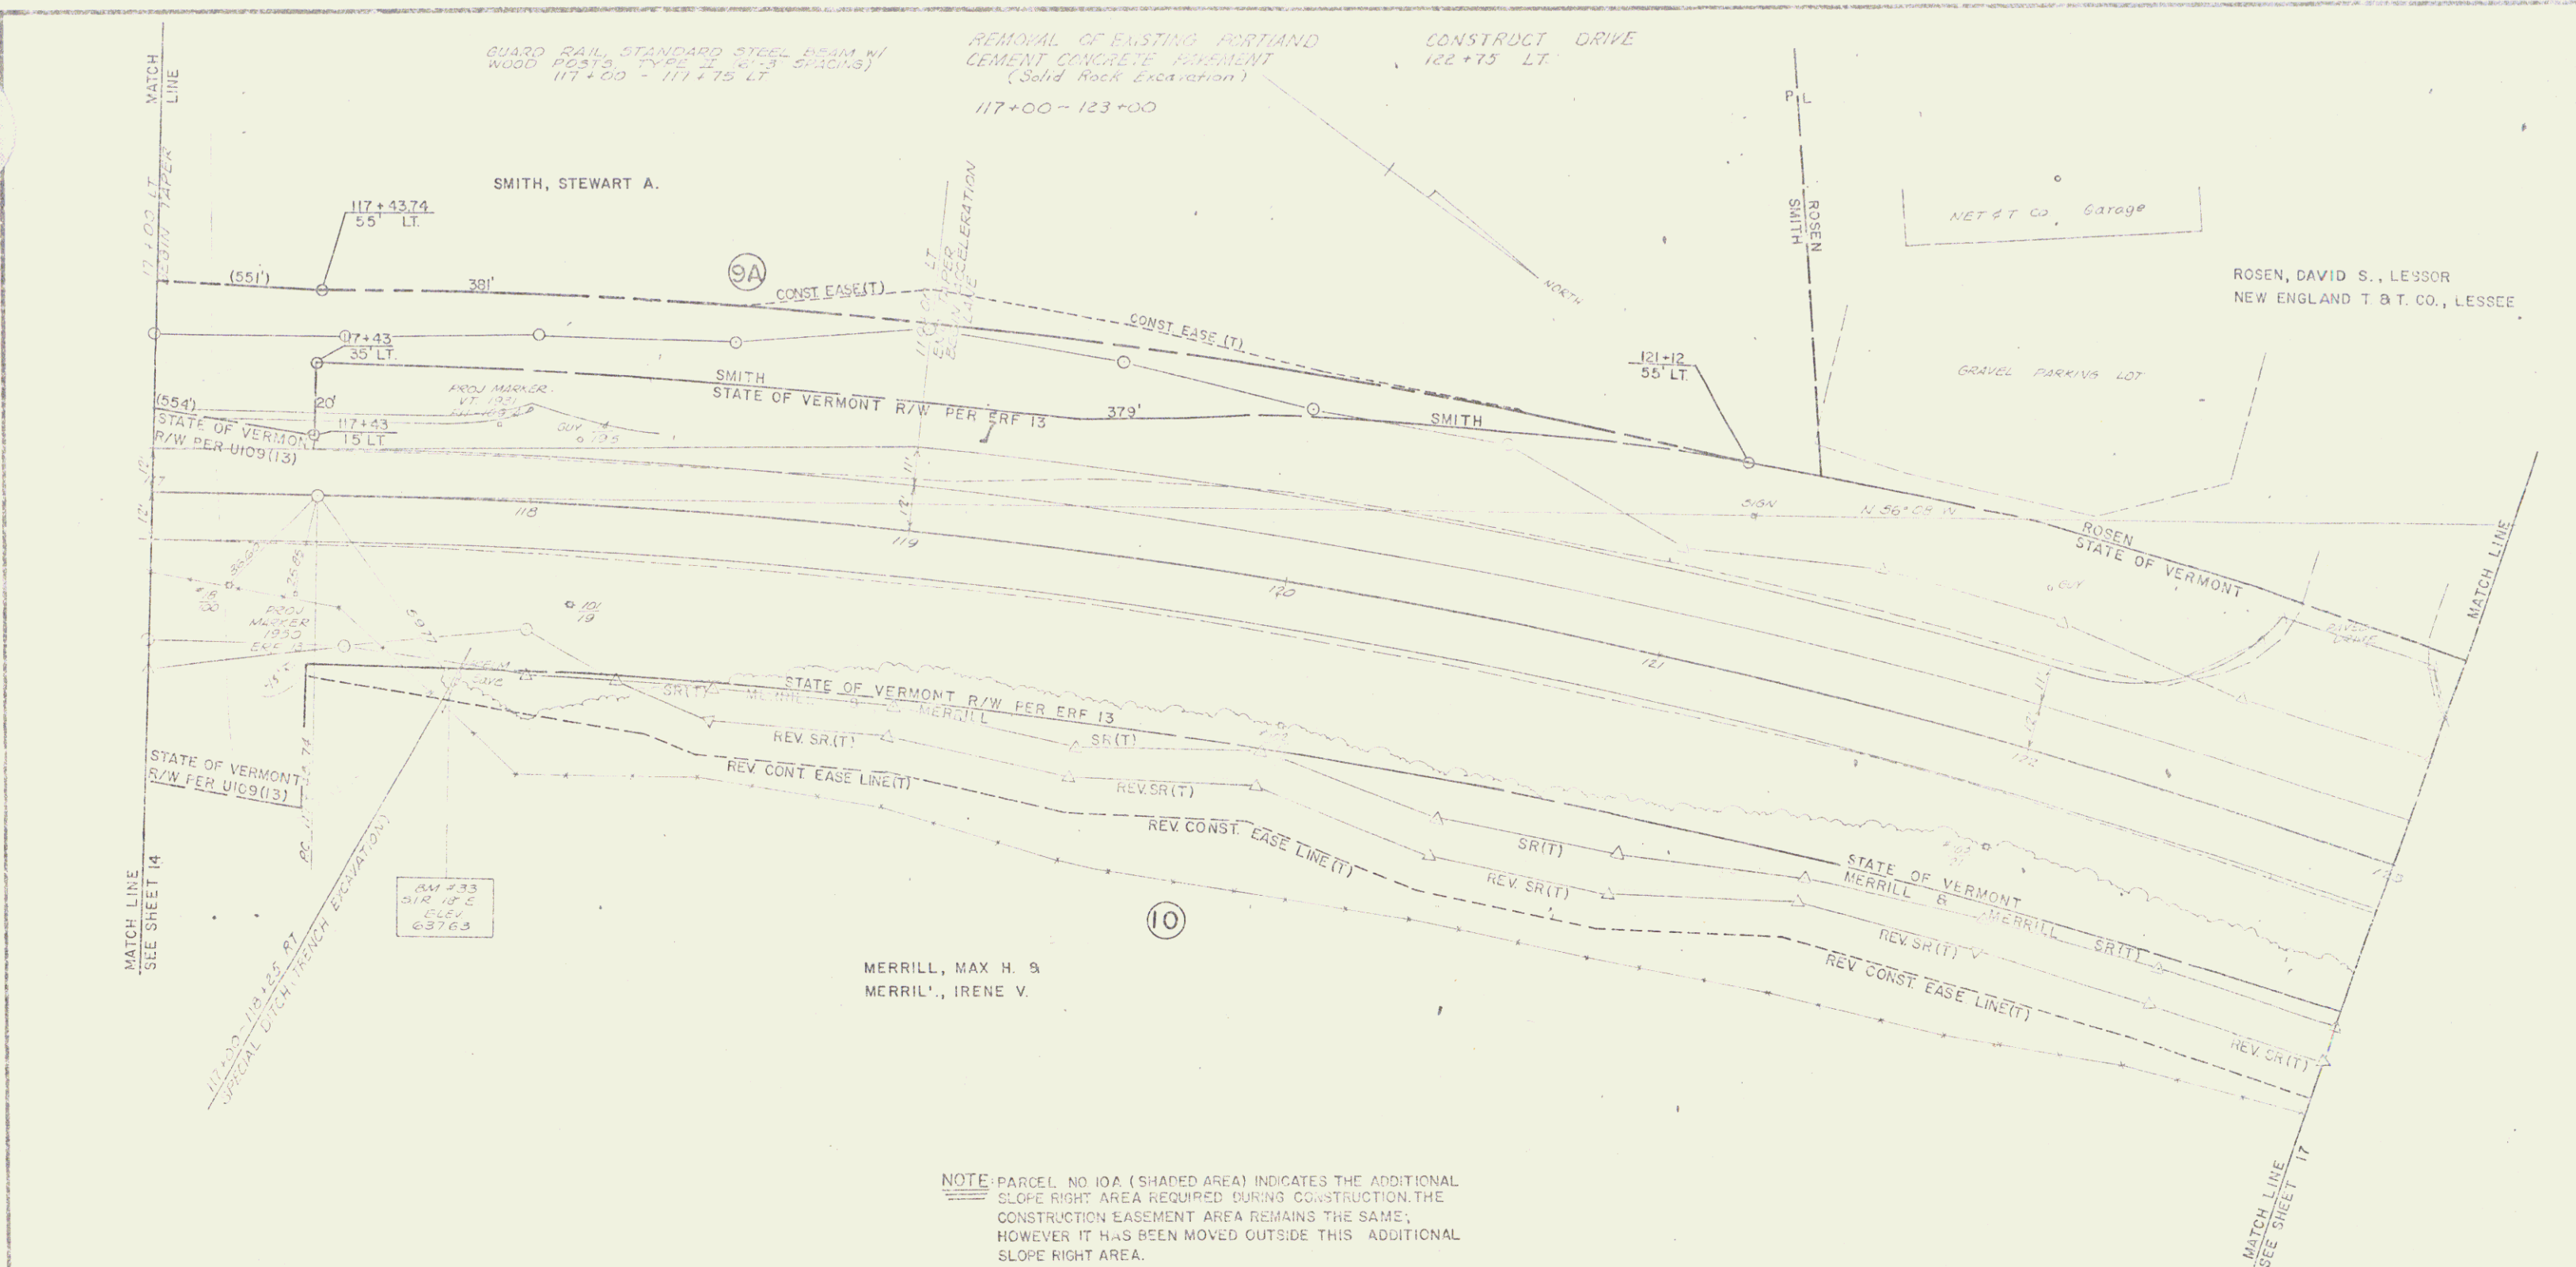

NOTE: PARCEL NO. 10A (SHADED AREA) INDICATES THE ADDITIONAL SLOPE RIGHT AREA REQUIRED DURING CONSTRUCTION. THE CONSTRUCTION EASEMENT AREA REMAINS THE SAME, HOWEVER IT HAS BEEN MOVED OUTSIDE THIS ADDITIONAL SLOPE RIGHT AREA.

DEC 21 1981

SURVEYED BY: [Signature]	
DRAWN BY: [Signature]	
CHECKED BY: [Signature]	
RUTLAND	
PROJECT NO. 010-5 (11)	
SHEET 6 OF 18	