




VERMONT AGENCY OF TRANSPORTATION

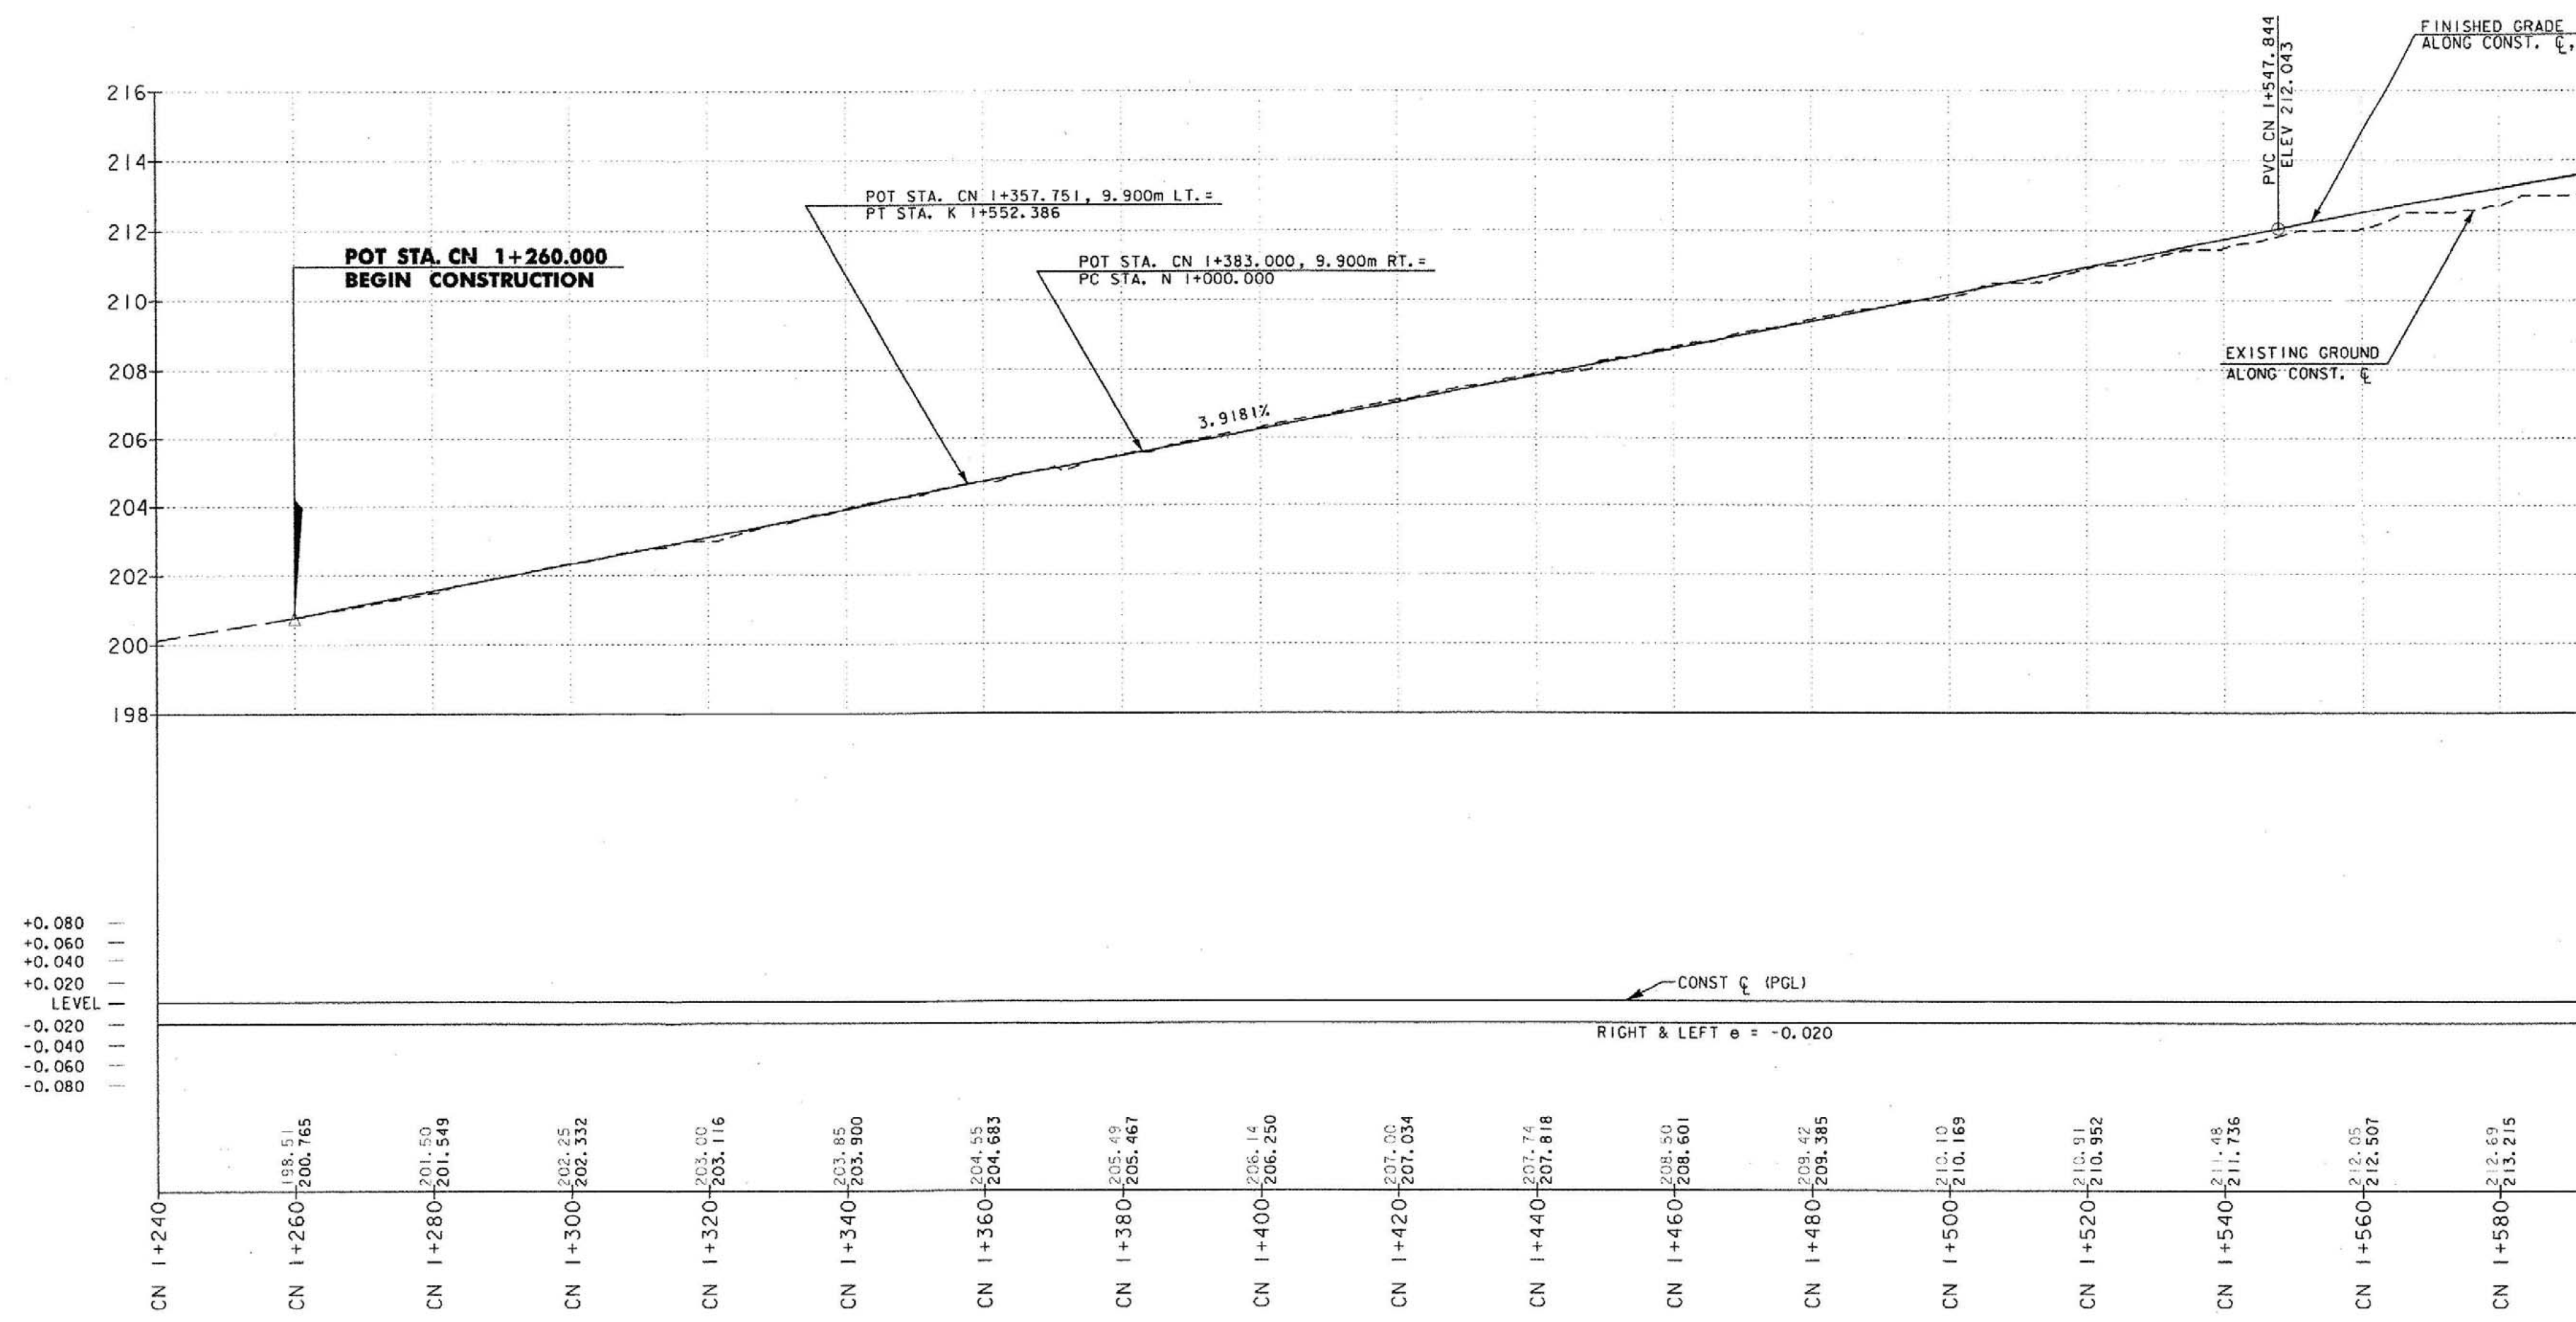

PROJECT NAME: BENNINGTON
PROJECT NUMBER: NH F019-1(5)

FILE NAME: ...Profiles\vt7Connector.prf
DESIGN SUPERVISOR: GREG EDWARDS
DESIGNED BY: MARC FOISY
ROUTE 7 CONNECTOR - PR-23

REVIEW

PLOT DATE: ...
DRAWN BY: ...
CHECKED BY: ...
SHEET 39