

INDEX OF SHEETS	
1	TITLE SHEET
2 - 4	TYPICAL SECTIONS OF IMPROVEMENT
5	PLATE PIPE ARCH DETAIL
6, 7	ALPHABETICAL INDEX OF OWNERS
8 - 35	RIGHT-OF-WAY DETAIL SHEETS
36 - 50	ROADWAY PLANS & PROFILES

STATE OF VERMONT AGENCY OF TRANSPORTATION





PROPOSED IMPROVEMENT TOWN OF TROY COUNTY OF ORLEANS

ROUTE 101 R.O.W. PLANS

LENGTH OF PROJECT = 21,465.02' FT. = 4.065 MI.
LENGTH OF PROJECT = 21,465.02' FT. = 4.065 MI.
LENGTH OF R.O.W. PROJECT = 21,529.39' FT. = 4.076 MI.

WORK DESCRIPTION
WORK TO BE PERFORMED UNDER THIS PROJECT INCLUDES GRADING, DRAINAGE, SUBBASE AND PAVEMENT FOR A STATE HIGHWAY GENERALLY ALONG EXISTING ALIGNMENT.

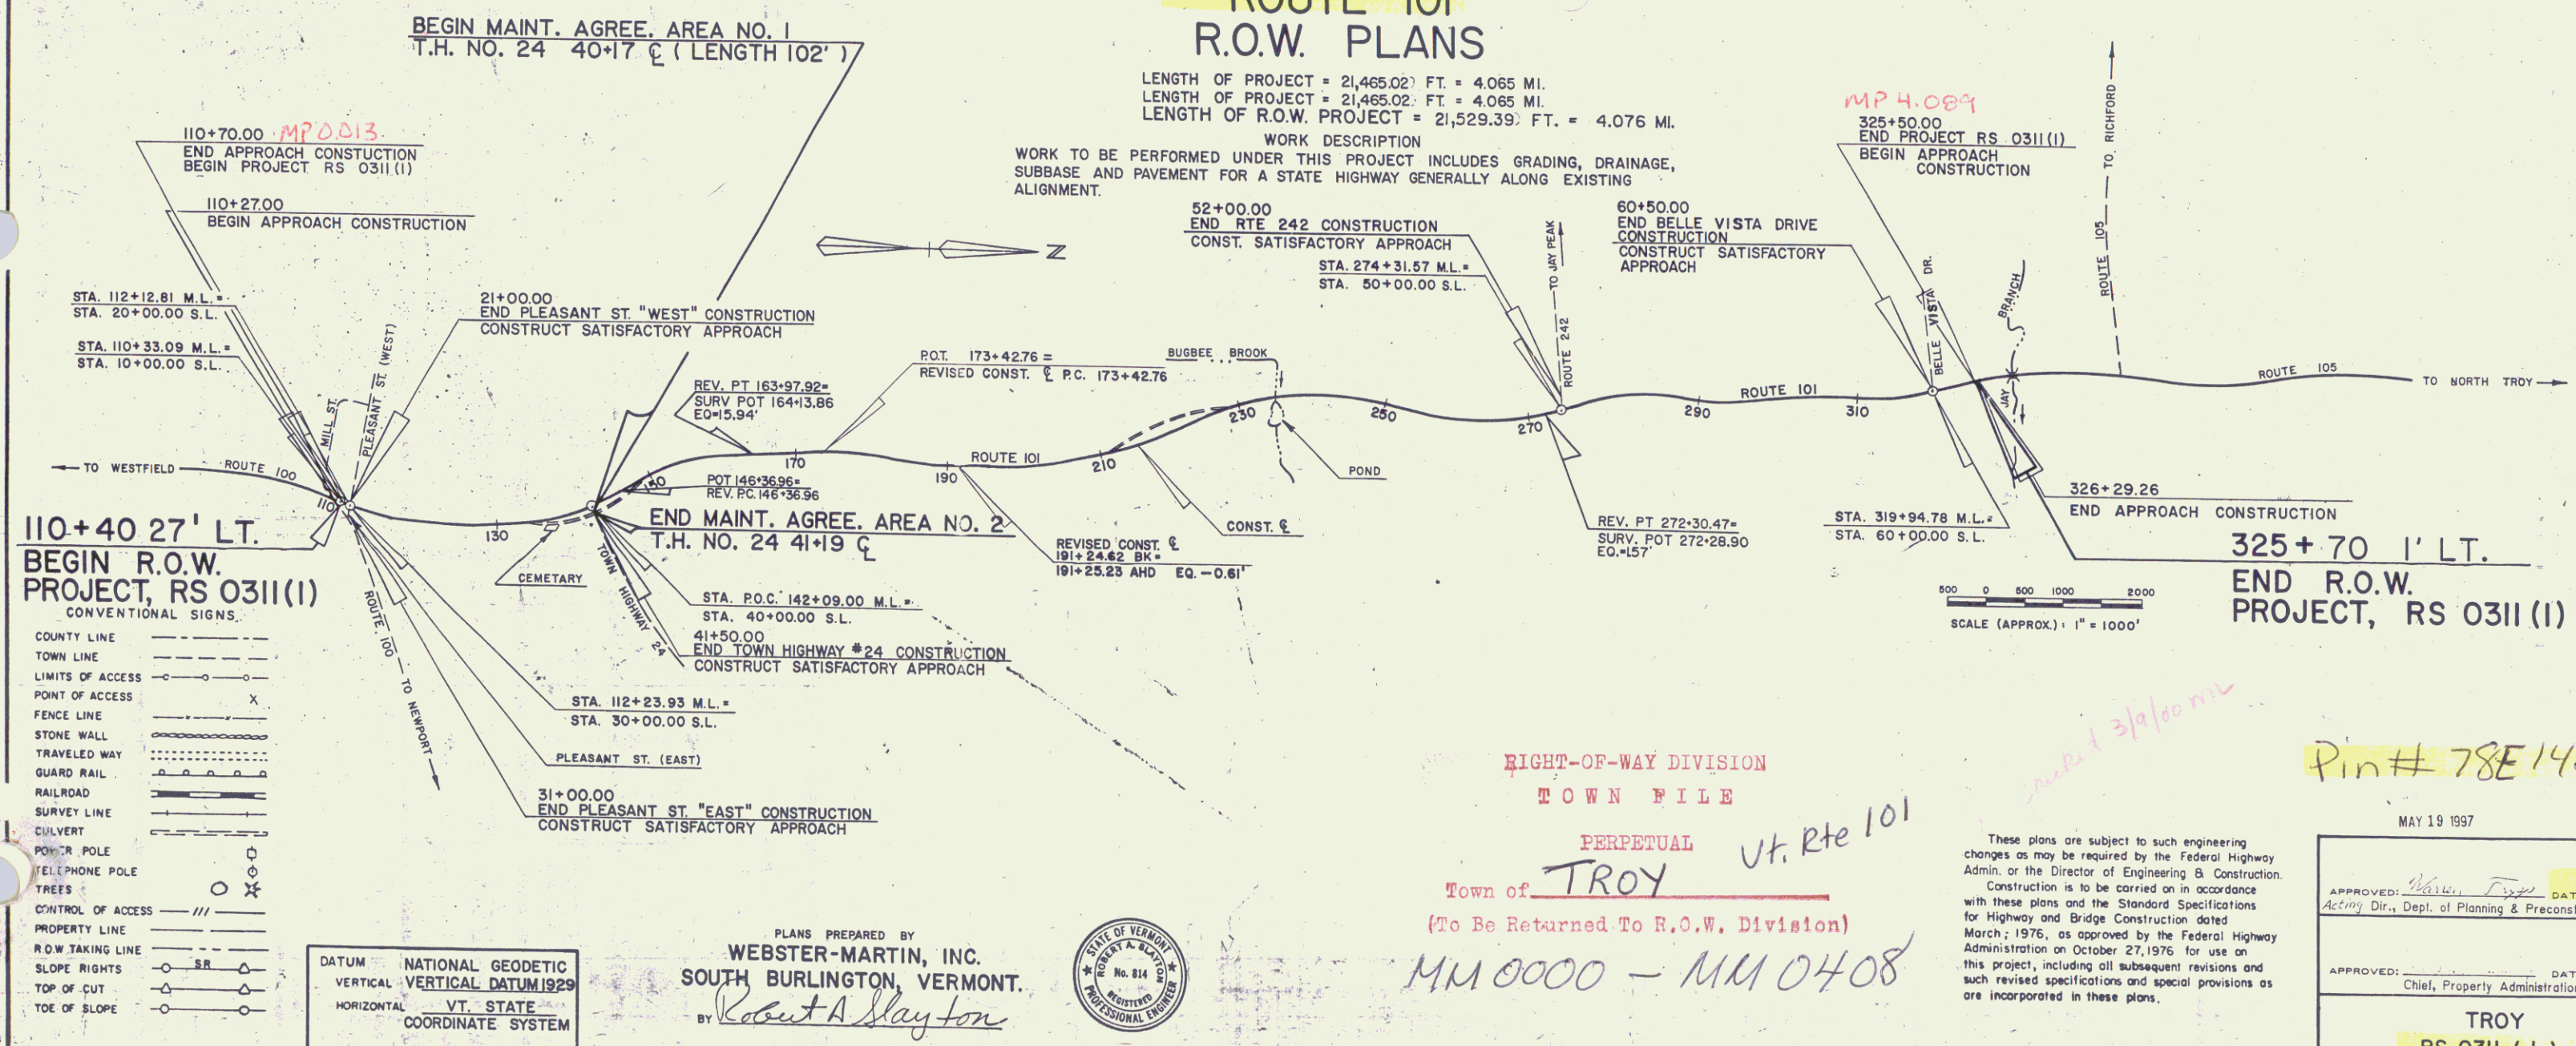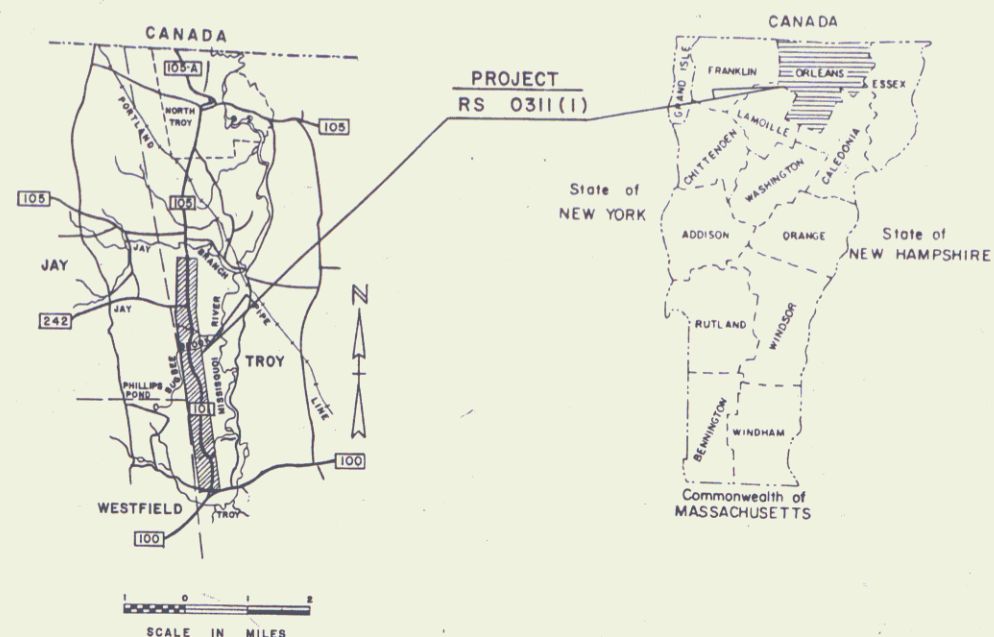

RIGHT-OF-WAY DIVISION
TOWN FILE

PERPETUAL
Town of TROY
(To Be Returned To R.O.W. Division)

MM 0000 - MM 0408

These plans are subject to such engineering changes as may be required by the Federal Highway Admin. or the Director of Engineering & Construction. Construction is to be carried on in accordance with these plans and the Standard Specifications for Highway and Bridge Construction dated March, 1976, as approved by the Federal Highway Administration on October 27, 1976 for use on this project, including all subsequent revisions and such revised specifications and special provisions as are incorporated in these plans.

Pin # 78E142

MAY 19 1997

APPROVED: Robert A. Clayton DATE: 3/24/97
Acting Dir., Dept. of Planning & Preconstruction

APPROVED: _____ DATE: _____
Chief, Property Administration

TROY
RS 0311(1)
SHEET 1 OF 50

PLANS PREPARED BY
WEBSTER-MARTIN, INC.
SOUTH BURLINGTON, VERMONT.
BY Robert A. Clayton



DATUM NATIONAL GEODETIC
VERTICAL VERTICAL DATUM 1929
HORIZONTAL VT. STATE
COORDINATE SYSTEM

TYPICAL SECTIONS

2 1/2" BITUMINOUS CONCRETE PAVEMENT, ITEM 406.25 (± 1/4")
(PLACE IN TWO LIFTS: 1" TYPE III, 1 1/2" TYPE II)

4" PLANT MIXED BASE COURSE, ITEM 303.25 (± 1/2")


24" SUBBASE OF GRAVEL, ITEM 301.15 (± 1")

SHOULDERS: 1" BITUMINOUS CONCRETE PAVEMENT, ITEM 406.25 (± 1/4")


0"-12" GRANULAR BORROW, ITEM 203.32 IN FILL (± 1")

0"-24" SAND BORROW, ITEM 203.31 IN CUT (± 1")


PERMISSIBLE TOLERANCES IN PARENTHESES APPLY TO THICKNESS ONLY.

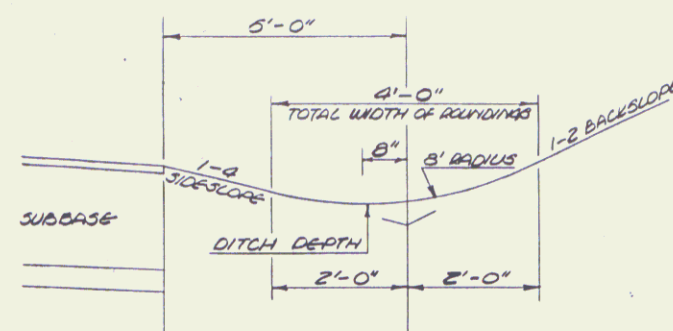


TYPICAL DITCH DETAIL
N.T.S.

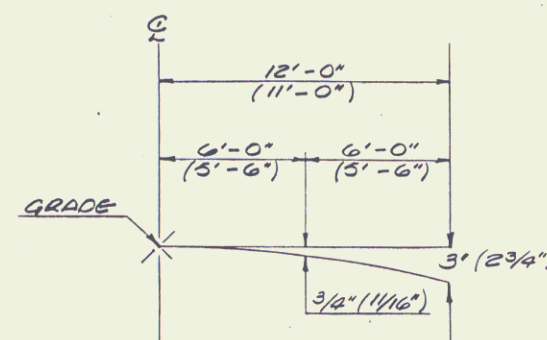


PARABOLIC DETAIL
N.T.S.

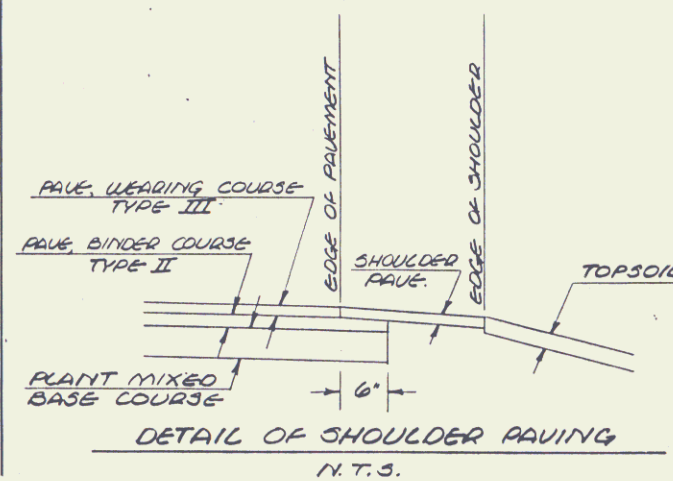

DETAIL OF SHOULDER PAVING
N.T.S.

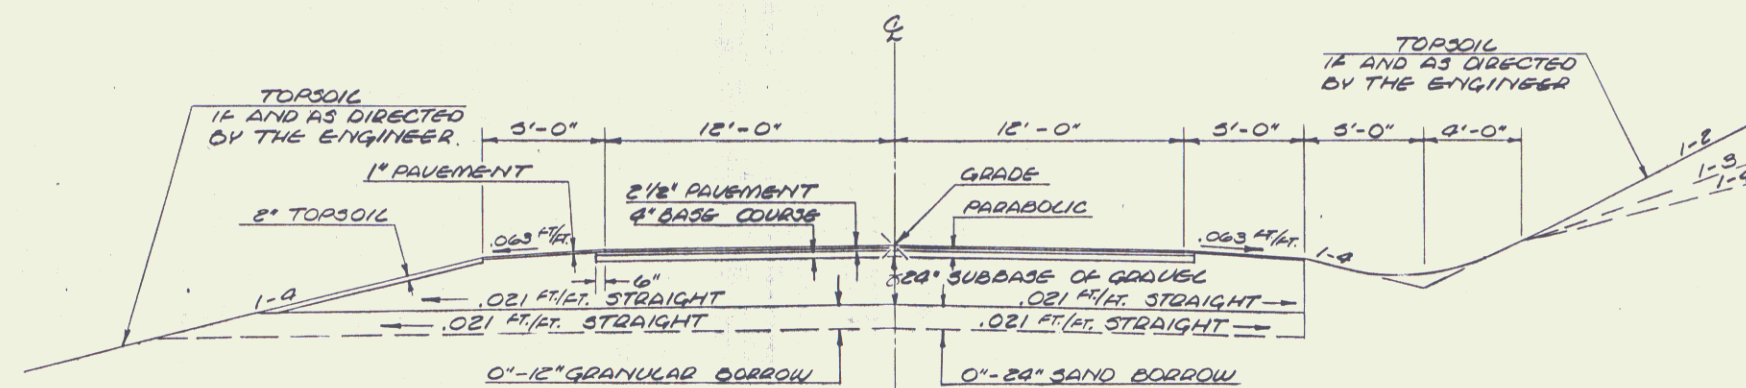

NORMAL SECTION

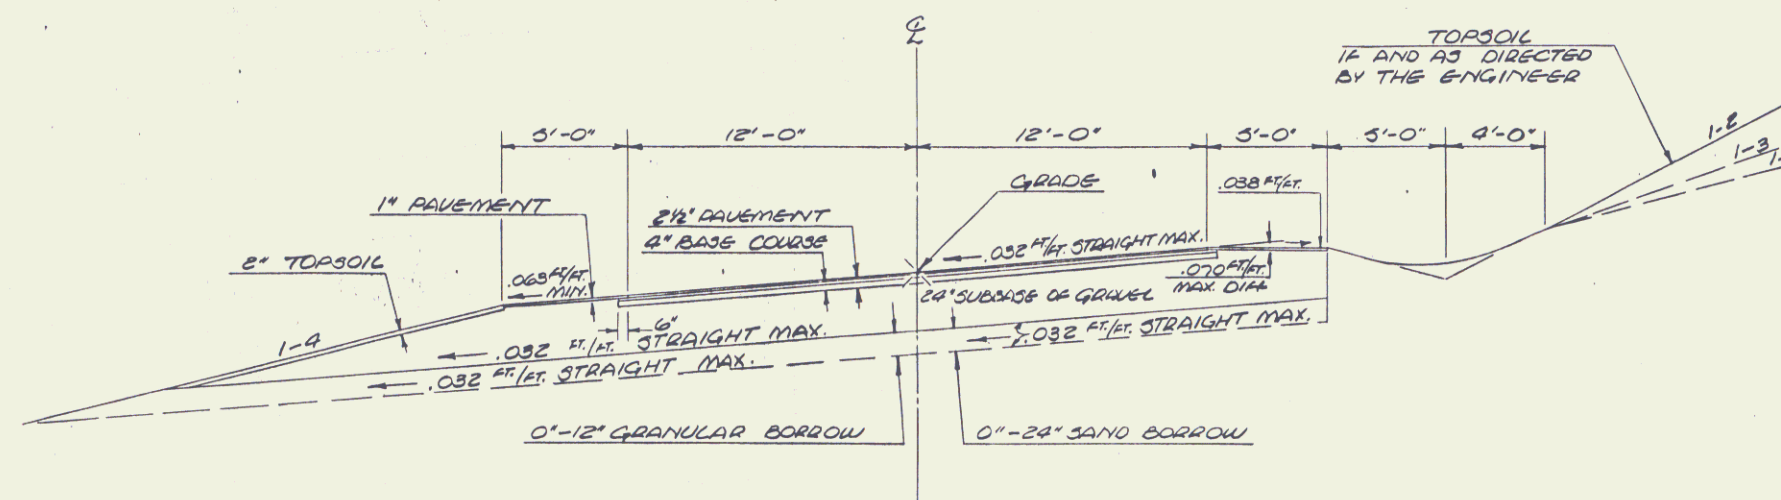

BANKED SECTION

MAINLINE 110+00 - 139+00
317+50 - 320+00 LT.

SCALE: 1/4" = 1' FEET

GENERAL NOTES

SEED, ITEM 651.10 TO BE APPLIED AS DIRECTED BY THE ENGINEER				
WT	LBS/A	NAME	PUR	GERM
3.33	2	CROWN VETCH	97	75
50.00	30	CREEPING RED FESCUE	98	85
8.33	5	TIMOTHY	99	85
16.67	10	PERENNIAL RYE GRASS (VAR. PENNFINE)	95	85
8.34	5	ALPALFA (VAR. SARANAC)	99	85
8.33	5	BIRDFOOT TREFOIL (VAR. EMPIRE)	98	85
5.00	3	HIGHLAND BENT GRASS	92	85
100.00	50	LBS/ACRE		

THE SEED MIXTURE SHALL NOT HAVE A WEED CONTENT EXCEEDING 0.40% BY WEIGHT AND SHALL BE FREE FROM ALL NOXIOUS WEED SEED

FERTILIZER, ITEM 651.15
FORMULA 10-20-10 TO BE USED WITH SEED, ITEM 651.10
APPLIED AT THE RATE OF 500 LBS/ACRE

AGRICULTURAL LIMESTONE, ITEM 651.20
TO BE APPLIED AT A RATE OF 2 TONS/ACRE OR AS DIRECTED BY THE ENGINEER

HAY MULCH, ITEM 651.25
TO BE PLACED ON EARTH SLOPES AT THE RATE OF 2 TONS/ACRE

TOPSOIL, ITEM 653.10
TO BE USED WITH SEED, ITEM 651.10 IN RESIDENTIAL AREAS, AS DIRECTED BY THE ENGINEER

SEE STANDARD SHEET B-5 FOR TYPICAL SLOPE ROUNDING

SEE STANDARD SHEET D-2 FOR PAY LIMITS OF SAND BORROW WHEN USED IN CONJUNCTION WITH UNDERDRAIN

MAY 19 1997

SURVEYED BY: GLC/GAG DATE: 08-85
DRAWN BY: REM DATE: 07-85
TOWN: TROY, VERMONT
ROUTE: ROUTE 101
PROJ. NO. 0311(1)
SHEET 2 OF 50

TYPICAL SECTIONS

2 1/2" BITUMINOUS CONCRETE PAVEMENT, ITEM 406.25 ($\pm 1/4"$)
(PLACE IN TWO LIFTS: 1" TYPE III, 1 1/2" TYPE II)

4" PLANT MIXED BASE COURSE, ITEM 303.25 ($\pm 1/2"$)

24" SUBBASE OF GRAVEL, ITEM 301.15 ($\pm 1"$)






SHOULDERS: 1" BITUMINOUS CONCRETE PAVEMENT, ITEM 406.25 ($\pm 1/4"$)

0"-12" GRANULAR BORROW, ITEM 203.32 IN FILL ($\pm 1"$)

0"-24" SAND BORROW, ITEM 203.31 IN CUT ($\pm 1"$)

PERMISSIBLE TOLERANCES IN
PARENTHESES APPLY TO
THICKNESS ONLY.

FOR: GENERAL NOTES,
PARABOLIC DETAIL,
SHOULDER PAVING DETAIL
SEE SHEET ____ OF ____

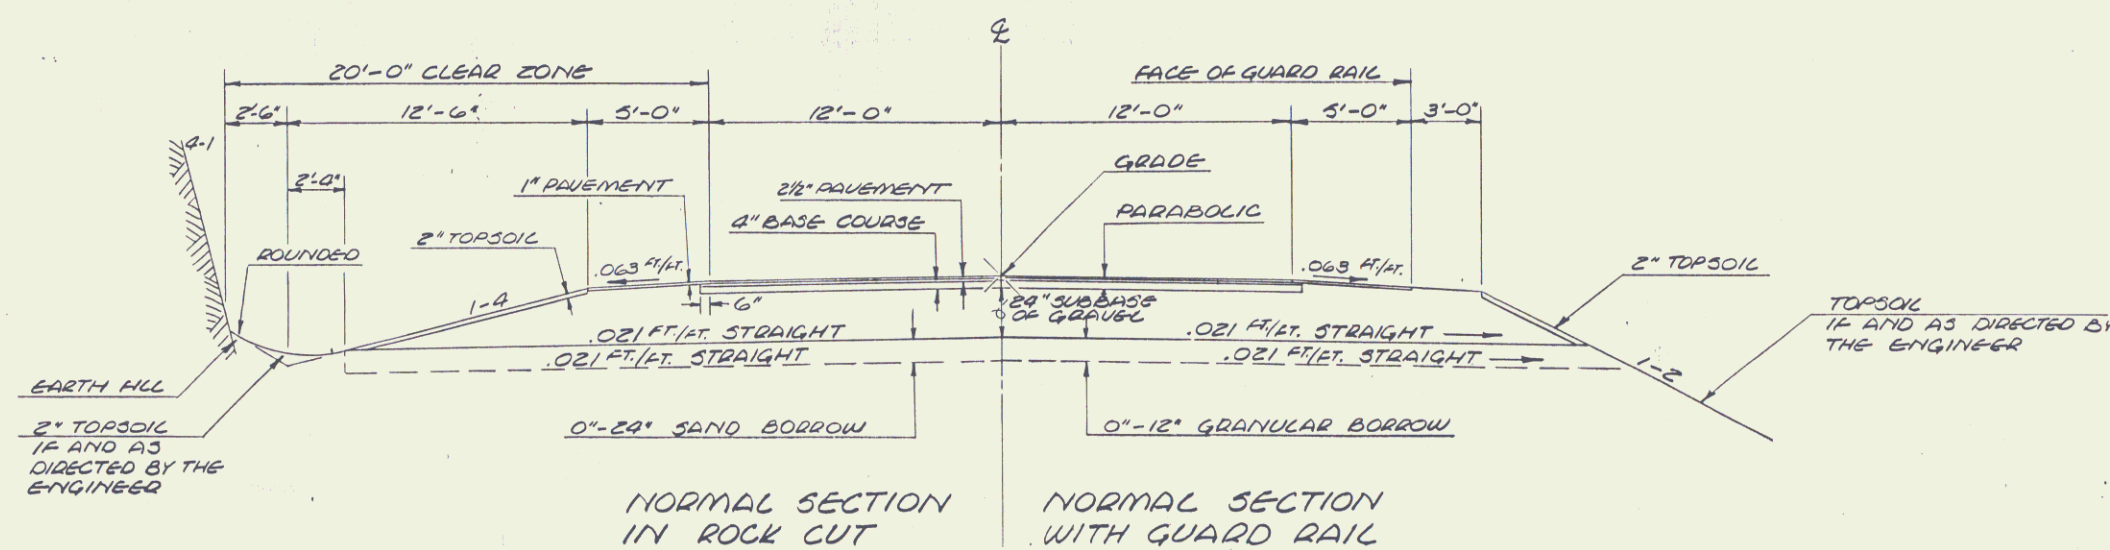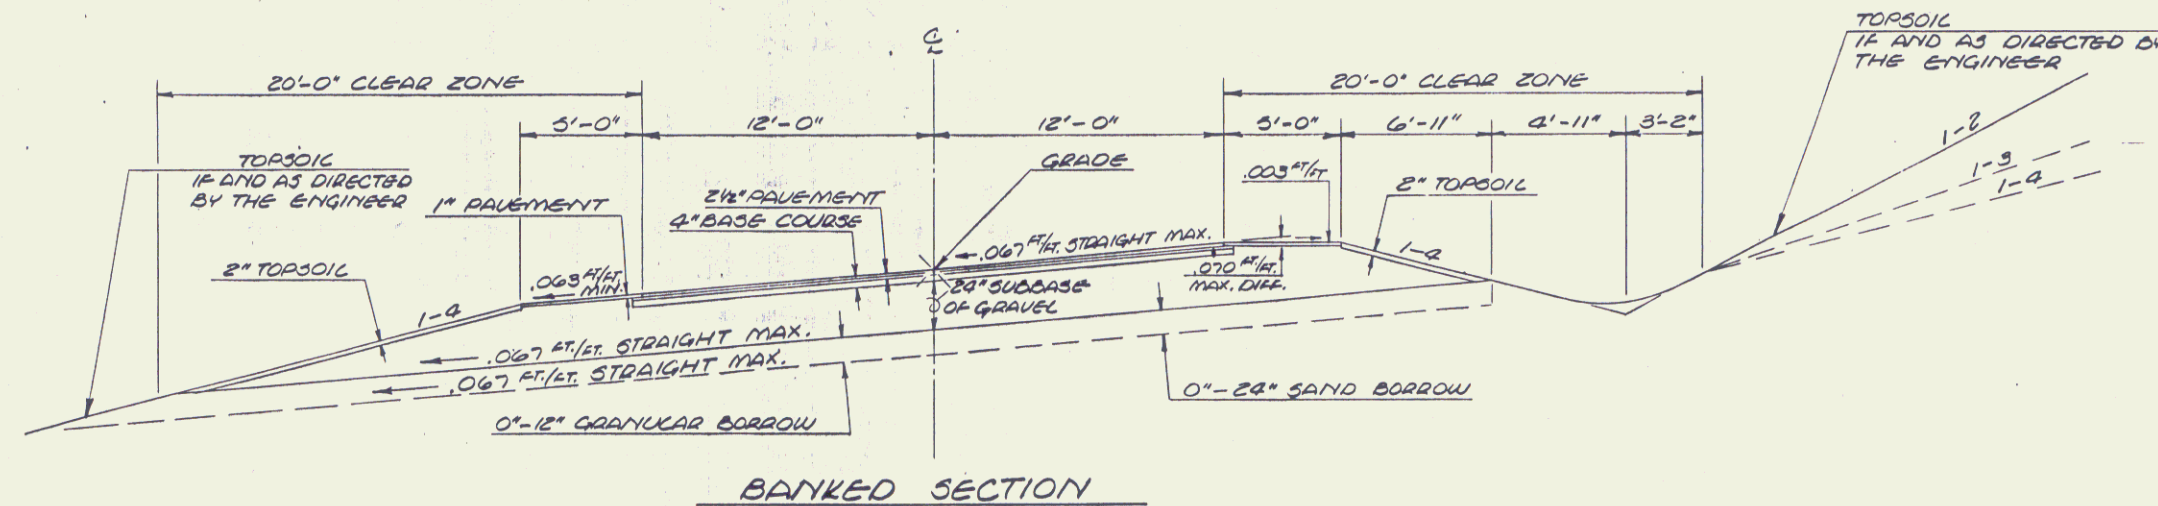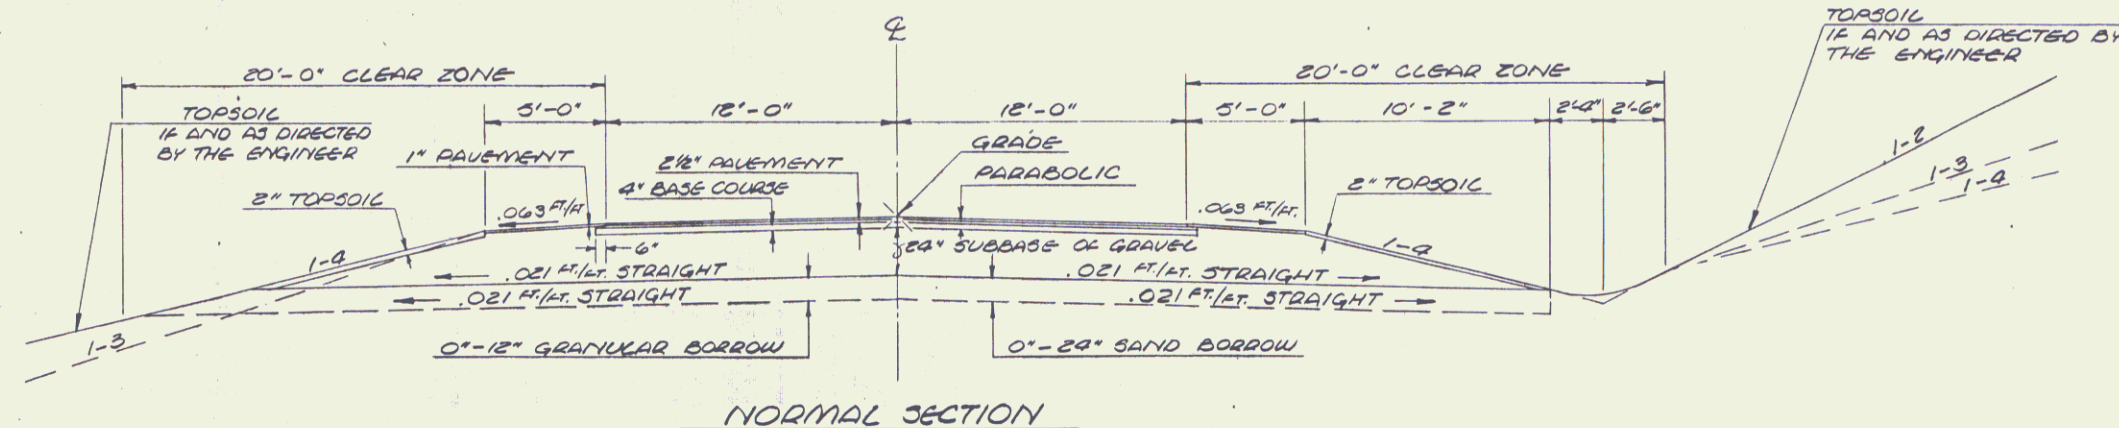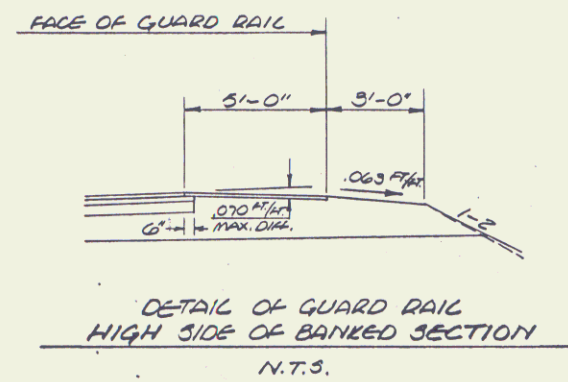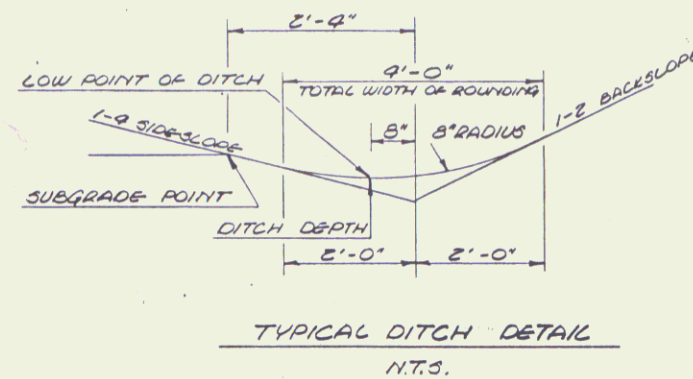


MAINLINE 139+00 - 326+00

SCALE: 4 FEET

MAI - MAY 19 1997

SURVEYED BY	DATE
DRAWN BY	DATE
TRACED BY	DATE
TOWN	ROUTE 101
PROJ.	NO. 0311(1)
SHEET	OF 50

TYPICAL SECTIONS

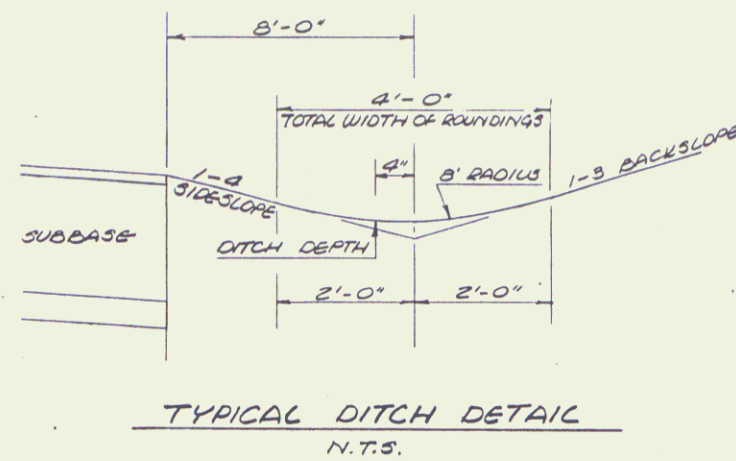

2 1/2" BITUMINOUS CONCRETE PAVEMENT, ITEM 406.25 ($\pm 1/4"$)
(PLACE IN TWO LIFTS: 1" TYPE III, 1 1/2" TYPE II)

4" PLANT MIXED BASE COURSE, ITEM 303.25 ($\pm 1/2"$)

24" SUBBASE OF GRAVEL, ITEM 301.15 ($\pm 1"$)



SHOULDERS: 1" BITUMINOUS CONCRETE PAVEMENT, ITEM 406.25 ($\pm 1/4"$)

0"-12" GRANULAR BORROW, ITEM 203.32 IN FILL ($\pm 1"$)

0"-24" SAND BORROW, ITEM 203.31 IN CUT ($\pm 1"$)

PERMISSIBLE TOLERANCES IN
PARENTHESES APPLY TO
THICKNESS ONLY.

NOTE: FOR GENERAL NOTES,
PARABOLIC DETAIL,
SHOULDER PAVING DETAIL,
SEE SHEET _____ OF _____.

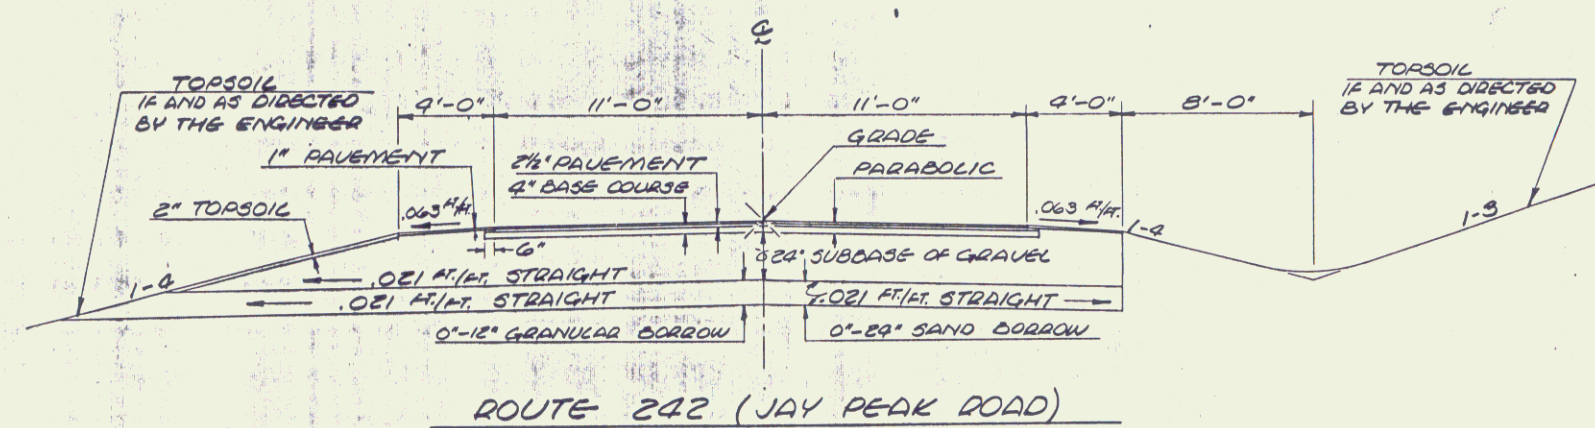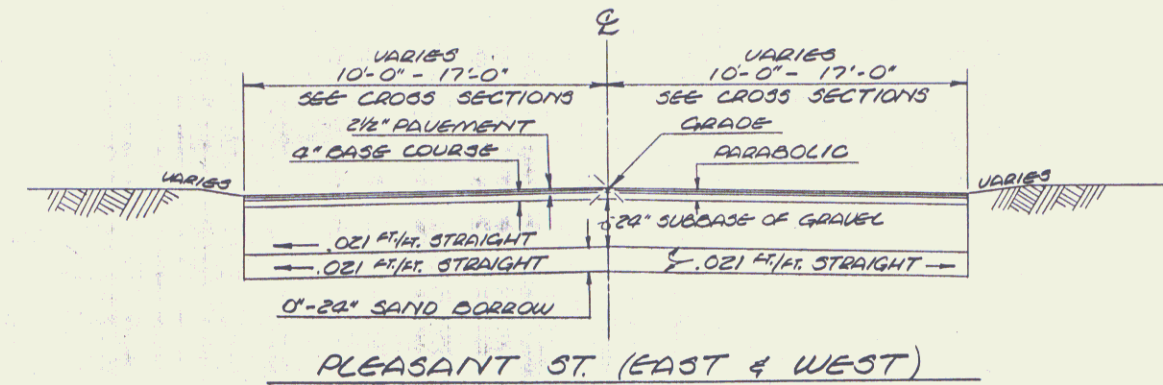


12" GRAVEL SURFACE COURSE, ITEM 401.10 ($\pm 1"$)

0"-12" GRANULAR BORROW, ITEM 203.32 IN FILL ($\pm 1"$)

0"-24" SAND BORROW, ITEM 203.31 IN CUT ($\pm 1"$)



AS INDICATED ON PLANS OR
AS DIRECTED BY ENGINEER

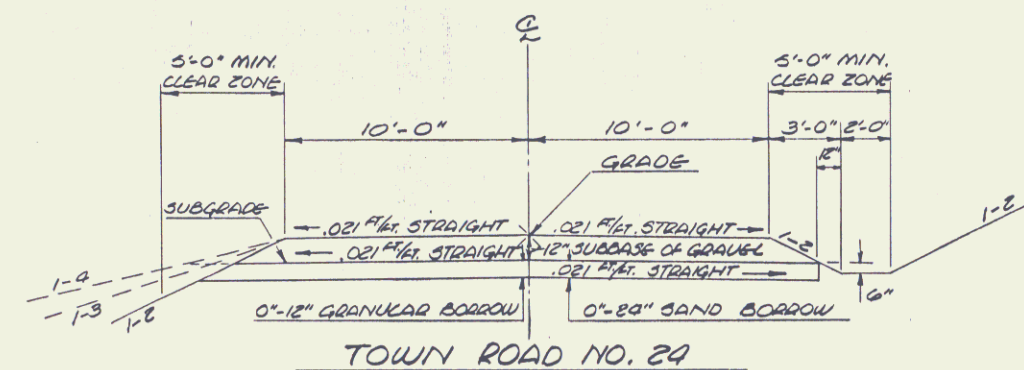

SCALE: 1/4" = 1' FEET

MAY 19 1997



SURVEYED BY _____ DATE _____
DRAWN BY CEL/GAS DATE 09-88
TRACED BY PEM DATE 07-88
TOWN TROY, VERMONT
ROUTE 101
PROJ. RS NO. 0311(1)
SHEET 7 OF 50

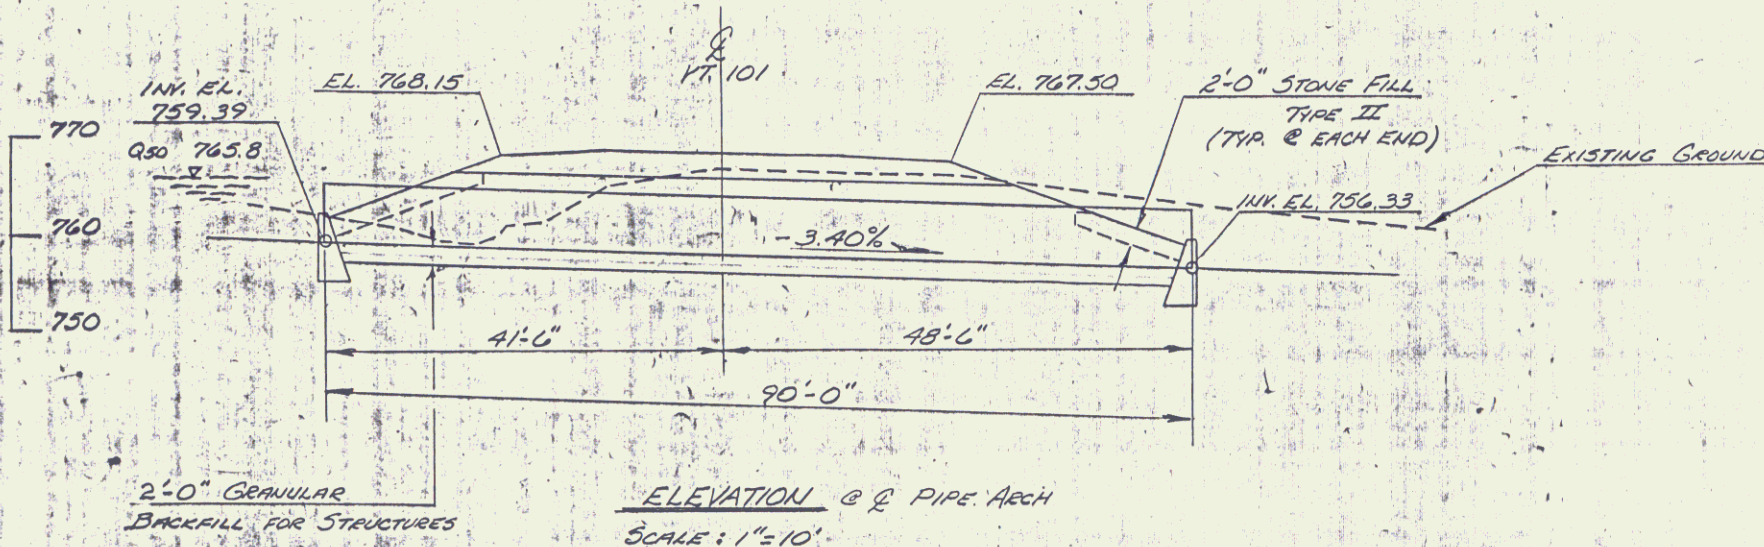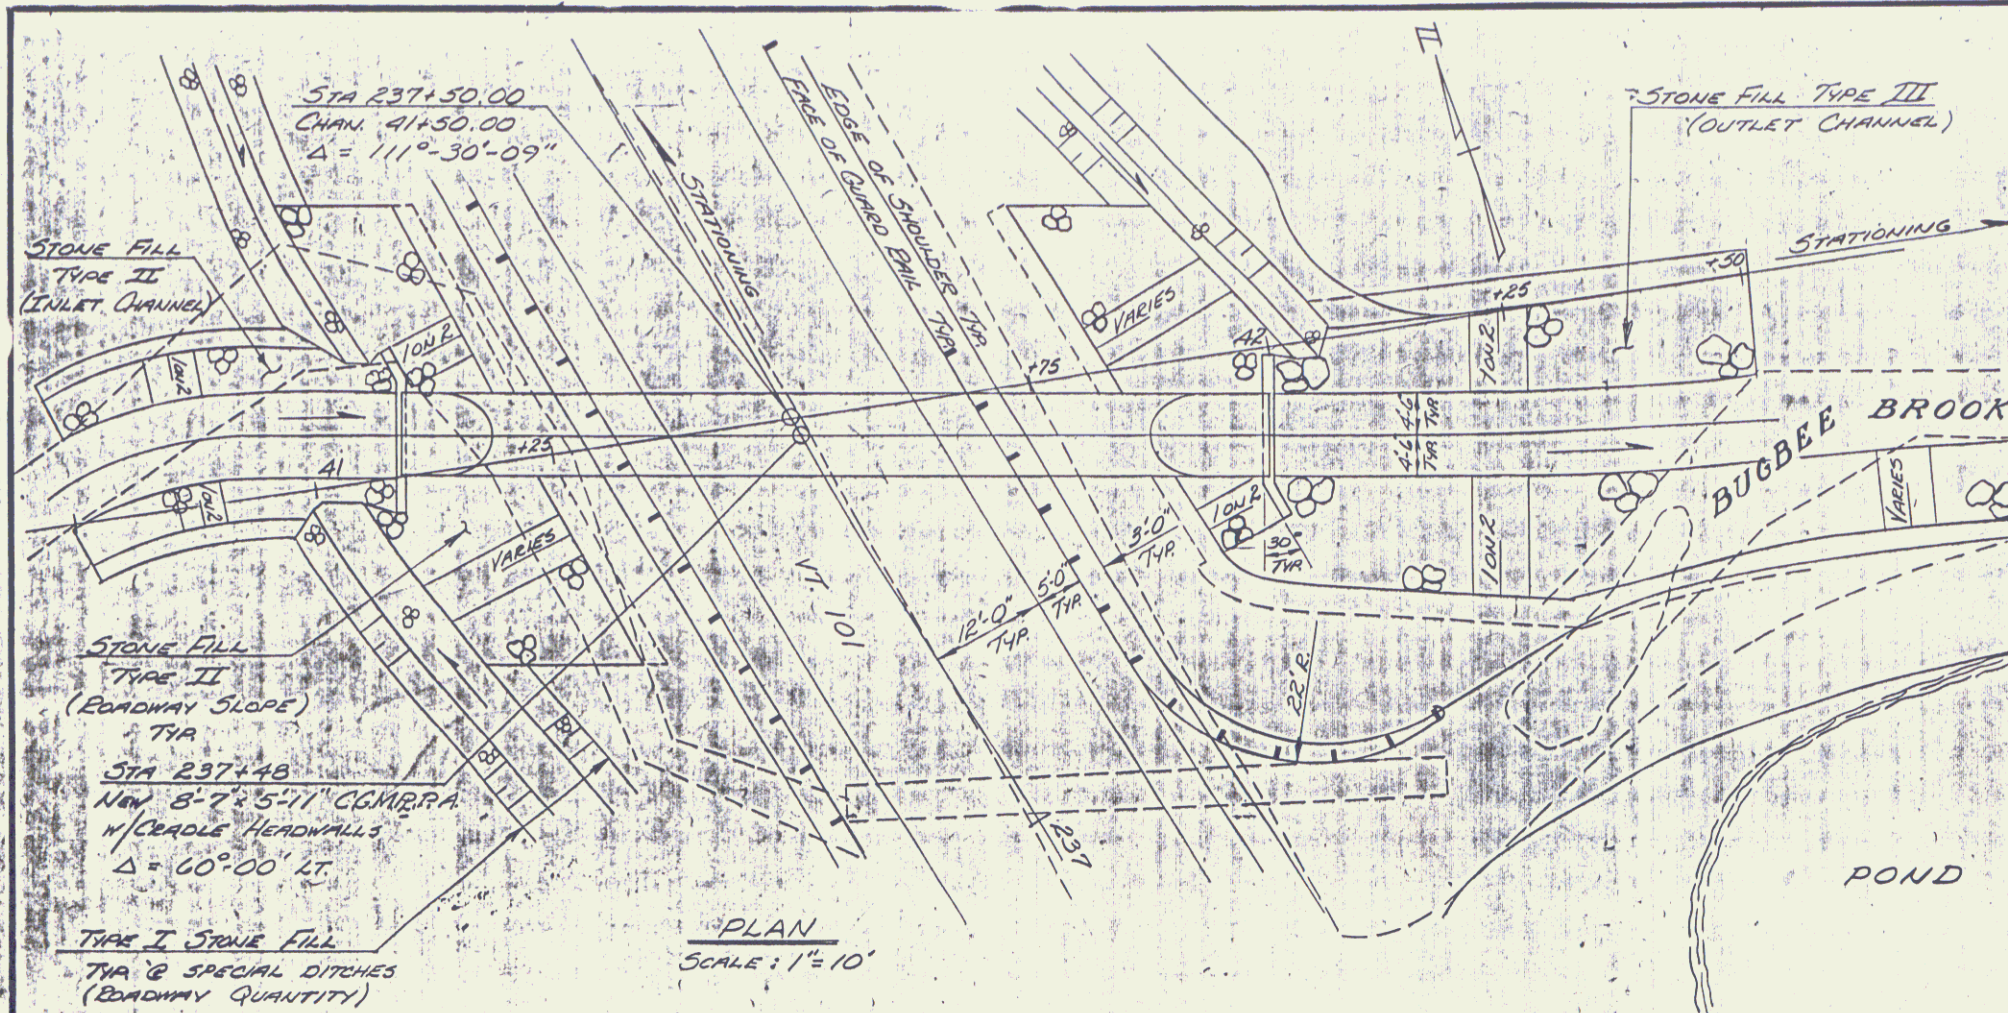

HYDRAULIC DATA			
DRAINAGE AREA	2.41 SQ. MI.	DESIGN FLOW Q	50
Q10	260 C.F.S.	Q10 HEADWATER ELEVATION	764.1
Q25	250 C.F.S.	Q25 HEADWATER ELEVATION	764.9
Q50	240 C.F.S.	Q50 HEADWATER ELEVATION	765.8
Q100	230 C.F.S.	Q100 HEADWATER ELEVATION	766.8
TAILWATER DEPTH AT Q50	2.5 FEET	ELEVATION	
OUTLET VELOCITY AT Q50	12.3 FEET PER SECOND		
ORDINARY HIGHWATER DEPTH		FEET	
COMMENTS	STONE FILL TYPE II @ INLET, TYPE III @ OUTLET CHAN.		

DETAILS OF STRUCTURAL PLATE PIPE CULVERTS			
	STEEL	STEEL	ALUMINUM
CORRUGATIONS	6"x2"		
SIZE OF PIPE OR PIPE ARCH	8'-7"x5'-11"		
WATERWAY AREA (S.F.)	40		
PLATE THICKNESS (COATED)	0.109		
BOLT SIZE	3/4"		
WEIGHT PER LINEAR FOOT	141 #		
TOTAL WEIGHT	14490 #		

- ### NOTES
- ALL MATERIALS AND CONSTRUCTION SHALL CONFORM TO THE VERMONT AGENCY OF TRANSPORTATION STANDARD SPECIFICATIONS FOR CONSTRUCTION DATED 1986, AND THE LATEST A.A.S.H.T.O. STANDARD SPECIFICATIONS FOR HIGHWAY BRIDGES. DESIGN IS FOR HS-20 LIVE LOADING.
 - UNLESS OTHERWISE INDICATED FOUR(4) BOLTS PER LINEAR FOOT FOR STEEL PLATES AND FIVE AND ONE THIRD (5 1/3) BOLTS FOR ALUMINUM PLATES ARE REQUIRED ALONG THE LONGITUDINAL SEAMS. ALL CONNECTIONS FOR STRUCTURAL PLATE SECTIONS SHALL BE MADE WITH GALVANIZED ASTM A-449 BOLTS.
 - WHEN NORMAL CONSTRUCTION OR REGULAR ROADWAY TRAFFIC IS MAINTAINED OVER THE PIPE THE CONTRACTOR SHALL MAINTAIN A MINIMUM COVER OF 3 FEET OF COMPACTED MATERIAL.
 - ALUMINUM PIPE THAT IS TO BE IN CONTACT WITH CONCRETE SHALL HAVE CONTACT SURFACES THOROUGHLY COATED WITH ZINC CHROMATE, OR BITUMINOUS, OR ASPHALTIC PAINT.
 - PIPES SHALL BE FACTORY ELONGATED 5% (PIPE ARCHES SHALL NOT BE ELONGATED).
 - THE ENDS OF THE PIPE SHALL BE CUT SQUARE (NOT BEVELED TO MATCH SLOPES).
 - AT THE OUTLET END INCLUDE A 10' FOOT PIECE OF 6" UNDERDRAIN EACH SIDE ON SAME GRADIENT AS CULVERT CONFORMING TO SECTION 711.01. COST TO BE INCLUDED IN UNIT PRICE BID FOR THE CULVERT PIPE.

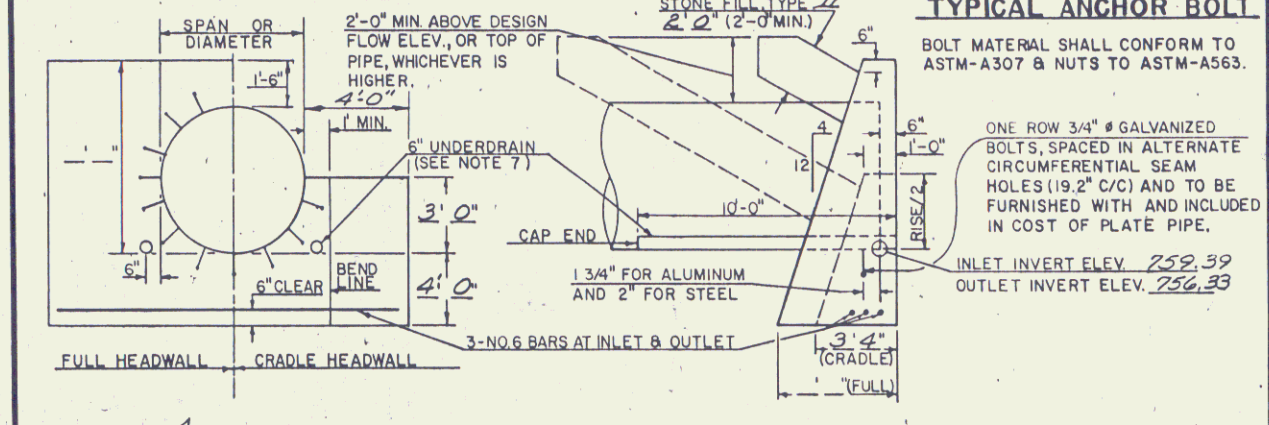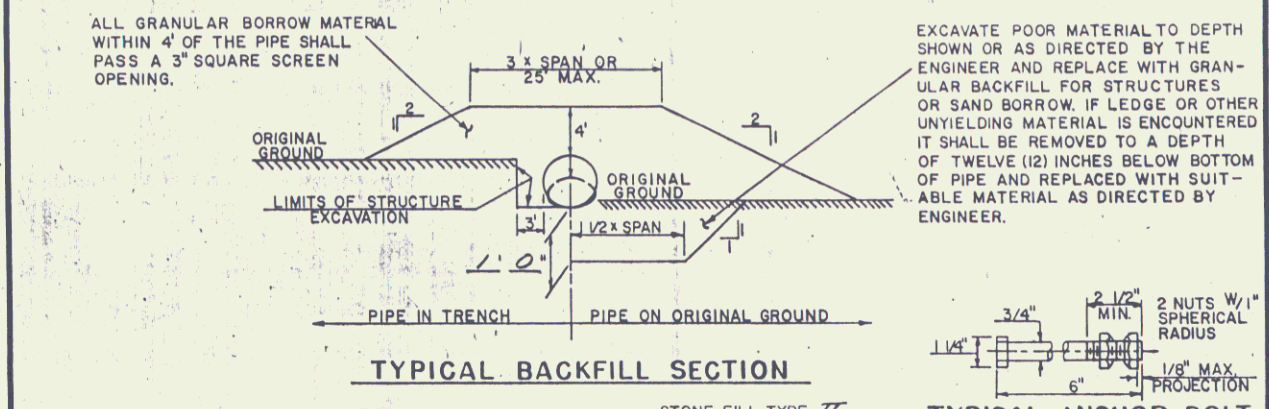

REINFORCING STEEL SCHEDULE						
NO.	PIECES	SIZE	LENGTH	MARK	TYPE	
1	6	6	17-11	CG01	I	A
2						B
3						
4						
5						
6						

ESTIMATED QUANTITIES				
NO.	ITEM	UNIT	TOTAL	FINAL
203.27	UNCLASS. CHANNEL EXCAV.	CY	340	
203.32	GRANULAR BORROW	CY	220	
204.15	STRUCTURE EXCAVATION	CY	400	
204.30	GRAVEL BACKFILL FOR STRUCT.	CY	100	
501.24	CONCRETE C. B.	CY	18	
502.19	PRIMEWELDING STEEL	LB	160	
711.01	CORR. GRAY METAL PLATE	EA	1	
711.02	PIPE ARCH (Q102) W/ 14490 #	EA	1	
529.15	REMOVAL OF STRUCTURE	EA	1	
413.11	STONE FILL TYPE III	CY	140	
413.12	STONE FILL TYPE III	CY	230	

STATE OF VERMONT

AGENCY OF TRANSPORTATION

TOWN OF TROY Bridge No. _____

HIGHWAY NO. RTE 101 Log Sta. _____

RTE 101 OVER BUGBEE BROOK Surv. Sta. 237+48

8'-7"x5'-11" PLATE PIPE DETAILS

Designed by M. GAECIA Drawn by M. GAECIA

Checked by G.V. SLOAN Bridge Design Supervisor

PROJECT TROY date 4/87 F.Y. BolKum date 4/87

PROJECT NO. 25 0311(1)

Bridge Sheet No. 5 of 50

MAY 19 1987 REV. 12/11/85

STATE OF VERMONT
AGENCY OF TRANSPORTATION
RIGHT OF WAY PLANS
ALPHABETICAL INDEX

GRANTOR	SHEET NO.	PARCEL NO.
A		
AUGER, GEORGETTE	28, 46 47	49
B		
BATHALON, ROGER M. & ROLANDE L.	13, 38	19
BEERWORTH, STEVEN G. & MARY C.	22, 43	40
BERKHOUT, DONALD W. & ALYCE M.	11, 36	12
BOUCHARD, JACQUES & CARMEN	9, 36	6
BRISSETT, CHARLES A. & ELIZABETH M.	17, 38	29
C		
CITIZENS UTILITIES CO.	35A	65
COMMUNITY NATIONAL BANK (LESSEE)	9, 36	4
COUTURE, JEAN J. & KATHERINE M.	10, 36	10
CUTTING, STEVEN H., SR. & DIANE S.	25, 46	45

GRANTOR	SHEET NO.	PARCEL NO.
D		
DESCHENEAUX, ROGER J. & JANICE	19, 42	34
DESCHENEAUX, ROGER J.	15, 38	25
DESJARLAIS, GILLES W. & MARY A.	12, 36 38	16
DUNBAR, MICHAEL E. & ELIZABETH B. (TRUSTEES)	32, 49	54
E		
F		
FADIMAN, MARY LOU & JONATHAN R.	25, 46	44
FLORIO, ANTHONY J. & PATRICIA M.	20, 42	35
FRICKE, PAUL H.	26, 27 46, 47	46

GRANTOR	SHEET NO.	PARCEL NO.
G		
GALPEAU, YVONNE E.	10, 36	8
GIGUERE, RAYMOND C., JR. & LILLIAN L.	15 38-40	26
GILMAN, LAWRENCE R. & VERNETTA	35A 46, 47	68
GRAY, DONALD & RITA	11, 36	11
GREENE, GORDON & MARION	27, 28 46	47
H		
HARRIS, MARTHA	35A 46, 47	68
HAYES, ARTHUR L. & ROBERTA A.	8, 36 37	3
HAZUKA, EDWARD & ERNESTINE	19, 41 42	33
HERMANN, GEORGE J. & HELENE M.	20, 21 42-44	37
I		

GRANTOR	SHEET NO.	PARCEL NO.
J		
JACOBS, GARY P.	24, 45, 46	42
JOHNSON, KAREN K.	21, 22 43	39
K		
L		
LABBEE, EDMOND A. & MURIEL P.	33, 49 50	57
LEBLANC, LAURENT & GEORGETTE	18, 41	31
LEMAY, RAYMOND J. & PATRICIA M.	13, 38	18
LEMAY, RAYMOND J.	15, 38	25
LEMIEUX, LOUIS & DELIA	14, 38	22
LENGE, CONSTANCE D.	34, 50	58
LETOURNEAU, RICHARD & DEBRA	31, 48 49	53
LIMOGES, REAL & MARTHA	10, 36	9
LIMOGES, ROLAND G. & YVETTE L.	13, 38	20
LIMOGES, RONALD & JANE	12, 13 36, 38	17
LONGLEY, GRAYDON N. & ANN B.	35A, 40	69
LONTINE, ROLAND W. & DOROTHY	16, 39	27
LOUX, HELENE A.	20, 42 43	36
LOUX, JAMES W., JR. & BARBARA H.	20, 42 43	36

STATE OF VERMONT
AGENCY OF TRANSPORTATION
RIGHT OF WAY PLANS
ALPHABETICAL INDEX

GRANTOR	SHEET NO.	PARCEL NO.
M		
MATTESICH, VIRGINA C.	18, 41	32
MAYHEW, CARL E., SR. & CLARA	34, 50	59
M AND E. TRUST, THE	32, 49	54
MCDERMUT, IRENE	28, 29	50
	47	
MISSISSQUOI CORPORATION	16, 17	28
	39-42	
MODESTINO, ANTHONY J. & SHERWOOD A.	15, 38	24
MONAHAN, JAMES W. & PAMELA K.	18, 40	30
	41	
MORIN, MAURICE & AURORE	9, 36	5
MORRISSETTE, RICHARD L. & DEBORAH A.	20342	35
N		
NEW ENGLAND TELEPHONE AND TELEGRAPH CO.	11, 36	13
O		

GRANTOR	SHEET NO.	PARCEL NO.
P		
POULIN, JEFFREY G.	30, 47	52
	48	
POULIN, PETER A.	30, 47	52
	48	
Q		
R		
ROUTHIER, CONRAD H.	9, 36	7
ROUTHER, JEAN	8, 36	1

GRANTOR	SHEET NO.	PARCEL NO.
S		
SABO, DENNIS J. & ELGA M.	28, 46	48
STARR, HAZEL - ESTATE	29, 47	51
	48	
STARR, JACK, E. SR. & ILLA B.	22-24	41
	43-46	
STARR, JACK E., JR. & DIANNE M.	33, 49	56
	50	
STARR, VIRGIL E. & LINDA D.	34, 35	60
	49, 50	
STARR, URBAN R., SR. -EXECUTOR	29, 47	51
	48	
T		
TAYLOR, GARY & RITA	12, 36	17
	38	
THURSTON, LEON A.	24,	42
	45, 46	
TOWN OF TROY	8, 36	2
	38-40	
	50	
TOWN OF TROY WATER & SEWER	35A	67
TURGEON, DENNIS L. & RACHEL S.	14, 38	23
U		

GRANTOR	SHEET NO.	PARCEL NO.
V		
VERMONT ELECTRIC CO-OP INC.	35A	66
VINCENT, DENNIS R. & SANDRA S.	12, 36	15
W		
WATTS, THOMAS W. & ELEANOR F. (LESSORS)	9, 36	4
WILLIAMS, MARIE	14, 38	21
WILLIS, URSULA-ESTATE	11, 36	14
WURSTHORN, DAVID F.	21, 43	38
X		
Y		
Z		

TABLE OF PROJECT PROPERTY ACQUISITION

STATE OF VERMONT
AGENCY OF TRANSPORTATION
RIGHT OF WAY PLANS
DETAIL SHEET

PARCEL NO.	GRANTOR	SHEET NO.	BEGINNING STATION	ENDING STATION	TAKING	REM.	RIGHTS	TITLE TAKEN	DATE	TOWN OR CITY RECORDED	BK.	PG.	REMARKS	REVISION NO.	SHEET	DESCRIPTION OF REVISION	DATE	MADE BY	APPROVED BY
1A	ROUTHIER, JEAN	36	110+40 LT. 111+60 LT.	110+50 LT.			SLOPE (T) DRIVE (T) 0.01A±	WD	7-06-89	TROY	48	360-61	25 S.F. ± 20' PAVED MM 0004	1	6, 7 14, 17 38	PARCEL NO. 21 DAIGLE. CHANGE PARCEL 21A & 21B TO 29A & 29B. NEW OWNER OF 21A&B- MARCIA J. STEVENS. PER C.O. 6908	4-10-87	M. J. R.	L. W. B.
1B		36	110+40 LT.	111+91 LT.	0.09A±		ALL R.T. & I.						4030 S.F. ± EXIST. VT. RTE. 101 R.O.W.	2	22, 23 43-46	PARCEL NO. 41 & 42, STARR & JACOBS. REMOVE TWO SLOPE (P) AT STA. 236+56 RT. ~ 236+80 RT. AND STA. 236+67 RT. ~ 237+31 RT. ADD NEW SLOPE (P) AT STA. 237+16 RT. ~ 237+65. CHANGE DRIVE (T) FROM STA. 237+08 RT. ~ 236+80 RT. CHANGE DITCH (P) AT STA. 237+15 RT. ~ STA. 237+67 RT. TO CHANNEL (P) STA. 236+75 RT. ~ 237+34 RT. REMOVE CUL. & DITCH (P) AT STA. 237+55 LT. ~ 237+85 LT. ADD DITCH (P) 237+22 LT. ~ 238+03 LT. THESE RIGHTS HAVE BEEN REVISED DUE TO THE NEW ALIGNMENT OF PIPE AND TO STAY AWAY FROM POND. PER C.O. NO. 6920.	4-29-87	M. J. R.	F. J. M.
2A	TOWN OF TROY	36	111+00 RT. 110+60 RT.	111+98 RT. 111+00 RT.	0.02A±	0.20A±	SLOPE (T) 0.01A±	COND	2-26-90	TROY	49	349-62	1040 S.F. ± 140 S.F. ±						
2B		36	110+50 RT.	111+99 RT.	0.08A±		ALL R.T. & I.						3310 S.F. ± EXIST. VT. RTE. 101 R.O.W.	3	12, 13 14, 17 38	PARCEL NO. 29 STEVENS. NO. 17 COUTURE NO. 19 BATHALON CULVERT AT 130+85 RT. HAS BEEN ELIMINATED. NEW SYSTEM FROM 128+00 RT. ~ 129+32 RT. CULVERT AT 133+00 HAS BEEN SKEWED TO OUTLET AT 133+50. PER C.O. NO. 6916.	7-14-87	M. J. R.	F. J. M.
2C		36	112+13 LT.				APPROACH (T)						PLEASANT STREET WEST						
2D		36	112+24 RT.				APPROACH (T)						TOWN HIGHWAY						
2E		38	134+21 RT.				APPROACH (T)						TOWN HIGHWAY #24						
2F		39	142+10 RT.				APPROACH (T)												
2G	DELETED																		
2H		40	REV. 160+44 LT. REV. 160+82 LT.	REV. 161+78 LT.	0.07A±	0.65A±	ALL R.T. & I. DRIVE (T)						2970 S.F. ± EXIST. VT. RTE. 101 R.O.W. 16' GRAVEL MM 0086	4	6, 7 28, 46	PARCEL NO. 48 BERKHOUT. CHANGE TITLE TO SABO, DENNIS J. & ELGA M. PER C.O. NO. 6978.	7-14-87	M. J. R.	F. J. M.
2I		50	320+00 LT.				APPROACH (T)						BELLE VISTA DRIVE	5	6, 7 15, 38	PARCEL NO. 24 CARPENTER. CHANGE TITLE TO MODESTINO, ANTHONY J. & SHERWOOD A. PER C.O. NO. 6979.	7-14-87	M. J. R.	F. J. M.
2J		38	137+70 RT.	138+85 RT.	0.06A±		ALL R.T. & I.						2676 S.F. ± EXIST. VT. RTE. 101 R.O.W.	6	24, 45	PARCEL NO. 42 JACOBS. REDUCE DRIVE FROM 30' TO 22' PER C.O. NO. 6980.	7-14-87	M. J. R.	F. J. M.
3A	HAYES, ARTHUR L. & ROBERTA A.	36, 37	112+39 LT. 112+40 LT. 112+46 LT. 113+13 LT.	112+68 LT. 112+47 LT.			SLOPE (T) 0.01A± CULVERT (P) REMOVE (T) DRIVE (T)	WD	2-8-89	TROY	48	113-4	30 S.F. ± 36' ELM & SIGN (PERSONAL PROPERTY) 40' PAVED MM 0007	7	31, 48	PARCEL NO. 53 LETOURNEAU. ADD CULVERT (P) AT STA. 296+68 LT. PER C.O. NO. 6981.	7-14-87	M. J. R.	F. J. M.
3B		36	112+40 LT.	113+35 LT.	0.05A±		ALL R.T. & I.						2135 S.F. ± EXIST. VT. RTE. 101 R.O.W.	8	33, 50	PARCEL NO. 56 STARR. DELETE SLOPE (T) AT 322+95 LT. ~ 323+72 LT. SLOPE PULLED IN TO AVOID GAS VENT PIPE. PER C.O. NO. 6982.	7-14-87	M. J. R.	F. J. M.
														9	11, 21 26, 35A 36, 43 46	PARCEL NO. 61-64, 14A, 38A, 46A, 46C. DELETE PARCELS 61-64. DELETE R.T. & I. TO R.O.W. ON PARCEL 14A, 38A, 46A. PER C.O. 7004	7-24-87	M. J. R.	F. J. M.
														10	9, 36	PARCEL NO. 4 WATTS. ADD SIGN & EASE. TO REMOVE (T) AT STA. 113+46 RT. PER C.O. NO. 7005	7-24-87	M. J. R.	F. J. M.

DR. RT.- DRAINAGE RIGHT
DIT. RT.- DITCHING RIGHT
CH. RT.- CHANNEL RT.
DRIVE RT.- DRIVE RIGHT
CUL. RT.- CULVERT RIGHT
Ⓢ- DEMOLITION OR REMOVAL
☒- WATER SOURCES

PRESENT R.O.W.
TAKING WITHOUT ACCESS
TAKING WITHOUT ACCESS ALONG PROPERTY LINE
TAKING WITH ACCESS
PERMANENT EASEMENT
TEMPORARY EASEMENT

LEGEND
--- CONJ. EASE. ---
SR SR
P
L
△ △ △
○ ○ ○

CONSTRUCTION EASEMENT
SLOPE RIGHTS
PROPERTY LINE
TOP OF CUT
TOE OF SLOPE

APPROVED: LAWRENCE BLISS, L.S. DATE: 3-10-87
AGENT D. PLANS & TITLES

R.O.W. PLANS
TROY
RS 0311(1)
SHEET 8 OF 50
MAY 19 1997

8

TABLE OF PROJECT PROPERTY ACQUISITION

STATE OF VERMONT
AGENCY OF TRANSPORTATION
RIGHT OF WAY PLANS
DETAIL SHEET

PARCEL NO.	GRANTOR	SHEET NO.	BEGINNING STATION	ENDING STATION	TAKING	REM.	RIGHTS	TITLE TAKEN	DATE	TOWN OR CITY RECORDED	BK.	PG.	REMARKS	REVISION NO.	SHEET	DESCRIPTION OF REVISION	DATE	MADE BY	APPROVED BY
4A	WATTS, THOMAS W. & ELEANOR F. - LESSORS COMMUNITY NATIONAL BANK - LESSEE	36	112+68 RT. 113+46 RT. 114+30 RT.	115+57 RT.	0.07A±	0.73A±	EASE. TO REMOVE (T)	WD	01-02-90	TROY	49	237-38	3227 S.F. ± SIGN (PERSONAL PROPERTY) 35' PAVED DRIVE MM 0009	11	10, 36	PARCEL NO. 8 GALIPEAU. REDUCED TAKING FROM 0.08A± TO 0.04A±. THE ENDING STA. IS NOW 117+08 RT. PER C.O. NO. 7019	8-12-87	A. S. J.	F. J. M.
4B		36	112+50 RT.	115+60 CL.	0.18A±		ALL R.T. & I.						EXIST. VT. RTE. 101 R.O.W.	12	7, 23-25 43-46	PARCEL NO. 41 DELETED PARCEL NO. 43 AND ADD TO 41 PER C.O. NO. 7018	8-12-87	A. S. J.	E. A. F.
5A	MORIN, MAURICE & AURORE	36, 37	113+50 LT. 113+62 LT. 114+31 LT. 114+48 LT.	113+74 RT. 114+55 LT.			CONST. & MAINT. (P) REMOVE & RELOCATE (T) DRIVE REMOVE & RELOCATE (T)	COND	02-26-90	TROY	49	349-62	DROP INLET CELLAR DRAIN 30' PAVED DRIVE MM 0009 CELLAR DRAIN	14	14, 38	PARCEL NO. 22 LEMIEUX. ADD 'SAVE' TO PLANS FOR 10' CEDAR AT STA. 133+25 LT., 8' SCOTCH PINE AT STA. 134+69 LT. CHANGE SLOPE (T) AREA AT STA. 133+55 LT- 134+74 LT. TO 493 S.F. ±. CHANGE SLOPE (T) AREA S.F. ± PER C.O. NO. 7026	8-28-87	M. J. R.	F. J. M.
5B		36	113+34 LT.	114+56 LT.	0.07A±		ALL R.T. & I.						3145 S.F. ±	15	18, 41	PARCEL NO. 31 LEBLANC. ADD CELLAR DRAIN AT STA. 182+40 LT. ADD NOTE TO CONNECT CELLAR DRAIN. PER C.O. NO. 7025	8-28-87	M. J. R.	F. J. M.
6	BOUCHARD, JACQUES & CARMEN	36	114+56 LT. 114+54 LT. 114+64 LT.	115+10 LT.	0.03A±		ALL R.T. & I. REMOVE & RESET (T)	WD	03-24-89	TROY	48	175	1455 S.F. ± EXIST. VT. RTE. 101 R.O.W. CELLAR DRAIN 12' PAVED DRIVE MM 0010	16	35, 50	PARCEL NO. 60 STARR. DELETED WATERLINE AT STA. 320+33 RT. ~ 320+42 RT. WATERLINE DOES NOT EXIST. PER C.O. NO. 7046	8-28-87	A. S. J.	F. J. M.
7A	ROUTHIER, CONRAD H.	36	115+30 LT. 115+78 LT.	115+61 LT.			SLOPE (T) 0.01A±	WD	9-26-88	TROY	47	395	40 S.F. ± 13' GRAVEL DRIVE MM 0012	17	11, 36 37	PARCEL NO. 11 GRAY. ADDED CULVERT AT STA. 117+24 LT. ~ 117+65 LT. PER C.O. NO. 7042	9-9-87	A. S. J.	F. J. M.
7B		36	115+10 LT.	116+00 LT.	0.06A±		ALL R.T. & I.						2465 S.F. ± EXIST. VT. RTE. 101 R.O.W.	18	8, 36	PARCEL NO. 3 ADDED PERMANENT RT. TO INSTALL & MAINT. CULVERT AT STA. 112+40 LT. ~ 112+47 LT. PER C.O. NO. 7034	9-15-87	A. S. J.	F. J. M.
														19	24, 45 46	PARCEL NO. 42 JACOBS CHANGED CENTERLINE TO AVOID BARN PER C.O. 7058	9-16-87	A. S. J.	L. W. B.
														20	7 30, 47	PARCEL NO. 52 POULIN. TITLE CHANGE FROM STANTON TO POULIN, PETER A. & JEFFERY G. PER C.O. NO. 7063	9-30-87	A. S. J.	J. D. P.
														21	6, 9 36	PARCEL NO. 6 ARMSTRONG. CHANGE TO AN ESTATE. PER C.O. NO. 7081	10-20-87	M. J. R.	L. W. B.
														22	11, 12 36, 7	PARCEL NO. 14 WILLIS. CHANGE TO AN ESTATE PER C.O. NO. 7082	10-20-87	M. J. R.	L. W. B.
														23	13, 38	PARCEL NO. 19 BATHALON. ADD NOTE 'TRANSPLANT TREES' AT STA. 128+73 RT., 129+45 RT., ALSO ADD 'SAVE' TO TREE AT STA. 128+38 RT. PER C.O. NO. 7072	11-6-87	M. J. R.	L. W. B.

ACCT. RYAN
2FA2670J0378E42D.DGN
PRF: 78E42D2.PRF LV:42
DATE PLOTTED 9-AUG-1989

DR. RT. - DRAINAGE RIGHT
DIT. RT. - DITCHING RIGHT
CH. RT. - CHANNEL RT.
DRIVE RT. - DRIVE RIGHT
CUL. RT. - CULVERT RIGHT
(D) - DEMOLITION OR REMOVAL
(W) - WATER SOURCES

PRESENT R.O.W.
TAKING WITHOUT ACCESS
TAKING WITHOUT ACCESS ALONG PROPERTY LINE
TAKING WITH ACCESS
PERMANENT EASEMENT
TEMPORARY EASEMENT

LEGEND
--- CONST. EASE. ---
SR SR
P
L
TOP OF CUT
TOE OF SLOPE

CONSTRUCTION EASEMENT
SLOPE RIGHTS
PROPERTY LINE
APPROVED: LAWRENCE BLISS, L.S. DATE: 3-10-87
AGENT D. PLANS & TITLES

R. O. W. PLANS

TROY
RS 0311(1)
SHEET 9 OF 50

TABLE OF PROJECT PROPERTY ACQUISITION

STATE OF VERMONT
AGENCY OF TRANSPORTATION
RIGHT OF WAY PLANS
DETAIL SHEET

PARCEL NO.	GRANTOR	SHEET NO.	BEGINNING STATION	ENDING STATION	TAKING	REM.	RIGHTS	TITLE TAKEN	DATE	TOWN OR CITY RECORDED	BK.	PG.	REMARKS	REVISION NO.	SHEET	DESCRIPTION OF REVISION	DATE	MADE BY	APPROVED BY
8A	GALPEAU, YVONNE E.	36	115+56 RT. 115+56 RT. 115+56 RT. 115+77 RT. 116+85 RT. 115+95 RT.	117+08 RT. 115+57 RT. 116+43 RT.	0.04A±	0.46A±	REMOVE & RESET (T) DIT. & DR. (P)	WD	9-26-88	TROY	47	397	1950 S.F.± WOOD RAIL FENCE WOOD RAIL FENCE D-1 16' PAVED DRIVE MP 0012 WOODRAIL FENCE D-2	24	38	PARCEL NO. 20 LIMOGES ADD THE FOLLOWING NOTE AND TOPO TO PLANS. SAVE 5' HIGH SPRUCE AND 3' HIGH WILLOW. PER C.O. NO. 7052	11-12-87	M. J. R.	L. W. B.
8B		36	115+56 RT.	117+07 RT.	0.08A±		ALL R.T. & I.						3390 S.F.± EXIST. VT. RTE. 101 R.O.W.	25	34,50	PARCEL NO. 60 STARR. ADD WATERLINE SLEEVE AND RIGHTS. ALL R.T. & I. TO WATERLINE STA. 318+40 LT. ~ 318+41 RT. PER C.O. NO. 7051	11-13-87	M. J. R.	E. A. F.
9A	LIMOGES, REAL & MARTHA	36	116+11 LT. 116+95 LT. 117+05 LT. 117+18 LT.	117+29 LT.			DRIVE (T) DRIVE (T) SLOPE (T) CUL. & DITCH (P) 0.01A±	WD	2-27-89	TROY	48	133-4	32' GRAVEL MP 0013 12' GRAVEL MP 0014 250 S.F.±	26	13,38	PARCEL NO. 19 BATHALON. ADD TEMPORARY TRANSPLANT RIGHT FROM STA. 128+73 RT. ~ 129+93 RT. FOR THREE TREES. PER C.O. NO. 7103	11-18-87	M. J. R.	L. W. B.
9B		36	116+00 LT.	117+17 LT.	0.07A±		ALL R.T. & I.						3240 S.F.± EXIST. VT. RTE. 101 R.O.W.	27	22-26 31,34	PARCEL NO. 41, 42, 44, 46, 53, 60. ADD REMOVE & RESET RIGHTS FOR FENCES LOCATED IN ABOVE PARCEL. PER C.O. NO. 7116	11-25-87	M. J. R.	L. W. B.
														28	17,38	PARCEL NO. 29 STEVENS. ADDED SWALE DITCH AT STA. 133+50 RT. ~ 134+00 RT. PER C.O. NO. 7151	01-15-88	A. S. J.	L. W. B.
														29	6,7 12,13	PARCEL NO. 17 LIMOGES & TAYLOR. TITLE CHANGE FROM COUTURE TO LIMOGES, RONALD & JANE AND TAYLOR, GARY & RITA. PER C.O. NO. 7163	01-19-88	A. S. J.	L. W. B.
10A	COUTURE, JEAN J. & KATHERINE M.	36	116+88 RT. 116+85 RT. 117+00 RT. 117+41 RT. 117+62 RT. 118+43 RT. 118+65 RT. 120+09 RT.	118+00 RT. 117+27 RT. 118+56 RT. 119+65 RT.	0.05A±	3.48A±	DIT. & DR. (P) SLOPE (T) 0.01A± DRIVE (T) SLOPE (T) 0.02A± DRIVE (T) SLOPE (T) 0.01A± DRIVE (T)	WD	1-27-89	TROY	48	52-3	2000 S.F.± 60 S.F.± 35' GRAVEL MP 0015 975 S.F.± 16' PAVED MP 0017 500 S.F.± 26' PAVED MP 0020	30	28,29 6,7 47 6,7	PARCEL NO. 50 INDER. CHANGE TITLE TO MCDERMUT, IRENE. PER C.O. NO. 7164	01-20-88	M. J. R.	L. W. B.
														31	32,33 49,50	PARCEL NO. 56 STARR. ADDED PARCEL 55A & B TO STARR DUE TO SELLOFF. PER C.O. NO. 7169	01-21-88	A. S. J.	L. W. B.
														32	21,43	PARCEL NO. 39 DIAZ ADDED DRIVE AT 217+50 LT. PER C.O. NO. 7161	01-25-88	A. S. J.	L. W. B.
10B		36	117+07 RT.	120+77 RT.	0.26A±		ALL R.T. & I.						EXIST. VT. RTE. 101 R.O.W.	33	6,7 14,17 38	PARCEL NO. 21 DIAGLE. CHANGE TITLE TO WILLIAMS, MARIE. PER C.O. NO. 7283	05-18-88	M. J. R.	L. W. B.
														34	9,36 6,7	PARCEL NO. 6 ORFICE. CHANGE TITLE TO BOUCHARD, JACQUES & CARMEN. PER C.O. 7317.	05-12-88	M. J. R.	J. D. P.
														35	9,36	PARCEL NO. 6 BOUCHARD. CONNECT EXISTING CELLAR DRAIN TO NEW D.I. AT STA. 114+54 LT.± PER C.O. 7358	08-15-88	A. S. J.	E. A. F.
														36	20,42 43,6	PARCEL NO. 36 LOUX. DELATED JAMES W. LOUX SR. FROM TITLE. PER C.O. 7402	10-12-88	A. S. J.	J. D. P.

DR. RT.- DRAINAGE RIGHT
DIT. RT.- DITCHING RIGHT
CH. RT.- CHANNEL RT.
DRIVE RT.- DRIVE RIGHT
CUL. RT.- CULVERT RIGHT
(D)- DEMOLITION OR REMOVAL
(W)- WATER SOURCES

PRESENT R.O.W.
TAKING WITHOUT ACCESS
TAKING WITHOUT ACCESS ALONG PROPERTY LINE
TAKING WITH ACCESS
(P) PERMANENT EASEMENT
(T) TEMPORARY EASEMENT

LEGEND

--- CONST. EASE ---
SR SR
P
L
△ △
○ ○

CONSTRUCTION EASEMENT
SLOPE RIGHTS
PROPERTY LINE
TOP OF CUT
TOE OF SLOPE

APPROVED: LAWRENCE BLISS, L.S. DATE: 3-10-87
AGENT D. PLANS & TITLES

R. O. W. PLANS

TROY
RS 0311(1)
SHEET 10 OF 50

TABLE OF PROJECT PROPERTY ACQUISITION

STATE OF VERMONT
AGENCY OF TRANSPORTATION
RIGHT OF WAY PLANS
DETAIL SHEET

PARCEL NO.	GRANTOR	SHEET NO.	BEGINNING STATION	ENDING STATION	TAKING	REM.	RIGHTS	TITLE TAKEN	DATE	TOWN OR CITY RECORDED	BK.	PG.	REMARKS	REVISION NO.	SHEET	DESCRIPTION OF REVISION	DATE	MADE BY	APPROVED BY
11A	GRAY, DONALD & RITA	36	117+17 LT. 117+18 LT. 117+24 LT. 117+85 LT. 118+00 LT.	117+46 LT. 117+65 LT. 118+56 LT.			SLOPE (T) 0.01A± CULVERT & DITCH (P) CULVERT (P) DRIVE (T) SLOPE (T) 0.01A±	WD	1-27-89	TROY	48	57-8	290 S.F.± 16' GRAVEL MP 0016 425 S.F.±	37	9, 36	PARCEL NO. 6 BOUCHARD REVISED BEG. STA. FROM 114+55LT. TO 114+56LT. PER. CO. 7460	11-29-88	A. S. J.	L. W. B.
11B		36	117+07 LT.	118+56 LT.	0.08A±		ALL R.T. & I.						3500 S.F.± EXIST. VT. RTE. 101 R.O.W.	38	9, 36	PARCEL NO. 5 MORIN. REVISED BEG. STA. & ENDING STA. FROM 113+35LT-114+55LT. TO READ 113+34LT.-114+56LT. PER.CO.7461	11-29-88	A. S. J.	L. W. B.
12A	BERKHOUT, DONALD W. & ALYCE M.	36	118+56 LT. 118+56 LT.	119+71 LT. 119+71 LT.	0.01A±	5.69A±	SLOPE (T) 0.03A±	WD	12-11-80	TROY	50	421- 422	275 S.F.± 1175 S.F.±	39	8, 36	PARCEL NO. 1 ROUTHIER. REVISED BEG. STA. FOR PARCEL 1B FROM 110+36LT. TO READ 110+40LT. PER CO. 7462	11-29-88	A. S. J.	L. W. B.
12B		36	118+56 LT.	119+71 LT.	0.06A±		ALL R.T. & I.						2690 S.F.± EXIST. VT. RTE. 101 R.O.W.	40	8	PARCEL NO. 2 TOWN OF TROY REVISED BEG. STA & ENDING STA. FROM 110+60RT.~111+98RT. TO READ 110+50RT.~111+99RT. PER.CO.7463	11-29-88	A. S. J.	L. W. B.
13A	NEW ENGLAND TELEPHONE AND TELEGRAPH COMPANY	36	119+71 LT. 119+71 LT. 120+53 LT. 120+64 LT.	120+71 LT. 120+52 LT. 120+71 LT.	0.01A±	0.21A±	SLOPE (T) 0.01A± DRIVE (T) SLOPE (T) 0.01A±	WD		TROY			300 S.F.± 445 S.F.± 12' PAVED MP 0021 20 S.F.±	41	11, 36	PARCEL NO.12 BERKHOUT REVISED ENDING STA. FOR PARCELS 12A,12B AND SLOPE(T) FROM 119+68LT. TO READ 119+71LT. PER CO. 7464	11-29-88	A. S. J.	L. W. B.
13B		36	119+71 LT.	120+71 LT.	0.05A±		ALL R.T. & I.						2200 S.F.± EXIST. VT. RTE. 101 R.O.W.	42	11, 36	PARCEL NO. 13 NEW ENGLAND TEL. & TEL CO. REVISED BEG. & ENDING STA. FOR PARCEL *13A & 13B FROM 119+68LT.~120+68LT. TO READ 119+71LT.~120+71LT REVISED SLOPE (T) BEG. STA. 119+68LT. TO READ 119+71LT. REVISED SLOPE (T) ENDING STA. 120+68LT. TO READ 120+71LT. PER CO. 7465	11-29-88	A. S. J.	L. W. B.
13C													UTILITY	43	12, 13 36	PARCEL NO.17 LIMOGES & TAYOR REVISED BEG. & ENDING STA. FOR PARCEL 17B FROM 122+85RT ~128+17RT. TO READ 122+84RT.~128+19RT. REVISED CONST. EASE (T) BEG. STA. FROM 122+85RT. TO READ 122+84RT. PER CO. 7466	11-29-88	A. S. J.	L. W. B.
14A	WILLIS, URSULA- ESTATE	36	120+68 LT. 120+68 LT. 121+10 LT. 121+52 LT. 121+66 LT. 122+26 LT. 122+35 LT.	122+47 LT. 120+87 LT. 121+50 LT. 122+00 LT. 122+47 LT.	0.02A±	0.36A±	SLOPE (T) 0.01A± SLOPE (T) 0.01A± DRIVE (T) SLOPE (T) 0.01A± DRIVE (T) SLOPE (T) 0.01A±	WD	1-30-89	TROY	48	59-0	885 S.F.± 40 S.F.± 260 S.F.± 16' PAVED MP 0023 175 S.F.± 12' PAVED MM 0024 45 S.F.±	44	13	PARCEL NO. 18 LEMAY. REVISED REM. AREA FROM 7.30A± TO 7.10A± REVISED 18B AREA FROM 0.32A± TO READ 0.20A± ALSO REVISED 18B BEG. STA. FROM 122+47LT. TO READ 122+40RT. PER. CO. 7467	11-29-88	A. S. J.	L. W. B.
14B		36	120+68 LT.	122+47 LT.	0.09A±		ALL R.T. & I.						3915 S.F.± EXIST. VT. RTE. 101 R.O.W.	45	15	PARCEL NO. 25 LEMAY, DESCHENEUX ADD SLOPE (T) STA. 137+00LT.~137+16LT. REVISED BEG. STA. OF PARCELS *25A, & 25B AND CHANGE CUL. & DROPINLET (P) FROM 136+66LT. TO READ 136+64LT. PER CO. 7468	11-29-88	A. S. J.	L. W. B.
														46	16, 39	PARCEL NO. 27 LONTINE. COMBINE A&B AND MAKE PARCEL *27 REVISE BEG. STA. TAKE FROM 142+72RT. TO READ 142+67RT. PER. CO. 7469	11-29-88	A. S. J.	L. W. B.
														47	17, 38	PARCEL NO. 29 STEVENS. REVISED SLOPE AREA IN REMARKS COLUMN FROM 620 S.F.± TO 565 S.F.± AT STA. 132+62RT.~133+55RT.	11-30-88	A. S. J.	L. W. B.

DR. RT.- DRAINAGE RIGHT
DIT. RT.- DITCHING RIGHT
CH. RT.- CHANNEL RT.
DRIVE RT.- DRIVE RIGHT
CUL. RT.- CULVERT RIGHT
(D)- DEMOLITION OR REMOVAL
(W)- WATER SOURCES

PRESENT R.O.W.
TAKING WITHOUT ACCESS
TAKING WITHOUT ACCESS ALONG PROPERTY LINE
TAKING WITH ACCESS
PERMANENT EASEMENT
TEMPORARY EASEMENT

LEGEND
--- CONST. EASE ---
SR SR CONSTRUCTION EASEMENT
P SLOPE RIGHTS
L PROPERTY LINE
TOP OF CUT
TOE OF SLOPE

APPROVED: LAWRENCE BLISS, L.S. DATE: 3-10-87
AGENT D. PLANS & TITLES

R. O. W. PLANS
TROY
RS 0311(1)
SHEET 11 OF 50

TABLE OF PROJECT PROPERTY ACQUISITION

STATE OF VERMONT
AGENCY OF TRANSPORTATION
RIGHT OF WAY PLANS
DETAIL SHEET

PARCEL NO.	GRANTOR	SHEET NO.	BEGINNING STATION	ENDING STATION	TAKING	REM.	RIGHTS	TITLE TAKEN	DATE	TOWN OR CITY RECORDED	BK.	PG.	REMARKS	REVISION NO.	SHEET	DESCRIPTION OF REVISION	DATE	MADE BY	APPROVED BY
15A	VINCENT, DENNIS R. & SANDRA S.	36	120+76 RT.	122+83 RT.			CONST. EASE. (T) 0.05A±	OPTION	3-14-89	TROY	48	147-8	2070 S.F. ±	48	6, 7 18, 40 35A	PARCEL NO. 69 LONGLEY, GRAYDON CREATED NEW PARCEL DO TO PARTIAL SELLOFF OF PARCEL 30A & 30B AND REDUCED RIGHTS ACORDINGLY PER. CO. 7471	11-30-88	A. S. J.	L. W. B.
15B		36	120+76 RT.	122+83 RT.	0.15A±		ALL R. T. & I.						EXIST. VT. RTE. 101 R.O.W.	49	20	PARCEL NO. 35 MORRISSETTE, REVISED BEG. STA. FOR PARCEL *35A, 35B AND SLOPE (T) FROM 199+64LT. TO READ 199+67LT. PER. CO. 7472	11-30-88	A. S. J.	L. W. B.
16A	DESJARLAIS, GILLES W. & MARY A.	36, 38	122+47 LT. 122+47 LT. 123+14 LT. 124+10 LT.	124+48 LT. 122+90 LT. 124+47 LT.	0.01A±	1.32A±	SLOPE (T) 0.01A± DRIVE (T) SLOPE (T) 0.01A±	COND	02-26-90	TROY	49	349-62	617 S.F. ± 100 S.F. ± 20' PAVED MM 0026 210 S.F. ±	50	20, 21 42-44	PARCEL NO. 37 HERMANN REVISED BEG. STA. FOR SLOPE (P) & CONST. EASE (T) FROM 203+42RT. & 203+43RT. TO BOTH READ 203+44RT.; CONST. EASE. (T) BEG. STA. 214+35RT. TO READ 214+40RT. DELETED DRIVE NOTATION ON DETAIL SHEET FOR DRIVE AT STA. 217+50LT. REVISED ENDING STA. FOR 37B FROM 220+65LT. TO READ 220+13LT. PER. CO. 7473	11-30-88	A. S. J.	L. W. B.
16B		36, 38	122+47 LT.	124+47 LT.	0.12A±		ALL R. T. & I.						EXIST. VT. RTE. 101 R.O.W.						
17A	LIMOGES, RONALD & JANE TAYLOR, GARY & RITA	36, 38	123+85 RT. 122+84 RT. 123+00 RT. 123+50 RT. 126+08 RT. 126+12 RT. 127+84 RT.	128+19 RT. 128+15 RT. 126+00 RT. 127+75 RT.	0.05A±		CONST. EASE. (T) 0.12A± SLOPE (P) 0.02A± DRIVE (T) SLOPE (P) 0.03A± DRIVE (T)	WD	12-04-89	TROY	49	54-55	2175 S.F. ± 30' GRAVEL DRIVE MM 0035 765 S.F. ± 12' GRAVEL MM 0032 1340 S.F. ± 16' GRAVEL MM 0035	52	35	PARCEL NO. 60 STARR. ADD RESET (T) FENCE FOR FOLLOWING STA. 305+95RT. ~312+25RT. PER. CO. 7475	12-05-88	A. S. J.	L. W. B.
														53	35A	PARCEL NO. 68 HARRIS & GILMAN ADD RESET (T) FENCE FOR FOLLOWING STA. REV. 265+05LT. ~ REV. 268+11LT. PER. CO. 7478	12-05-88	A. S. J.	L. W. B.
17B		36, 38	122+84 RT.	128+19 RT.	0.29A±		ALL R. T. & I.						EXIST. VT. RTE. 101 R.O.W.	54	33	PARCEL NO. 56 STARR ADD RESET (T) FENCE FOR FOLLOWING STA. 308+98LT. ~313+51LT.; 305+98LT. ~308+98LT. PER. CO. 7479	12-05-88	A. S. J.	L. W. B.
17C		38	130+23 RT. 130+58 RT.	130+73 RT.	0.02A±	19.93A±							950 S.F. ± 12' GRAVEL DRIVE MM 0040	55	32	PARCEL NO. 54 M & M TRUST ADD RESET (T) FENCE FOR FOLLOWING STA. 304+50LT. ~305+99LT PER. CO. 7480	12-05-88	A. S. J.	L. W. B.
	PARCEL 17 CONT. ON SHEET *13													56	31	PARCEL NO. 53 LETOURNEAU, ADD RESET (T) FENCE FOR THE FOLLOWING STATIONS: 288+65LT. ~ 295+12LT.; 289+20RT. ~305+12RT.; 305+45RT. ~ 305+95RT. PER. CO. 7481	12-06-88	A. S. J.	L. W. B.
														57	29	PARCEL NO. 51 STARR-ESTATE, ADD RESET FENCE FOR FOLLOWING STATIONS: 274+10RT. ~276+31RT. 276+31RT. ~282+35RT. PER. CO. 7482	12-05-88	A. S. J.	L. W. B.

PROP. ADJEN. 5-87

DR. RT.- DRAINAGE RIGHT
DIT. RT.- DITCHING RIGHT
CH. RT.- CHANNEL RT.
DRIVE RT.- DRIVE RIGHT
CUL. RT.- CULVERT RIGHT
(D) - DEMOLITION OR REMOVAL
[W] - WATER SOURCES

PRESENT R.O.W.
TAKING WITHOUT ACCESS
TAKING WITHOUT ACCESS ALONG PROPERTY LINE
TAKING WITH ACCESS
PERMANENT EASEMENT
TEMPORARY EASEMENT

LEGEND
--- CONST. EASE. ---
SR SR
P
L
TOP OF CUT
TOE OF SLOPE

CONSTRUCTION EASEMENT
SLOPE RIGHTS
PROPERTY LINE
APPROVED: LAWRENCE BLISS, L.S. DATE: 3-10-87
AGENT D. PLANS & TITLES

R. O. W. PLANS
TROY
RS 0311(1)
SHEET 12 OF 50

TABLE OF PROJECT PROPERTY ACQUISITION

STATE OF VERMONT
AGENCY OF TRANSPORTATION
RIGHT OF WAY PLANS
DETAIL SHEET

PARCEL NO.	GRANTOR	SHEET NO.	BEGINNING STATION	ENDING STATION	TAKING	REM.	RIGHTS	TITLE TAKEN	DATE	TOWN OR CITY RECORDED	BK.	PG.	REMARKS	REVISION NO.	SHEET	DESCRIPTION OF REVISION	DATE	MADE BY	APPROVED BY
170	LIMOGES, RONALD & JANE TAYLOR, GARY & RITA (CONTINUED FROM SHEET #12)	38	130+23 RT.	130+73 RT.	0.03A±		ALL R.T. & I.						EXIST VT. RTE. 101 R.O.W. 1150 S.F.±	58	26, 27	PARCEL NO. 46 FRICKE: ADD RESET (T) FENCE FOR THE FOLLOWING STA. REV. 260+96RT. ~ REV. 261+93RT.; 273+10RT. ~273+41RT.; 273+41RT 273+75RT. PER CO. 7483	12-05-88	A. S. J.	L. W. B.
18A	LEMay, RAYMOND J. & PATRICIA M.	38	124+47 LT. 124+64 LT. 126+20 LT. 126+90 LT.	129+27 LT. 129+27 LT. 129+27 LT.	0.10A±	7.10A±	DRIVE (T) CONST. EASE. (T) SLOPE (P) 0.06A± 0.12A±	WD	12-11-80	TROY	50	425-426	21' GRAVEL MM 0029 2750 S.F.±	59	25	PARCEL NO. 44 MAYHEW ADD RESET (T) FENCE FOR FOLLOWING STA. REV. 255+99LT. ~256+57LT. PER CO. 7484	12-06-88	A. S. J.	L. W. B.
18B		38	122+40 RT.	129+27 LT.	0.20A±		ALL R.T. & I.						EXIST. VT. RTE. 101 R.O.W.	60	24	PARCEL NO. 42 JACOBS, THURSTON ADD RESET (T) FENCE FOR THE FOLLOWING STA. REV. 237+24LT. ~ REV. 251+52LT.; REV. 253+10LT. ~REV. 255+99LT.; REV. 246+94RT. ~REV. 250+58RT. PER. CO. 7485	12-06-88	A. S. J.	L. W. B.
19A	BATHALON, ROGER M. & ROLANDE L.	38	128+17 RT. 128+73 RT. 129+11 RT.	130+23 RT. 129+93 RT.	0.07A±	0.93A±	LANDSCAPE (T) DRIVE (T)	WD	01-27-89	TROY	48	55-6	3040 S.F.± POST & RAIL FENCE TRANSPLANT 3 TREES 22' GRAVEL MM 0037	61	23, 24	PARCEL NO. 41 STARR ADD RESET (T) FENCE FOR FOLLOWING STA.; REV. 233+25LT. ~REV. 237+21LT.; REV. 237+25RT. ~REV. 246+94RT.; REV. 253+61RT. ~REV. 254+20RT.; REV. 256+18RT. ~REV. 260+96RT. PER. CO. 7486	12-06-88	A. S. J.	L. W. B.
19B		38	128+17 RT.	130+23 RT.	0.13A±		ALL R.T. & I.						EXIST. VT. RTE. 101 R.O.W.	62	25, 46	PARCEL NO. 44 MAYHEW REVISED TAKE, REMAINDER & RIGHTS TO CONFORM THE REVISED CENTER LINE CHANGE PER CO. 7487	12-06-88	A. S. J.	L. W. B.
20A	LIMOGES, ROLAND G. & YVETTE L.	38	132+65 LT. 129+27 LT. 129+28 LT. 131+15 LT. 131+38 LT.	133+22 LT. 131+00 LT. 131+00 LT.	0.01A±	4.40A±	SLOPE (P) CONST. EASE. (T) DRIVE (T) 0.07A± 0.04A±	WD	11-08-89	TROY	49	91-92	60 S.F.± 2875 S.F.± 1770 S.F.± 23' PAVED MM 0041 CINDER BLOCK WALL D-3	63	23, 24 43-46	PARCEL NO. 41 STARR, SR. REVISED TAKE, REMAINDER & RIGHTS TO CONFORM WITH NEW REVISED CENTERLINE PER CO. 7488	12-06-88	A. S. J.	L. W. B.
20B		38	129+27 LT.	133+22 LT.	0.26A±		ALL R.T. & I.						EXISTING VT. RTE. 101 R.O.W.	64	25, 46	PARCEL NO. 45 CUTTING, REVISED TAKE, & REMAINDER TO CONFORM WITH NEW REVISED CENTERLINE PER CO. 7489	12-06-88	A. S. J.	L. W. B.
														65	27, 28 46	PARCEL NO. 47 GREENE REVISED TAKE, & REMAINDER & RIGHTS TO CONFORM TO NEW REVISED CENTERLINE PER CO. 7490	12-06-88	A. S. J.	L. W. B.
														66	26, 27 46, 47	PARCEL NO. 46 FRICKE: REVISED TAKE, & REMAINDER & RIGHTS TO CONFORM TO NEW REVISED CENTERLINE PER CO. 7491	12-06-88	A. S. J.	L. W. B.
														67	6, 26 27, 46 47	PARCEL NO. 46 FRICKE: TITLE CHANGE FROM DONNELLY, DONALD H. & MARJORIE R. TO FRICKE, PAUL H. PER CO. 7492	12-06-88	A. S. J.	L. W. B.
														68	28, 46 47	PARCEL NO. 49 AUGER REVISED TAKE, & REMAINDER & RIGHTS TO CONFORM WITH NEW REVISED CENTERLINE PER CO. 7493	12-06-88	A. S. J.	L. W. B.
														69	28, 46	PARCEL NO 48 SABO REVISED TAKE, REMAINDER & RIGHTS TO CONFORM WITH NEW REVISED CENTERLINE PER CO. 7494	12-06-88	A. S. J.	L. W. B.

ACCT. RYAN
ZFA21701078E1420.DGN
PRF: 78E14206.PRF LV=46
DATE PLOTTED 9-AUG-1989

DR. RT.- DRAINAGE RIGHT
DIT. RT.- DITCHING RIGHT
CH. RT.- CHANNEL RT.
DRIVE RT.- DRIVE RIGHT
CUL. RT.- CULVERT RIGHT
(D)- DEMOLITION OR REMOVAL
(W)- WATER SOURCES

PRESENT R.O.W.
TAKING WITHOUT ACCESS
TAKING WITHOUT ACCESS ALONG PROPERTY LINE
TAKING WITH ACCESS
PERMANENT EASEMENT
TEMPORARY EASEMENT

LEGEND

--- CONST. EASE. ---
SR SR
P
L
TOP OF CUT
TOE OF SLOPE

CONSTRUCTION EASEMENT
SLOPE RIGHTS
PROPERTY LINE
TOP OF CUT
TOE OF SLOPE

APPROVED: LAWRENCE BLISS, L.S. DATE: 3-10-87
AGENT D. PLANS & TITLES

R. O. W. PLANS

TROY
RS 0311(1)
SHEET 13 OF 50

TABLE OF PROJECT PROPERTY ACQUISITION

STATE OF VERMONT
AGENCY OF TRANSPORTATION
RIGHT OF WAY PLANS
DETAIL SHEET

PARCEL NO.	GRANTOR	SHEET NO.	BEGINNING STATION	ENDING STATION	TAKING	REM.	RIGHTS	TITLE TAKEN	DATE	TOWN OR CITY RECORDED	BK.	PG.	REMARKS	REVISION NO.	SHEET	DESCRIPTION OF REVISION	DATE	MADE BY	APPROVED BY
21A	SOLD												FORMERLY DAIGLE	70	28, 29	PARCEL NO. 50 M. DERMUTH REVISED TAKE, REMAINDER & RIGHTS TO CONFORM WITH NEW REVISED CENTERLINE PER. CO. 7495	12-06-88	A. S. J.	L. W. B.
21B	SOLD												FORMERLY DAIGLE	47					
21C	WILLIAMS, MARIE	38	137+16 LT.	137+84 LT.	0.02A±	0.43A±		WD	12-17-90	TROY	50	483	705 S.F. ±	71	29, 47	PARCEL NO. 51 STARR ESTATE REVISED TAKE, REMAINDER & RIGHTS TO CONFORM WITH NEW REVISED CENTERLINE PER. CO. 7496	12-06-88	A. S. J.	L. W. B.
21D		38	137+16 LT.	137+82 LT.	0.04A±		ALL R.T. & I.						EXIST. VT. RTE. 101 R.O.W. 1915 S.F. ±	72	30, 47	PARCEL NO. 52 POULIN ADDED SLOPE (T) AT STA 276+87LT. ~277+20LT. REVISED BEG. & ENDING STA. FOR PARCEL 52C FROM 274+66LT. ~288+63LT. TO READ 274+31LT. ~288+72LT. PER. CO. 7497	12-06-88	A. S. J.	L. W. B.
22A	LEMIEUX, LOUIS & DELIA	38	133+22 LT. 133+48 LT. 133+65 LT. 134+00 LT. 134+69 LT.	134+74 LT. 134+69 LT. 134+74 LT.	0.01A±	0.51A±	DRIVE (T) CULVERT (P) SLOPE (T) CULVERT (P)	WD	11-22-89	TROY	49	113-14	455 S.F. 21' GRAVEL MM 0046 BY OPTION ONLY 370 S.F. ±	73	32, 49	PARCEL NO. 54 M&E TRUST DELETED SLOPE (T) STA. 304+00LT. ~304+15LT. REVISED BEG. STA. FOR PARCEL 54B FROM 302+85LT. TO READ 302+88LT. DELETED DITCH (P) BETWEEN STA. 305+00LT. ~305+27LT. PER. CO. 7498	12-06-88	A. S. J.	L. W. B.
22B		38	133+22 LT.	134+74 LT.	0.09A±		ALL R.T. & I.						EXIST. VT. RTE. 101 R.O.W. 3800 S.F. ±	74	33, 49	PARCEL 56 STARR, JR. CORRECTED SPELLING ON DETAIL ON DIANNE STARR, DELETED SLOPE (T) STA. 322+33LT. ~322+65LT. REVISED BEG. ENDING STA. FOR 56G FROM 305+98LT. ~308+99LT. TO READ 305+97LT. ~308+98LT. PER. CO. 7499	12-06-88	A. S. J.	L. W. B.
23A	TURGEON, DENNIS L. & RACHEL S.	38	134+47 RT. 134+48 RT. 134+69 RT.	137+70 RT. 136+35 RT.	0.08A±	1.32A±	SLOPE (T) CUL. DIT. & DR. (P)	WD	01-16-90	TROY	49	262-63	3475 S.F. ± 750 S.F. ±	75	34, 50	PARCEL NO. 58 LENGE ADD MIDDLE INITIAL 'D' REVISED ENDING STA. FOR SLOPE (T) FROM 317+77RT. TO READ 318+23RT. PER. CO. 7500	12-06-88	A. S. J.	L. W. B.
23B		38	134+47 RT.	137+70 RT.	0.19A±		ALL R.T. & I.						EXISTING VT. RTE. 101 R.O.W.	76	34, 50	PARCEL NO. 59 MAYHEW REVISED BEG. STA. FOR SLOPE (T) FROM 318+50LT. TO READ 317+76LT. PER. CO. 7501	12-06-88	A. S. J.	L. W. B.
														77	34, 35	PARCEL NO. 60 STARR V. ADD 'D' MIDDLE INITIAL FOR LINDA D. STARR REVISED ENDING STA. FOR CONST. EASE (T) FROM 318+64RT. TO READ 319+50RT. REVISED AREA FROM 0.04A± TO 0.03A± REVISED ENDING STA. FOR PARCEL 60B FROM 321+80RT. TO READ 321+80LT. PARCEL 60C REVISED ENDING STA. OF SLOPE (T) FROM 317+46RT. TO READ 317+80RT. PER. CO. 7502	12-06-88	A. S. J.	L. W. B.
														78	35A	PARCEL NO. 68 HARRIS, GILMAN REVISED TAKE, REMAINDER & RIGHTS TO CONFORM WITH NEW REVISED CENTERLINE PER. CO. 7503	12-06-88	A. S. J.	L. W. B.
														79	15, 38-40	PARCEL NO. 26 GIGUERE; CHANGED DETAIL SHEET TO AGREE WITH REVISED LINE CHANGE PER CO. 7282	12-08-88	A. S. J.	L. W. B.

CCT, RYAN
ZFA2170, J178E1420.DGN
PRF: 78E14201.PRF LV: 47
DATE PLOTTED 9-AUG-1989

DR. RT. - DRAINAGE RIGHT
DIT. RT. - DITCHING RIGHT
CH. RT. - CHANNEL RT.
DRIVE RT. - DRIVE RIGHT
CUL. RT. - CULVERT RIGHT
⊖ - DEMOLITION OR REMOVAL
W - WATER SOURCES

PRESENT R.O.W.
TAKING WITHOUT ACCESS
TAKING WITHOUT ACCESS ALONG PROPERTY LINE
TAKING WITH ACCESS
PERMANENT EASEMENT
TEMPORARY EASEMENT

LEGEND
--- CONST. EASE. ---
SR SR
P
L
△
○

CONSTRUCTION EASEMENT
SLOPE RIGHTS
PROPERTY LINE
TOP OF CUT
TOE OF SLOPE

APPROVED: LAWRENCE BLISS, L.S. DATE: 3-10-87
AGENT D. PLANS & TITLES

R. O. W. PLANS

TROY
RS 0311(1)
SHEET 14 OF 50

TABLE OF PROJECT PROPERTY ACQUISITION

STATE OF VERMONT
AGENCY OF TRANSPORTATION
RIGHT OF WAY PLANS
DETAIL SHEET

PARCEL NO.	GRANTOR	SHEET NO.	BEGINNING STATION	ENDING STATION	TAKING	REM.	RIGHTS	TITLE TAKEN	DATE	TOWN OR CITY RECORDED	BK.	PG.	REMARKS	REVISION NO.	SHEET	DESCRIPTION OF REVISION	DATE	MADE BY	APPROVED BY
24A	MODESTINO, ANTHONY J. & SHERWOOD A.	38	134+74 LT. 134+74 LT. 135+50 LT. 136+20 LT. 136+50 LT.	136+66 LT. 135+37 LT. 136+66 LT. 136+66 LT.	0.01A±	0.64A±	SLOPE (T) 0.01A± DRIVE (T) 0.01A± SLOPE (T) 0.01A± CULVERT (P)	WD	1-13-89	TROY	48	48-9	385 S.F.± 218 S.F.± 19' GRAVEL MM 0050 235 S.F.±	80	18	PARCEL NO. 30 MONAHAN; REVISED TAKE, REMAINDER AND RIGHTS TO CONFORM WITH NEW REVISED CENTERLINE PER. CO. 7412	12-08-88	A. S. J.	L. W. B.
24B		38	134+74 LT.	136+66 LT.	0.13A±		ALL R.T. & I.						EXIST. VT. RTE. 101 R.O.W.	81	17,18	PARCEL NO. 28 MISSISSQUOI CORP. REVISED TAKE REMAINDER & RIGHTS TO CONFORM WITH NEW REVISED LINE CHANGE PER. CO. 7414	12-08-88	A. S. J.	L. W. B.
25A	LEMAY, RAYMOND J. DESCENEUX, ROGER J.	38	136+64 LT. 136+64 LT. 136+83 LT.	137+16 LT. 137+05 LT.	0.01A±	28.12A±	CUL. & DROP INLET(P) DRIVE (T)	WD	8-25-89	TROY	48	473-74	175 S.F.± 25' GRAVEL MM 0052	82	8,36	PARCEL NO. 2 TOWN OF TROY; REVISED PARCEL TO CONFORM WITH REVISED LINE CHANGE PER. CO. 7413	12-08-88	A. S. J.	L. W. B.
25B		38	136+64 LT.	137+16 LT.	0.03A±		ALL R.T. & I.						EXIST. VT. RTE. 101 R.O.W. 1500 S.F.±	83	19,42	PARCEL NO. 34 DESCHENEUX; CHANGE BEG. STA. FOR PARCEL 34 FROM 191+22LT. TO REV. STA. 191+22LT. PER. CO. 7426	12-08-88	A. S. J.	L. W. B.
26A	GIGUERE, RAYMOND C., JR. & LILLIAN L.	38-40	137+82 LT. 137+84 LT. 138+25 LT. 140+00 LT. 143+40 LT. 144+00 LT. 145+55 LT. REV. 154+58 LT. REV. 157+45 LT. REV. 157+80 LT. REV. 159+36 LT.	REV. 150+50 LT. 144+84 LT. 139+50 LT. 144+40 LT. 143+58 LT. REV. 148+45 LT. REV. 159+30 LT. REV. 158+10 LT.	2.17A±	109.13A±	CONST. EASE. (T) 0.15A± SLOPE (T) 0.01A± SLOPE (T) 0.28A± CUL, DIT, & DR. (P) DRAINAGE (P) CONST. EASE. (T) 0.03A± SLOPE (T) 0.01A± DRIVE (T)	COND	02-26-90	TROY	49	349-62	510 S.F.± FENCE D-4 12' GRAVEL MM 0086 1388 S.F.± 32 S.F.± 12' GRAVEL MM 0095	84	19,41	PARCEL NO. 33 HAZUKA CHANGED ALL STA. TO READ REVISED STA. PER. CO. 7427	12-08-88	A. S. J.	L. W. B.
26B		38-40	137+74 RT. 141+54 RT.	REV. 160+47 RT. 142+16 RT.	1.36A±		ALL R.T. & I. SLOPE (T) 0.01A±						EXISTING VT. RTE. 101 R.O.W. 192 S.F.±	85	18,41	PARCEL NO. 32 MATTESICH; CHANGED ALL STA. TO READ REVISED, CHANGED BEG. STA. FROM 182+48LT. TO READ REV. 182+47LT. PER. CO. 7428	12-08-88	A. S. J.	L. W. B.
														86	41	PARCEL NO. 31 LEBLANC; CHANGE ALL STA. TO READ REVISED, CHANGED BOTTOM STA. FROM REV. 186+46 8' LT. TO REV. 182+47 8' LT. CHANGED ENDING STA. FROM 182+48LT. TO REV. 182+47LT. PER. CO. 7429	12-08-88	A. S. J.	L. W. B.
														87	9,36	PARCEL NO. 4 WATTS; REVISED TOTAL AREA TO 0.80A± PER. CO. 7436	12-08-88	A. S. J.	L. W. B.
														88	22,43	PARCEL NO. 39 DIAZ; CHANGED ENDING STA. FOR 39C 219+62 124' LT. TO READ 219+59 121' LT. REVISED ENDING STA. FOR 39B FROM 212+78LT. TO READ 212+77LT. CHANGED BEG STA. 39C FROM 215+64LT. TO READ 215+55LT. PER. CO. 7437	12-08-88	A. S. J.	L. W. B.
														89	34,50	PARCEL NO. 59 MAYHEW REVISED TAKING AND REMAINDER AND SLOPE AREAS; REVISED ENDING STATIONS FOR 59A, 59B, AND SLOPE BECAUSE OF DECREASED R.O.W. WIDTH OF BELLE VISTA RD. FROM 66' TO 50' PER. CO. 7512	12-16-88	A. S. J.	L. W. B.
														90	8	PARCEL NO. 2' REVISED TAKING AREA FROM 0.70A± TO 0.07A± PER. CO. 07533	01-11-89	A. S. J.	L. W. B.

DR. RT.- DRAINAGE RIGHT
DIT. RT.- DITCHING RIGHT
CH. RT.- CHANNEL RT.
DRIVE RT.- DRIVE RIGHT
CUL. RT.- CULVERT RIGHT
ⓓ- DEMOLITION OR REMOVAL
W- WATER SOURCES

PRESENT R.O.W.
TAKING WITHOUT ACCESS
TAKING WITHOUT ACCESS ALONG PROPERTY LINE
TAKING WITH ACCESS
PERMANENT EASEMENT
TEMPORARY EASEMENT

LEGEND
--- CONST. EASE. ---
SR SR
P
L
△ △ △
○ ○ ○
CONSTRUCTION EASEMENT
SLOPE RIGHTS
PROPERTY LINE
TOP OF CUT
TOE OF SLOPE

APPROVED: LAWRENCE BLISS, L.S. DATE: 3-10-87
AGENT D. PLANS & TITLES

R. O. W. PLANS

TROY
RS 0311(1)
SHEET 15 OF 50

TABLE OF PROJECT PROPERTY ACQUISITION

STATE OF VERMONT
AGENCY OF TRANSPORTATION
RIGHT OF WAY PLANS
DETAIL SHEET

PARCEL NO.	GRANTOR	SHEET NO.	BEGINNING STATION	ENDING STATION	TAKING	REM.	RIGHTS	TITLE TAKEN	DATE	TOWN OR CITY RECORDED	BK.	PG.	REMARKS	REVISION NO.	SHEET	DESCRIPTION OF REVISION	DATE	MADE BY	APPROVED BY
27	LONTINE, ROLAND W. & DOROTHY	39	142+67 RT. TOWN HWY. # 24 41+25 LT.	144+18 RT.	0.09A±		ALL R.T. & I DRIVE (T)	COND	2-26-90	TROY	49	349-62	EXIST. VT. RTE. 101 R.O.W. 4050 S.F.± 12' GRAVEL	91	8	PARCEL NO. 2 TOWN OF TROY; REVISED TAKING AREA TO READ 0.07A± AND NOT 0.70A± PER. CO. 07533	01-19-89	A. S. J.	L. W. B.
														92	13, 38	PARCEL NO. 20 LIMOGES; DELETED SLOPE (P) FROM STA. 132+65LT. TO 133+22LT. PER. CO. 7540	01-19-89	A. S. J.	L. W. B.
														93	14, 38	PARCEL NO. 22 LEMIEUX; CHANGE SLOPE (T) AT STA. 133+55LT. TO 134+74LT. 493 SF± TO 134+00LT. ~134+74LT. AREA IS NOW 370 SF± PER. CO. 7541	01-19-89	A. S. J.	L. W. B.
														94	15, 38	PARCEL NO. 25 LEMAY; DELETED SLOPE (T) AT STA. 137+00LT. TO 137+16LT. PER. CO. 7542	01-19-89	A. S. J.	L. W. B.
28A	MISSISSQUOI, CORPORATION CONT. ON SHEET 17	39-42	REV. 146+55 RT. REV. 147+97 RT. REV. 149+38 RT. REV. 152+40 RT. REV. 152+46 RT. REV. 153+63 RT. REV. 154+50 RT. REV. 156+98 RT. REV. 160+09 RT. REV. 162+05 RT. REV. 162+35 RT. REV. 162+64 RT. REV. 163+84 RT. REV. 166+50 RT. REV. 167+10 RT. REV. 167+00 RT. REV. 168+00 RT. REV. 170+50 RT. REV. 171+33 RT. REV. 173+00 RT. REV. 173+68 RT.	203+44 RT. REV. 149+66 RT. REV. 155+72 RT. REV. 155+51 RT. REV. 158+68 RT. REV. 161+66 RT. REV. 166+00 RT. REV. 165+60 RT. REV. 175+40 RT. REV. 170+40 RT. REV. 175+13 RT.	6.17A±	1150.81A±	DRAINAGE (P) DRIVE (T) CONST. EASE. (T) 0.06A± SLOPE (T) 0.01A± CUL. DIT. & DR. (P) CONST. EASE. (T) 0.01A± CONST. EASE. (T) 0.02A± CONST. EASE. (T) 0.30A± DRAINAGE (P) SLOPE (P) 0.06A± CUL. DIT. & DR. (P) CONST. EASE. (T) 0.10A± SLOPE (P) 0.04A± DIT. & DR. (P) CUL. DIT. & DR. (P) DIT. & DR. (P) DIT. & DR. (P) DRAINAGE (P) SLOPE (T) 0.05A±	WD	1-24-90	TROY	49	349-62	FENCE 0-5 13' GRAVEL MM 0082 2487 S.F.± 308 S.F.± 664 S.F.± 821 S.F.± 2600 S.F.± 1700 S.F.± 2000 S.F.±	95	14, 38	PARCEL NO. 21 WILLIAMS; DELETED SLOPE (T) AT STA. 137+16LT. TO 137+40LT. PER. CO. 7543	01-19-89	A. S. J.	L. W. B.
														96	17, 38	PARCEL NO. 29 STEVENS; DELETED SLOPE (T) AT STA. 132+62RT. TO 133+55RT. PER. CO. 7544	01-19-89	A. S. J.	L. W. B.
														97	16, 17 39, 42	PARCEL NO. 28 MISSISSQUOI CORP. CHANGE ENDING OF CONST. EASE. (T) AT REV. STA. 175+36RT. TO 166+00RT. & ENDING STA. OF SLOPE (T) AT STA. 170+40RT. TO 165+60RT. & BEGINNING STA. OF SLOPE (T) FROM 173+23RT. TO 173+68RT. CHANGE ENDING STA. OF SLOPE (T) FROM 178+50RT. TO REV. 177+90RT. & ENDING STA. OF SLOPE (T) FROM 180+38RT. TO REV. 179+95RT. DELETED SLOPE (P) AT STA. 171+10RT. TO 171+45RT. DELETED SLOPE (T) AT REV. STA. 182+72RT. TO REV. 183+25RT. ADD SLOPE (P) AT REV. STA. 167+10RT. TO REV. 170+40RT. AREA IS NOW 0.04A± 1700 SF± ADD SLOPE (P) REV. STA. 166+50RT. TO REV. 170+40RT. 0.10A± INCREASE CONST. EASE (T) REV. STA. 175+94RT. TO REV. 180+70RT. FROM 0.10A± TO 0.13A± PER. CO. 7545	01-19-89	A. S. J.	L. W. B.
														98	19, 41	PARCEL NO. 33 HAZUKA; DELETED TWO SLOPES (T) AT REV. STA. 185+20LT. TO REV. 185+35LT. & REV. STA. 185+47LT. TO REV. 185+80LT. PER. CO. 7546	01-19-89	A. S. J.	L. W. B.
														99	20, 42	PARCEL NO. 35 MORRISSETTE; DELETED 3 SLOPES (T) AT STA. 199+67LT. TO 199+98LT. & 200+14LT. TO 200+40LT. & 200+60LT. TO 201+14LT. & DELETED CONST. EASE. (T) AT STA. 200+40LT. TO 201+14LT. PER. CO. 7547	01-19-89	A. S. J.	L. W. B.

DR. RT.- DRAINAGE RIGHT
DIT. RT.- DITCHING RIGHT
CH. RT.- CHANNEL RT.
DRIVE RT.- DRIVE RIGHT
CUL. RT.- CULVERT RIGHT
⊖- DEMOLITION OR REMOVAL
☒- WATER SOURCES

PRESENT R.O.W.
TAKING WITHOUT ACCESS
TAKING WITHOUT ACCESS ALONG PROPERTY LINE
TAKING WITH ACCESS
PERMANENT EASEMENT
TEMPORARY EASEMENT

LEGEND

--- CONST. EASE. ---
SR SR
P
L
△ △ △
○ ○ ○

CONSTRUCTION EASEMENT
SLOPE RIGHTS
PROPERTY LINE
TOP OF CUT
TOE OF SLOPE

MAY 19 1997

APPROVED: LAWRENCE BLISS, L.S. DATE: 3-10-87
AGENT D. PLANS & TITLES

R. O. W. PLANS

TROY
RS 0311(1)
SHEET 16 OF 50

TABLE OF PROJECT PROPERTY ACQUISITION

STATE OF VERMONT
AGENCY OF TRANSPORTATION
RIGHT OF WAY PLANS
DETAIL SHEET

PARCEL NO.	GRANTOR	SHEET NO.	BEGINNING STATION	ENDING STATION	TAKING	REM.	RIGHTS	TITLE TAKEN	DATE	TOWN OR CITY RECORDED	BK.	PG.	REMARKS	REVISION NO.	SHEET	DESCRIPTION OF REVISION	DATE	MADE BY	APPROVED BY
28A	MISSISSQUOI CORPORATION CONT. FROM SHEET 16	41-42	REV. 173+50 RT. REV. 175+94 RT. REV. 176+27 RT. REV. 178+00 RT. REV. 179+00 RT. REV. 182+00 RT. REV. 183+62 RT. REV. 184+05 RT. REV. 186+96 RT. REV. 187+65 RT. 191+26 RT. 191+55 RT. 192+00 RT. 192+65 RT. 192+50 RT. 194+50 RT. 196+00 RT. 199+13 RT. 200+77 RT. 201+00 RT. 202+35 RT. 202+49 RT.	REV. 180+70 RT. REV. 177+90 RT. REV. 179+95 RT. REV. 185+85 RT. REV. 185+63 RT. REV. 184+27 RT. REV. 190+55 RT. REV. 189+98 RT. 196+35 RT. 196+11 RT. 201+40 RT. 203+42 RT. 203+42 RT.			DRAINAGE (P) CONST. EASE. (T) 0.13A± SLOPE (T) 0.06A± CUL. DIT. & DR. (P) SLOPE (T) 0.02A± CONST. EASE. (T) 0.09A± SLOPE (T) 0.03A± CUL. DIT. & DR. (P) CONST. EASE. (T) 0.06A± SLOPE (P) 0.05A± DRIVE (T) CONST. EASE. (T) 0.12A± SLOPE (T) 0.10A± DIT. & DR. (P) CUL. & DIT. & DR. (P) CUL. & DR. (P) DRAINAGE (P) SLOPE (T) CUL. DIT. & DR. (P) CONST. EASE. (T) 0.03A± SLOPE (P) 0.01A±						2800 S.F. ± 660 S.F. ± 4264 S.F. ± 1386 S.F. ± CHANNEL LINE 'C' 2725 S.F. ± 2200 S.F. ± FENCE D-6 13' GRAVEL MM 0156 279 S.F. ± 1400 S.F. ± 525 S.F. ± EXIST. VT. RTE. 101 R.O.W.	100	20, 43	PARCEL NO. 37 HERMANN: DELETED CONST. EASE (T) AT STA. 205+61 RT. TO 213+53 RT. DELETED SLOPE AT STA. 205+84 RT. TO 210+50 RT. DELETED REMOVE & RESET STA. 206+50 RT. DELETED SLOPE AT STA. 210+50 RT. TO 213+10 RT. ADD CONST. EASE. (T) AT STA. 206+72 RT. TO 212+50 RT. PER. CO. 07548	01-19-89	A. S. J.	L. W. B.
														101	9, 36	PARCEL NO. 4 WATTS: DELETED DRIVE AT STA. 114+30 RT. PER. CO. 07560	01-19-89	A. S. J.	L. W. B.
														102	17, 38	PARCEL NO. 29 BRISSETT: TITLE CHANGE FROM STEVENS, MARCIA J. TO BRISSETT, CHARLES A. & ELIZABETH M. PER. CO. 07566	01-27-89	A. S. J.	L. W. B.
														103	19, 42	PARCEL NO. 34 DESCHENEUX: CHANGE ENDING STA. OF 34A TO 199+49 LT. & ENDING STA. OF 34B TO 199+50 LT. AND AREA TO 0.47A± PER. CO. 07569	01-27-89	A. S. J.	L. W. B.
														104	25, 46	PARCEL NO. 44 FADIMAN: CHANGE TITLE FROM MAYHEW, DAVID & DEBRA L. TO FADIMAN, MARY LOU & JONATHAN R. PER. CO. 07568	01-27-89	A. S. J.	L. W. B.
28B		39-42	144+10 RT.	203+42 RT.	3.48A±		ALL R.T. & I.							105	21, 43	PARCEL NO. 39 JOHNSON: TITLE CHANGE FROM DIAZ, FRANK E. & PATTI L. TO JOHNSON, KAREN K. PER. CO. 07572	01-27-89	A. S. J.	L. W. B.
29A	BRISSETT, CHARLES A. & ELIZABETH M.	38	130+73 RT. 130+84 RT.	133+98 RT. 132+27 RT.	0.12A±	1.18A±	SLOPE (T) 0.05A±	COND	2-26-90	TROY	49	349-62	2400 S.F. ±	106	21, 43	PARCEL NO. 39 JOHNSON: REVISED SLOPE (T) FROM STA. 210+50 LT. CHANGE AREA FROM 0.02A± / 705 S.F. ± TO READ 0.01A± / 96 S.F. ± INCREASE CONST. EASE (T) BY 0.01A± PER. CO. 07591	02-08-89	A. S. J.	L. W. B.
29B		38	130+73 RT.	133+98 RT.	0.18A±		ALL R.T. & I.						EXISTING VT. RTE. 101 R.O.W.	107	22, 43	PARCEL NO. 40 BEERWORTH: DELETED (TWO) SLOPE (T) BETWEEN STATIONS 214+05 LT. ~ 214+40 LT. & 214+56 LT. PER. CO. 07592	02-08-89	A. S. J.	L. W. B.
														108	21, 43	PARCEL NO. 38 WURSTHORN: DELETED SLOPE (T) FROM STA. 209+55 LT. ~ 209+98 LT. REVISED SLOPE (T) BEG. STA. FROM 207+75 LT. TO READ 207+88 LT. ALSO CHANGE SLOPE AREA FROM 60 SF. TO READ 35 S.F. ± PER. CO. 07593	02-08-89	A. S. J.	L. W. B.

ACCT. RYAN
2FA24C70.0378E42D.DGN
PRF1 78E42D00.PRF LV=50
DATE PLOTTED 9-AUG-1989

DR. RT.- DRAINAGE RIGHT
DIT. RT.- DITCHING RIGHT
CH. RT.- CHANNEL RT.
DRIVE RT.- DRIVE RIGHT
CUL. RT.- CULVERT RIGHT
(D)- DEMOLITION OR REMOVAL
(W)- WATER SOURCES

PRESENT R.O.W.
TAKING WITHOUT ACCESS
TAKING WITHOUT ACCESS ALONG PROPERTY LINE
TAKING WITH ACCESS
PERMANENT EASEMENT
TEMPORARY EASEMENT

LEGEND
--- CONST. EASE. ---
SR SR
P
L
TOP OF CUT
TOE OF SLOPE

CONSTRUCTION EASEMENT
SLOPE RIGHTS
PROPERTY LINE
TOP OF CUT
TOE OF SLOPE

MAY 19 1997
APPROVED: LAWRENCE BLISS, L.S. DATE: 3-10-87
AGENT D. PLANS & TITLES

R.O.W. PLANS
TROY
RS 0311(1)
SHEET 17 OF 50

TABLE OF PROJECT PROPERTY ACQUISITION

STATE OF VERMONT
AGENCY OF TRANSPORTATION
RIGHT OF WAY PLANS
DETAIL SHEET

PARCEL NO.	GRANTOR	SHEET NO.	BEGINNING STATION	ENDING STATION	TAKING	REM.	RIGHTS	TITLE TAKEN	DATE	TOWN OR CITY RECORDED	BK.	PG.	REMARKS	REVISION NO.	SHEET	DESCRIPTION OF REVISION	DATE	MADE BY	APPROVED BY
30A	MONAHAN, JAMES W. & PAMELA K.	40	REV. 161+78 LT. REV. 163+58 LT. REV. 163+73 LT.	167+05 LT. 167+05 LT. 166+55 LT.	0.26A±	9.83A±	CONST. EASE. (T) 0.07A± SLOPE (P) 0.10A±	OPTION	07-13-94	TROY	54	99-100	3062 S.F.±	109	17, 41	PARCEL NO. 28 MISSISSOUI CORP. REVISED AREA FOR CONST. EASE. (T) FROM REV. STA. 182+00 RT. ~ REV. 185+85 RT. FROM 0.07A± / 3000 SF± TO READ 0.09A± / 4264 S.F.± REVISED SLOPE (T) BEG. STA. FROM REV. 183+55 RT. TO READ REV. 183+62 RT. & REVISED AREA FROM 0.06A± / 2650 S.F.± TO READ 0.03A± / 1386 SF± REVISED SLOPE (T) BEG. & END STA. FROM 192+28 RT. ~ 196+16 RT. TO READ 192+65 RT. ~ 196+11 RT. AND REVISED AREA FROM 0.13A± TO 0.10A± REVISED SLOPE (T) BEG. & END STA. FROM 200+70 RT. ~ 201+42 RT. TO READ 200+77 RT. ~ 201+40 RT. AND REVISED AREA FROM 0.02A± / 705 S.F.± TO READ 0.01A± / 279 S.F.± REVISED SLOPE (P) AREA FROM STA. 202+49 RT. ~ 203+42 RT. FROM 0.02A± / 725 S.F.± TO READ 0.01A± / 525 S.F.± REVISE AREA OF CONST. EASE. (T) STA. 202+35 RT. ~ 203+42 RT. FROM 1200 SF± TO READ 1400 SF± REVISE AREA OF CONST. EASE. (T) 192+00 RT. ~ 196+35 RT. FROM 0.09A± / 4000 SF± TO 0.12A± PER CO. 07595	02-08-89	A. S. J.	L. W. B.
30B		41	REV. 173+62 LT. REV. 174+75 LT. REV. 175+20 LT. REV. 177+00 LT. REV. 178+15 LT. REV. 179+80 LT.	REV. 180+48 LT. REV. 180+48 LT. REV. 175+75 LT. REV. 177+80 LT. REV. 179+40 LT. REV. 180+48 LT.	0.34A±	10.32A±	CONST. EASE. (T) 0.09A± SLOPE (P) 0.01A± SLOPE (P) 0.01A± SLOPE (P) 0.01A± SLOPE (T) 0.01A±						3950 S.F.± 175 S.F.± 190 S.F.± 440 S.F.± 160 S.F.±						
30C		40	REV. 161+76 LT.	167+05 LT.	0.25A±		ALL R.T. & I.						EXISTING VT. RTE. 101 R.O.W.						
30D		41	REV. 173+61 LT.	REV. 180+48 LT.	0.38A±		ALL R.T. & I.						EXISTING VT. RTE. 101 R.O.W.						
31A	LEBLANC, LAURENT & GEORGETTE	41	REV. 180+48 LT. REV. 181+83 LT. REV. 181+92 LT. REV. 182+15 LT.	REV. 181+70 LT. REV. 182+48 LT. REV. 182+35 LT.			SLOPE (T) 0.04A± DRIVE (T) SLOPE (T) 0.01A± INSTALL (T)	WD	11-22-89	TROY	49	III-12	1875 S.F.± 24' PAVED MM 0137 630 S.F.± CELLAR DRAIN	110	15	PARCEL NO. 26 GIGUERE; REVISE SLOPE (T) AREA AT STA. 140+00 LT. ~ 144+40 LT. FROM 0.24A± TO 0.28A± PER. CO. 07594	02-08-89	A. S. J.	L. W. B.
31B		41	REV. 180+48 LT.	REV. 182+47 LT.	0.12A±		ALL R.T. & I.						EXISTING VT. RTE 101 R.O.W.	111	29, 48	PARCEL NO. 51 STARR ESTATE; DELETED SLOPES AT STA. 279+35 RT. ~ 280+80 RT. & 282+70 RT. ~ 282+94 RT. & 283+06 RT. ~ 283+35 RT. DELETED TWO CONST. EASE (T) AT STA. 279+06 RT. ~ 282+84 RT. & 282+52 RT. TO 283+53 RT. ADD CONST. EASE (T) AT STA. 280+35 RT. TO 282+30 RT. ADD SLOPE (T) AT STA. 281+17 RT. ~ 281+88 RT. PER. CO. 7559	02-08-89	A. S. J.	L. W. B.
32A	MATTESICH, VIRGINA C.	41	REV. 182+47 LT. REV. 182+54 LT. REV. 183+07 LT. REV. 183+13 LT. REV. 183+14 LT. REV. 183+55 LT. REV. 184+00 LT. REV. 184+75 LT.	REV. 183+01 LT. REV. 183+40 LT. REV. 183+70 LT. REV. 185+21 LT. REV. 184+90 LT. REV. 184+95 LT.			SLOPE (T) 0.01A± REMOVE & RESET (T) DRIVE (T) SLOPE (T) 0.01A± SLOPE (T) 0.08A± SPECIAL DITCH (P) 0.02A± CUL. & DIT. (P)	WD	11-27-89	TROY	49	122-23	275 S.F.± FENCE 12' GRAVEL MM 0140 60 S.F.± FENCE D-9 3485 S.F.± 970 S.F.±	112	20, 43	PARCEL NO. 37 HERMANN; DELETED CUL. & DIT. (P) AT STA. 207+80 RT. DELETED CUL. (P) AT STA. 211+27 RT. DELETE CUL. & DIT. AT STA. 218+00 RT. REVISED BEG. STA. OF SLOPE (T) FROM 217+79 RT. TO 218+50 RT. CHANGE AREA FROM 0.09A± / 375 SF± TO READ 0.01A± / 680 SF± REVISED ENDING STA OF CONST. EASE FROM 219+38 RT. TO READ 219+34 RT. CHANGE AREA ALSO FROM 0.13A± TO 0.10A± PER. CO. 7590	02-09-89	A. S. J.	L. W. B.
32B		41	REV. 182+47 LT.	REV. 185+20 LT.	0.16A±		ALL R.T. & I.						EXISTING VT. RTE. 101 R.O.W.	113	36	PARCEL NO. 5 MORIN; EXTEND PAVING TO GARAGE PER. CO. 07583	02-09-89	A. S. J.	L. W. B.

ACCT. RYAN
ZFA2(1701)178E1420.DGN
PRF: 78E1420.DPR LV=51
DATE PLOTTED 15-JUN-1989
PROP. ACME N. 5-89

DR. RT.- DRAINAGE RIGHT
DIT. RT.- DITCHING RIGHT
CH. RT.- CHANNEL RT.
DRIVE RT.- DRIVE RIGHT
CUL. RT.- CULVERT RIGHT
ⓓ- DEMOLITION OR REMOVAL
W- WATER SOURCES

PRESENT R.O.W.
TAKING WITHOUT ACCESS
TAKING WITHOUT ACCESS ALONG PROPERTY LINE
TAKING WITH ACCESS
PERMANENT EASEMENT
TEMPORARY EASEMENT

LEGEND
--- CONST. EASE ---
SR SR
P
L
△ △ △
○ ○ ○

CONSTRUCTION EASEMENT
SLOPE RIGHTS
PROPERTY LINE
TOP OF CUT
TOE OF SLOPE

APPROVED: LAWRENCE BLISS, L.S. DATE: 3-10-87
AGENT D. PLANS & TITLES

MAY 19 1997

R. O. W. PLANS
TROY
RS 0311(1)
SHEET 18 OF 50

18

TABLE OF PROJECT PROPERTY ACQUISITION

STATE OF VERMONT
AGENCY OF TRANSPORTATION
RIGHT OF WAY PLANS
DETAIL SHEET

PARCEL NO.	GRANTOR	SHEET NO.	BEGINNING STATION	ENDING STATION	TAKING	REM.	RIGHTS	TITLE TAKEN	DATE	TOWN OR CITY RECORDED	BK.	PG.	REMARKS	REVISION NO.	SHEET	DESCRIPTION OF REVISION	DATE	MADE BY	APPROVED BY
33A	HAZUKA, EDWARD & ERNESTINE	41, 42	REV. 185+20 LT. REV. 185+20 LT. REV. 185+40 LT. REV. 186+00 LT. REV. 186+40 LT. REV. 189+90 LT. REV. 190+65 LT.	REV. 191+22 LT. REV. 190+95 LT. REV. 190+00 LT.	0.34A±	4.74A±	DRIVE (T) CONST. EASE. (T) 0.11A± SLOPE (P) 0.07A± ALL R.T. & I. DRIVE (T)	WD	11-27-89	TROY	49	120-21	FENCE D-10 12' GRAVEL MM 0144 3125 S.F.± WELL D-11 16' GRAVEL MM 0154	114	34, 50	PARCEL NO. 59 MAYHEW; DELETED SLOPE (T) STA 317+76 LT. ~ 319+64 LT. REVISED AREA OF SLOPE (T) STA. 319+31 LT. ~ 319+50 LT. FROM 55 SF± TO 136 SF± PER. CO. 07602	02-09-89	A. S. J.	L. W. B.
33B		41, 42	REV. 185+16 LT.	REV. 191+22 LT.	0.35A±		ALL R.T. & I.						EXISTING VT. RTE. 101 R.O.W.	115	32, 49	PARCEL NO. 54 THE M. & E. TRUST REVISED SLOPE (T) AREA 0.02A± / 940 SF± TO READ 0.01A± / 490 SF± PER. CO. 07596	02-09-89	A. S. J.	L. W. B.
33B		41, 42	REV. 185+16 LT.	REV. 191+22 LT.	0.35A±		ALL R.T. & I.						EXISTING VT. RTE. 101 R.O.W.	116	35A 46, 47	PARCEL NO. 68 HARRIS, GILMAN; CORRECT FROM VERNETA, TO VERNETTA; INCREASED AREA OF SLOPE (P) FROM 0.08A± TO 0.10A± INCREASED CONST. EASE. (T) FROM 0.07A± / 3275 SF± TO READ 0.08A± / 3380 SF± PER. CO. 07607	02-09-89	A. S. J.	L. W. B.
34A	DESCHENEUX, ROGER J. & JANICE	42	REV. 191+22 LT. 193+25 LT. 194+35 LT. 195+65 LT. 196+45 LT. 196+57 LT. 196+72 LT. 197+82 LT. 197+60 LT. 198+65 LT. 199+00 LT.	199+49 LT. 195+50 LT. 195+20 LT. 197+39 LT. 198+35 LT. 199+40 LT.	0.31A±	22.53A±	CONST. EASE. (T) 0.04A± SLOPE (P) 0.01A± SLOPE (P) 0.05A± DRIVE (T) SLOPE (P) 0.01A± DRIVE (T) SLOPE (P) 0.01A± CUL. & DIT. (P)	WD	1-19-90	TROY	49	282-83	1800 S.F.± 130 S.F.± 2286 S.F.± STONE PILLAR D-12 16' GRAVEL MM 0165 STONE PILLAR D-13 432 S.F.± 40' GRAVEL MM 0167 518 S.F.±	117	34, 50	PARCEL NO. 58 LENCE; DELETED SLOPE (T) BETWEEN STA. 317+56 RT. ~ 318+23 RT.; REVISED SLOPE (T) AREA STA. 317+89 RT. ~ 318+23 RT. FROM 400 SF± TO 140 SF± PER. CO. 7599	02-09-89	A. S. J.	L. W. B.
34B		42	191+22 LT.	199+50 LT.	0.47A±								EXISTING VT. RTE. 101 R.O.W.	118	34, 49 50	PARCEL NO. 60 V. STARR DELETED CONST. EASE. (T) STA. 313+37 RT. ~ 314+52 RT.; DELETED SLOPE (T) STA. 316+57 RT. ~ 317+02 RT. & SLOPE (T) STA. 317+14 RT. ~ 317+48 RT. DELETED SLOPES STA. 319+52 RT. ~ 319+76 RT.; 319+86 RT. ~ 319+96 RT.; 320+04 RT. ~ 320+19 RT. & 320+28 RT. ~ 320+46 RT. REVISE ENDING STA. FOR SLOPE (T) FROM 321+50 RT. TO 321+70 RT. & CHANGE AREA 0.01A± / 375 SF± TO READ 0.02A± / 952 SF± ADD SLOPE (T) 0.01A± / 365 SF± BETWEEN STA. 318+23 RT. ~ 319+20 RT. PER. CO. 07600	02-09-89	A. S. J.	L. W. B.
														119	33, 50	PARCEL NO. 56 J. STARR; 56C REVISED SLOPE (T) STA. 320+13 LT. ~ 321+50 LT. 0.04A± / 1600 SF± TO READ 320+32 LT. ~ 321+70 LT. 0.02A± / 1060 SF±; 56E REVISED SLOPE (T) BEG. STA. FROM 321+78 RT. TO READ 321+79 RT. & CHANGE AREA FROM 600 SF± TO 430 SF± 56C REVISED DRIVE FROM STA. 325+00 LT. TO STA. 324+68 LT. & MP 0405 TO MP 0404 REVISE CONST. EASE. (T) AREA STA. 320+13 LT. ~ 322+08 LT. FROM 0.04A± / 1890 SF± TO READ 0.06A± / 2430 SF± REVISE AREA OF SLOPE (T) STA. 309+82 LT. ~ 310+00 LT. FROM 0.01A± / 65 SF± TO 0.01A± / 22 SF± PER. CO. 7601	02-10-89	A. S. J.	L. W. B.

ACCT. RYAN
ZFA2470, J178E142D.DGN
PRF: 18E142D12.PRF
DATE PLOTTED 24-AUG-1989

DR. RT.- DRAINAGE RIGHT
DIT. RT.- DITCHING RIGHT
CH. RT.- CHANNEL RT.
DRIVE RT.- DRIVE RIGHT
CUL. RT.- CULVERT RIGHT
(D)- DEMOLITION OR REMOVAL
(W)- WATER SOURCES

PRESENT R.O.W.
TAKING WITHOUT ACCESS
TAKING WITHOUT ACCESS ALONG PROPERTY LINE
TAKING WITH ACCESS
PERMANENT EASEMENT
TEMPORARY EASEMENT

LEGEND

--- CONST. EASE. ---
SR SR
P
L
△ △ △
○ ○ ○

CONSTRUCTION EASEMENT
SLOPE RIGHTS
PROPERTY LINE
TOP OF CUT
TOE OF SLOPE

APPROVED: LAWRENCE BLISS, L.S. DATE: 3-10-87
AGENT D. PLANS & TITLES

R. O. W. PLANS

TROY
RS 0311(1)
SHEET 19 OF 50

TABLE OF PROJECT PROPERTY ACQUISITION

STATE OF VERMONT
AGENCY OF TRANSPORTATION
RIGHT OF WAY PLANS
DETAIL SHEET

PARCEL NO.	GRANTOR	SHEET NO.	BEGINNING STATION	ENDING STATION	TAKING	REM.	RIGHTS	TITLE TAKEN	DATE	TOWN OR CITY RECORDED	BK.	PG.	REMARKS	REVISION NO.	SHEET	DESCRIPTION OF REVISION	DATE	MADE BY	APPROVED BY
35A	FLORIO, ANTHONY J. & PATRICIA M.	42	199+49 LT. 200+05 LT. 201+00 LT.	201+14 LT.	0.01A±	1.15A±	DRIVE (T) DITCH (P)	WD	01-02-90	TROY	49	234-35	164 S.F. ± 16' GRAVEL MM 0172	120	26, 47	PARCEL NO. 46 FRICKE; REVISED 46A TAKE AREA FROM 0.06A± TO 0.07A± REVISE 46A CONST. EASE. (T) FROM 0.07A± TO 0.01A± 47E DELETE SLOPE (P) STA. 273+00 RT. ~ 273+41 RT. REVISE ENDING STA. FOR SLOPE (T) FROM 273+00 RT. TO READ 272+57 RT. & REVISE AREA OF SLOPE FROM 1382 SF± TO 1250 SF± REVISE ENDING STA. FOR CONST. EASE. (T) FROM 273+41 RT. TO 272+90 RT. & REVISE AREA FROM 0.05A± / 2360 SF± TO 0.03A± / 1550 SF± PER. CO. 07605	02-10-89	A. S. J.	L. W. B.
35B		42	199+49 LT.	201+14 LT.	0.09A±		ALL R. T. & I.						EXIST. VT. RTE. 101 R.O.W. 3936 S.F. ±						
36A	LOUX, HELENE A. LOUX, JAMES W., JR. & BARBARA H.	42, 43	201+14 LT. 201+14 LT. 201+14 LT. 202+00 LT. 202+05 LT.	205+77 LT. 201+36 LT. 205+75 LT. 205+75 LT. 205+00 LT.	0.15A±	11.85A±	REMOVE & RESET (T) SLOPE (T) 0.01A± DRIVE (T) SLOPE (P) 0.05A±	WD	6-15-89	TROY	48	325-326	FENCE 270 S.F. ± FENCE D-14 12' GRAVEL MM 0176 2100 S.F. ±	121	30, 47 48	PARCEL NO. 52 POULIN; REVISE ENDING STA. FOR CONST. EASE. (T) FROM 279+92 LT. TO READ 277+85 LT. & AREA FROM 0.02A± / 1175 SF± TO 0.03A± / 1236 SF±; REVISE DITCH STA. FROM 277+20 LT. TO 277+21 LT. REVISED CONST. EASE. (T) FROM 281+55 LT. ~ 283+30 LT. 0.03A± / 1700 SF± TO 282+40 LT. ~ 288+61 LT. 0.13A± DELETED CONST. EASE. (T) STA. 283+70 LT. ~ 284+90 LT. REVISE SLOPE (T) FROM 284+32 LT. ~ 284+65 LT. 0.01A± / 225 SF± TO 283+00 LT. ~ 286+50 LT. 0.07A± / 3025 SF± DELETED CONST. EASE. (T) STA. 287+15 LT. ~ 288+61 LT. PER. CO. 07607	02-10-89	A. S. J.	L. W. B.
36B		42, 43	201+14 LT.	205+75 LT.	0.36A±		ALL R. T. & I.						EXIST. VT. RTE. 101 R.O.W.						
37A	HERMANN GEORGE J. & HELENE M. CONT. ON NEXT SHEET 21	42, 43 44	203+42 RT. 203+44 RT. 203+44 RT. 204+00 RT. 204+07 RT. 205+25 RT. 206+72 RT. 207+80 RT. 211+27 RT. 214+40 RT. 214+85 RT. 217+40 RT. 218+50 RT. 218+00 RT. 218+40 RT. 219+40 RT. 219+45 RT.	220+03 LT. 203+80 RT. 204+75 RT. 206+50 RT. 212+50 RT. 206+50 RT. 212+50 RT. 219+34 RT. 216+40 RT. 217+75 RT. 218+50 RT. 218+40 RT. 219+40 RT. 219+45 RT.	1.94A±	13.06A±	SLOPE (P) 0.01A± CONST. EASE. (T) 0.02A± DRIVE (T) CONST. EASE. (T) 0.12A± DRAINAGE (P) DIT. DR. (P) CONST. EASE. (T) 0.10A± SLOPE (P) 0.01A± SPECIAL DITCH (P) 0.01A± SLOPE (T) 0.01A± DRAINAGE (P) REMOVE & RESET (T)	WD	1-24-90	TROY	49	290-91	125 S.F. ± 855 S.F. ± FENCE D-15 13' GRAVEL MM 0179 FENCE D-16 475 S.F. ± 110 S.F. ± 680 S.F. ± BRONZE DISC D-17 FENCE FENCE D-18	122	31, 48	PARCEL NO. 53 LETOURNEAU; REVISE AREA OF CONST. EASE. (T) STA. 288+60 LT. ~ 295+10 LT. FROM 014A± TO READ 0.15A± REVISE AREA FOR SLOPE (P) STA. 295+30 LT. ~ 296+90 LT. FROM 225 SF± TO 425 SF±; REVISE AREA FOR SLOPE (P) STA. 297+10 LT. ~ 298+00 LT. FROM 325 SF. TO 652 SF± REVISE ENDING STA. FOR CONST. EASE (T) FROM 300+00 RT. TO 292+35 RT. & AREA FROM 0.23A± TO 0.10A± REVISE SLOPE (T) ENDING STA. 291+80 RT. TO 292+00 & AREA FROM 0.03A± / 1500 SF± TO 0.04A± / 1600 SF REVISE BEG. STA. OF SLOPE (T) FROM 296+50 RT. TO 297+22 RT. & AREA FROM 560 SF± TO 84 SF± ADD CONST. EASE. (T) STA. 296+88 RT. ~ 300+00 RT. 0.04A± / 1570 SF± PER CO 07608	02-10-89	A. S. J.	L. W. B.
														123	20, 42	PARCEL NO. 35 FLORIO; TITLE CHANGE FROM MORRISSETTE, R.D. TO FLORIO, ANTHONY J. & PATRICIA M. ALSO CHANGE REM. FROM 0.98A± / 150 SF± TO 1.15A± & 164 SF± CHANGE TAKE FROM 0.08A± TO 0.09A± / 3936 SF± PER. CO. 07589	02-10-89	A. S. J.	L. W. B.

ACCT. RYAN
ZF42170J078E42D.DGN
PRF: 78E42D3.PRF LV=53
DATE PLOTTED 15-JUN-1989
PROP. ADEN. 5-89

DR. RT.- DRAINAGE RIGHT
DIT. RT.- DITCHING RIGHT
CH. RT.- CHANNEL RT.
DRIVE RT.- DRIVE RIGHT
CUL. RT.- CULVERT RIGHT
(D)- DEMOLITION OR REMOVAL
(W)- WATER SOURCES

PRESENT R.O.W.
TAKING WITHOUT ACCESS
TAKING WITHOUT ACCESS ALONG PROPERTY LINE
TAKING WITH ACCESS
PERMANENT EASEMENT
TEMPORARY EASEMENT

LEGEND

--- CONST. EASE. ---
SR SR
P
L
△ △ △
○ ○ ○

CONSTRUCTION EASEMENT
SLOPE RIGHTS
PROPERTY LINE
TOP OF CUT
TOE OF SLOPE

MAY 19 1997

APPROVED: LAWRENCE BLISS, L.S. DATE: 3-10-87
AGENT D. PLANS & TITLES

R. O. W. PLANS

TROY
RS 0311(1)
SHEET 20 OF 50

TABLE OF PROJECT PROPERTY ACQUISITION

STATE OF VERMONT
AGENCY OF TRANSPORTATION
RIGHT OF WAY PLANS
DETAIL SHEET

PARCEL NO.	GRANTOR	SHEET NO.	BEGINNING STATION	ENDING STATION	TAKING	REM.	RIGHTS	TITLE TAKEN	DATE	TOWN OR CITY RECORDED	BK.	PG.	REMARKS	REVISION NO.	SHEET	DESCRIPTION OF REVISION	DATE	MADE BY	APPROVED BY
37B	HERMANN, GEORGE J. & HELENE M. CONT. FROM SHEET 20	42-44	203+42 RT.	220+13 LT.	0.96A±		ALL R.T. & I.						EXIST. VT. RTE. 101 R.O.W.	124	19, 42	PARCEL NO. 34 DESCHENEUX; REVISE SLOPE (P) AREA STA. 195+65LT. ~ 197+39LT. FROM 0.03A± / 1560 SF± TO 0.5A± / 2286 SF± REVISE SLOPE (P) AREA STA. 197+82LT. ~ 198+35LT FROM 0.04A± / 460 SF± TO 0.01A± / 432 SF± PER C.O. 07587	02-13-89	A. S. J.	L. W. B.
38A	WURSTHORN, DAVID F.	43	205+75 LT. 205+75 LT. 207+46 LT. 209+50 LT.	210+18 LT. 210+16 LT. 209+57 LT.	0.27A±	11.73A±	CONST. EASE. (T) 0.04A± DRIVE (T)	COND	02-26-90	TROY	49	349-362	FENCE D-19 1605 S.F.± 16' GRAVEL MM 0190	125	28	PARCEL NO. 50 MCDERMUT; DELETE SLOPE (P) AT STA. 273+55 LT. ~ 273+95 LT. 0.01A± / 430 SF± PER C.O. 07615	02-16-89	A. S. J.	L. W. B.
38B		43	205+75 LT.	210+16 LT.	0.27A±		ALL R.T. & I.						EXIST. VT. RTE. 101 R.O.W.	126	26	PARCEL NO. 46 FRICKE; CHANGE TAKING FROM 0.07A± 2979 SF± TO 0.01A± 4500 S.F.± PER C.O. 7656	03-20-89	A. S. J.	L. W. B.
39A	JOHNSON, KAREN K.	43	210+16 LT. 210+16 LT. 210+18 LT. 210+50 LT. 217+50 LT.	212+78 LT. 212+78 LT. 212+45 LT.	0.12A±	125.88A±	CONST. EASE. (T) 0.02A± DRIVE (T)	COND	02-26-90	TROY	49	349-362	FENCE D-20 890 S.F.± 16' GRAVEL MM 0191 16' GRAVEL DRIVE MM 0205	127	24, 46	PARCEL NO. 42 JACOBS. CHANGE CONST. EASE. FROM REV. 253+80 LT. ~ REV. 255+99 LT. TO REV. 253+80 LT. ~ REV. 255+85 LT., 1195 S.F.±. CHANGE SLOPE(P) FROM REV. 254+54 LT. ~ REV. 255+99 LT., 0.03A±, 1662 S.F.± TO REV. 254+54 LT. ~ REV. 255+37 LT., 0.01A±, 581 S.F.±. PER C.O. 7686	5-17-89	M. J. R.	E. A. F.
														128	25, 46	PARCEL NO. 44 FADIMAN. DELETE SLOPE (T) REV. 255+99 LT. ~ REV. 257+62 LT. DELETE CONST. EASE. (T) REV. 255+99 LT. ~ REV. 256+50 LT. PER C.O. 7685	5-17-89	M. J. R.	E. A. F.
														129	18, 40	PARCEL NO. 30 CHANGED P/L AND RIGHTS WHICH REFLECTED SELL OFF TO PARCEL 69. PER C.O. 7705.	6-12-89	A. S. J.	J. D. P.
														130	35A	PARCEL NO. 69 CHANGED P/L AND RIGHTS WHICH REFLECTED SELL OFF TO PARCEL 30. PER C.O. 7704.	6-12-89	A. S. J.	J. D. P.
														131	34, 50	PARCEL NO. 60 STARR. ADD TRANSPLANT (T) AT 320+85 RT., 2-2' PINES. PER C.O. 7760.	8-08-89	M. J. R.	L. W. B.
														132	14, 38	PARCEL NO. 22 LEMIEUX. ADD CUL. (P) AT 133+65 LT. ~ 134+69 LT. PER C.O. 7757.	8-08-89	M. J. R.	L. W. B.
														133	17, 38	PARCEL NO. 29 BRISSETT. DELETE CUL. (P), AND DIT. & DR. (P). DELETE CULVERT AT STA. 133+00 CL. PER C.O. 7759.	8-08-89	M. J. R.	L. W. B.
														134	9	PARCEL NO. 4 WATTS. CHANGE REMAINDER TO 0.73A± PER C.O. 7758.	8-08-89	M. J. R.	L. W. B.
														135	25, 46	PARCEL NO. 44 FADIMAN. DELETE REFERENCE TO TWO TEMPORARY RIGHTS INVOLVING BARBED WIRE FENCING. PER C.O. 7762.	8-08-89	M. J. R.	L. W. B.

ACCT. RYAN
ZF:\E\TO\115E\420.DGN
PRF: 78E\420\4\PRF LV:54
DATE PLOTTED 2-MAY-1990

DR. (T)- DRAINAGE RIGHT
DIT. (T)- DITCHING RIGHT
CH. (T)- CHANNEL RT.
DRIVE (T)- DRIVE RIGHT
CUL. (T)- CULVERT RIGHT
[W]- WATER SOURCES

PRESENT R.O.W.
TAKING WITHOUT ACCESS
TAKING WITHOUT ACCESS ALONG PROPERTY LINE
TAKING WITH ACCESS
PERMANENT EASEMENT
TEMPORARY EASEMENT

LEGEND
CONST. (T)
SR SR
P
L
TOP OF CUT
TOE OF SLOPE
CONSTRUCTION EASEMENT
SLOPE RIGHTS
PROPERTY LINE
TOP OF CUT
TOE OF SLOPE

APPROVED: LAWRENCE BLISS, L.S. DATE: 3-10-87
AGENT D. PLANS & TITLES
MAY 19 1997

R. O. W. PLANS

TROY
RS 0311(1)
SHEET 21 OF 50

TABLE OF PROJECT PROPERTY ACQUISITION

STATE OF VERMONT
AGENCY OF TRANSPORTATION
RIGHT OF WAY PLANS
DETAIL SHEET

PARCEL NO.	GRANTOR	SHEET NO.	BEGINNING STATION	ENDING STATION	TAKING	REM.	RIGHTS	TITLE TAKEN	DATE	TOWN OR CITY RECORDED	BK.	PG.	REMARKS	REVISION NO.	SHEET	DESCRIPTION OF REVISION	DATE	MADE BY	APPROVED BY
39B	JOHNSEN, KAREN K. CONT. FROM SHEET 21	43	210+16 LT.	212+77 LT.	0.15A±		ALL R.T. & I.						EXIST. VT. RTE. 101 R.O.W.	136	34, 50	PARCEL NO. 59 MAYHEW. MOVE TAKE LINE IN 5'. DECREASE TAKE AREA TO 0.04A±, 1786 S.F.±. CHANGE REMAINDER TO 0.65A±. INCREASE SLOPE (T) AREA TO 338 S.F.±. PER C.O. 7765.	8-14-89	M. J. R.	J. D. P.
39C		43	215+55 LT.	219+59 LT.	0.23A±		ALL R.T. & I.						EXIST. VT. RTE. 101 R.O.W.	137	19, 41	PARCEL NO. 33 HAZUKA. DELETE REMOVE & RESET (T) FOR FENCE AT REV. 185+20 LT. PER C.O. 7767.	8-16-89	M. J. R.	J. D. P.
40A	BEERWORTH, STEVEN G. & MARY C.	43	212+77 LT. 213+05 LT. 214+13 LT. 214+50 LT.	213+40 LT. 214+86 LT.			SPECIAL DITCH REMOVE & RESET (P) REMOVE & RESET (T) REMOVE & RESET (T) DRIVE (T)	WD	09-25-89	TROY	48	542-543	590 S.F.± FENCE FENCE 16' GRAVEL MM 0199	138	33	PARCEL NO. 56 STARR. CHANGE AREA FROM 0.26A± TO 0.53A± PER. CO. 7794	9-26-89	A. S. J.	J. D. P.
40B		43	212+77 LT.	215+60 LT.	0.16A±		ALL R.T. & I.						EXIST. VT. RTE. 101 R.O.W.	139	19	PARCEL NO. 33 HAZUKA. ADD ALL R.T. & I. WELL AT STA. 189+90 LT. PER. CO. 7791	9-26-89	A. S. J.	J. D. P.
41A	STARR, JACK E., SR. & ILA B. CONT. ON SHEET 23	44, 45	REV. 225+00 LT. REV. 225+84 LT. REV. 230+50 LT. REV. 233+25 LT. REV. 235+21 LT.	REV. 237+24 LT. REV. 237+21 LT.	0.85A±		DRIVE (T) DITCH (P) RESET (T)	COND	2-26-90	TROY	49	349-62	27' GRAVEL MM 0221 FENCE D-21 12' GRAVEL DRIVE MM 0239	140	27, 46	PARCEL NO. 47 GREENE. SKEW NEW PIPE TO LINE UP WITH EXISTING DITCH. CHANGE STA. OF CUL. DIT. & DR. (P) FROM REV. 264+41 RT. TO REV. 246+26 RT. PER. CO. 7790	10-3-89	M. J. R.	F. J. M.
														141	32, 49	PARCEL NO. 54 M. & E. TRUST ADD 12' DRIVE AT STA. 305+66 LT. PER. CO. 7795	10-6-89	A. S. J.	L. W. B.
														142	35, 49	PARCEL NO. 60 STARR. MOVE WATERLINE & SLEEVE TO STA. 319+43 LT. ~319+62 RT. A16' GRAVEL DRIVE AT STA. 309+20 RT. CHANGE DRAINAGE TO STA. 310+15 RT. PER C.O. 7796	10-19-89	A. S. J.	F. J. M.
														143	48, 49	PARCEL NO. 53 LETOURNEAU. ADD CONCRETE BARNYARD PAD. MODIFY DITCH & CONSTRUCT SHALLOW SWALE. PER C.O. 7822	11-21-89	J. D. P.	J. D. P.
														144	28	PARCEL NO 48, 8, 49 CHANGE REMAINDER OF PARCEL 48 FROM 0.73A± TO 0.85A± AND PARCEL 49 FROM 0.74A± TO 0.87A± PER CO. 7841	12-01-89	A. S. J.	<i>E.H.S.</i>
														145	33, 50	PARCEL NO 56 STARR. ADD DRIVE (T) AT STA. 322+61 RT. ALSO GRAVEL TURNAROUND AT STA. 325+00 RT. IS TO BE LEFT ALONE PER CO. 7821	12-01-89	A. S. J.	<i>E.H.S.</i>
														146	35A, 46 47	PARCEL NO 68 HOME & CITY SAVINGS BANK TITLE CHANGE FROM HARRIS TO HOME & CITY SAVINGS BANK PER CO. 7864	01-19-90	A. S. J.	<i>L.W.B.</i>
														147	21, 43	PARCEL NO 39 JOHNSEN. DELETE SLOPE AT STA. 210+18 LT. ~ 210+50 LT. CHANGE CONST. EASE (T) TO 210+18 LT ~ 212+45 LT. 890 SF.±. DELETE REMOVE & RESET FENCE, SPECIAL DITCH, CULVERT RT. AND DELETED ALSO THE REMOVE & RESET FENCE PER CO. 7869	01-25-90	A. S. J.	J. D. P.

ACCT. RYAN
ZFHX70J078E1420.DGN
PRF: 78E14205.PRF
DATE PLOTTED 30-NOV-1989

DR. RT.- DRAINAGE RIGHT
DIT. RT.- DITCHING RIGHT
CH. RT.- CHANNEL RT.
DRIVE RT.- DRIVE RIGHT
CUL. RT.- CULVERT RIGHT
(D)- DEMOLITION OR REMOVAL
(W)- WATER SOURCES

PRESENT R.O.W.
TAKING WITHOUT ACCESS
TAKING WITHOUT ACCESS ALONG PROPERTY LINE
TAKING WITH ACCESS
PERMANENT EASEMENT
TEMPORARY EASEMENT

LEGEND
--- CONST. EASEL ---
SR SR
P L
TOP OF CUT
TOE OF SLOPE

CONSTRUCTION EASEMENT
SLOPE RIGHTS
PROPERTY LINE
TOP OF CUT
TOE OF SLOPE

MAY 19 1997
APPROVED: LAWRENCE BLISS, L.S. DATE: 3-10-87
AGENT D. PLANS & TITLES

R.O.W. PLANS
TROY
RS 0311(1)
SHEET 22 OF 50

TABLE OF PROJECT PROPERTY ACQUISITION

STATE OF VERMONT
AGENCY OF TRANSPORTATION
RIGHT OF WAY PLANS
DETAIL SHEET

PARCEL NO.	GRANTOR	SHEET NO.	BEGINNING STATION	ENDING STATION	TAKING	REM.	RIGHTS	TITLE TAKEN	DATE	TOWN OR CITY RECORDED	BK.	PG.	REMARKS	REVISION NO.	SHEET	DESCRIPTION OF REVISION	DATE	MADE BY	APPROVED BY
41B	STARR, JACK E., SR. & ILLA B. CONT. FROM SHEET 22	43, 44 45	219+47 RT. 219+31 RT. 219+40 RT. 220+50 RT. 221+50 RT. 224+00 RT. 224+13 RT. REV. 225+82 RT. REV. 230+50 RT. REV. 232+95 RT. REV. 236+43 RT. REV. 236+78 RT. REV. 237+00 RT. REV. 237+20 RT. REV. 238+27 RT. 219+47 RT.	REV. 239+02 RT. REV. 228+83 RT. REV. 223+75 RT. REV. 226+25 RT. REV. 242+03 RT. REV. 237+85 RT. REV. 239+02 RT. REV. 260+96 RT.	1.70A±		CONST. EASE. (T) 0.18A± SLOPE (P) 0.08A± CUL. DIT. & DR. (P) CUL. DIT. & DR. (P) DITCH & DR. (P) SLOPE (T) 0.02A± DRIVE (T) DRAINAGE (P) CONST. EASE. (T) 0.12A± DITCH & DR. (P) DRIVE (T) REMOVE & RESET (T) REMOVE & RESET (T) SLOPE (P) 0.01A±						3425 S.F. ± 804 S.F. ± 12' GRAVEL MM 0221 13' GRAVEL DRIVE MM 0234 18' GRAVEL MM 0242 FENCE 150 S.F. ±	148	21, 43	PARCEL NO. 36 WURSTHORN. CHANGE DRIVE FROM 210+05 LT. TO 209+50 LT. CHANGE ENDING STA. OF CONST. EASE. FROM 210+20 LT. TO 209+57 LT., 0.04A±, 1605 S.F. ± PER C.O. 7874 MYLARS TO DESIGN	02-07-90	M. J. R.	J. D. P.
41C		43, 44 45	219+50 LT. 219+59 LT. 221+50 LT. 222+31 LT. REV. 237+25 LT.	REV. 246+94 RT. REV. 237+21 LT. REV. 246+94 RT.	2.79A±	30.21A±	ALL R.T. & I. DITCH (P) RESET (T)						EXIST. VT. RTE. 101 R.O.W. 12' GRAVEL DRIVE MM 0214 FENCE D-22	149	46	PARCEL NO. 42 JACOBS & THURSTON. ADD SEPTIC TANK & LEACH FIELD TO LAYOUT. ADD NOTE 'DO NOT DISTURB' PER C.O. 7897	03-09-90	M. J. R.	L. W. B.
41D		46	REV. 253+64 RT. REV. 253+61 RT. REV. 253+64 RT. REV. 253+72 RT. REV. 254+19 RT. REV. 254+23 RT. REV. 254+76 RT. REV. 256+53 RT. REV. 259+47 RT. REV. 260+35 RT.	REV. 260+96 RT. REV. 254+20 RT. REV. 253+82 RT. REV. 254+74 RT. REV. 254+75 RT. REV. 260+96 RT.	0.34A±		RESET (T) REMOVE & RESET (T) SLOPE (T) 0.02A± CUL. DIT. & DR. (P) DIT & CUL. (P) DRIVE (T) CONST. EASE. (T) 0.02A± DIT. & DR. (P)						FENCE D-8 FENCE 846 S.F. ± 12' GRAVEL MM 0275 12' GRAVEL DRIVE MM 0279 1250 S.F. ±	150	21, 43	PARCEL NO. 39 JOHNSON. ADD DRIVE AT 210+50 RT. 16' GRAVEL. PER C.O. 7917	04-30-90	M. J. R.	L. W. B.
														151	35A, 40	PARCEL NO. 69 LONGLEY. CHANGE SLOPE (P) TO SLOPE (T). PER C.O. 7992. NEW MYLARS TO DESIGN.	11-07-90	M. J. R.	L. W. B.
														152	44	PARCEL NO. 41 STARR INSTALL CONDUIT FOR ELECTRIC & TELEPHONE SERVICE AT STA. REV. 233+85. PER C.O. 8050.	6-03-92	M. J. R.	L. W. B.
	CONT. ON SHEET 24																		

ACCT, RYAN
ZFHL70, J178E1420.DGN
PRF: 78E142016.PRF LV:56
DATE PLOTTED 2-MAY-1990

DR. (T)- DRAINAGE RIGHT
DIT. (T)- DITCHING RIGHT
CH. (T)- CHANNEL RT.
DRIVE (T)- DRIVE RIGHT
CUL. (T)- CULVERT RIGHT
[W]- WATER SOURCES

PRESENT R.O.W.
TAKING WITHOUT ACCESS
TAKING WITHOUT ACCESS ALONG PROPERTY LINE
TAKING WITH ACCESS
PERMANENT EASEMENT
TEMPORARY EASEMENT

LEGEND
CONST. (T)
SR SR
P
L
CONSTRUCTION EASEMENT
SLOPE RIGHTS
PROPERTY LINE
TOP OF CUT
TOE OF SLOPE

APPROVED: LAWRENCE BLISS, L.S. DATE: 3-10-97
AGENT D. PLANS & TITLES

R. O. W. PLANS

TROY
RS 0311(1)
SHEET 23 OF 50

TABLE OF PROJECT PROPERTY ACQUISITION

STATE OF VERMONT
AGENCY OF TRANSPORTATION
RIGHT OF WAY PLANS
DETAIL SHEET

PARCEL NO.	GRANTOR	SHEET NO.	BEGINNING STATION	ENDING STATION	TAKING	REM.	RIGHTS	TITLE TAKEN	DATE	TOWN OR CITY RECORDED	BK.	PG.	REMARKS	REVISION NO.	SHEET	DESCRIPTION OF REVISION	DATE	MADE BY	APPROVED BY
41E	STARR, JACK E., SR. & I LA B. CONT. FROM SHEET 23	46	REV. 253+63 RT. REV. 256+18 RT.	REV. 260+93 RT. REV. 260+96 RT.	0.35A±		ALL R. T. & I. RESET (T)						EXIST. VT. RTE. 101 R. O. W. FENCE D-23						
41F		45	REV. 239+75 RT. REV. 240+02 RT. REV. 241+76 RT. REV. 243+60 RT. REV. 243+79 RT. REV. 245+03 RT. REV. 246+94 RT.	REV. 246+96 RT REV. 245+62 RT. REV. 245+03 RT. REV. 246+96 RT.	0.09A±		DRIVE (T) DIT. & DR. (P) CONST. EASE. (T) 0.04A± SLOPE (T) 0.01A± DRAINAGE (P) RESET (T)						4059 S. F. ± 12' GRAVEL MM 0247 1873 S. F. ± 592 S. F. ± FENCE						
42A	JACOBS, GARY P. THURSTON, LEON A.	45, 46	REV. 237+21 LT. REV. 237+24 LT. REV. 238+90 LT. REV. 239+88 LT. REV. 241+76 LT. REV. 243+02 LT. REV. 250+42 LT. REV. 252+03 LT. REV. 252+75 LT. REV. 253+10 LT. REV. 253+72 LT. REV. 253+80 LT. REV. 254+00 LT. REV. 254+54 LT.	REV. 255+99 LT. REV. 251+52 LT. REV. 251+50 LT. REV. 241+65 LT. REV. 253+55 LT. REV. 255+99 LT. REV. 255+85 LT. REV. 254+25 LT. REV. 255+37 LT.	1.50A±	86.72A±	RESET (T) CONST. EASE. (T) 0.20A± SLOPE (P) 0.01A± DITCH (P) DRIVE (T) SLOPE (P) 0.04A± DRIVE (T) DRIVE (T) RESET (T) DRIVE (T) CONST. EASE. (T) 0.03A± CUL. & DIT. (P) SLOPE (P) 0.01A±	COND	2-26-90	TROY	49	349-62	FENCE D-24 576 S. F. ± 12' GRAVEL MM 0253 2087 S. F. ± 12' GRAVEL MM 0270 12' GRAVEL MM 0272 FENCE D-25 12' GRAVEL MM 0273 1195 S. F. ± 581 S. F. ±						
42B		45, 46	REV. 246+94 RT. REV. 246+94 RT. REV. 248+36 RT. REV. 248+52 RT. REV. 249+69 RT. REV. 251+03 RT. REV. 253+03 RT.	REV. 250+50 RT. REV. 253+64 RT. REV. 250+59 RT. REV. 250+30 RT.	0.10A±	4.5A±	CONST. EASE. (T) 0.05A± DIT. & DR. (P) SLOPE (T) 0.01A± DRIVE (T) DRIVE (T)						2287 S. F. ± 165 S. F. ± 22' GRAVEL MM 0268 16' GRAVEL MM 0272						
42C		45, 46	REV. 237+24 LT. REV. 246+94 RT.	REV. 255+99 LT. REV. 250+58 RT.	1.48A±		ALL R. T. & I RESET (T)						EXIST. VT. RTE. 101 R. O. W. FENCE D-26						

DR. RT.- DRAINAGE RIGHT
DIT. RT.- DITCHING RIGHT
CH. RT.- CHANNEL RT.
DRIVE RT.- DRIVE RIGHT
CUL. RT.- CULVERT RIGHT
DEMOLITION OR REMOVAL
WATER SOURCES

PRESENT R.O.W.
TAKING WITHOUT ACCESS
TAKING WITHOUT ACCESS ALONG PROPERTY LINE
TAKING WITH ACCESS
PERMANENT EASEMENT
TEMPORARY EASEMENT

LEGEND
CONST. EASE.
SR SR
P
L
TOP OF CUT
TOE OF SLOPE

CONSTRUCTION EASEMENT
SLOPE RIGHTS
PROPERTY LINE
TOP OF CUT
TOE OF SLOPE

APPROVED: LAWRENCE BLISS, L.S. DATE: 3-10-97
AGENT D, PLANS & TITLES

MAY 19 1997

R.O.W. PLANS
TROY
RS 0311(1)
SHEET 24 OF 50

TABLE OF PROJECT PROPERTY ACQUISITION

STATE OF VERMONT
AGENCY OF TRANSPORTATION
RIGHT OF WAY PLANS
DETAIL SHEET

PARCEL NO.	GRANTOR	SHEET NO.	BEGINNING STATION	ENDING STATION	TAKING	REM.	RIGHTS	TITLE TAKEN	DATE	TOWN OR CITY RECORDED	BK.	PG.	REMARKS	REVISION NO.	SHEET	DESCRIPTION OF REVISION	DATE	MADE BY	APPROVED BY
43	SOLD												FORMERLY V. STARR NOW PART OF 41D & 41E J. & I. STARR						
44A	FADIMAN, MARY LOU AND JONATHAN R.	46	REV. 255+99 LT. REV. 257+74 LT.	REV. 257+88 LT.	C. 07A±	0.79A±	DRIVE (T)	COND	2-26-90	TROY	49	349-62	15' GRAVEL MM 0281						
44B		46	REV. 255+98 RT.	REV. 257+90 LT.	C. 11A±		ALL R. T. & I.						EXIST. VT. RTE. 101 R.O.W.						
45A	CUTTING, STEVEN H., SR. & DIANE S.	46	REV. 257+88 LT. REV. 259+34 LT. REV. 260+35 LT.	REV. 260+90 LT.	C. 07A±	2.32A±	DITCH (P)	WD	1-24-90	TROY	49	293	16' PAVED DRIVE MM 0284						
45B		46	REV. 257+88 LT.	REV. 260+90 LT.	C. 17A±		ALL R. T. & I.						EXIST. VT. RTE. 101 R.O.W.						

ACCT. RYAN
ZFA24270J078E42D.DGN
PRF: 78E42DIB.PRF LV:58
DATE PLOTTED 9-AUG-1989

DR. RT.- DRAINAGE RIGHT
DIT. RT.- DITCHING RIGHT
CH. RT.- CHANNEL RT.
DRIVE RT.- DRIVE RIGHT
CUL. RT.- CULVERT RIGHT
(D)- DEMOLITION OR REMOVAL
(W)- WATER SOURCES

--- --
--- P ---
--- L ---
(P)
(T)

PRESENT R.O.W.
TAKING WITHOUT ACCESS
TAKING WITHOUT ACCESS ALONG PROPERTY LINE
TAKING WITH ACCESS
PERMANENT EASEMENT
TEMPORARY EASEMENT

LEGEND

--- CONST. EASE. ---
SR SR
P
L
△
○

CONSTRUCTION EASEMENT
SLOPE RIGHTS
PROPERTY LINE
TOP OF CUT
TOE OF SLOPE

APPROVED: LAWRENCE BLISS, L.S. DATE: 3-10-87
AGENT D, PLANS & TITLES

MAY 19 1987

R. O. W. PLANS

TROY
RS 0311(1)
SHEET 25 OF 50

TABLE OF PROJECT PROPERTY ACQUISITION

STATE OF VERMONT
AGENCY OF TRANSPORTATION
RIGHT OF WAY PLANS
DETAIL SHEET

PARCEL NO.	GRANTOR	SHEET NO.	BEGINNING STATION	ENDING STATION	TAKING	REM.	RIGHTS	TITLE TAKEN	DATE	TOWN OR CITY RECORDED	BK.	PG.	REMARKS	REVISION NO.	SHEET	DESCRIPTION OF REVISION	DATE	MADE BY	APPROVED BY
46A	FRICKE, PAUL H.	46	REV. 260+93 RT. REV. 260+96 RT. REV. 260+93 RT. REV. 260+96 RT. REV. 262+06 RT. REV. 260+96 RT.	REV. 262+43 RT. REV. 261+91 RT. REV. 261+93 RT. 274+07 RT.	0.0 A±		CONST. EASE. (T) 0.01A± REMOVE & RESET (T) RESET (T) DRIVE (T) 47.31A±	WD	01-02-90	TROY	49	231-32	4500 S.F. ± 440 S.F. ± FENCE FENCE D-28 16' GRAVEL MM 0289 FORMERLY DONNELLY 1557 S.F. ± 14' GRAVEL MM 0295 50 S.F. ± EXIST. VT. RTE. 101 R.O.W. 3787 S.F. ±						
46B	SOLD																		
46C		46	REV. 264+89 RT. REV. 265+02 RT. REV. 265+07 RT.	REV. 265+90 RT. REV. 265+25 RT.	0.03A±		DRIVE (T) SLOPE (T) 0.01A±												
46D	CONT. ON SHEET 27 PARCEL 46E	46	REV. 260+90 RT.	REV. 262+42 LT.	0.08A±		ALL R.T. & L.												

PROP. ACQ. N. 5-87

DR. RT.- DRAINAGE RIGHT
DIT. RT.- DITCHING RIGHT
CH. RT.- CHANNEL RT.
DRIVE RT.- DRIVE RIGHT
CUL. RT.- CULVERT RIGHT
(D)- DEMOLITION OR REMOVAL
(W)- WATER SOURCES

--- -- -- -- --
--- -- -- -- --
--- -- -- -- --
--- -- -- -- --
(P)
(T)

PRESENT R.O.W.
TAKING WITHOUT ACCESS
TAKING WITHOUT ACCESS ALONG PROPERTY LINE
TAKING WITH ACCESS
PERMANENT EASEMENT
TEMPORARY EASEMENT

LEGEND

--- -- -- -- --
SR SR
P
L
--- -- -- -- --
--- -- -- -- --

CONSTRUCTION EASEMENT
SLOPE RIGHTS
PROPERTY LINE
TOP OF CUT
TOE OF SLOPE

APPROVED: LAWRENCE BLISS, L.S. DATE: 3-10-87
AGENT D. PLANS & TITLES

MAY 19 1997

R. O. W. PLANS

TROY
RS 0311(1)
SHEET 26 OF 50

**STATE OF VERMONT
AGENCY OF TRANSPORTATION
RIGHT OF WAY PLANS
DETAIL SHEET**

27

TABLE OF PROJECT PROPERTY ACQUISITION

STATE OF VERMONT
AGENCY OF TRANSPORTATION
RIGHT OF WAY PLANS
DETAIL SHEET

PARCEL NO.	GRANTOR	SHEET NO.	BEGINNING STATION	ENDING STATION	TAKING	REM.	RIGHTS	TITLE TAKEN	DATE	TOWN OR CITY RECORDED	BK.	PG.	REMARKS	REVISION NO.	SHEET	DESCRIPTION OF REVISION	DATE	MADE BY	APPROVED BY
47B	GREENE, GORDON & MARION CONT. FROM SHEET 27	46	REV. 262+42 RT.	REV. 264+90 CL.	0.14A±		ALL R. T. & I.						EXISTING VT. RTE. 101 R.O.W.						
48A	SABO, DENNIS J. & ELGA M.	46	REV. 265+89 RT. REV. 265+89 RT. REV. 266+56 RT.	REV. 267+88 RT. REV. 267+88 RT. REV. 267+88 RT.	0.07A±	0.85A±	CONST. EASE. (T) 0.04A± SLOPE (T) 0.01A±	COND	2-26-90	TROY	49	349-62	4000 S.F. ± 1720 S.F. ± 611 S.F. ±						
48B		46	REV. 265+89 RT.	REV. 267+88 RT.	0.12A±		ALL R. T. & I.						EXISTING VT. RTE. 101 R.O.W.						
49A	AUGER, GEORGETTE	46, 47	REV. 267+88 RT. REV. 267+88 RT. REV. 267+88 RT. REV. 268+02 RT. REV. 269+02 RT. REV. 269+18 RT.	REV. 269+88 RT. REV. 268+94 RT. REV. 269+87 RT. REV. 269+70 RT.	0.05A±	0.87A±	SLOPE (T) 0.01A± CONST. EASE. (T) 0.02A± DIT. & DR. (P) DRIVE (T) SLOPE (T) 0.01A±	COND	2-26-90	TROY	49	349-62	2820 S.F. ± 351 S.F. ± 1080 S.F. ± 12' GRAVEL MM 0302 153 S.F. ±						
49B		46, 47	REV. 267+88 RT.	REV. 269+89 RT.	0.13A±		ALL R. T. & I.						EXISTING VT. RTE. 101 R.O.W.						
50A	MCDERMUT, IRENE CONT. ON SHEET 29	47	REV. 268+16 LT. REV. 268+16 LT. REV. 268+18 LT. REV. 268+20 LT. REV. 271+40 LT.	RTE. 242 52+00 LT. REV. 269+53 LT. REV. 270+97 LT. REV. 271+40 LT.	0.44A±	5.56A±	SLOPE (P) 0.14A± CONST EASE. (T) 0.07A± DITCH (P)	COND	2-26-90	TROY	49	349-62	FENCE D-31 3192 S.F. ±						

DR. RT.- DRAINAGE RIGHT
DIT. RT.- DITCHING RIGHT
CH. RT.- CHANNEL RT.
DRIVE RT.- DRIVE RIGHT
CUL. RT.- CULVERT RIGHT
ⓓ- DEMOLITION OR REMOVAL
W- WATER SOURCES

PRESENT R.O.W.
TAKING WITHOUT ACCESS
TAKING WITHOUT ACCESS ALONG PROPERTY LINE
TAKING WITH ACCESS
PERMANENT EASEMENT
TEMPORARY EASEMENT

LEGEND
--- CONST. EASE. ---
SR SR
P
L
△ △ △
○ ○ ○

CONSTRUCTION EASEMENT
SLOPE RIGHTS
PROPERTY LINE
TOP OF CUT
TOE OF SLOPE

MAY 19 1997
APPROVED: LAWRENCE BLISS, L.S. DATE: 3-10-97
AGENT D, PLANS & TITLES

R. O. W. PLANS
TROY
RS 0311(1)
SHEET 28 OF 50

TABLE OF PROJECT PROPERTY ACQUISITION

STATE OF VERMONT
AGENCY OF TRANSPORTATION
RIGHT OF WAY PLANS
DETAIL SHEET

PARCEL NO.	GRANTOR	SHEET NO.	BEGINNING STATION	ENDING STATION	TAKING	REM.	RIGHTS	TITLE TAKEN	DATE	TOWN OR CITY RECORDED	BK.	PG.	REMARKS	REVISION NO.	SHEET	DESCRIPTION OF REVISION	DATE	MADE BY	APPROVED BY
50B	MCDERMOTT, IRENE CONT. FROM SHEET 28	47	REV. 268+09 RT.	RTE. 242 52+00 LT.	0.55A±		ALL R. T. & I.						EXISTING VT. RTE. 101 R. O. W. & RTE. 242						
51A	STARR, HAZEL - ESTATE STARR, URBAN R., SR. - EXECUTOR	47, 48	274+07 RT. 274+10 RT. 275+00 RT. 275+40 RT. 276+31 RT. 277+21 RT. 277+21 RT. 280+38 RT. 281+19 RT. 282+07 RT. 283+00 RT. 284+00 RT. 285+20 RT. 285+50 RT.	288+65 RT. 276+31 RT. 277+67 RT. 282+35 RT. 277+55 RT. 282+42 RT. 281+95 RT. 288+65 RT. 288+65 RT.	0.79A±	151.02A±	RESET (T) DRAINAGE (P) CONST. EASE. (T) 0.04A± RESET (T) CUL. DIT. & DR (P) SLOPE (T) 0.01A± CONST. EASE. (T) 0.03A± SLOPE (T) 0.01A± DIT. & DR. (P) DRIVE (T) DRAINAGE (P) CONST. EASE. (T) 0.08A± SLOPE (T) 0.05A±	WD	2-13-91	TROY	50	532- 535	FENCE D-32 1945 S.F.± FENCE D-32 33 S.F.± 1500 S.F.± 234 S.F.± 12' GRAVEL MM 0329 3650 S.F.± 2350 S.F.±						
51B		47, 48	274+10 RT.	288+69 LT.	0.99A±		ALL R. T. & I.						EXISTING VT. RTE. 101 R. O. W.						

DR. RT.- DRAINAGE RIGHT
DIT. RT.- DITCHING RIGHT
CH. RT.- CHANNEL RT.
DRIVE RT.- DRIVE RIGHT
CUL. RT.- CULVERT RIGHT
(D)- DEMOLITION OR REMOVAL
(W)- WATER SOURCES

PRESENT R.O.W.
TAKING WITHOUT ACCESS
TAKING WITHOUT ACCESS ALONG PROPERTY LINE
TAKING WITH ACCESS
PERMANENT EASEMENT
TEMPORARY EASEMENT

LEGEND
--- CONST. EASE. ---
SR SR
P
L
△ △ △
○ ○ ○

CONSTRUCTION EASEMENT
SLOPE RIGHTS
PROPERTY LINE
TOP OF CUT
TOE OF SLOPE

MAY 19 1997
APPROVED: LAWRENCE BLISS, L.S. DATE: 3-10-87
AGENT D. PLANS & TITLES

R. O. W. PLANS
TROY
RS 0311(1)
SHEET 29 OF 50

29

TABLE OF PROJECT PROPERTY ACQUISITION

STATE OF VERMONT
AGENCY OF TRANSPORTATION
RIGHT OF WAY PLANS
DETAIL SHEET

PARCEL NO.	GRANTOR	SHEET NO.	BEGINNING STATION	ENDING STATION	TAKING	REM.	RIGHTS	TITLE TAKEN	DATE	TOWN OR CITY RECORDED	BK.	PG.	REMARKS	REVISION NO.	SHEET	DESCRIPTION OF REVISION	DATE	MADE BY	APPROVED BY
52A	POULIN, PETER A. POULIN, JEFFREY G.	47	274+66 LT.	RTE. 242 52+00 RT.	0.09A±			COND	2-26-90	TROY	49	349-62	3700 S.F.±						
52B		47, 48	276+87 LT. 274+92 LT. 274+92 LT. 274+92 LT. 275+20 LT. 275+80 LT. 277+21 LT. 278+38 LT. 282+40 LT. 282+00 LT. 282+35 LT. 283+00 LT. 284+00 LT. 284+30 LT. 287+45 LT.	288+63 LT. 288+61 LT. 275+40 LT. 275+20 LT. 277+85 LT. 288+61 LT. 286+50 LT. 288+10 LT.	0.36A±	111.55A±	CONST. EASE. (T) 0.01A± SPECIAL DITCH (P) 0.01A± CONST. EASE. (T) 0.03A± DITCH (P) DRIVE (T) CONST. EASE. (T) 0.13A± DITCH (P) SLOPE (T) 0.07A± DITCH (P) DRIVE (T) SLOPE (T) 0.01A±						450 S.F.± 240 S.F.± 1236 S.F.± 12' GRAVEL MM 0320 15' GRAVEL DRIVE MM 0330 3025 S.F.± 12' GRAVEL MM 0331 130 S.F.± EXISTING VT. RTE. 101 & 242 R.O.W. 50 S.F.±						
52C		47, 48	274+31 LT. 276+87 LT.	288+72 LT. 277+20 LT.	0.98A±		ALL R.T. & I. SLOPE (T) 0.01A±												

DR. RT.- DRAINAGE RIGHT
DIT. RT.- DITCHING RIGHT
CH. RT.- CHANNEL RT.
DRIVE RT.- DRIVE RIGHT
CUL. RT.- CULVERT RIGHT
ⓓ- DEMOLITION OR REMOVAL
☒- WATER SOURCES

PRESENT R.O.W.
TAKING WITHOUT ACCESS
TAKING WITHOUT ACCESS ALONG PROPERTY LINE
TAKING WITH ACCESS
PERMANENT EASEMENT
TEMPORARY EASEMENT

LEGEND
--- CONST. EASE. ---
SR SR
P
L
△ △ △
○ ○ ○
CONSTRUCTION EASEMENT
SLOPE RIGHTS
PROPERTY LINE
TOP OF CUT
TOE OF SLOPE

MAY 19 1997
APPROVED: LAWRENCE BLISS, L.S., DATE: 3-10-97
AGENT D, PLANS & TITLES

R. O. W. PLANS
TROY
RS 0311(1)
SHEET 30 OF 50

PROP. ACQ. N. 5-87

30

TABLE OF PROJECT PROPERTY ACQUISITION

STATE OF VERMONT
AGENCY OF TRANSPORTATION
RIGHT OF WAY PLANS
DETAIL SHEET

PARCEL NO.	GRANTOR	SHEET NO.	BEGINNING STATION	ENDING STATION	TAKING	REM.	RIGHTS	TITLE TAKEN	DATE	TOWN OR CITY RECORDED	BK.	PG.	REMARKS	REVISION NO.	SHEET	DESCRIPTION OF REVISION	DATE	MADE BY	APPROVED BY
53A	LETOURNEAU, RICHARD & DEBRA	48, 49	288+61 LT. 288+60 LT. 288+63 LT. 288+65 LT. 288+90 LT. 289+50 LT. 293+45 LT. 294+65 LT. 295+30 LT. 296+68 LT. 297+00 LT. 297+10 LT. 298+40 LT. 300+15 LT. 300+50 LT. 301+50 LT. 301+80 LT.	302+88 LT. 295+10 LT. 295+12 LT. 293+00 LT. 296+90 LT. 298+00 LT. 302+00 LT. 302+85 LT. 301+00 LT. 302+25 LT. 302+85 LT.	0.37A±	64.75A±	CONST. EASE (T) 0.15A± REMOVE & RESET (T) RESET (T) DITCH (P) SLOPE (P) 0.07A± DITCH (P) SLOPE (P) 0.01A± CULVERT (P) DRIVE (T) SLOPE (P) 0.01A± REMOVE & RESET (T) CONST. EASE. (T) 0.06A± SLOPE (T) 0.01A± SLOPE (T) 0.01A± REMOVE & RESET (T)	NO OPTION	11-28-90 4-11-90	TROY TROY	50 49	398-9 442-43	FENCE FENCE D-34 2860 S.F. ± 25' GRAVEL DRIVE MM 0351 425 S.F. ± 16' GRAVEL MM 0355 652 S.F. ± FENCE D-35 2600 S.F. ± 50 S.F. ± 50 S.F. ± FENCE						
53B		48, 49	288+65 RT. 288+65 RT. 288+91 RT. 289+00 RT. 289+18 RT. 296+88 RT. 297+22 RT. 300+07 RT. 300+50 RT. 303+77 RT. 305+15 RT. 305+40 RT. 305+45 RT.	305+95 RT. 292+35 RT. 292+00 RT. 300+00 RT. 297+60 RT. 300+80 RT. 305+92 RT. 305+95 RT.	1.09A±	18.74A±	CONST EASE. (T) 0.10A± CUL. DIT. & DR. (P) SLOPE (T) 0.04A± REMOVE & RESET (T) CONST. EASE. (T) 0.04A± SLOPE (T) 0.01A± CONST. EASE. (T) 0.01A± DIT. & DR. (P) CONST. EASE. (T) 0.05A± REMOVE & RESET (T) CUL. DIT. & DR. (P) RESET (T)					1600 S.F. ± FENCE 1570 S.F. ± 84 S.F. ± 490 S.F. ± 2275 S.F. ± FENCE FENCE D-43							
53C		48, 49	288+63 LT. 289+20 RT.	305+95 RT. 305+12 RT.	1.82A±		ALL R.T. & I. RESET (T)						EXISTING VT. RTE. 101 R.O.W. FENCE D-36						

PROP. ADJEN. 5-87

DR. RT.- DRAINAGE RIGHT
DIT. RT.- DITCHING RIGHT
CH. RT.- CHANNEL RT.
DRIVE RT.- DRIVE RIGHT
CUL. RT.- CULVERT RIGHT
ⓓ- DEMOLITION OR REMOVAL
Ⓜ- WATER SOURCES

PRESENT R.O.W.
TAKING WITHOUT ACCESS
TAKING WITHOUT ACCESS ALONG PROPERTY LINE
TAKING WITH ACCESS
PERMANENT EASEMENT
TEMPORARY EASEMENT

LEGEND

--- CONST. EASE ---
SR SR
P
L
△ △ △
○ ○ ○

CONSTRUCTION EASEMENT
SLOPE RIGHTS
PROPERTY LINE
TOP OF CUT
TOE OF SLOPE

R. O. W. PLANS

MAY 19 1997

APPROVED: LAWRENCE BLISS, L.S. DATE: 3-10-87
AGENT D. PLANS & TITLES

TROY
RS 0311(1)
SHEET 31 OF 50

TABLE OF PROJECT PROPERTY ACQUISITION

STATE OF VERMONT
AGENCY OF TRANSPORTATION
RIGHT OF WAY PLANS
DETAIL SHEET

PARCEL NO.	GRANTOR	SHEET NO.	BEGINNING STATION	ENDING STATION	TAKING	REM.	RIGHTS	TITLE TAKEN	DATE	TOWN OR CITY RECORDED	BK.	PG.	REMARKS	REVISION NO.	SHEET	DESCRIPTION OF REVISION	DATE	MADE BY	APPROVED BY
54A	THE M. & E. TRUST DUNBAR, MICHAEL E. & ELIZABETH B. TRUSTEES	49	302+85 LT. 304+27 LT. 304+27 LT. 304+31 LT. 304+50 LT. 304+50 LT. 305+30 LT. 305+66 LT.	305+99 LT. 305+45 LT. 305+99 LT. 305+99 LT.	0.12A±	7.77A±	SLOPE (T) 0.01A± CONST. EASE. (T) 0.04A± DRIVE (T) REMOVE & RESET (T) RESET (T) DITCH (P) DRIVE (T)	WD	01-16-90	TROY	49	266-67	490 S.F. ± 1650 S.F. ± 12' GRAVEL MM 0369 FENCE FENCE D-37 12' GRAVEL MM 0370						
54B		49	302+88 LT.	305+98 LT.	0.18A±		ALL R.T. & I.						EXISTING VT. RTE. 101 R.O.W.						
55	SOLD												FORMERLY LAFAVER G.E. NOW PARCEL 56F, 56G WHICH IS J. STARR JR.,						

PROJ. ADORN. 5-87

DR. RT. - DRAINAGE RIGHT
DIT. RT. - DITCHING RIGHT
CH. RT. - CHANNEL RT.
DRIVE RT. - DRIVE RIGHT
CUL. RT. - CULVERT RIGHT
ⓓ - DEMOLITION OR REMOVAL
☒ - WATER SOURCES

PRESENT R.O.W.
TAKING WITHOUT ACCESS
TAKING WITHOUT ACCESS ALONG PROPERTY LINE
TAKING WITH ACCESS
PERMANENT EASEMENT
TEMPORARY EASEMENT

LEGEND

--- CONST. EASE. ---
SR SR
P
L
△
○

CONSTRUCTION EASEMENT
SLOPE RIGHTS
PROPERTY LINE
TOP OF CUT
TOE OF SLOPE

MAY 19 1997

APPROVED: LAWRENCE BLISS, L.S. DATE: 3-10-97
AGENT D. PLANS & TITLES

R. O. W. PLANS

TROY
RS 0311(1)
SHEET 32 OF 50

32

**STATE OF VERMONT
AGENCY OF TRANSPORTATION
RIGHT OF WAY PLANS
DETAIL SHEET**

ACCT.RYAN
ZFI:[70,]78E142D.0GN
PRF: 78E142D26.PRFLV=4
DATE PLOTTED 5-DEC-1989

— — — — —	PRESENT R.O.W.
— — — — —	TAKING WITHOUT ACCESS
— — — — —	TAKING WITHOUT ACCESS ALONG PROPERTY LINE
— — — — —	TAKING WITH ACCESS
(P)	PERMANENT EASEMENT
(T)	TEMPORARY EASEMENT

APPROVED: LAWRENCE BLISS, L.S. DATE: 3-10-87
AGENT D, PLANS & TITLES

TROY
RS 0311(1)
SHEET 33 OF 50

TABLE OF PROJECT PROPERTY ACQUISITION

STATE OF VERMONT
AGENCY OF TRANSPORTATION
RIGHT OF WAY PLANS
DETAIL SHEET

PARCEL NO.	GRANTOR	SHEET NO.	BEGINNING STATION	ENDING STATION	TAKING	REM.	RIGHTS	TITLE TAKEN	DATE	TOWN OR CITY RECORDED	BK.	PG.	REMARKS	REVISION NO.	SHEET	DESCRIPTION OF REVISION	DATE	MADE BY	APPROVED BY
58A	LENCE, CONSTANCE D.	50	317+48 RT. 317+84 RT. 317+89 RT.	318+23 RT. 318+23 RT.	0.03A±	106.97A±	DRIVE (T) SLOPE (T) 0.01A±	COND	2-26-90	TROY	49	349-82	1165 S.F.± 12' GRAVEL MM 0395 140 S.F.±						
58B		50	317+47 RT.	318+23 RT.	0.04A±		ALL R.T. & I.						EXISTING VT. RTE. 101 R.O.W. 1875 S.F.±						
59A	MAYHEW, CARL E., SR. & CLARA	50	317+76 LT. 318+00 LT. 318+57 LT. 319+31 LT.	319+66 LT. 319+64 LT.	0.04A±	0.65A±	DITCH (P) SLOPE (T) 0.01A±	WD	11-27-89	TROY	49	124-25	1786 S.F.± 12' GRAVEL DRIVE MM 0396 338 S.F.±						
59B		50	317+76 LT.	319+68 RT.	0.11A±		ALL R.T. & I.						EXISTING VT. RTE. 101 R.O.W.						
60A	STARR, VIRGIL E. & LINDA D. (CONT. ON SHEET 35)	50	318+23 RT. 318+23 RT. 318+23 RT. 318+23 RT. 318+38 RT. 319+85 RT. 320+27 RT. 320+85 RT. 320+94 RT. 321+68 RT.	321+79 RT. 319+20 RT. 319+50 RT. 321+70 RT.	0.14A±	1.54A±	REMOVE & RESET (T) SLOPE (T) 0.01A± CONST. EASE. (T) 0.03A± CUL., DIT. & DR. (P) DRIVE (T) DRIVE (T) TRANSPLANT (T) SLOPE (T) 0.02A± CUL., DIT. & DR. (P)	WD	1-19-90	TROY	49	288-89	FENCE D-42 FENCE 365 S.F.± 1525 S.F.± 12' GRAVEL MM 0399 14' GRAVEL MM 0400 2 - 2" PINES 952 S.F.±						
60B		50	318+22 RT. 319+43 LT±	321+80 LT. 319+62 RT.±	0.20A±		ALL R.T. & I. ALL R.T. & I.						EXISTING VT. RTE. 101 R.O.W. WATERLINE						

ACCT. RYAN
ZFA2670.H178E142D.DGN
PRF: 78E142027.PRF
DATE PLOTTED 12-AUG-1989

DR. RT.- DRAINAGE RIGHT
DIT. RT.- DITCHING RIGHT
CH. RT.- CHANNEL RT.
DRIVE RT.- DRIVE RIGHT
CUL. RT.- CULVERT RIGHT
(D)- DEMOLITION OR REMOVAL
(W)- WATER SOURCES

PRESENT R.O.W.
TAKING WITHOUT ACCESS
TAKING WITHOUT ACCESS ALONG PROPERTY LINE
TAKING WITH ACCESS
PERMANENT EASEMENT
TEMPORARY EASEMENT

LEGEND

--- CONST. EASE. ---
SR SR
P
L
△ △ △
○ ○ ○

CONSTRUCTION EASEMENT
SLOPE RIGHTS
PROPERTY LINE
TOP OF CUT
TOE OF SLOPE

APPROVED: LAWRENCE BLISS, L.S. DATE: 3-10-87
AGENT D. PLANS & TITLES

MAY 19 1997

R. O. W. PLANS

TROY
RS 0311(1)
SHEET 34 OF 50

TABLE OF PROJECT PROPERTY ACQUISITION

STATE OF VERMONT
AGENCY OF TRANSPORTATION
RIGHT OF WAY PLANS
DETAIL SHEET

PARCEL NO.	GRANTOR	SHEET NO.	BEGINNING STATION	ENDING STATION	TAKING	REM.	RIGHTS	TITLE TAKEN	DATE	TOWN OR CITY RECORDED	BK.	PG.	REMARKS	REVISION NO.	SHEET	DESCRIPTION OF REVISION	DATE	MADE BY	APPROVED BY
60C	STARR, VIRGIL E. & LINDA D. CONT. FROM SHEET 34	49, 50	305+93 RT. 305+92 RT.	317+48 RT. 307+00 RT.	0.71A±	8.23A±	CONST. EASE. (T) 0.02A± SLOPE (T) 0.01A± CONST. EASE. (T) 0.01A± DRAINAGE (P) DRIVE (T) DIT. & DR. (P) DRIVE (T) DRIVE (T)						1000 S.F. ± 275 S.F. ± 630 S.F. ± 12' GRAVEL MM 0385 16' GRAVEL MM 0380 12' GRAVEL MM 0384						
60D		49, 50	305+95 RT. 305+95 RT.	317+47 RT. 312+25 RT.	0.66A±		ALL R.T. & I. RESET (T)						EXISTING VT. RTE. 101 R.O.W. FENCE D-33						

DR. RT.- DRAINAGE RIGHT
DIT. RT.- DITCHING RIGHT
CH. RT.- CHANNEL RT.
DRIVE RT.- DRIVE RIGHT
CUL. RT.- CULVERT RIGHT
ⓧ- DEMOLITION OR REMOVAL
☒- WATER SOURCES

PRESENT R.O.W.
TAKING WITHOUT ACCESS
TAKING WITHOUT ACCESS ALONG PROPERTY LINE
TAKING WITH ACCESS
PERMANENT EASEMENT
TEMPORARY EASEMENT

LEGEND

--- CONST. EASE. ---
SR SR
P
L
△ △ △
○ ○ ○

CONSTRUCTION EASEMENT
SLOPE RIGHTS
PROPERTY LINE
TOP OF CUT
TOE OF SLOPE

APPROVED: LAWRENCE BLISS, L.S., DATE: 3-10-87
AGENT D. PLANS & TITLES

R. O. W. PLANS

TROY
RS 0311(1)
SHEET 35 OF 50

TABLE OF PROJECT PROPERTY ACQUISITION

STATE OF VERMONT
AGENCY OF TRANSPORTATION
RIGHT OF WAY PLANS
DETAIL SHEET

PARCEL NO.	GRANTOR	SHEET NO.	BEGINNING STATION	ENDING STATION	TAKING	REM.	RIGHTS	TITLE TAKEN	DATE	TOWN OR CITY RECORDED	BK.	PG.	REMARKS	REVISION NO.	SHEET	DESCRIPTION OF REVISION	DATE	MADE BY	APPROVED BY
61	DELETED												FORMERLY WILLIS						
62	DELETED												FORMERLY WURSTHORN						
63	DELETED												FORMERLY FERGUSON						
64A	DELETED												FORMERLY DEMUTH						
64B																			
65	CITIZENS UTILITIES CO.							COND	2-26-90	TROY	49	349-62	UTILITY						
66	VERMONT ELECTRIC CO-OP, INC.												UTILITY						
67	TOWN OF TROY WATER & SEWER												UTILITY						
68A	HOME & CITY SAVINGS BANK	46, 47	REV. 260+90 LT.	REV. 268+18 LT.	0.17A±	21.62A±		COND	2-26-90	TROY	49	349-62	15' GRAVEL MM 0291 13' GRAVEL MM 0295 3380 S.F. ± FENCE FENCE D-29 FENCE						
			REV. 263+23 LT. REV. 264+85 LT. REV. 264+92 LT. REV. 264+90 LT. REV. 265+05 LT. REV. 265+05 LT. REV. 268+11 LT.	REV. 268+20 LT. REV. 268+23 LT. REV. 268+11 LT.			DRIVE (T) DRIVE (T) SLOPE (P) 0.10A± CONST. EASE. (T) 0.08A± REMOVE & RESET (T) RESET (T) REMOVE & RESET (T)												
68B		46, 47	REV. 260+90 LT.	REV. 268+16 LT.	0.41A±		ALL R.T. & I.						EXISTING VT. RTE. 101 R.O.W.						
69A	LONGLEY, GRAYDON N. & ANN B.	40-41	167+05 LT. 167+05 LT. 167+05 LT. 168+80 LT. 168+17 LT. 170+13 LT. 170+30 LT. 170+50 LT. 170+75 LT. REV. 173+50 LT.	REV. 173+64 LT. 168+00 LT. 172+00 LT. 170+45 LT. 170+13 LT. 170+70 LT. 171+45 LT. 171+15 LT.	0.38A±	9.78A±	CONST. EASE (T) 0.07A± SLOPE (T) 0.02A± DITCH (P) 0.01A± CULVERT (P) DRIVE (T) SLOPE (T) 0.03A± DITCH (P) 60 S.F. ± DITCH (P) 50 S.F. ±	WD	2-07-90	TROY	49	335-36	FENCE D-7 3020 S.F. ± 1196 S.F. ± 499 S.F. ± 16' GRAVEL MM 0115 1437 S.F. ±						
69B		40-41	167+05 LT.	REV. 173+62 LT.	0.34A±		ALL R.T. & I.						EXIST. VT. RTE. 101 R.O.W.						
	MAINTENANCE AGREEMENT AREA NO 1	39	TH24 40+17 CL.	TH24 41+19 CL.									TOWN HIGHWAY NO. 24						

DR. RT.- DRAINAGE RIGHT
DIT. RT.- DITCHING RIGHT
CH. RT.- CHANNEL RT.
DRIVE RT.- DRIVE RIGHT
CUL. RT.- CULVERT RIGHT
ⓓ- DEMOLITION OR REMOVAL
W- WATER SOURCES

PRESENT R.O.W.
TAKING WITHOUT ACCESS
TAKING WITH ACCESS
PERMANENT EASEMENT
TEMPORARY EASEMENT

LEGEND
--- CONST. EASE. ---
SR SR
P
L
△ △ △
○ ○ ○

CONSTRUCTION EASEMENT
SLOPE RIGHTS
PROPERTY LINE
TOP OF CUT
TOE OF SLOPE


APPROVED: LAWRENCE BLISS, L.S. DATE: 2-10-97
AGENT D. PLANS & TITLES

MAY 19 1997

R. O. W. PLANS
TROY
RS 0311(1)
SHEET 35A OF 50 36

PLAN
DATE
BY
CHECKED
NOTED
NO.

PROFILE
DATE
BY
CHECKED
NOTED
NO.

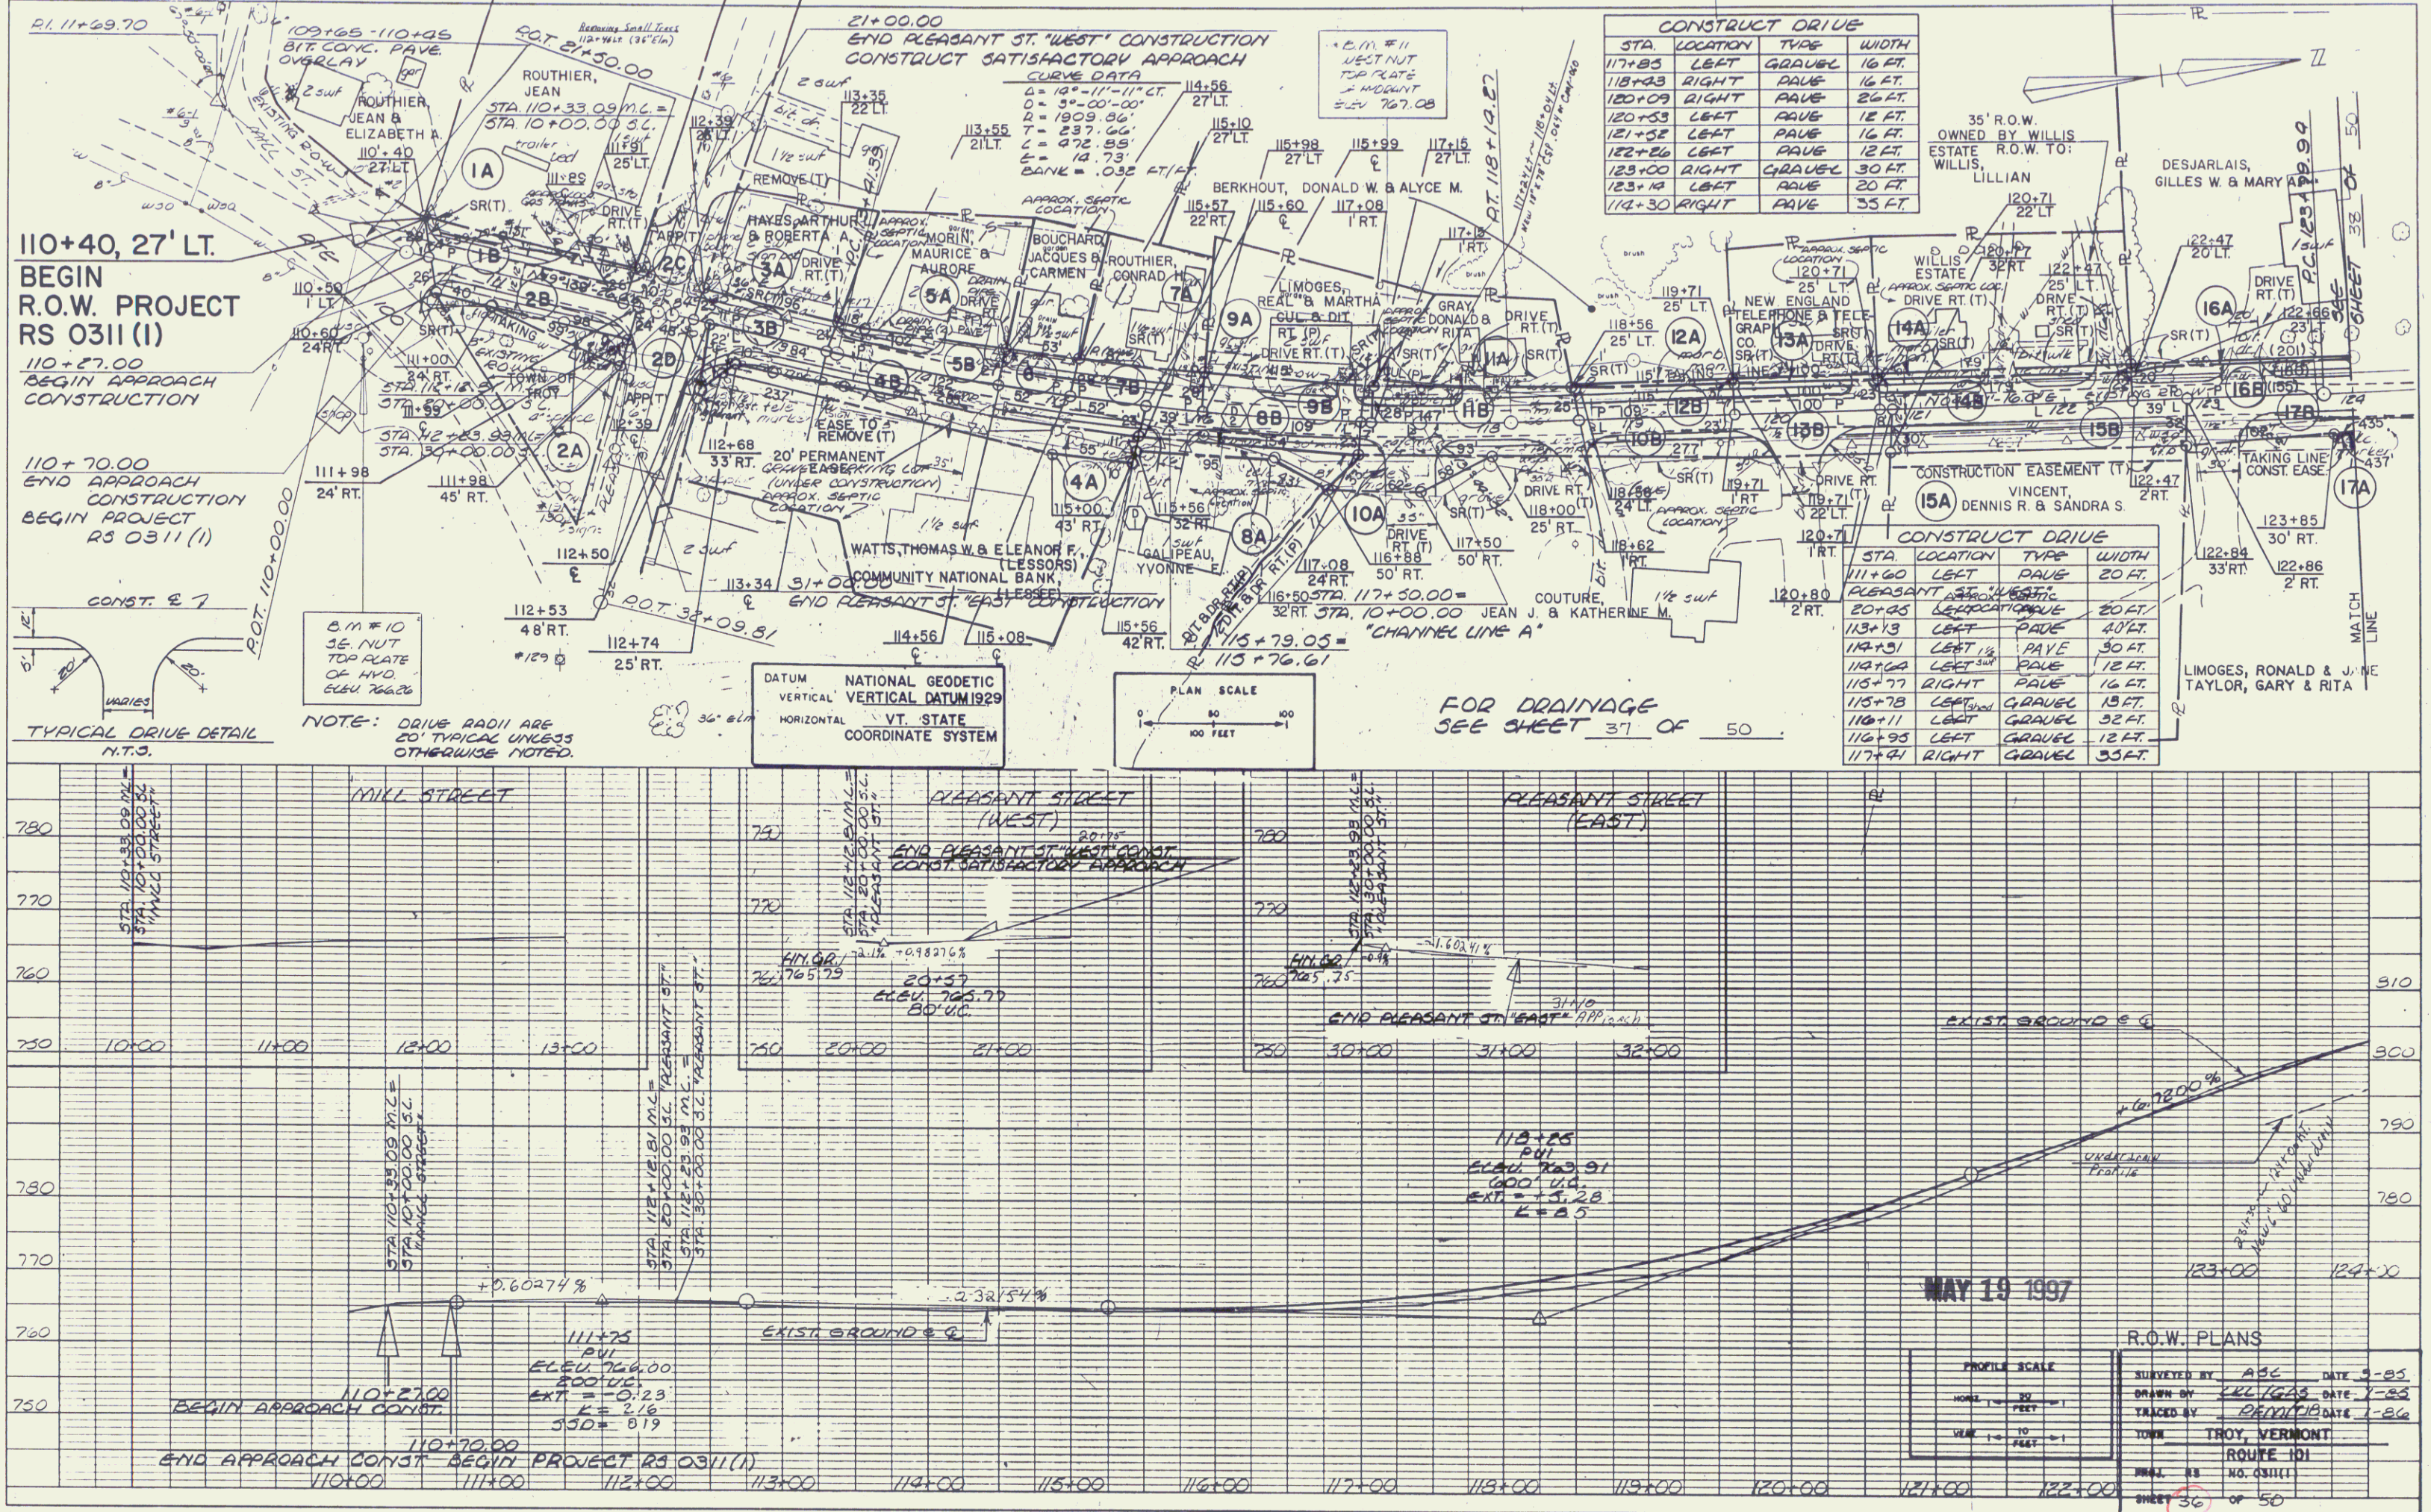

DATE	
PROJECT	
NOTE BOOK	
NO.	

DATE	
PROJECT	
NOTE BOOK	
NO.	




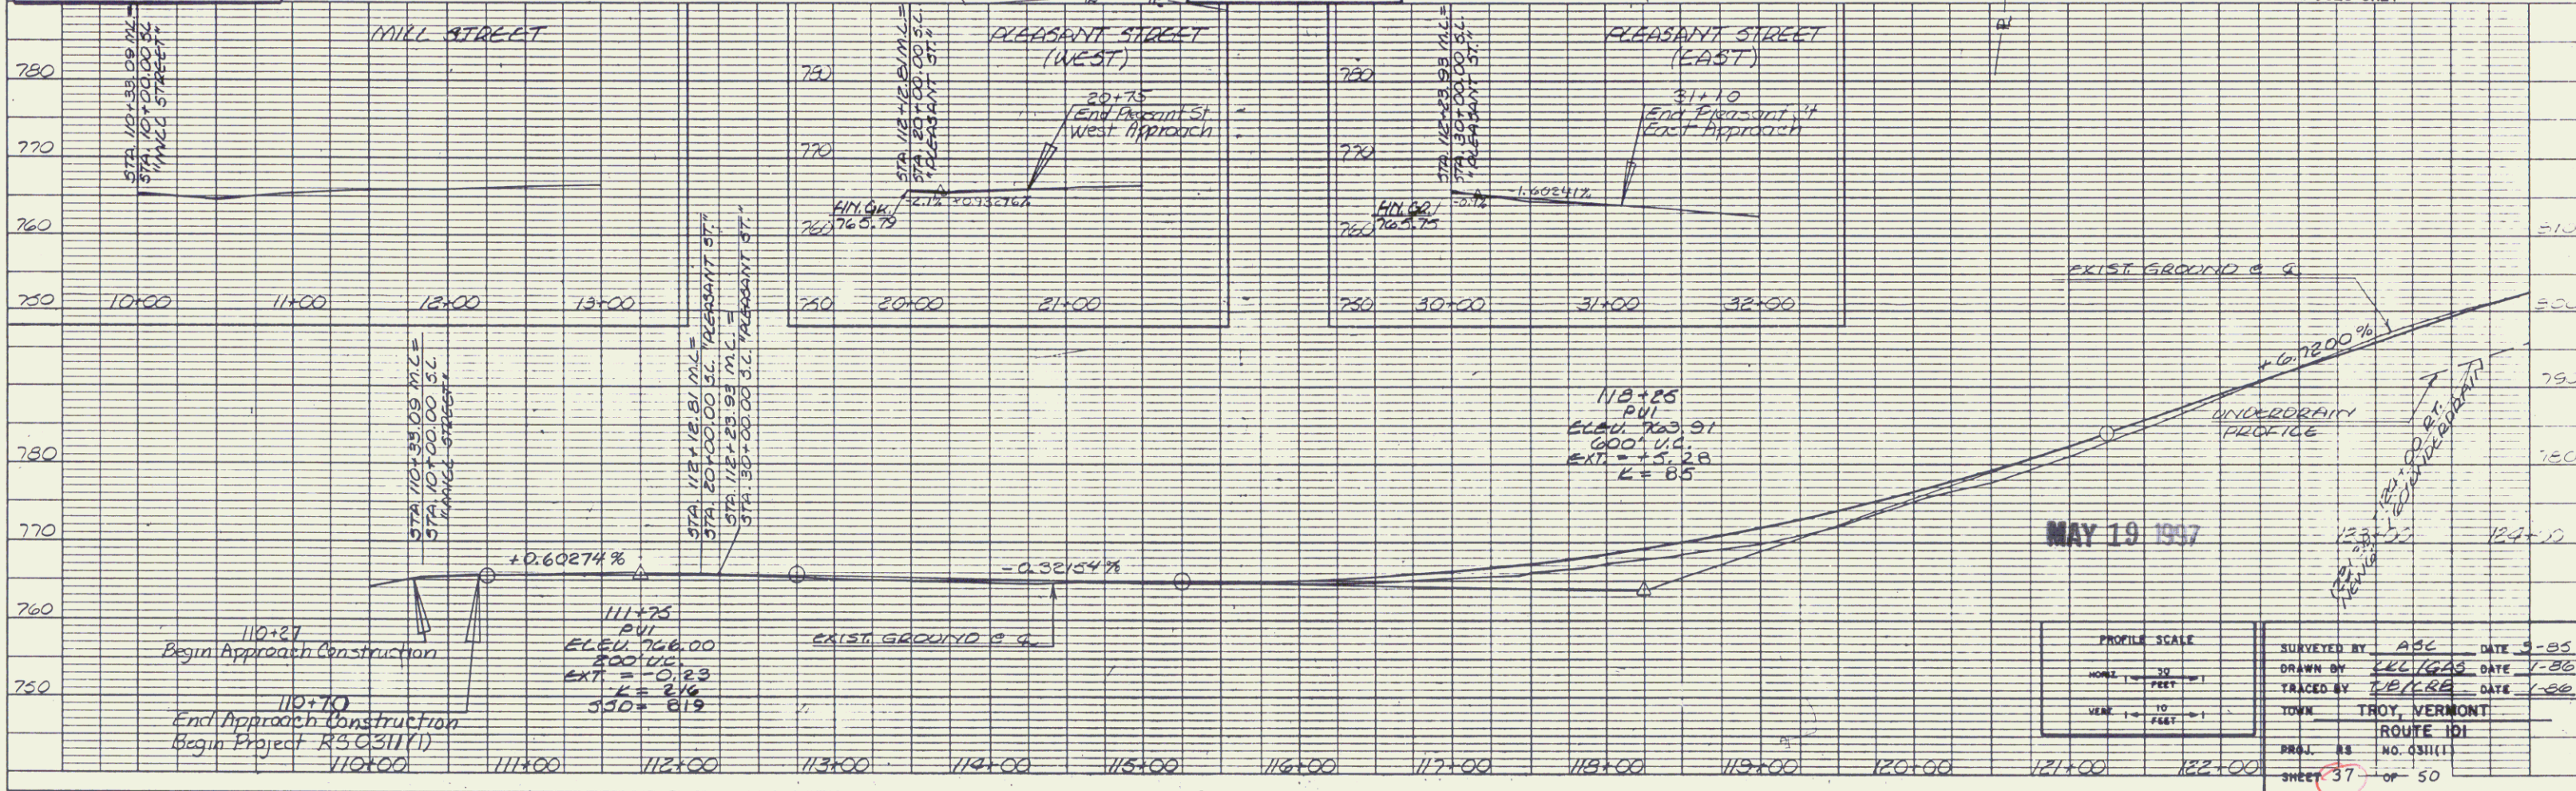



PLATE 1 PLAN PROFILE & ELEVATION STANDARDS
DETROIT CORPORATION
DETROIT, MICHIGAN

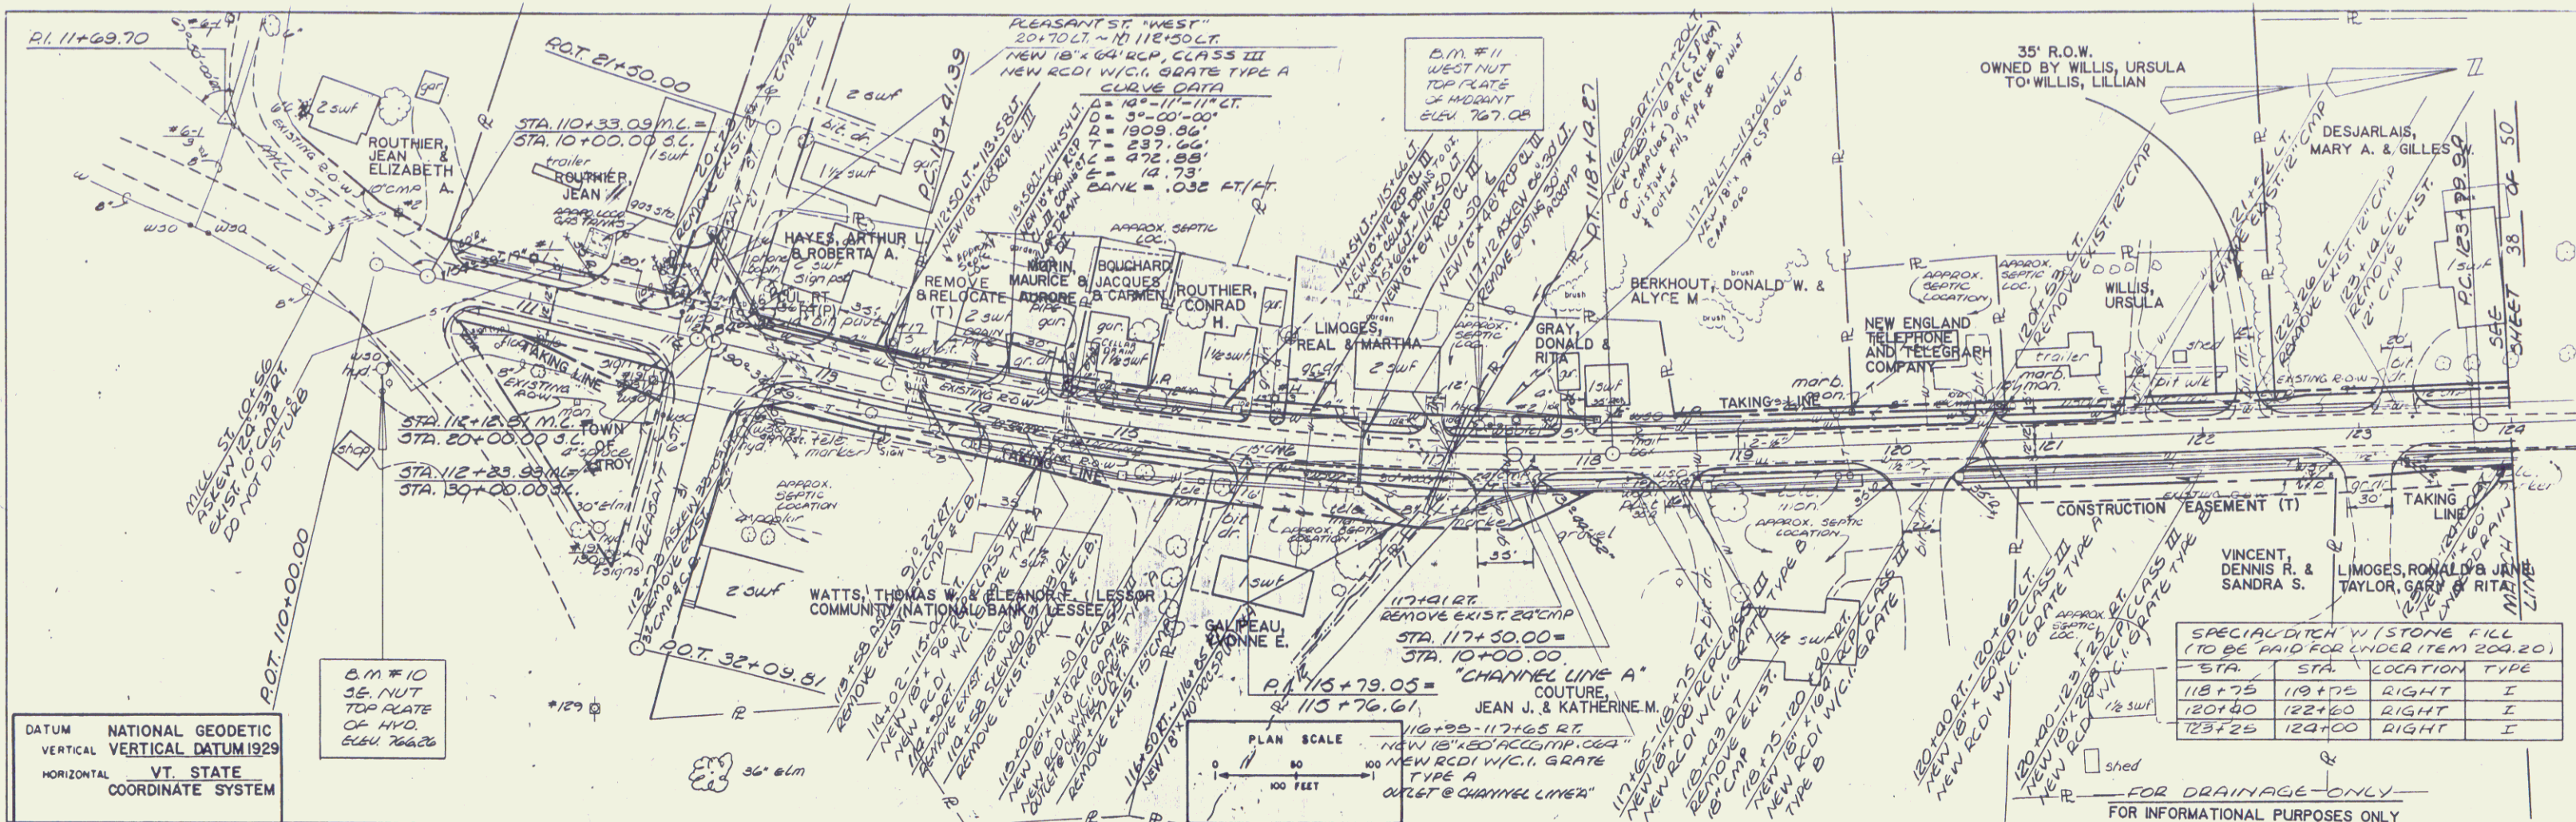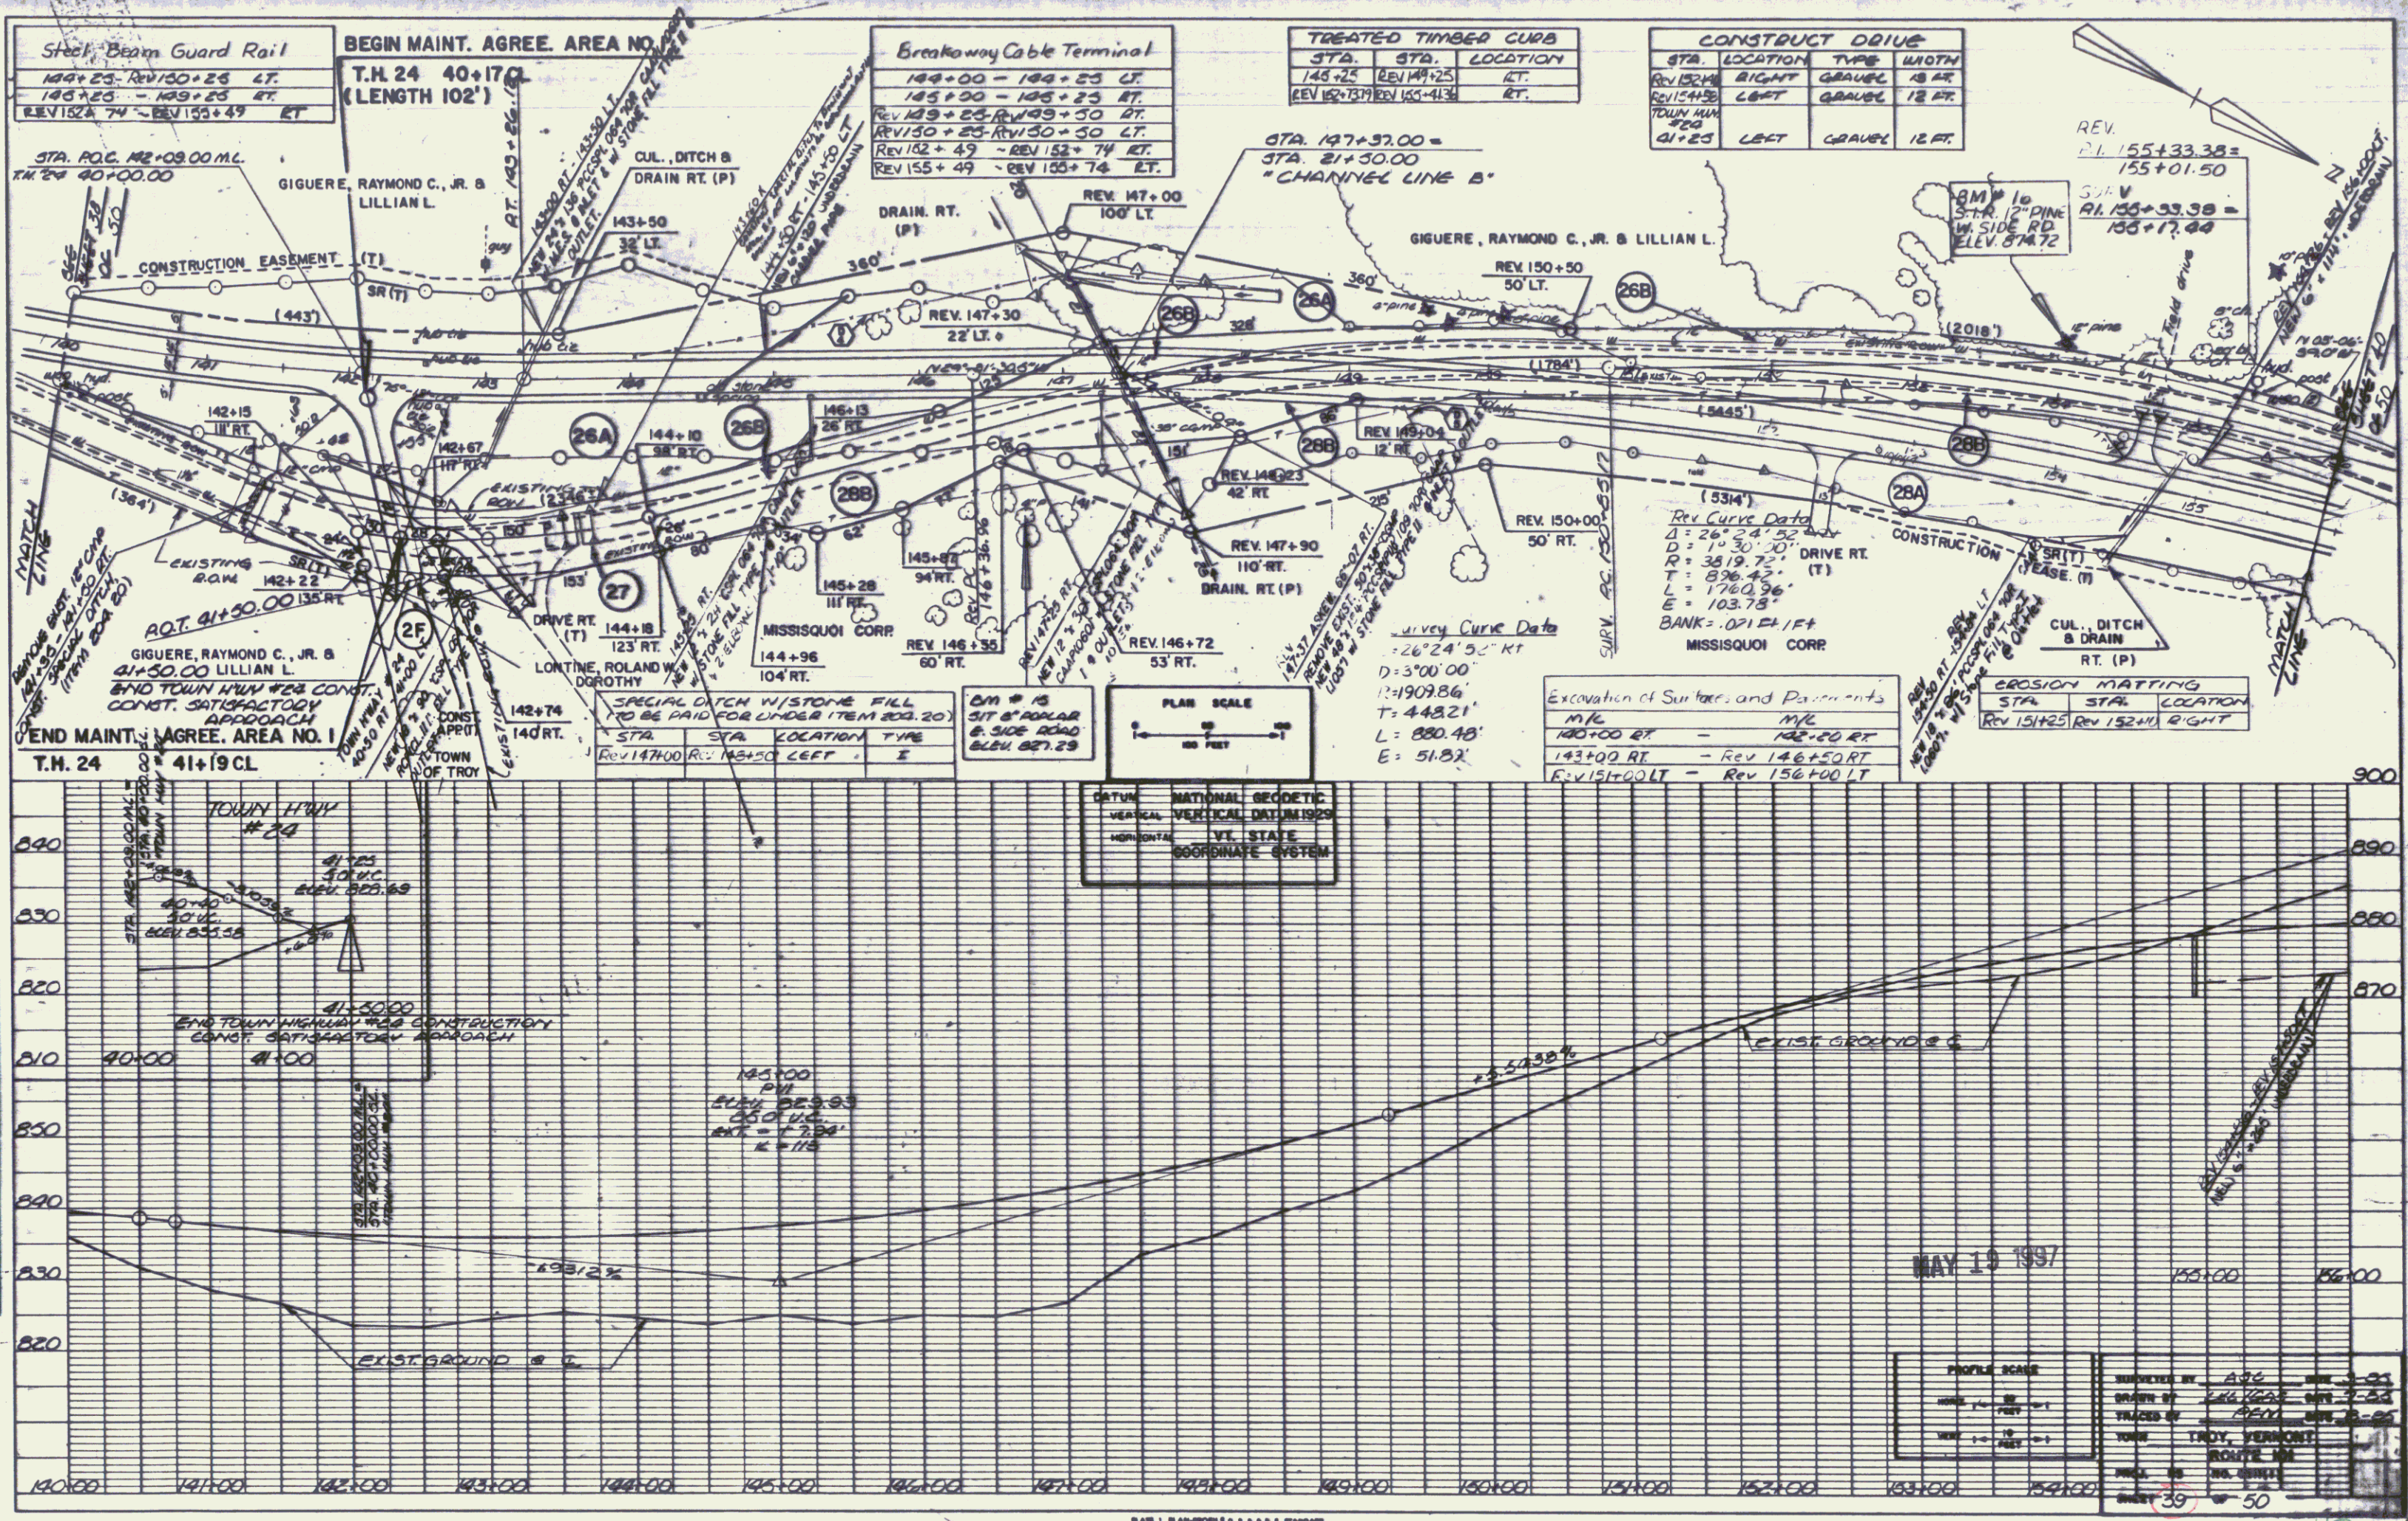


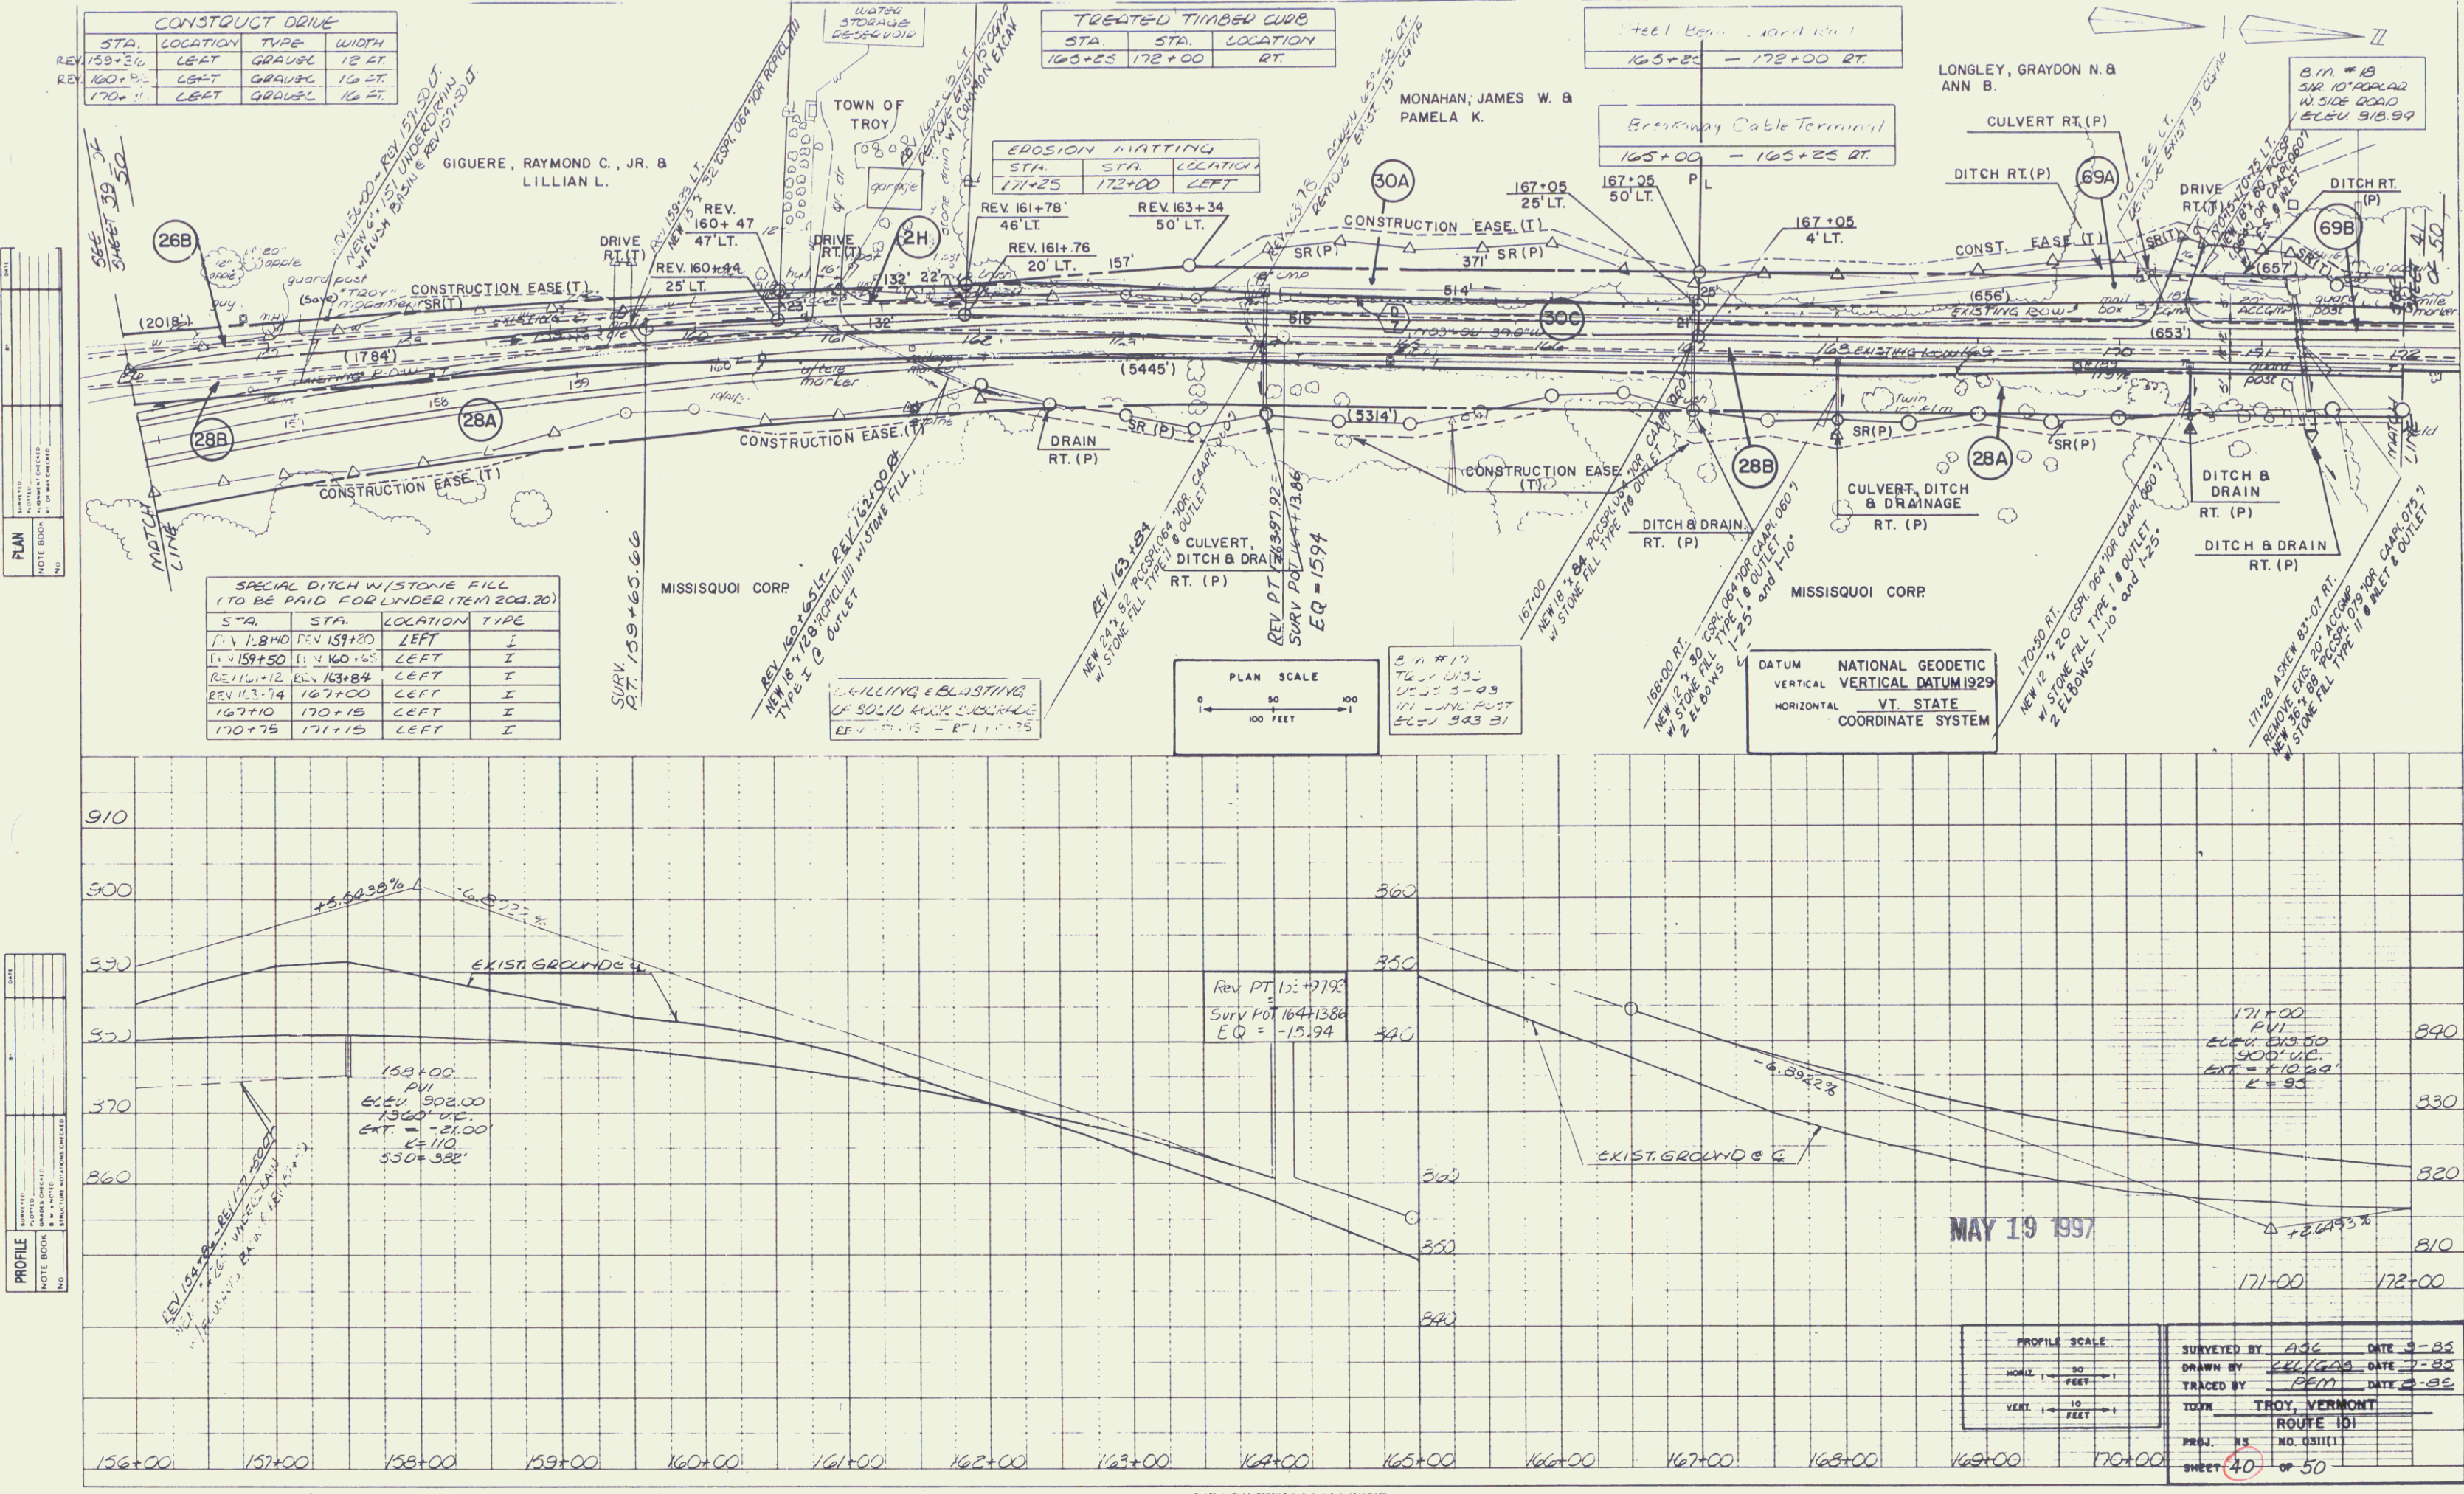

PLAN	DATE	BY	CHKD
REVISION			
NO.			


PROFILE	DATE	BY	CHKD
REVISION			
NO.			

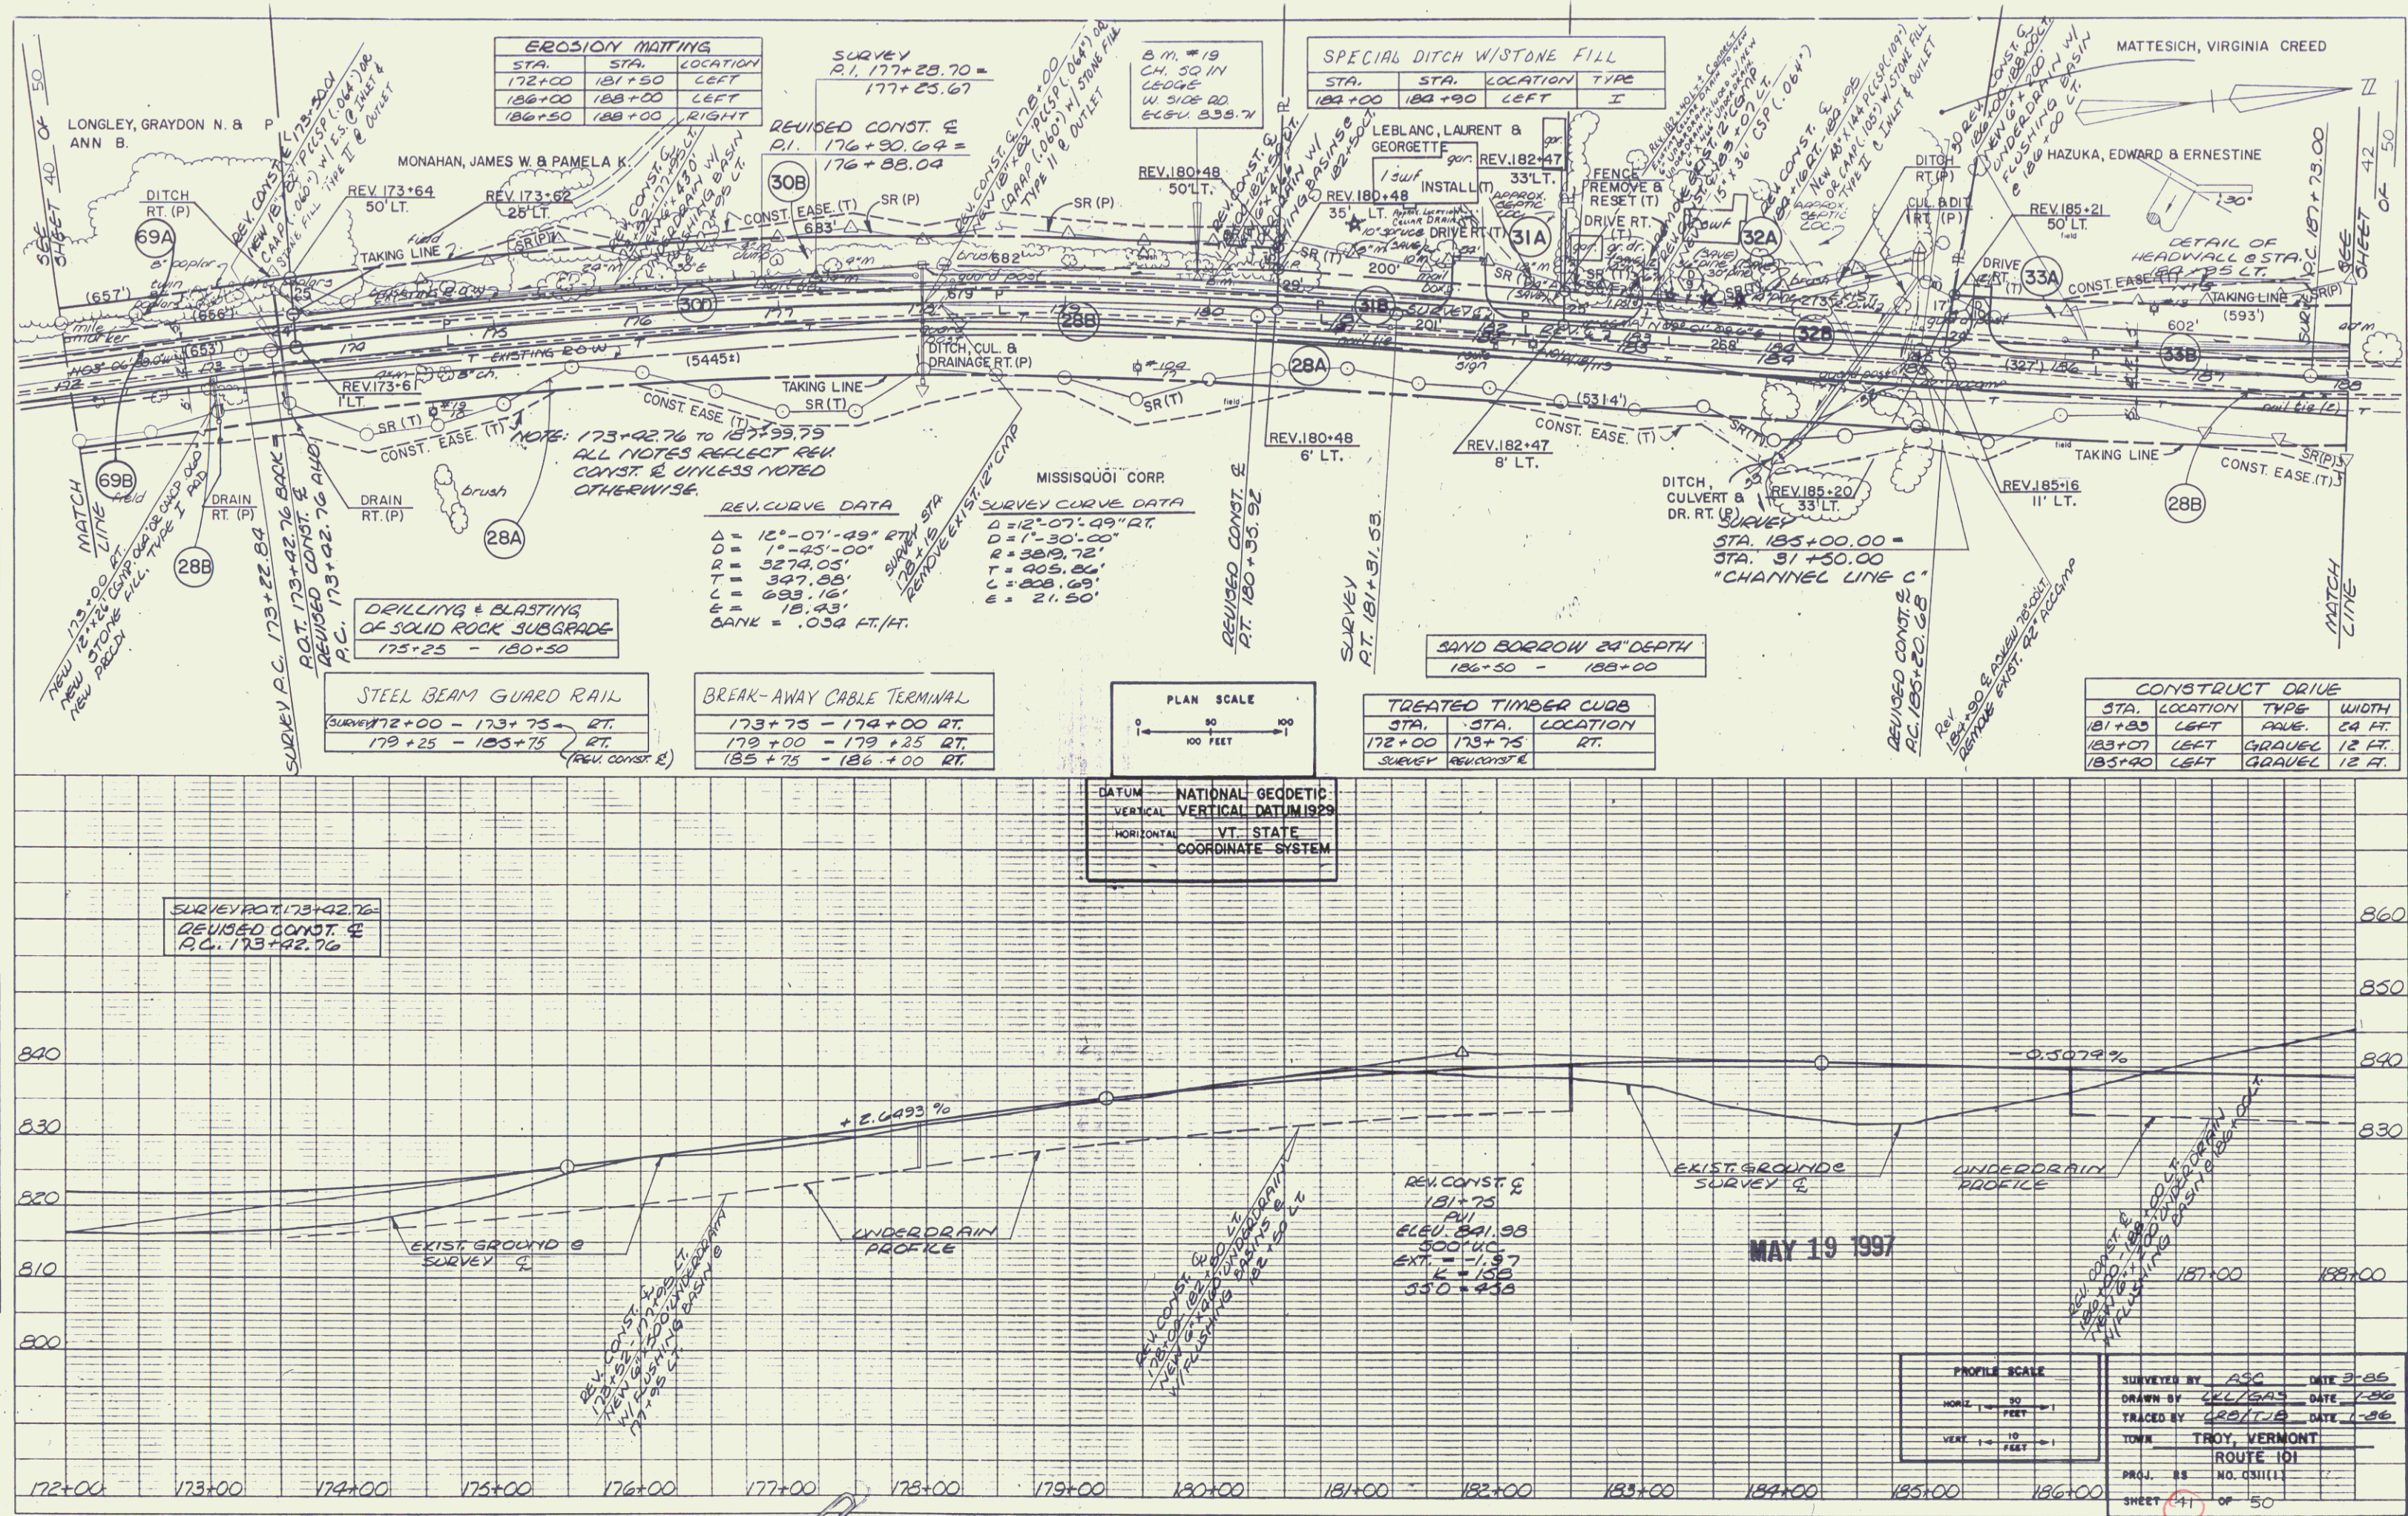

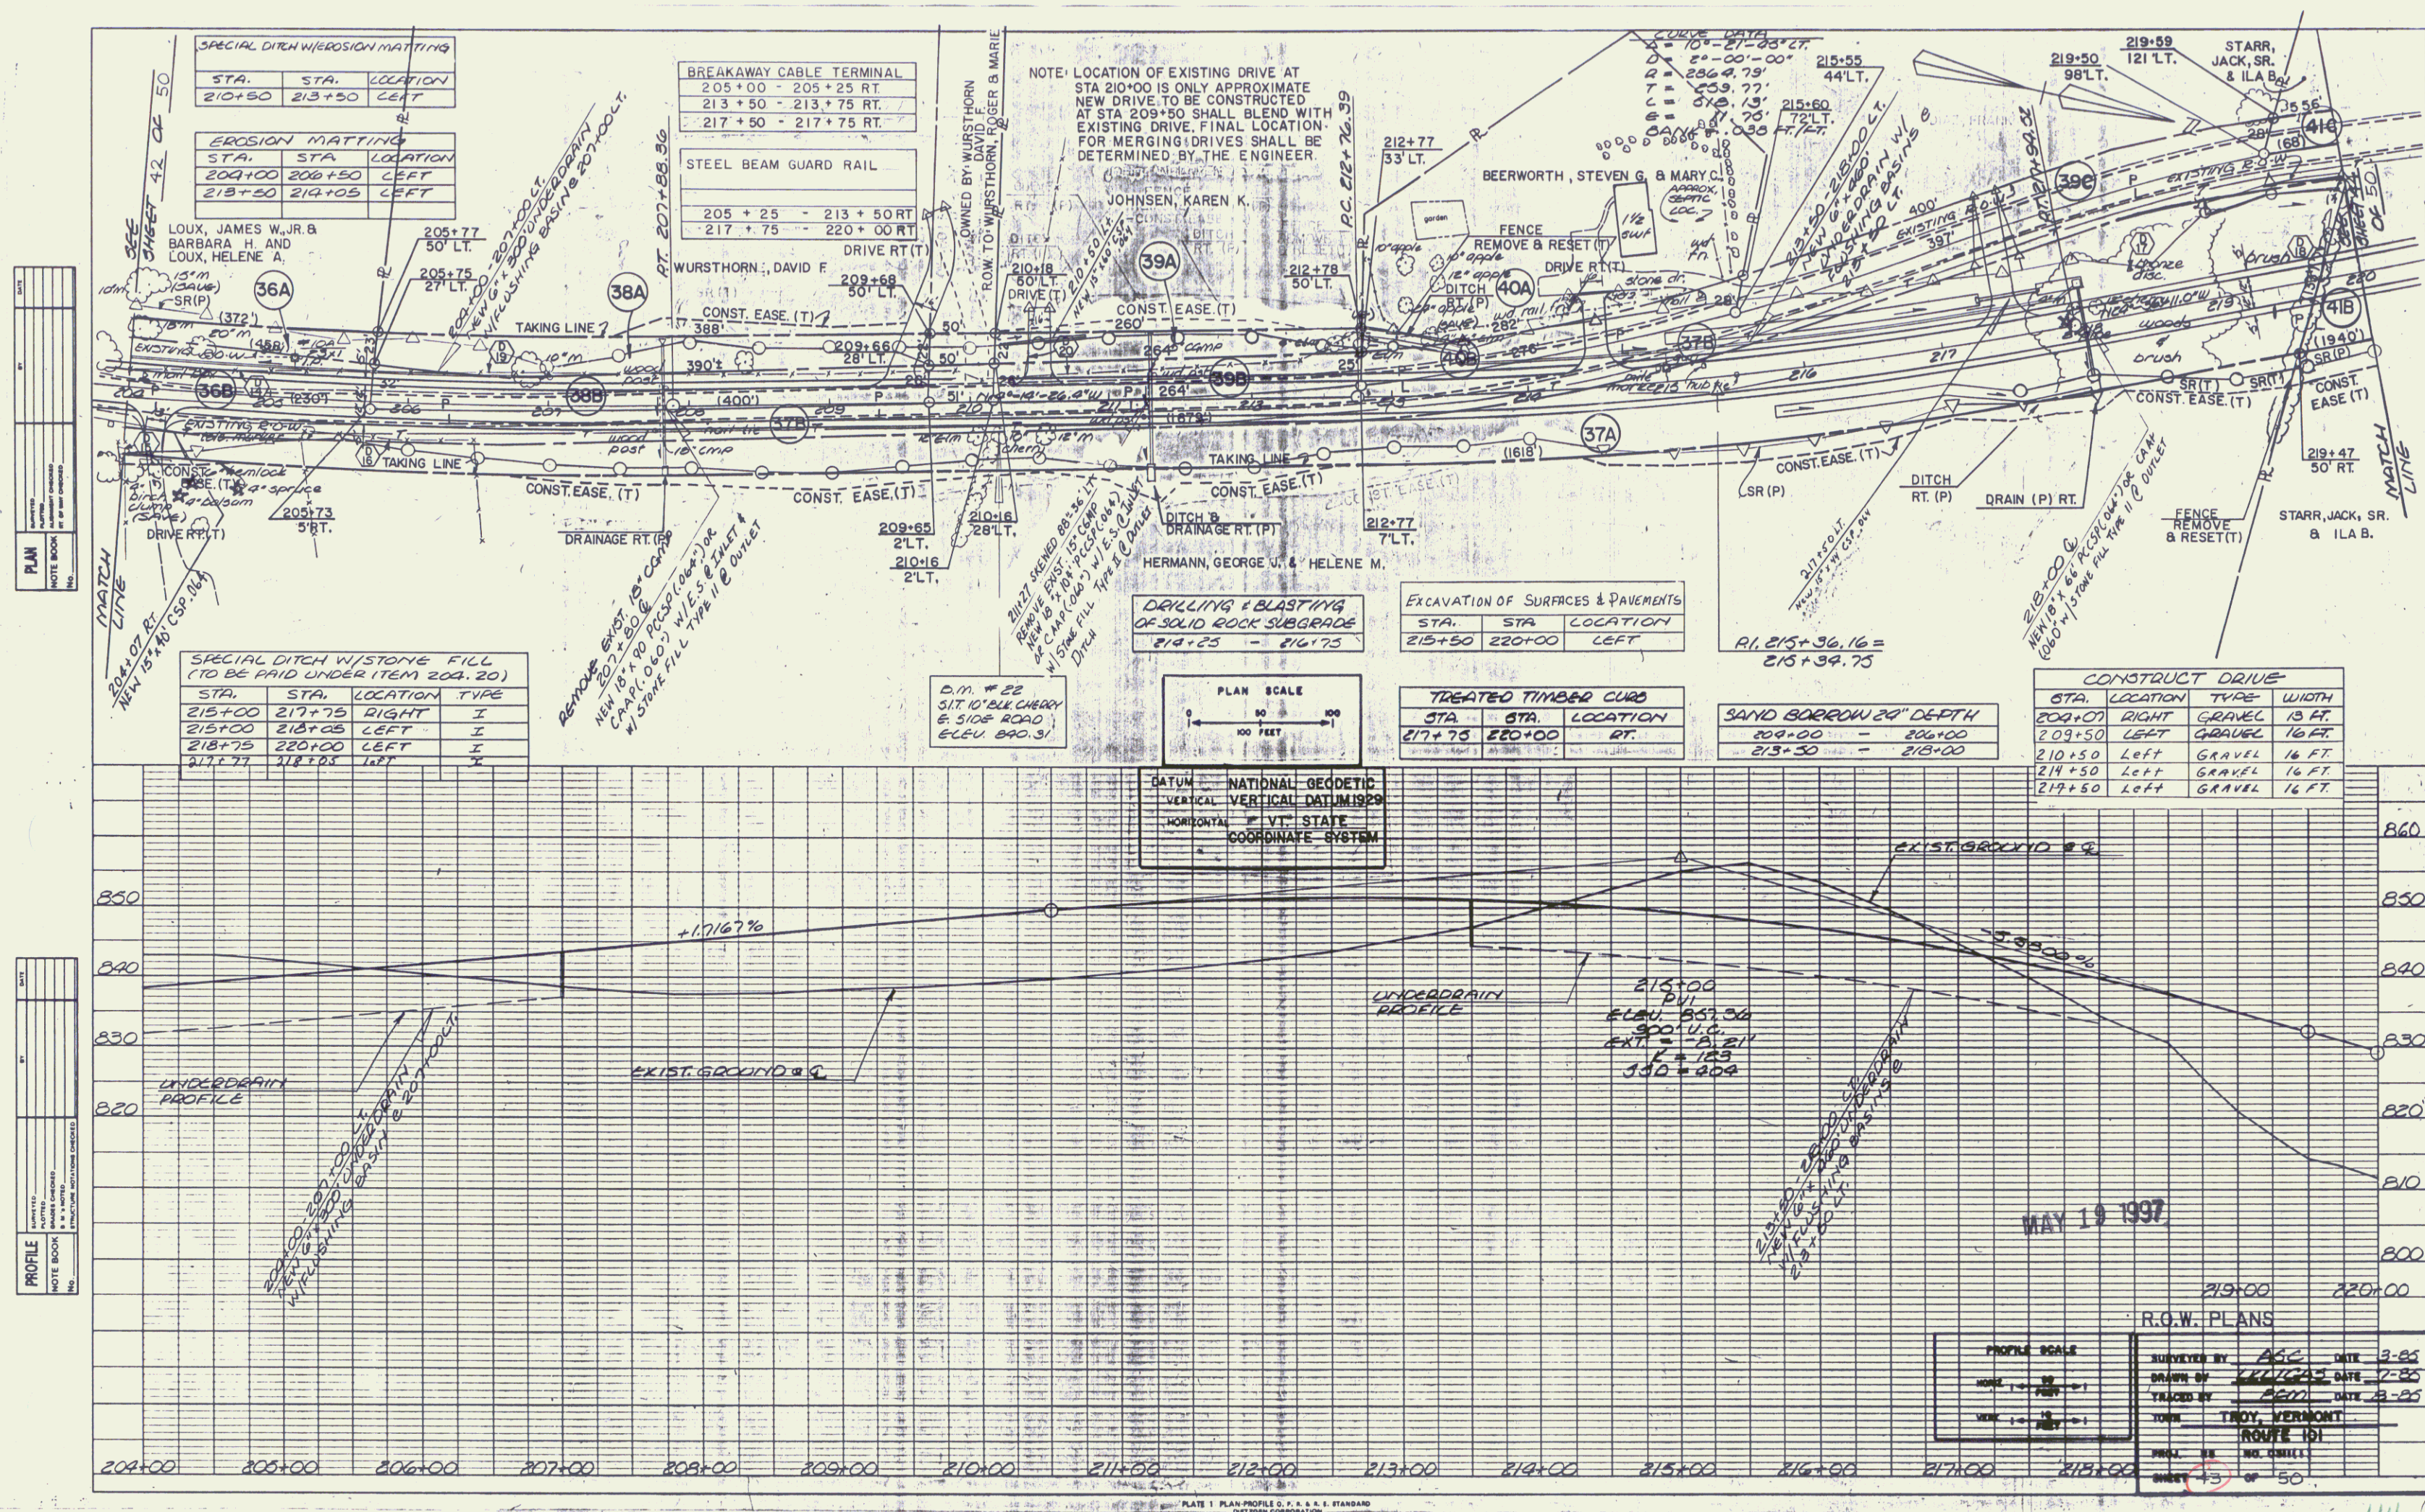


PLAN	DATE
NO.	

PROFILE	DATE
NO.	

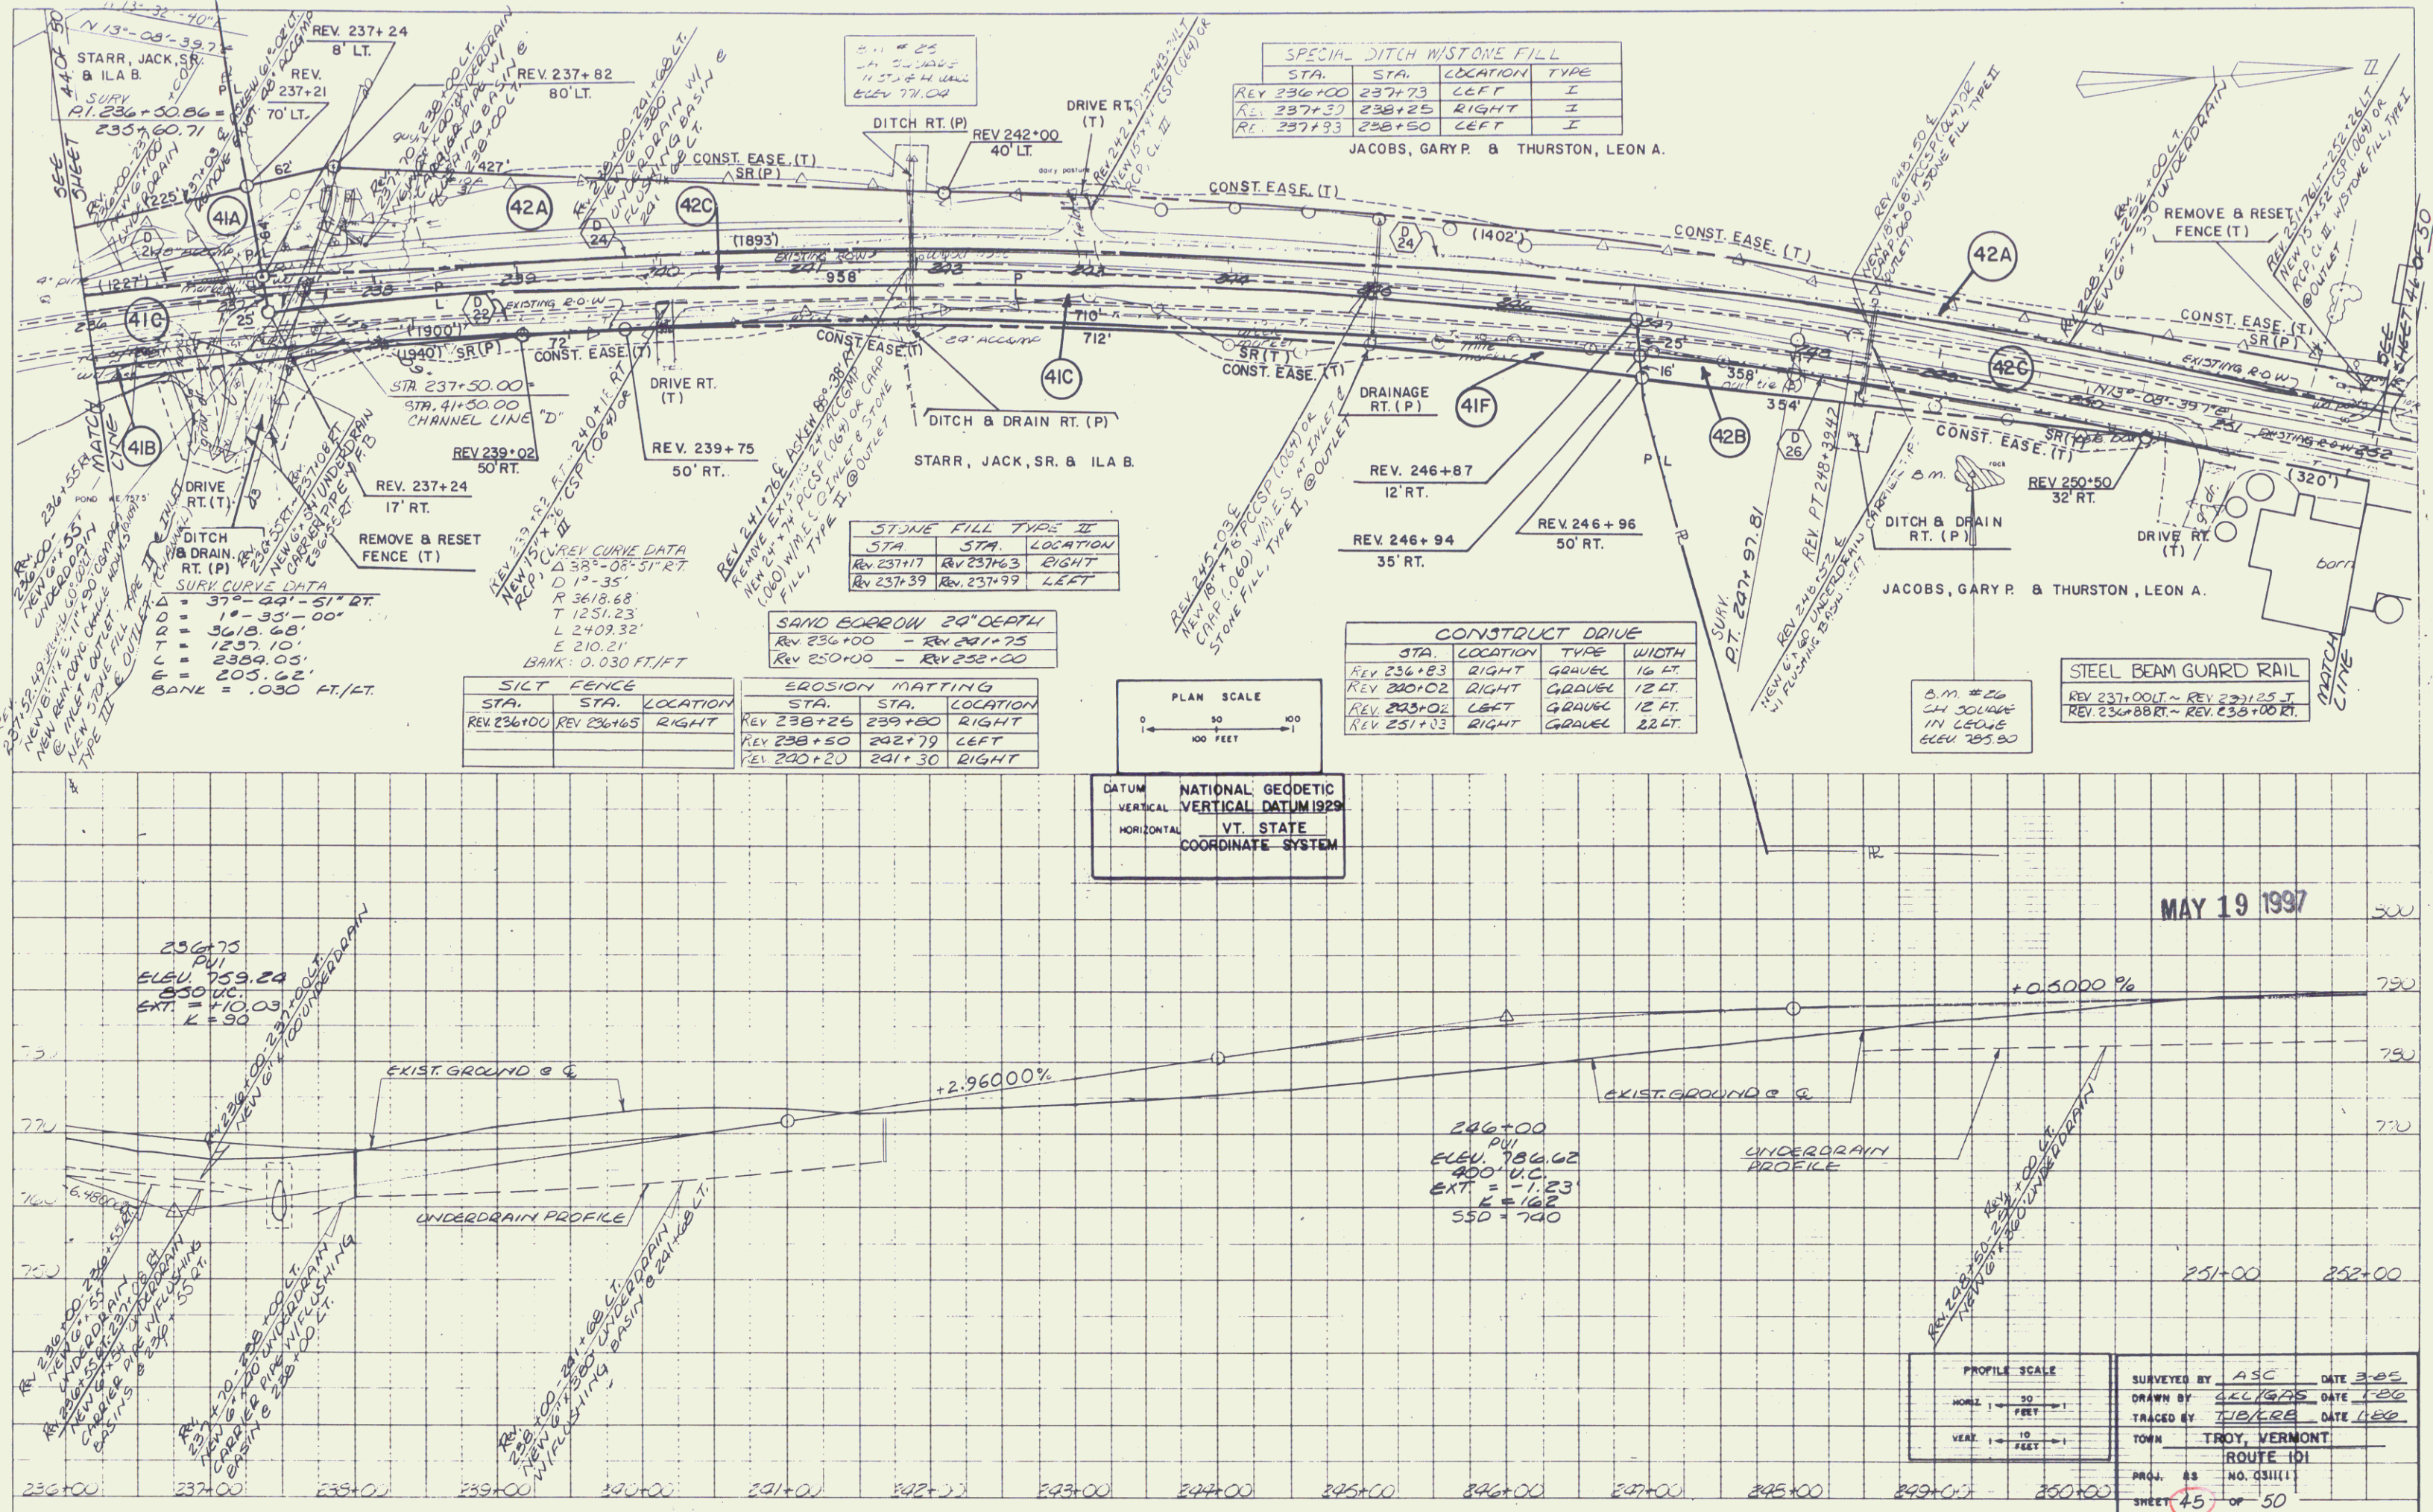


PLAN	DATE
NO. 1	
NO. 2	
NO. 3	
NO. 4	
NO. 5	
NO. 6	
NO. 7	
NO. 8	
NO. 9	
NO. 10	

PROFILE	DATE
NO. 1	
NO. 2	
NO. 3	
NO. 4	
NO. 5	
NO. 6	
NO. 7	
NO. 8	
NO. 9	
NO. 10	

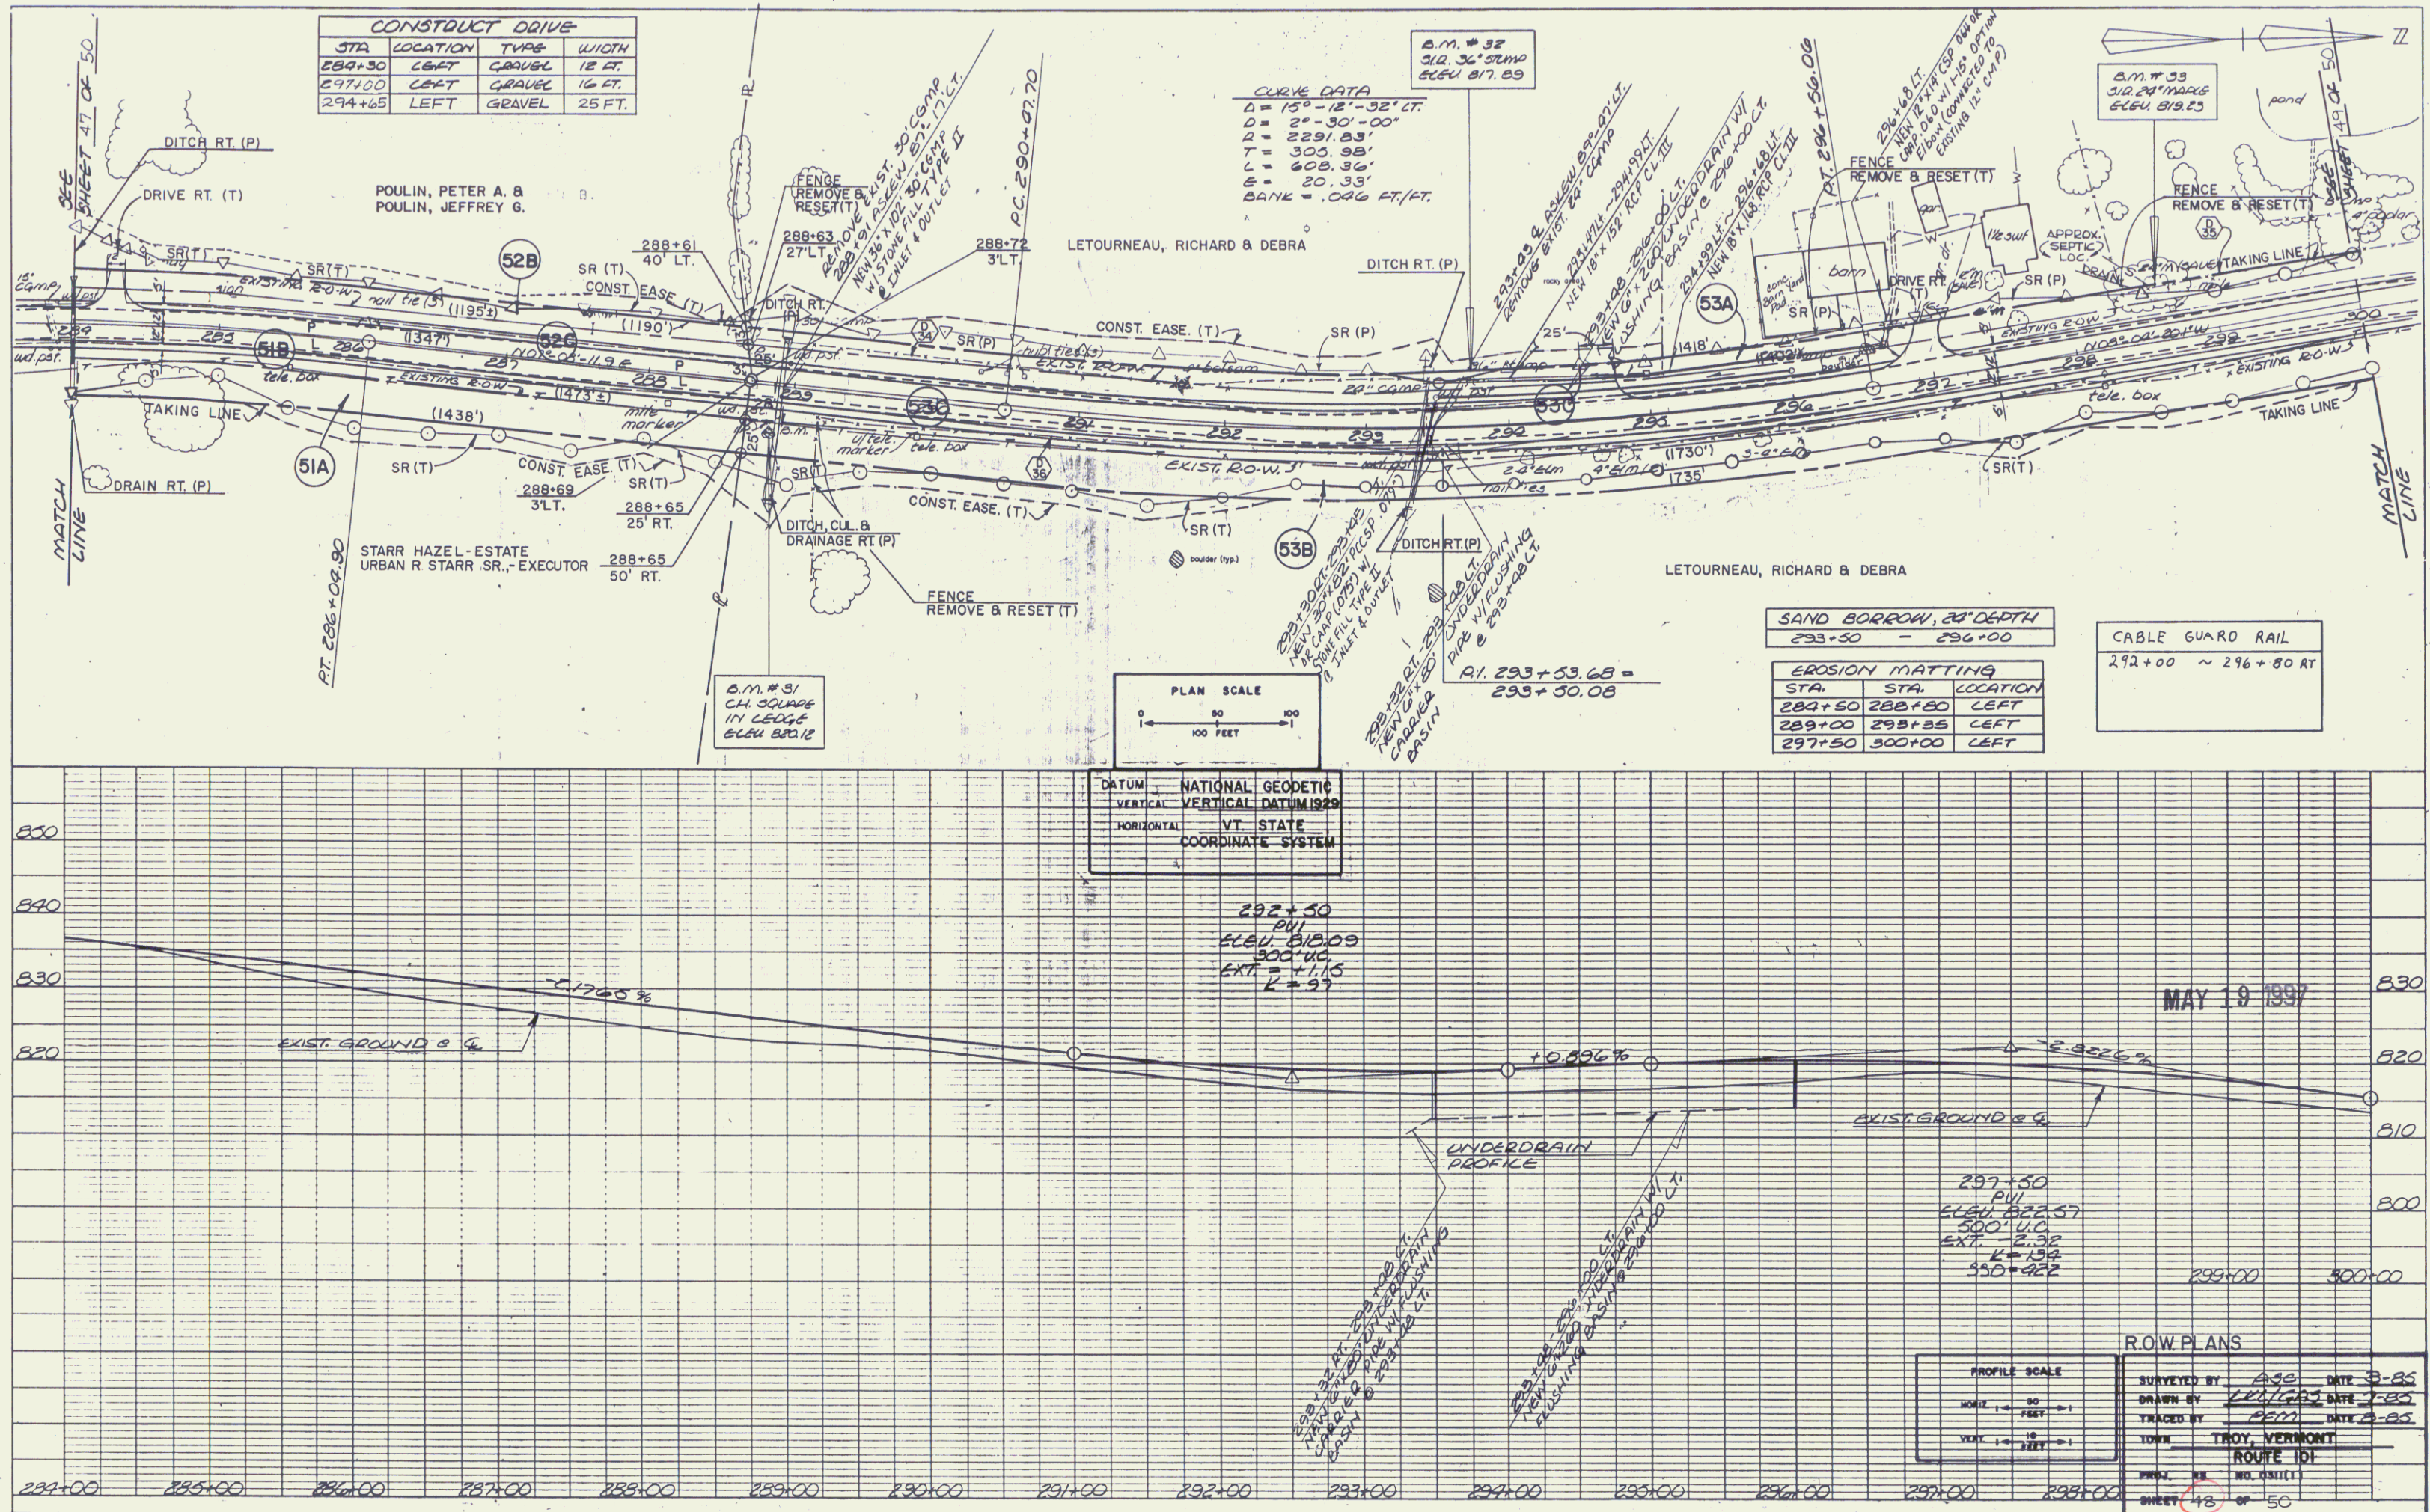


PLAN	NO.
1	1
2	2
3	3
50	50

PROFILE	NO.
1	1
2	2
3	3
50	50

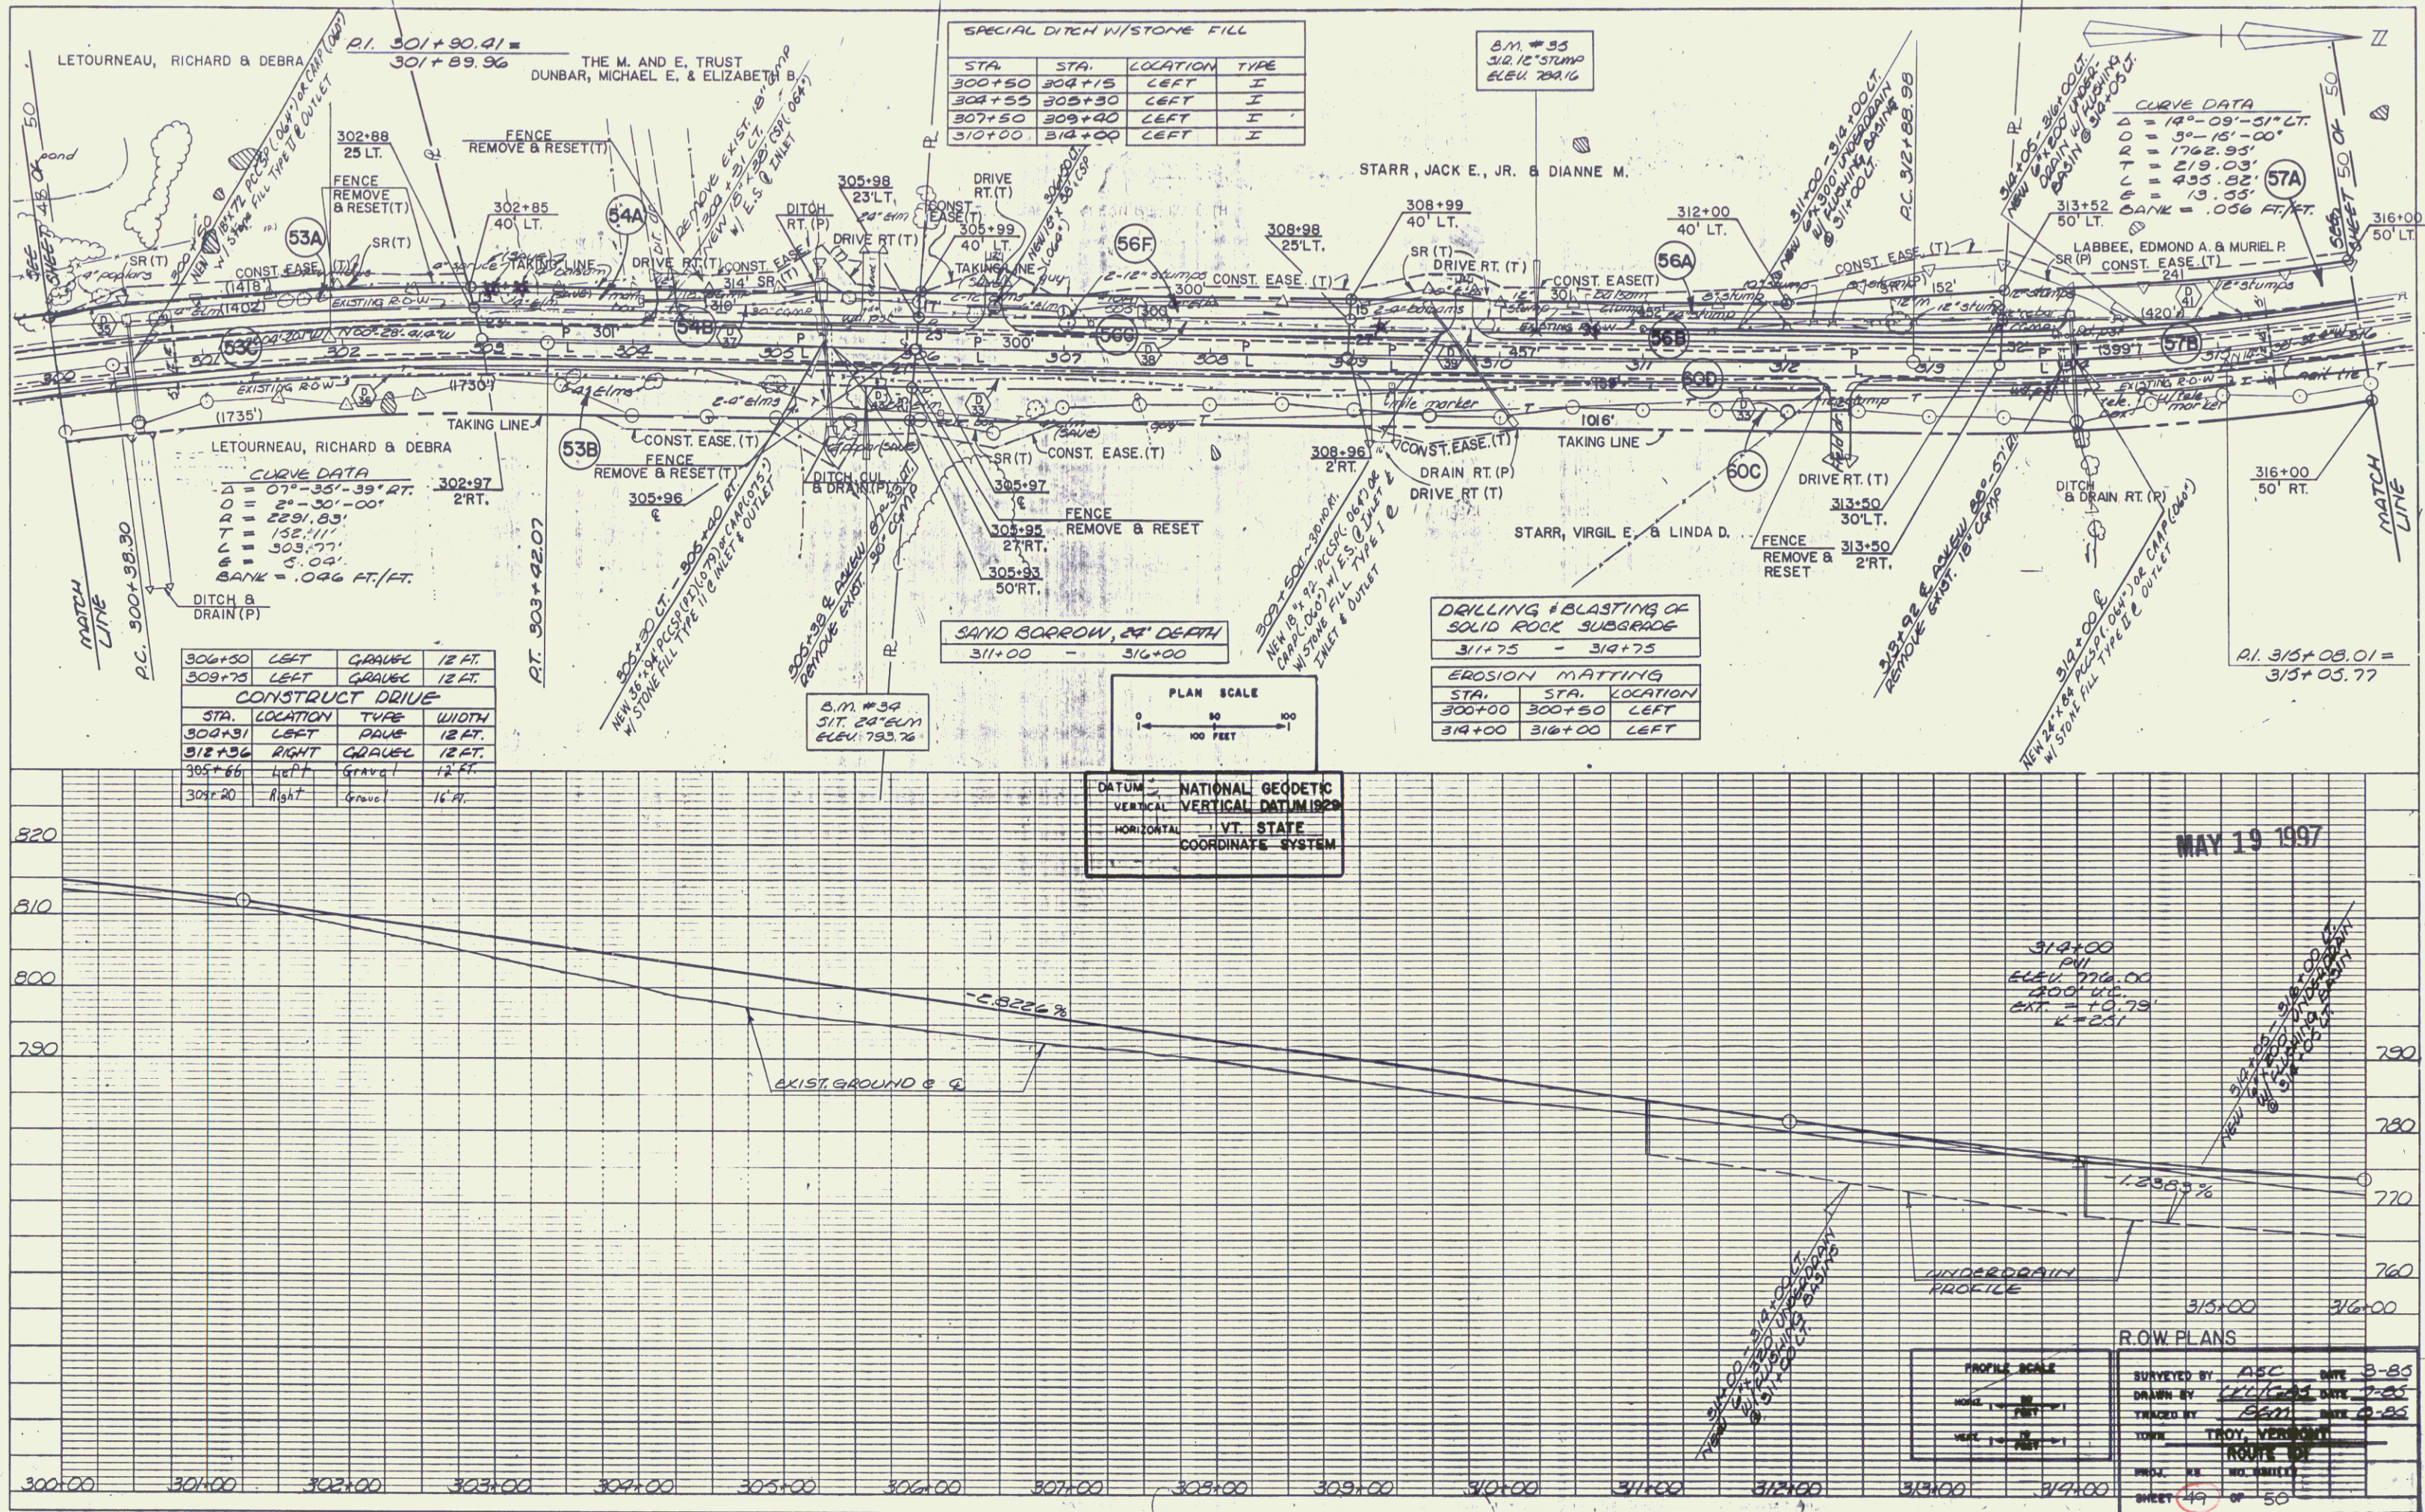


PLAN
DATE
BY
CHECKED
NOTED
NO.

PROFILE
DATE
BY
CHECKED
NOTED
NO.

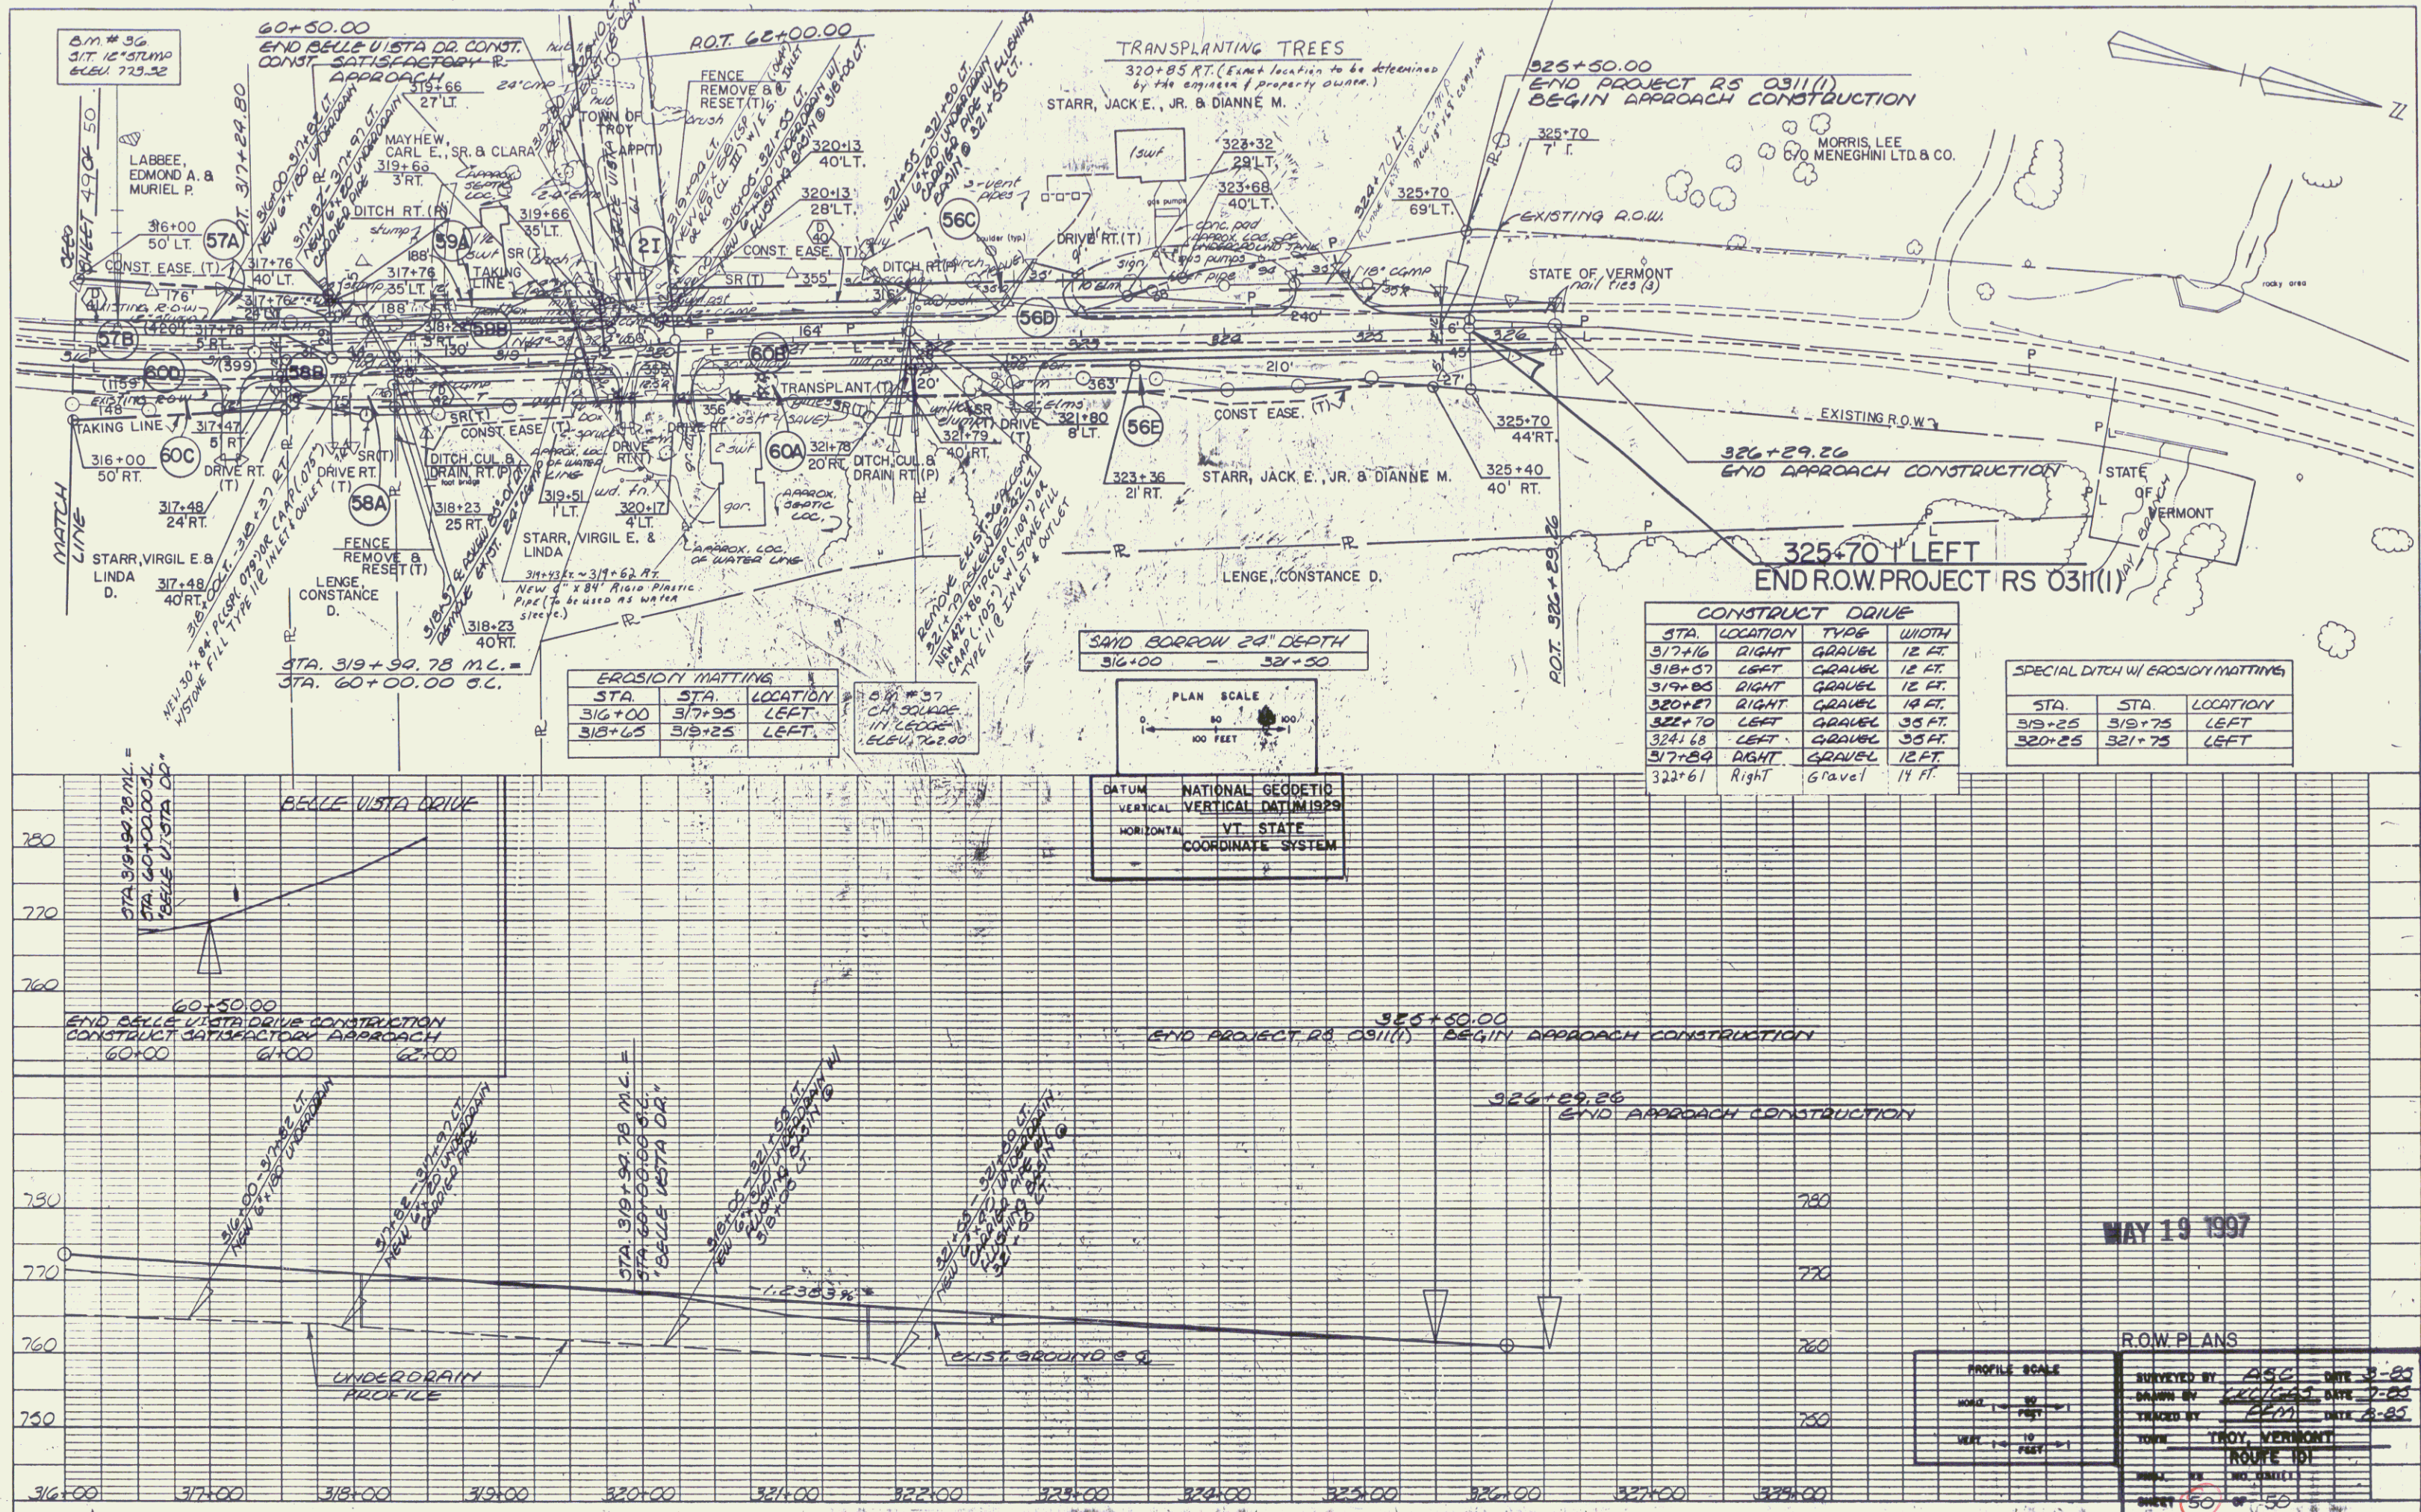

PLAN	DATE	BY	CHK
DESIGNED			
DRAWN			
CHECKED			
APPROVED			
NOTE BOOK			
NO.			

PROFILE	DATE	BY	CHK
DESIGNED			
DRAWN			
CHECKED			
APPROVED			
NOTE BOOK			
NO.			

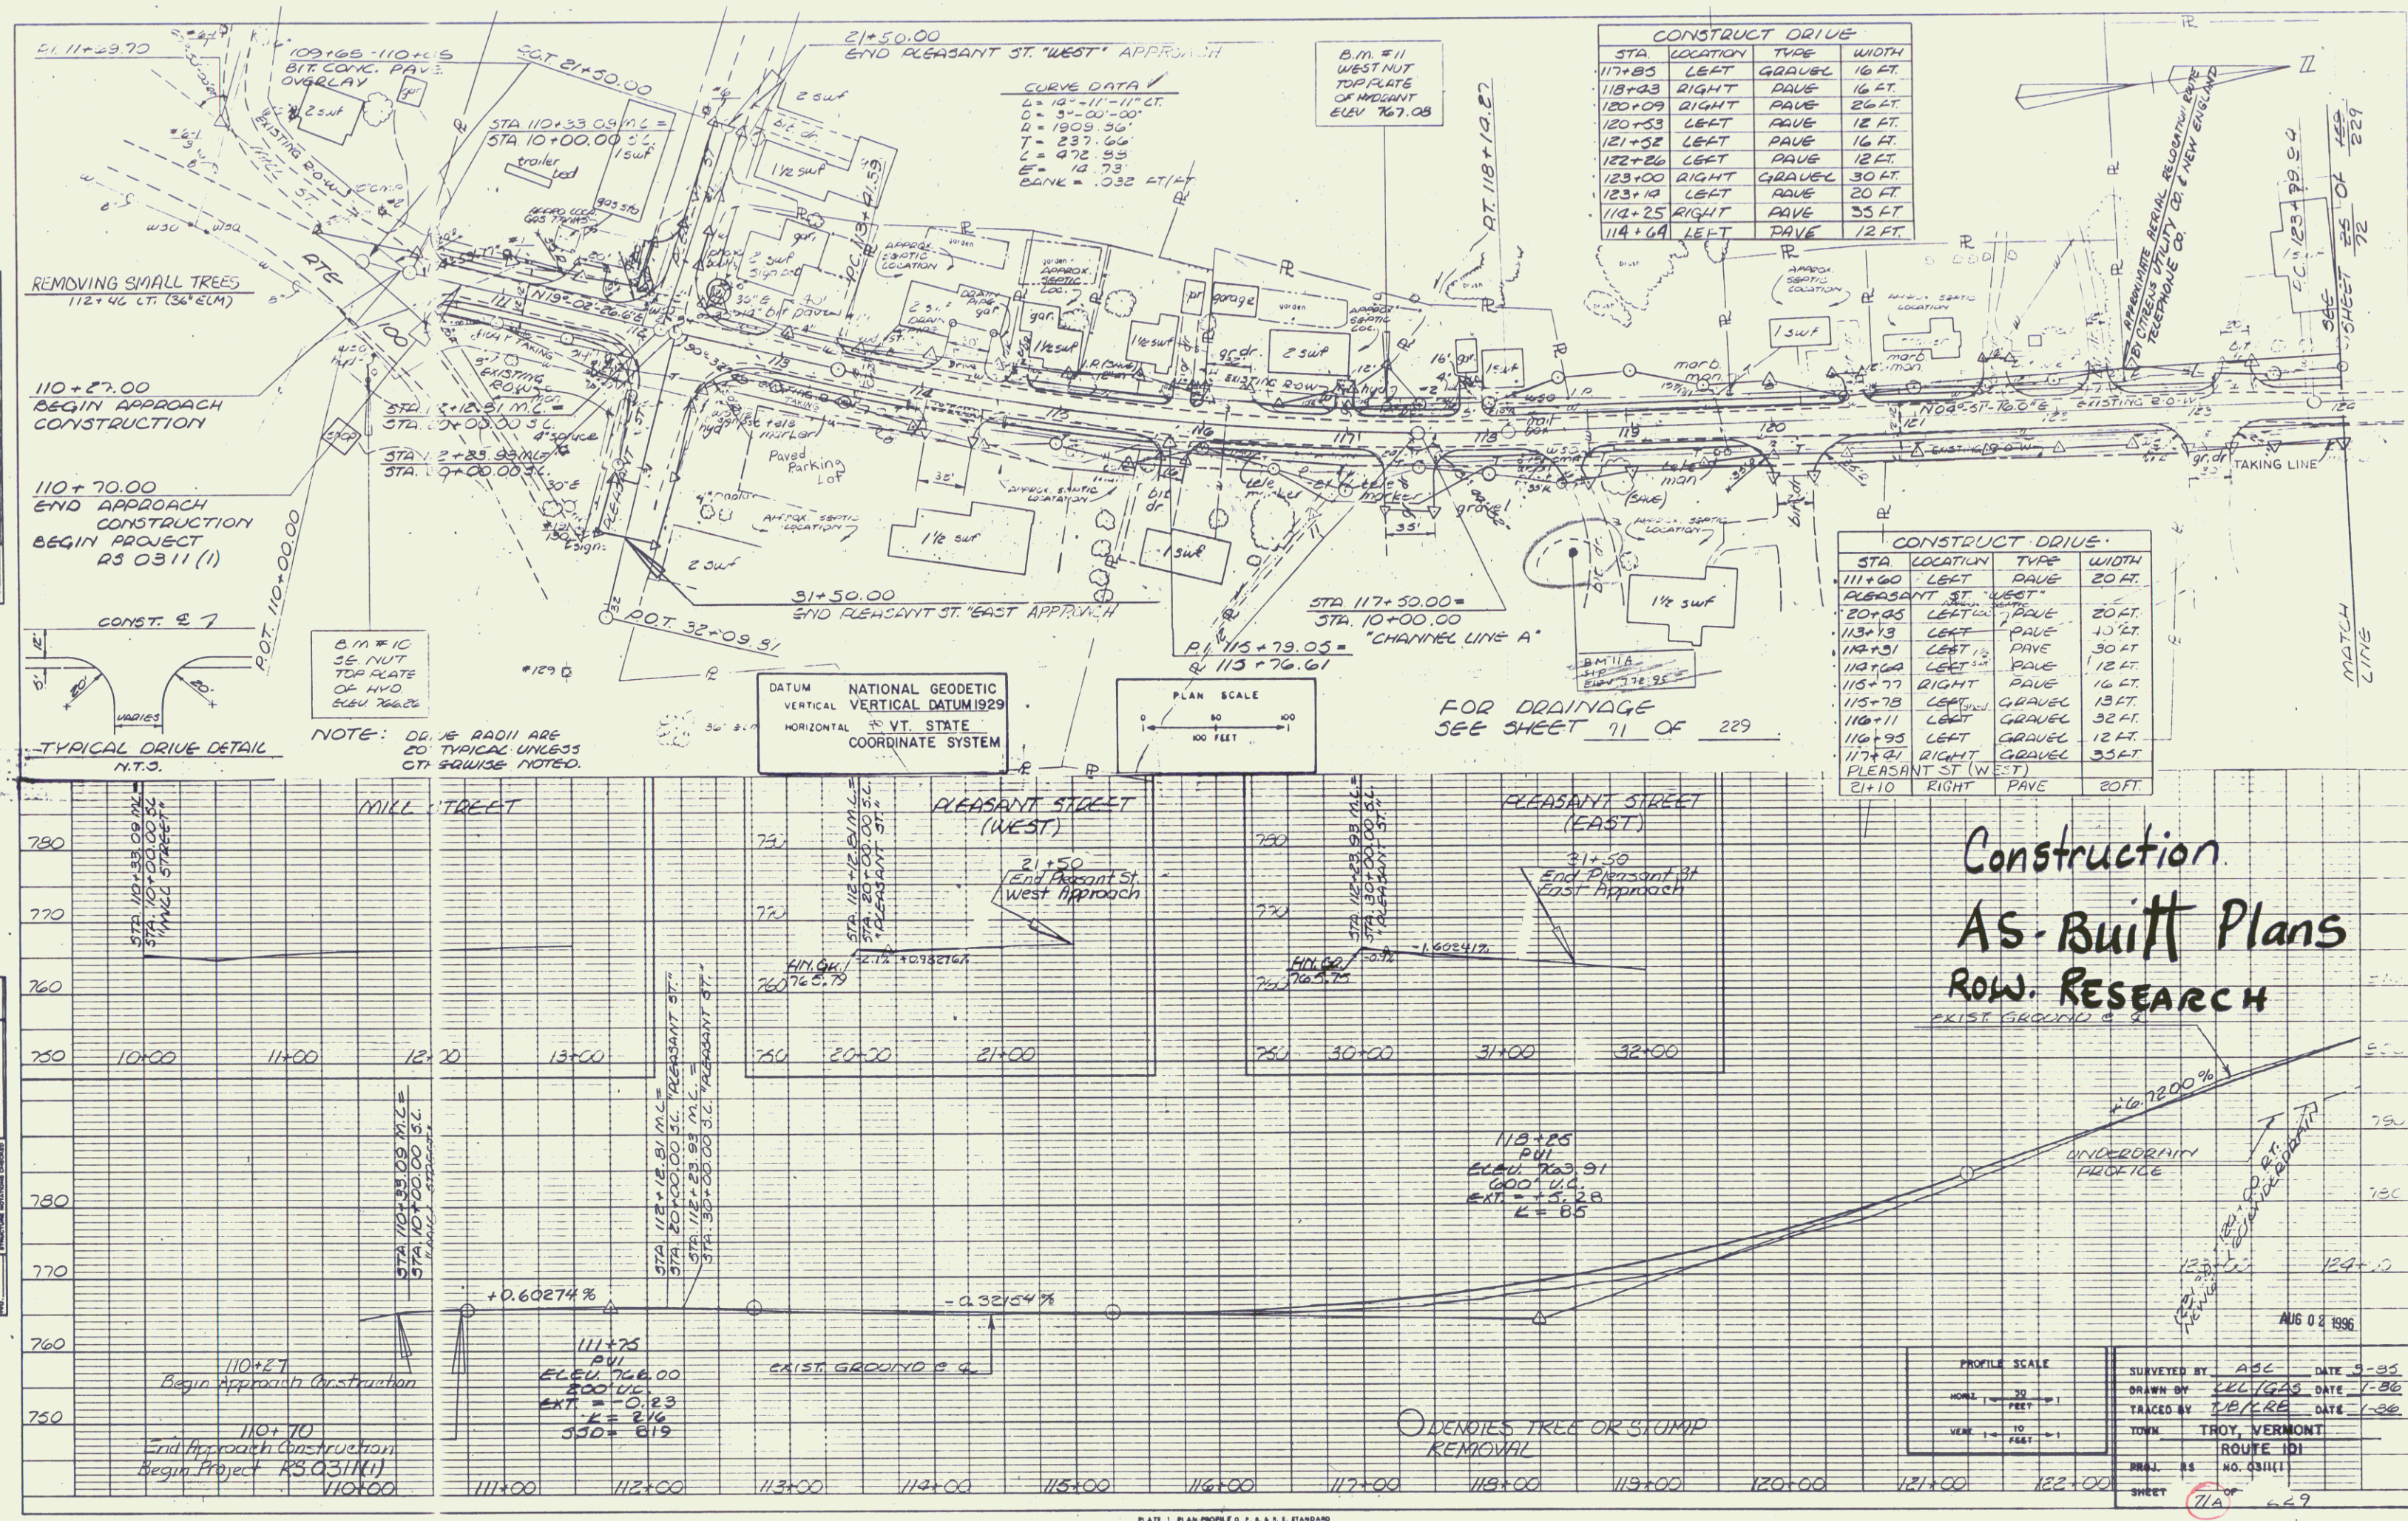

PLAN	DATE
REVISION	BY
NOTE BOOK	NO.

PROFILE	DATE
REVISION	BY
NOTE BOOK	NO.


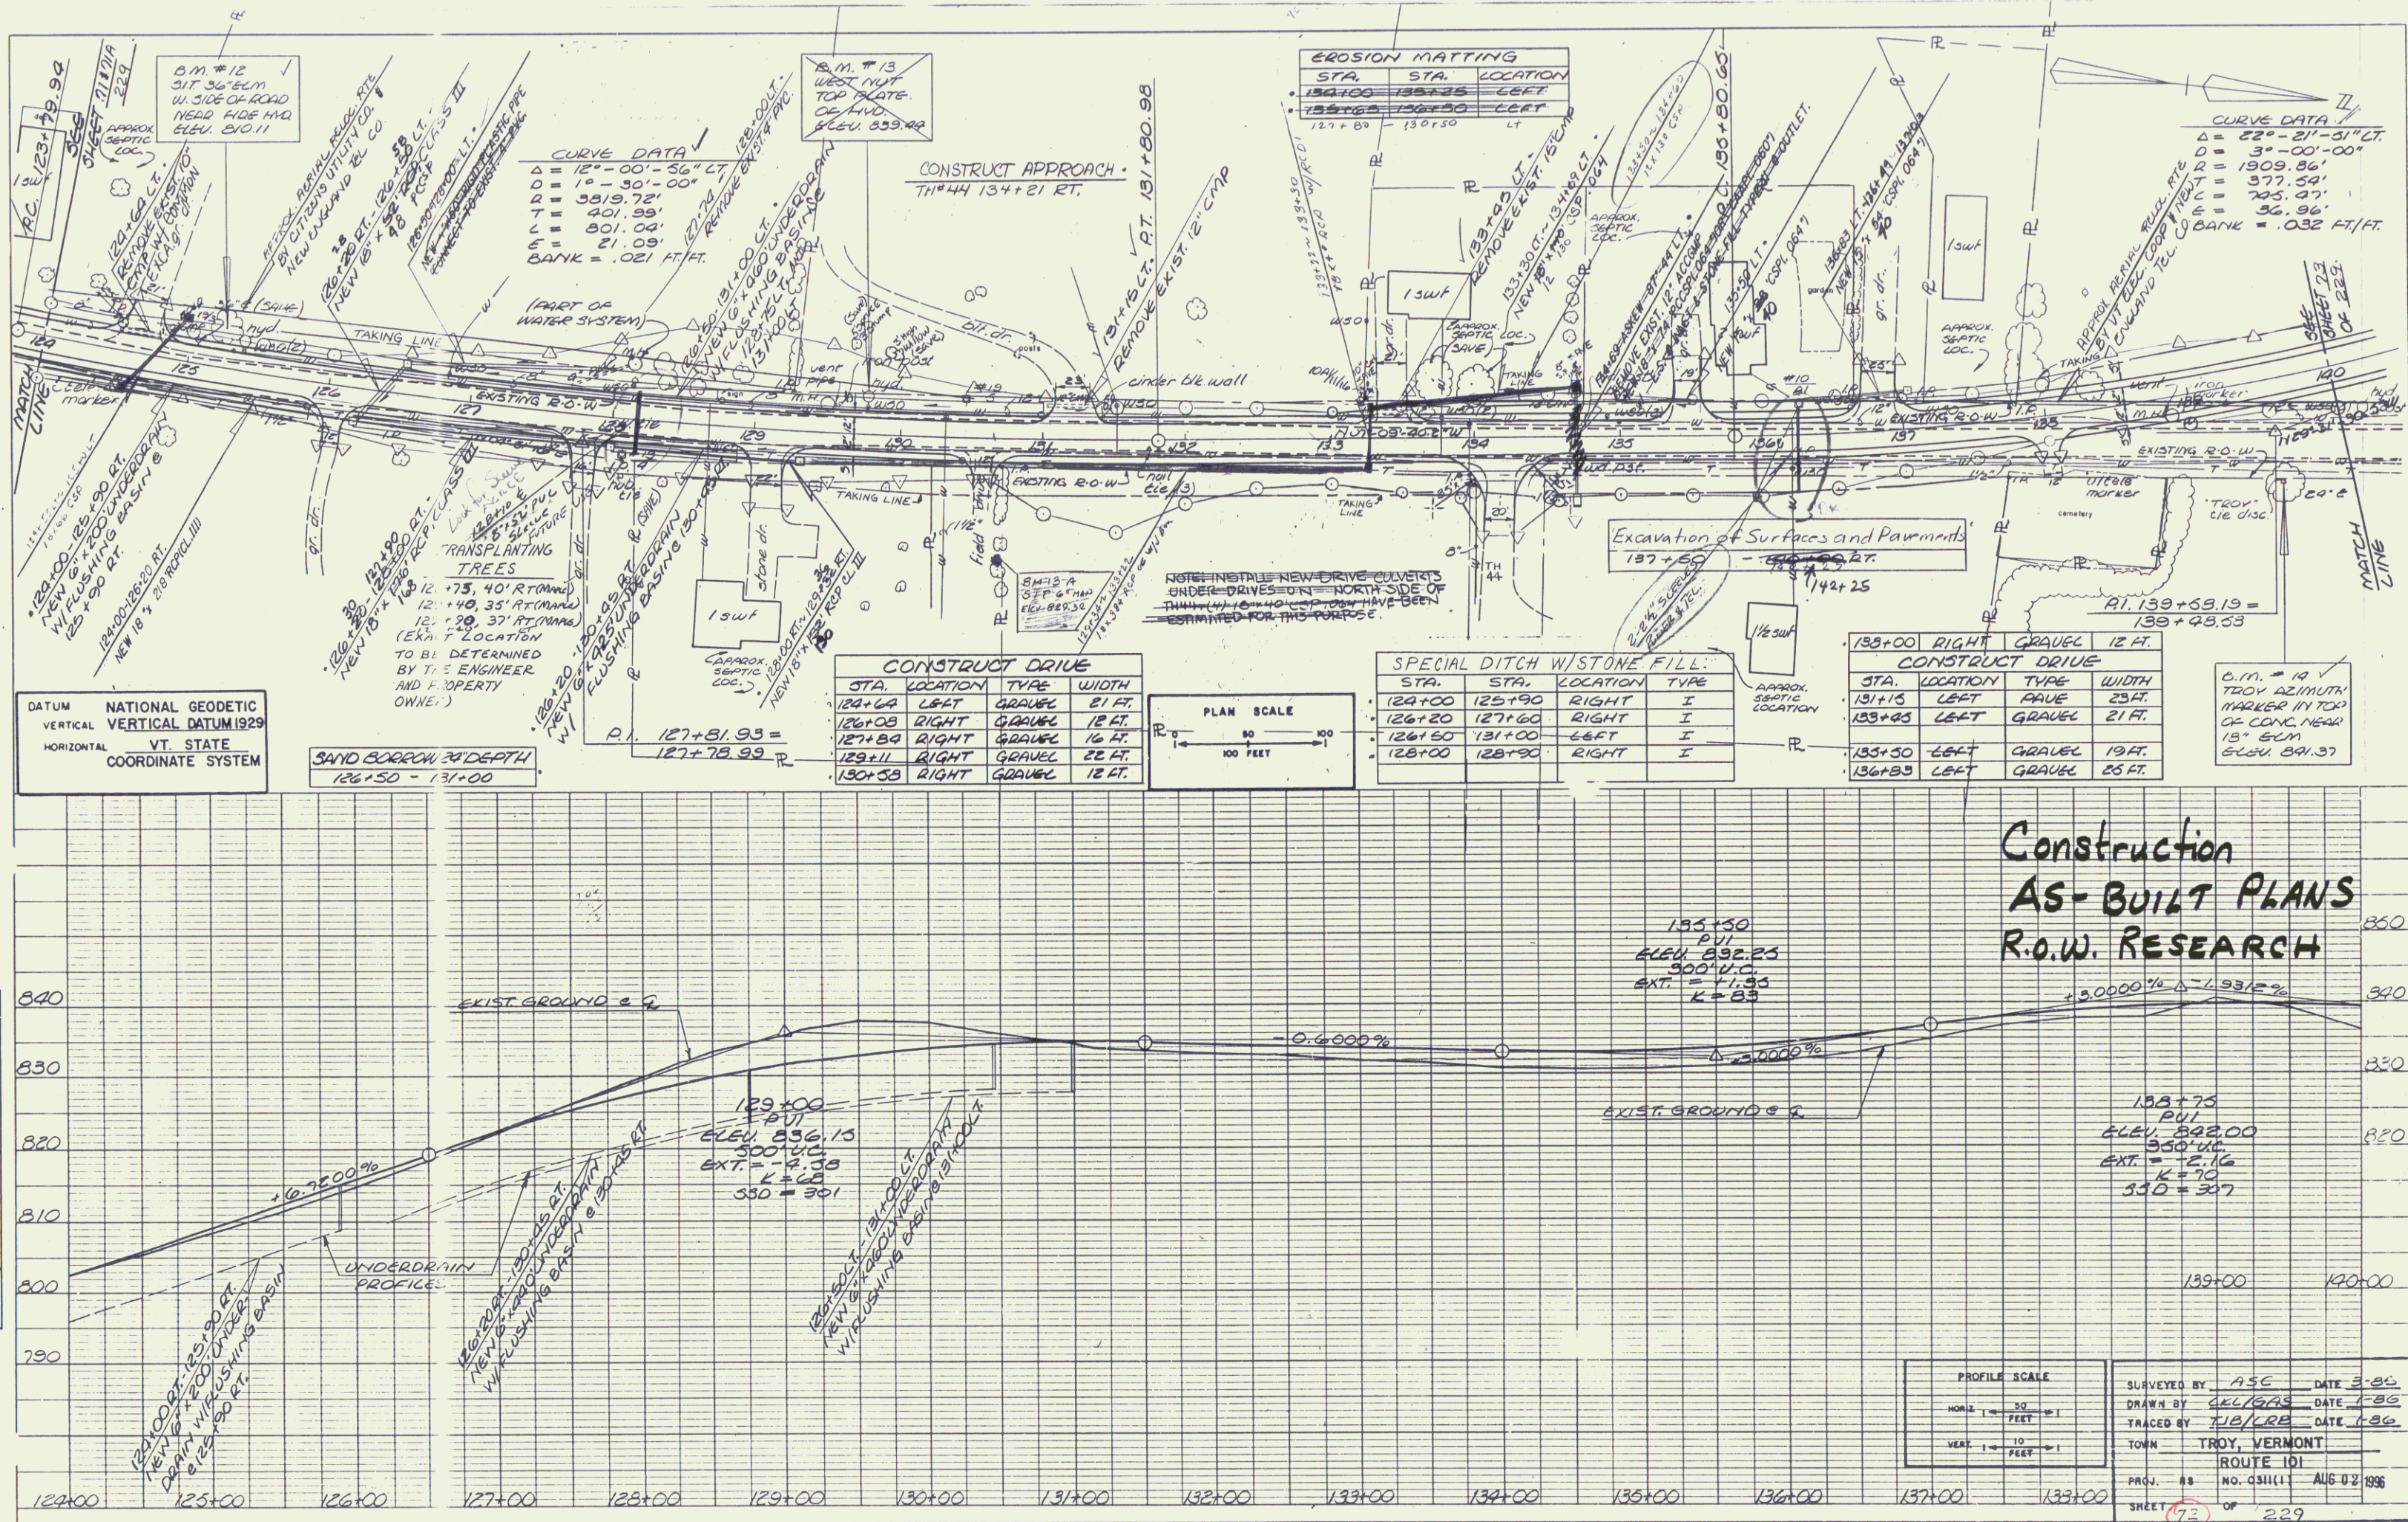


PLATE 1. PLAN PROFILE D. P. & S. E. STANDARD
 DIST. PLAN CORPORATION
 BOSTON, U.S.A.

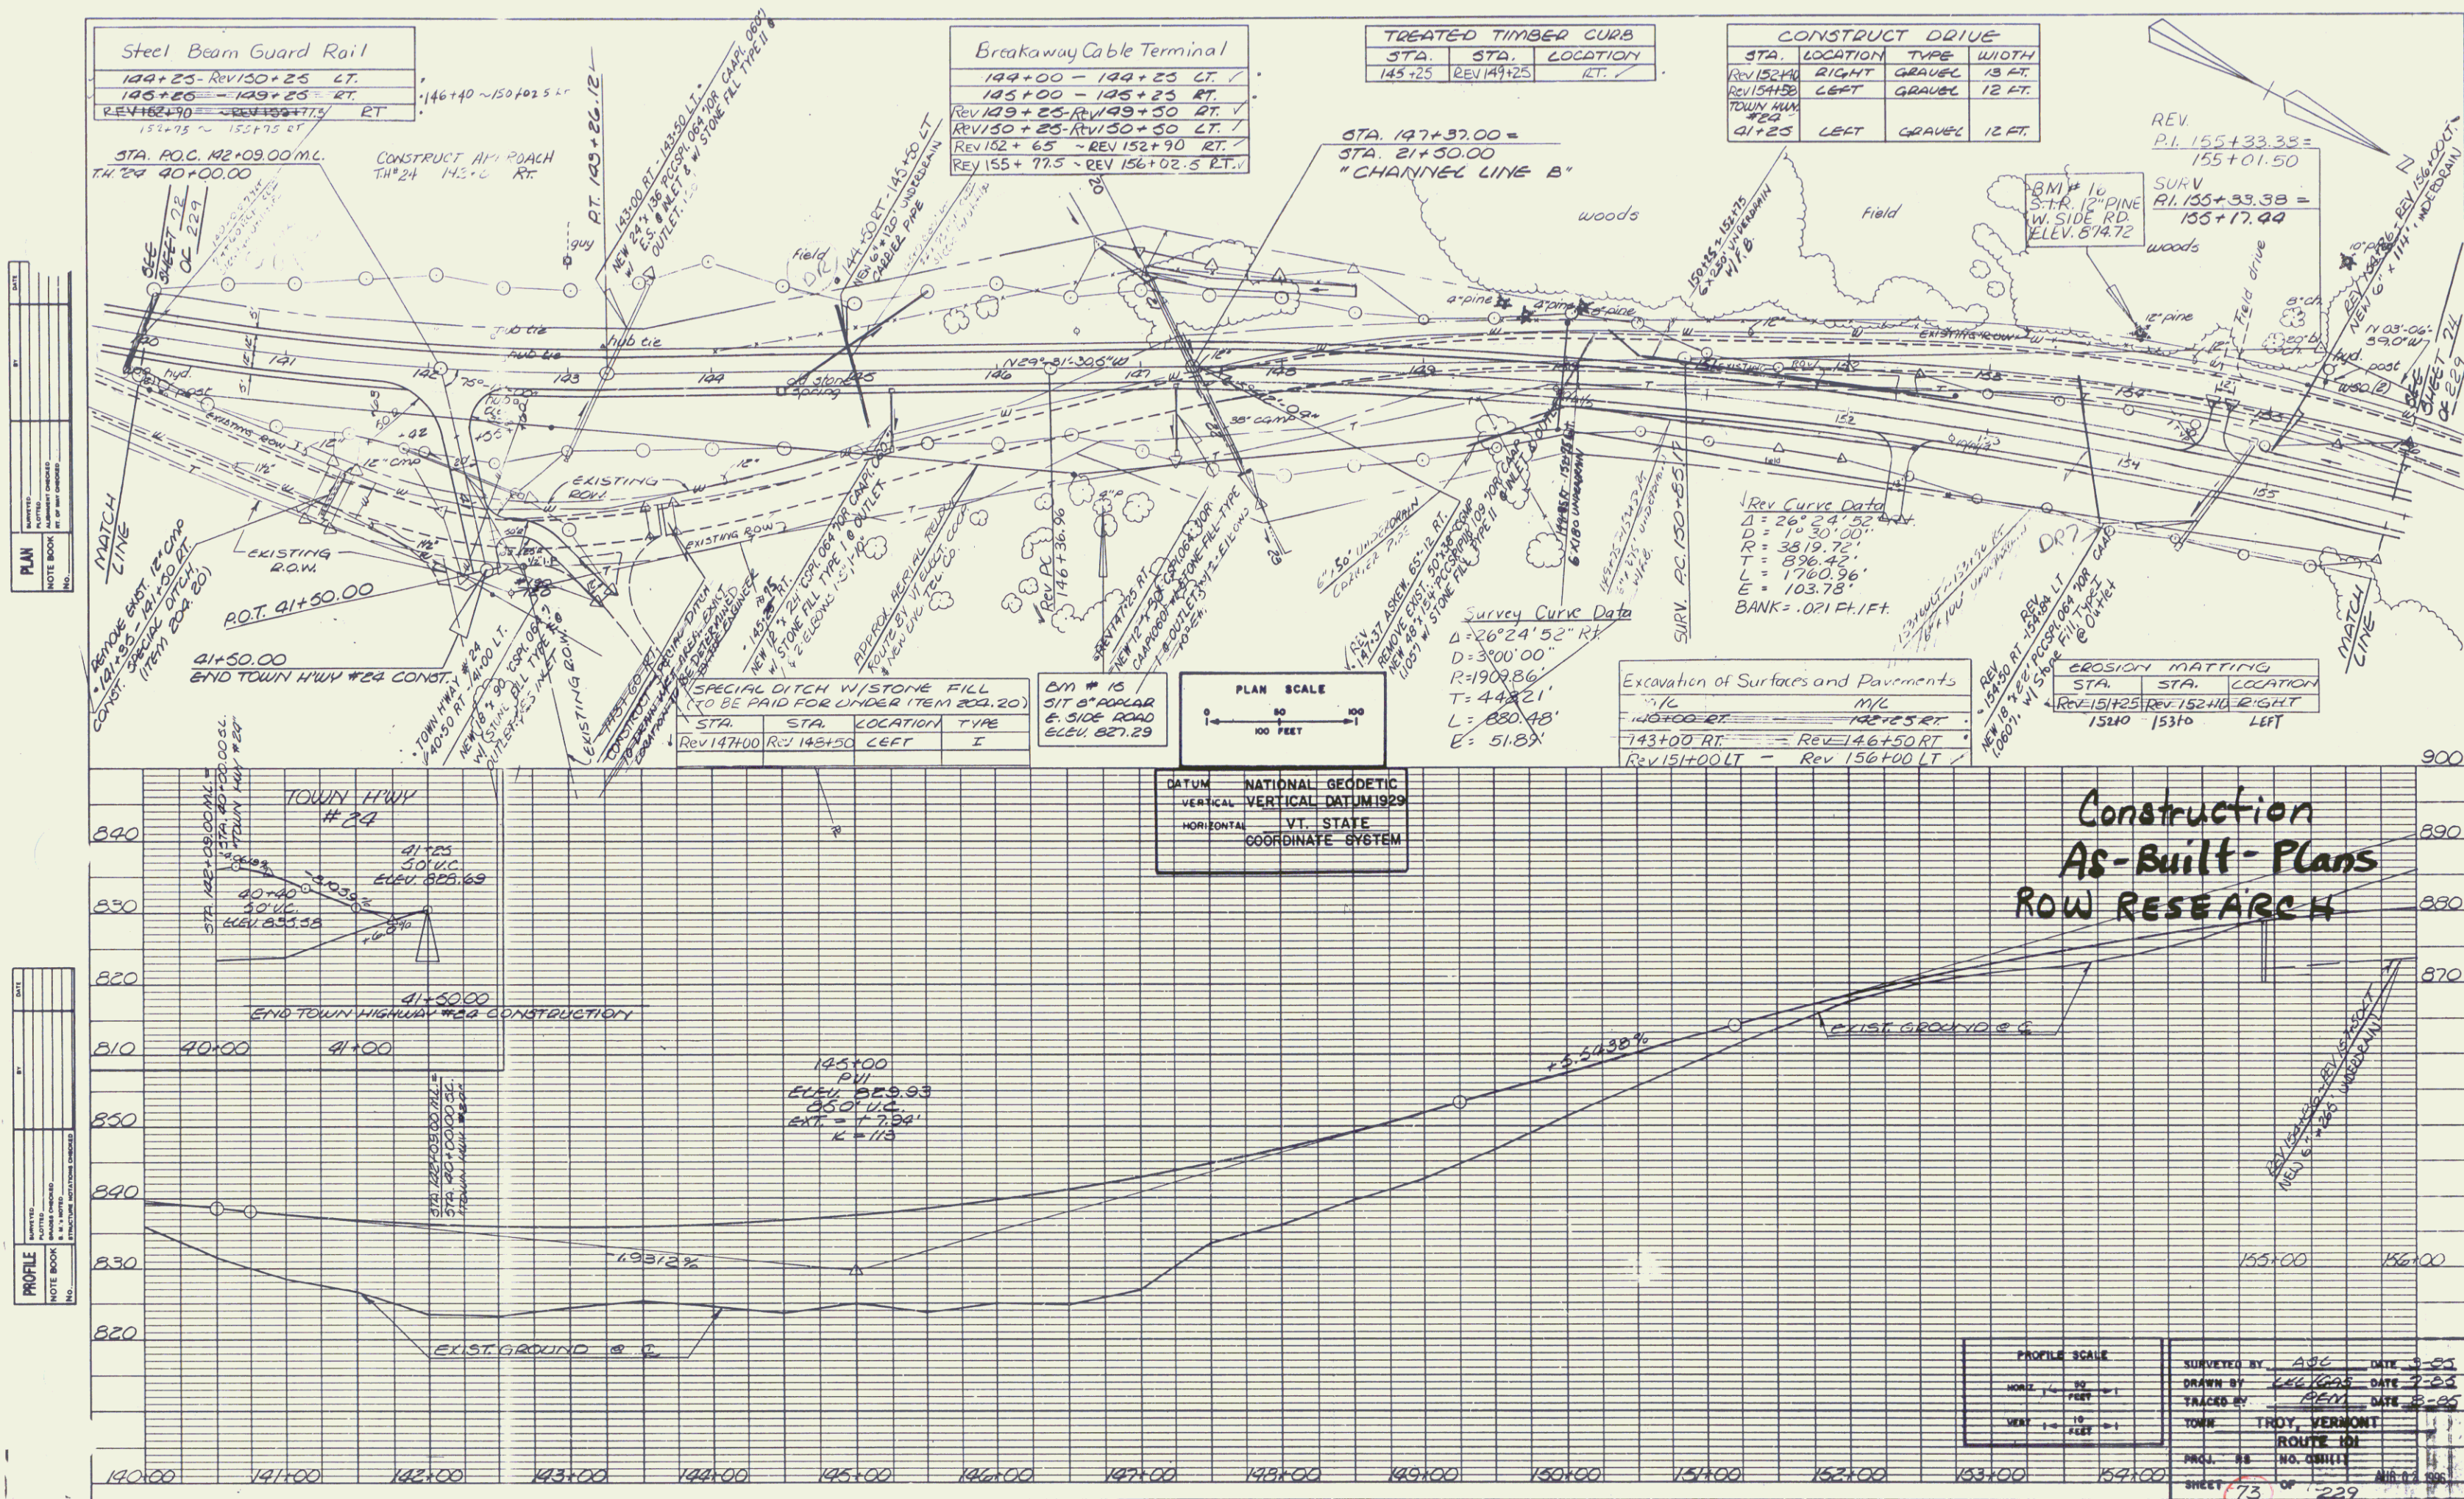

PLAN	DATE	BY
NOTE BOOK		

PROFILE	DATE	BY
NOTE BOOK		



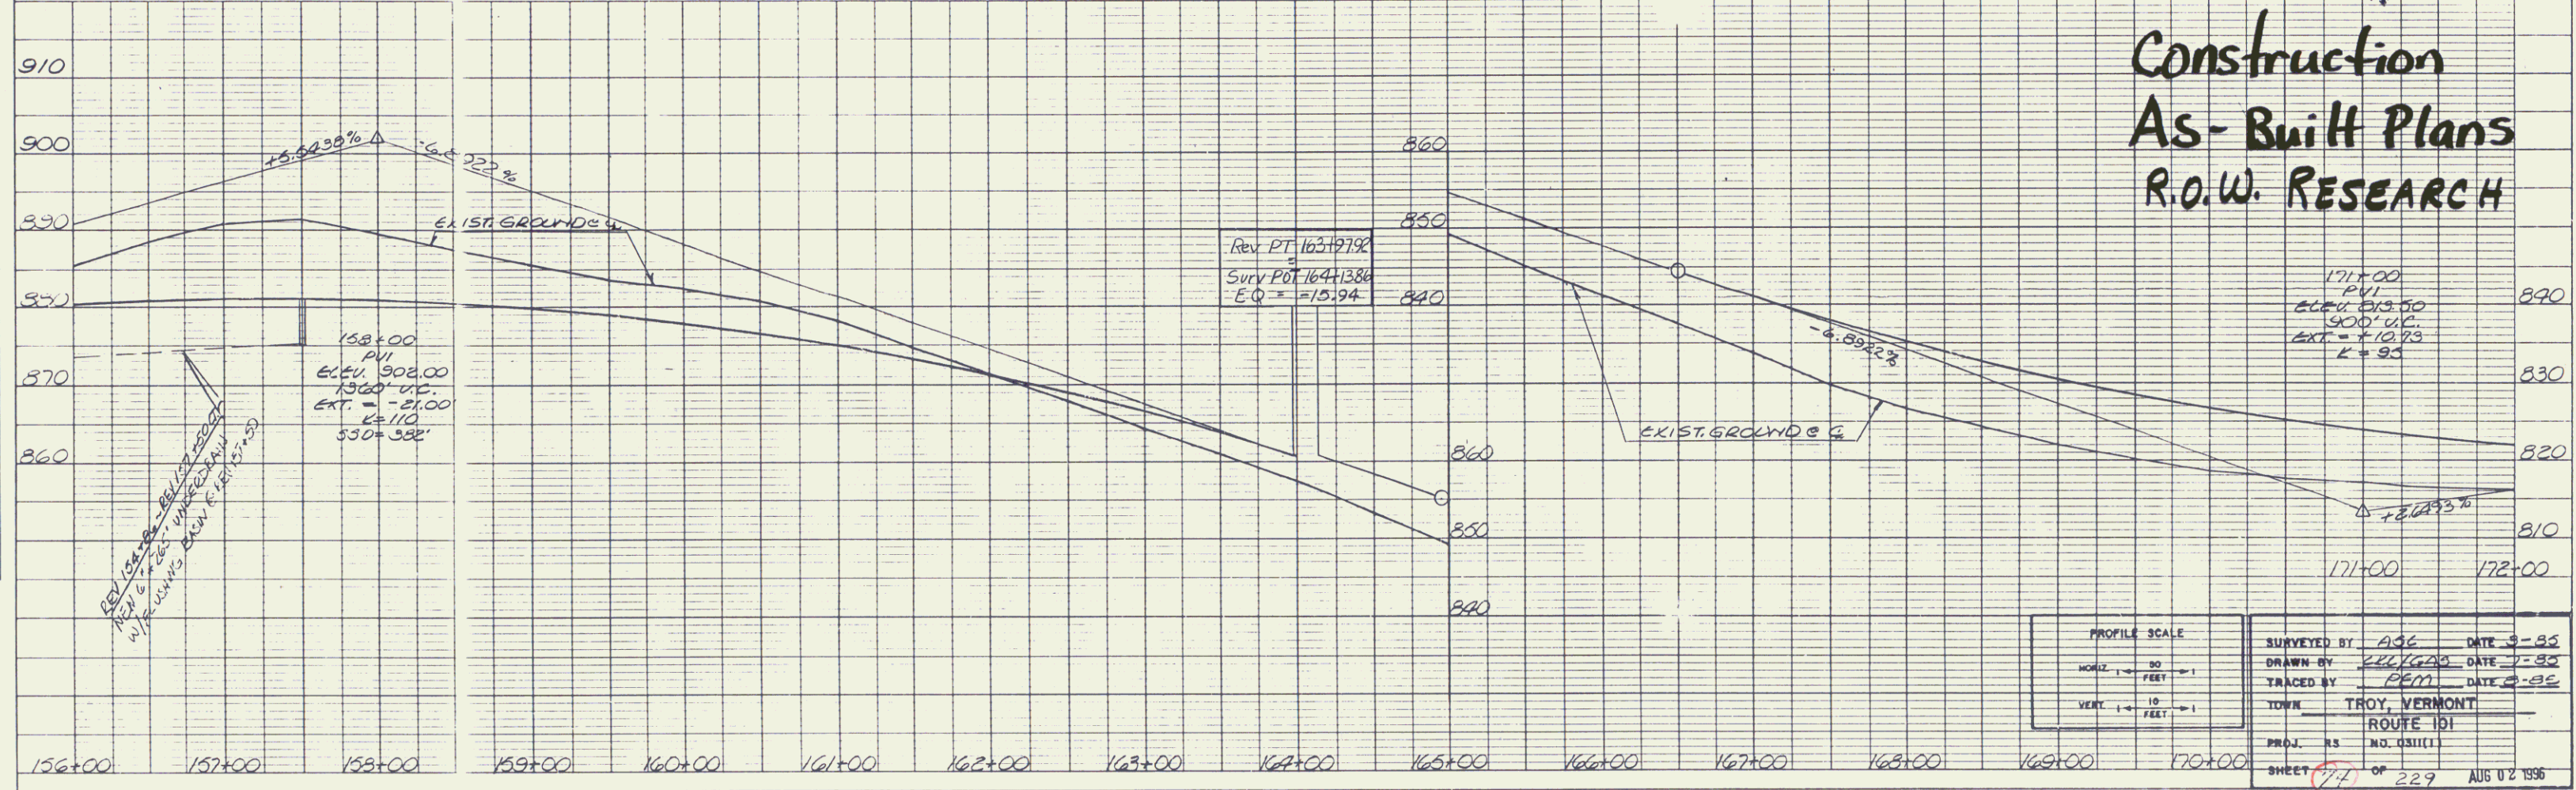


PLATE 1 PLAN/PROFILE D.P. & S.I. STANDARD
OF FOUR CORPORATION
PRINTED IN U.S.A.

56

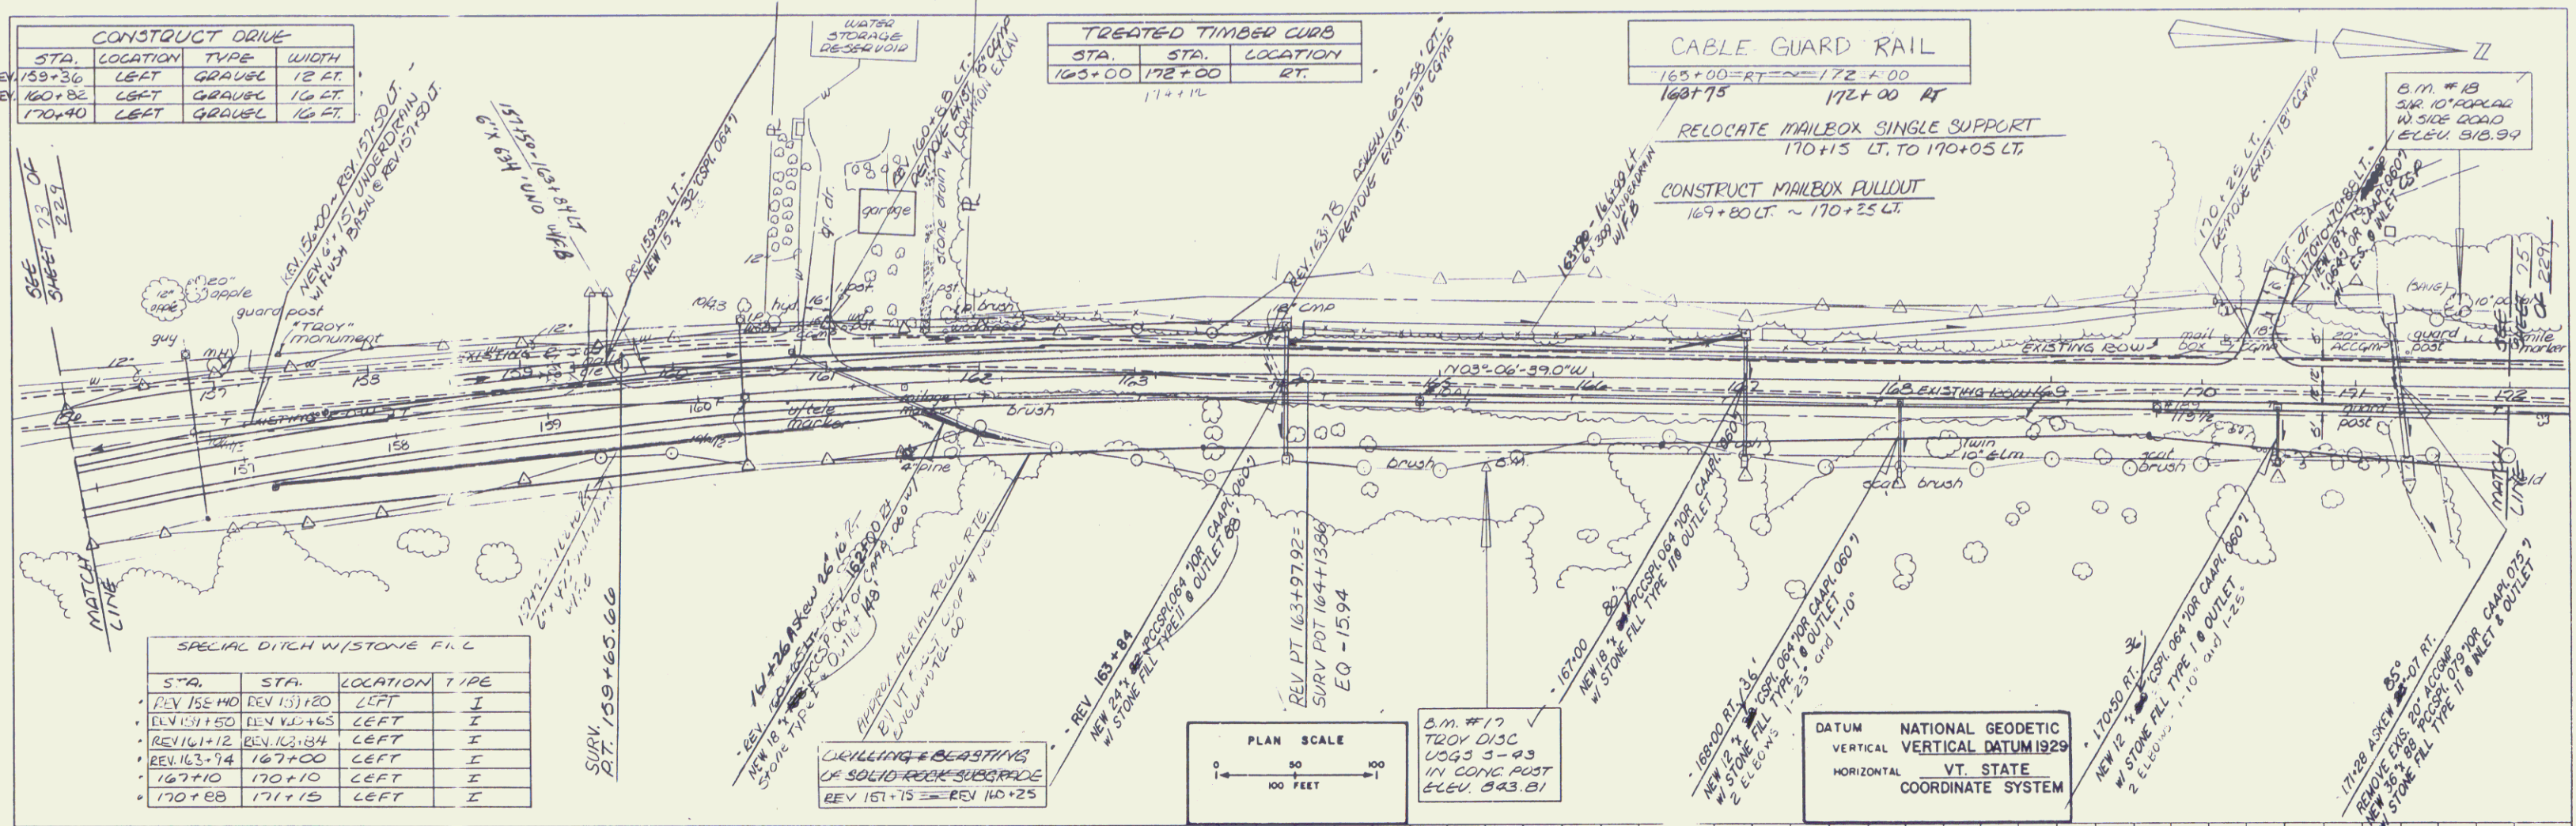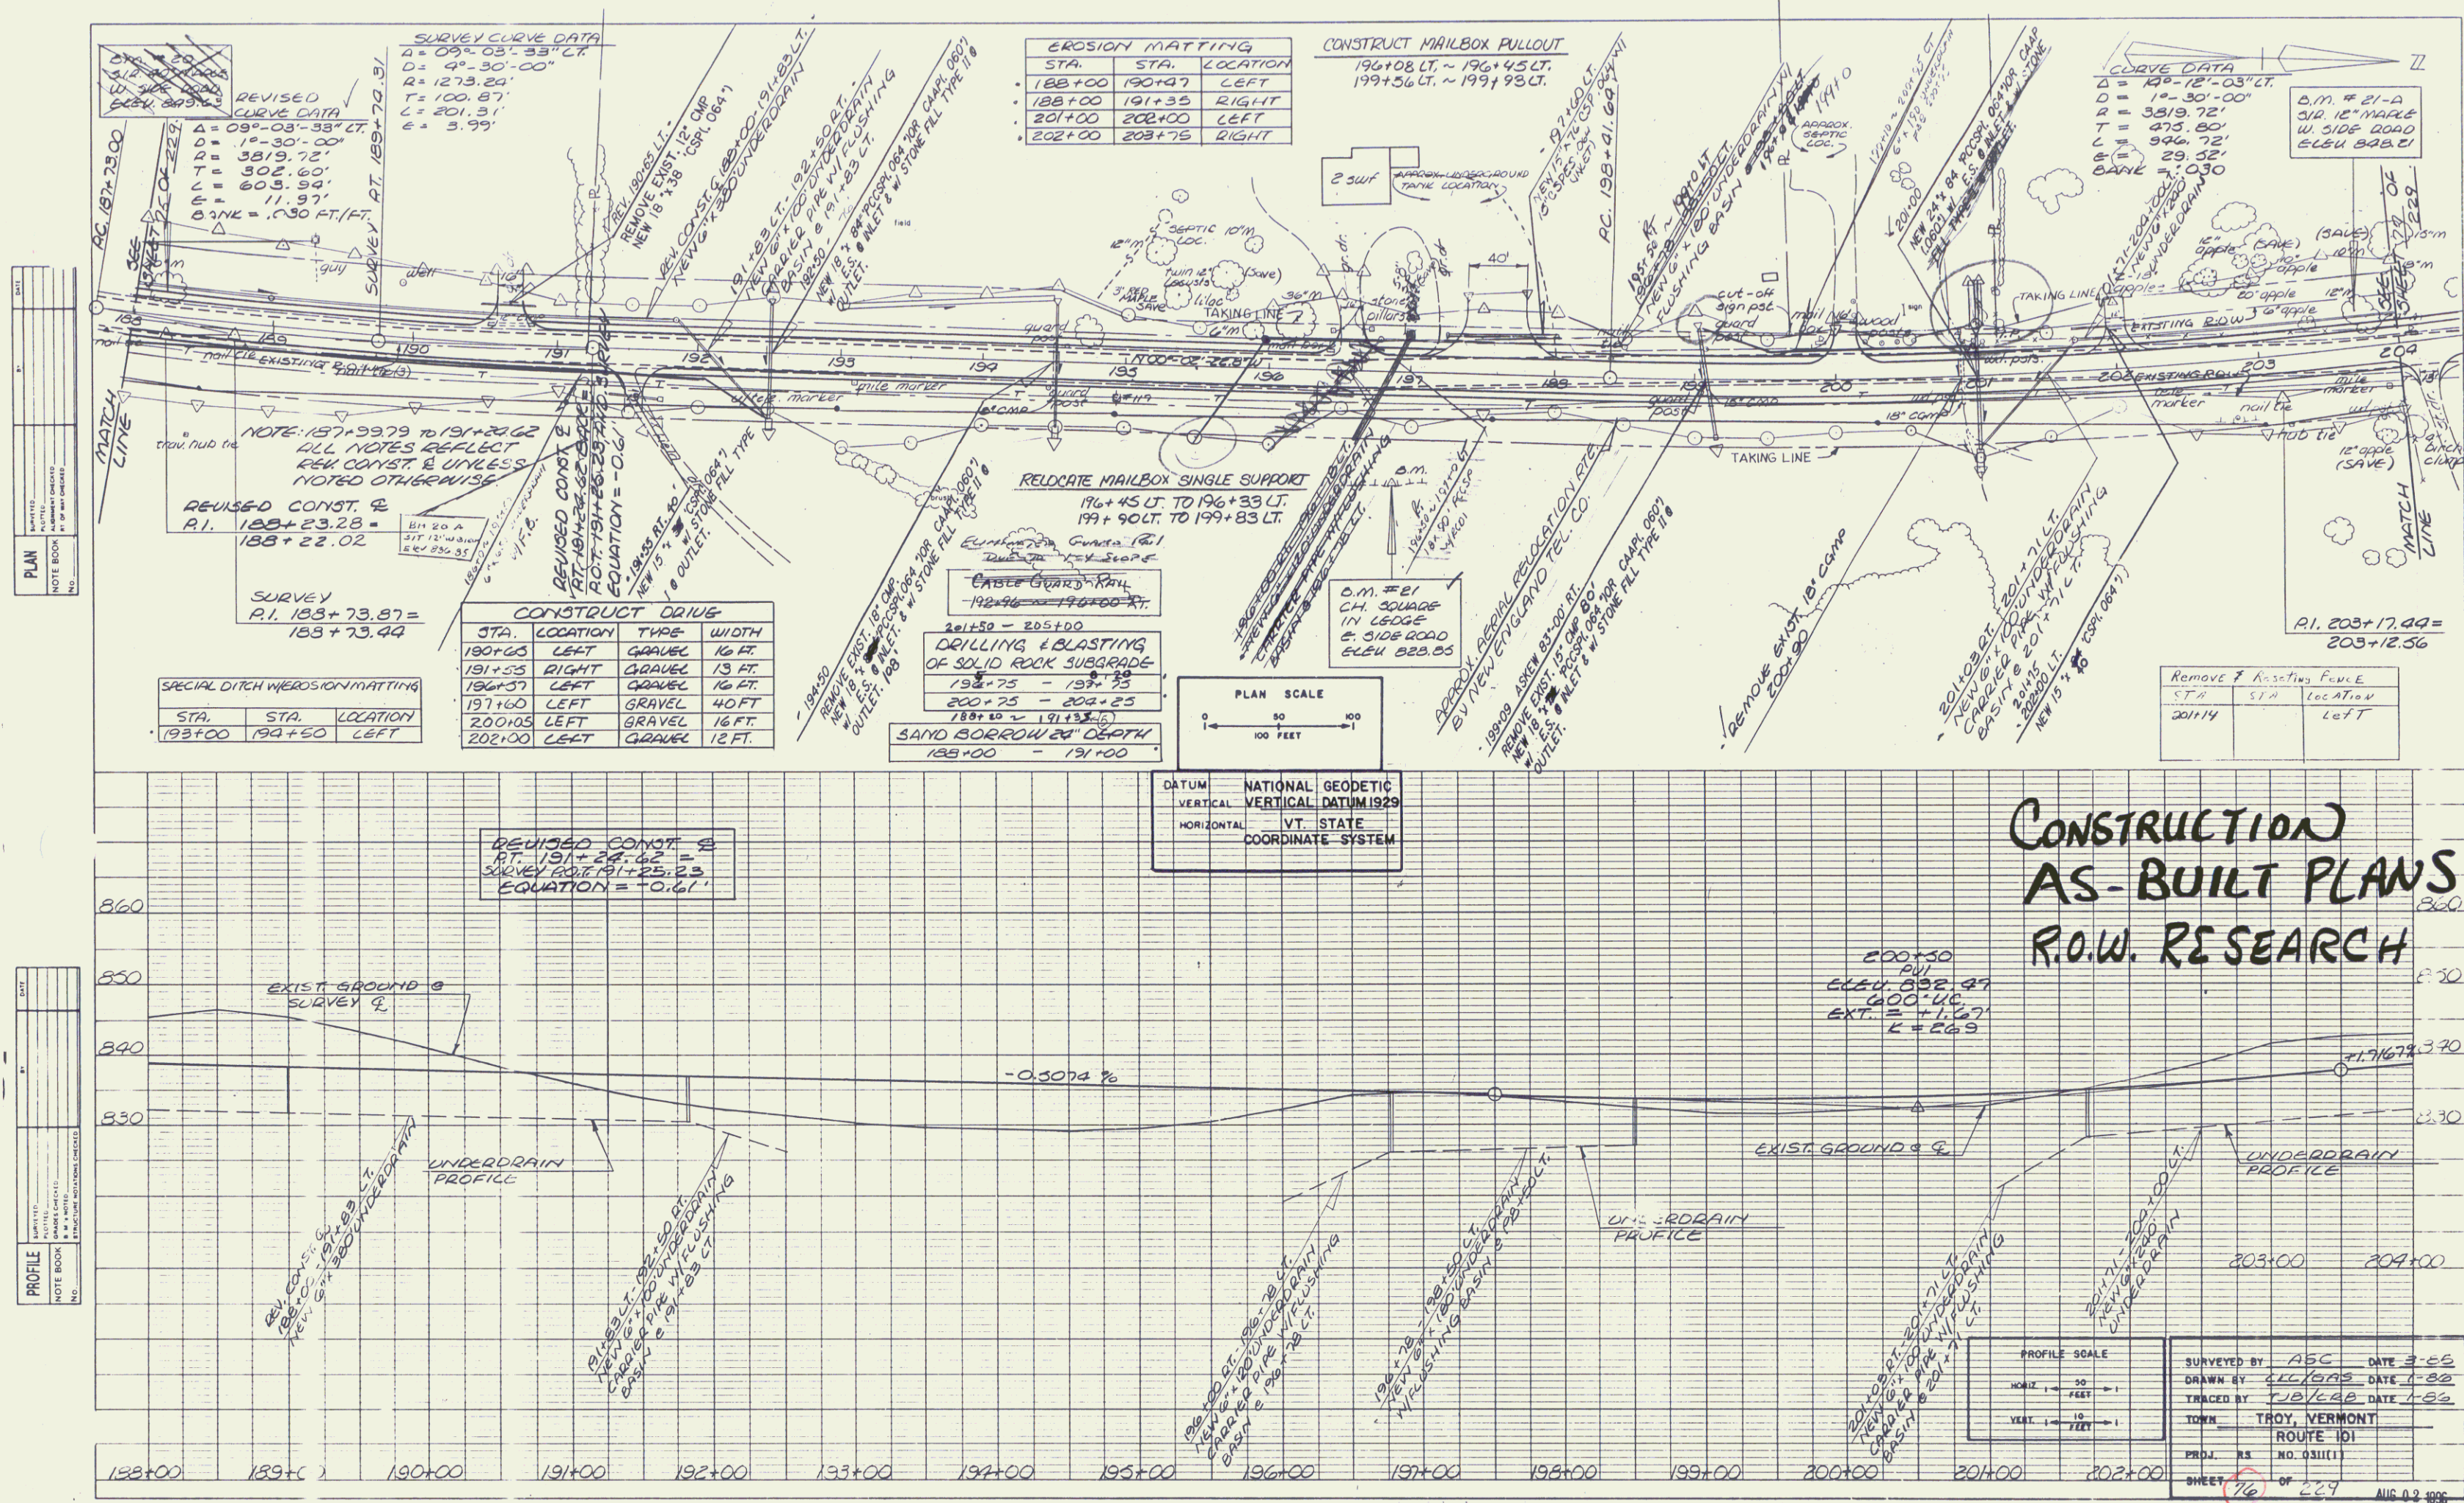


CONSTRUCTION AS-BUILT PLANS R.O.W. RESEARCH

STA.	STA.	LOCATION
188+00	190+47	LEFT
188+00	191+35	RIGHT
201+00	202+00	LEFT
202+00	203+75	RIGHT

STA.	LOCATION	TYPE	WIDTH
188+00	LEFT	GRAVEL	10 FT.
191+55	RIGHT	GRAVEL	13 FT.
196+57	LEFT	GRAVEL	16 FT.
197+60	LEFT	GRAVEL	40 FT.
200+03	LEFT	GRAVEL	16 FT.
202+00	LEFT	GRAVEL	12 FT.



DATUM NATIONAL GEODETIC
VERTICAL VERTICAL DATUM 1929
HORIZONTAL VT. STATE
COORDINATE SYSTEM

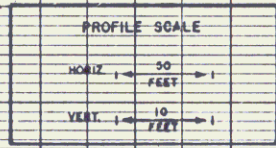

SURVEYED BY	ABC	DATE	3-86
DRAWN BY	JCB/CRB	DATE	1-88
TRACED BY	JCB/CRB	DATE	1-88
TOWN	TROY, VERMONT		
ROUTE	101		
PROJECT NO.	0311(1)		
SHEET	16	OF	229
AUG 02 1986			

PLAN	DATE
NO.	
REVISIONS	
BY	DATE
NO.	

PROFILE	DATE
NO.	
REVISIONS	
BY	DATE
NO.	

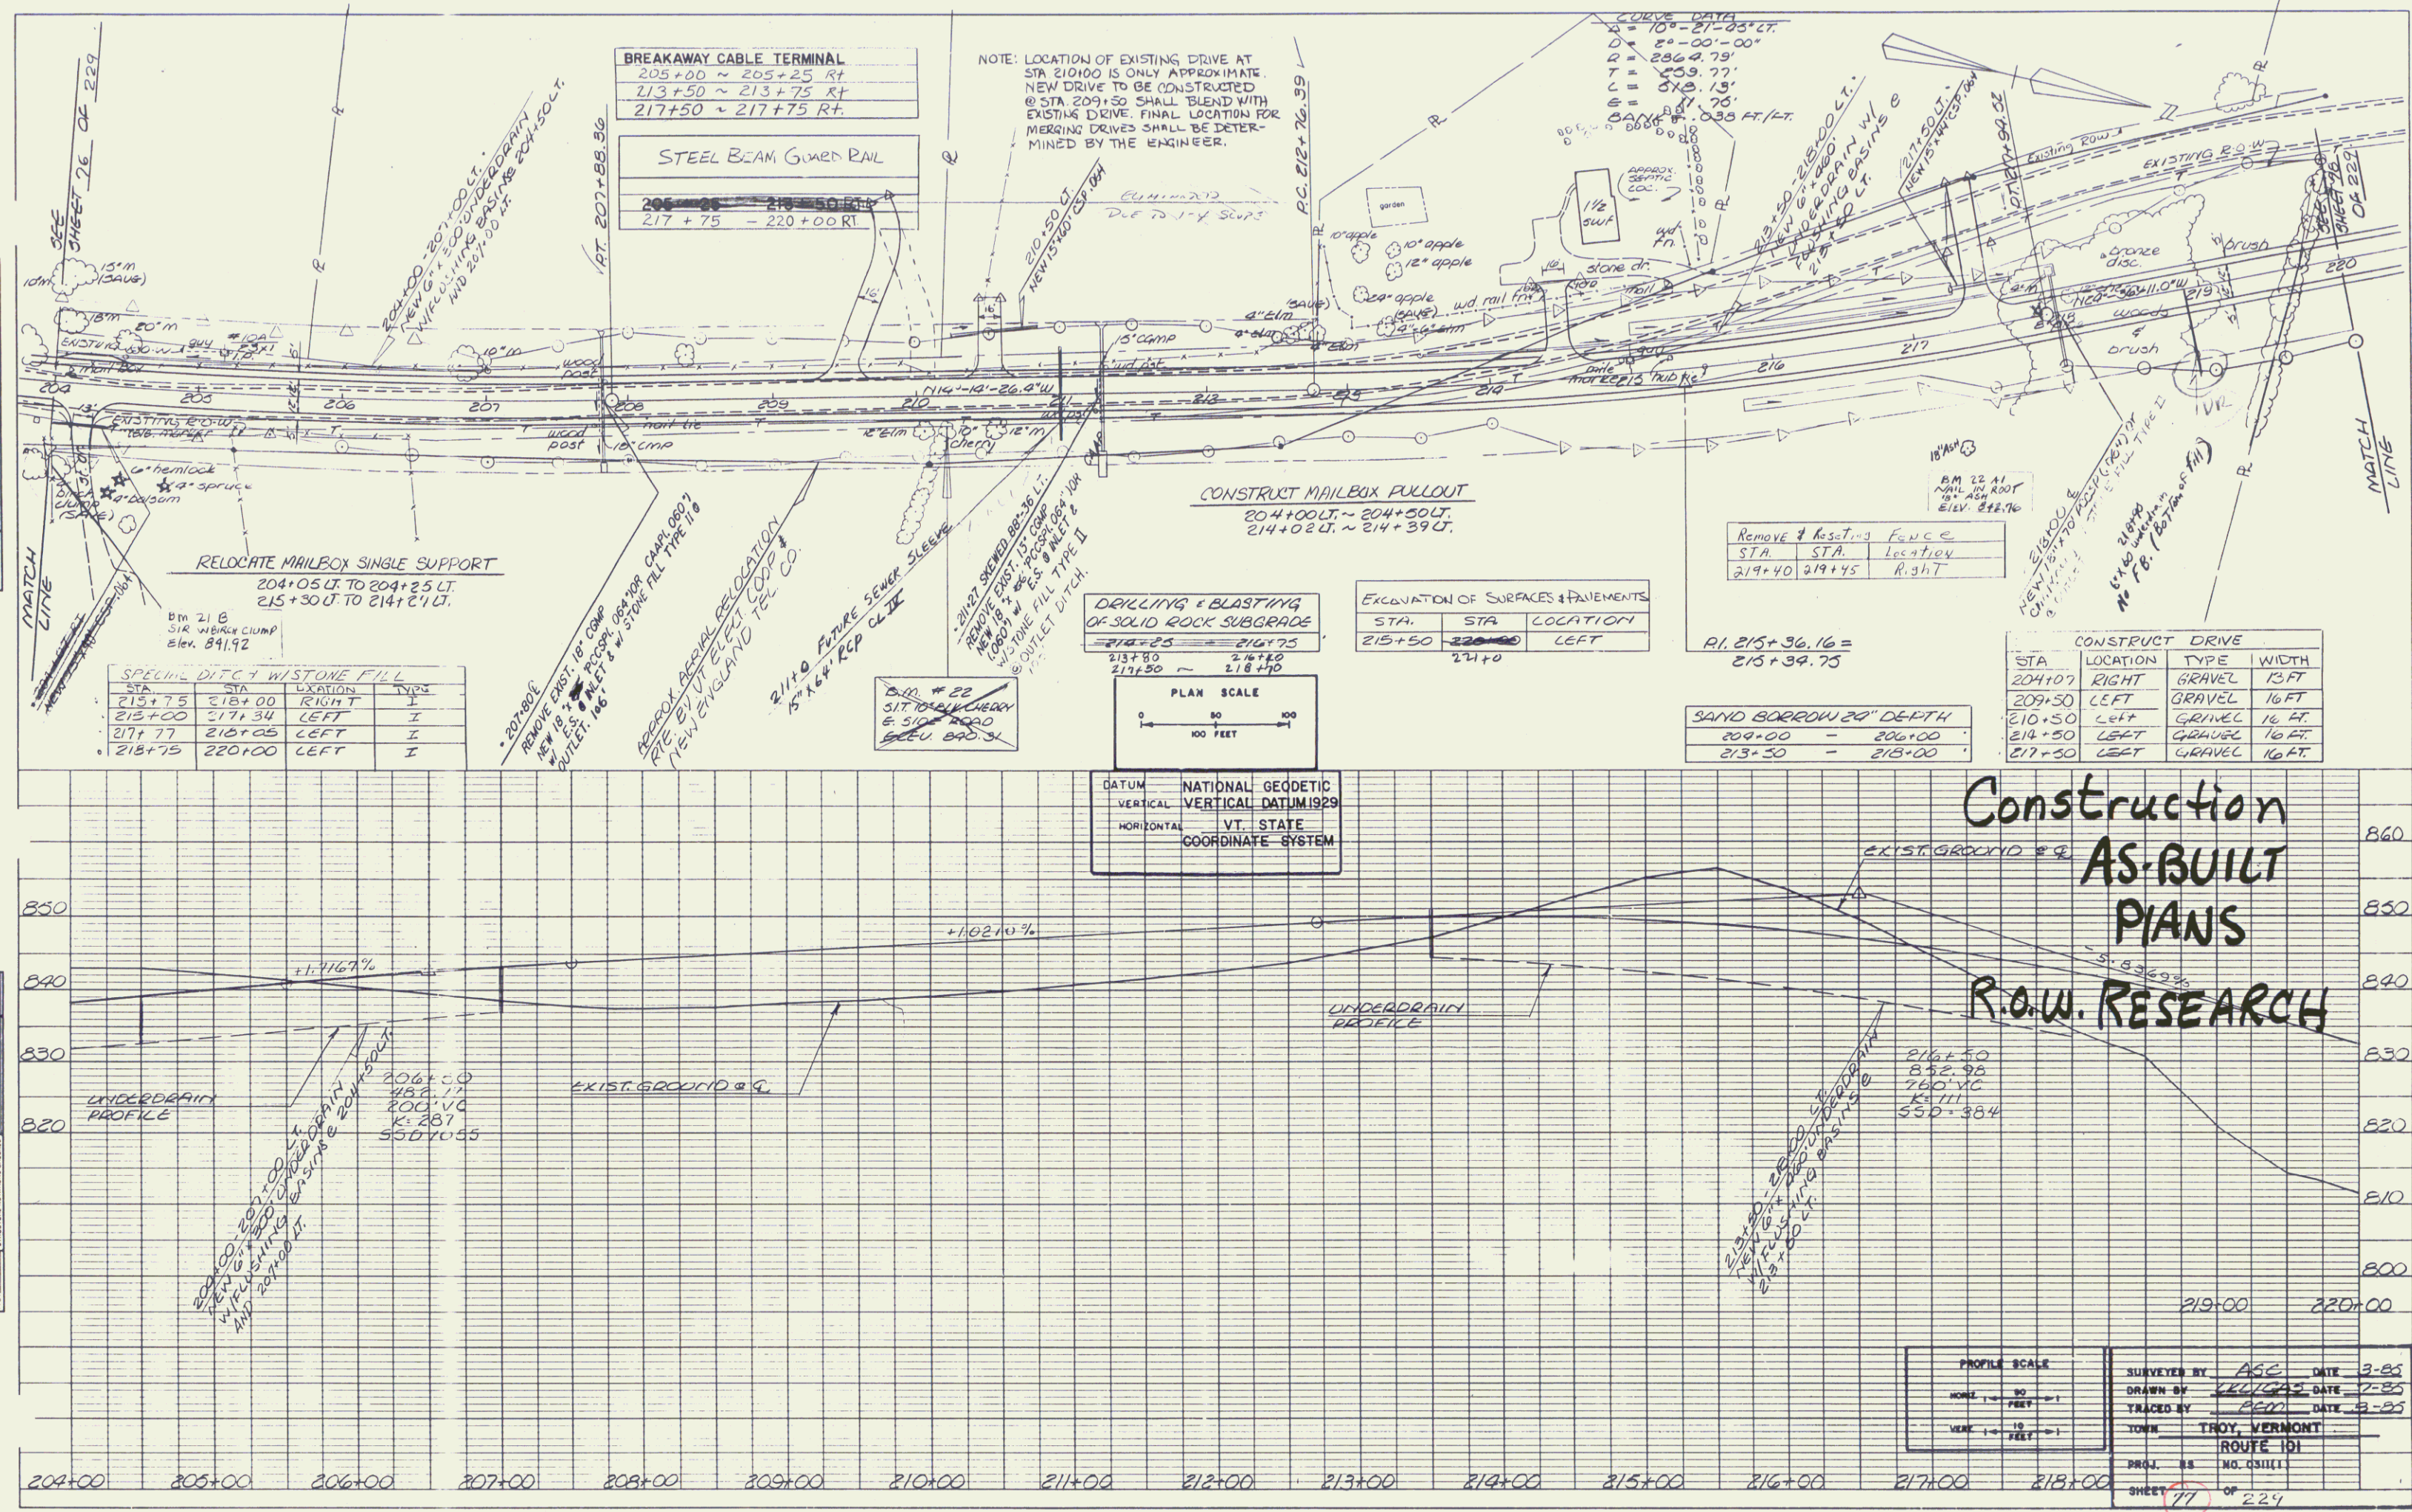


PLATE 1 PLAN PROFILE G.P.A.S.A.E. STANDARD
DETROIT CORPORATION
PRINTED IN U.S.A.

AUG 02 1996

59

PLAN
NOTE BOOK
NO.

PROFILE
NOTE BOOK
NO.


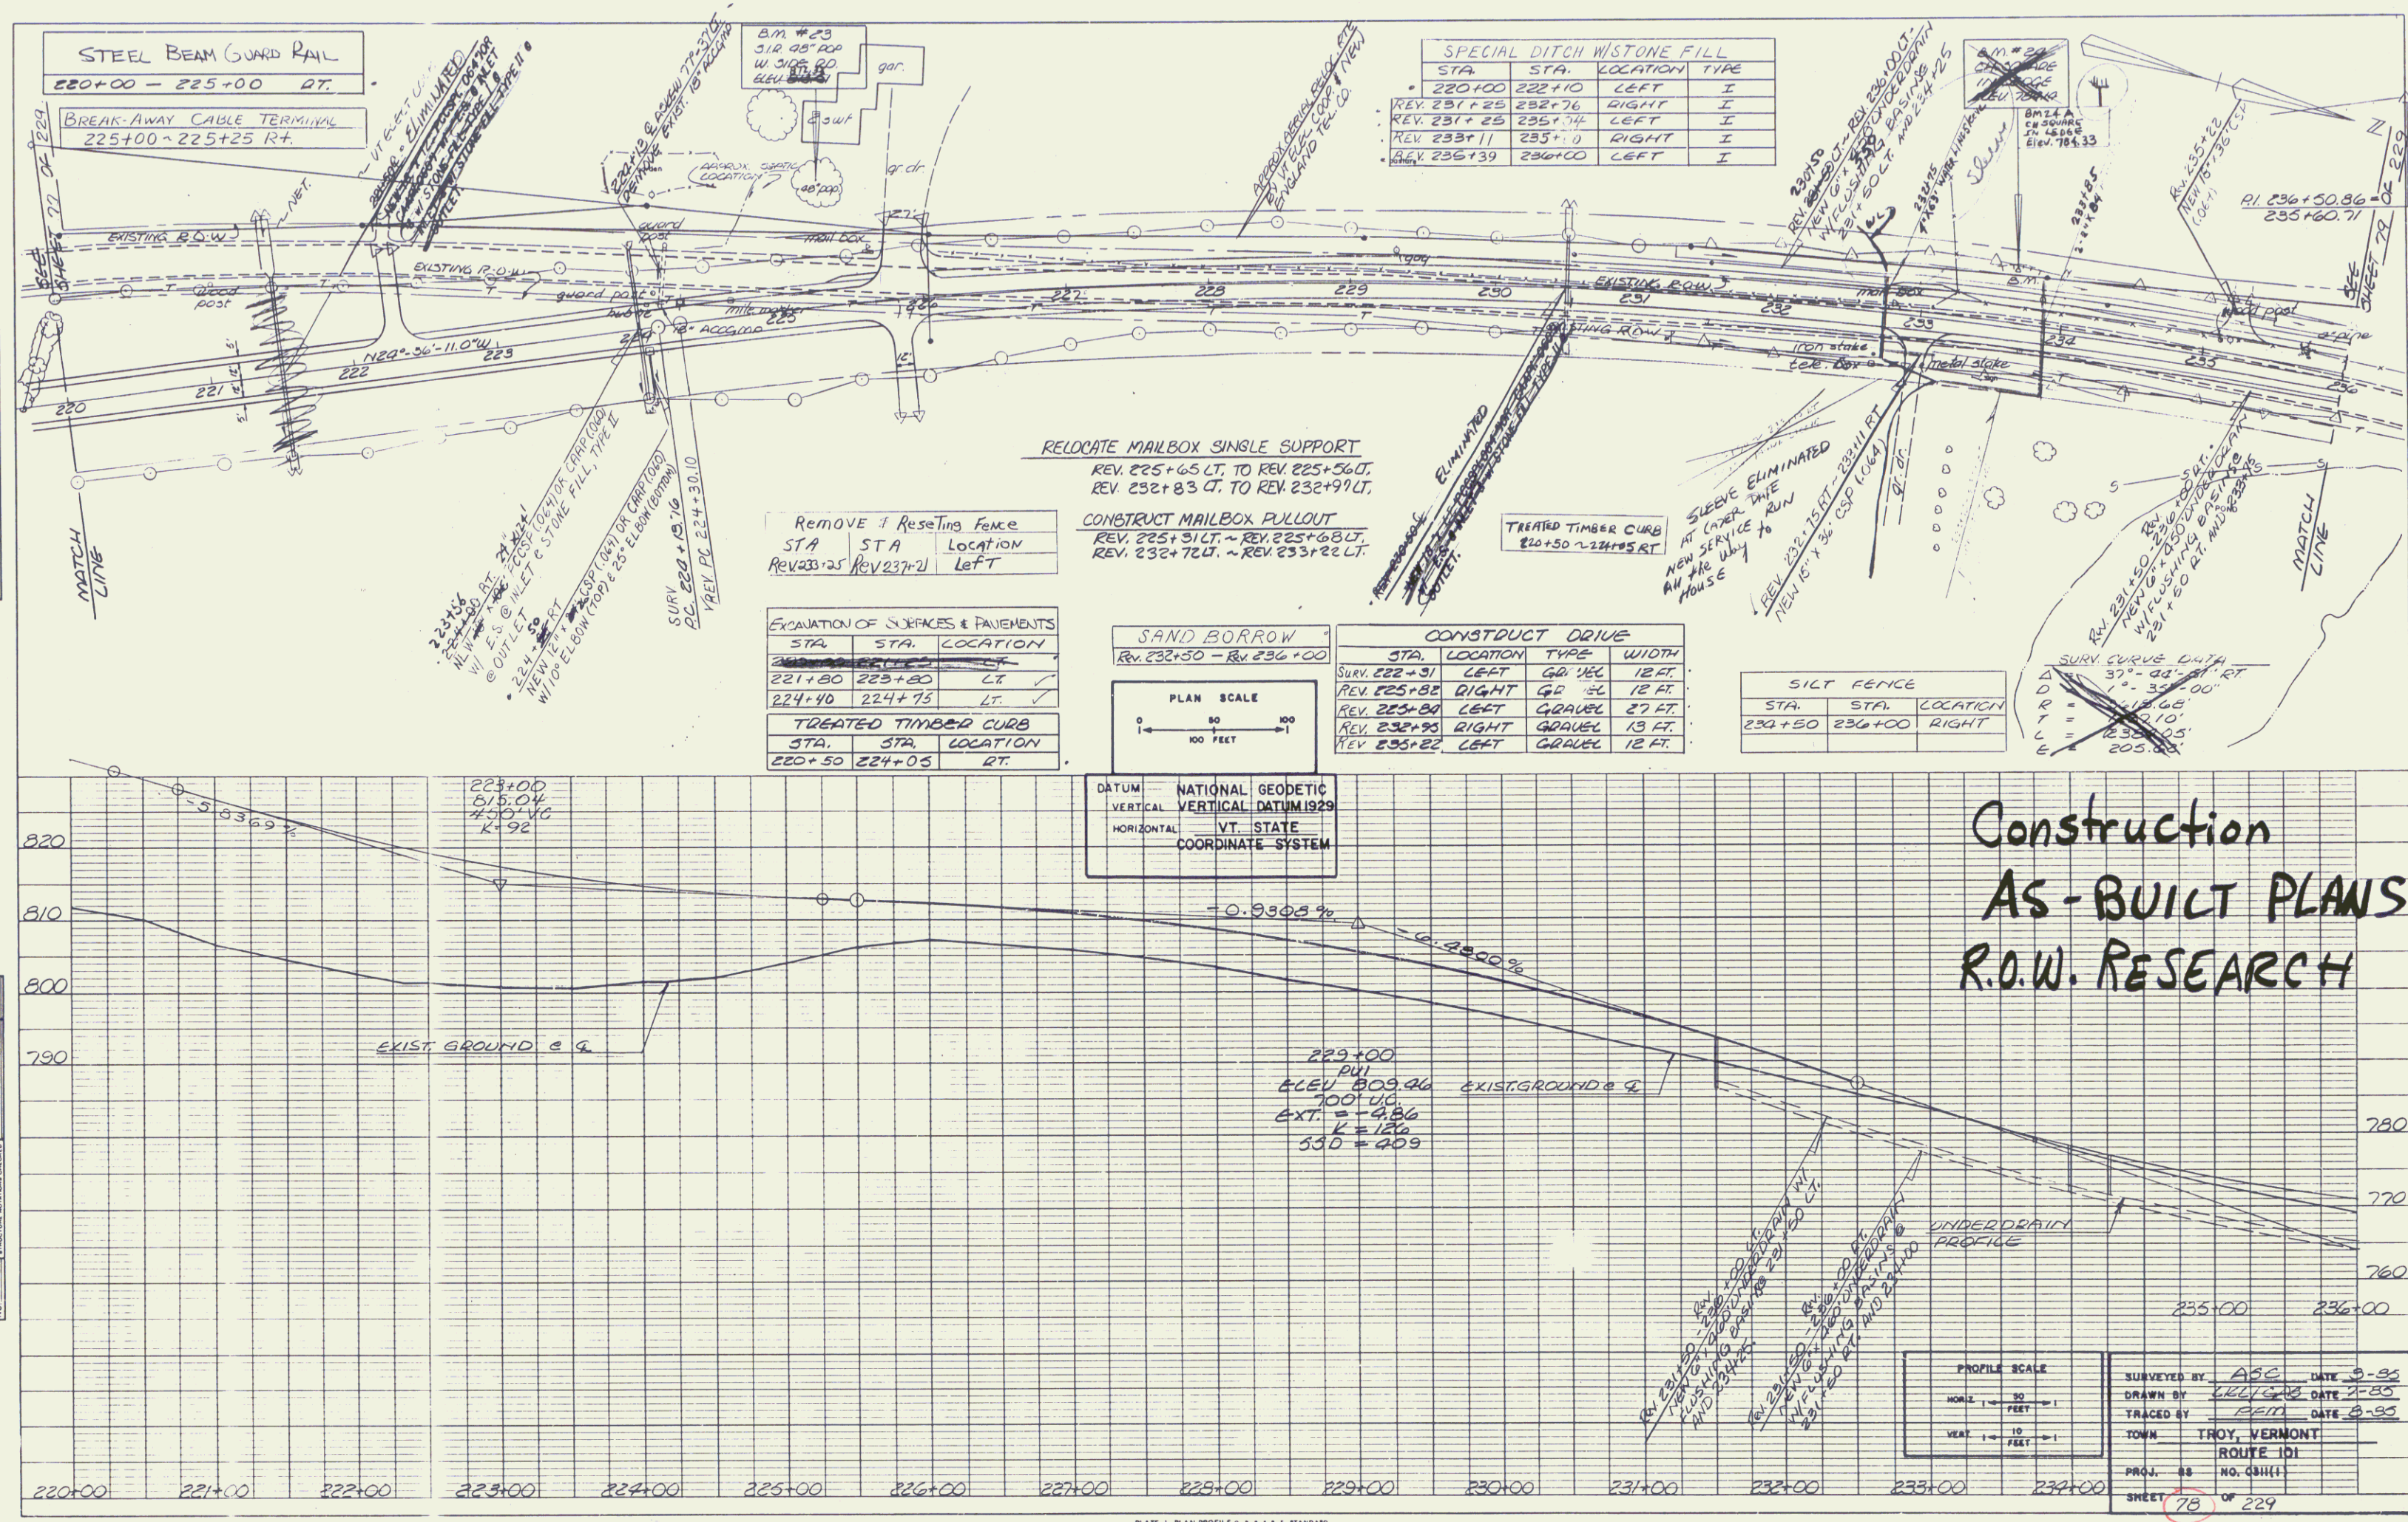


PLATE 1 PLAN PROFILE P.S.S.S. STANDARD
UNIT: FEET
PRINTED 2-1-85

AUG 02 1996


PLAN	DATE
NO. 1	
NO. 2	
NO. 3	
NO. 100	

PROFILE	DATE
NO. 1	
NO. 2	
NO. 3	
NO. 100	

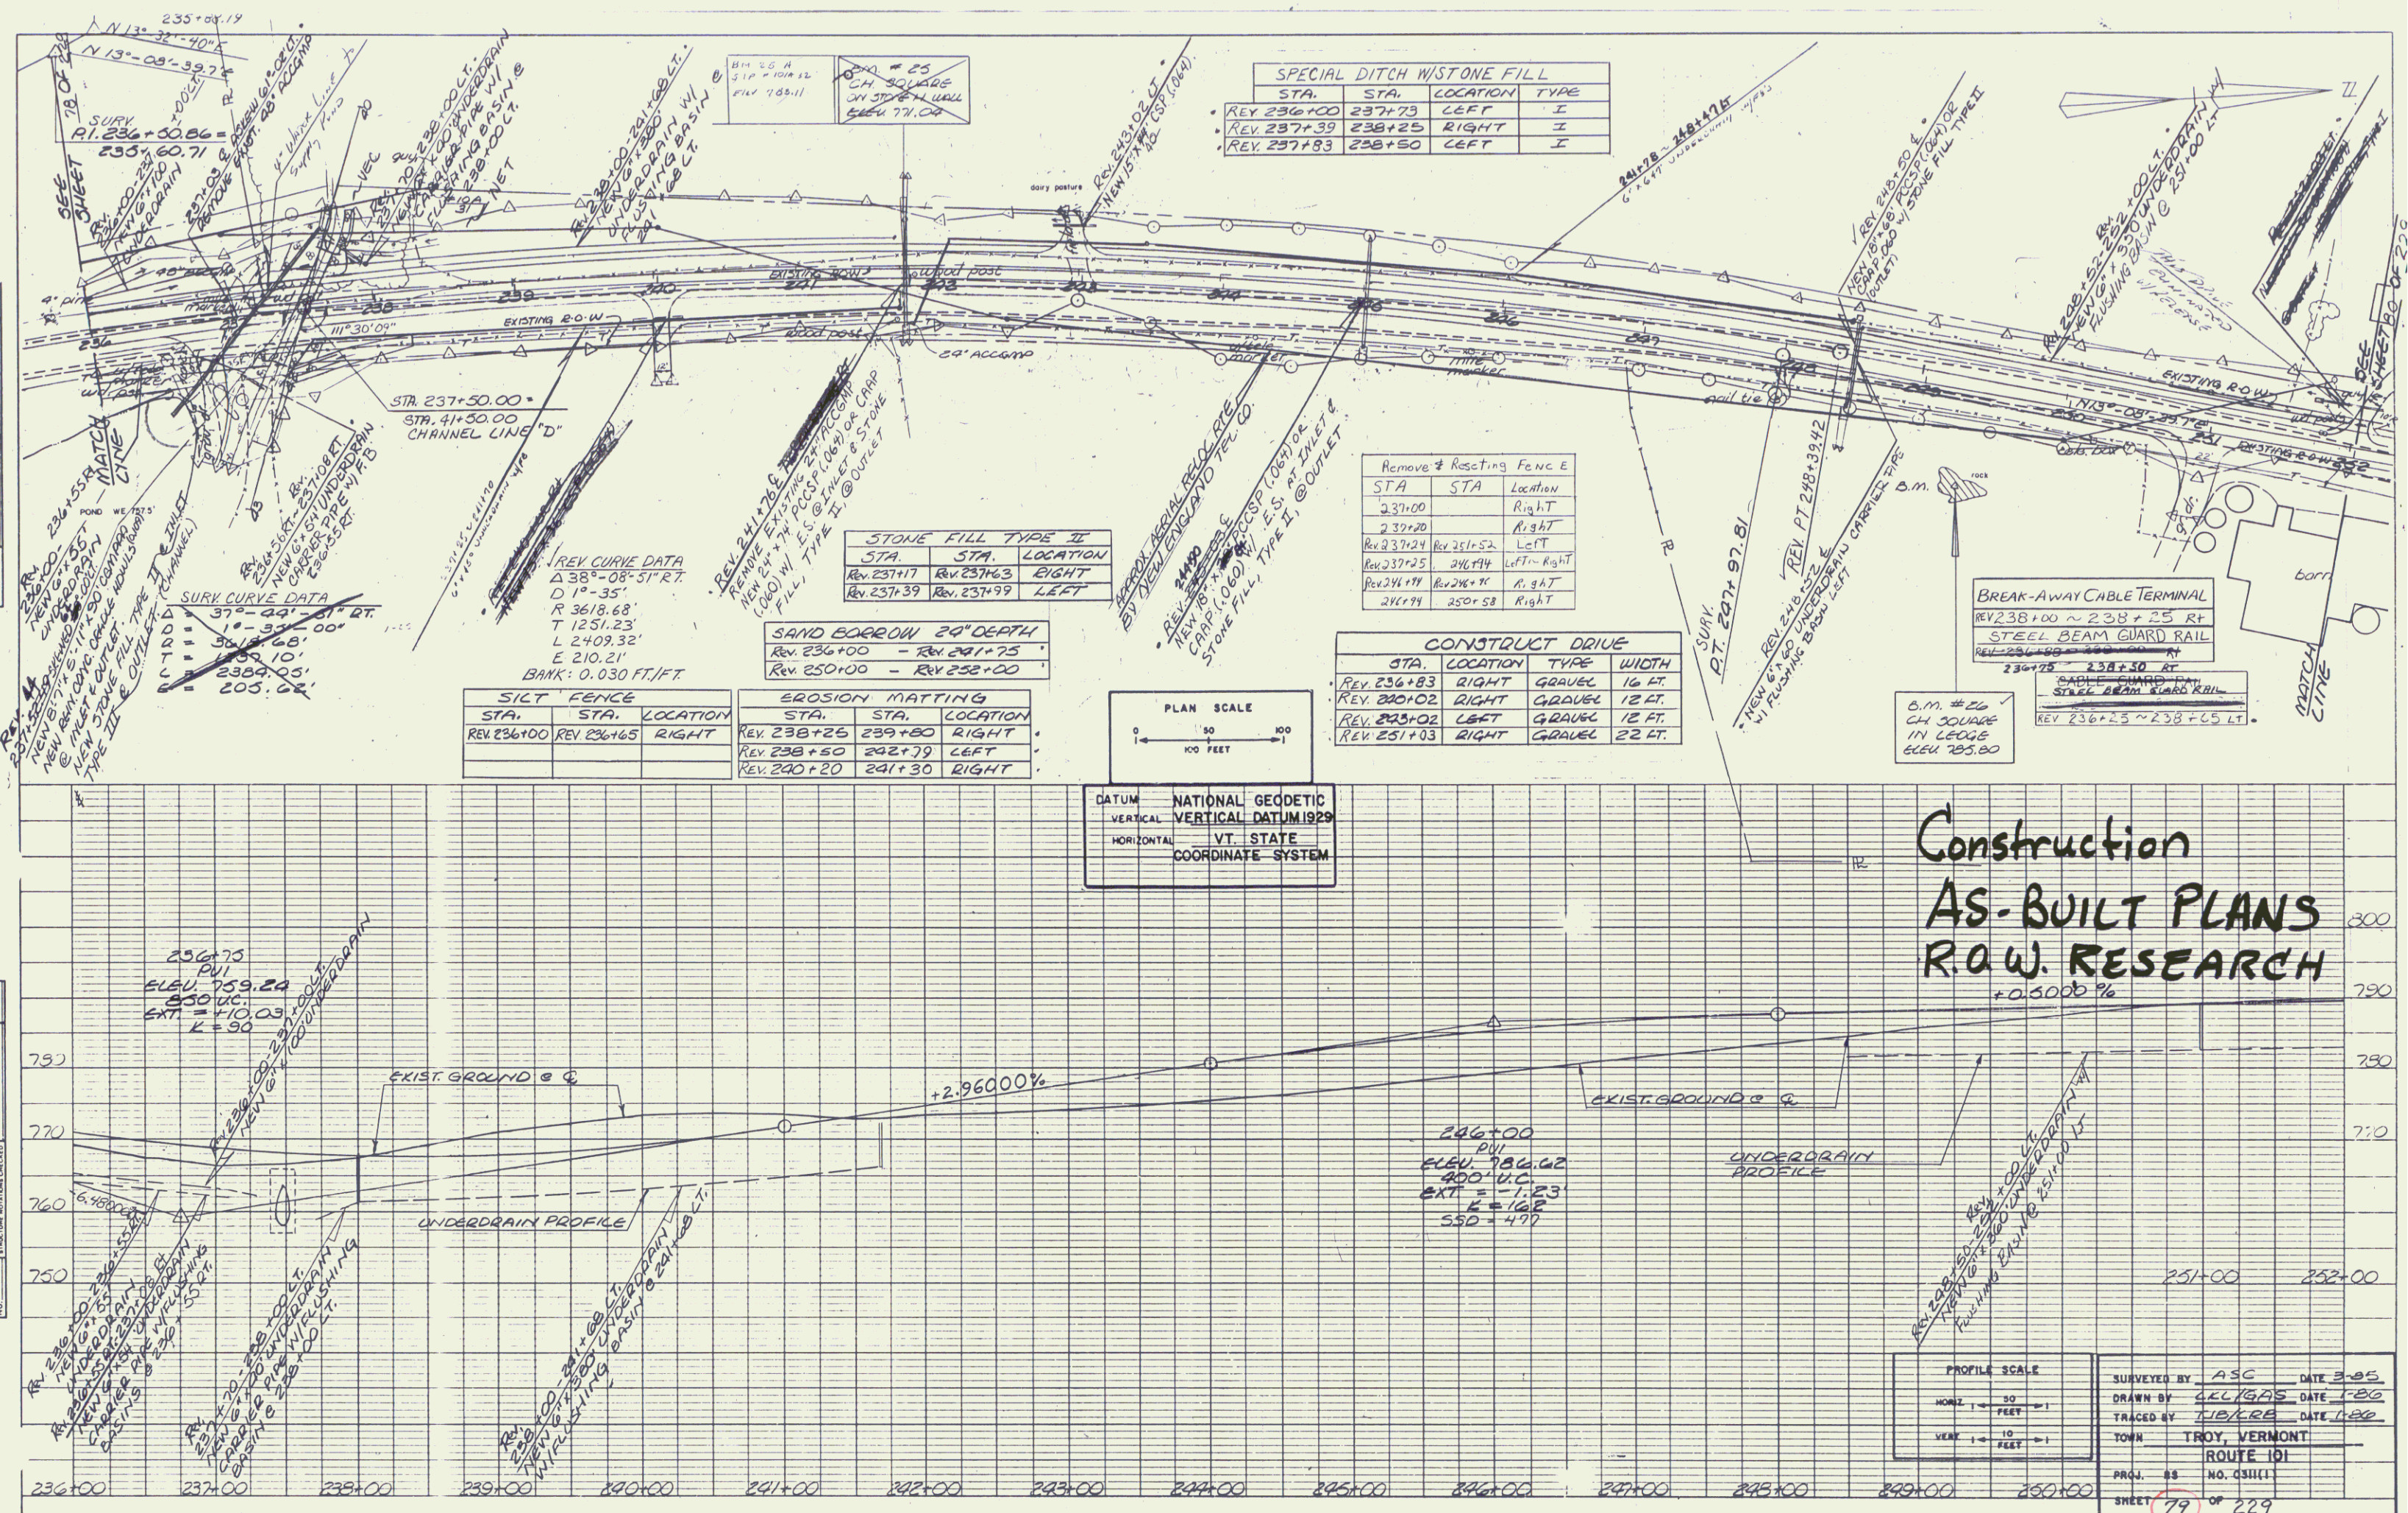


PLAN	DATE
BY	
CHECKED	
APPROVED	
NOTE BOOK	
NO.	

PROFILE	DATE
BY	
CHECKED	
APPROVED	
NOTE BOOK	
NO.	

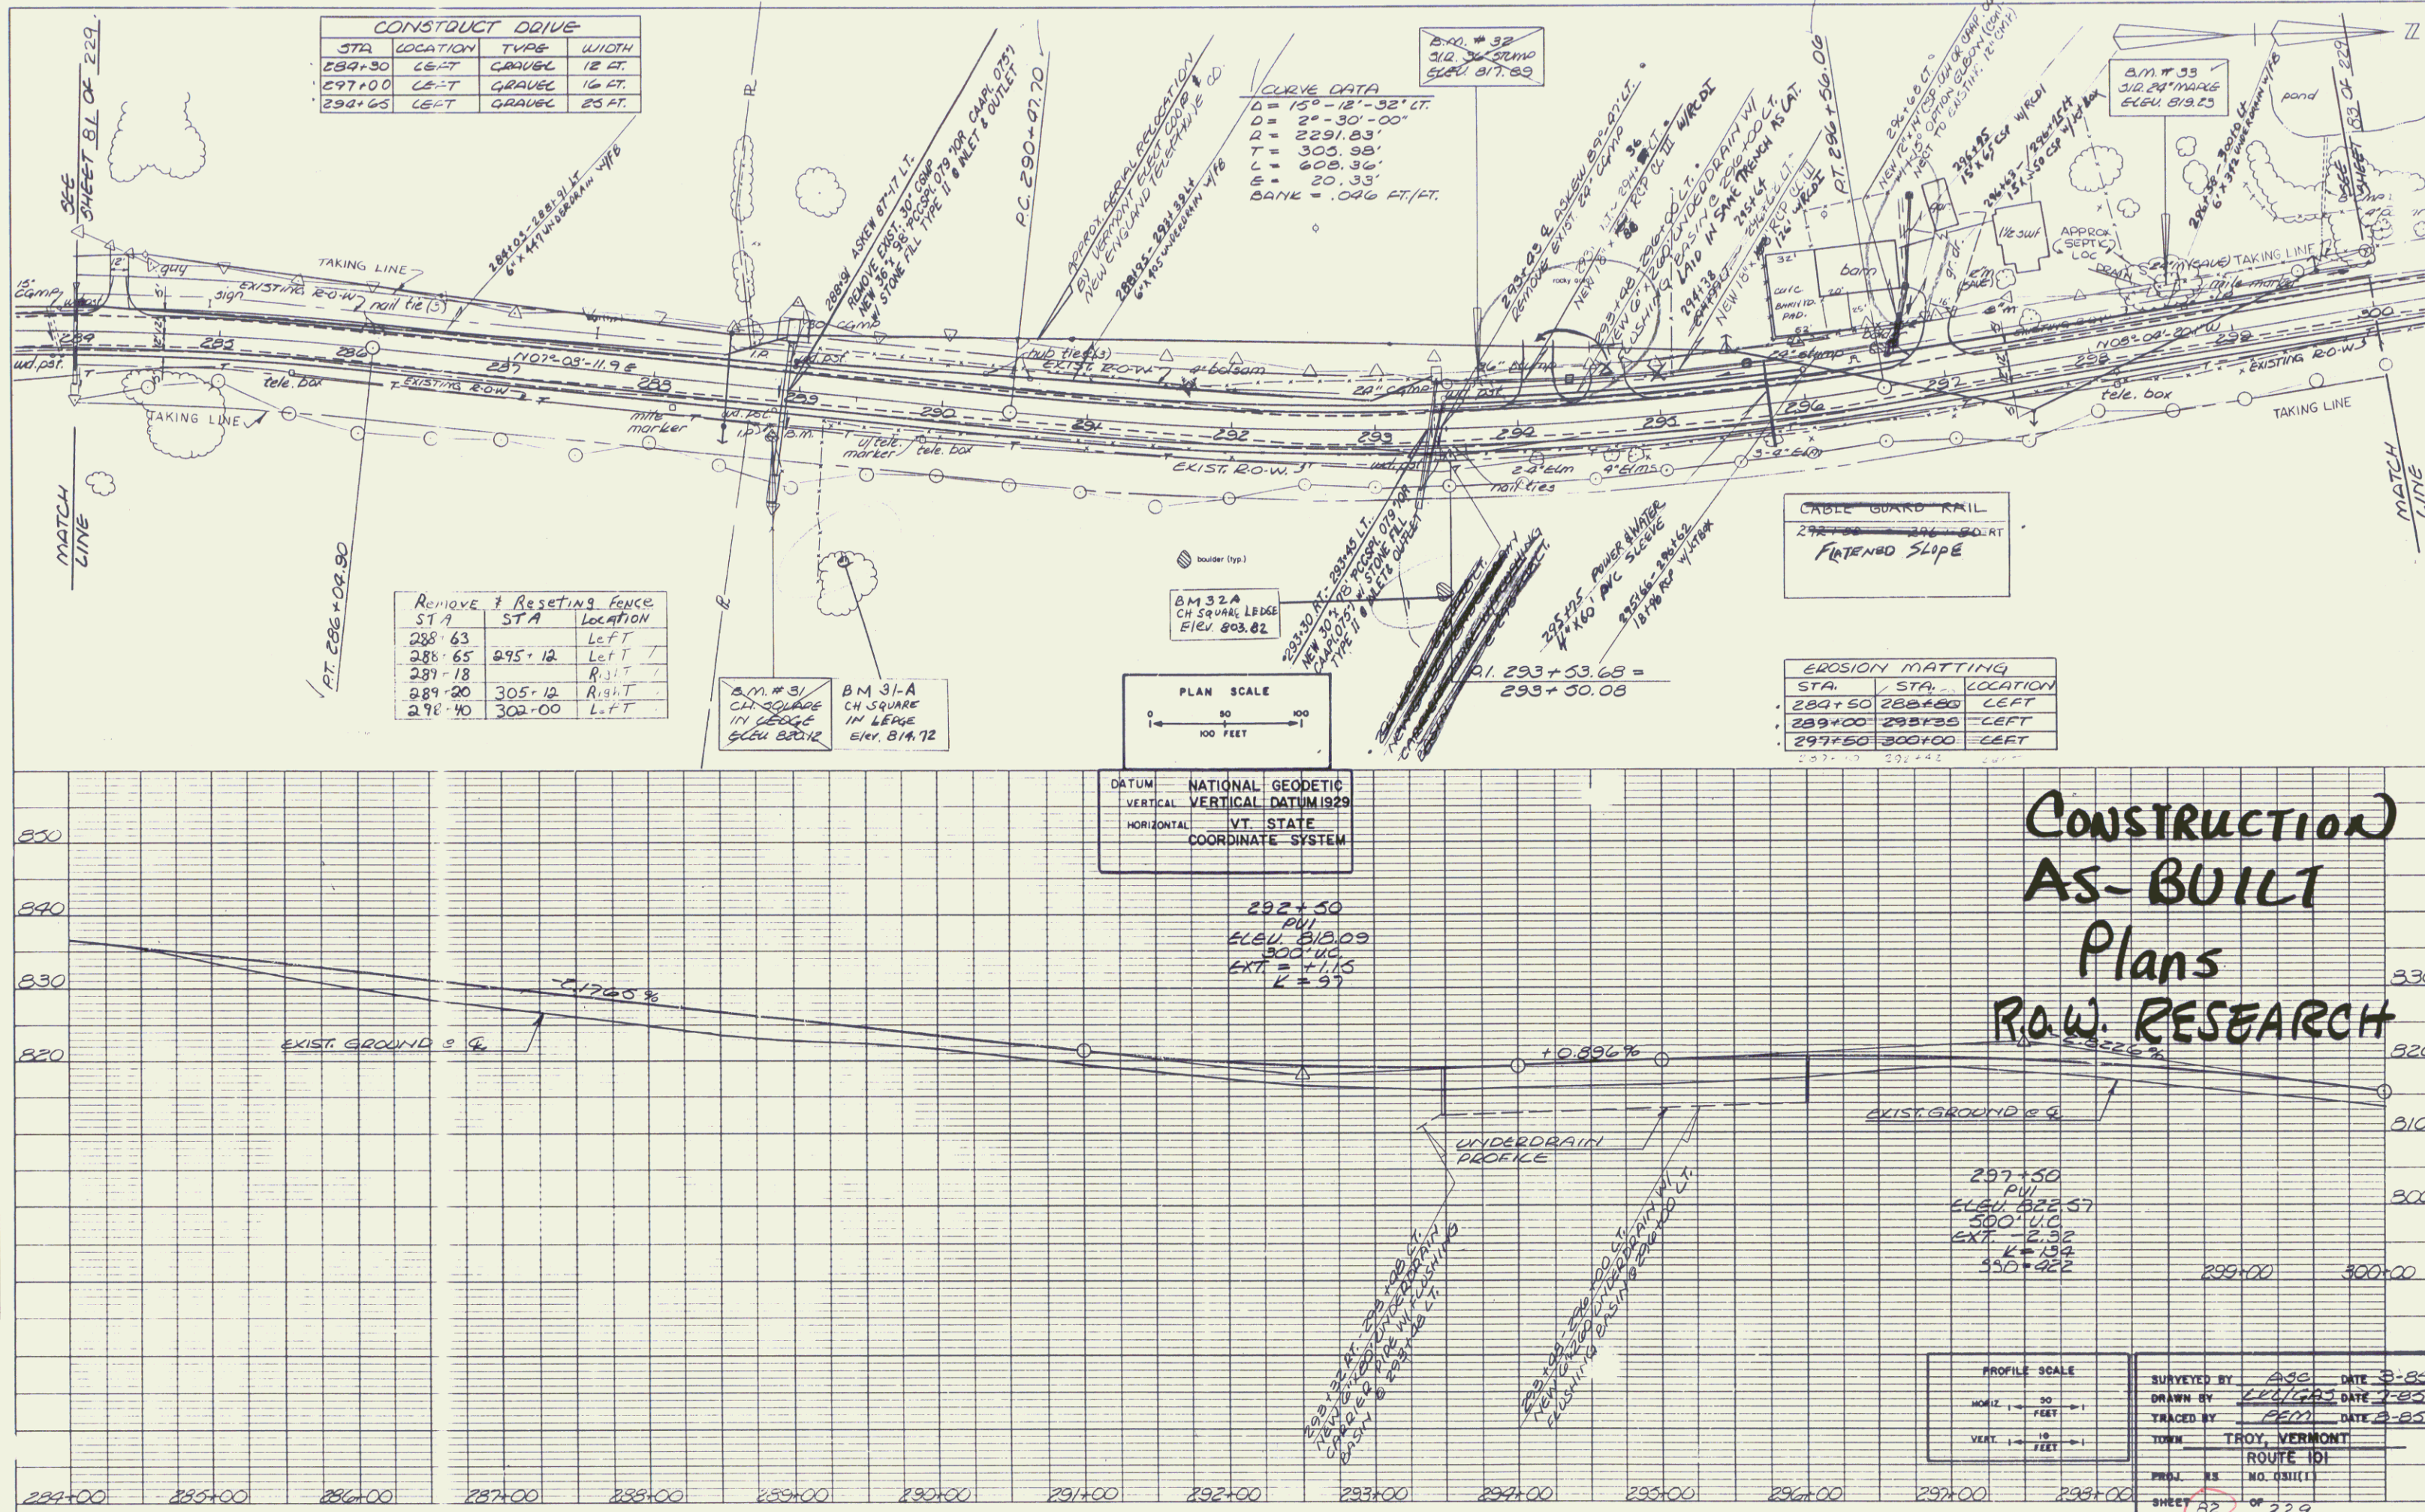

PLAN
NOTE BOOK
NO.

PROFILE
NOTE BOOK
NO.

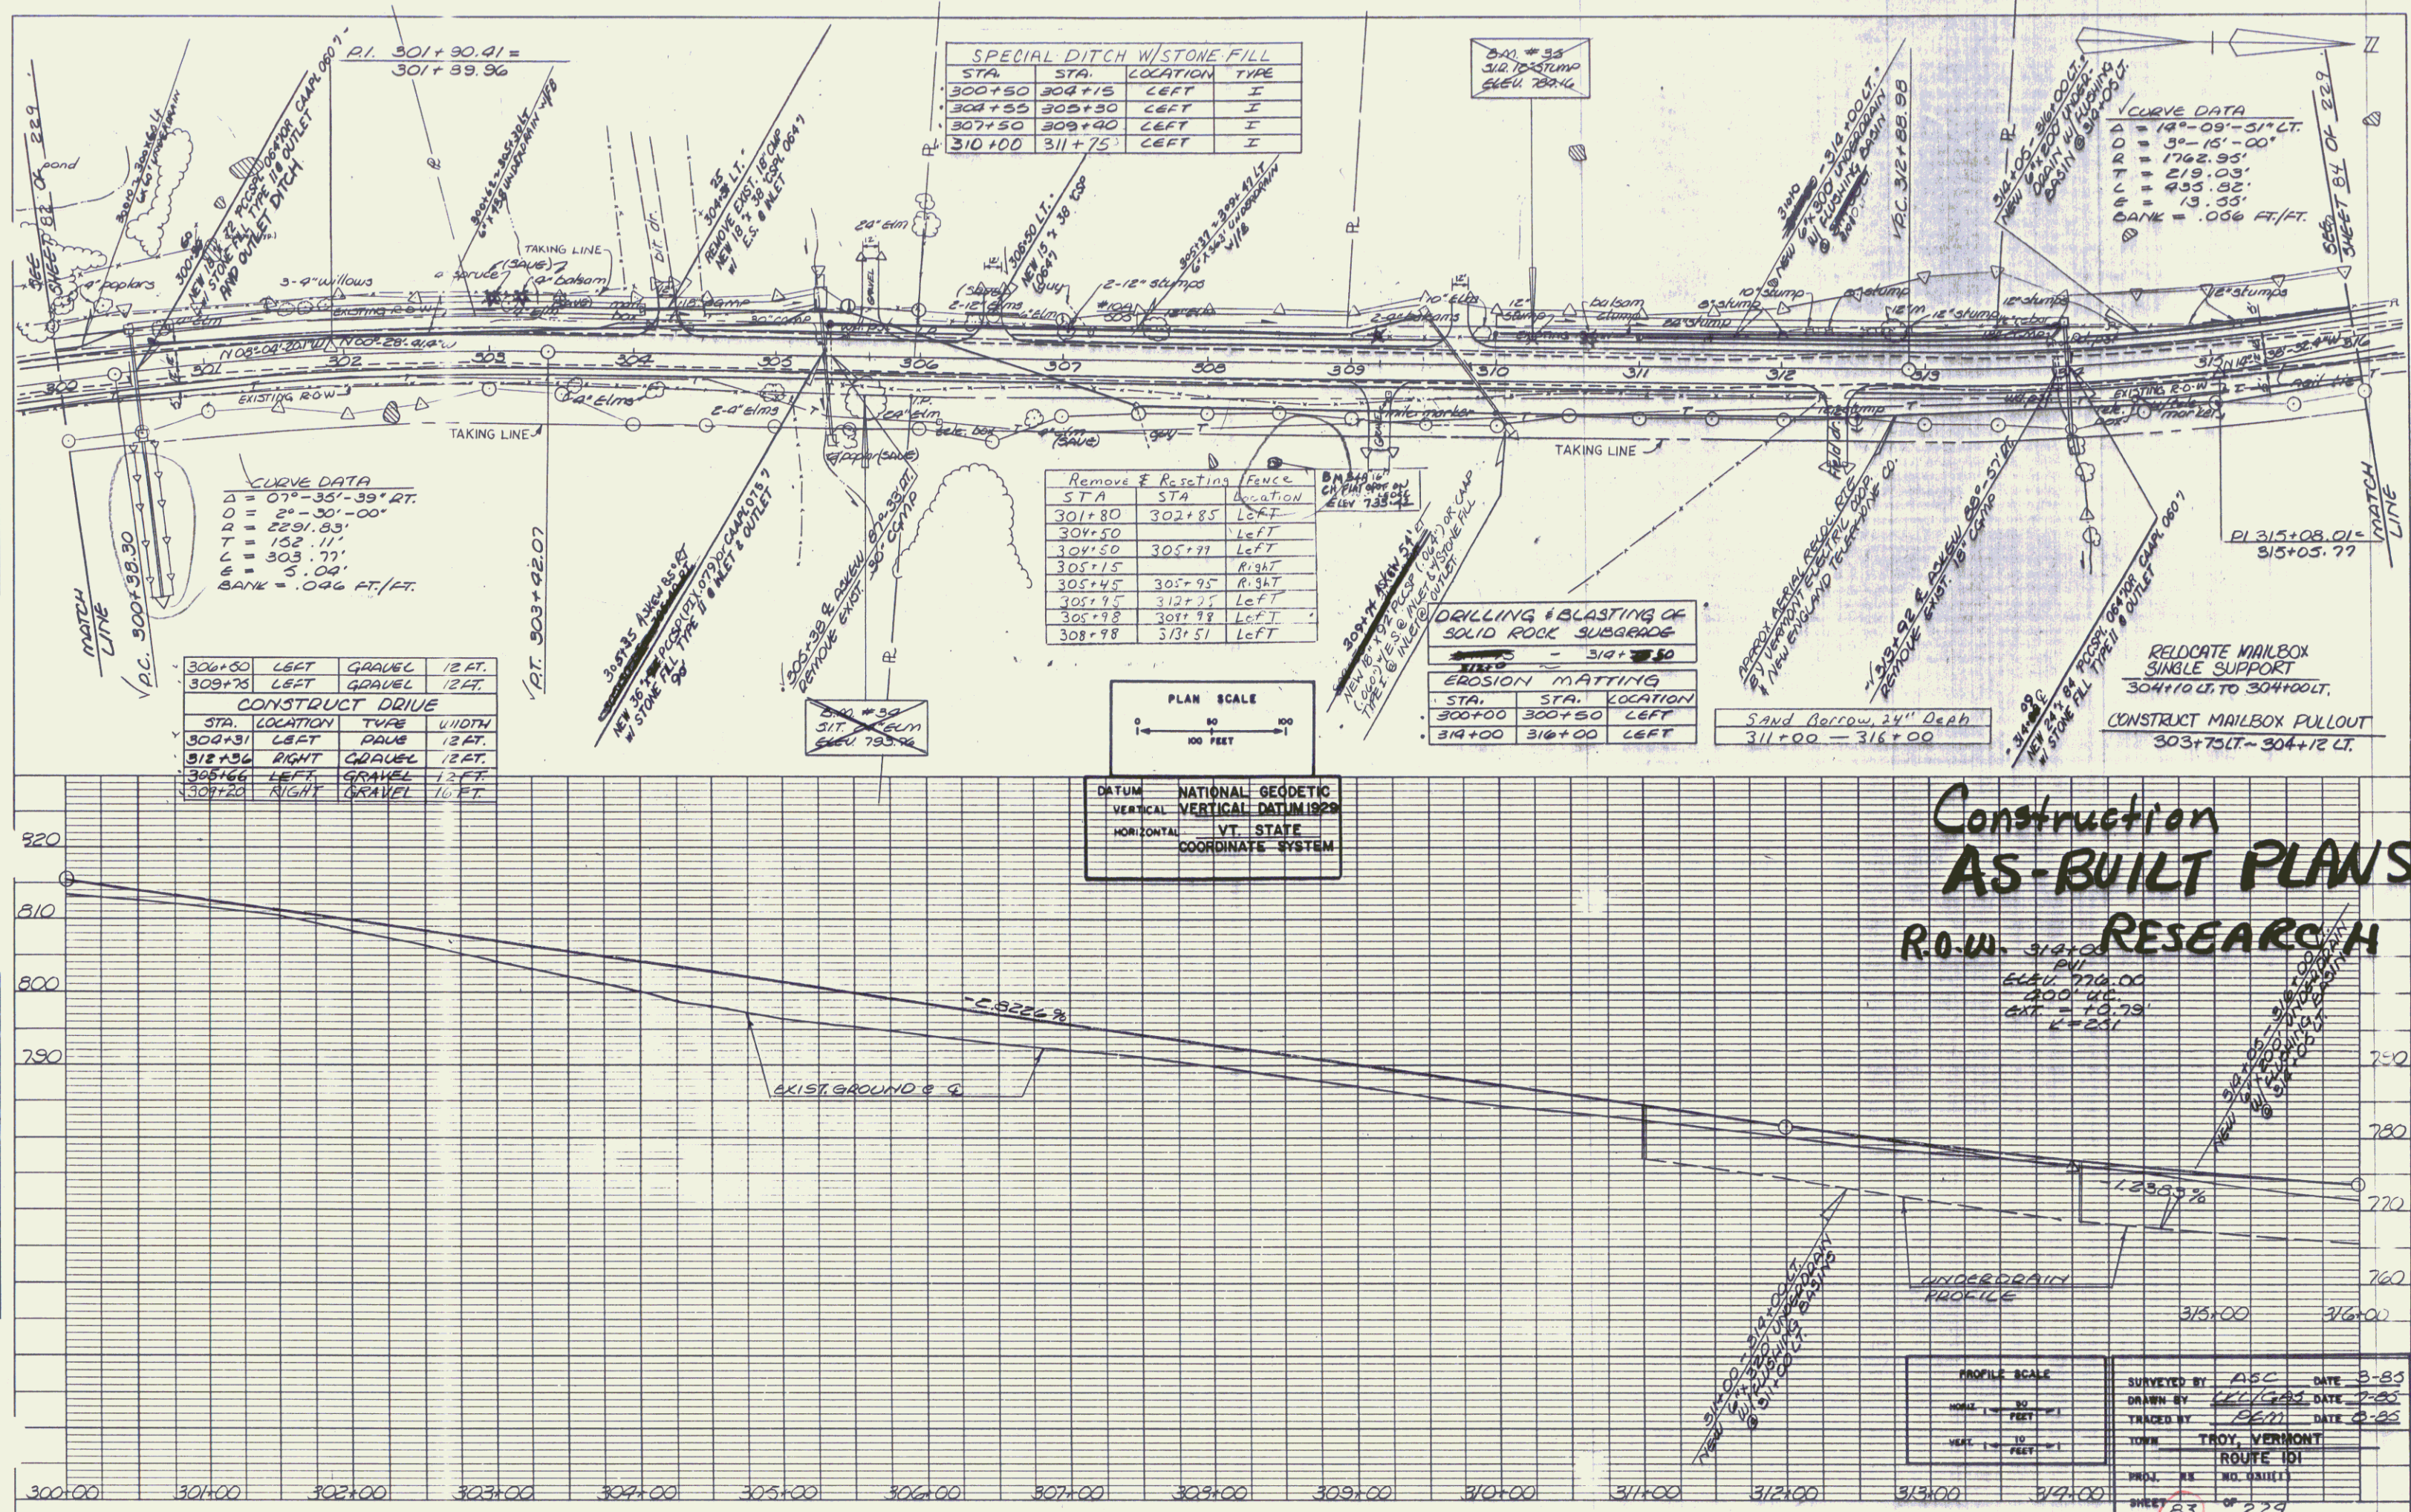

PLAN	DATE
NOTES	
NO.	

PROFILE	DATE
NOTES	
NO.	


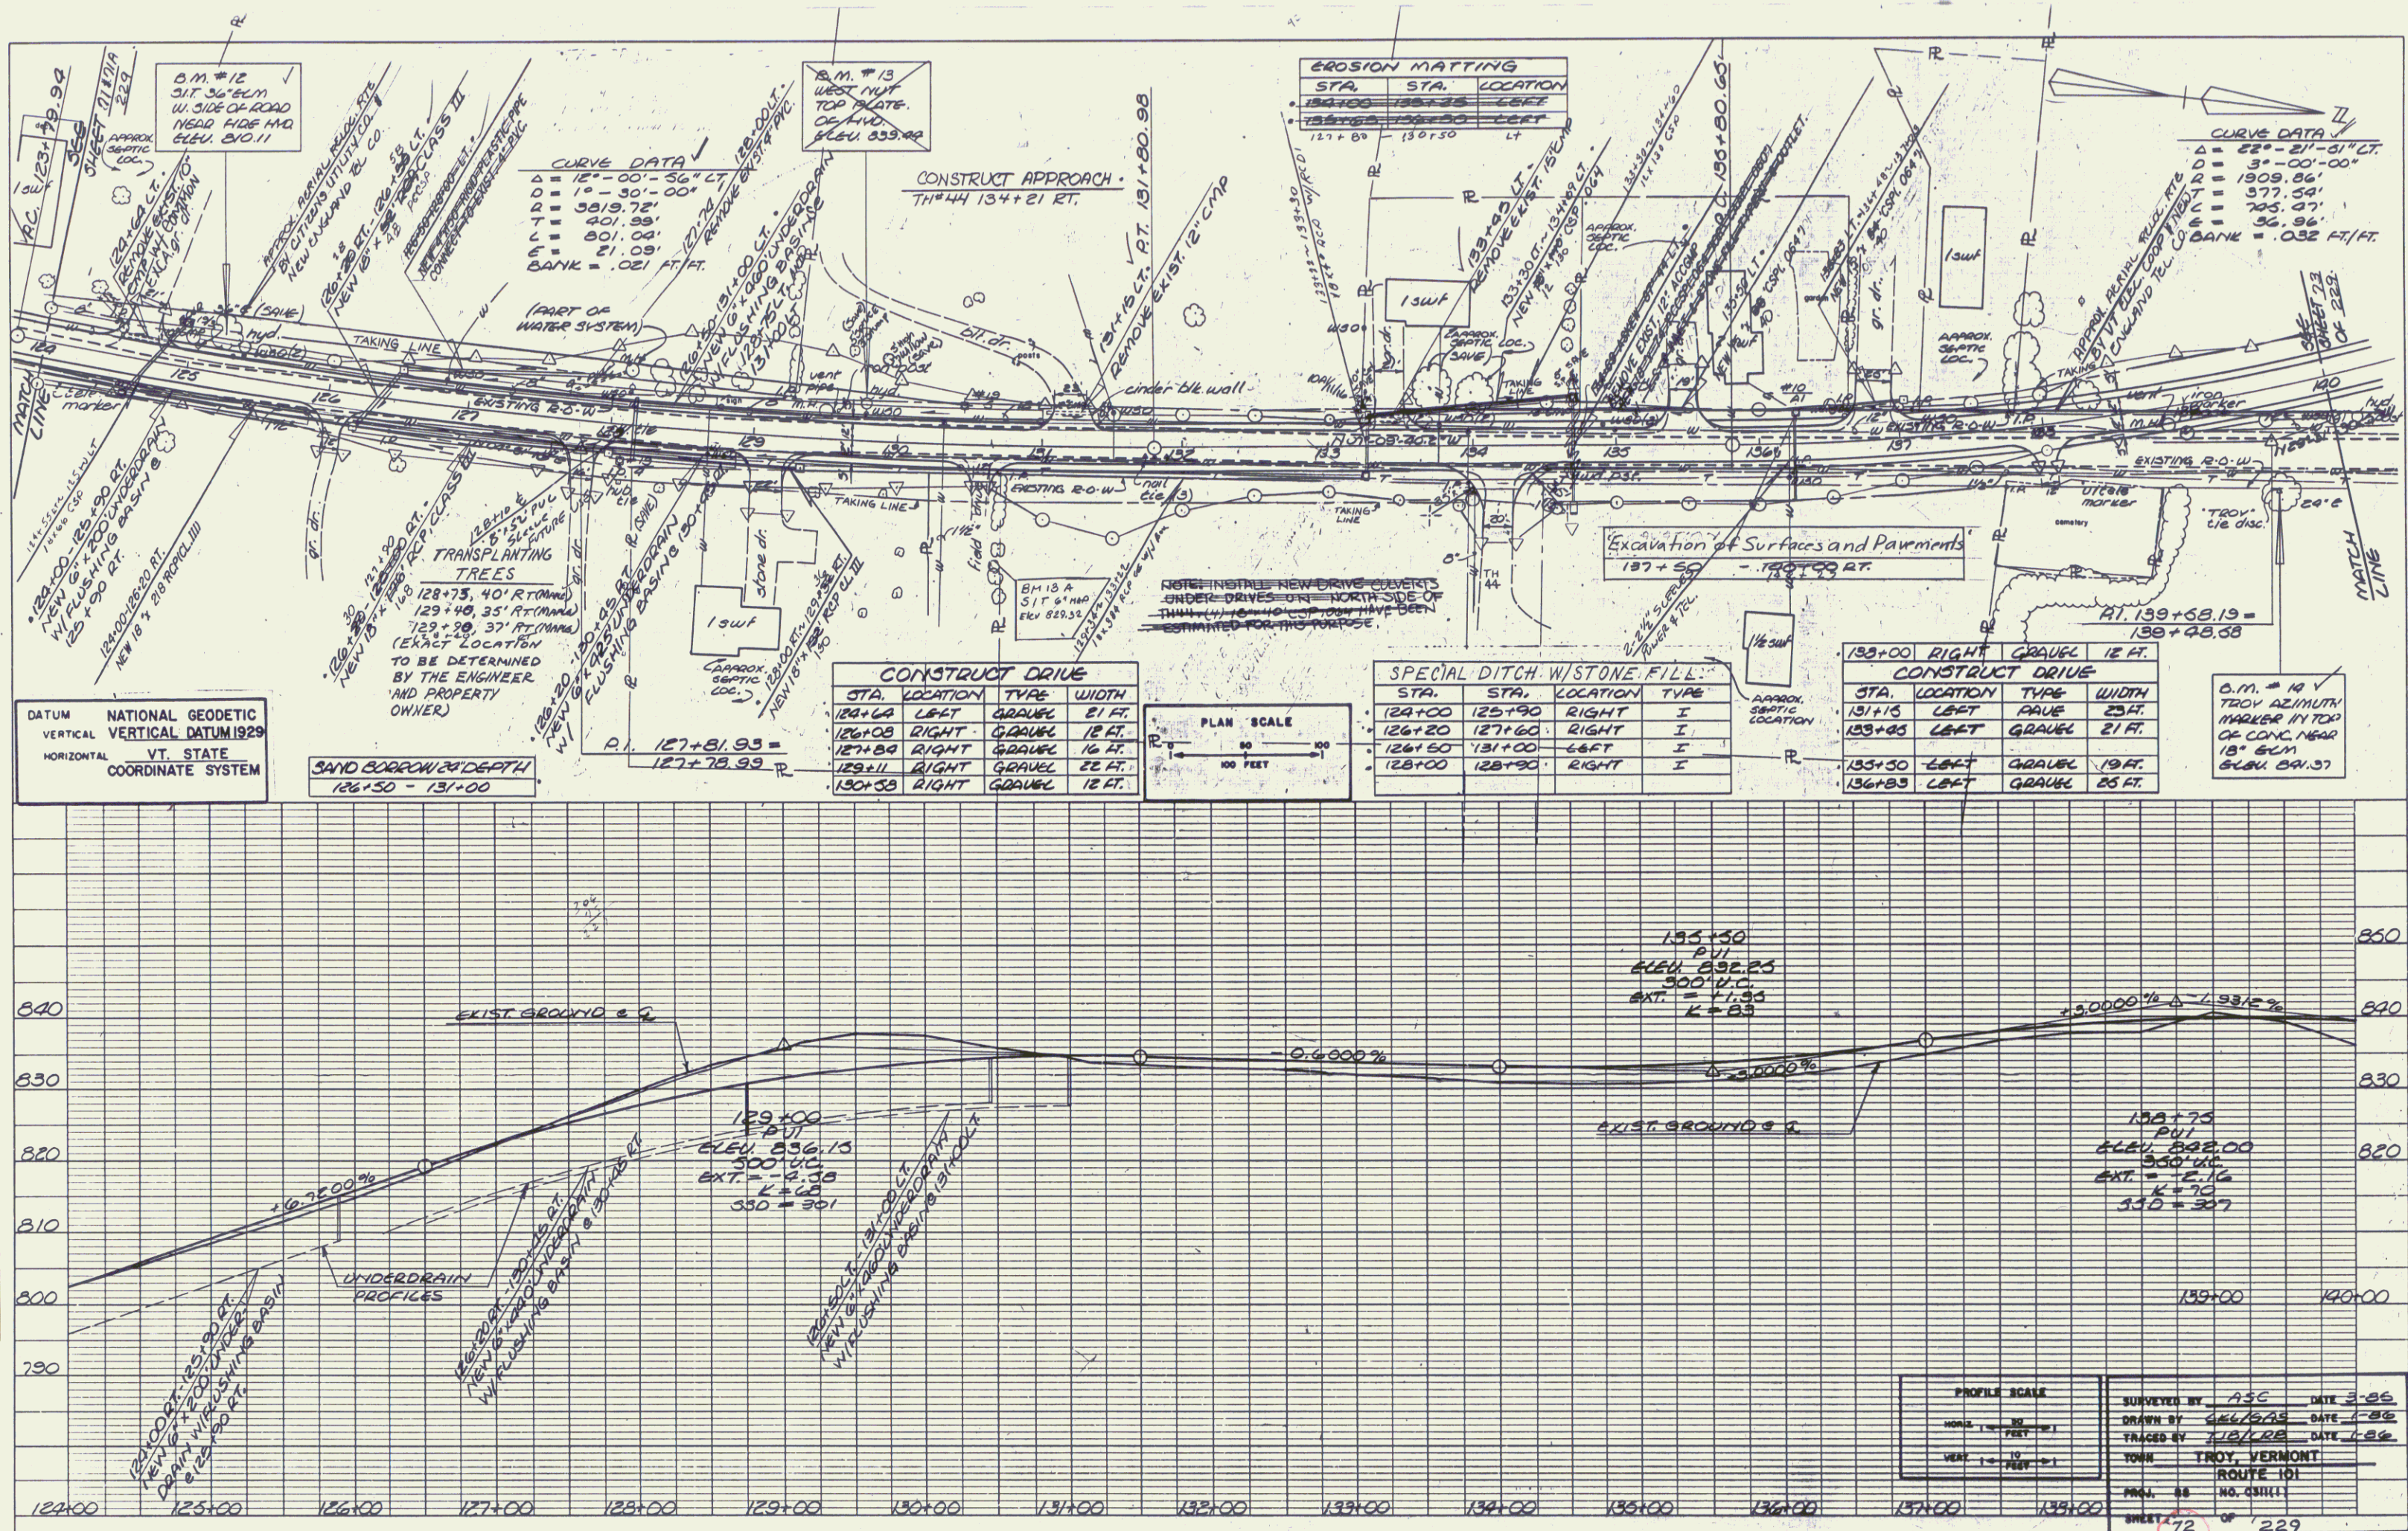


PLATE 1 PLAN-PROFILE D. P. & S. E. STANARD
DRAFTSMAN CORPORATION
PRINTED IN U.S.A.

MAR 29 1995

PLAN	NOTE BOOK
DATE	NO.
BY	NO.
CHECKED	NO.
APPROVED	NO.


PROFILE	NOTE BOOK
DATE	NO.
BY	NO.
CHECKED	NO.
APPROVED	NO.

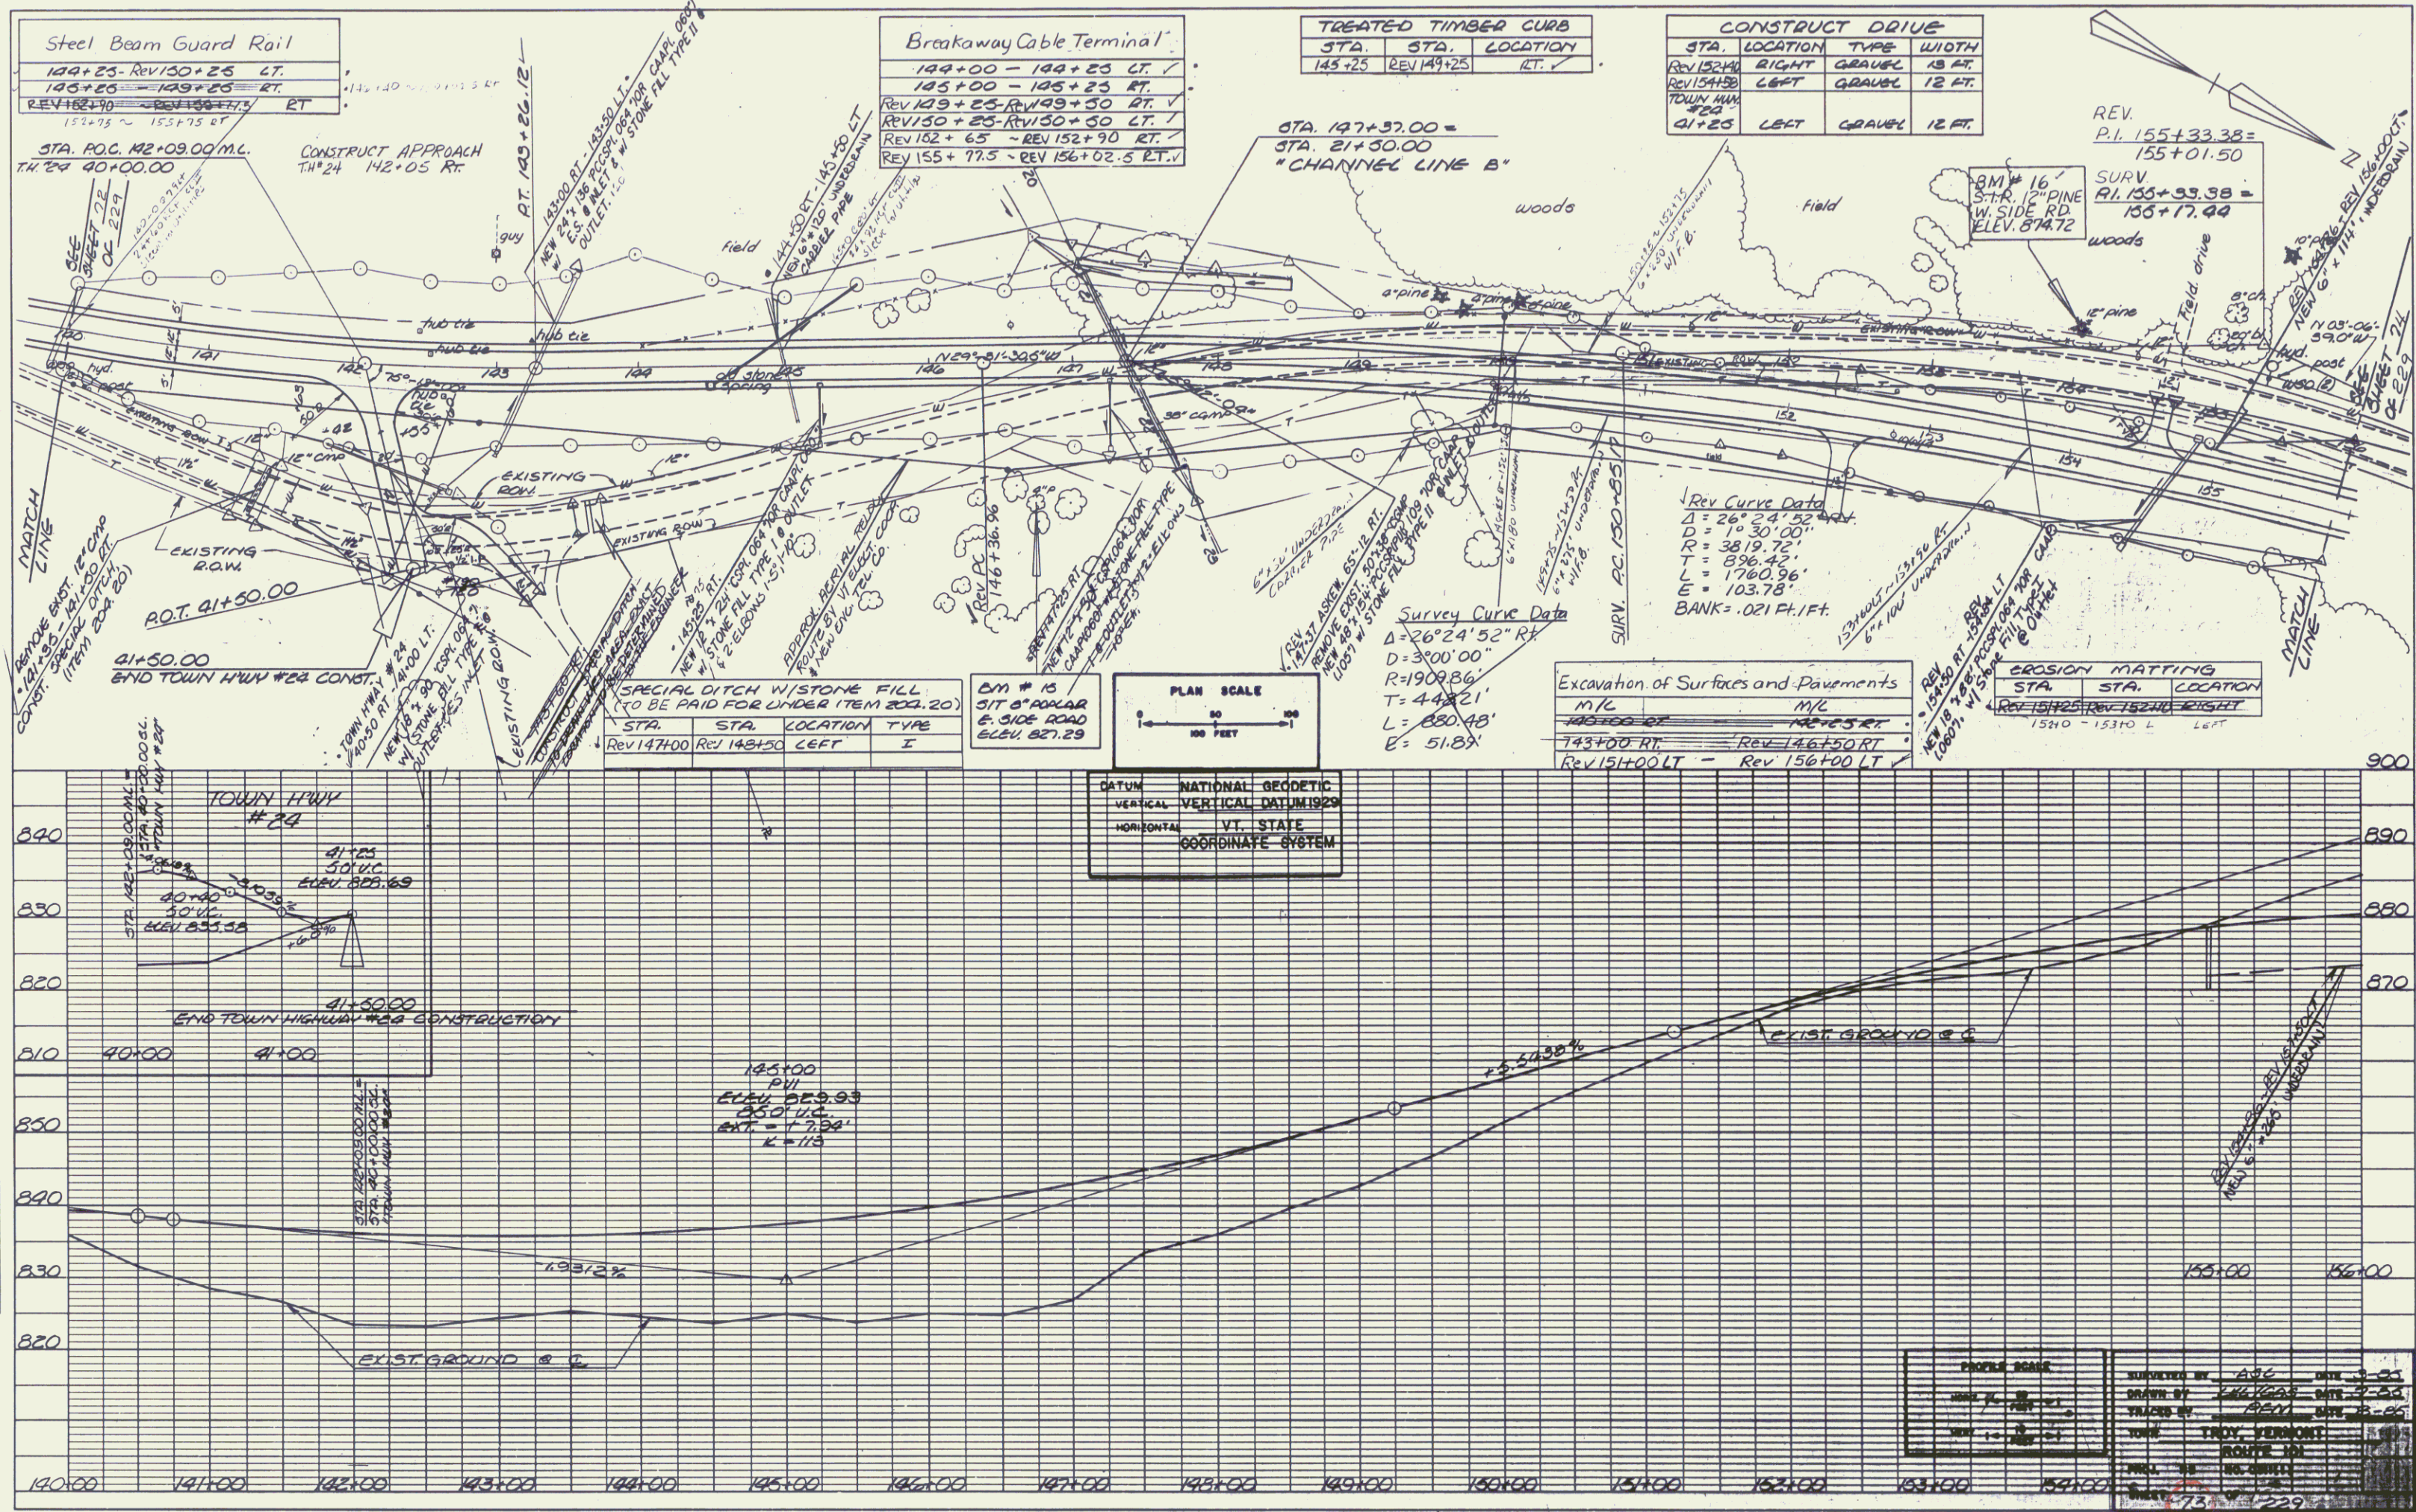

MAR 29 1995 70


PLAN	DATE
REVISIONS	
NO.	
DATE	
BY	
NOTE BOOK	
NO.	

PROFILE	DATE
REVISIONS	
NO.	
DATE	
BY	
NOTE BOOK	
NO.	

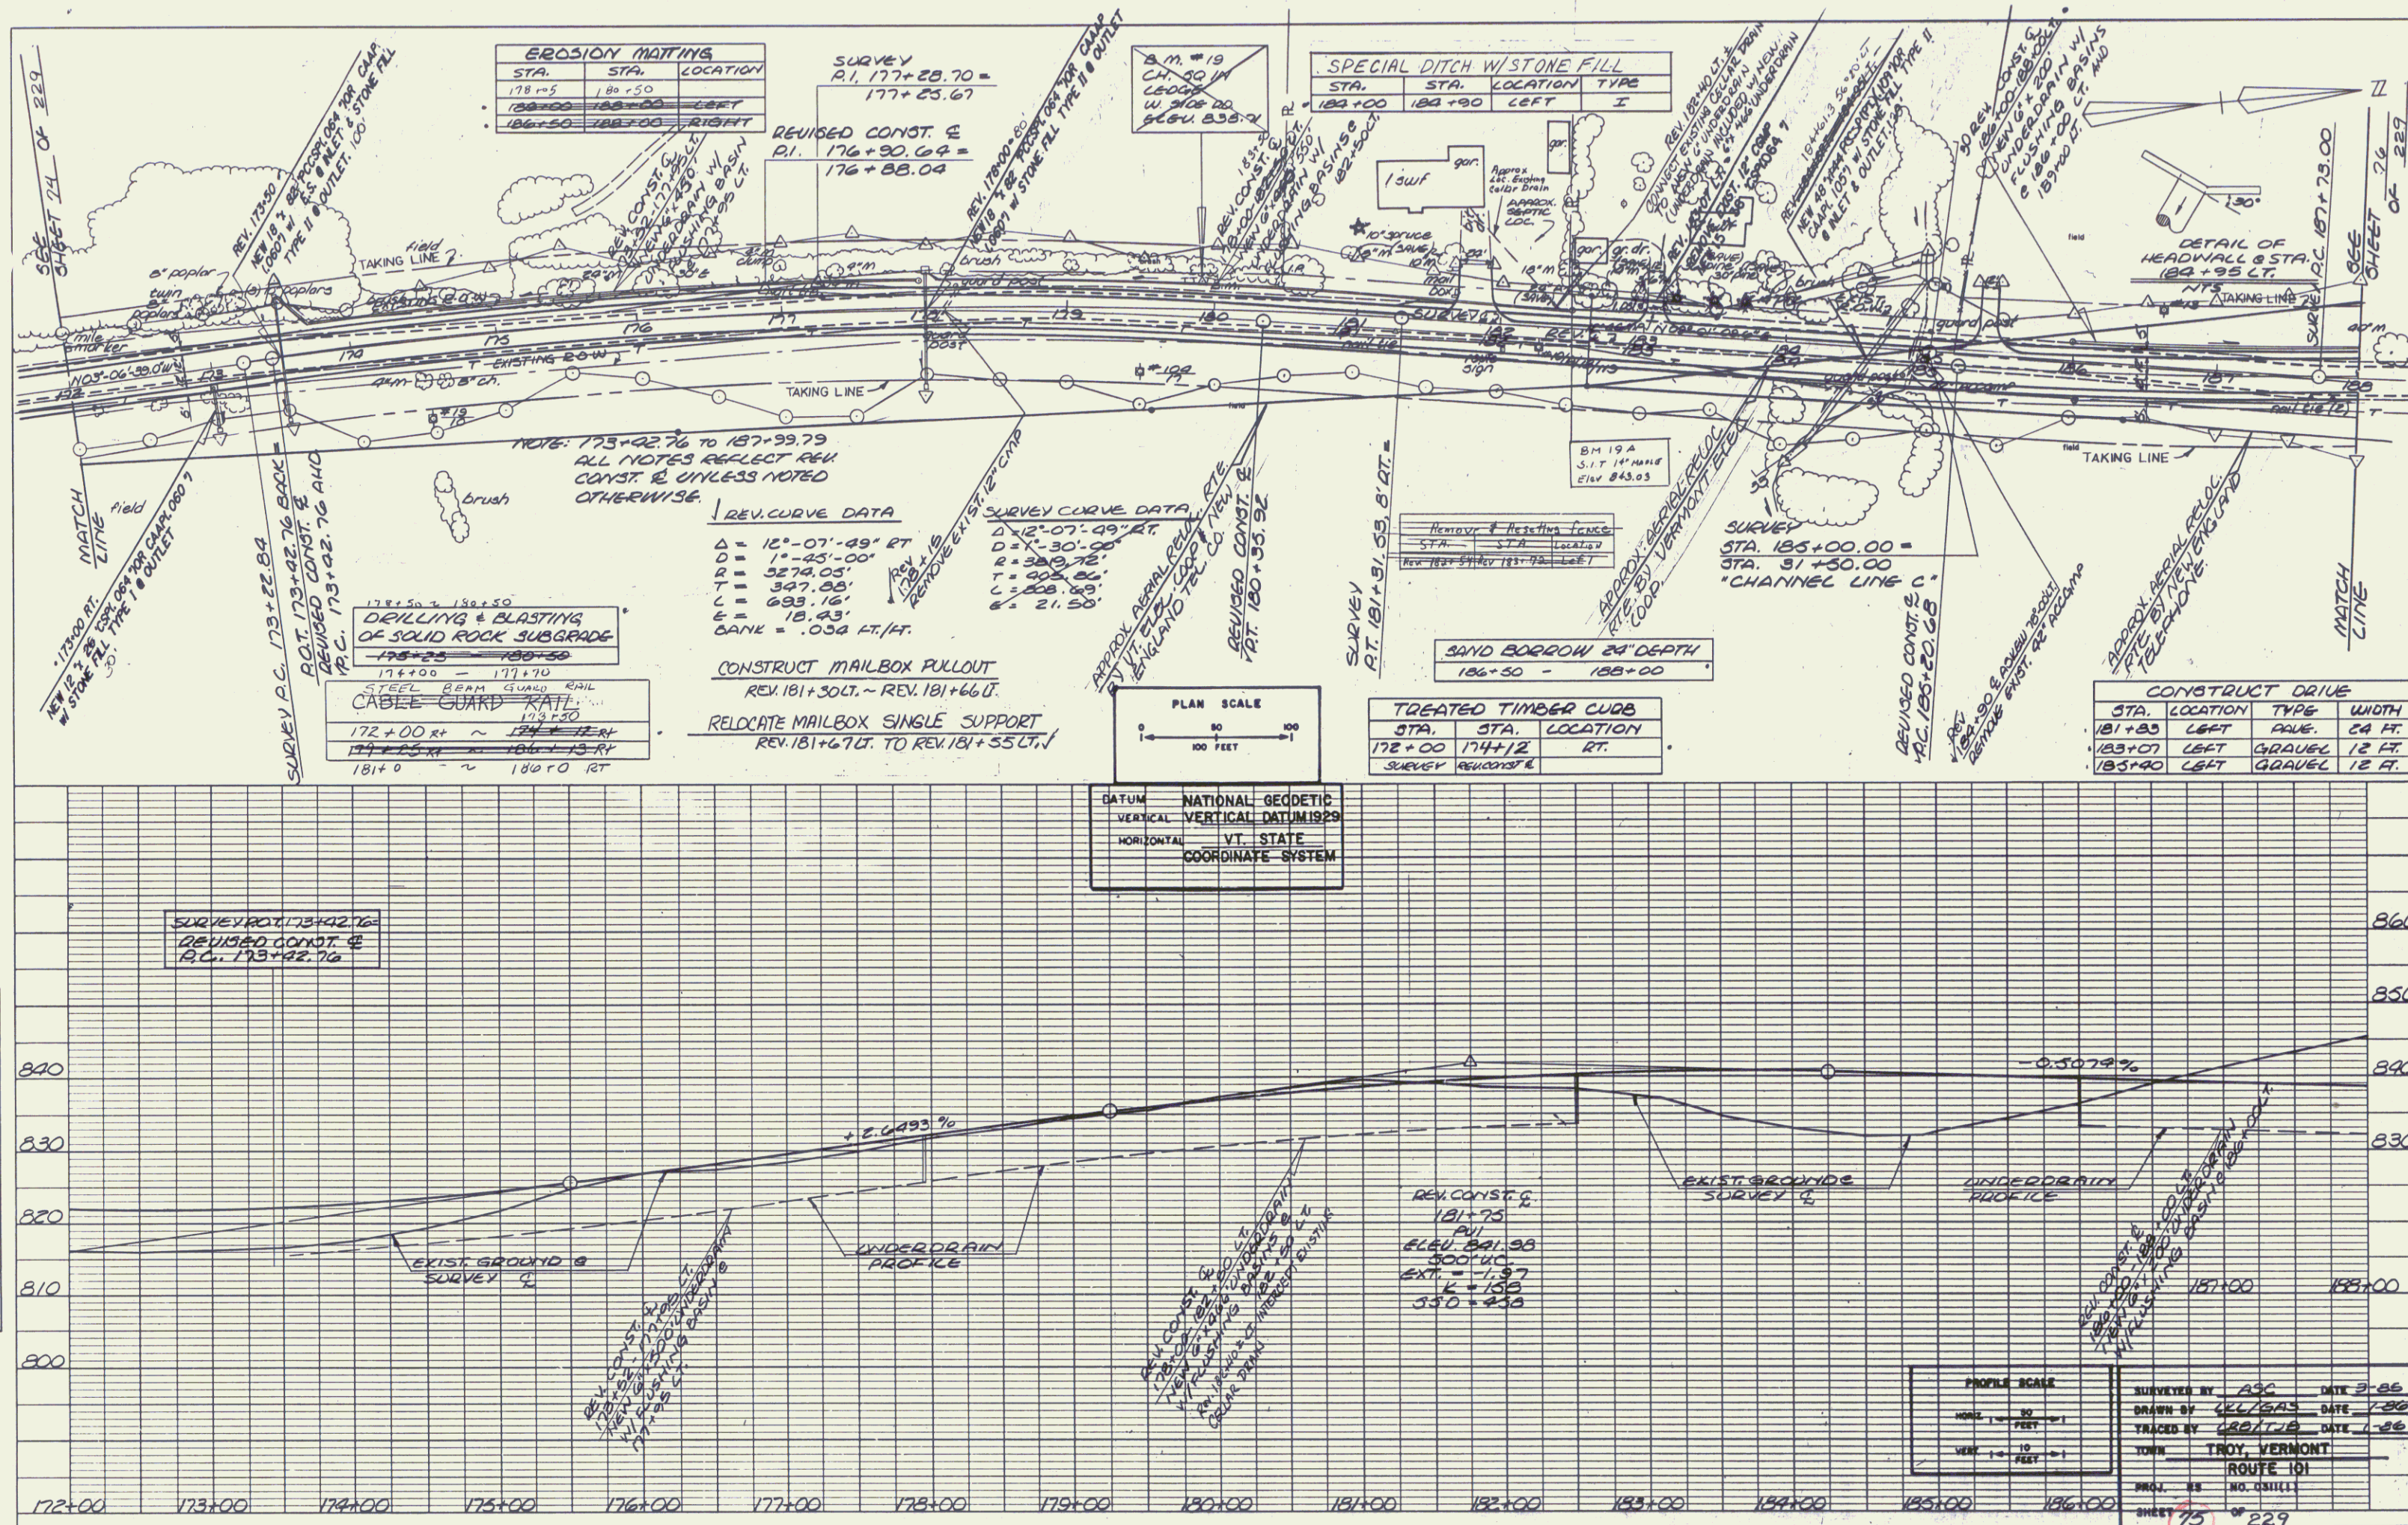

PLAN	DATE	BY
NO.		

PROFILE	DATE	BY
NO.		

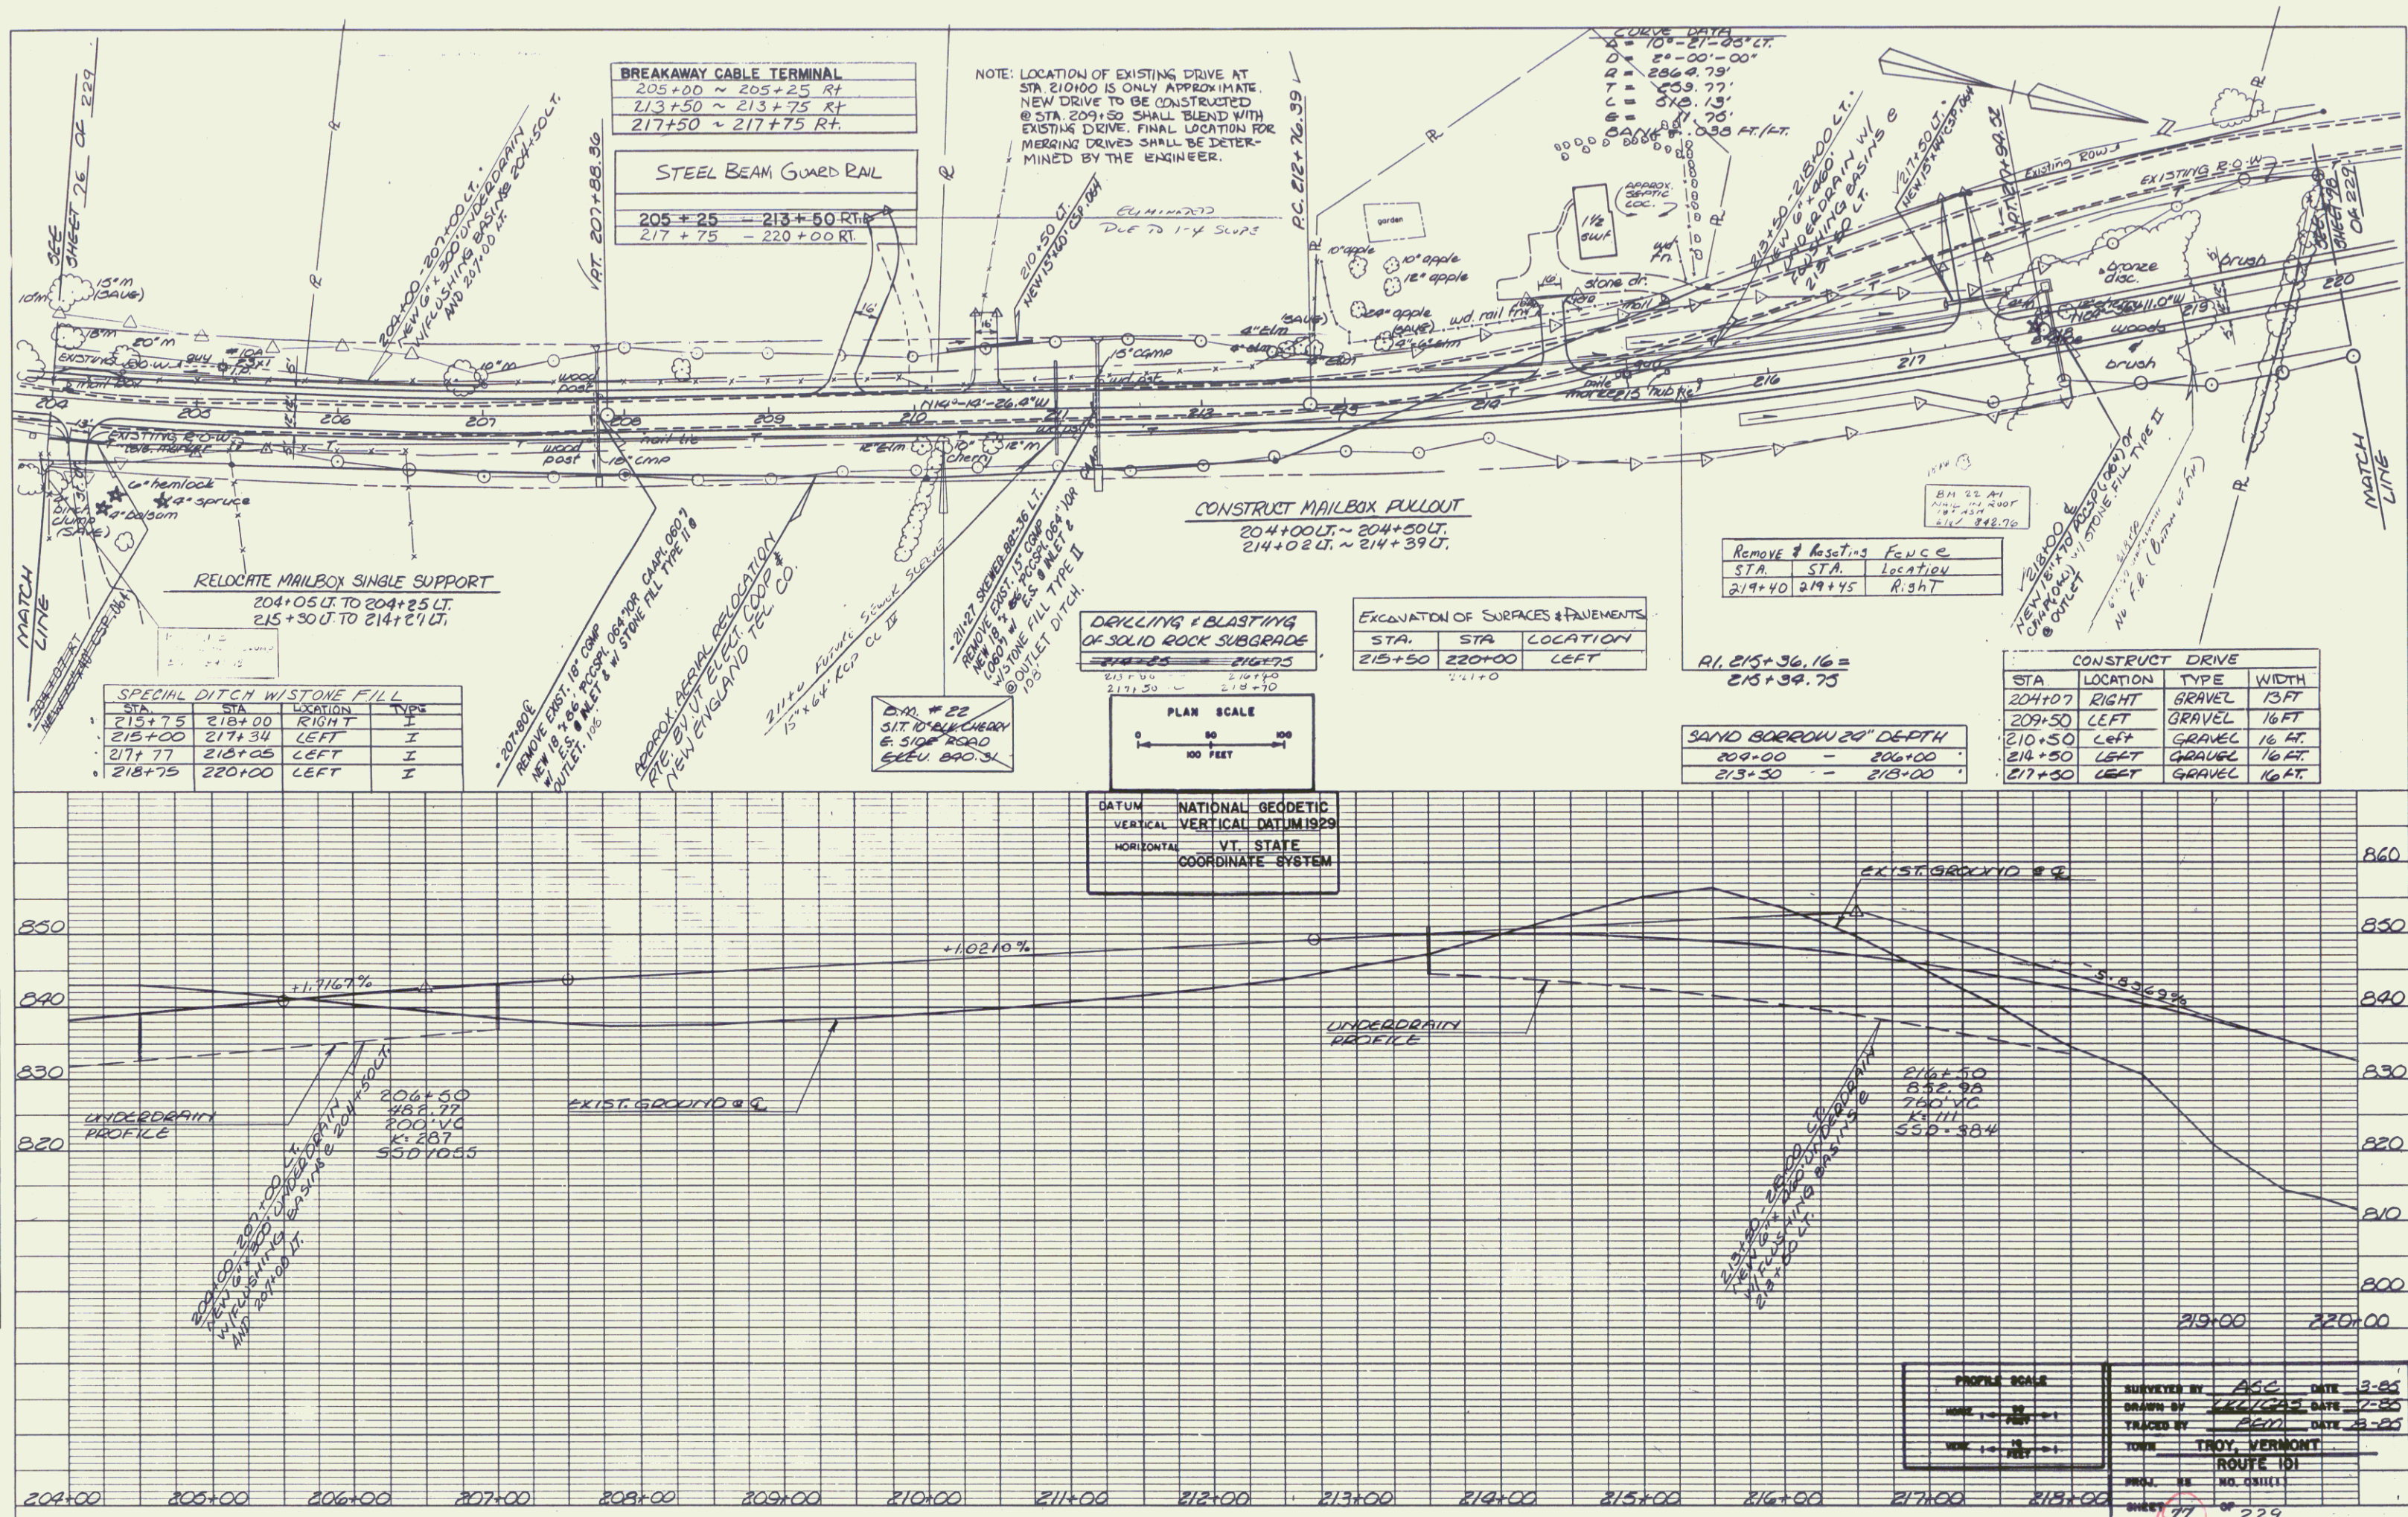

MAR 29 1995

PLAN
NO.
DATE
BY
CHECKED
DATE
BY
DATE
BY
DATE

PROFILE
NO.
DATE
BY
CHECKED
DATE
BY
DATE
BY
DATE


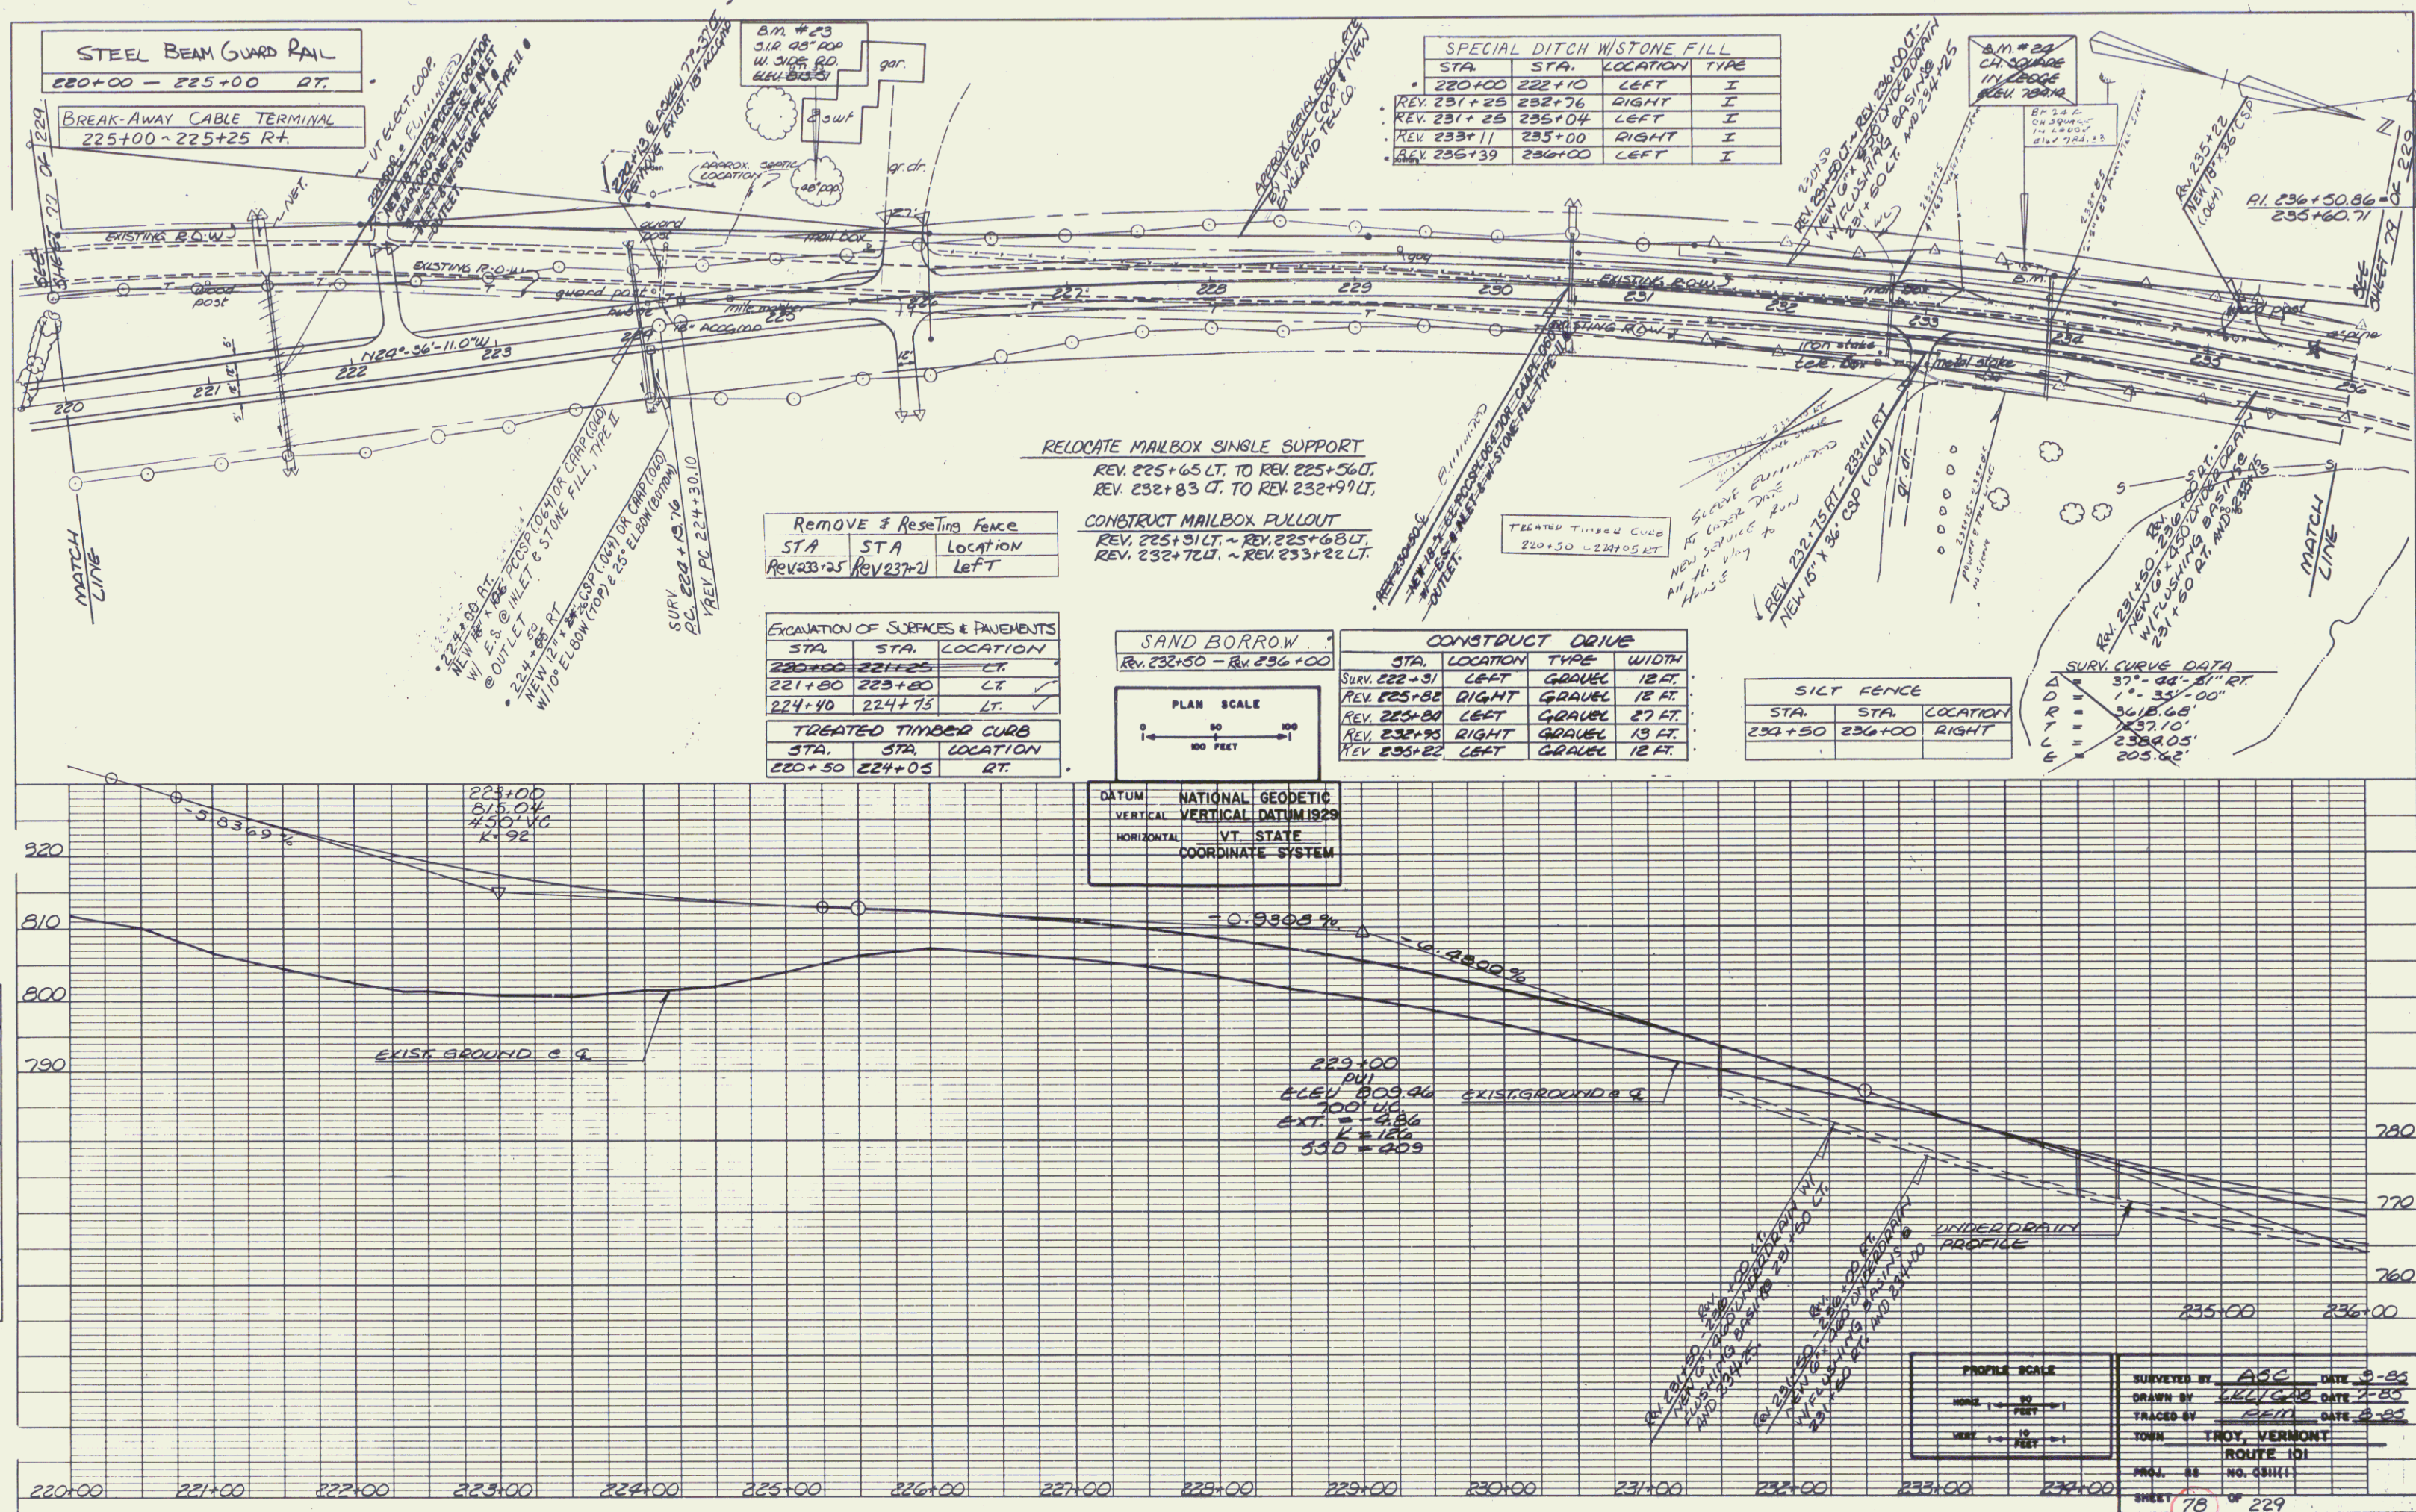


PLATE 1 PLAN/PROFILE OF P. & S. E. STANDARD
DATE: 10/1/85
PRINTED IN U.S.A.

MAR 29 1995 75

PLAN	DATE
NOTED BOOK	
NO.	

PROFILE	DATE
NOTED BOOK	
NO.	

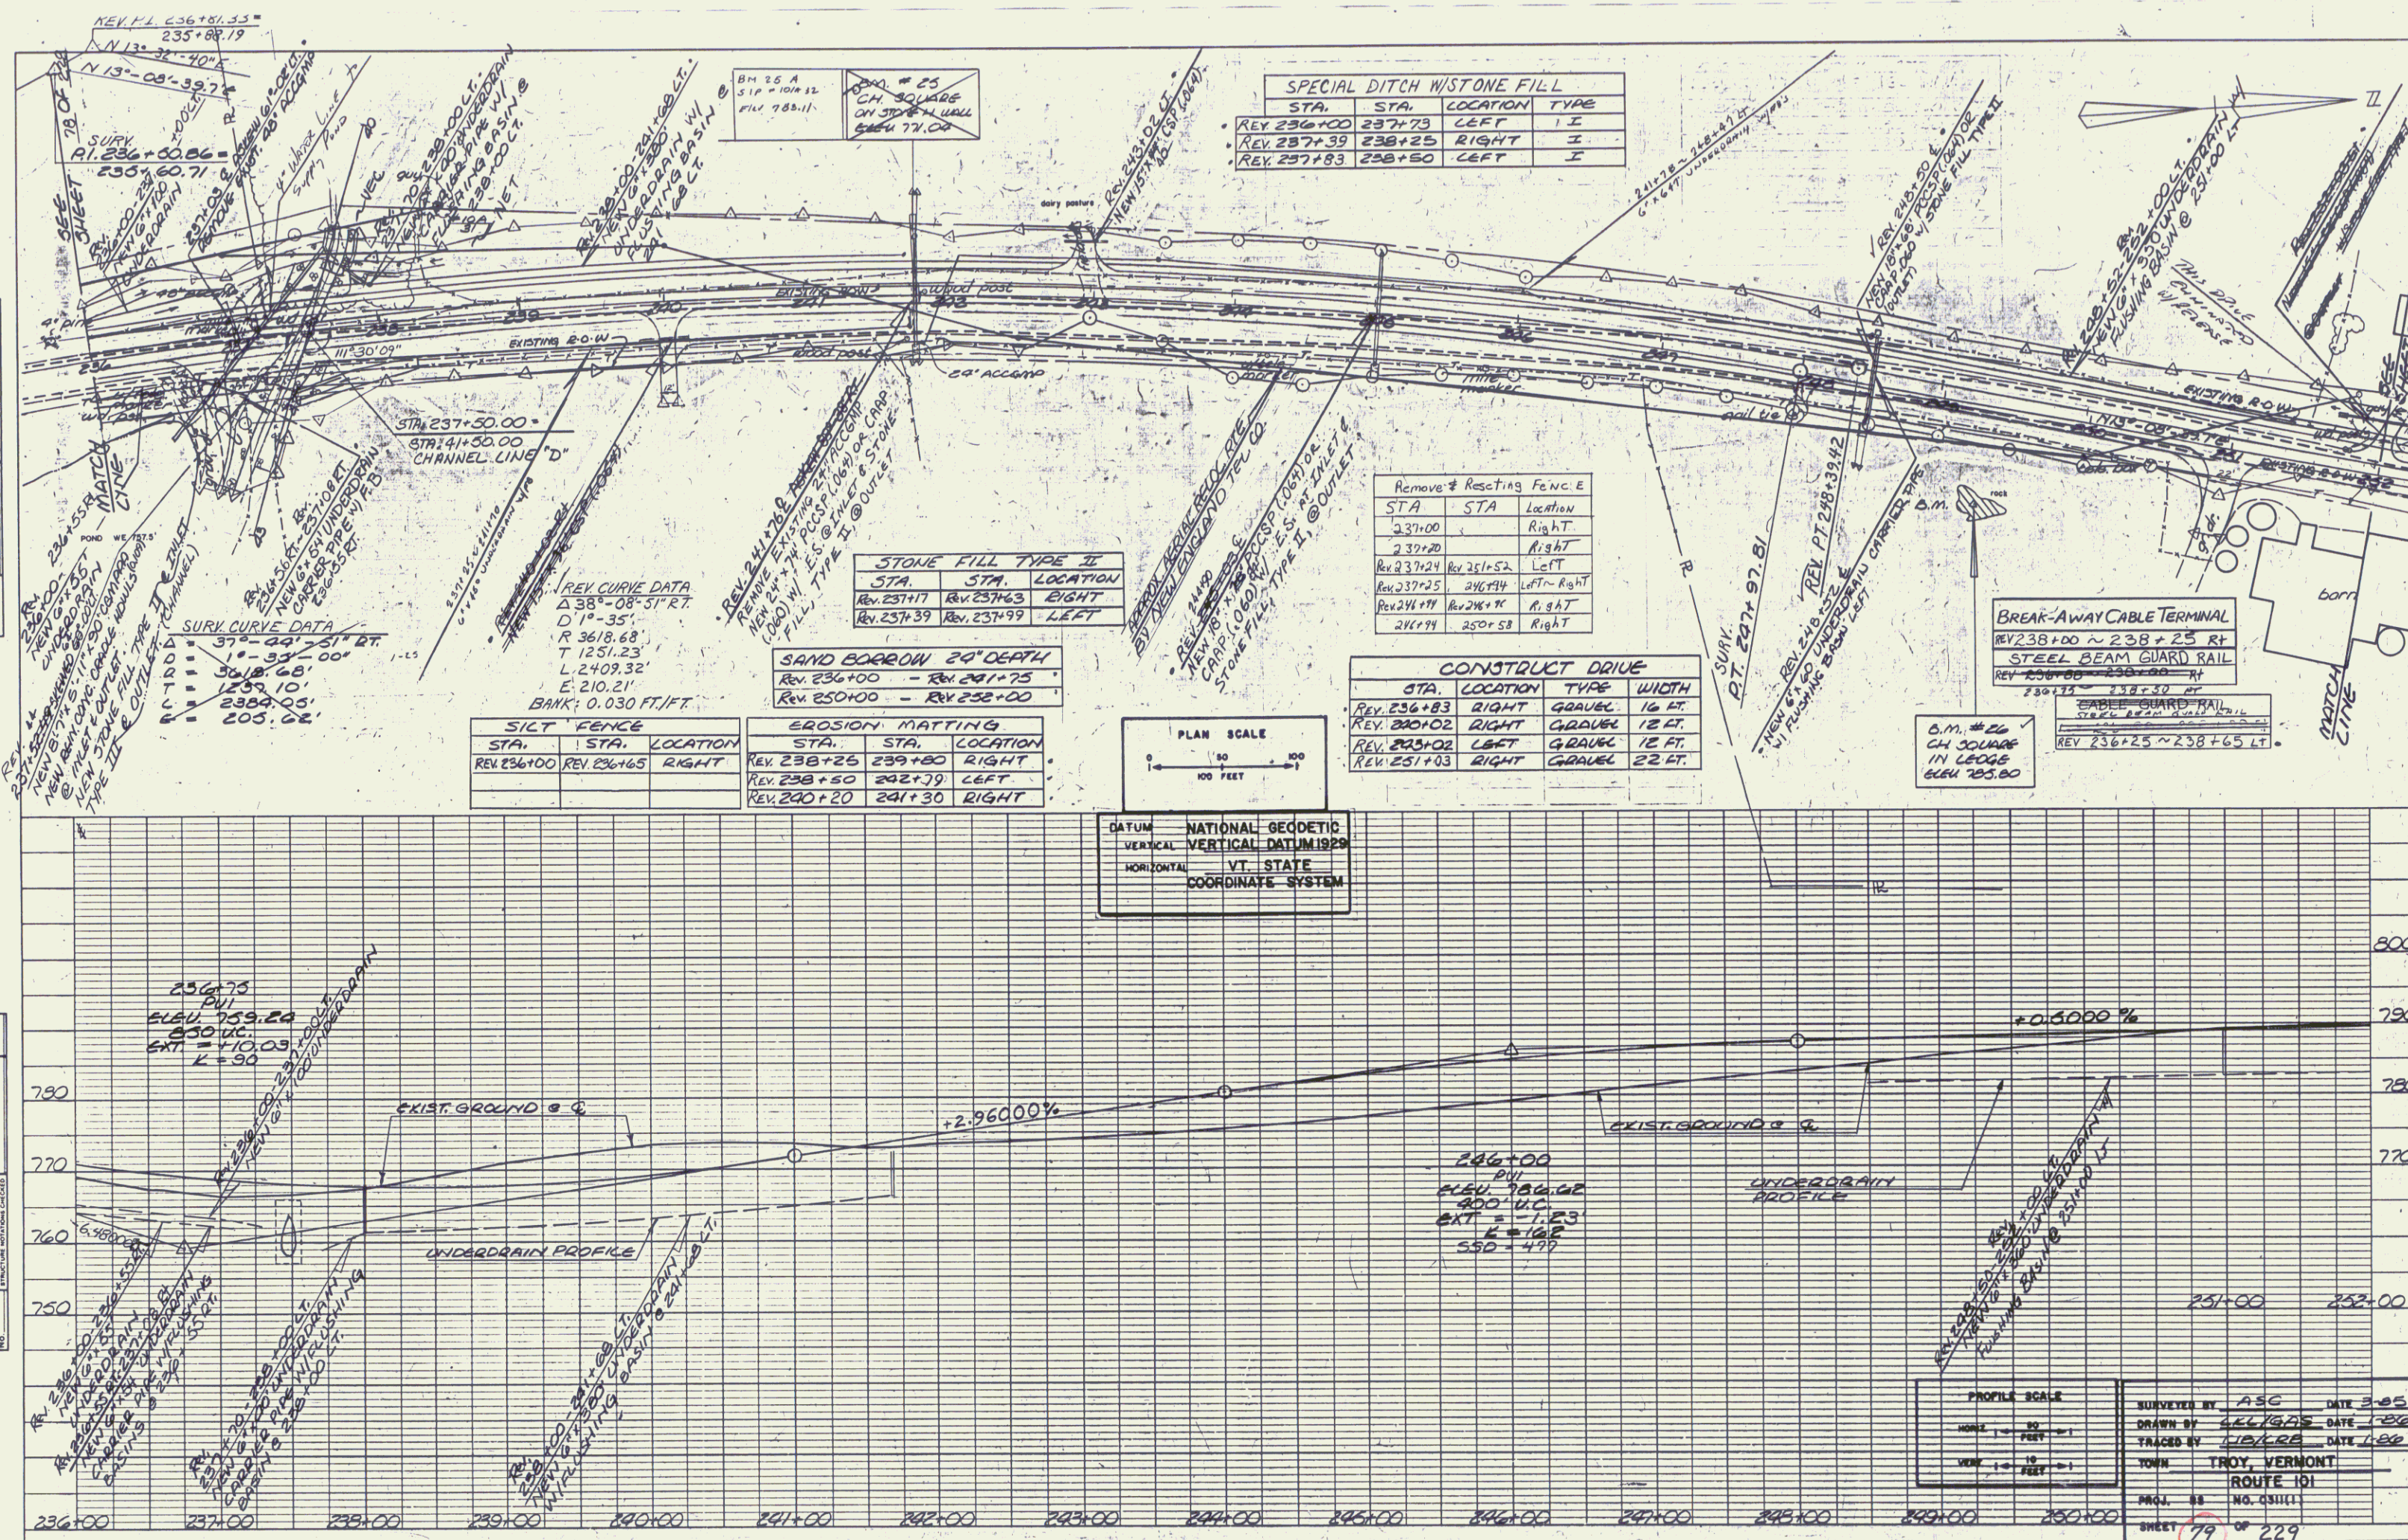

MAR 29 1995

PLAN

DATE

BY

REVISIONS

NO.

NOTE BOOK

NO.

PROFILE

DATE


BY

REVISIONS

NO.

NOTE BOOK

NO.

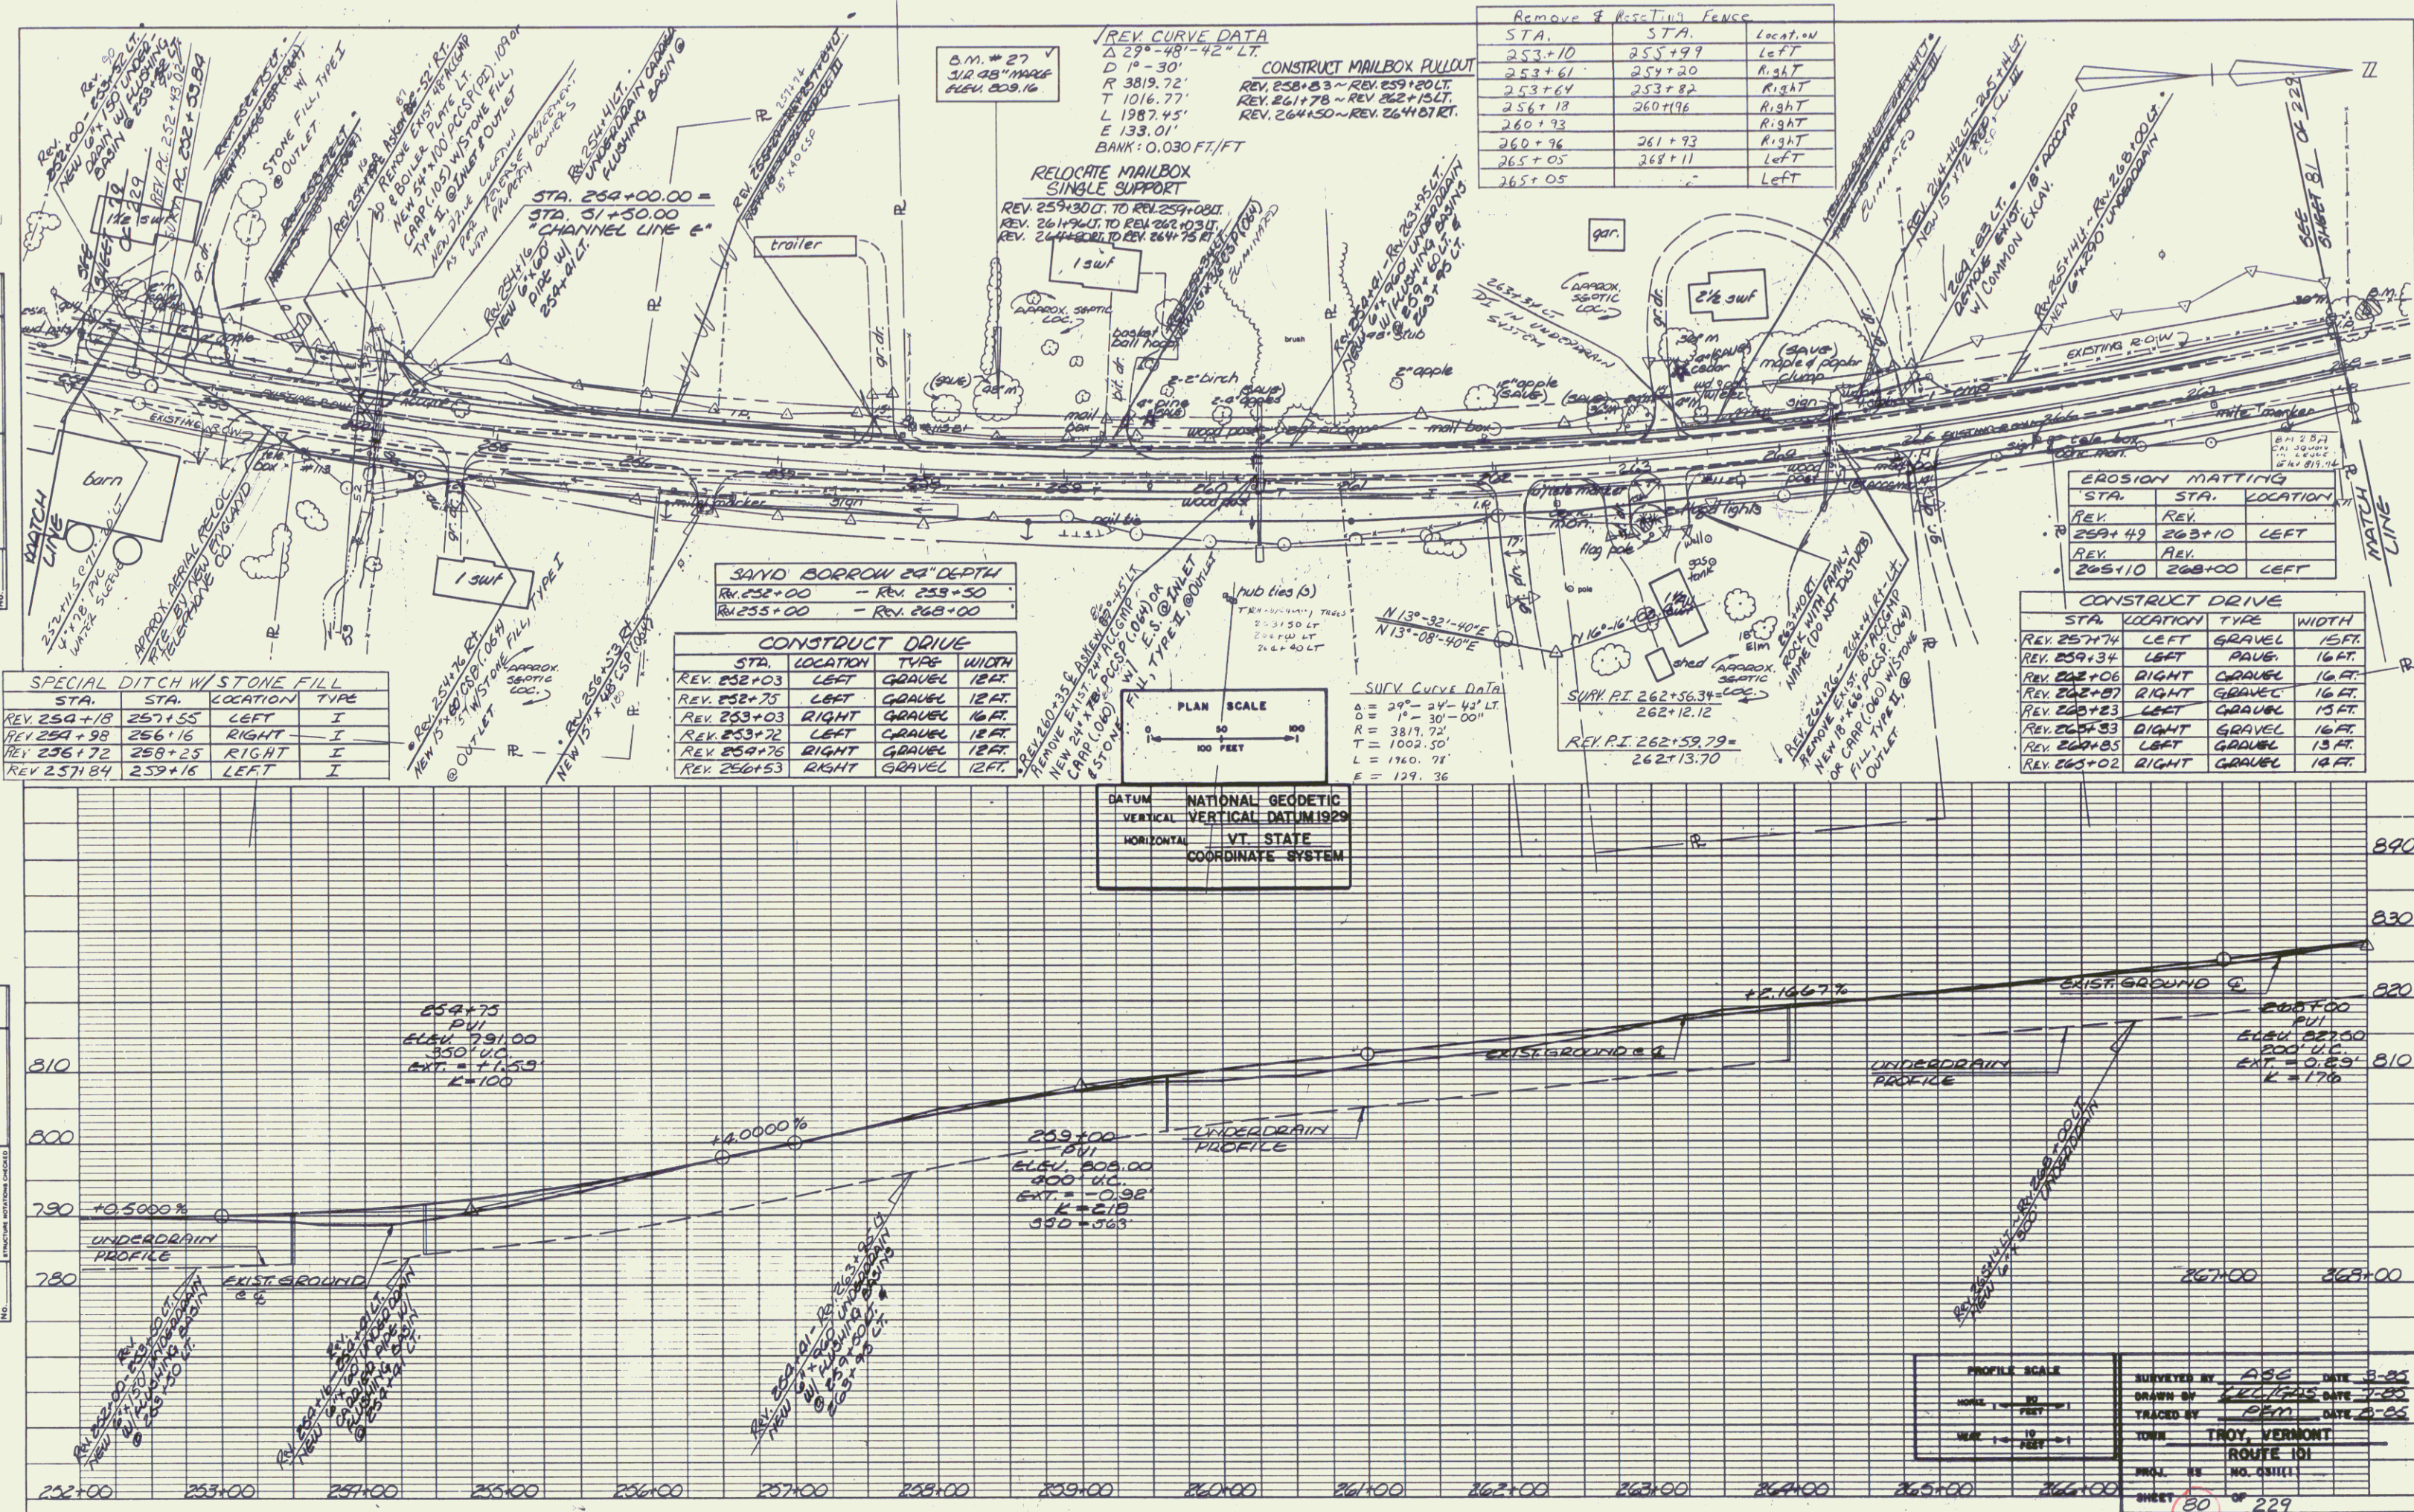


MAR 29 1995

77

PLAN	DATE
NOTE BOOK	

PROFILE	DATE
NOTE BOOK	

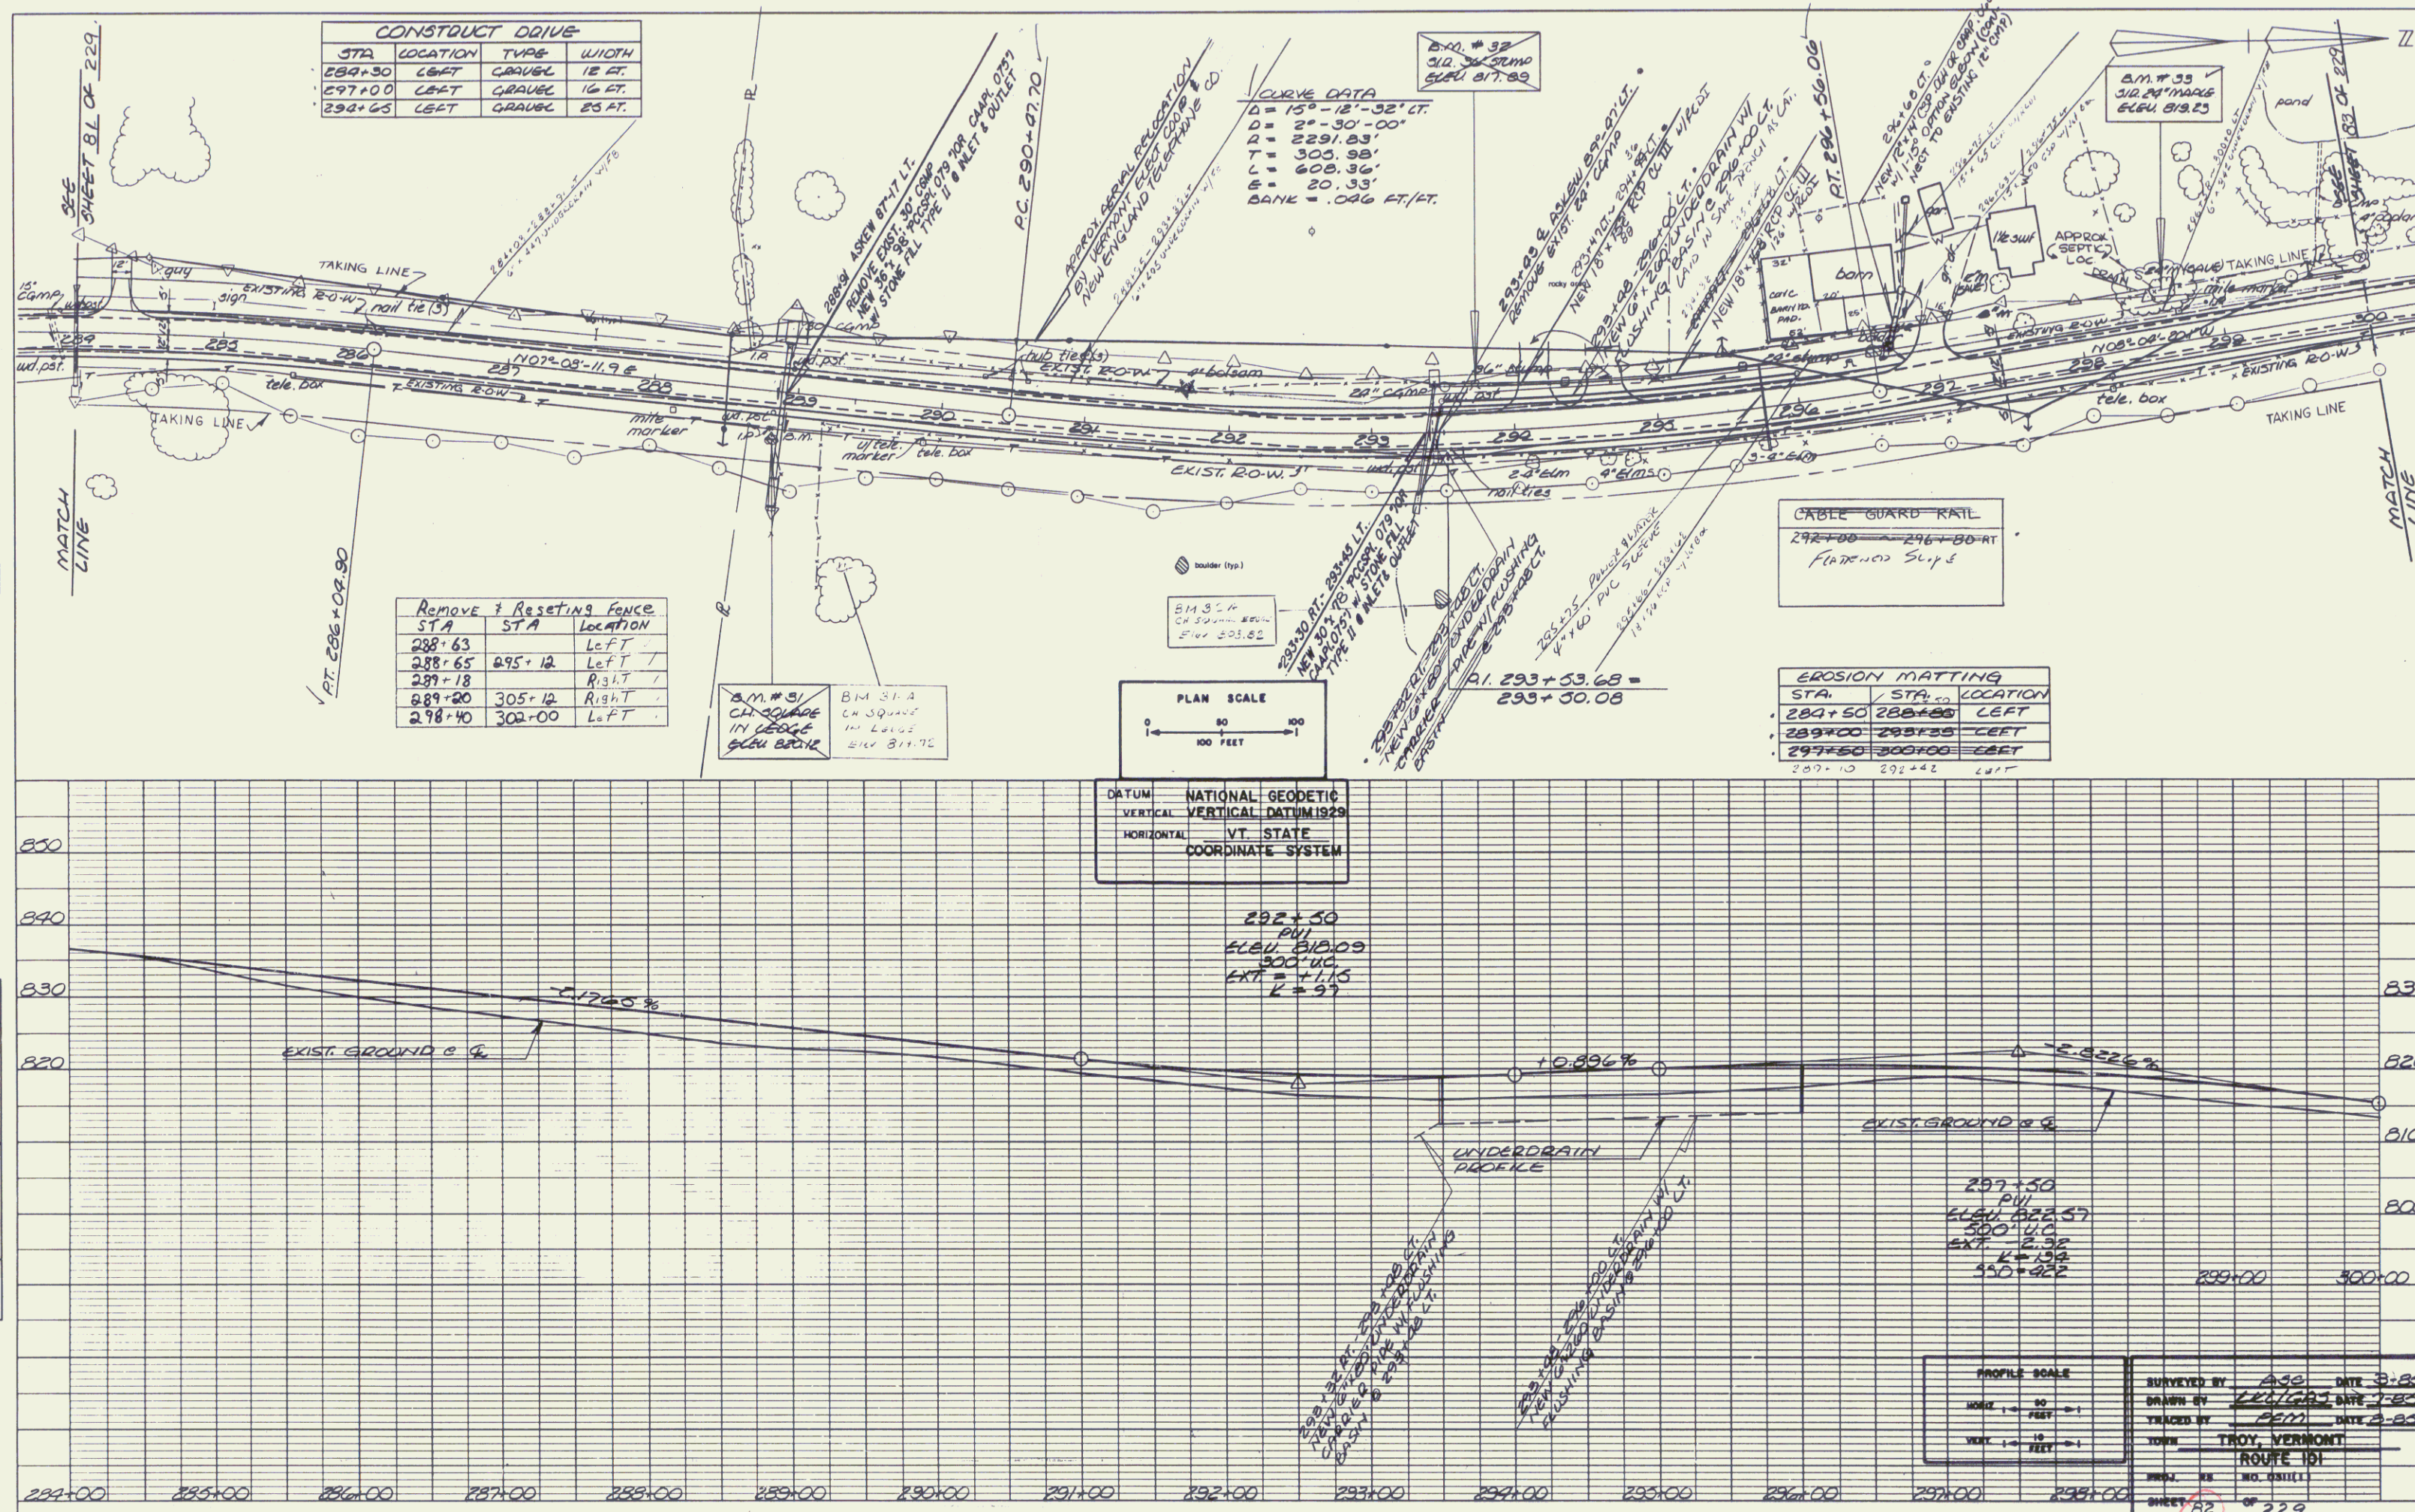

MAR 29 1995

79

PLAN	DATE
NOTES	
BOOK	
NO.	

PROFILE	DATE
NOTES	
BOOK	
NO.	

