
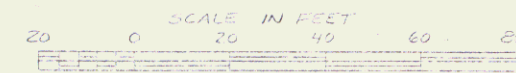



POOR ORIGINAL COPY

DATE
BY
CHECKED
DATE
BY

DATE
BY
CHECKED
DATE
BY

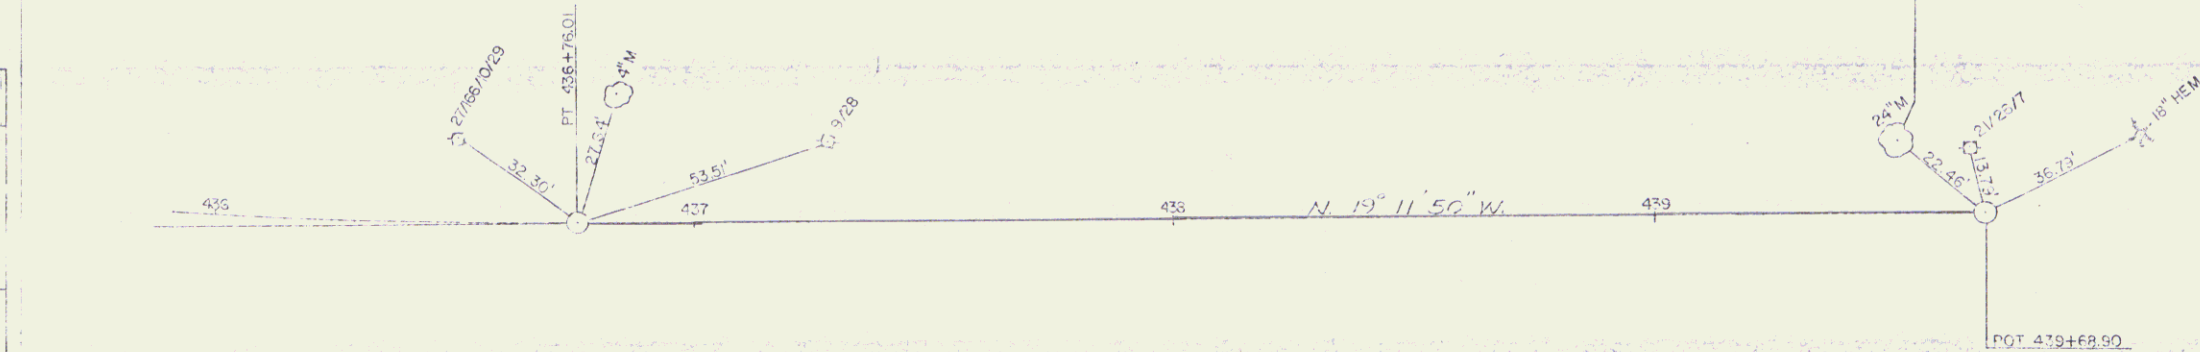

PROFILE
SCALE IN FEET

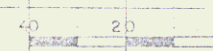

WESTMINSTER-ROCKINSHAM
P.R.S. 01111111
MAINLINE
SURV BY FALL 8-82
SHEET 23 OF 27