

R.O.W. PLANS

STATE OF VERMONT AGENCY OF TRANSPORTATION



PROPOSED IMPROVEMENT BRIDGE PROJECT

TOWN OF CASTLETON

COUNTY OF RUTLAND


ROUTE NO : VT 4A

BRIDGE NO : 8

PROJECT LOCATION : The Bridge is at MM 4.20 east from Fair Haven.
The Project Limits are MM 4.17 and MM 4.23.

PROJECT DESCRIPTION : Replace bridge and approaches.

LENGTH OF STRUCTURE : 60.20 FEET.
LENGTH OF ROADWAY : 264.80 FEET.
LENGTH OF PROJECT : 325.00 FEET.
LENGTH OF ROW PROJECT : 528.2 FEET

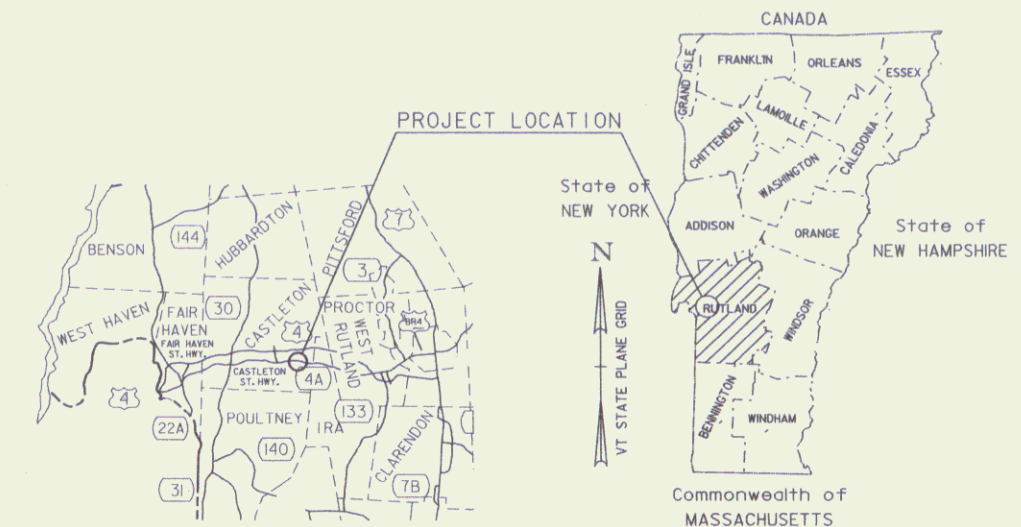

END MAINTENANCE AGREEMENT ZONE
TH #8 STA. 500+26.39 CL

BEGIN MAINTENANCE AGREEMENT ZONE
TH #8 STA. 500+11.00 CL LENGTH : 16.39'

BEGIN R.O.W. PROJECT RS 0142(10)
STA. 398+96.8 33.5' LT.


END R.O.W. PROJECT
RS 0142(10)
STA. 404+25.00 55.00' RT.

CONVENTIONAL SYMBOLS

COUNTY LINE	— — — — —
TOWN LINE	— — — — —
LIMITS OF ACCESS	— — — — —
POINT OF ACCESS	X
FENCE LINE	X — X — X — X —
STONE WALL	— — — — —
TRAVELED WAY	— — — — —
GUARD RAIL	— — — — —
RAILROAD	— — — — —
SURVEY LINE	— — — — —
CULVERT	— — — — —
POWER POLE	⊕
TELEPHONE POLE	⊕
TREES	⊕
CONTROL OF ACCESS	— — — — —
PROPERTY LINE	— — — — —
R.O.W. TAKING LINE	— — — — —
SLOPE RIGHTS	— — — — —
TOP OF CUT	— — — — —
TOE OF SLOPE	— — — — —

SURVEYED BY : ORVIS
SURVEYED DATE : 07-23-2002

DATUM
VERTICAL NAVD 88
HORIZONTAL NAD 83 (1996)

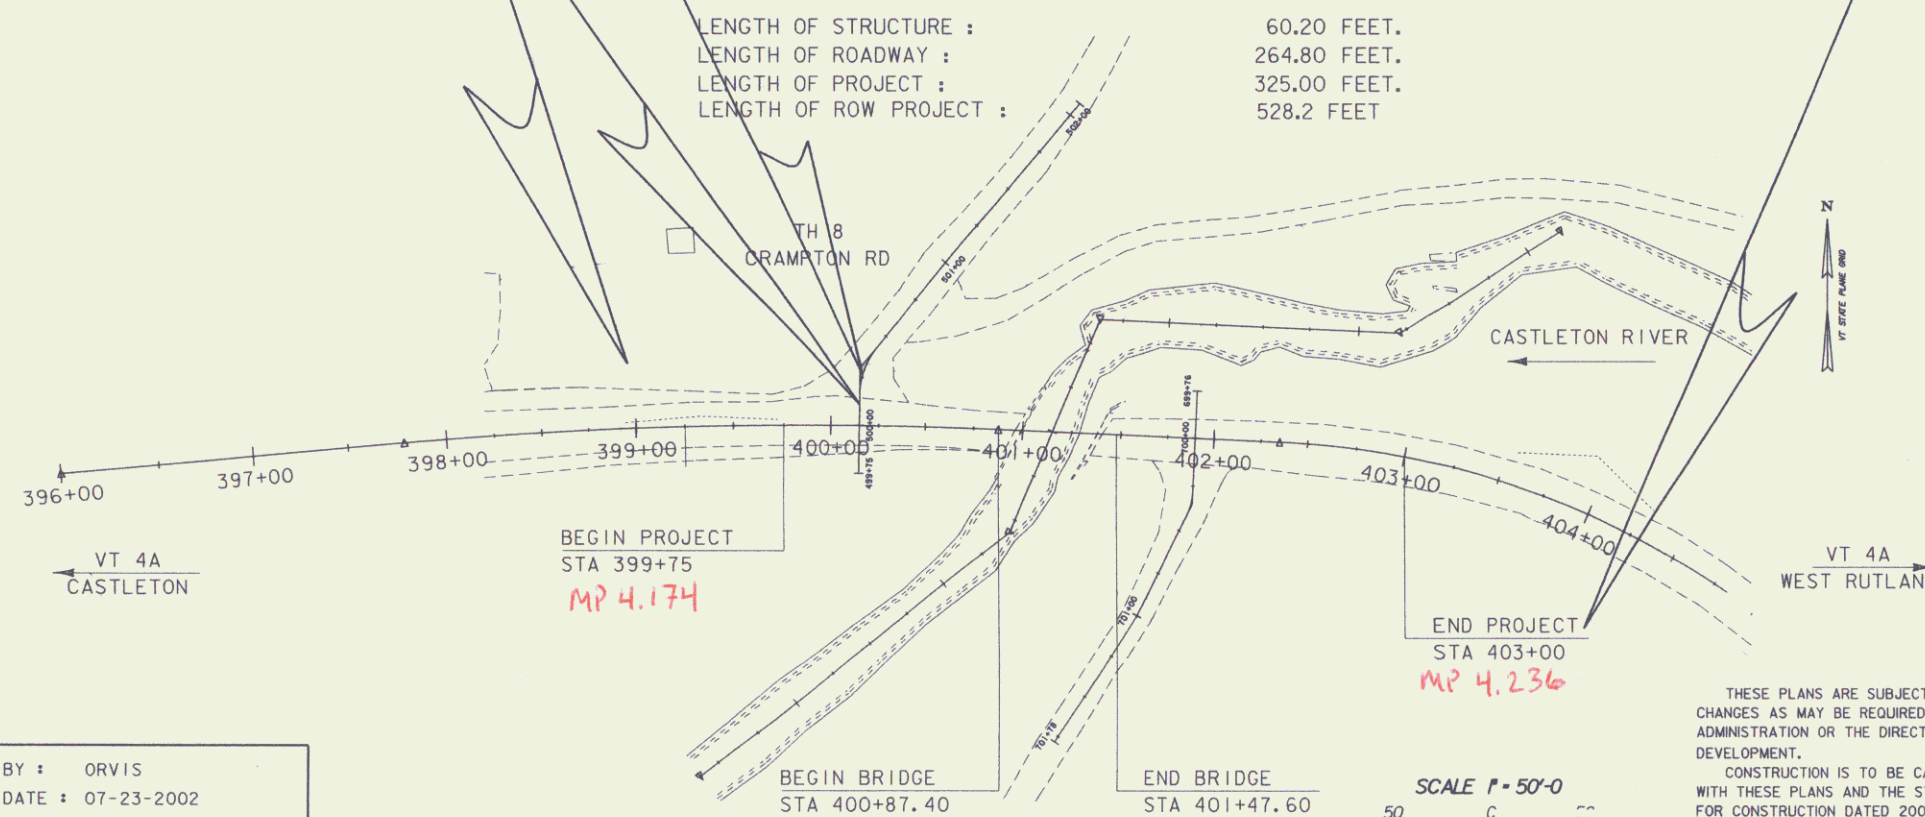

SCALE 1" = 50'-0"

THESE PLANS ARE SUBJECT TO SUCH ENGINEERING CHANGES AS MAY BE REQUIRED BY THE FEDERAL HIGHWAY ADMINISTRATION OR THE DIRECTOR OF PROJECT DEVELOPMENT.
CONSTRUCTION IS TO BE CARRIED ON IN ACCORDANCE WITH THESE PLANS AND THE STANDARD SPECIFICATIONS FOR CONSTRUCTION DATED 2001, AS APPROVED BY THE FEDERAL HIGHWAY ADMINISTRATION ON JANUARY 4, 2001 FOR USE ON THIS PROJECT, INCLUDING ALL SUBSEQUENT REVISIONS AND SUCH REVISED SPECIFICATIONS AND SPECIAL PROVISIONS AS ARE INCORPORATED IN THESE PLANS.

78f193/str/sf193bdr.dgn sf193ts.i 27-SEP-2005

SEP 16 2008

PIN # 78F193

APPROVED *Richard J. Feltz* DATE 9-22-05
Director of Program Development

APPROVED *William J. Mee* DATE 9/23/05
Chief of Right of Way

CASTLETON
RS 0142(10)

R.O.W. SHEET 1 OF 14 SHEETS