

CONSTRUCT DRIVE
89+50 LT (36' GRAVEL)
90+65 RT (18' GRAVEL)
92+50 LT (12' GRAVEL)
93+25 RT (30' GRAVEL)
92+20 RT (18' GRAVEL)

4' Island w/Gravel Slope Edging
93+40 ~ 94+00 RT
Note: Slope Edging to be
set with a 4" Reveal

Erosion Matting
89+00 LT - 90+40 RT
89+00 LT - 89+25 LT
89+25 LT - 90+25 LT
90+25 LT - 92+45 RT
92+45 LT - 94+00 LT


CURVE DATA
Δ 1°-09'-20" LT
D 1°
R 5729.56
T 57.76
L 115.56
E 0.29



EXISTING GRASS BLDG
(OLD MOTEL)

PUFFER, HAROLD B. & JANET B.

PAVED DRIVE

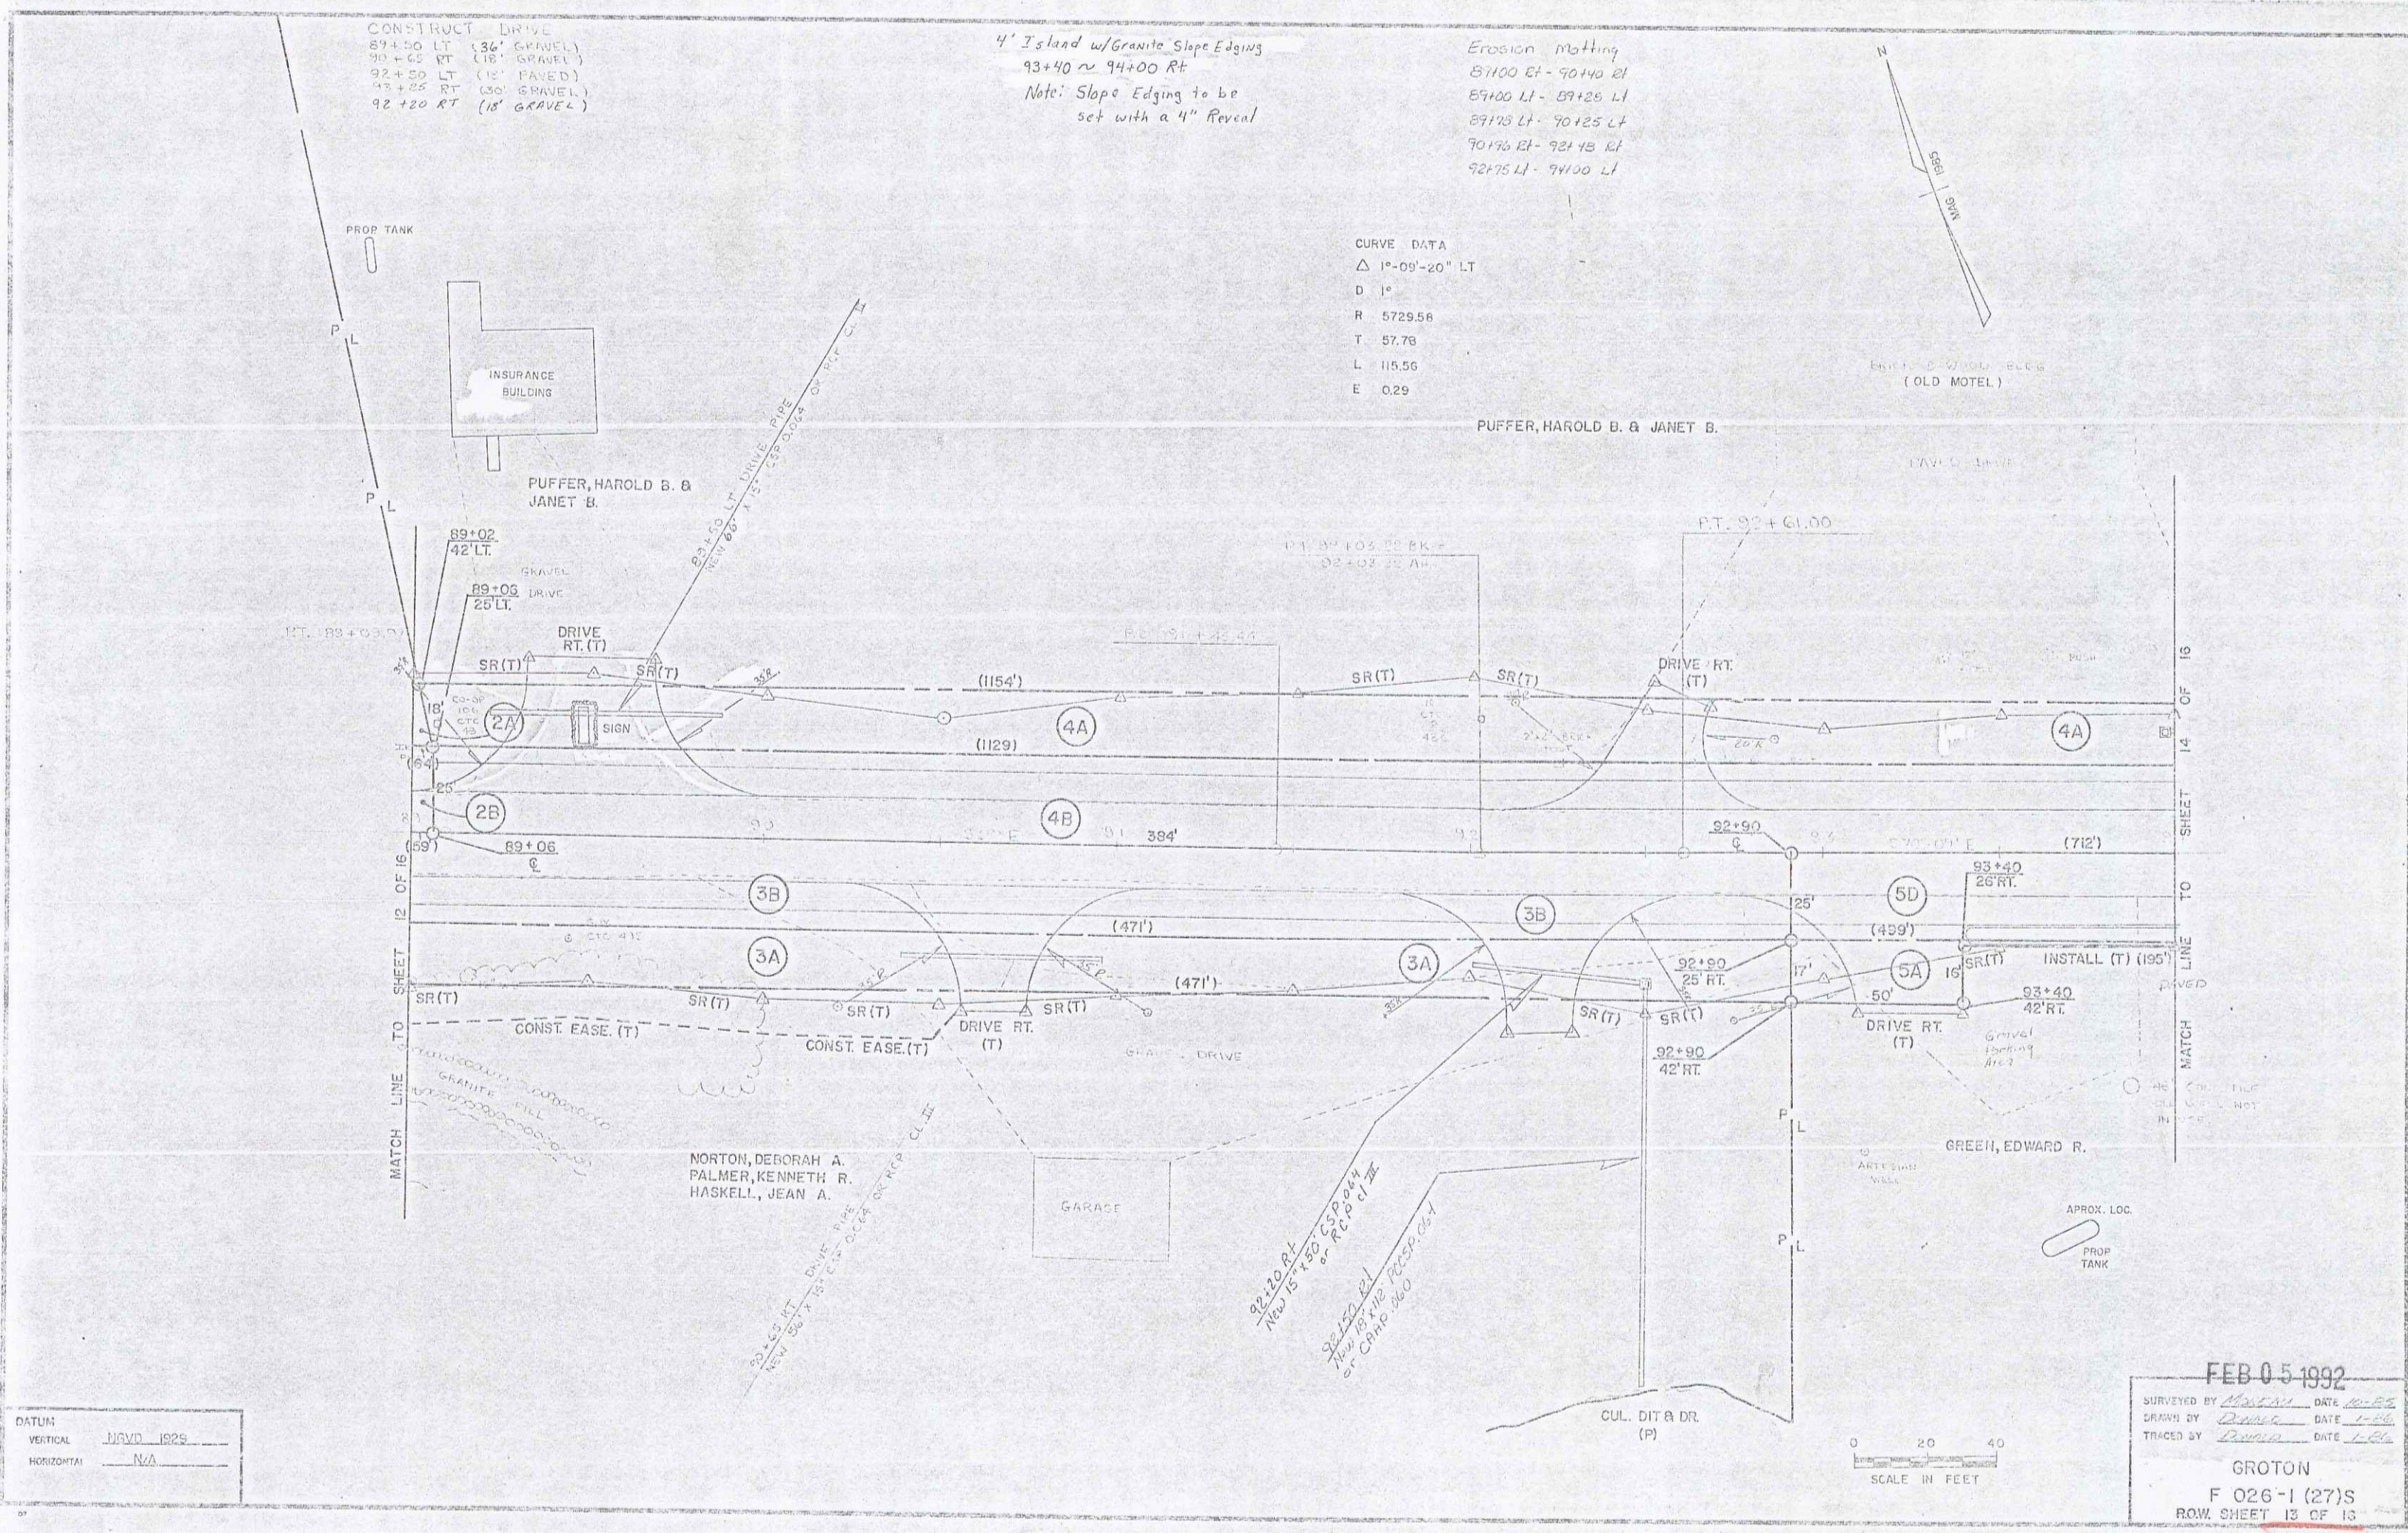

DATUM
VERTICAL NAD 1929
HORIZONTAL N/A

FEB 05 1992
SURVEYED BY Manan DATE 10-88
DRAWN BY Danica DATE 1-89
TRACED BY Danica DATE 1-89
GROTON
F 026-1 (27)S
ROW SHEET 13 OF 13