


Erosion Matting
105+00 - 105+20 RT
105+64 - 106+75 RT




CURVE DATA
Δ 45° 18' RT.
D 2° 45'
R 2083.48'
T 890.63'
L 1683.64'
E 182.45'
BANK 0.05 FT./FT.

END R.O.W. PROJECT
F 026-1 (27)S STA. 105+70 40' RT.

STATE OF VERMONT

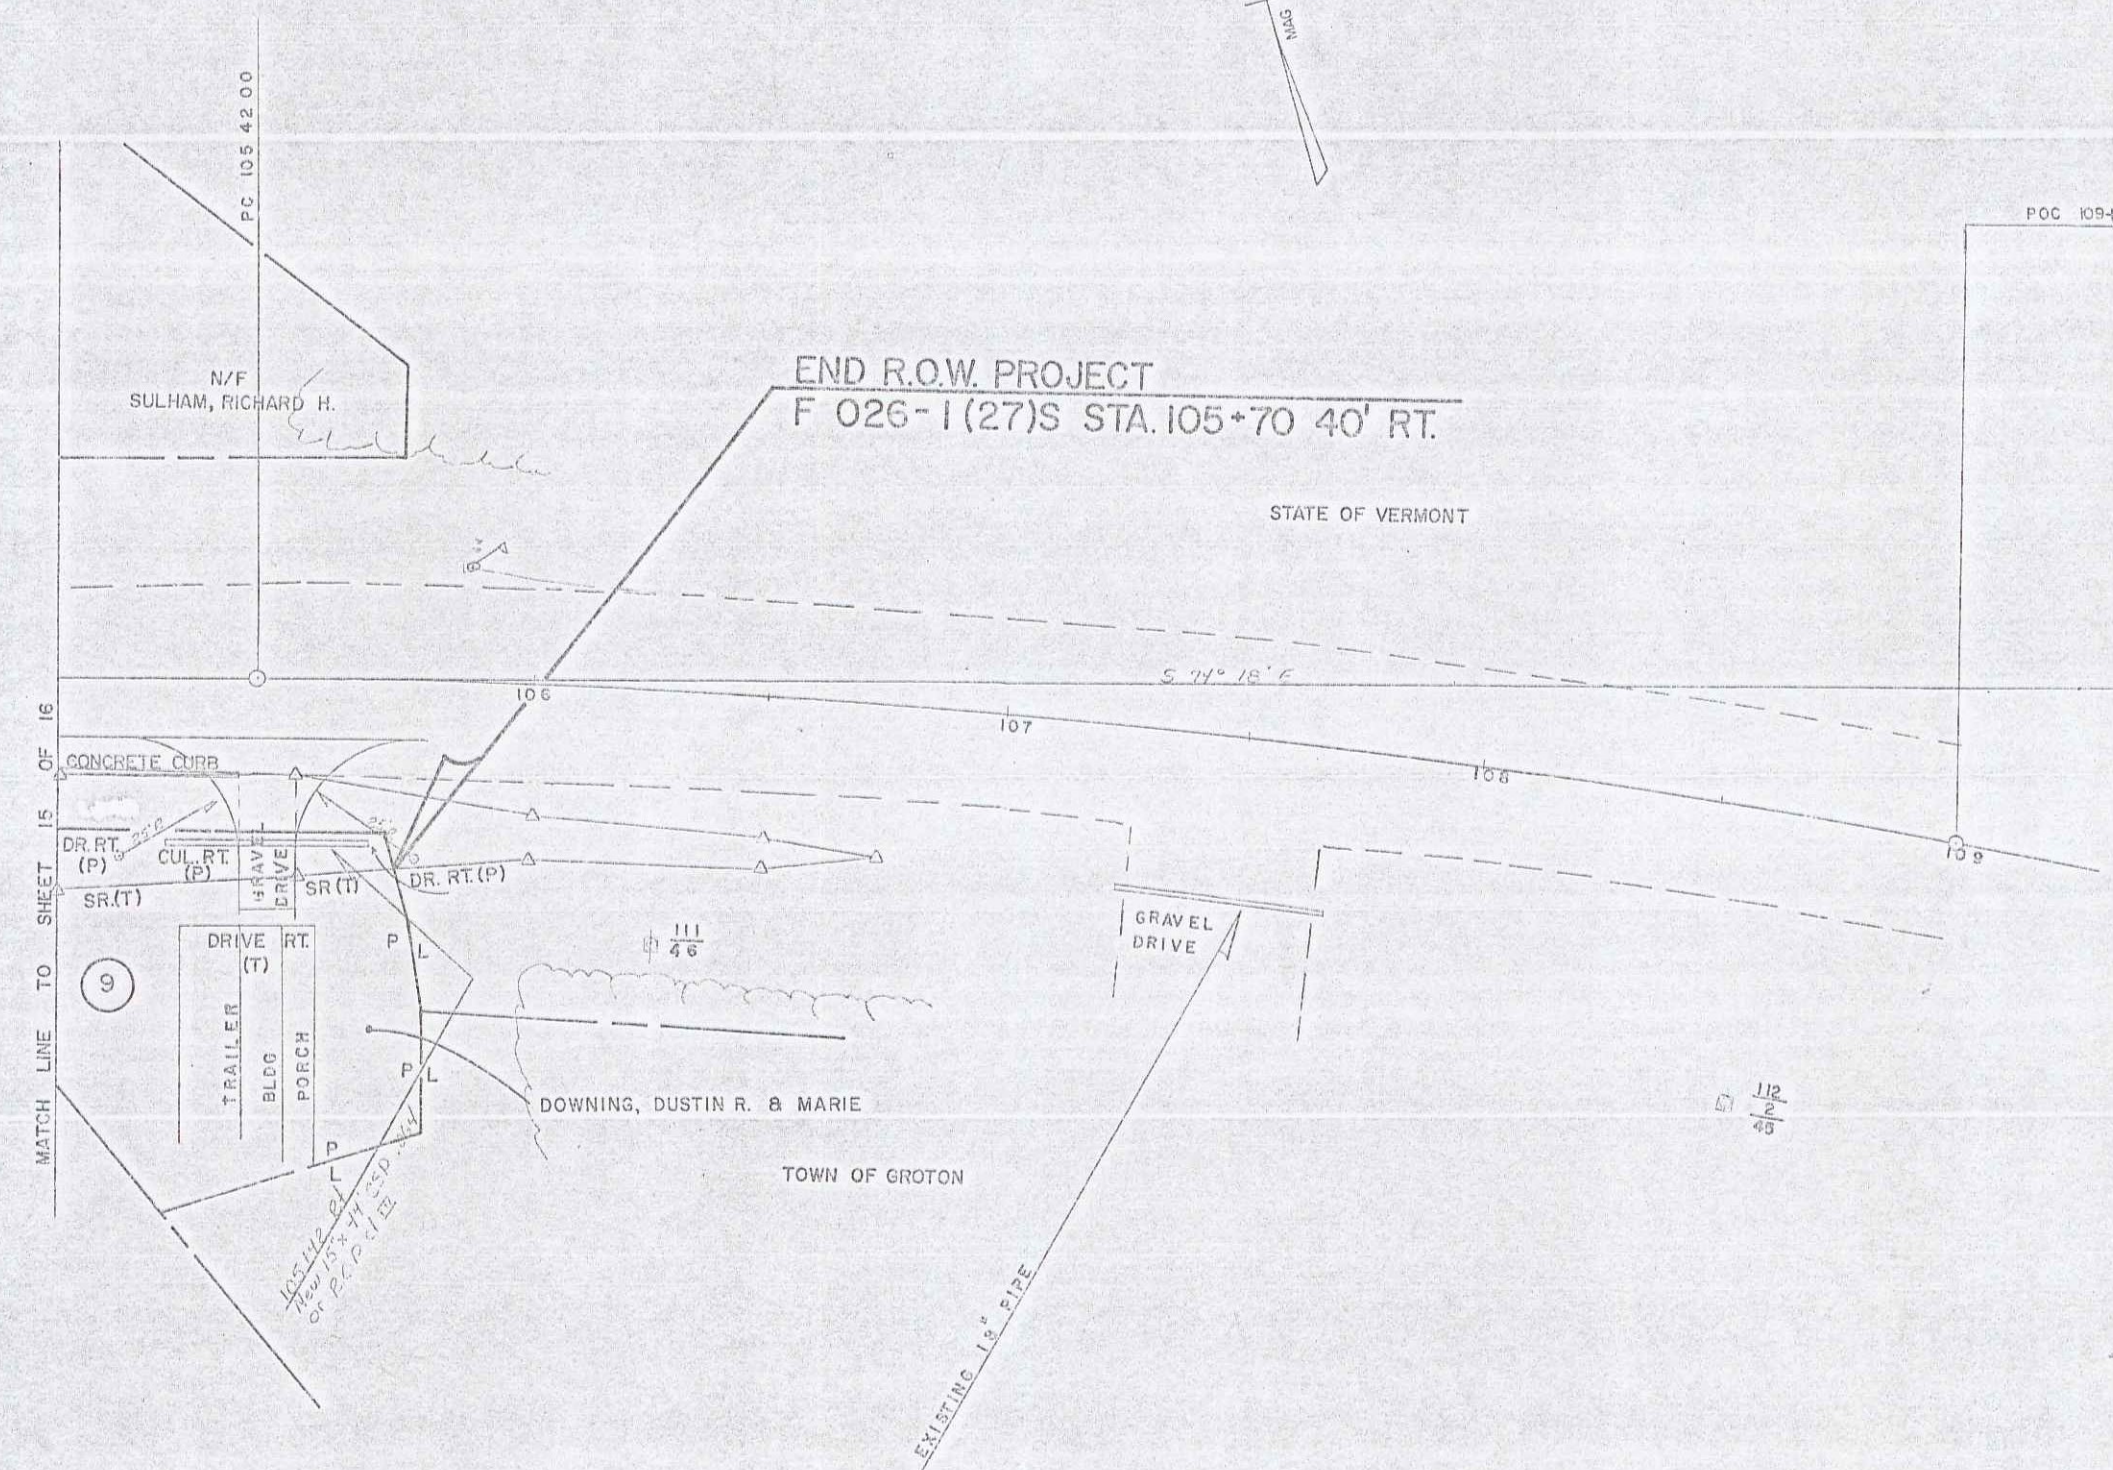

DATUM
VERTICAL NGVD 1929
HORIZONTAL N/A

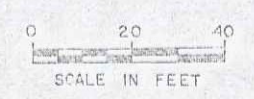

FEB 05 1992
SURVEYED BY John J. Sullivan DATE 2/1/92
DRAWN BY John J. Sullivan DATE 2/1/92
TRACED BY John J. Sullivan DATE 2/1/92
GROTON
F 026-1 (27)S
R.O.W. SHEET 16 OF 16