


PROFILE	SUPPLIED _____	DATE _____
PLOTTED _____		
GRACES CHECKED _____		
B. M. NOTED _____		
STRUCTURE NOTATIONS CHKD NO. _____		

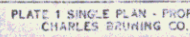

WALLINGFORD & MT. HOLLY
RS 0138 (8)
SHEET 11 OF 22

MAR 19 1993