

STATE OF VERMONT
AGENCY OF TRANSPORTATION


R.O.W. PLANS

TOWNS OF STOWE—MORRISTOWN

COUNTY OF LAMOILLE

RTE. 100

LENGTH OF ROW PROJ. 1850.00 FEET = 0.350 MILES

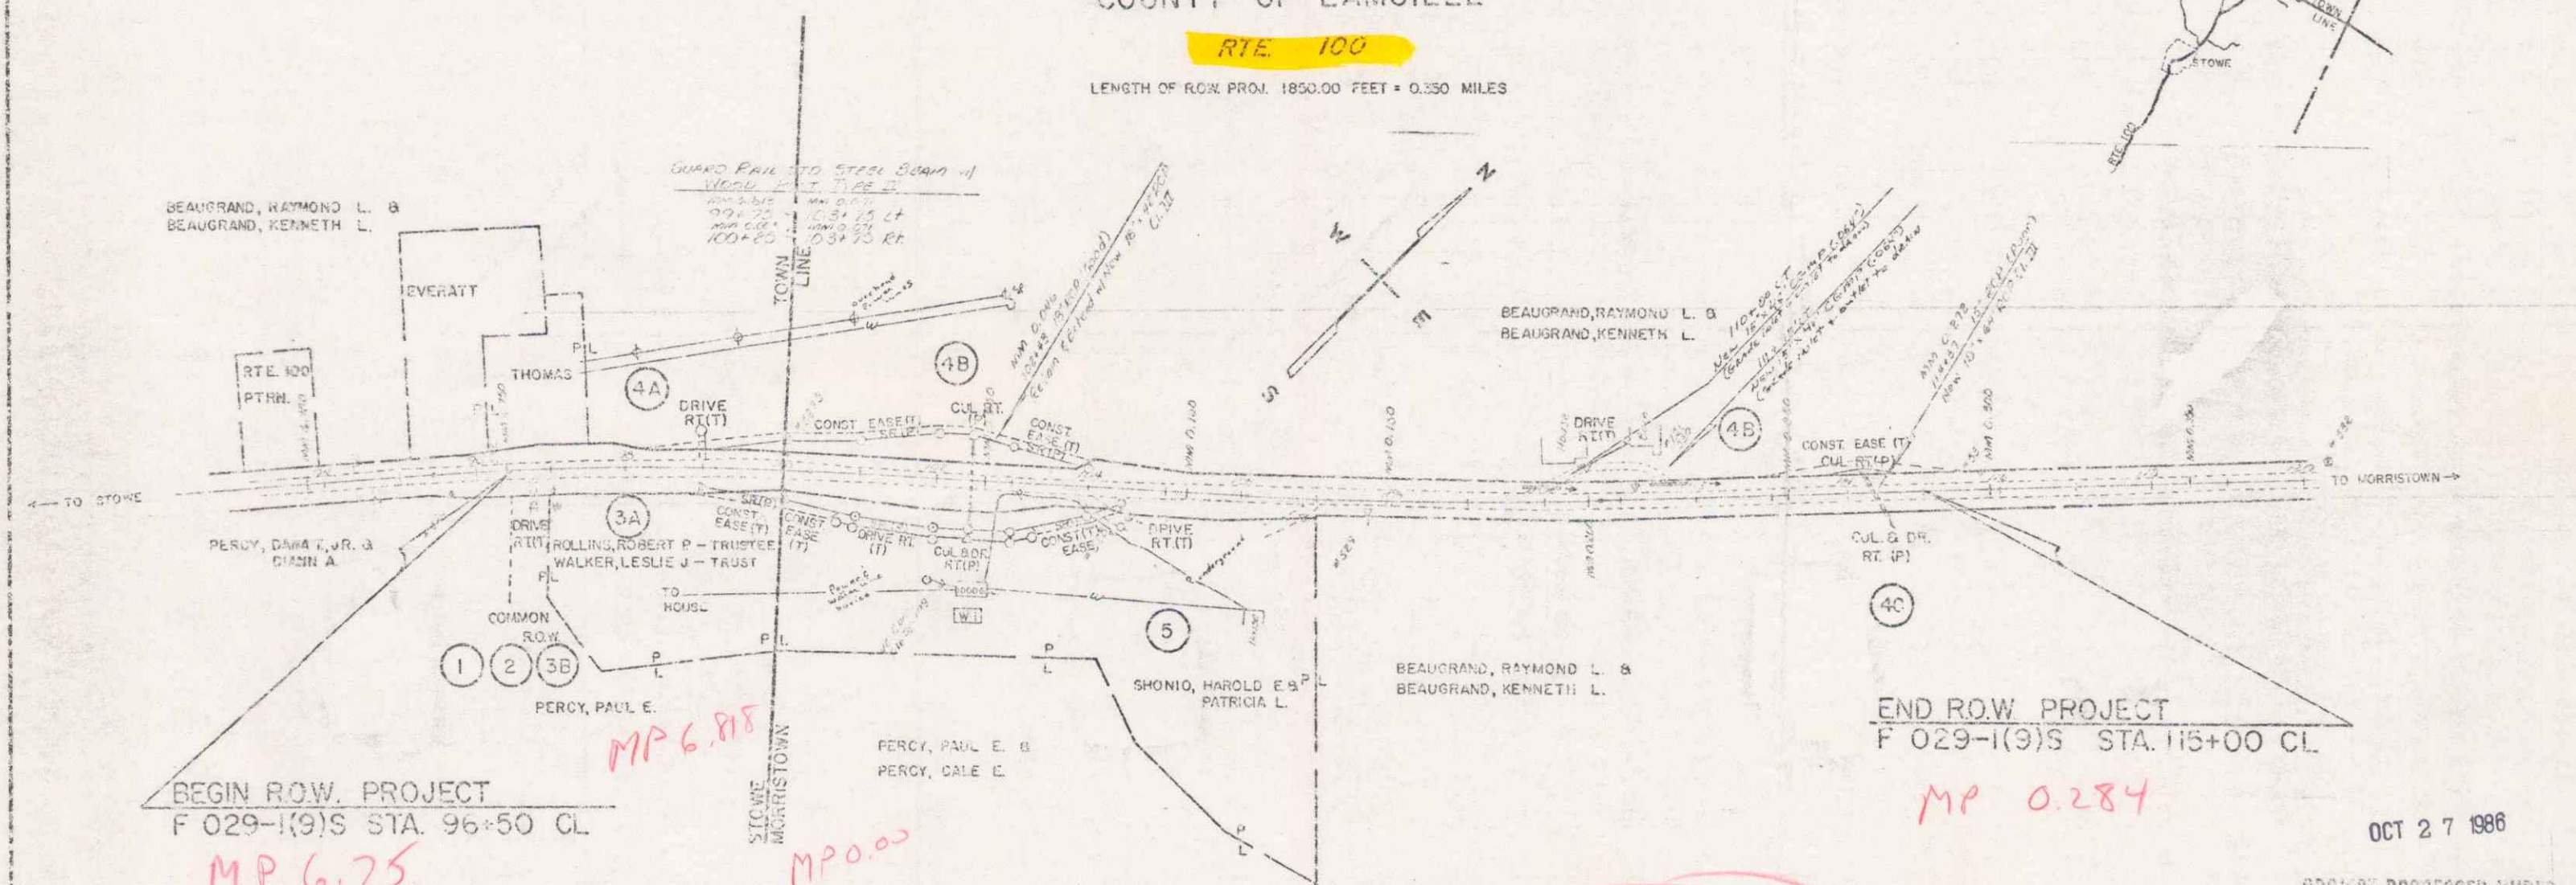

BEGIN ROW PROJECT
F 029-1(9)S STA. 96+50 CL

MP 6.75

MP 6.815

MP 0.00

END ROW PROJECT
F 029-1(9)S STA. 115+00 CL

MP 0.284

Stowe
Consolidating Drive
77+44 LT
94+23 RT
76+27 RT
96+77 RT
99+00 LT
101+75 - 103+35 RT
(old wide Service Dr.)

Morristown
Consolidating Drive
70+00 RT (to Sta. 100)
106+00 RT (to Sta. 110)
110+00 RT
111+75 RT

PROJECT: F 029-1(9)S
TOWN: STOWE
ROUTE: VT 100
PIN: 84B903
DATE: 04/10/1985

Pin # 84B903

SCALE IN FEET
0 100 200 300 400 500

OCT 27 1986

PROJECT PROCESSED UNDER
SECONDARY ROAD PLAN

ALL DRIVES AS INDICATED ON
PLANS ARE SUBJECT TO PER-
MITS PURSUANT TO TITLE 19,
SECTION 43, V.S.A.

SUBMITTED BY	ENGR. [Signature]	DATE	10/10/85
APPROVED	[Signature]	DATE	10/10/85
DIRECTOR OF ENGINEERING AND CONSTRUCTION			
APPROVED	[Signature]	DATE	10/10/85
CHIEF, PROPERTY ADMINISTRATION			
STOWE - MORRISTOWN			
Project No. F 029-1(9)S			
PAGE 1 OF 2			