


STATE OF VERMONT AGENCY OF TRANSPORTATION



PROPOSED IMPROVEMENT TOWN OF BRATTLEBORO COUNTY OF WINDHAM VT RTE 9 (F.A.P.)

BEGINNING AT A POINT ON VT 9 IN BRATTLEBORO
APPROXIMATELY 1.201 MILES EASTERLY OF THE MARLBORO-
BRATTLEBORO TOWN LINE AND EXTENDING EASTERLY FOR
0.454 MILES

LENGTH OF ROADWAY = 2399.20 FEET = 0.454 MILES.
LENGTH OF PROJECT = 2399.20 FEET = 0.454 MILES
LENGTH OF R.O.W. PROJECT 2830.20 FEET = 0.536 MILES
WORK TO BE DONE UNDER THIS PROJECT INCLUDES
RELOCATION OF A SECTION OF VT RTE 9 WITH
GRADING, DRAINAGE, SUBBASE AND PAVEMENT.

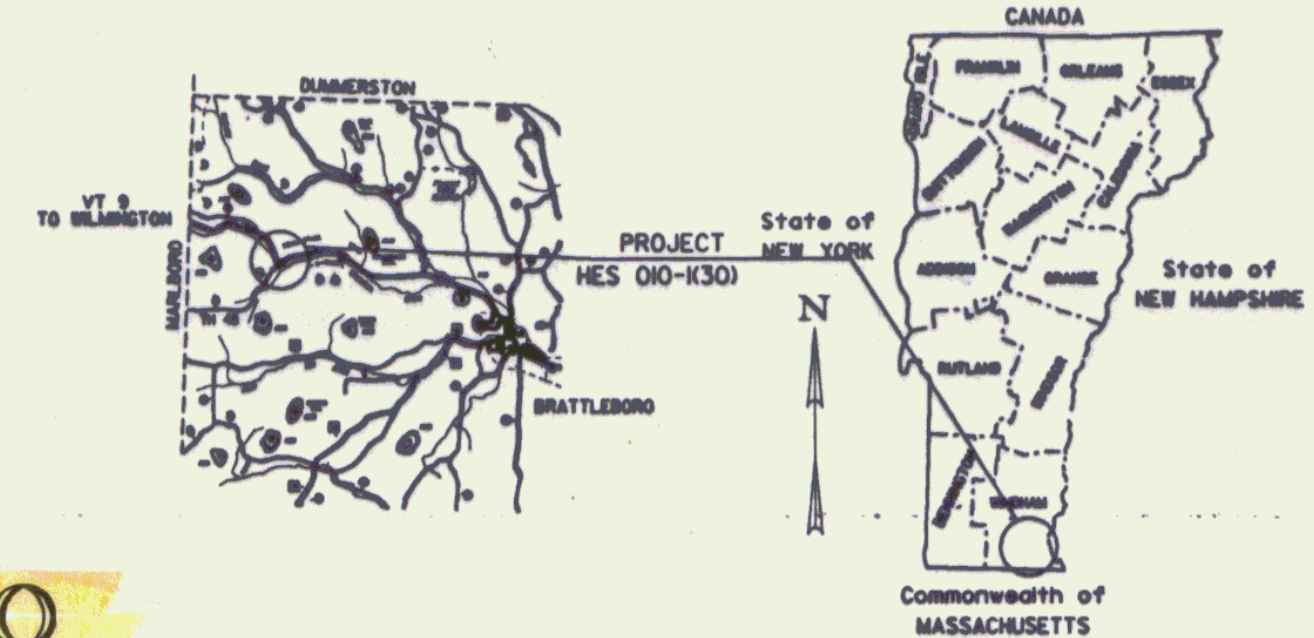


0 1 2
SCALE IN MILES

R.O.W. PLANS

END R.O.W. PROJECT
HES 010-1(30)
STA. 130+15 25' RT.

BEGIN R.O.W. PROJECT
HES 010-1(30) STA. 101+84 25' RT.

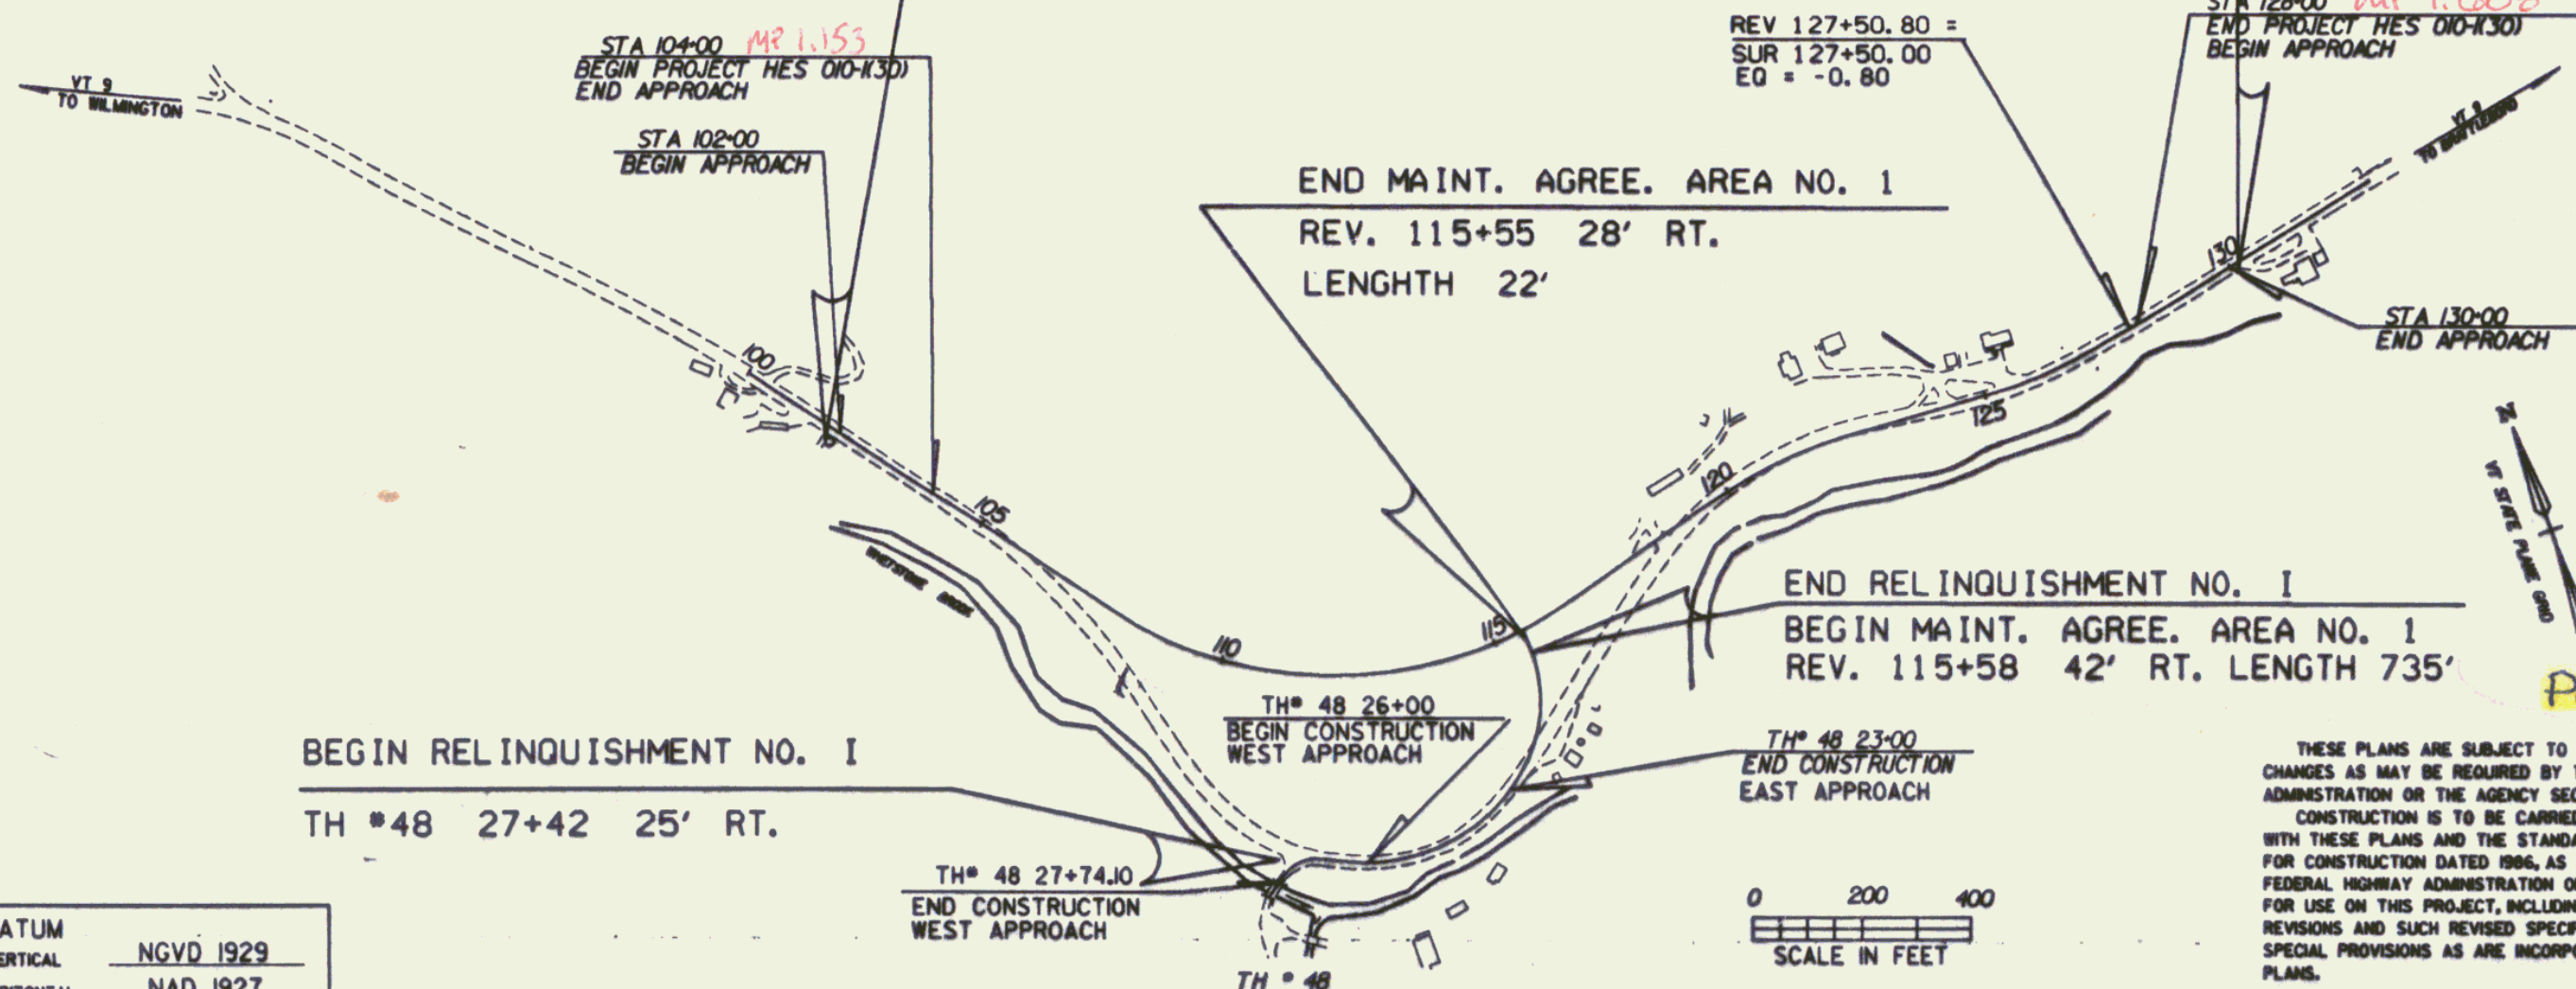

VT, Rte #9
RIGHT-OF-WAY DIVISION
TOWN FILE

PERPETUAL
Town of *BRATTLEBORO*
(To Be Returned To R.O.W. Division)

ALL DRIVES AS INDICATED ON PLANS
ARE SUBJECT TO PERMITS PURSUANT
TO TITLE 19 SECTION 11, V.S.A.

Pin # 84E070 MAR 20 1996

CONVENTIONAL SIGNS	
COUNTY LINE	---
TOWN LINE	---
LIMITS OF ACCESS	---o---
POINT OF ACCESS	X
FENCE LINE	---X---
STONE WALL	-----
TRAVELED WAY	-----
GUARD RAIL	---o---
RAILROAD	---+---
SURVEY LINE	---+---
CULVERT	---+---
POWER POLE	o
TELEPHONE POLE	o
TREES	o
CONTROL OF ACCESS	///
PROPERTY LINE	---
R.O.W. TAKING LINE	---
SLOPE RIGHTS	SR
TOP OF CUT	---o---
TOE OF SLOPE	---o---

DATUM
VERTICAL NGVD 1929
HORIZONTAL NAD 1927


THESE PLANS ARE SUBJECT TO SUCH ENGINEERING
CHANGES AS MAY BE REQUIRED BY THE FEDERAL HIGHWAY
ADMINISTRATION OR THE AGENCY SECRETARY.
CONSTRUCTION IS TO BE CARRIED ON IN ACCORDANCE
WITH THESE PLANS AND THE STANDARD SPECIFICATIONS
FOR CONSTRUCTION DATED 1986, AS APPROVED BY THE
FEDERAL HIGHWAY ADMINISTRATION ON NOVEMBER 21, 1985
FOR USE ON THIS PROJECT, INCLUDING ALL SUBSEQUENT
REVISIONS AND SUCH REVISED SPECIFICATIONS AND
SPECIAL PROVISIONS AS ARE INCORPORATED IN THESE
PLANS.

APPROVED GORDON B. MCCARTHUR DATE 9-22-92
Director of Engineering


APPROVED ALLEN N. BLAKE DATE 9-22-91
Chief of Right-of-Way

Project No. *BRATTLEBORO STP*
HES 010-1(30)
R.O.W. SHEET 1 OF 1 SHEETS

17-MAR-1992

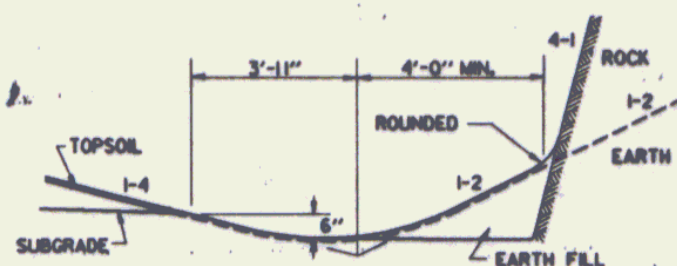


DETAILS OF DITCH AND BACKSLOPE FOR LOW SIDE OF BANK < 0.042 FT/FT WITH CLIMBING LANE

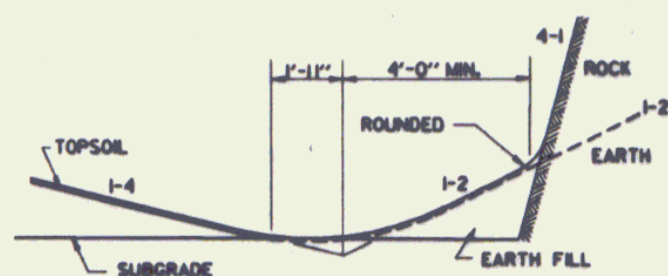


DETAILS OF DITCH AND BACKSLOPE FOR LOW SIDE OF BANK ≥ 0.042 FT/FT WITH CLIMBING LANE

FOR SLOPES IN SOLID ROCK EXCAVATION AND DRILLING AND BLASTING OF SOLID ROCK SUBGRADE, SEE STANDARD SHEET A-62.

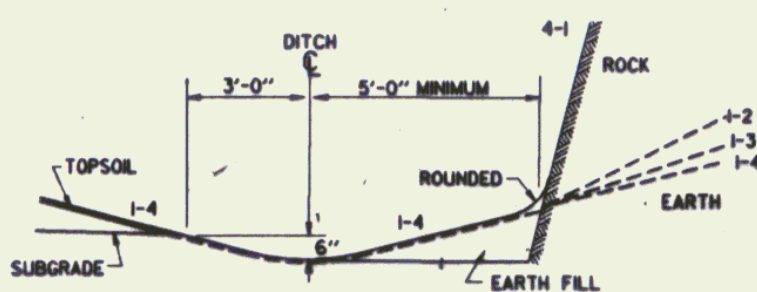

DETAILS OF DITCH AND BACKSLOPE FOR LOW SIDE OF BANK < 0.042 FT/FT WITHOUT CLIMBING LANE

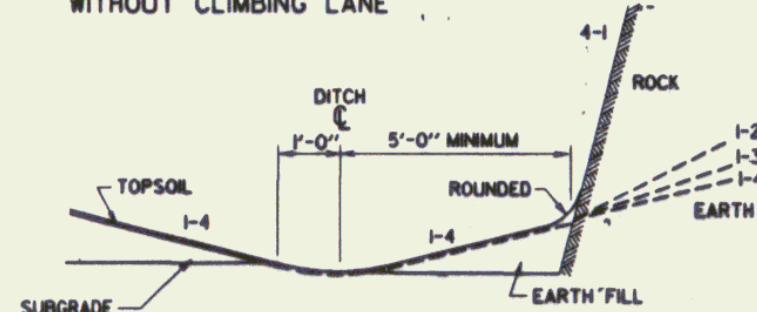

DETAILS OF DITCH AND BACKSLOPE FOR LOW SIDE OF BANK ≥ 0.042 FT/FT WITHOUT CLIMBING LANE

FOR SLOPES IN SOLID ROCK EXCAVATION AND DRILLING AND BLASTING OF SOLID ROCK SUBGRADE, SEE STANDARD SHEET A-60.


CLIMBING LANE TYPICAL SECTIONS

3" BITUMINOUS CONCRETE PAVEMENT (TYPE II)
6" BITUMINOUS CONC. PAV'T. (2-3" LIFT TYPE I BASE COURSE)
24" SUBBASE OF DENSE GRADED CRUSHED STONE
1/2" BITUMINOUS CONCRETE PAVEMENT (TYPE III)
12" SAND BORROW (ONLY 3" REQUIRED IN LEDGE CUTS)


SHOULDERS :

FOR SEEDING FORMULA & GENERAL NOTES, SEE SHEET 3


MATERIAL ITEM	THICKNESS TOLERANCE
PAVEMENT	± 1/4"
BASE COURSE	± 1/2"
SUBBASE	± 1"
SAND BORROW	± 1"

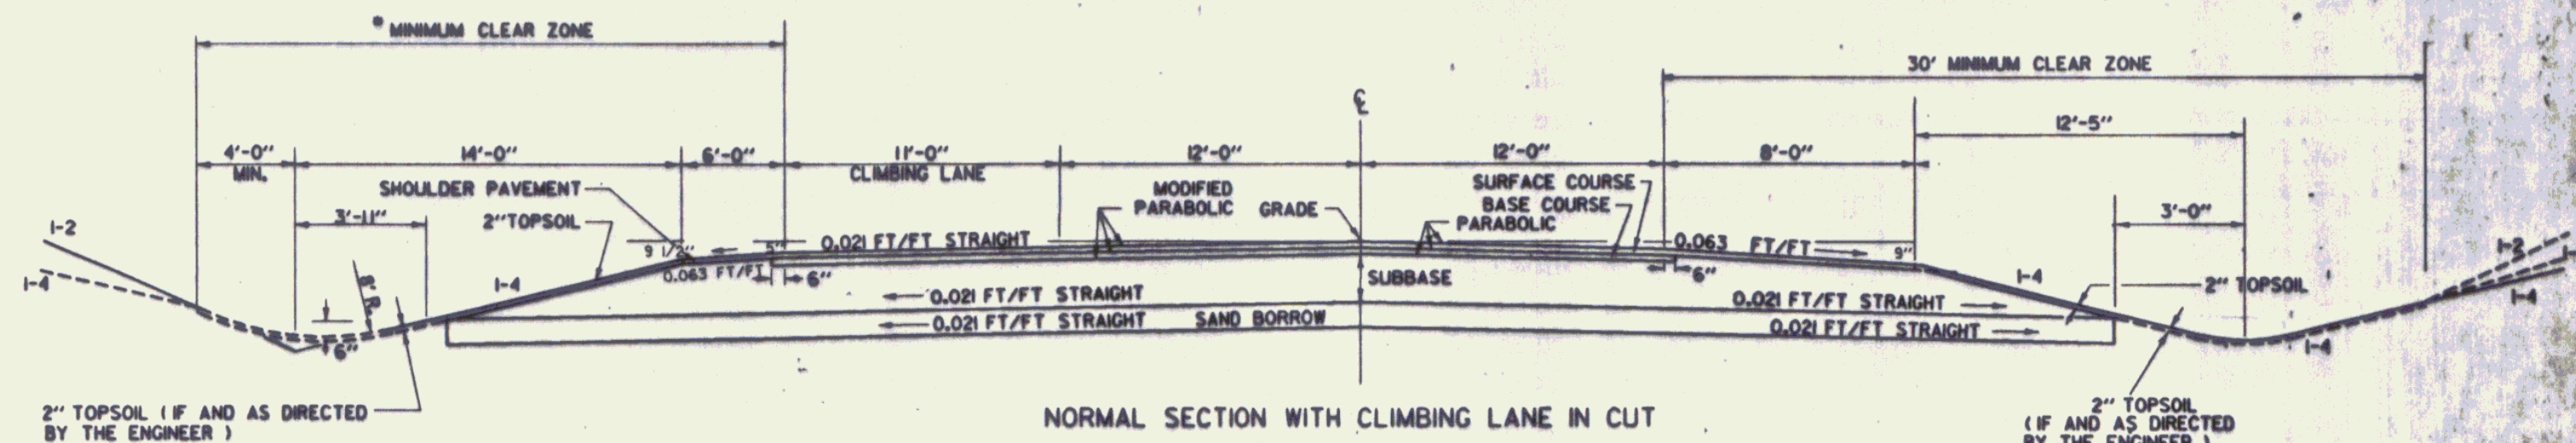


NORMAL SECTION WITH CLIMBING LANE IN CUT

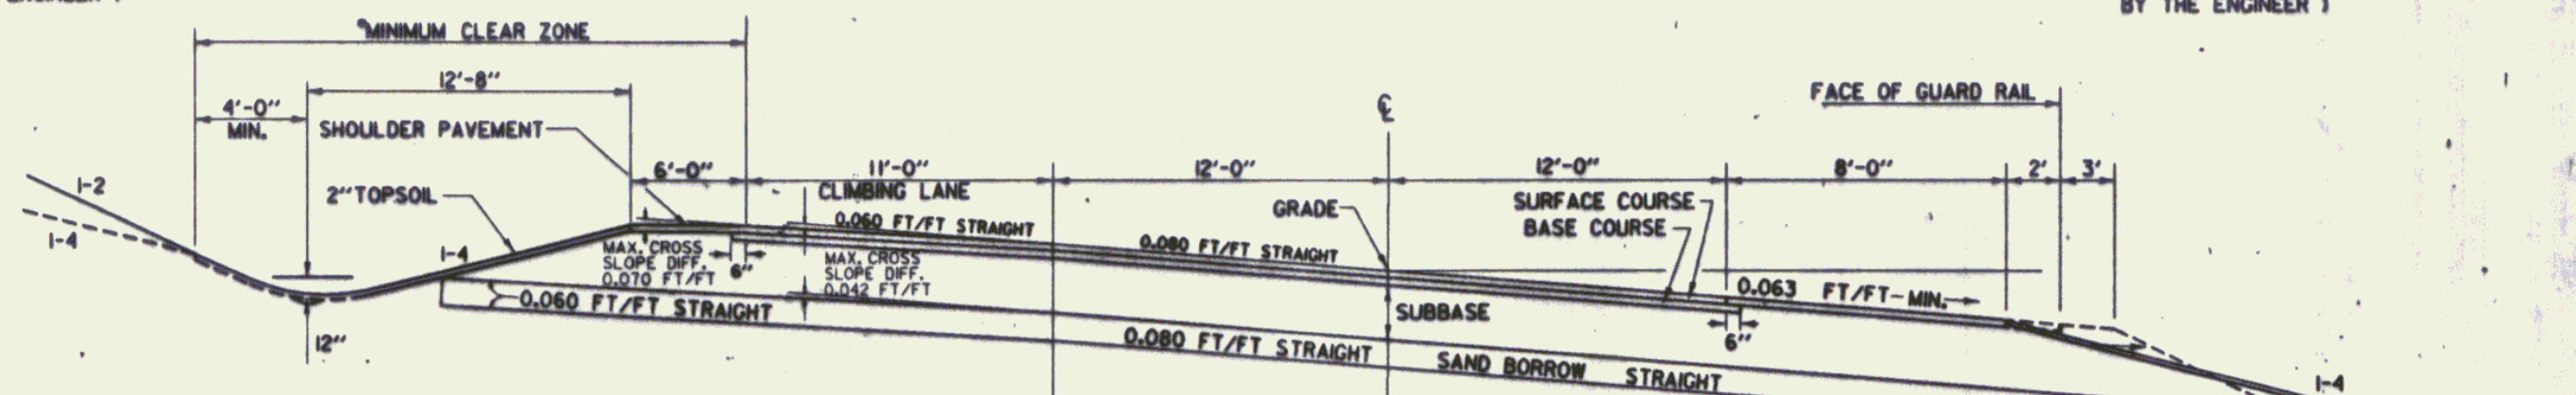


BANKED SECTION WITH CLIMBING LANE (HIGH SIDE) 0.080 FT/FT

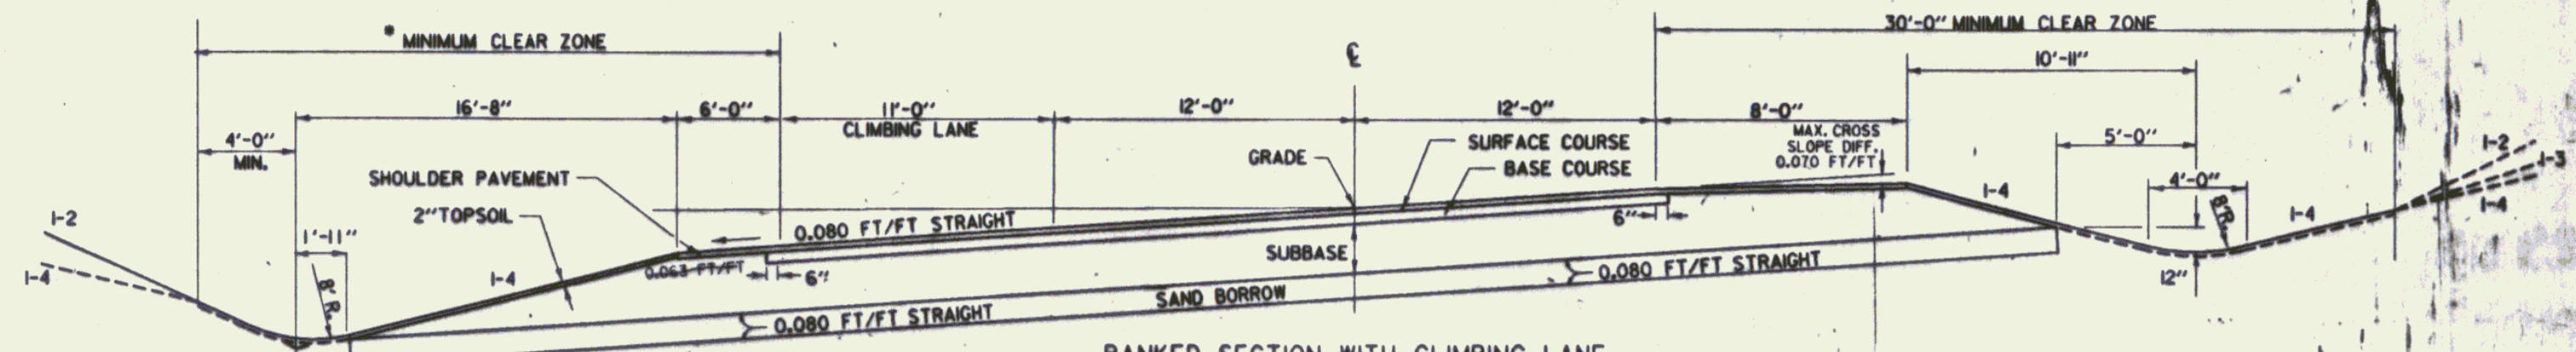


BANKED SECTION WITH CLIMBING LANE LOW SIDE 0.080 FT/FT.

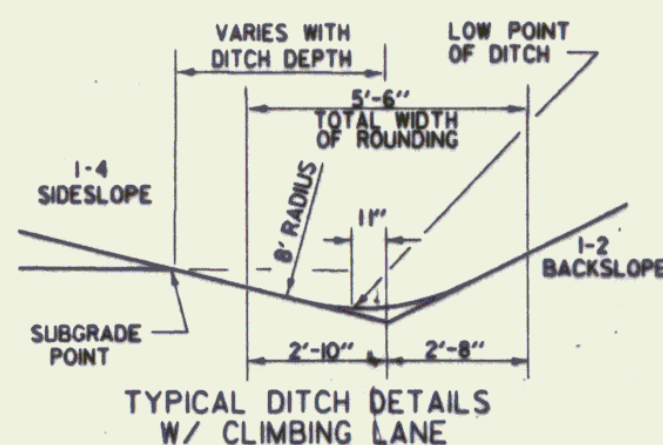


TYPICAL DITCH DETAILS W/ CLIMBING LANE

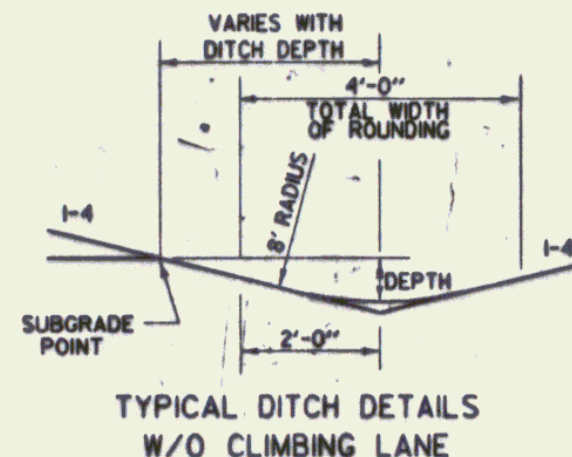

TYPICAL DITCH DETAILS W/O CLIMBING LANE

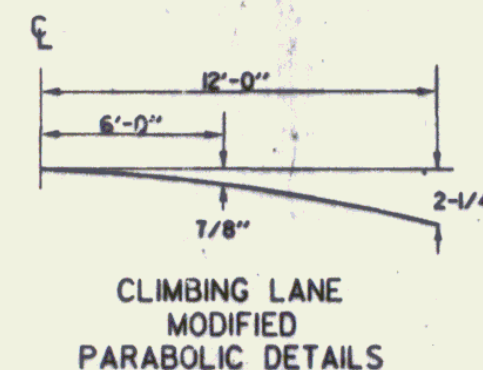

CLIMBING LANE MODIFIED PARABOLIC DETAILS

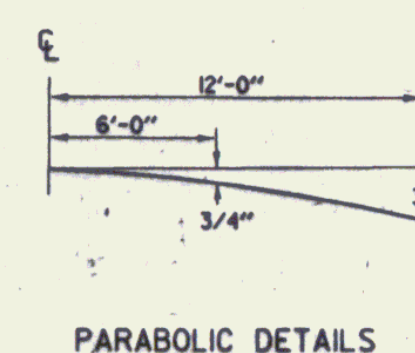

PARABOLIC DETAILS

DATUM
VERTICAL NGVD 1929
HORIZONTAL NAD 1927

MAR 20, 1998

SURVEYED BY	REDMOND	DATE	9/89
DRAWN BY	LJUNGVALL	DATE	9/89
DESIGN FILE NO.	ZG0150.6784E070.DGN		
PRF FILE	84E070TY1	DATE PLOTTED	13-SEP-1990
BRATTLEBORO HES 010-1(30)			
R.O.W. SHEET 2 OF 11 SHEETS			

TYPICAL SECTIONS TH 48 CONNECTOR

MATERIAL ITEM	THICKNESS TOLERANCE
PAVEMENT	* 1/4"
SUBBASE	* 1"
GRANULAR BORROW	* 1"
SAND BORROW	* 1"





2 - 1/2" BITUMINOUS CONCRETE PAVEMENT (2 LIFTS 1/4" TYPE III)

18" SUBBASE OF GRAVEL





SHOULDERS 1 - 1/2" BITUMINOUS CONCRETE PAVE

0" TO 12" GRANULAR BORROW (IN FILLS) } AS INDICATED ON THE PLANS OR
0" TO 12" SAND BORROW (IN CUTS) } AS DIRECTED BY THE ENGINEER

• THE MINIMUM CLEAR ZONE EXTENDS FROM THE EDGE OF THE TRAVEL WAY TO THE BACK OF DITCH.

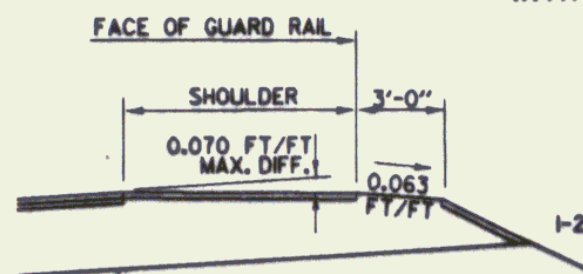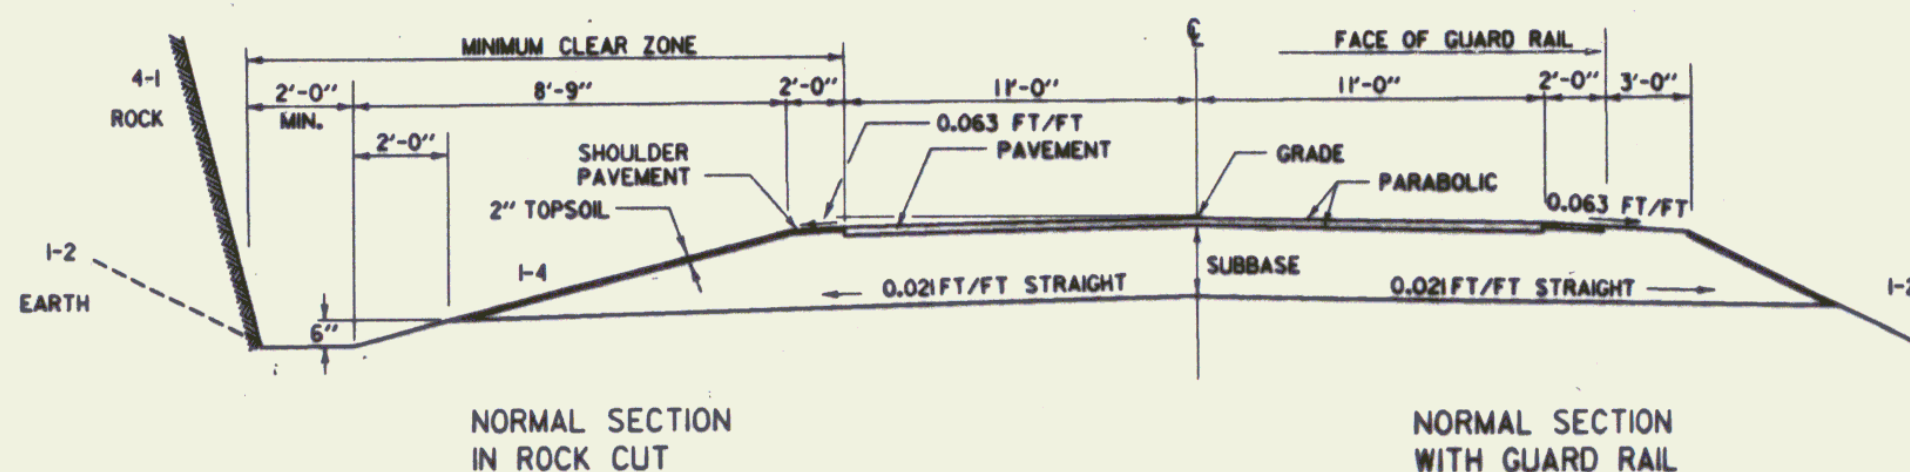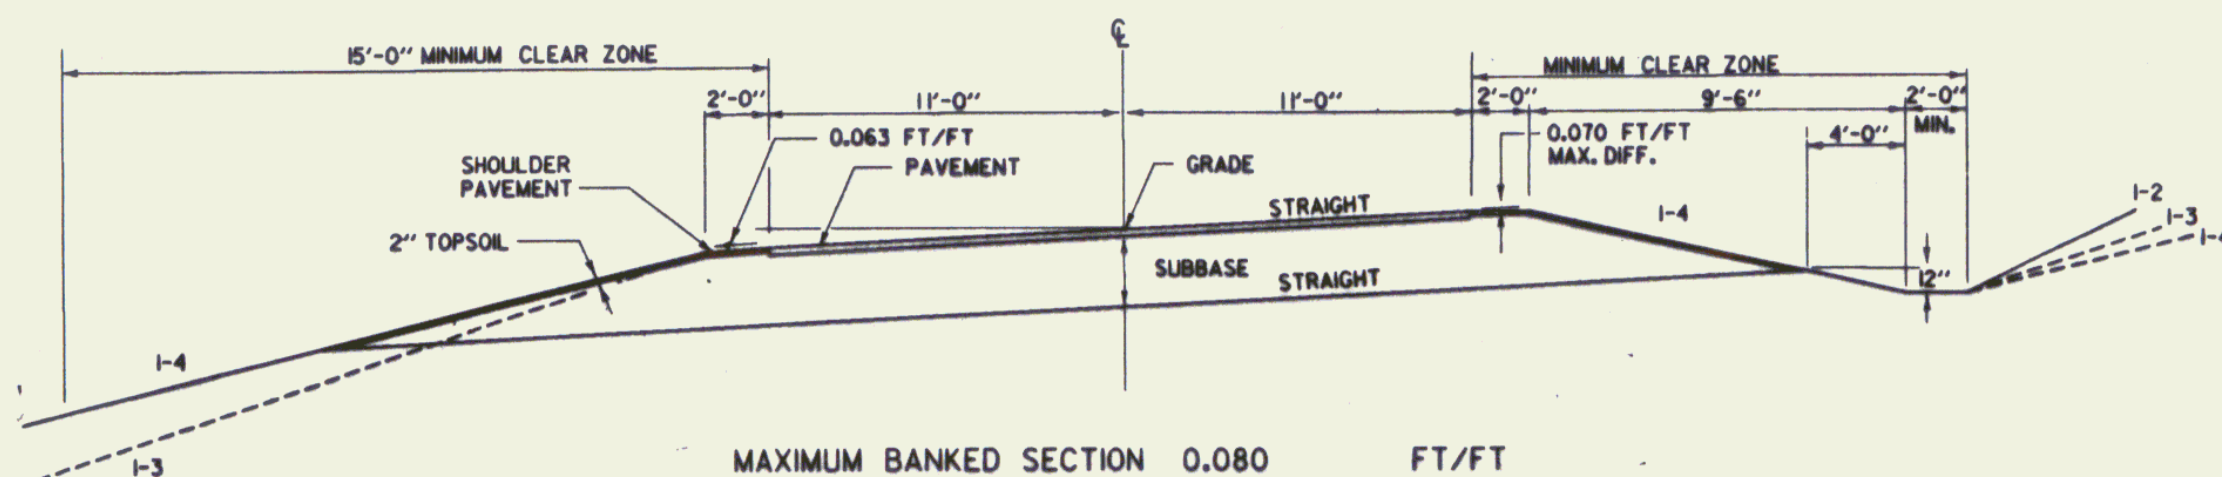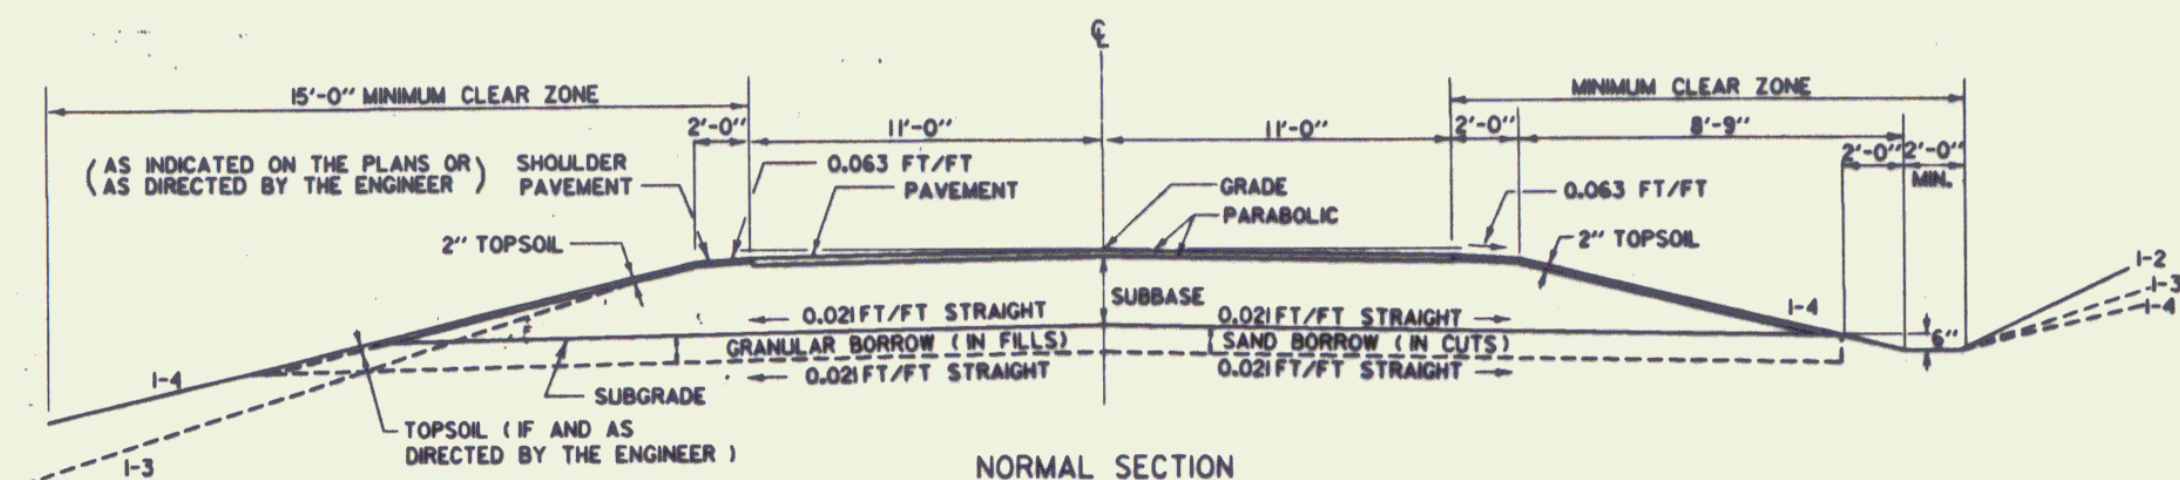

DETAIL OF GUARD RAIL ON HIGH SIDE OF BANKED SECTION

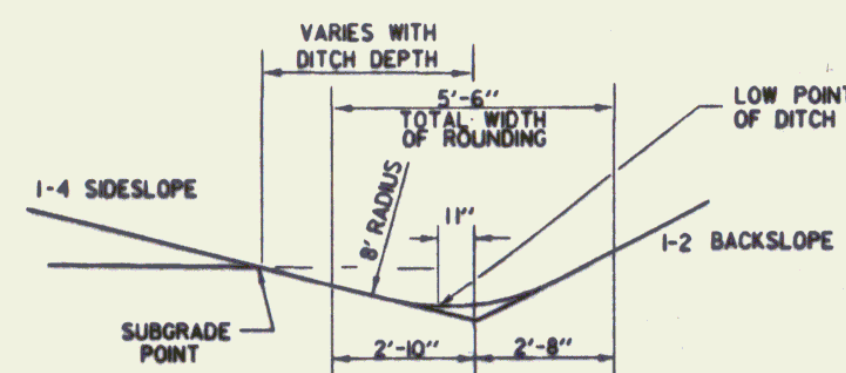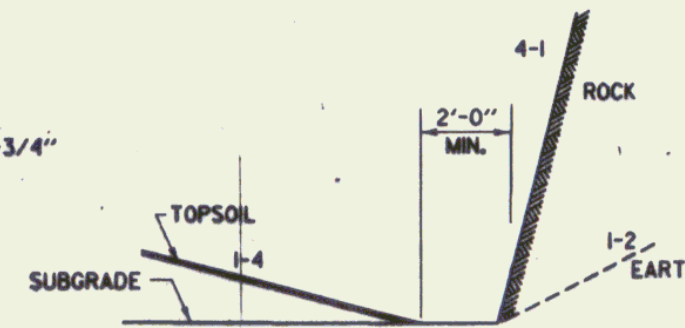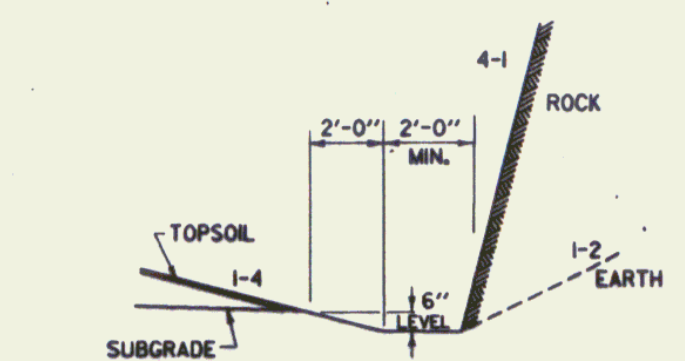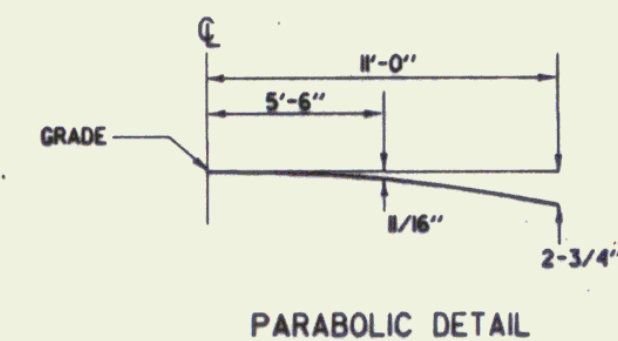

SEEDING FORMULA RURAL AREAS

% WT.	LBS./A.	NAME	PUR %	GERM %
3.33	2	CROWN VETCH	97	75
50.00	30	CREeping RED FESCUE	98	85
8.33	5	TIMOTHY	99	85
16.67	10	PERENNIAL RYE GRASS (VAR. PENNFINE)	95	85
8.34	5	ALFALFA (VAR. SARANAC)	99	85
8.33	5	BIRDSFOOT TREFOIL (VAR. EMPIRE)	98	85
5.00	3	HIGHLAND BENT GRASS	92	85
100.00	60			

THE SEED MIXTURE SHALL NOT HAVE A WEED CONTENT EXCEEDING 0.40% BY WEIGHT AND SHALL BE FREE OF ALL NOXIOUS WEED SEED.
SEED- TO BE APPLIED PER SEEDING FORMULAS DIRECTED BY THE ENGINEER.
FERTILIZER- FORMULA 10-20-10 TO BE USED WITH SEED, APPLIED AT THE RATE OF 500 LBS./ACRE.
AGRICULTURAL LIMESTONE- TO BE APPLIED AT THE RATE OF 2 TONS/ACRE OR AS DIRECTED BY THE ENGINEER.
HAY MULCH- TO BE PLACED ON EARTH SLOPES AT THE RATE OF 2 TONS/ACRE, OR AS DIRECTED BY THE ENGINEER.
TOPSOIL- TO BE USED WITH SEED AS INDICATED ON THE PLANS, OR AS DIRECTED BY THE ENGINEER.
MARKER POSTS- TO BE PLACED AS DIRECTED BY THE ENGINEER.
SLOPE ROUNDING- ALL CUT SLOPES TO BE ROUNDED IN ACCORDANCE WITH STANDARD SHEET B-5
PAY LIMITS OF SAND BORROW WHEN USED IN CONJUNCTION WITH UNDERDRAIN- SEE STANDARD SHEET D-2.


FOR SLOPES IN SOLID ROCK EXCAVATION AND DRILLING AND BLASTING OF SOLID ROCK SUBGRADE, SEE STANDARD SHEET A-61.

DATUM
VERTICAL NGVD 1929
HORIZONTAL NAD 1927

MAR 20 1996

SURVEYED BY	REDMOND	DATE	9/88
DRAWN BY	LJUNGVAL		
SQUAD LEADER			
DESIGN FILE NO.	260150.67384E070.DGN		
PRF FILE	84E070TYT	DATE PLOTTED	15-JUN-1990

BRATTLEBORO
HES 010-1(30)
R.O.W. SHEET 3 OF 11 SHEETS

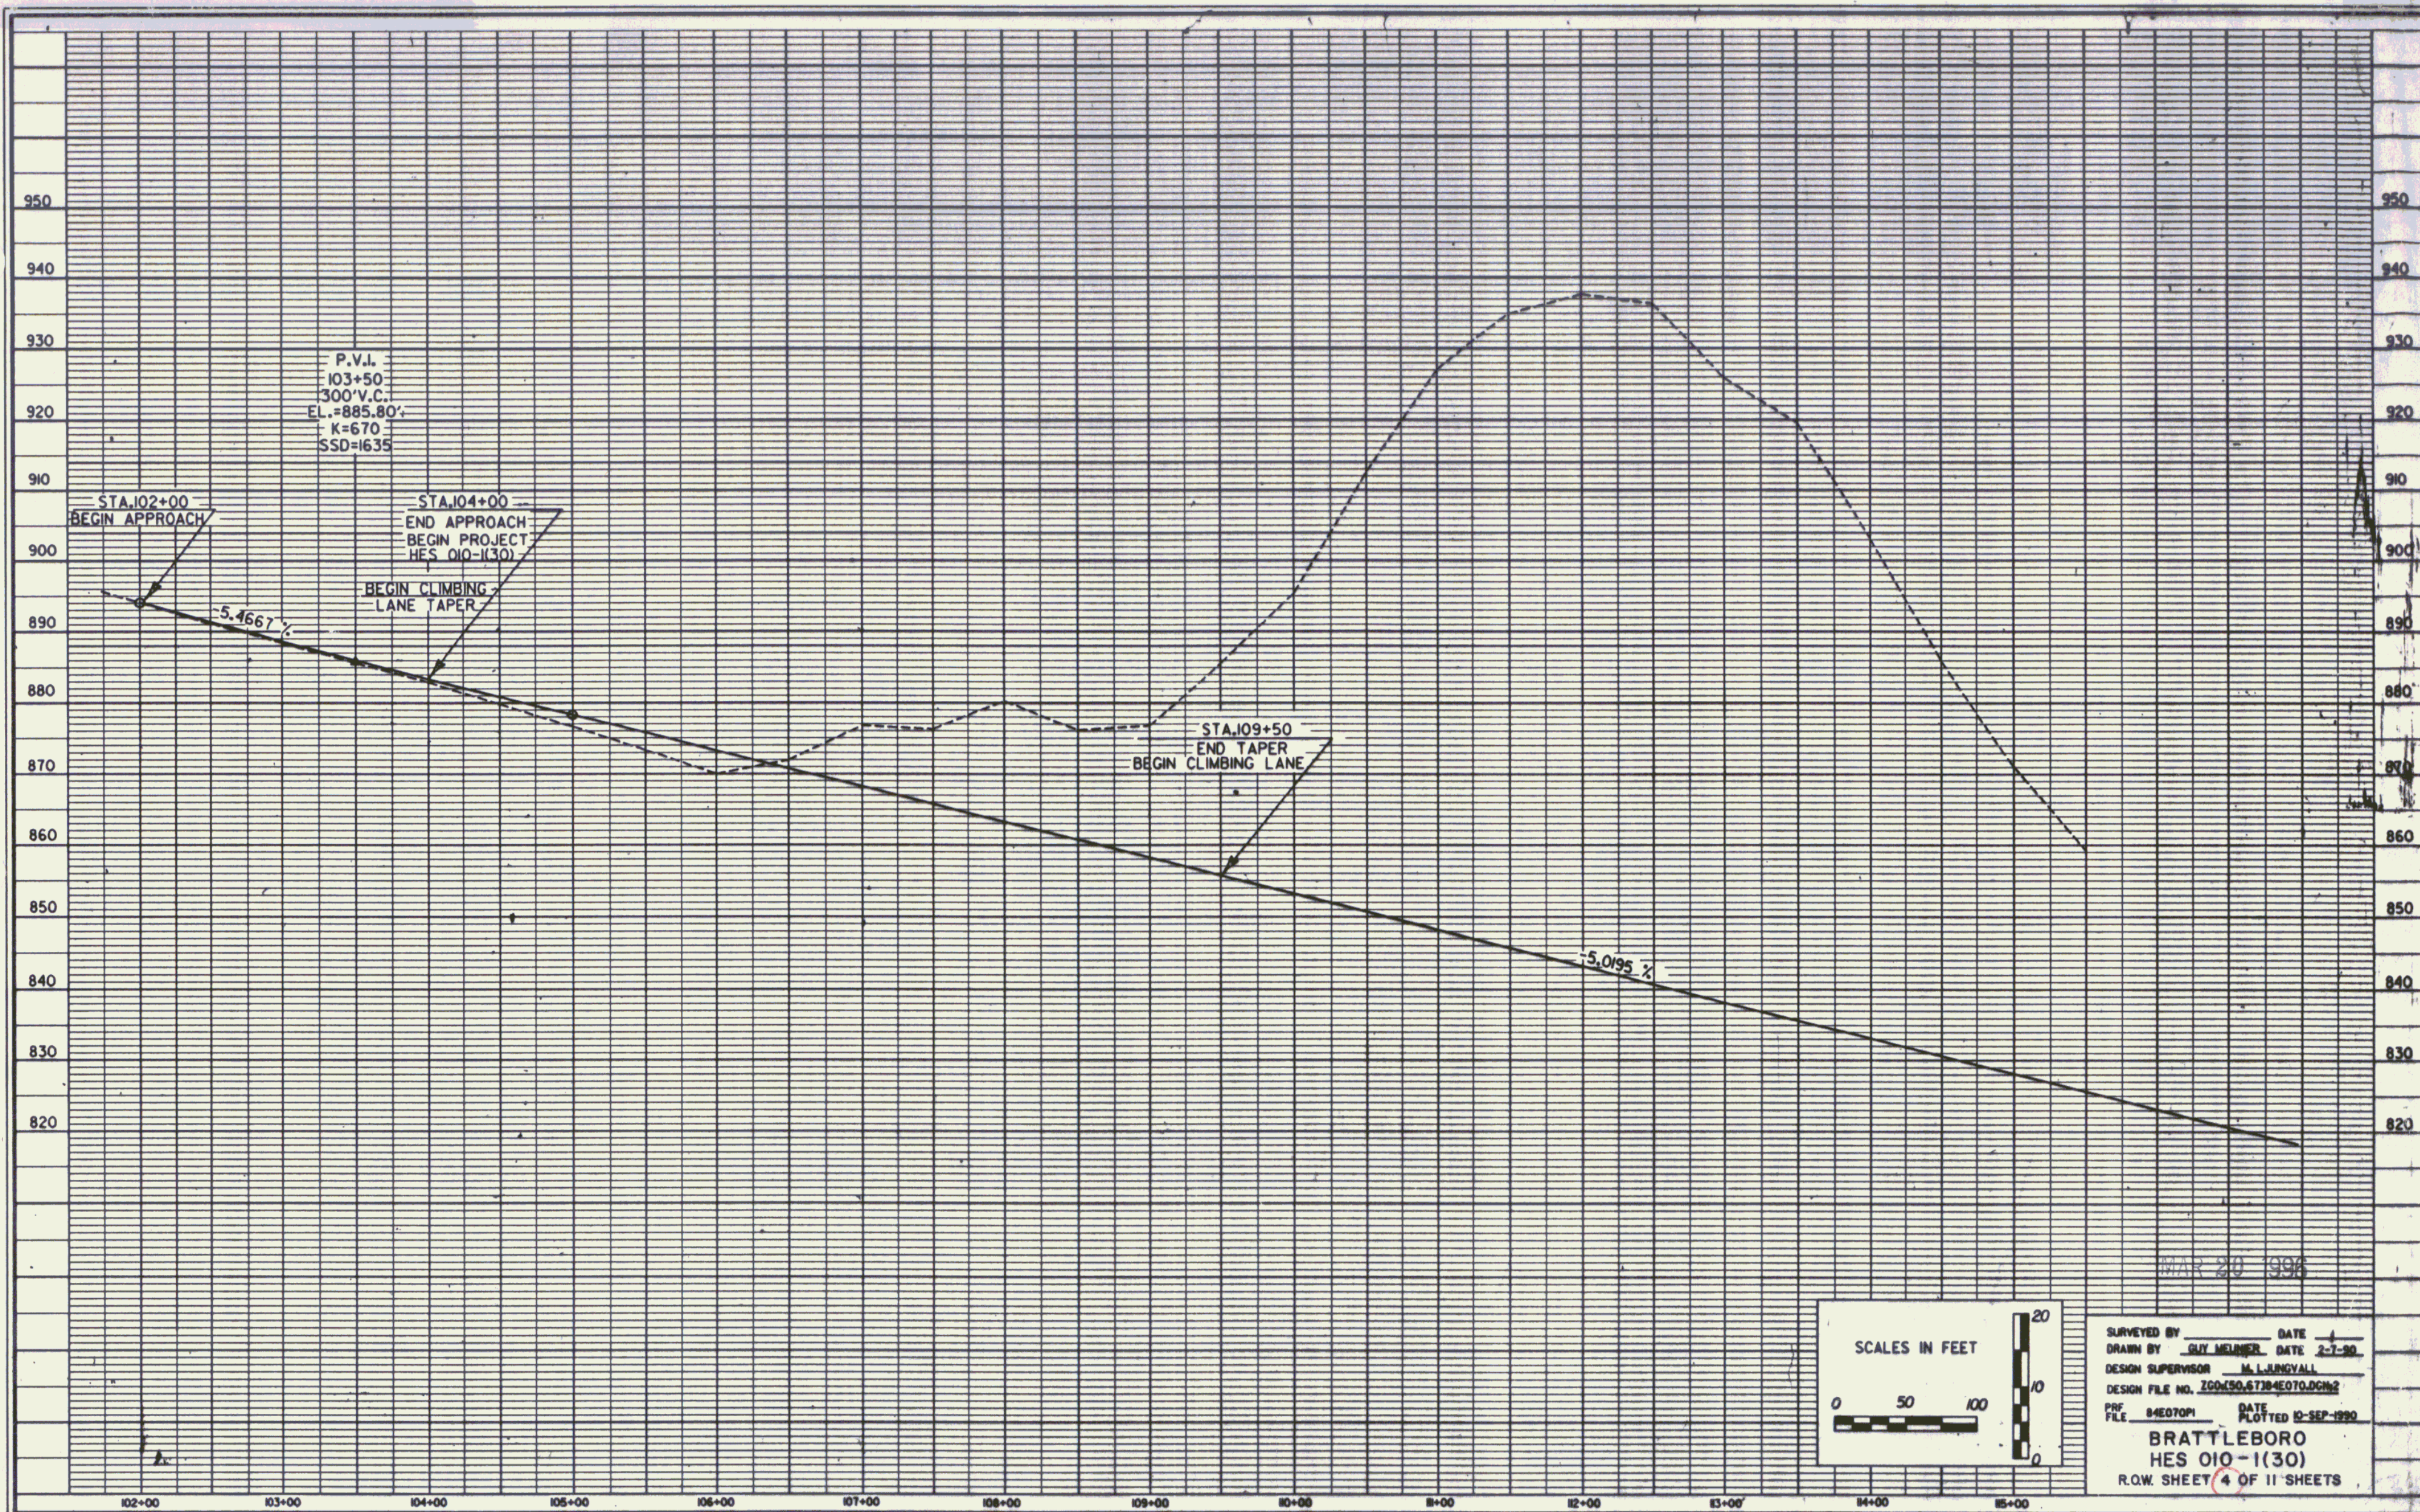

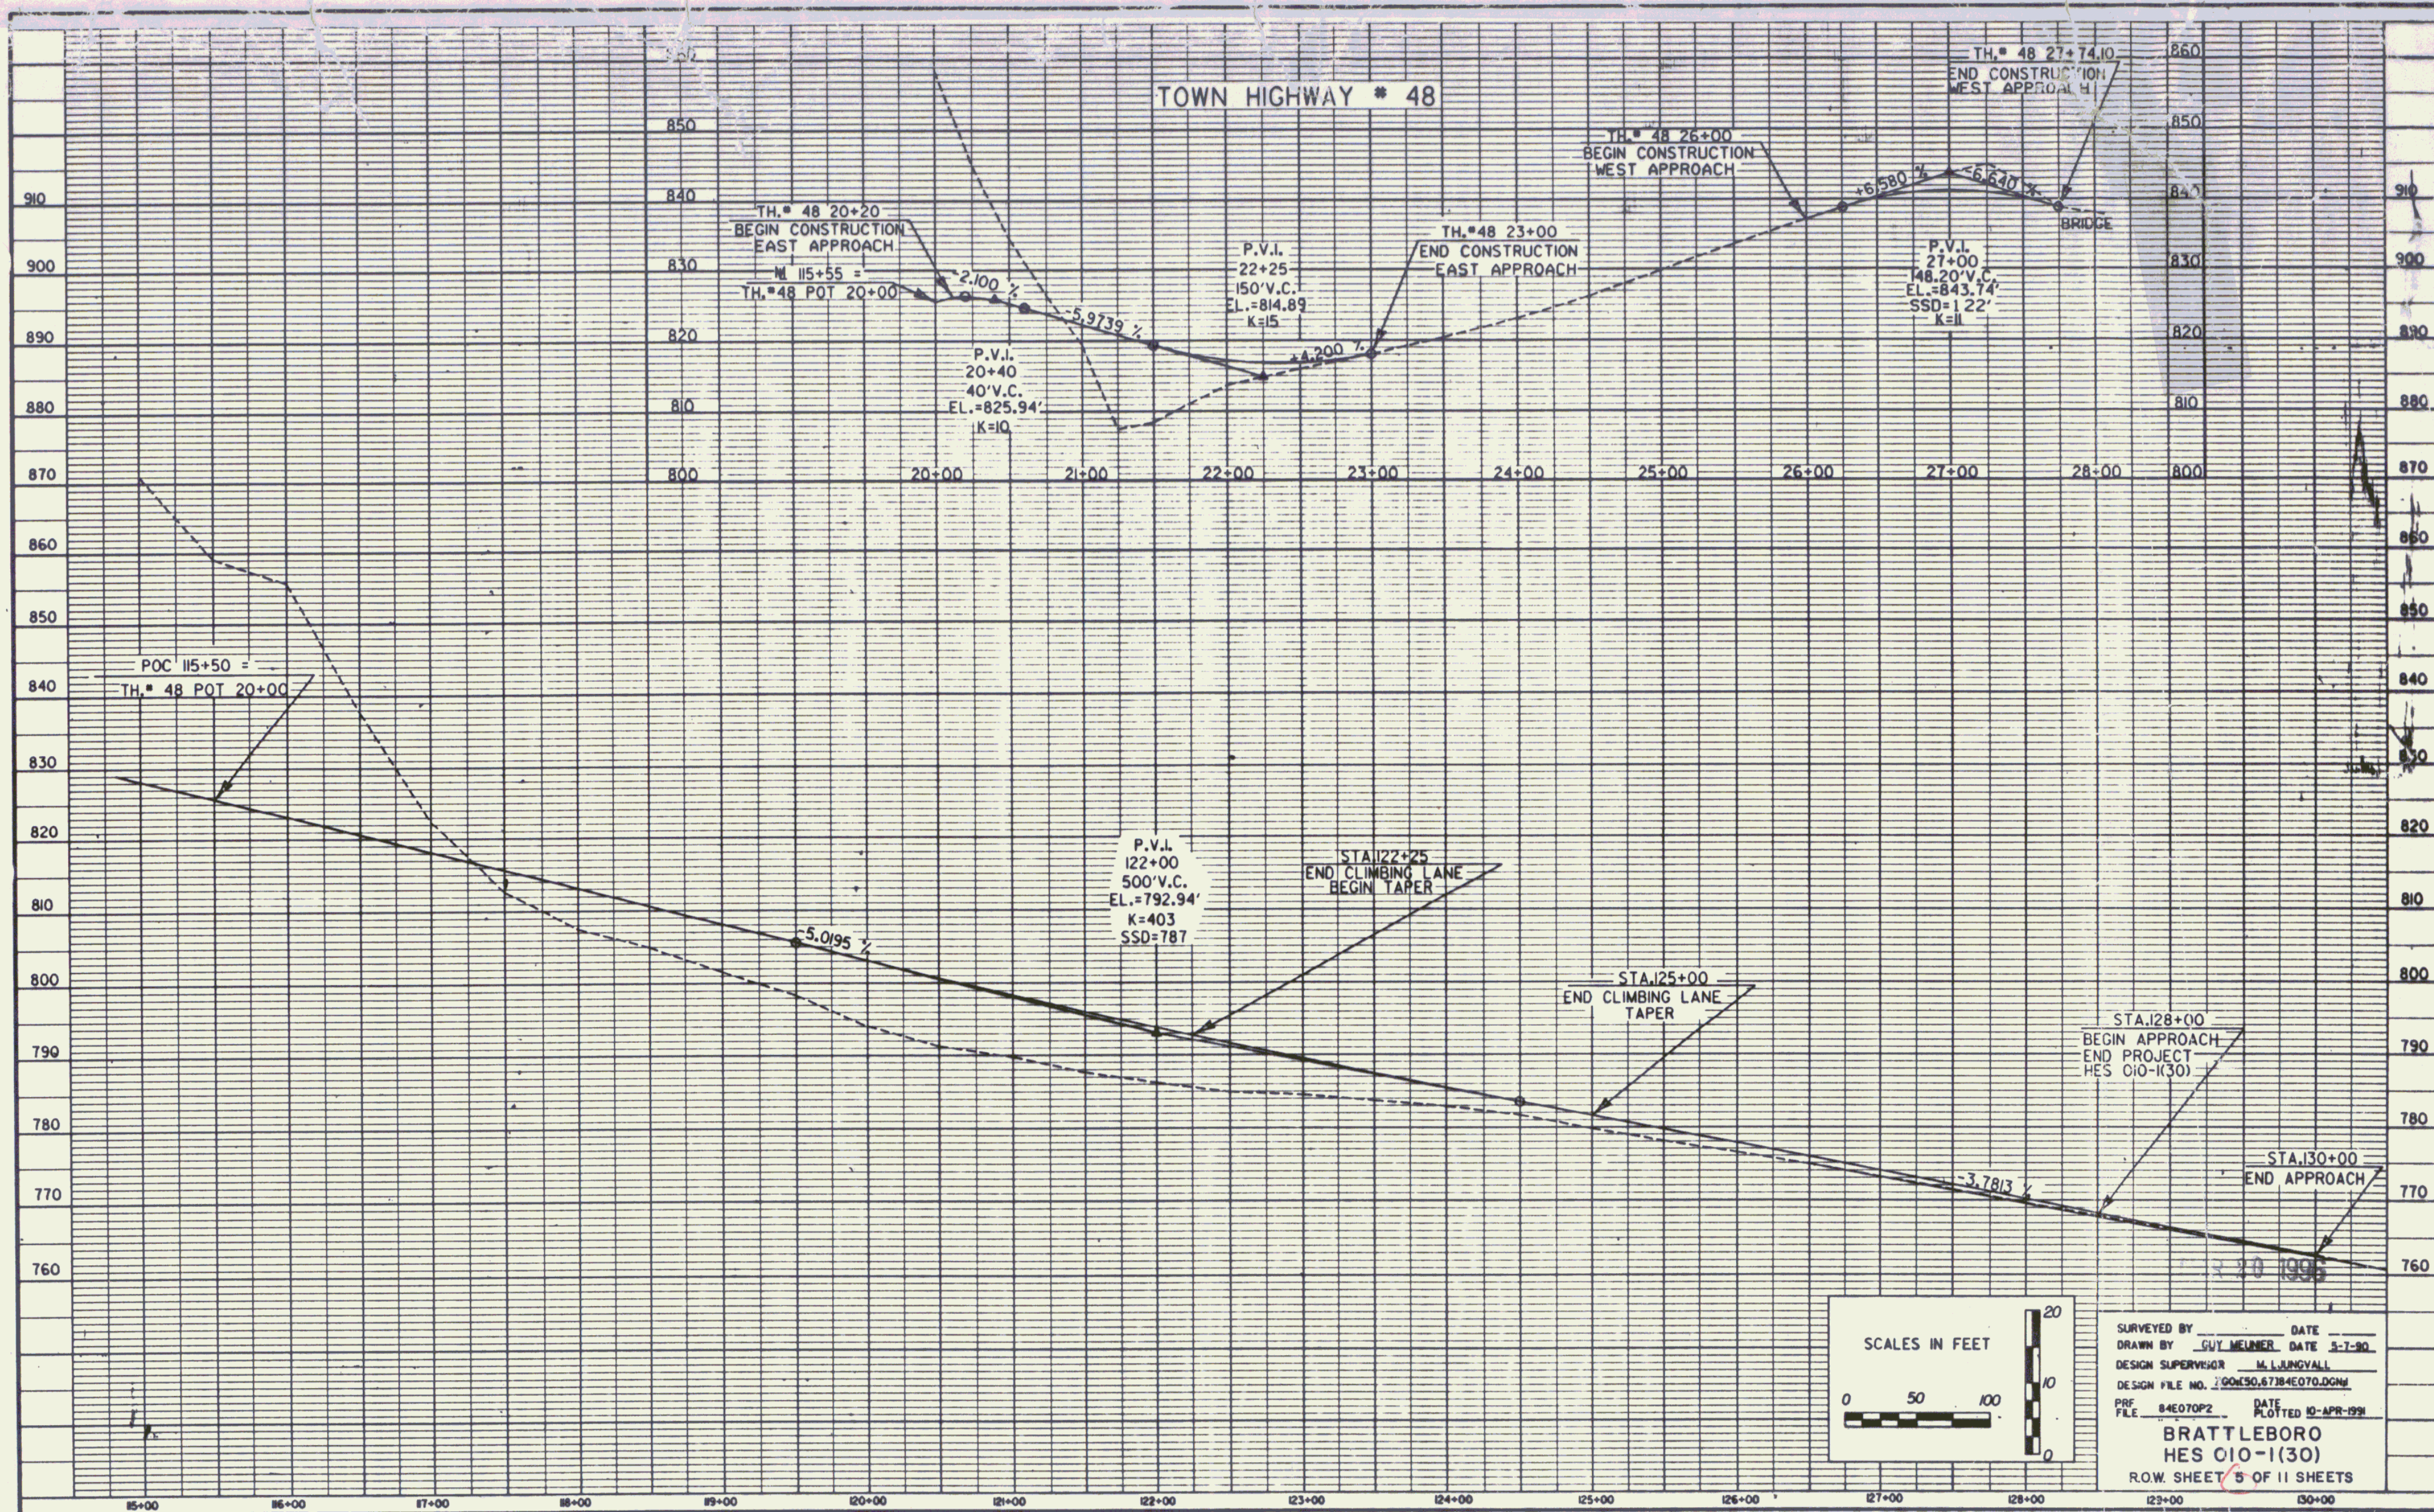


TABLE OF PROJECT PROPERTY ACQUISITION

STATE OF VERMONT AGENCY OF TRANSPORTATION RIGHT OF WAY PLANS DETAIL SHEET

PARCEL NO.	GRANTOR	SHEET NO.	BEGINNING STATION	ENDING STATION	TAKING	REM.	RIGHTS	TITLE TAKEN	DATE	TOWN OR CITY RECORDED	BK.	PG.	REMARKS	REVISION NO.	SHEET	DESCRIPTION OF REVISION	DATE	MADE BY	APPROVED BY
1	STARK, DONALD A.	10	101+84 RT. 101+84 RT.	102+02 RT. 102+00 RT.			CONST. (T) 0.01A± SLOPE (T) 0.01A±	AGREE.		BRATTLEBORO			80 S.F.± 150 S.F.±	1	7,10 11	PARCEL NO. 5 DODGE. ADD DODGE, ET TA M - LESSEE TO TITLE. PER C.O. 8125.	10-07-91	M. J. R.	L. W. B.
2	STRONG, ANN S.	10	102+00 CL. 102+00 RT. 102+00 RT. 103+50 RT. 105+50 RT. 108+10 RT. 108+25 RT. TH 48 27+40 RT. TH 48 27+42 RT.	108+88 RT. 103+50 RT. 107+10 RT. 107+00 RT. 108+90 RT. 108+75 RT. TH 48 27+65 RT. TH 48 27+80 RT.	0.41A±		ALL R. T. & I. SLOPE (T) 0.13A± CONST. (T) 0.11A± SLOPE (P) 0.10A± CUL., DIT. & DR. (P) CONST. (T) 0.02A± DITCH & DRAINAGE (P) 0.02A± SLOPE (T) 0.01A± CONST. (T) 0.01A±	WD	02-17-93	BRATTLEBORO	233	501	VT. RTE. 9 1000 S.F.± 900 S.F.± 260 S.F.± 400 S.F.±	2	6,10	PARCEL NO. 2 STRONG. ADD ANN S. STRONG TO TITLE. PER C.O. 8124.	10-07-91	M. J. R.	L. W. B.
2A		10	103+40 RT.±				CUL., DIT. & DR. (P)	WDOE	07-21-95	BRATTLEBORO	249	478		3	6,10	PARCEL NO. 3 HAMILTON. CHANGE P/L ALIGNMENT. INCREASE TAKE, REMAINDER AND CHANGE ENDING STATION. PER C.O. 8168.	01-03-91	M. J. R.	F. J. M.
3A	HAMILTON, ELWIN R. & CINDY C.	10	102+00 LT. 109+00 RT. 105+50 LT. 109+60 RT. 113+22 LT.	113+69 RT. 113+69 RT. 113+22 LT. 113+38 RT. 113+10 LT.	4.71A±	2.58A±	SLOPE (P) 0.62A± CONST. (T) 0.12A± ALL R. T. & I.	WD		BRATTLEBORO			STONE WALL	4	7,10 11	PARCEL NO. 5 DODGE. CHANGE TAKE TO 2.94A± REMAINDER 0.33A±. CHANGE BEG. STA. OF REMAINDER TO 113+69 RT. ADD ALL R.T. & I. FOR STORAGE SHED AT 119+55 LT. ON PARCEL 5B CHANGE STA. 24+80 CL TO 23+86 CL, 0.40A±. ADD WALL, WALK & SHED TOPO. PER C.O. 8167.	01-03-92	M. J. R.	F. J. M.
3B		10	102+00 CL.	109+00 RT.	0.41A±		ALL R. T. & I.						VT. RTE. 9	5	7,11	PARCEL NO. 7 OLSON. CHANGE STA. TO REV. 124+28 LT. FOR ALL R.T. & I. IN ROW. PER C.O. 8164.	01-03-92	M. J. R.	F. J. M.
4A	BOYD, MARK A. & BOYD, EMILY A.	11	119+25 RT. 116+15 RT. 116+20 RT. 117+35 RT. 118+25 RT. 118+55 RT. REV. 121+60 RT. REV. 122+50 RT.	REV. 124+31 RT. 117+75 RT. 116+60 RT. 117+65 RT. REV. 124+31 RT. REV. 122+50 RT. REV. 124+12 RT.	0.23A±		CONST. (T) 0.07A± DITCH & DRAINAGE (P) 0.02A± DITCH & DRAINAGE (P) 0.01A± CONST. (T) 0.13A± SLOPE (P) 0.11A± CUL., DIT. & DR. (P) SLOPE (T) 0.06A±	WD		BRATTLEBORO			2934 S.F.± 765 S.F.± 225 S.F.± 2494 S.F.±	6	8,11	PARCEL NO. 8 OLSON. CHANGE STA. TO REVISED 124+28 LT. FOR ALL R.T. & I. IN ROW. CHANGE TAKE LINE NOT TO INCLUDE TOTAL COMMON ROW. REDUCE TAKE TO 0.12A±. PER C.O. 8163.	01-03-92	M. J. R.	F. J. M.
4B		11	115+95 RT.	REV. 124+31 RT.	0.51A±		ALL R. T. & I.						VT RTE. 9	7	8,11	PARCEL NO. 9 FILION & STALKER. CHANGE STA. TO REV. 124+28 LT. FOR ALL R.T. & I. IN ROW. PER C.O. 8162.	01-03-92	M. J. R.	F. J. M.
	PARCEL 4 CONTINUED ON FOLLOWING SHEET													8	8,11	PARCEL NO. 10 BORST. CHANGE STA. TO REV. 124+28 LT. FOR ALL R.T. & I. IN ROW. PER C.O. 8165.	01-03-92	M. J. R.	F. J. M.
														9	8,11	PARCEL NO. 11 DEROSIA. CHANGE STA. TO REV. 124+28 LT. FOR ALL R.T. & I. IN ROW. PER C.O. 8166.	01-03-92	M. J. R.	F. J. M.
														10	7,11	PARCEL NO. 5 DODGE. CHANGE TAKE FROM 2.99 A± TO 2.94A±; CHANGE REMAINDER FROM 0.57A± TO 0.33A±; CHANGE BEGINNING STA. OF REMAINDER FROM 113+38 RT. TO 113+69 RT.; ADD ALL R. T. & I. AT STA. 119+55 LT. FOR STORAGE SHEDS.; ON PARCEL 5B, CHANGE STA. 24+80 CL. TO 23+86 CL. AND AREA FROM 0.45 A± TO 0.40A±; ADD NEW TOPO TO LAYOUT. PER C.O. 8167.	01-03-92	M. J. R.	F. J. M.
														11	7	PARCEL NO. 5 DODGE. REMOVE *PERSONAL PROPERTY* ON MOBILE HOME. PER C.O. 8177.	01-03-92	M. J. R.	F. J. M.

03-3220 1805 84E070

DR. (P)- DRAINAGE RIGHT
DIT. (P)- DITCHING RIGHT
CH. (P)- CHANNEL RT.
DRIVE (T)- DRIVE RIGHT
CUL. (P)- CULVERT RIGHT
[W]- WATER SOURCES

PRESENT R.O.W.
TAKING WITHOUT ACCESS
TAKING WITHOUT ACCESS ALONG PROPERTY LINE
TAKING WITH ACCESS
PERMANENT EASEMENT
TEMPORARY EASEMENT

LEGEND
CZ (P)
CONST. (T)
SR
P
L
A
A
A

CLEAR ZONE
CONSTRUCTION EASEMENT
SLOPE RIGHTS
PROPERTY LINE
TOP OF CUT
TOE OF SLOPE

REVISED 04-13-95

R. O. W. PLANS

BRATTLEBORO
HES 010-1(30)
SHEET 6 OF 11

ACCT. prop
/prop/84e070/re070d.dgn
DATE PLOTTED 13-APR-1995
84e070dl.i

APPROVED: LAWRENCE BLISS L.S. DATE: 8-26-91
AGENT D, PLANS & TITLES

6

TABLE OF PROJECT PROPERTY ACQUISITION

STATE OF VERMONT AGENCY OF TRANSPORTATION RIGHT OF WAY PLANS DETAIL SHEET

PARCEL NO.	GRANTOR	SHEET NO.	BEGINNING STATION	ENDING STATION	TAKING	REM.	RIGHTS	TITLE TAKEN	DATE	TOWN OR CITY RECORDED	BK.	PG.	REMARKS	REVISION NO.	SHEET	DESCRIPTION OF REVISION	DATE	MADE BY	APPROVED BY
4C	PARCEL 4 CONTINUED FROM PREVIOUS SHEET BOYD, MARK A. & BOYD, EMILY A.	10	TH 48 27+14 LT. TH 48 26+55 LT. TH 48 26+30 LT.	TH 48 27+20 LT. TH 48 27+60 LT. TH 48 27+80 LT.			INSTALL & MAINTAIN (P) SLOPE (T) 0.01A± CONST. (T) 0.02A±						GUARDRAIL 150 S.F. ± 900 S.F. ±	12	9,10	RELINQUISHMENT NO. 1. CHANGE BEG. STA. TO TH 48 27+42 RT. AND REDUCE LENGTH TO 735'. PER C.O. 8194.	01-30-92	M. J. R.	F. J. M.
5A	BELLOWS FALLS TRUST COMPANY	10,11	113+22 LT. 113+22 LT. 117+90 LT. 119+00 LT. 118+50 LT. 119+55 LT. ±	119+65 RT. 113+10 LT.	2.94A±	NONE	ALL R. T. & I. ALL R. T. & I. ALL R. T. & I.	WD	07-07-93	BRATTLEBORO	236	572	STONE WALL ARTESIAN WELL SEPTIC TANK & APPURTENANCE DRIVE 12' GRAVEL M.P. 0147 STORAGE SHEDS	13	9,11	PARCEL NO. 17 OLSON. ADD NEW PARCEL NO. 17 OLSON, EDWARD W. & JOYCE M. PER C.O. 8198.	02-18-92	M. J. R.	F. J. M.
5B		10,11	TH 48 23+86 CL.	119+65 LT.	0.40A±		ALL R. T. & I.						VT RTE. 9	14	7,10	PARCEL NO. 18 DODGE. ADD NEW PARCEL (*18) FOR ETTA M. DODGE, ALL R.T. & I. IN HOUSE TRAILER, 118+85 LT. ~ 119+50 LT. PER C.O. 8205.	03-06-92	M. J. R.	L. W. B.
5C		10,11	113+69 RT.	114+50 RT.	0.33A±									15	7,10	PARCEL NO. 5 DODGE. CHANGE TITLE TO BELLOWS FALLS TRUST COMPANY. REMOVE ALL R. T. & I. IN HOUSE TRAILER. PER C.O. 8206.	03-06-92	M. J. R.	L. W. B.
5D		10,11	113+22 LT.	119+65 LT.	6.73A±									16	6,10	PARCEL NO. 2 STRONG. REMOVE RAYMOND B. STRONG, JR. FROM DETAIL SHEET AND LAYOUT. PER C.O. 8287.	11-09-92	C. C. P.	L. W. B.
6	AKELEY, MARIAN D. BOYD, EMILY E. STARK, ELIZABETH A. DODGE, ETTA M.	10,11	TH 48 23+38 CL. TH 48 22+25 LT. TH 48 22+25 RT.	116+15 RT.	0.15A±		ALL R. T. & I. DRIVE (T) ALL R. T. & I.	WD	10-08-92	BRATTLEBORO	230	668	VT RTE. 9 12' GRAVEL SPRING & APPURTENANCE	17	7,11	PARCEL NO. 5 BELLOWS FALLS TRUST CO. REMOVE ALL R. T. & I. IN RIGHTS COLUMN OF DETAIL SHEET AND ON LAYOUT FOR STORAGE SHEDS AT STA. 119+55 LT. ± PER C.O. 8289.	11-30-92	C. C. P.	L. W. B.
7A	OLSON, STEVEN M. & DIANE M.	11	119+65 LT. REV. 120+00 LT. REV. 120+25 LT. REV. 121+25 LT.	REV. 121+45 LT. REV. 121+45 LT. REV. 121+45 LT.	0.14A±		CONST. (T) 0.03A± DITCH (P) 0.01A± CULVERT (P)	WD		BRATTLEBORO			1237 S.F. ± 423 S.F. ±	18	8,11	PARCEL NO. 8 OLSON. REMOVE CAROL A. OLSON FROM TITLE. ADD PERSONAL PROPERTY, SIGN, AT STA. 124+78 LT. PER C.O. 8312. MYLARS TO DESIGN 03-15-93	01-26-93	M. J. R.	L. W. B.
7B		11	119+65 CL.	REV. 121+45 LT.	0.10A±		ALL R. T. & I.						VT RTE. 9	19	7,10	PARCEL NO. 5 BELLOWS FALLS TRUST COMPANY. ADD PARCELS 5C AND 5D TO DETAIL AND LAYOUT SHEETS. ALSO DELETE REMAINDER LISTED IN PARCEL 5A. PER C.O. 8348.	04-02-93	C. C. P.	L. W. B.
7C		11	REV. 124+28 LT. REV. 124+65 LT.	REV. 125+70 LT.			ALL R. T. & I. DRIVE (T)						20' R.O.W. TO RTE. 9 30' GRAVEL M.P. 0159	20	7,10	PARCEL NO. 5A BELLOWS FALLS TRUST COMPANY. REMOVE SLOPE (P), 0.16A±, STA. 13+10 LT. ~ 117+20 LT. FROM LAYOUT & DETAIL SHEET. PER C.O. 8353.	04-07-93	C. C. P.	L. W. B.
														21	6,10	PARCEL NO. 2 STRONG. ADD NEW SUB-PARCEL 2A WITH 'CUL., DIT. & DR (P)' AT STA. 103+40 RT. ± PER C.O. 8679.	04-13-95	C. C. P.	L. W. B.

MAR 20 1996

ACCT. prop
/prop/84e070/re070d.dgn
DATE PLOTTED 13-APR-1995
84e070d2.i

DR. (P)- DRAINAGE RIGHT
DIT. (P)- DITCHING RIGHT
CH. (P)- CHANNEL RT.
DRIVE (T)- DRIVE RIGHT
CUL. (P)- CULVERT RIGHT
[W]- WATER SOURCES

PRESENT R.O.W.
TAKING WITHOUT ACCESS
TAKING WITHOUT ACCESS ALONG PROPERTY LINE
TAKING WITH ACCESS
PERMANENT EASEMENT
TEMPORARY EASEMENT

LEGEND CZ (P)
CONST. (T)
SR SR
P L
△ △ △
○ ○ ○

APPROVED: LAWRENCE BLISS, L.S. DATE: 8-26-91
AGENT D. PLANS & TITLES

R. O. W. PLANS
BRATTLEBORO
HES 010-1(30)
SHEET 7 OF 11

STATE OF VERMONT
AGENCY OF TRANSPORTATION
TABLE OF PROJECT PROPERTY ACQUISITION

STATE OF VERMONT
AGENCY OF TRANSPORTATION
RIGHT OF WAY PLANS
DETAIL SHEET

PARCEL NO.	GRANTOR	SHEET NO.	BEGINNING STATION	ENDING STATION	TAKING	REM.	RIGHTS	TITLE TAKEN	DATE	TOWN OR CITY RECORDED	BK.	PG.	REMARKS	REVISION NO.	SHEET	DESCRIPTION OF REVISION	DATE	MADE BY	APPROVED BY
8A	OLSON, MICHAEL J.	11	REV. 121+45 LT. REV. 121+45 LT. REV. 121+45 LT. REV. 124+24 LT. REV. 126+50 LT. REV. 126+50 LT. REV. 124+00 LT. REV. 124+65 LT. REV. 124+78 LT. REV. 125+20 LT.	REV. 125+70 LT. REV. 122+25 LT. REV. 124+00 LT. REV. 126+62 LT. REV. 126+62 LT. REV. 125+70 LT.	0.12A±		SLOPE (T) 0.01A± CONST. (T) 0.04A± CULVERT (P) ALL R. T. & I. SLOPE (T) 0.01A± DRIVE (T) SLOPE (T) 0.01A±	WD		BRATTLEBORO			516 S.F.± 1885 S.F.± STONE WALL 102 S.F.± SIGN - PERSONAL 30' GRAVEL M.P. 0159 SIGN - PERSONAL 330 S.F.±	22	10,11	REVISE RELINQUISHMENT NO. 1. REVISE MAINTENANCE AGREEMENT AREA NO. 1 ACCORDING TO THE MARKED UP PLANS. PER C.O. 8805.	08-20-96	M. J. R.	L. W. B.
8B		11	REV. 121+45 LT.	REV. 126+62 LT.	0.30A±		ALL R. T. & I.						VT RTE. 9						
8C		11	REV. 124+28 LT.	REV. 125+70 LT.			ALL R. T. & I.						20' R.O.W. TO RTE. 9						
9	FILION, PETER J. & STALKER, CYNTHIA D.	11	REV. 124+28 LT. REV. 124+65 LT.	REV. 125+70 LT.			ALL R. T. & I. DRIVE (T)	QCD		BRATTLEBORO			20' R.O.W. TO RTE. 9 30' GRAVEL M.P. 0159						
10	BORST, HARRY W. JR. & CAROLYN E.	11	REV. 124+28 LT. REV. 124+65 LT.	REV. 125+70 LT.			ALL R. T. & I. DRIVE (T)	QCD		BRATTLEBORO			20' R.O.W. TO RTE. 9 30' GRAVEL M.P. 0159						
11	DEROSIA, STEPHEN V. & KRIS A.	11	REV. 124+28 LT. REV. 124+65 LT.	REV. 125+70 LT.			ALL R. T. & I. DRIVE (T)	QCD		BRATTLEBORO			20' R.O.W. TO RTE. 9 30' GRAVEL M.P. 0159						
12A	GOLEMBIEWSKI, JOSEPH H. & KARIN G.	11	REV. 124+31 RT. REV. 127+25 RT. 128+00 RT. 129+50 RT. 129+80 RT.	130+00 RT. 130+00 RT. 129+70 RT. 130+15 RT.	0.31A±		CONST. (T) 0.06A± SLOPE (T) 0.02A± CUL., DIT. & DR. (P) REMOVE & RESET (T)	WD	02-12-93	BRATTLEBORO	233	433	2701 S.F.± 981 S.F.± FENCE						
12B		11	REV. 124+31 RT.	130+00 RT.	0.32A±		ALL R. T. & I.						VT RTE. 9						

03-3220 1805 84E070

ACCT.prop
/prop/84e070/re070d.dgn
DATE PLOTTED 19-AUG-1996
84e070d3.i

DR. (P)- DRAINAGE RIGHT
DIT. (P)- DITCHING RIGHT
CH. (P)- CHANNEL RT.
DRIVE (T)- DRIVE RIGHT
CUL. (P)- CULVERT RIGHT
[W]- WATER SOURCES

PRESENT R.O.W.

TAKING WITHOUT ACCESS

TAKING WITHOUT ACCESS ALONG PROPERTY LINE

TAKING WITH ACCESS

PERMANENT EASEMENT

TEMPORARY EASEMENT

(P)

(T)

LEGEND

.....CZ(P).....

CONST.(T)

SR

P

L

△

△

△

CLEAR ZONE

CONSTRUCTION EASEMENT

SLOPE RIGHTS

PROPERTY LINE

TOP OF CUT

TOE OF SLOPE

APPROVED: LAWRENCE BLISS L.S. DATE: 8-26-91
AGENT D. PLANS & TITLES

R. O. W. PLANS
BRATTLEBORO
HES 010-1 (30)
SHEET 8 OF 11

TABLE OF PROJECT PROPERTY ACQUISITION

STATE OF VERMONT AGENCY OF TRANSPORTATION RIGHT OF WAY PLANS DETAIL SHEET

PARCEL NO.	GRANTOR	SHEET NO.	BEGINNING STATION	ENDING STATION	TAKING	REM.	RIGHTS	TITLE TAKEN	DATE	TOWN OR CITY RECORDED	BK.	PG.	REMARKS	REVISION NO.	SHEET	DESCRIPTION OF REVISION	DATE	MADE BY	APPROVED BY
13A	MCKAY, JOHN E. & CHRISTIE M.	11	REV. 126+62 LT. REV. 126+77 LT. REV. 128+70 LT.	130+00 LT. 130+00 LT. 130+00 LT.	0.17A±		CONST. SLOPE (T) 0.06A± (T) 0.01A±	WD	01-25-93	BRATTLEBORO	233	104	2813 S.F.± 427 S.F.±						
13B		11	REV. 126+62 LT.	130+00 LT.	0.19A±		ALL R. T. & I.						VT RTE. 9						
14	TOWN OF BRATTLEBORO	10	TH 48 26+73 CL.				APPROACH (T)						TH 48						
15	NEW ENGLAND TELEPHONE COMPANY												UTILITY						
16	CENTRAL VERMONT PUBLIC SERVICE CORP.												UTILITY						
17	OLSON, EDWARD M. & JOYCE M.	11	REV. 124+28 LT. REV. 124+65 LT.	REV. 125+70 LT.			ALL R. T. & I. DRIVE (T)	QCD	01-28-93	BRATTLEBORO	233	211	20' ROW TO RTE. 9 30' GRAVEL MP 0159						
18	DODGE, ETTA M.	11	118+85 LT.	119+50 LT.			ALL R. T. & I.						HOUSE TRAILER						
	RELINQUISHMENT NO. 1	10, 11	TH 48 27+42 RT.	REV. 115+58 RT.									LENGTH 1115' VT. RTE. 9						
	MAINTENANCE AGREE. NO. 1	11	REV. 115+58 RT.	REV. 115+55 RT.									LENGTH 22' NEW T.H. 48						

MAR 20 1996

ACCT. PROP
ZFAHETO, 70384E070D.DGN
PRF: 84E070D4
DATE PLOTTED 6-MAR-1992

03-3220 1805 84E070

DR. (P)- DRAINAGE RIGHT
DIP. (P)- DITCHING RIGHT
CH. (P)- CHANNEL RT.
DRIVE (T)- DRIVE RIGHT
CUL. (P)- CULVERT RIGHT
W- WATER SOURCES

PRESENT R.O.W.
TAKING WITHOUT ACCESS
TAKING WITHOUT ACCESS ALONG PROPERTY LINE
TAKING WITH ACCESS
PERMANENT EASEMENT
TEMPORARY EASEMENT

LEGEND . . . CZ (P) CLEAR ZONE
CONST. (T) CONSTRUCTION EASEMENT
SR SLOPE RIGHTS
P PROPERTY LINE
L TOP OF CUT
O TOE OF SLOPE

APPROVED: LAWRENCE BLISS L.S. DATE: 8-26-91
AGENT D. PLANS & TITLES

R. O. W. PLANS

BRATTLEBORO
HES 010-1 (30)
SHEET 9 OF 11

EXCAVATION OF SURFACES & PAVEMENTS
107+25 ~ 111+50 RT. (ON EXIST. RT. 9)
(DO NOT SEED THIS AREA GRAVEL
SURFACE ONLY IS TO REMAIN)

DRILLING & BLASTING OF
SOLID ROCK SUBGRADE
106+00 ~ 117+50 LT.

CONSTRUCT STONE LINED DITCH
102+00 ~ 106+00 LT.

REMOVAL & DISPOSAL OF GUARDRAIL
108+35 ~ 111+25 RT. (ON EXIST. RT. 9)
TH 48 27+50 LT ~ 27+65 LT.

STEEL BEAM GUARD RAIL W/STEEL POSTS
102+25 ~ 107+00 RT.

BREAKWAY CABLE TERMINAL
102+00 ~ 102+25 RT.
107+00 ~ 107+25 RT.

REMOVE AND RESET GUARD RAIL

TERMINAL CONNECTOR FOR STEEL
BEAM GUARD RAIL
TH # 48 27+74.10 LT.

HEAVY DUTY STEEL BEAM GUARD RAIL
W/STEEL POSTS, TYPE I
TH # 48 27+50 ~ 27+74.10 LT.
(FACTORED LENGTH)

CONSTRUCT DRIVE
109+34 RT 16' WIDE

STONE FILL TYPE II
FOR SLOPE STABILIZATION
105+50 ~ 114+00 LT

PLANK RAIL
108+88 RT ~ 109+00 R.


CURVE DATA

$\Delta = 68^{\circ}06'44''$ LT
D = 730'
R = 763.94'
T = 516.38'
L = 908.16'
E = 158.15'

BANK = 0.080 FT / FT & CINDY C.
MAXIMUM CONSTRUCTION LIMITS
FOR UNSUITABLE MATERIAL.
(SEE NOTE 1 BELOW.)

BEGIN R.O.W. PROJECT

HES 010-1 (30) STA. 101+84 25' RT.

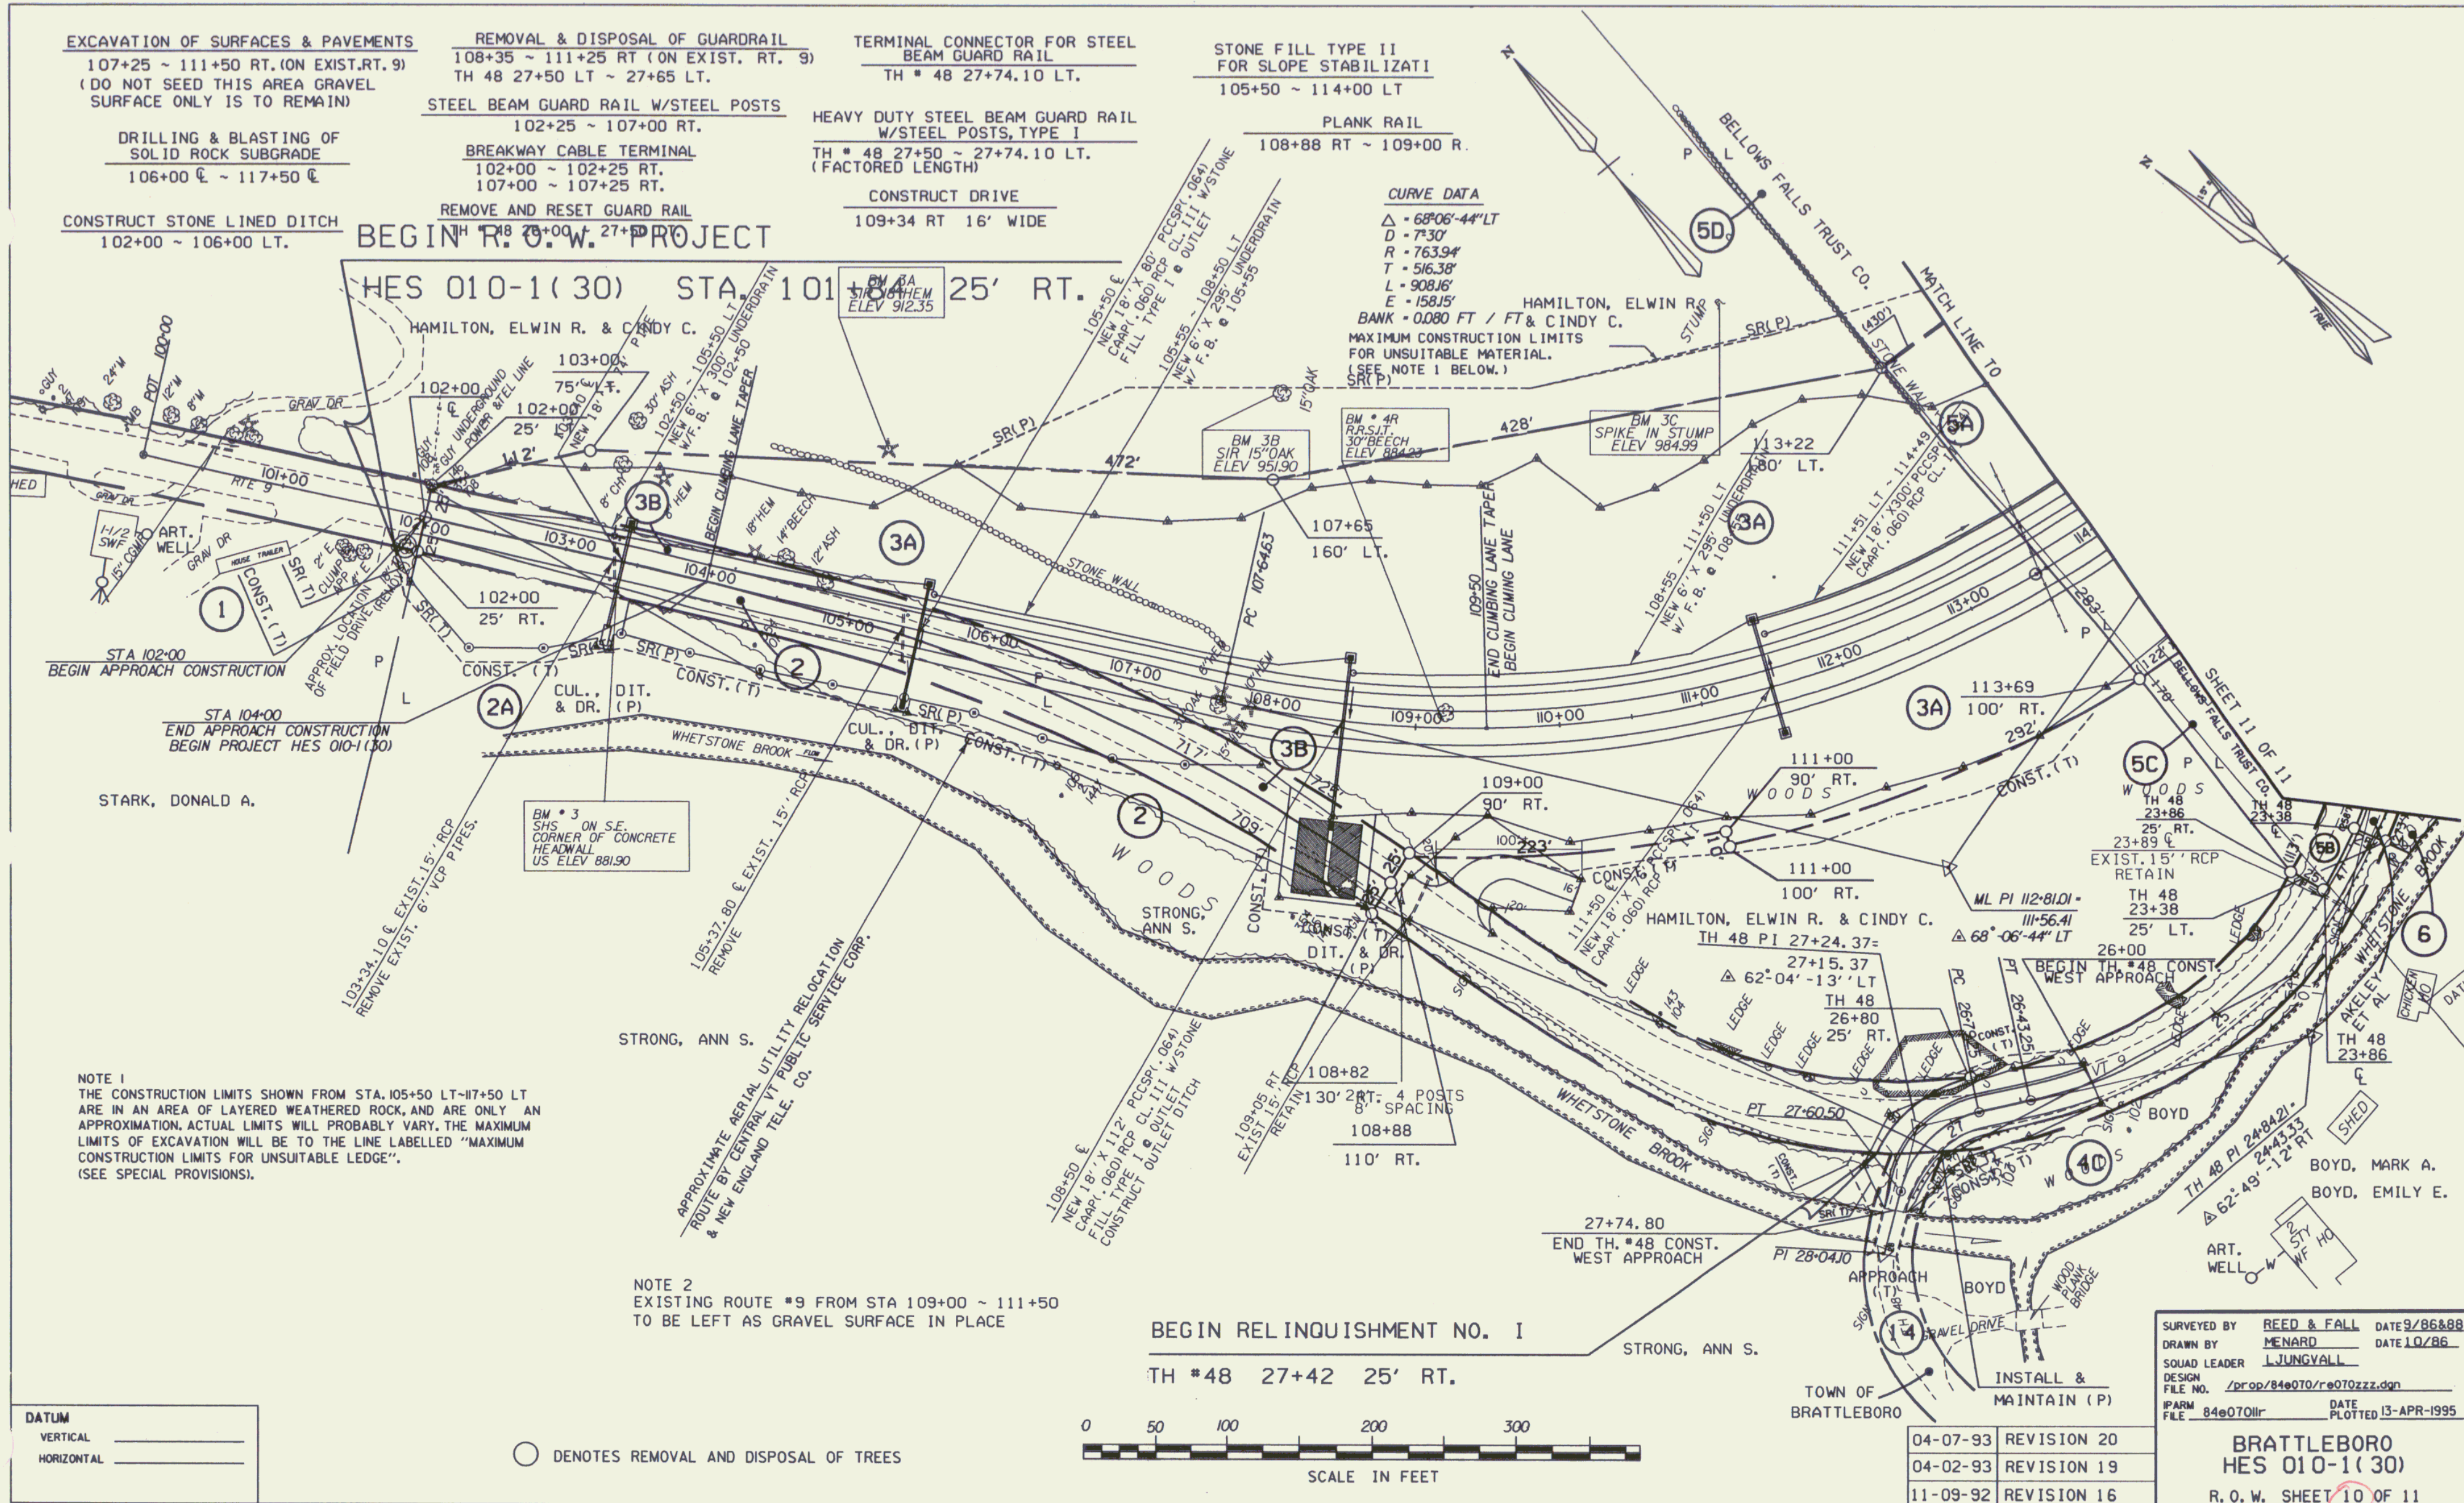

MAR 20 1996

SURVEYED BY	REED & FALL	DATE	9/86&88
DRAWN BY	MENARD	DATE	10/86
SQUAD LEADER	L. JUNGVAL		
DESIGN			
FILE NO.	/prop/84e070/r0070zzz.dgn		
IPARM	84e070iir	DATE	13-APR-1995
FILE			
04-07-93	REVISION	20	
04-02-93	REVISION	19	
11-09-92	REVISION	16	
BRATTLEBORO			
HES 010-1 (30)			
R.O.W. SHEET 10 OF 11			

EXCAVATION OF SURFACES & PAVEMENTS
TH# 48 23+00 E ~ 118+20 RT (EXIST. RT 9)
118+20 E ~ 123+50 E

DRILLING & BLASTING OF
SOLID ROCK SUBGRADE
106+00 E ~ 117+50 E

REMOVE & REPLACE MAILBOX
124+10 LT (MULTIPLE SUPPORT)
(NEW MAILBOXES @ 124+31 LT.)

STEEL BEAM GUARDRAIL
117+50 ~ 123+50 RT
125+35 ~ 127+13 LT

CONSTRUCT DRIVES
118+50 LT (12' WIDE)
124+65 LT (30' WIDE)
TH# 48 22+25 LT (12' WIDE)

BREAKWAY CABLE TERMINAL
117+25 ~ 117+50 RT.
123+50 ~ 123+75 RT.
125+10 ~ 125+35 LT.
127+13 ~ 127+38 LT.

SURV. CURVE DATA
 $\Delta = 151^\circ 10' 10''$ LT
D = 730'
R = 763.95'
T = 101.84'
L = 202.48'
E = 676'
BANK = 0.080 FT / FT

CONSTRUCT STONE LINED DITCH

117+50 ~ 118+26 LT.
118+73 ~ 121+25 LT.
126+65 ~ 130+00 LT.

CONSTRUCT PAVED DITCH
125+70 ~ 126+55 LT.

END RELINQUISHMENT NO. 1

BEGIN MAINT. AGREE. AREA NO. 1
REV. 115+58 42' RT. LENGTH

SCARIFYING PAVEMENT
118+00 E ~ 122+50 E

OLSON, STEVEN M. & DIANE M.


OLSON, MICHAEL J.

FILION, PETER J. &
STALKER, CYNTHIA D.

REV. CURVE DATA
 $\Delta = 165^\circ 08.3''$ LT
D = 730'
R = 763.95'
T = 113.77'
L = 224.70'
E = 834'
BANK = 0.080 FT / FT

McKAY, JOHN E.
& CHRISTIE W.

END R.O.W. PROJECT
HES 010-1(30)
STA. 130+15 15' RT.

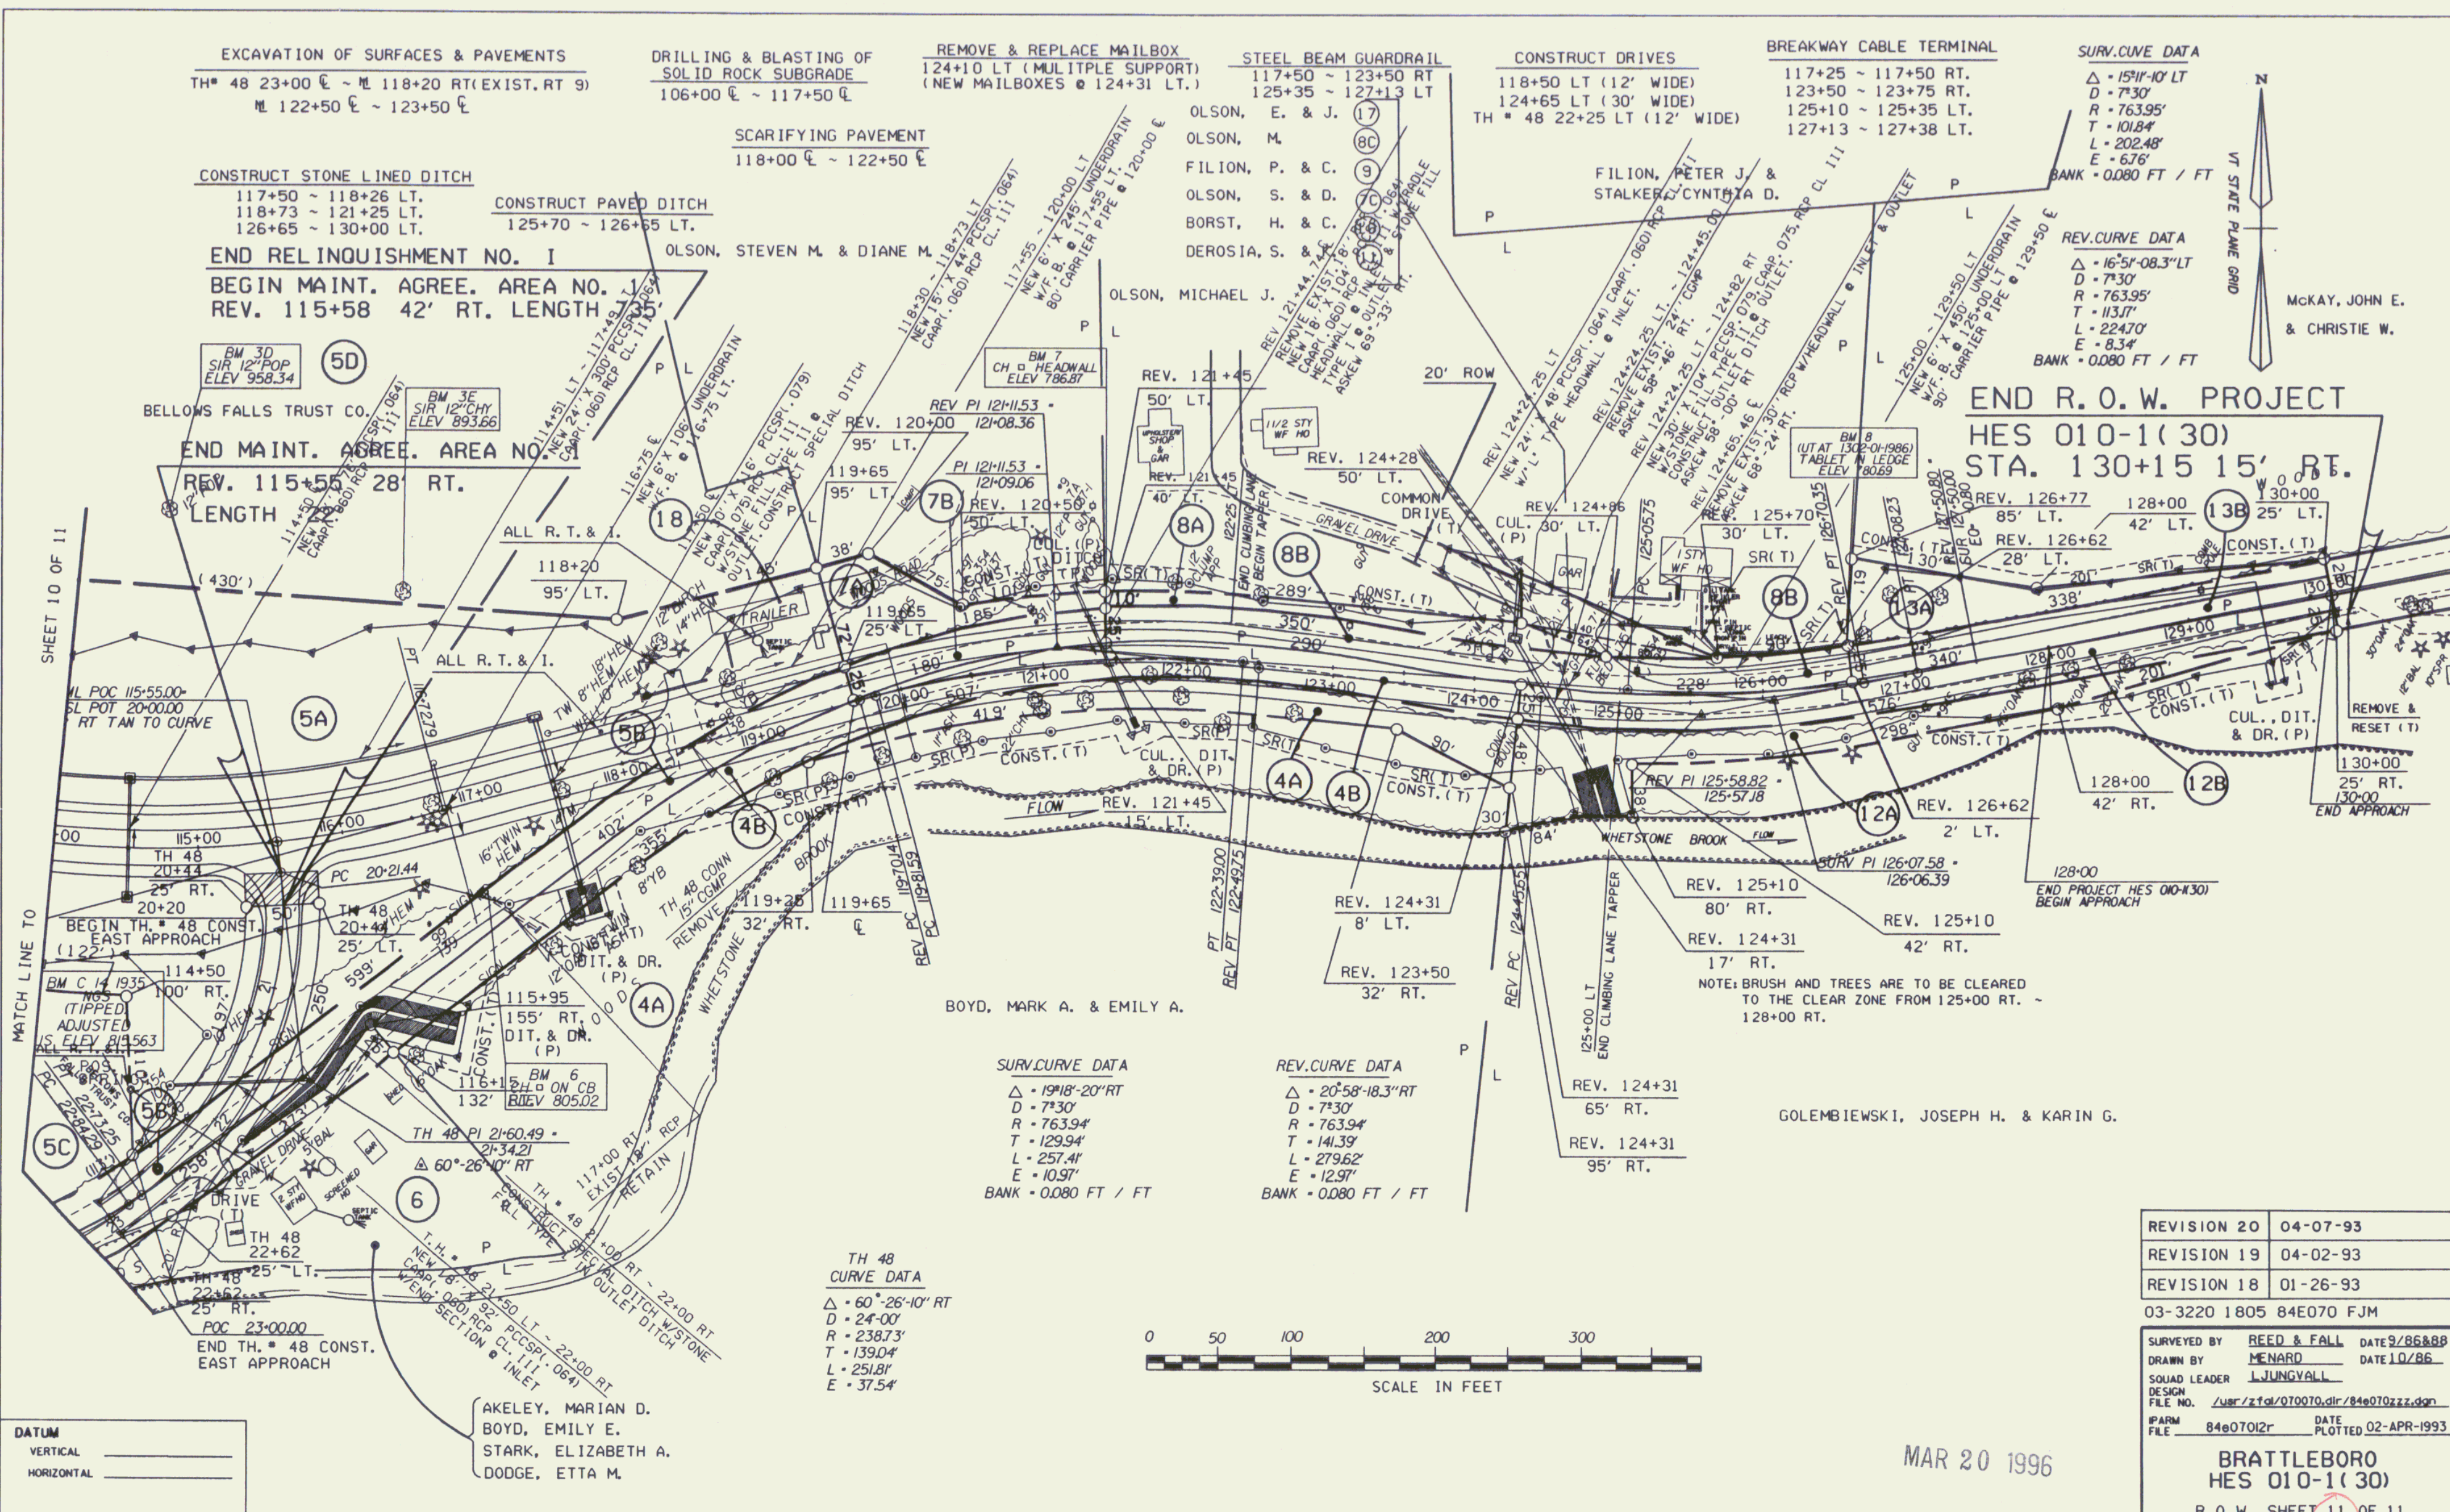

REVISION 20	04-07-93
REVISION 19	04-02-93
REVISION 18	01-26-93
03-3220 1805 84E070 FJM	
SURVEYED BY	REED & FALL DATE 9/86&88
DRAWN BY	MENARD DATE 10/86
SQUAD LEADER	LJUNGVAL
DESIGN	FILE NO. /usr/zfd/070070.dlr/84e070zzz.dgn
IPARM	FILE 84e07012r DATE PLOTTED 02-APR-1993
BRATTLEBORO HES 010-1(30)	
R.O.W. SHEET 11 OF 11	