



Wat

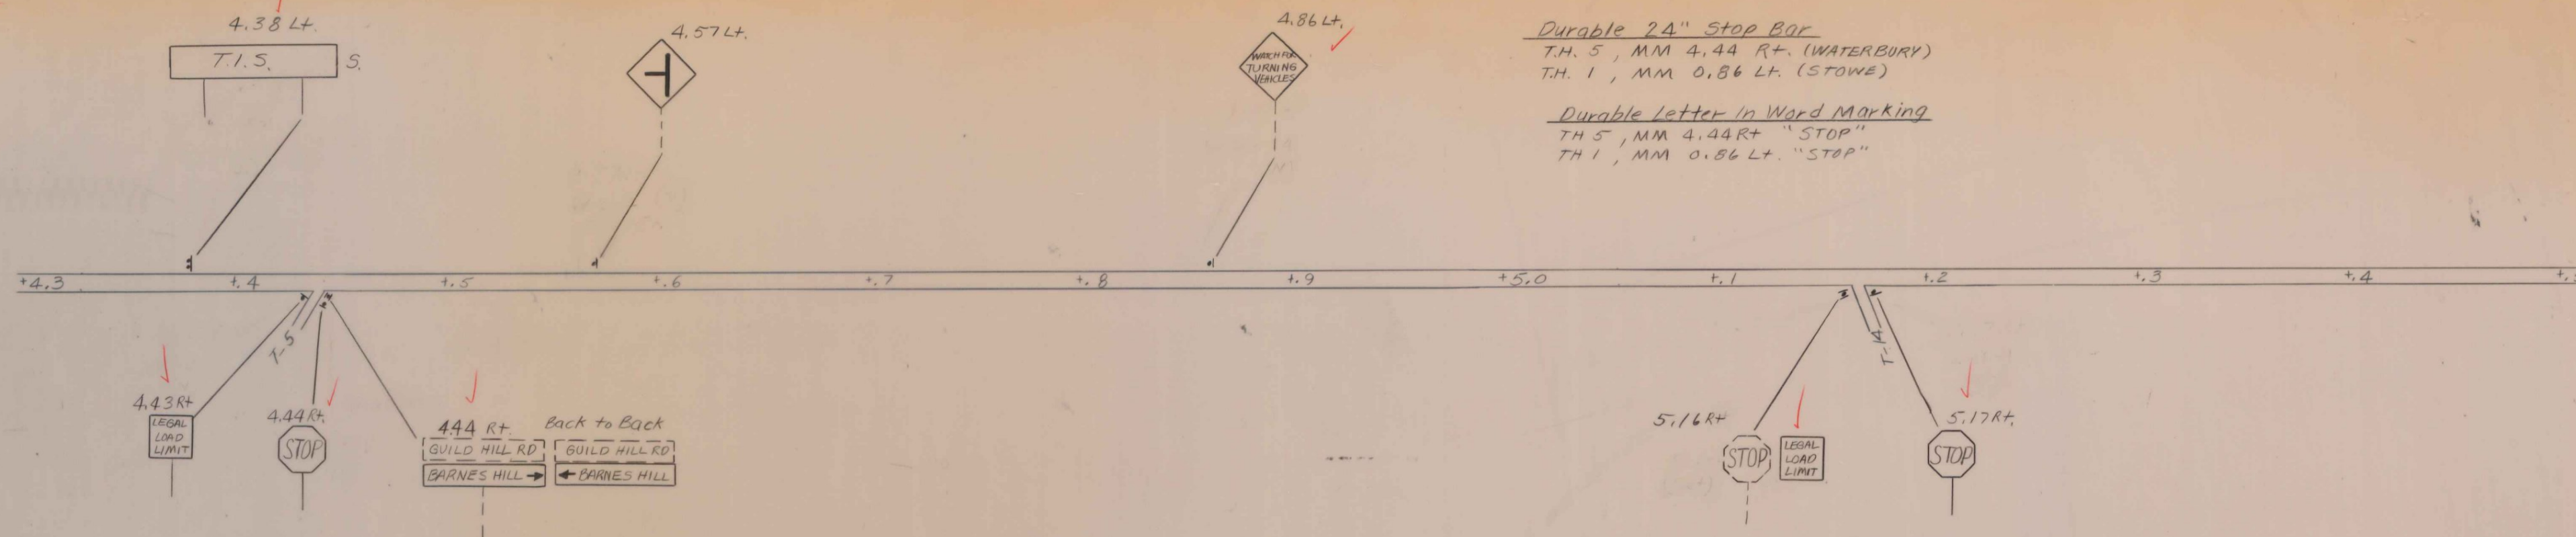


Durable 24" Stop Bar
T.H. 5, MM 4.44 Rt. (WATERBURY)
T.H. 1, MM 0.86 Lt. (STOWE)

Durable Letter in Word Marking
T.H. 5, MM 4.44 Rt. "STOP"
T.H. 1, MM 0.86 Lt. "STOP"

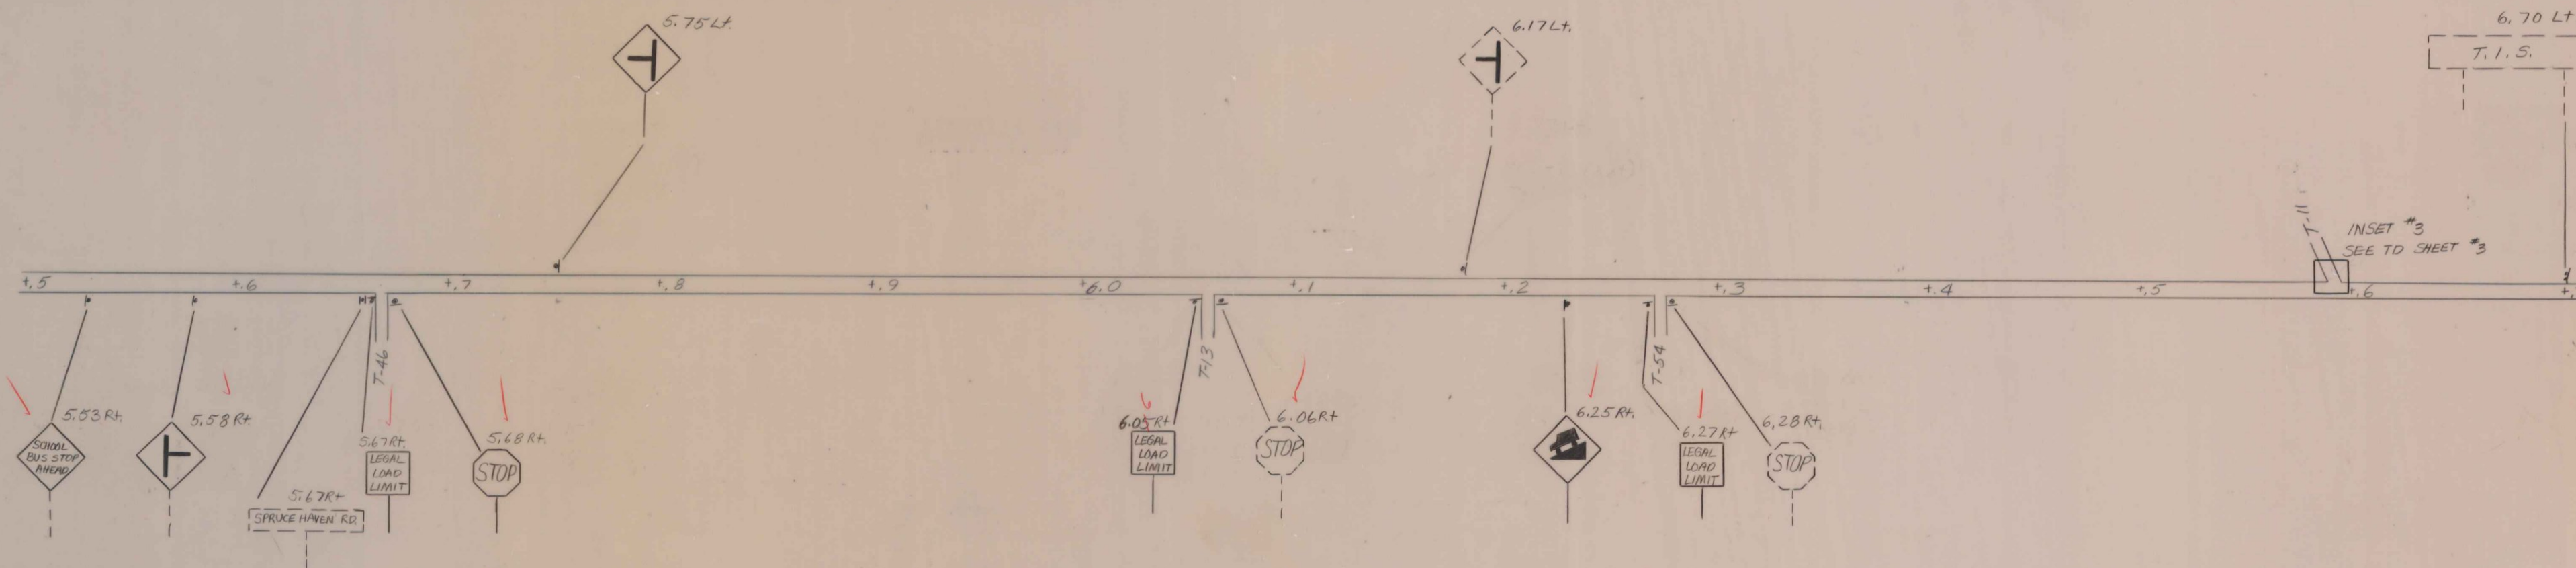

Stowe

Remove & Replace Reflector Unit
STOWE - MM 0.92 - Existing Steel Beam 6.R. 10 Ea.
(Detail on TD #16)

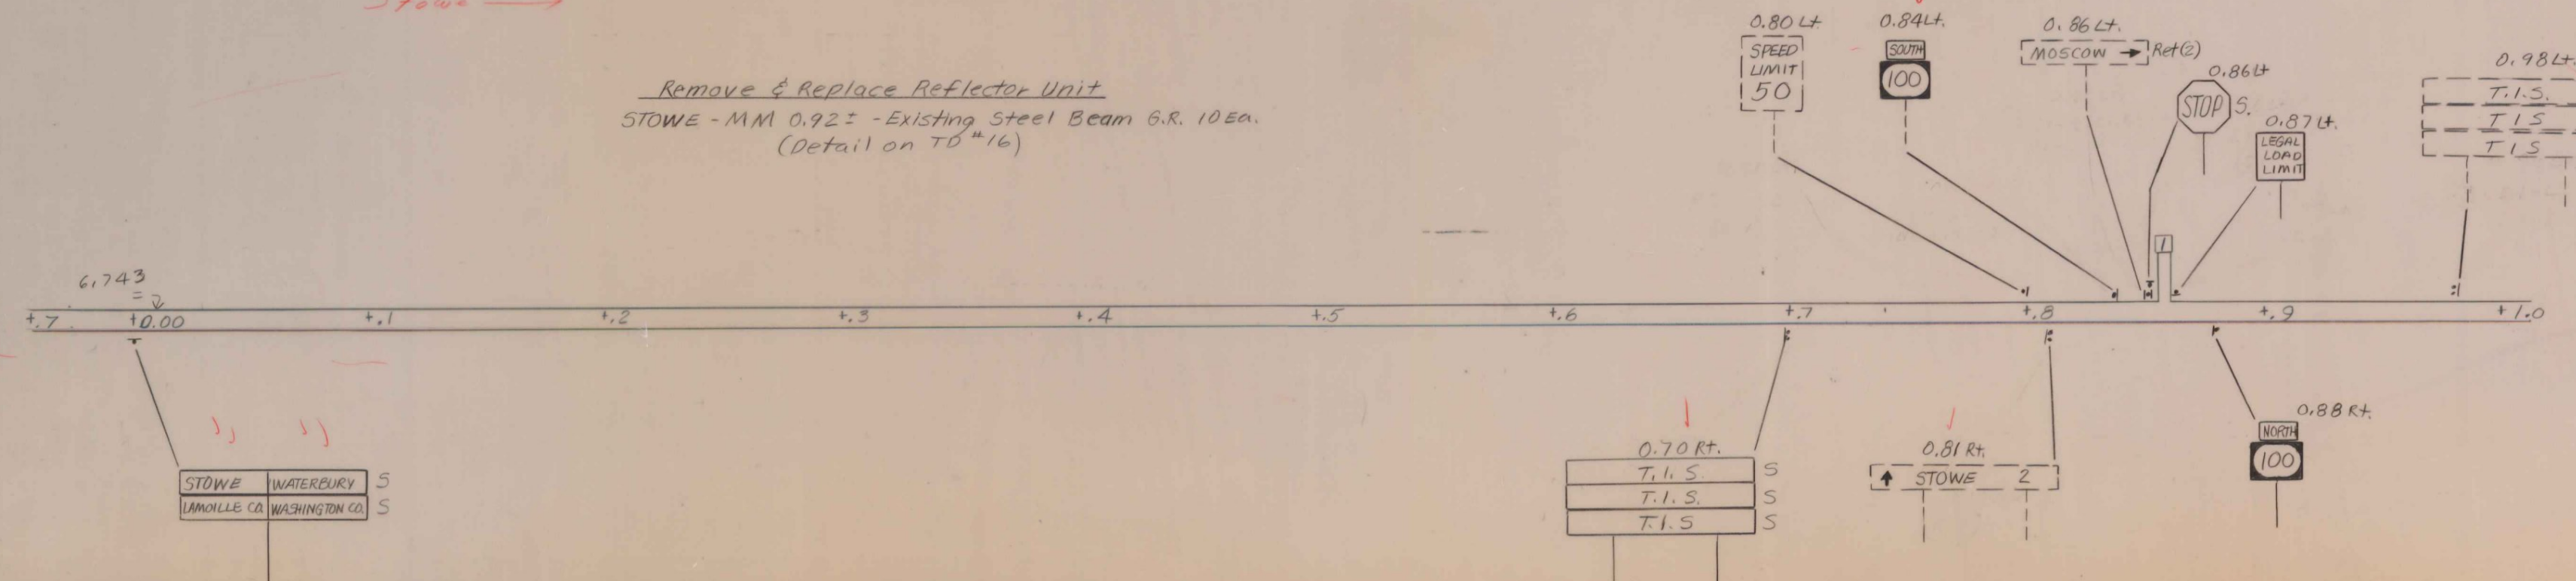

LEGEND

--- = Retained
— = New
S. = Salvaged

NEW SIGNS

PREPARED BY JB DATE 8-86
CHECKED BY DATE
WATERBURY ~ STOWE
PROJ F NO 029-1(12)

TRAFFIC SHEET NO. 5 SHEET 27 OF 108