

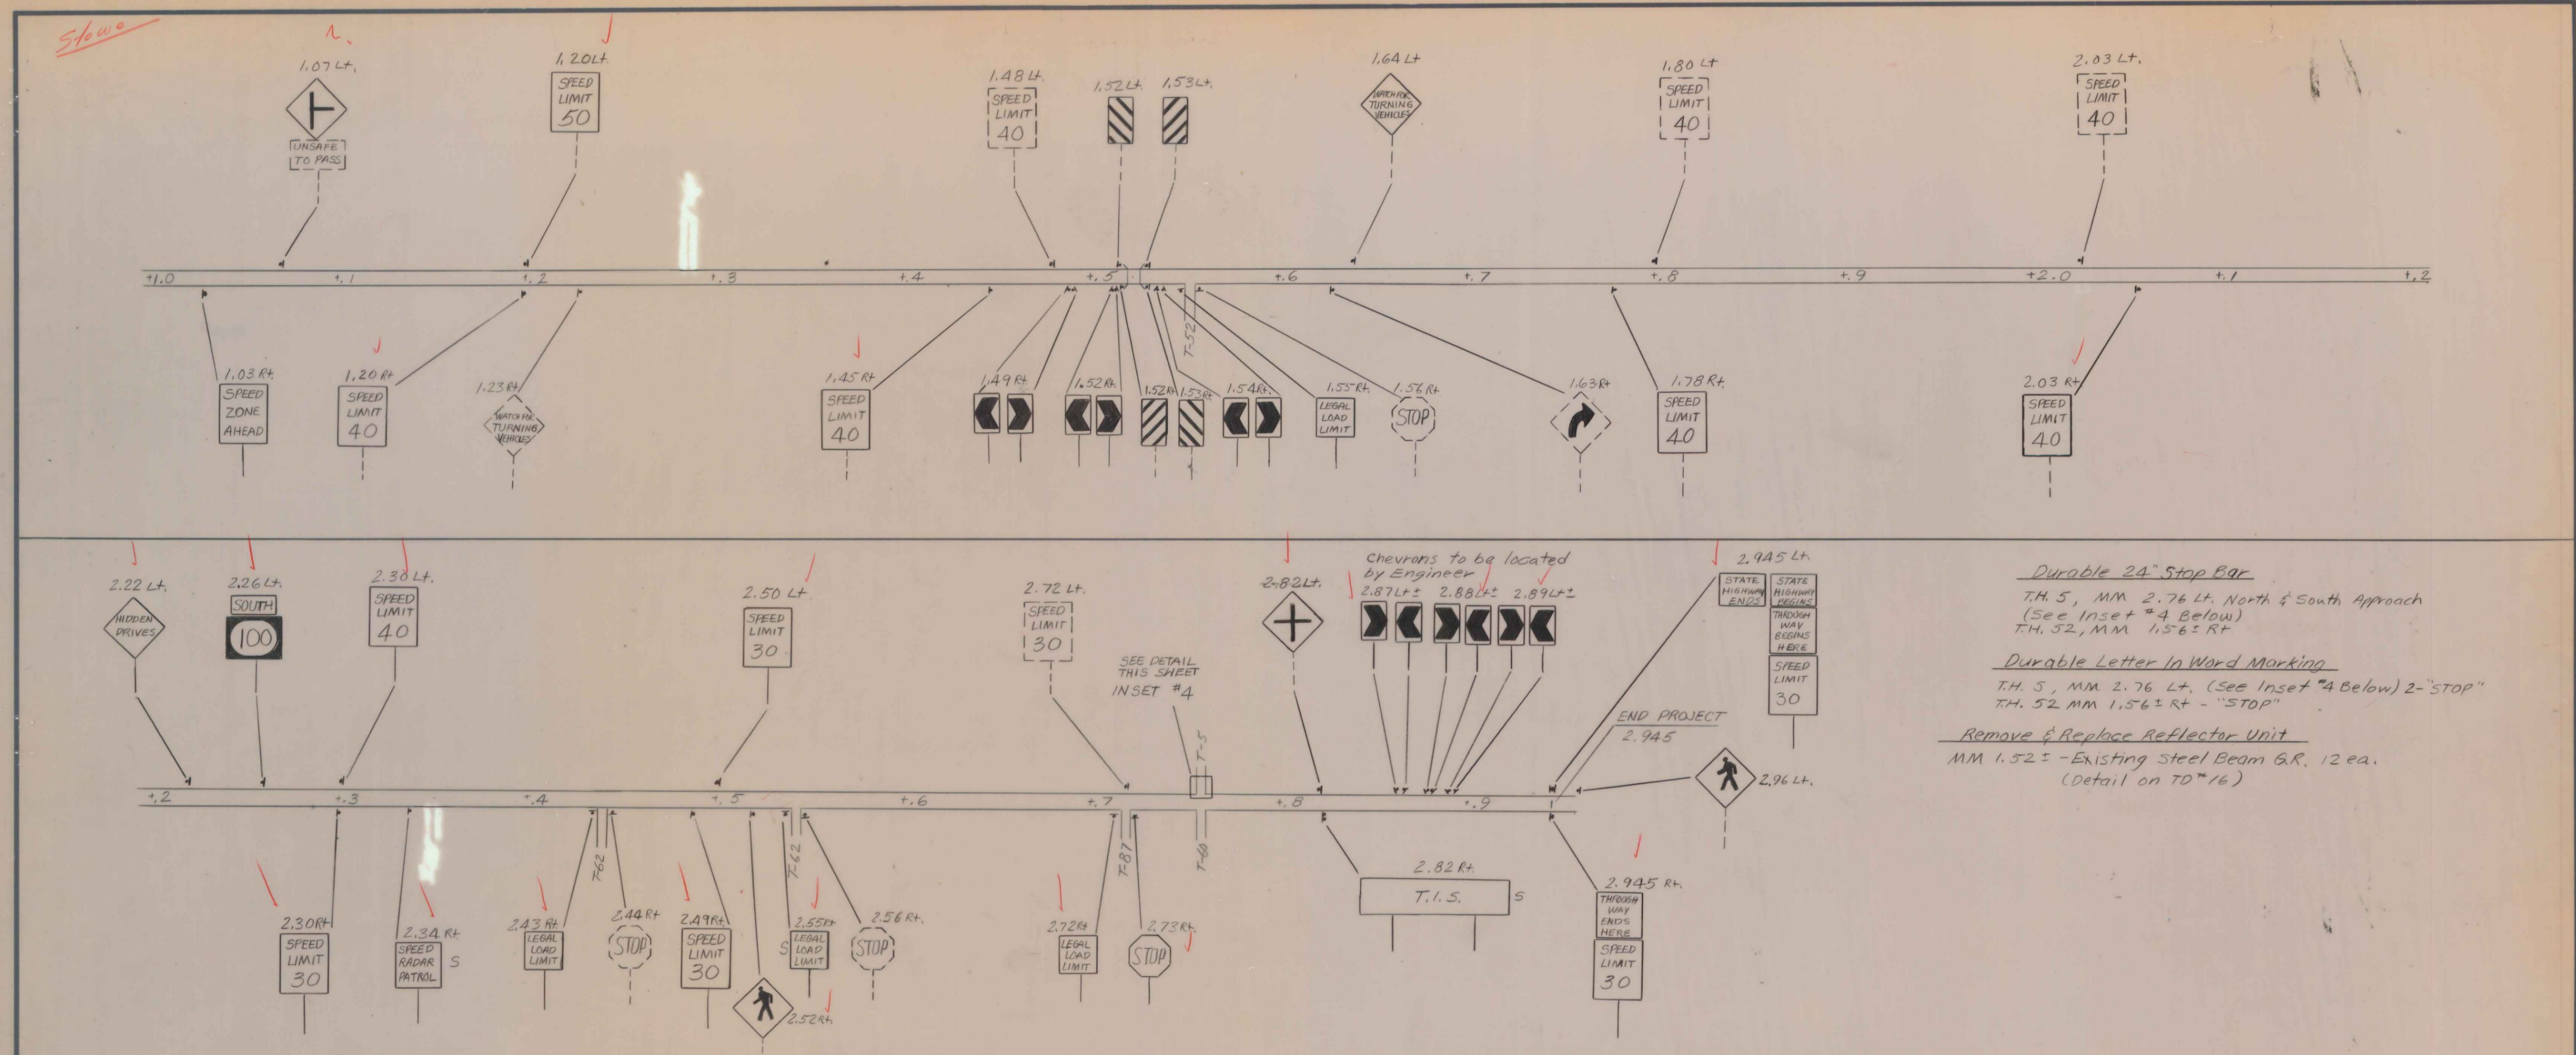
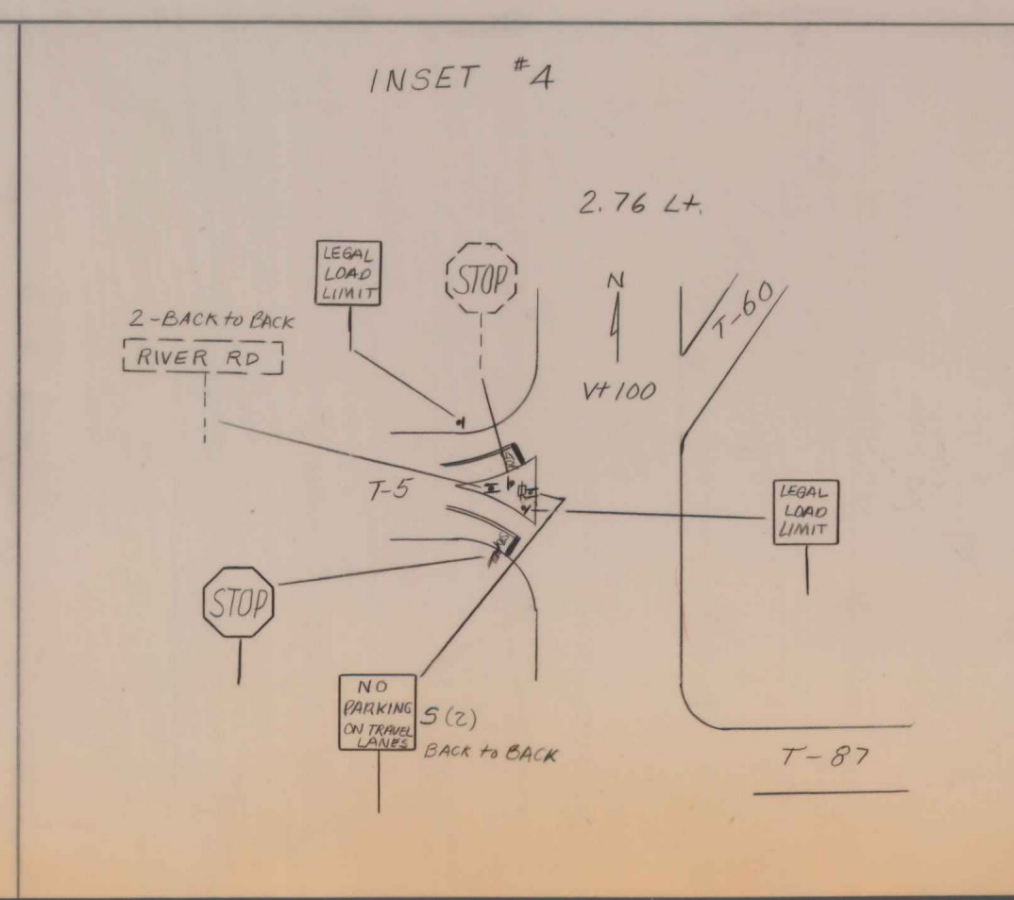
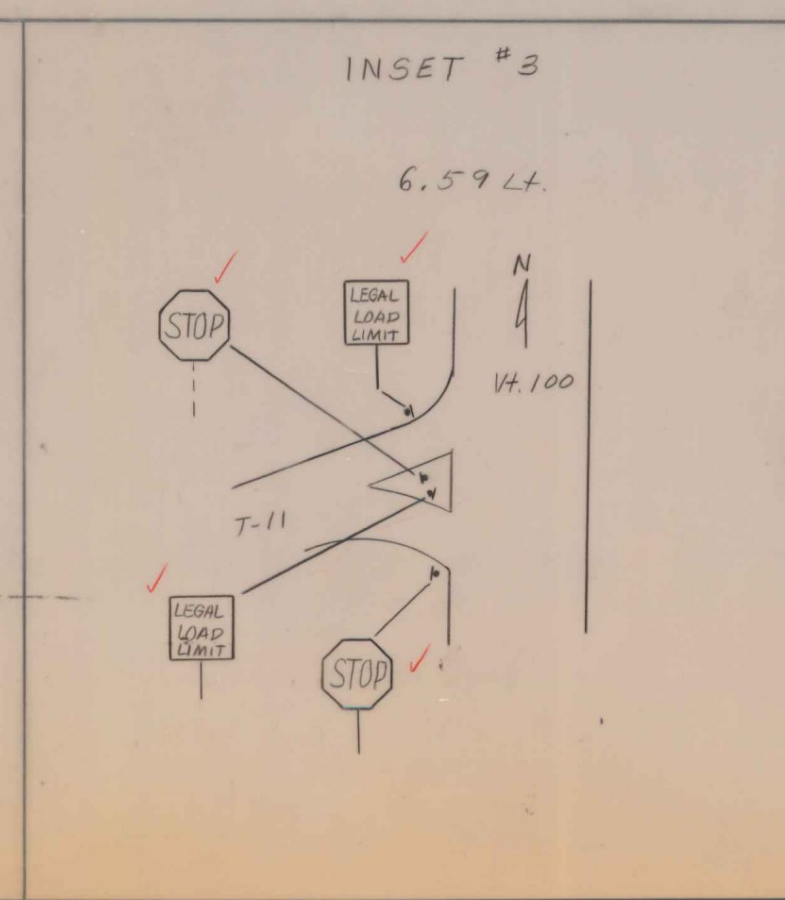


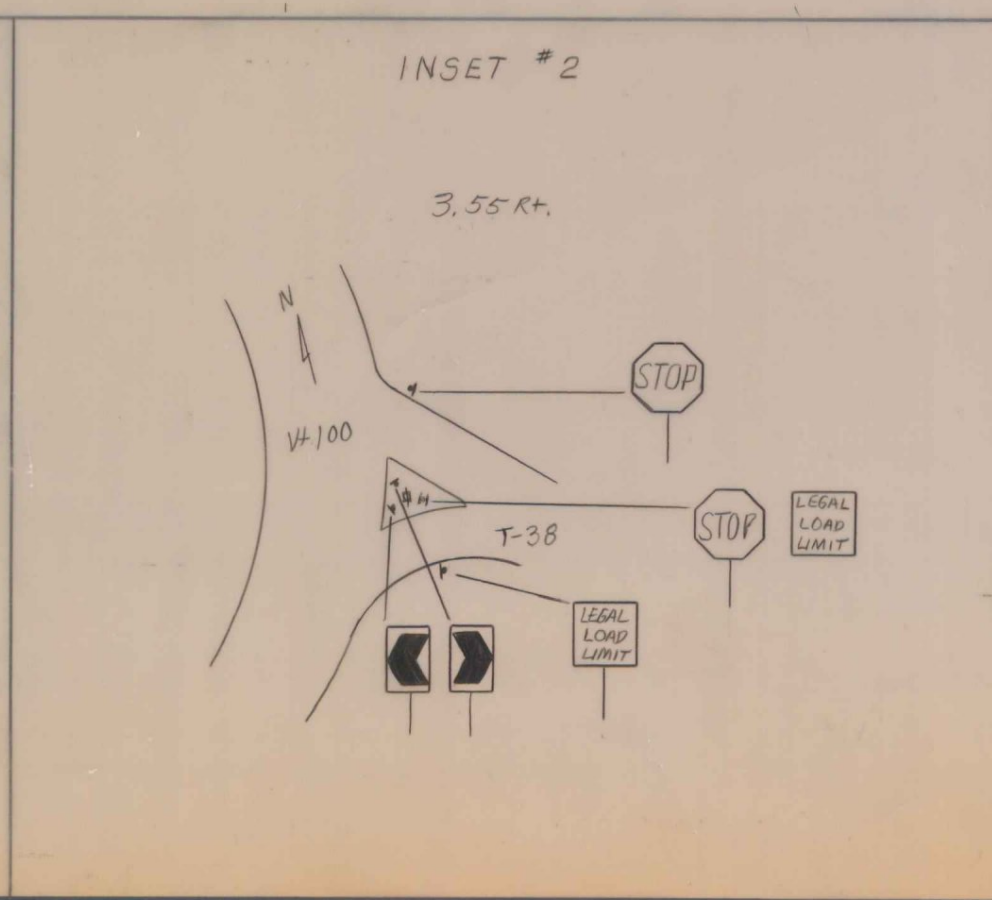

Durable 24" Stop Bar
 T.H. 5, MM 2.76 Lt. North & South Approach
 (See Inset #4 Below)
 T.H. 52, MM 1.56 ± Rt

Durable Letter In Word Marking
 T.H. 5, MM 2.76 Lt. (See Inset #4 Below) 2-"STOP"
 T.H. 52, MM 1.56 ± Rt - "STOP"

Remove & Replace Reflector Unit
 MM 1.52 ± - Existing Steel Beam G.R. 12 ea.
 (Detail on TD #16)

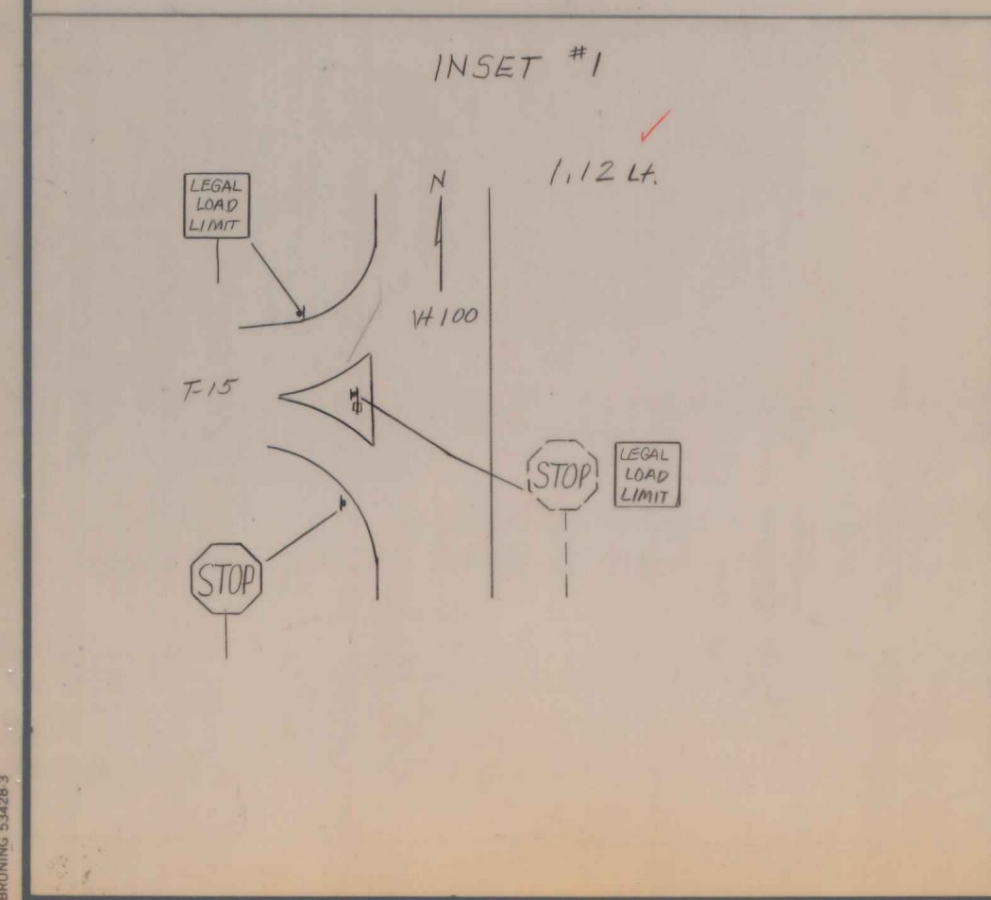

LEGEND

--- = Retained
 — = New
 S. = Salvaged

0 0.05mi. 0.1mi.

NEW SIGNS

PREPARED BY JB DATE 8-86
 CHECKED BY DATE
 WATERBURY ~ STOWE
 PROJ F NO. 029-1(12)
 TRAFFIC SHEET NO. 6 SHEET 28 OF 108