


COLCHESTER MM 0.000=ROUTE LOG STA. 0+00.00
 BEGIN PROJECT F 030-1(13)

Note: Centerline stationing shown is Colchester route log stationing extended throughout entire project for reference (not established in field).

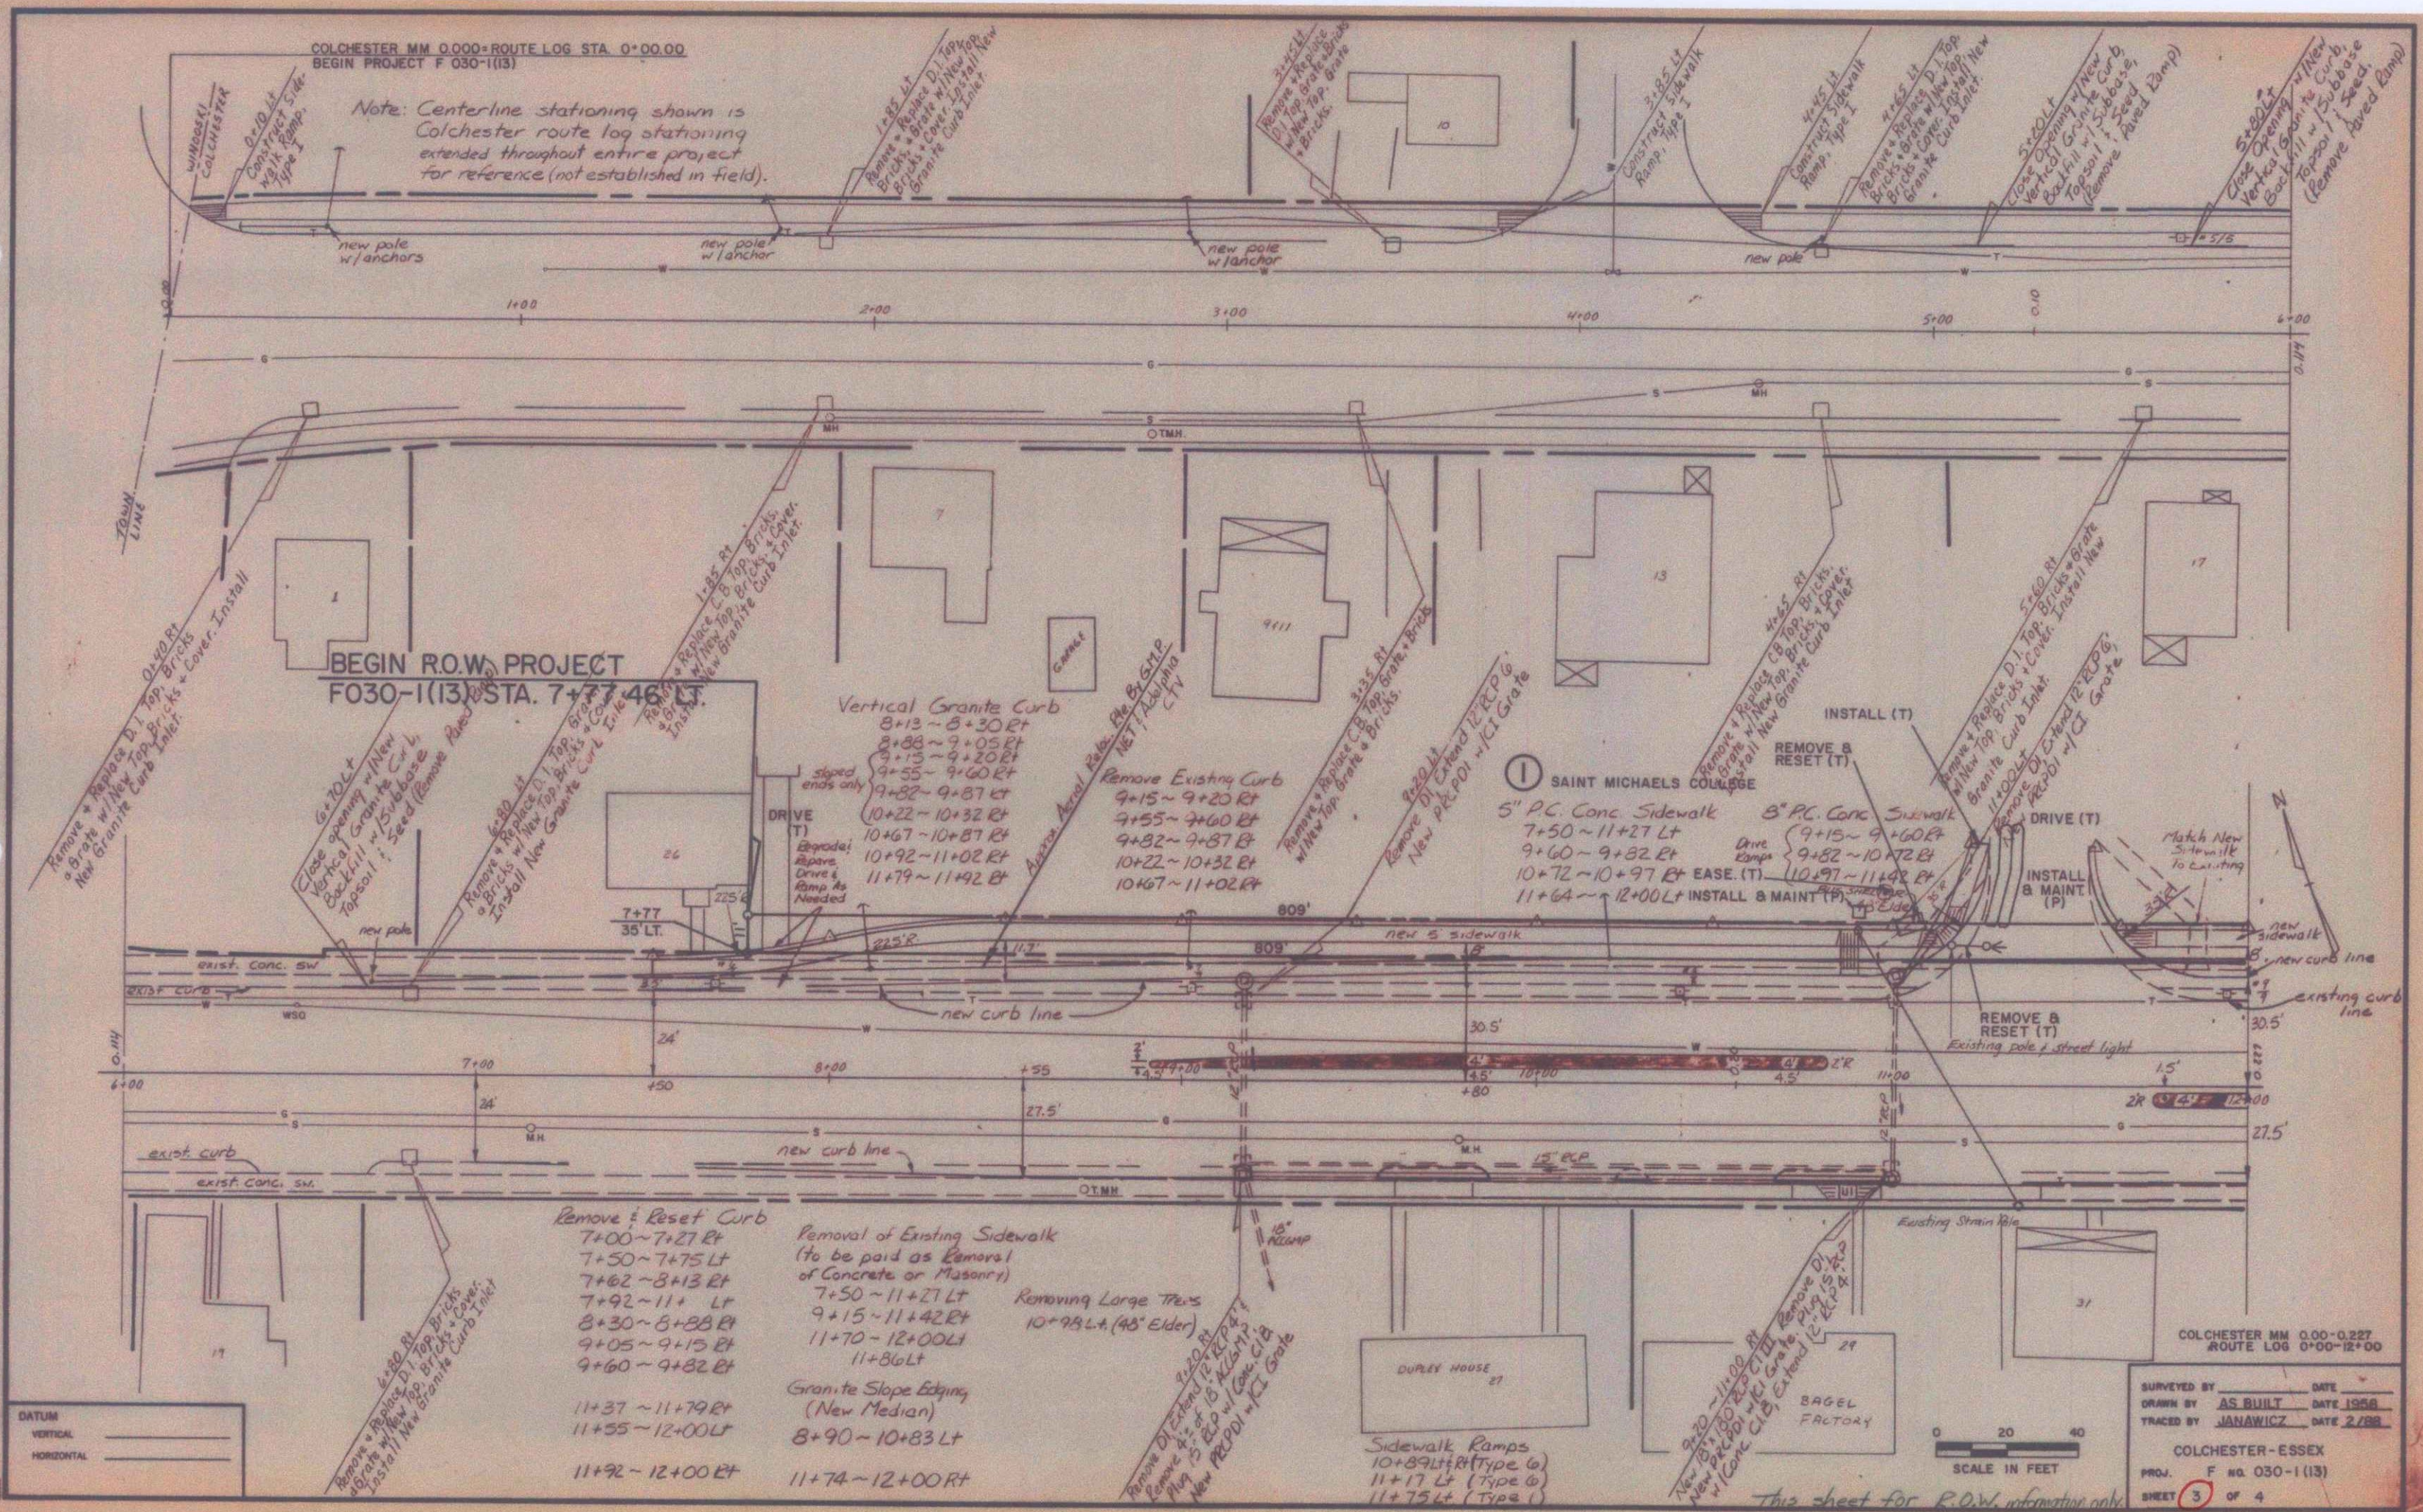

DATUM
 VERTICAL
 HORIZONTAL

COLCHESTER MM 0.00-0.227
 ROUTE LOG 0+00-12+00

SURVEYED BY	DATE
DRAWN BY AS BUILT	DATE 1956
TRACED BY JANAWICZ	DATE 2/78

COLCHESTER-ESSEX
 PROJ. F NO. 030-1(13)
 SHEET 3 OF 4

13 OF 144