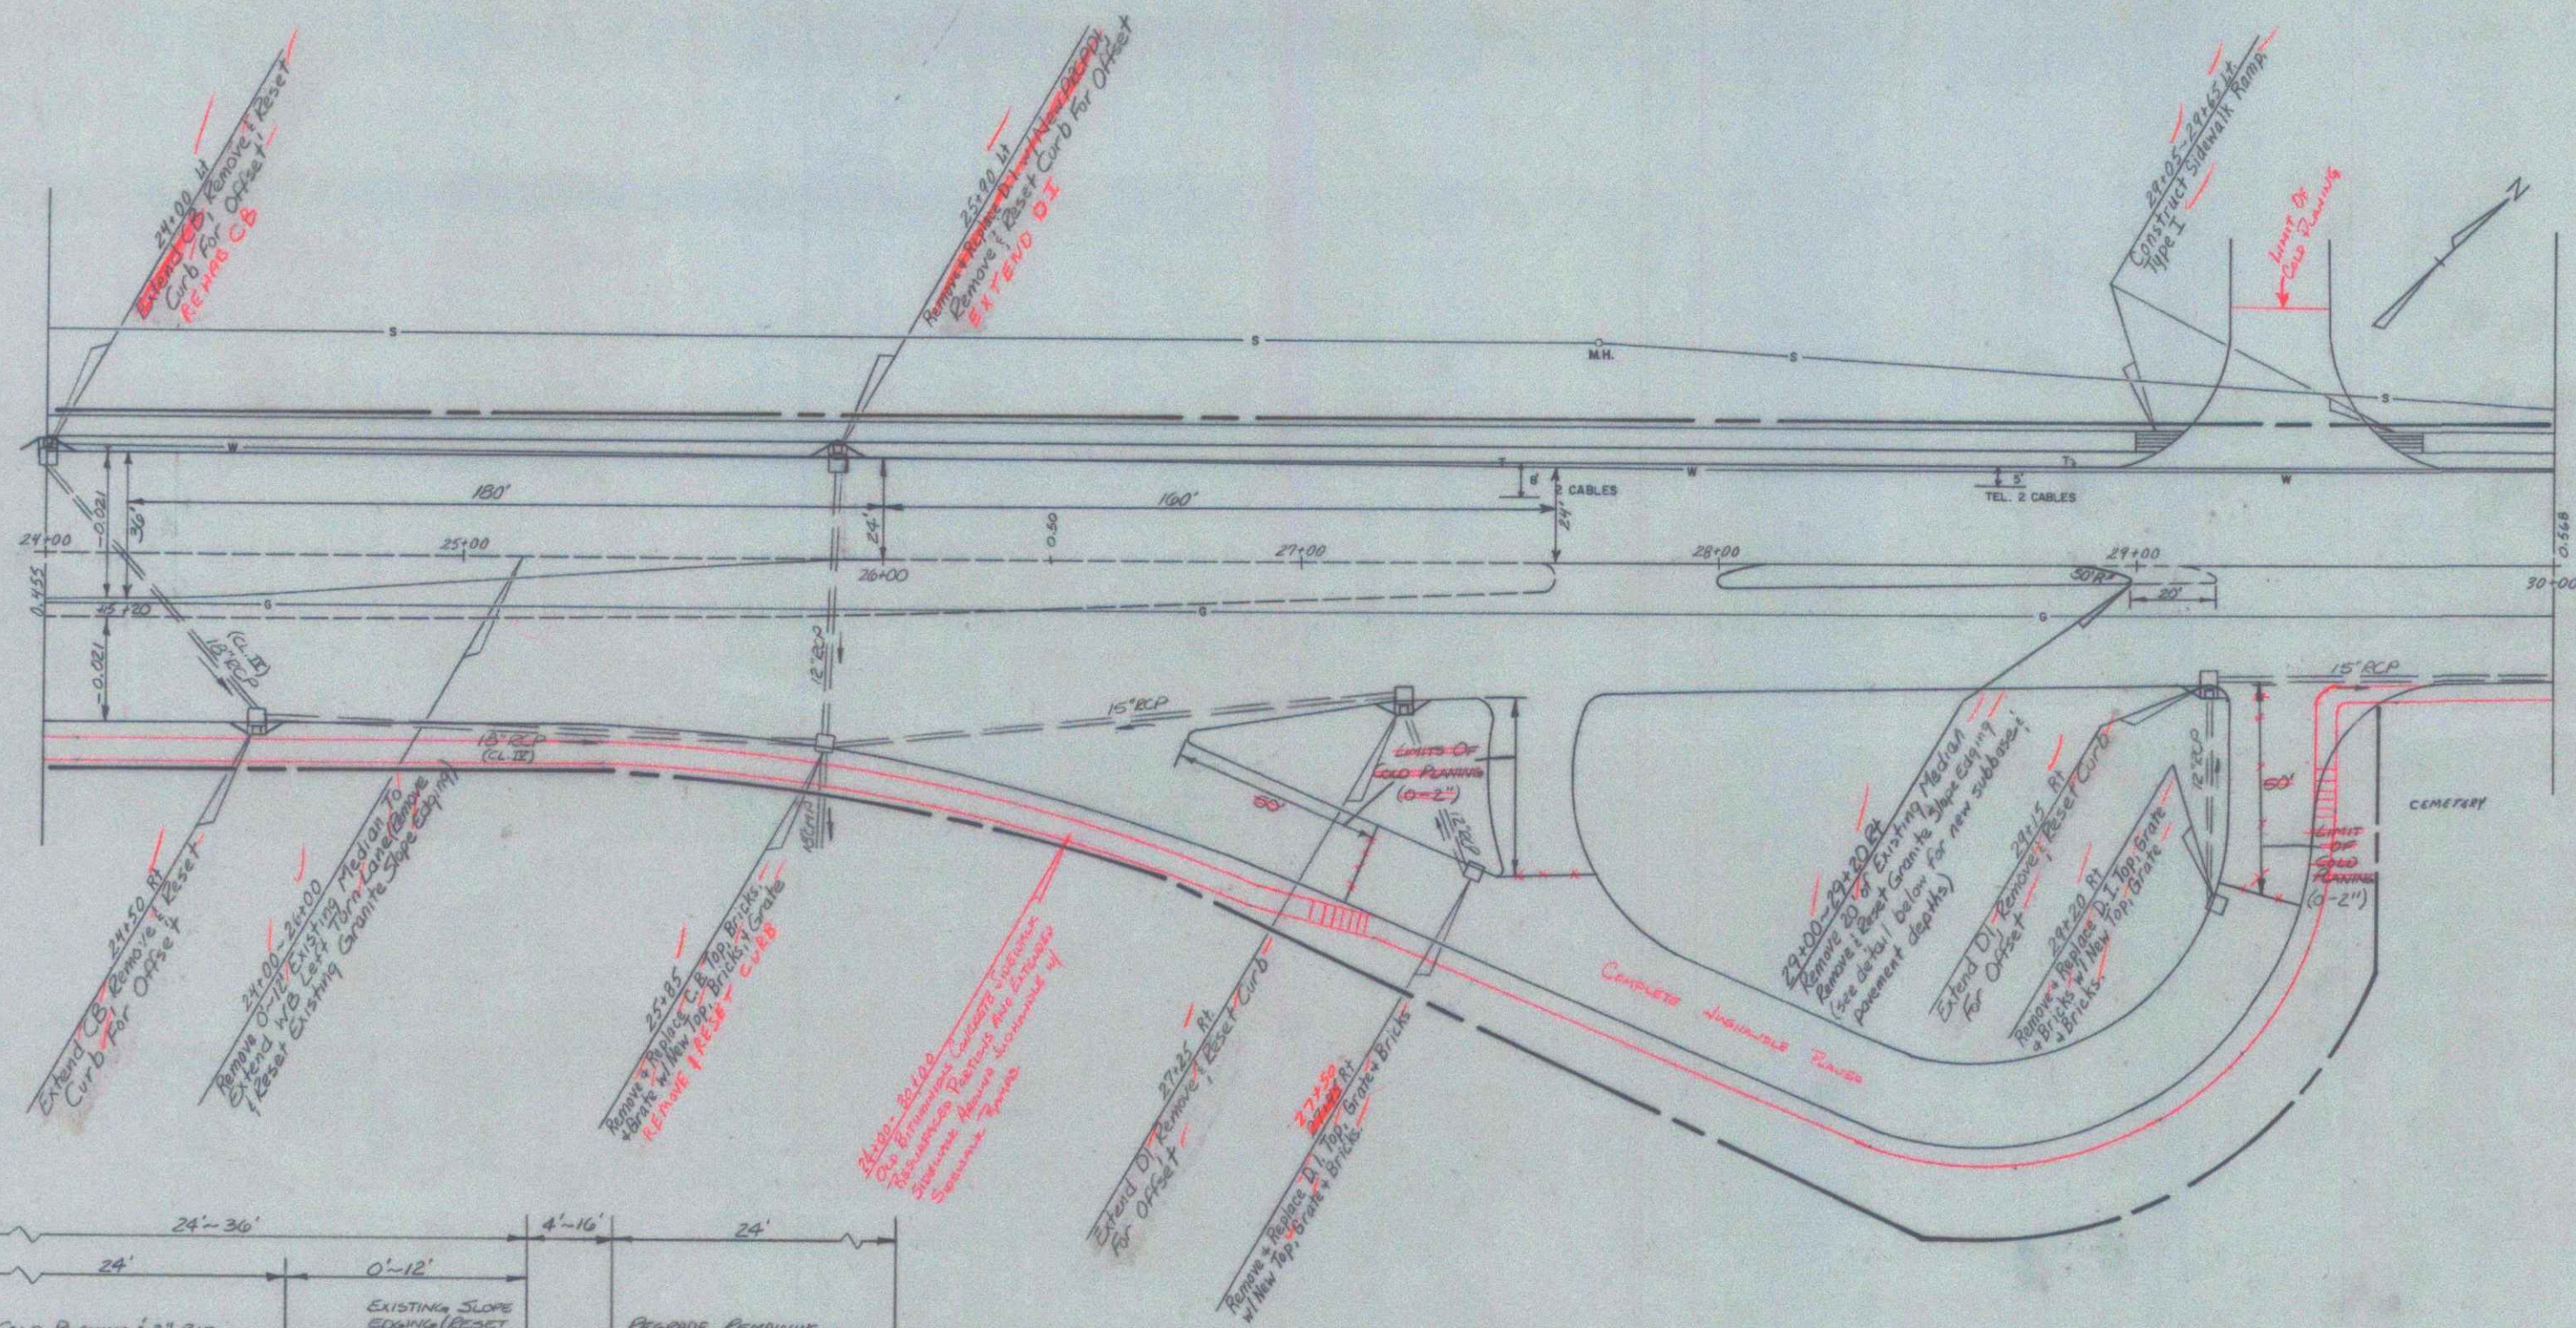


EXCAVATE EXISTING MEDIAN & REPLACE W/ 2" BIT. CONC. PMT. (TYPE II), 5" BIT. CONC. PMT. TYPE I (2-2 1/2" LIFTS), & 18" SUBBASE OF CRUSHED STONE  
 MEDIAN MODIFICATION DETAILS  
 COLCHESTER 23+55-26+00

DATUM  
 VERTICAL \_\_\_\_\_  
 HORIZONTAL \_\_\_\_\_

0 20 40  
 SCALE IN FEET

COLCHESTER MM 0.455-0.568  
 ROUTE LOG 24+00-30+00  
 SURVEYED BY \_\_\_\_\_ DATE \_\_\_\_\_  
 DRAWN BY AS BUILT DATE 1958  
 TRACED BY JANAWICZ DATE 2/88  
 COLCHESTER-ESSEX  
 PROJ. NO. 030-1(13)  
 SHEET 23 OF 144