



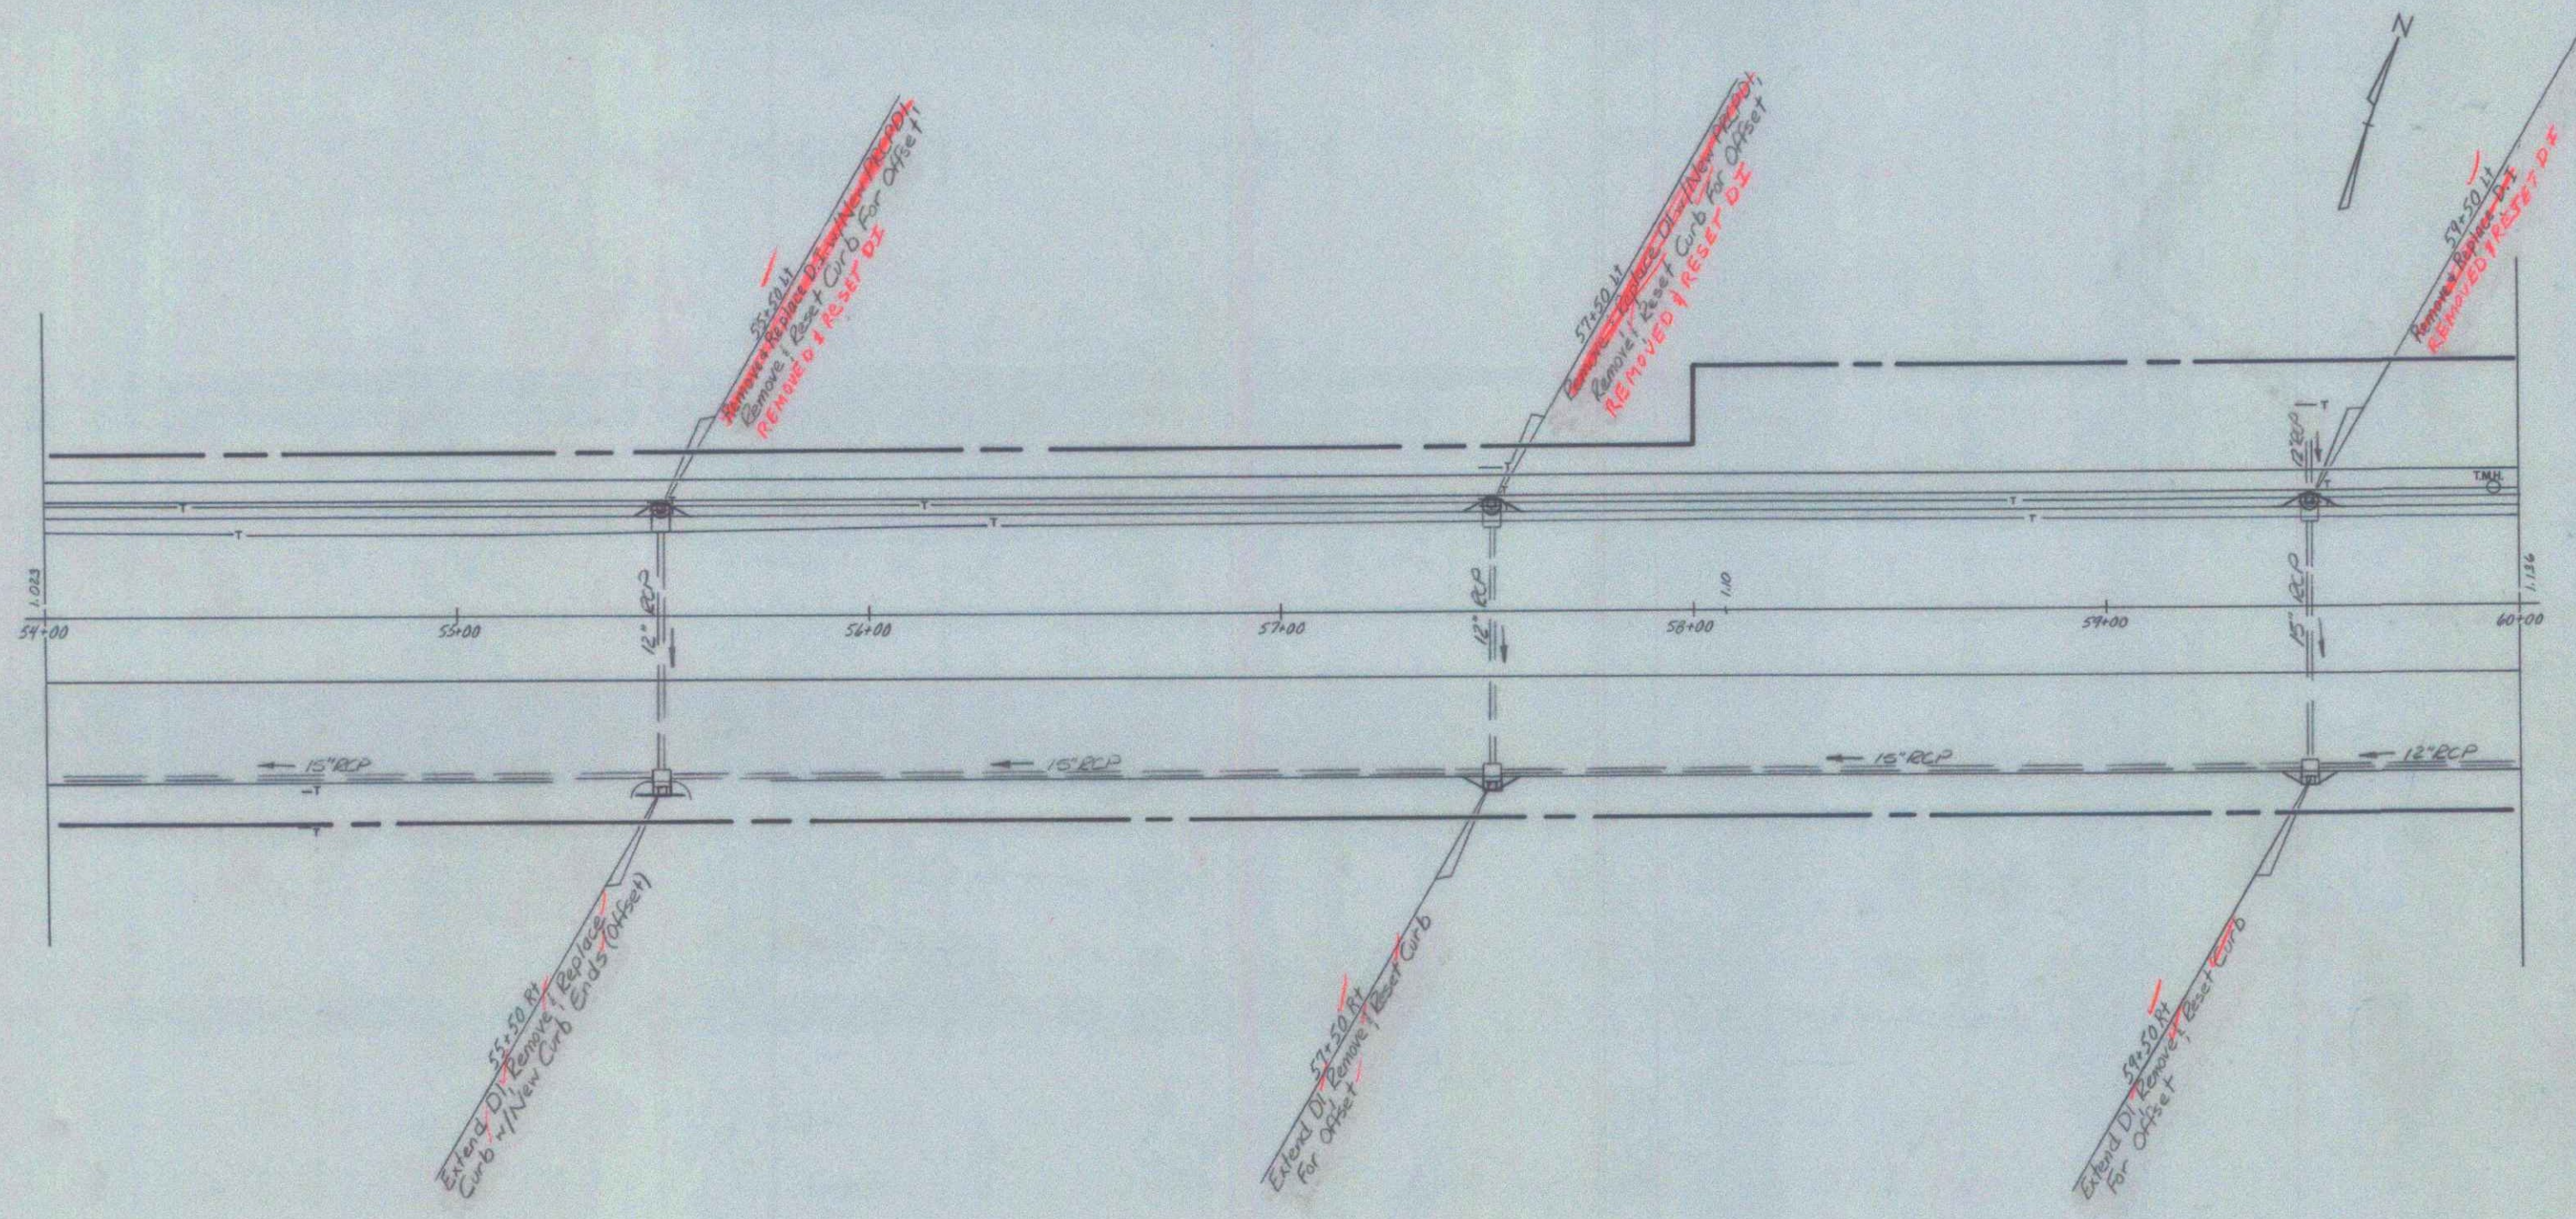

DATUM
 VERTICAL _____
 HORIZONTAL _____

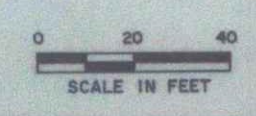

COLCHESTER MM 1023-1136
 ROUTE LOS 54+00-60+00

SURVEYED BY	DATE
DRAWN BY AS BUILT	DATE 1958
TRACED BY JANAWICZ	DATE 2/88

COLCHESTER-ESSEX
 PROJ. F NO. 030-1 (13)
 SHEET 28 OF 144