



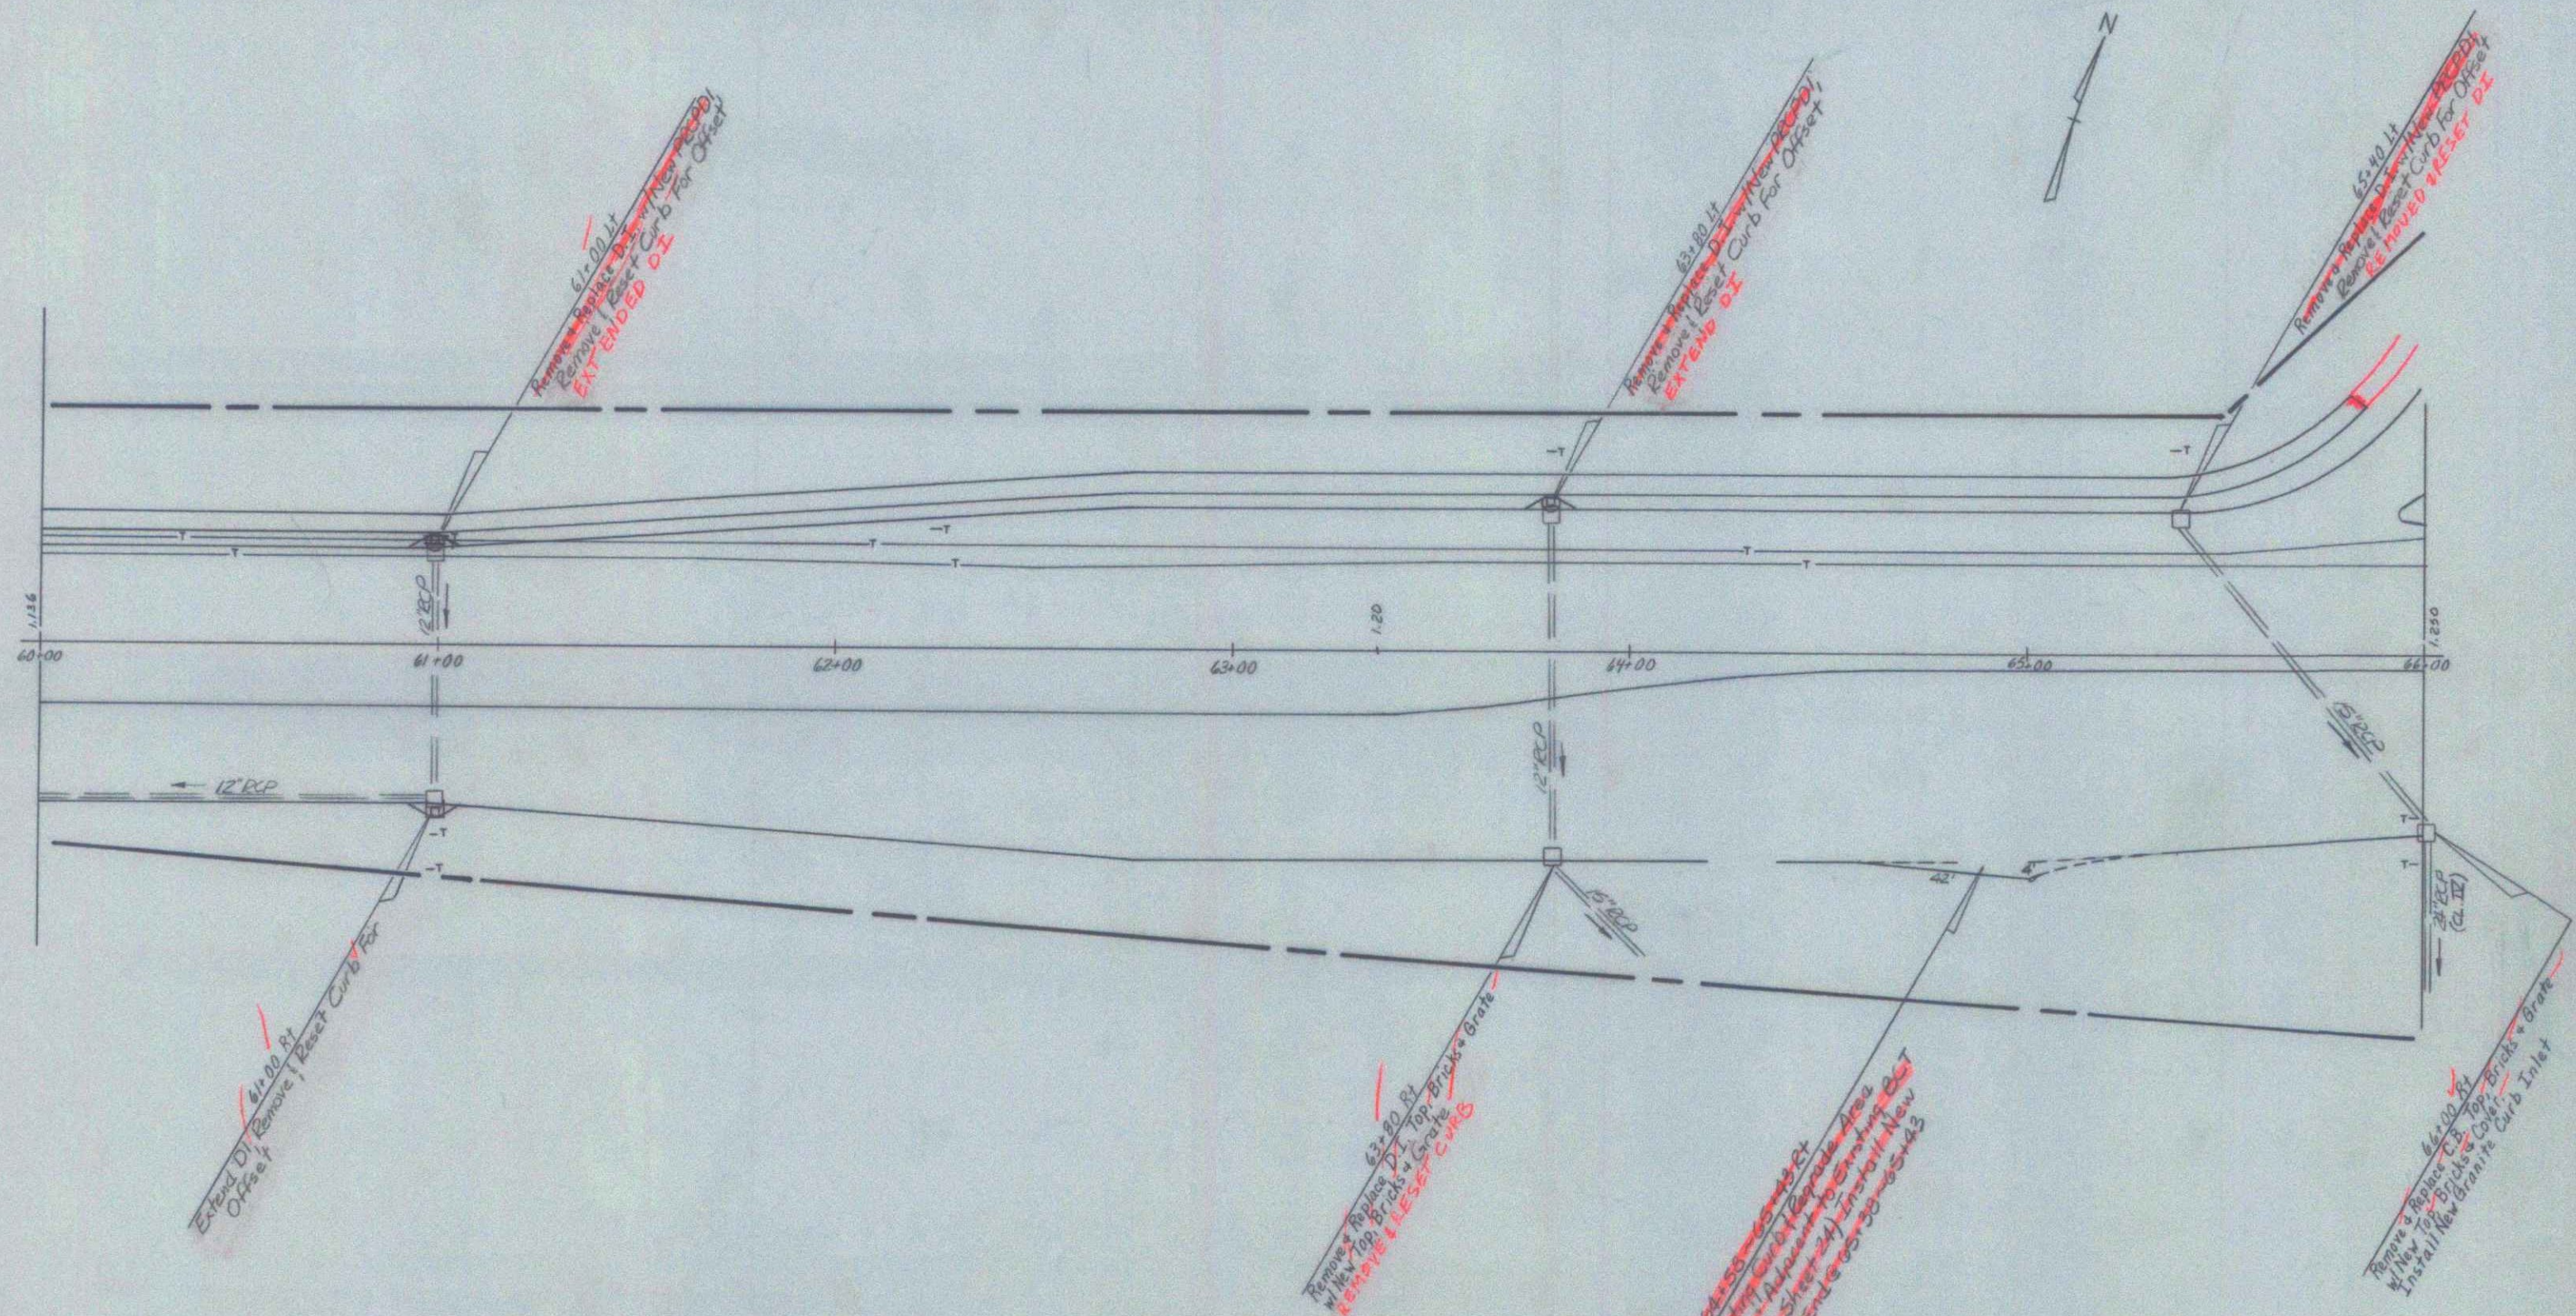

DATUM
 VERTICAL _____
 HORIZONTAL _____

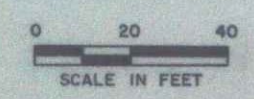

COLCHESTER MM 1136-1250
 ROUTE LOG 60+00-66+00

SURVEYED BY	DATE
DRAWN BY AS BUILT	DATE 1958
TRACED BY JANAWICZ	DATE 2/88

COLCHESTER - ESSEX
 PROJ. F NO. 030-1(13)
 SHEET 29 OF 144