





BRANDON 1443(22)

STRUCTURE SHEET # 1

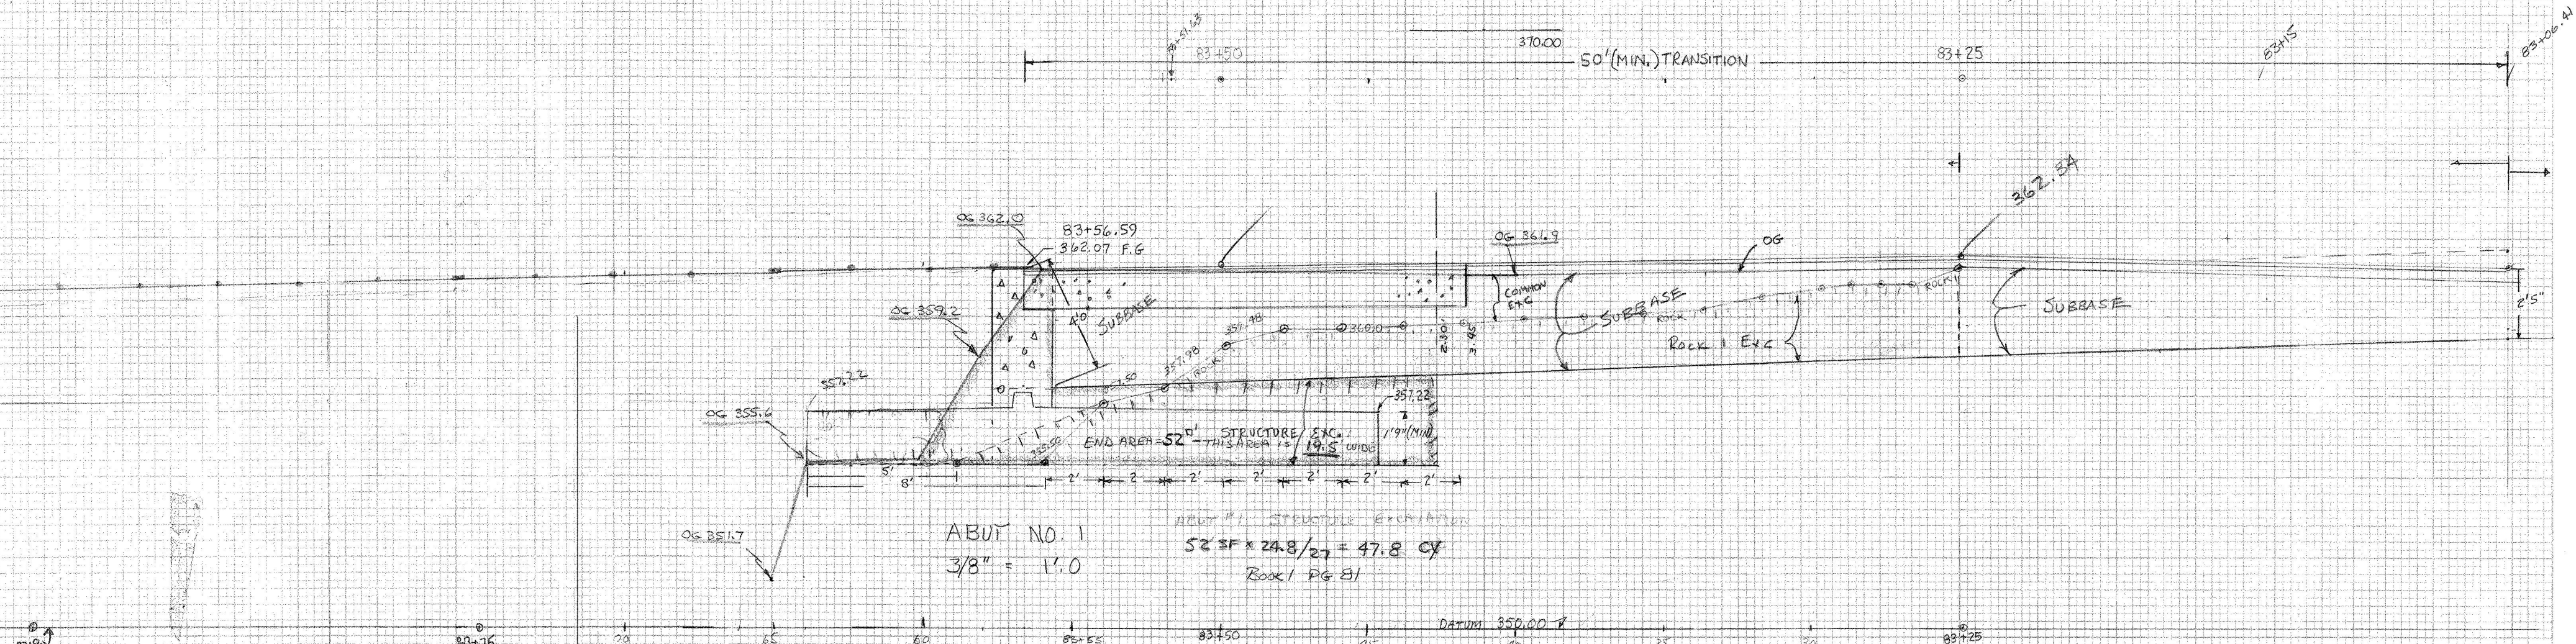

ABUT. NO. 1
3/8" = 1.0'
END AREA = 52' - THIS AREA IS 19.8' WIDE
52 SF x 24.8/27 = 47.8 CY
BOOK 1 PG 81

ABUTMENT #1 W/APPR & SUBBASE DETAIL

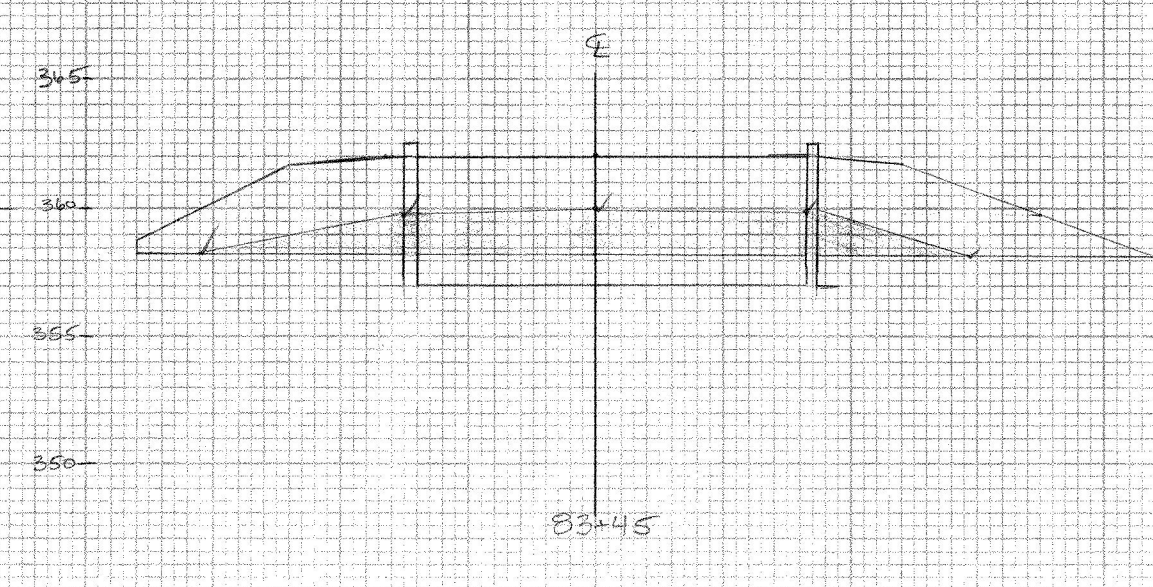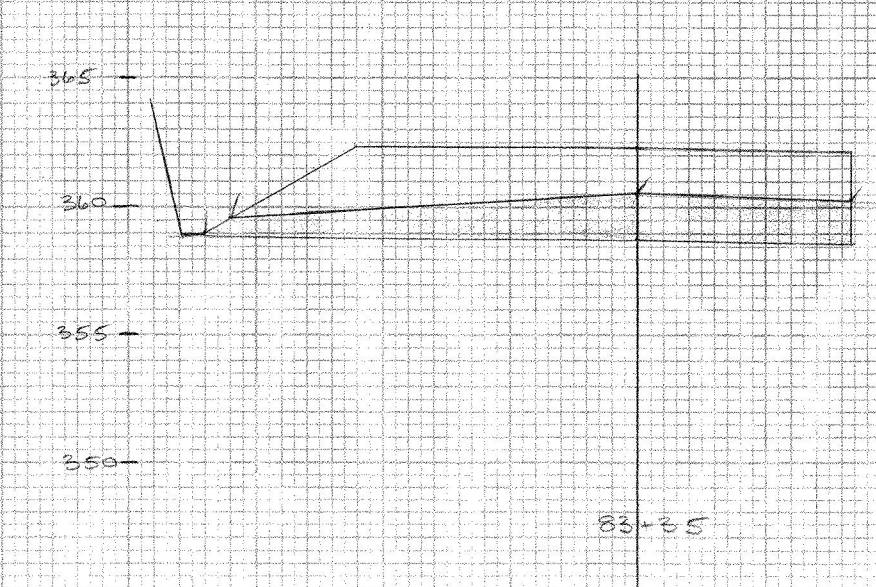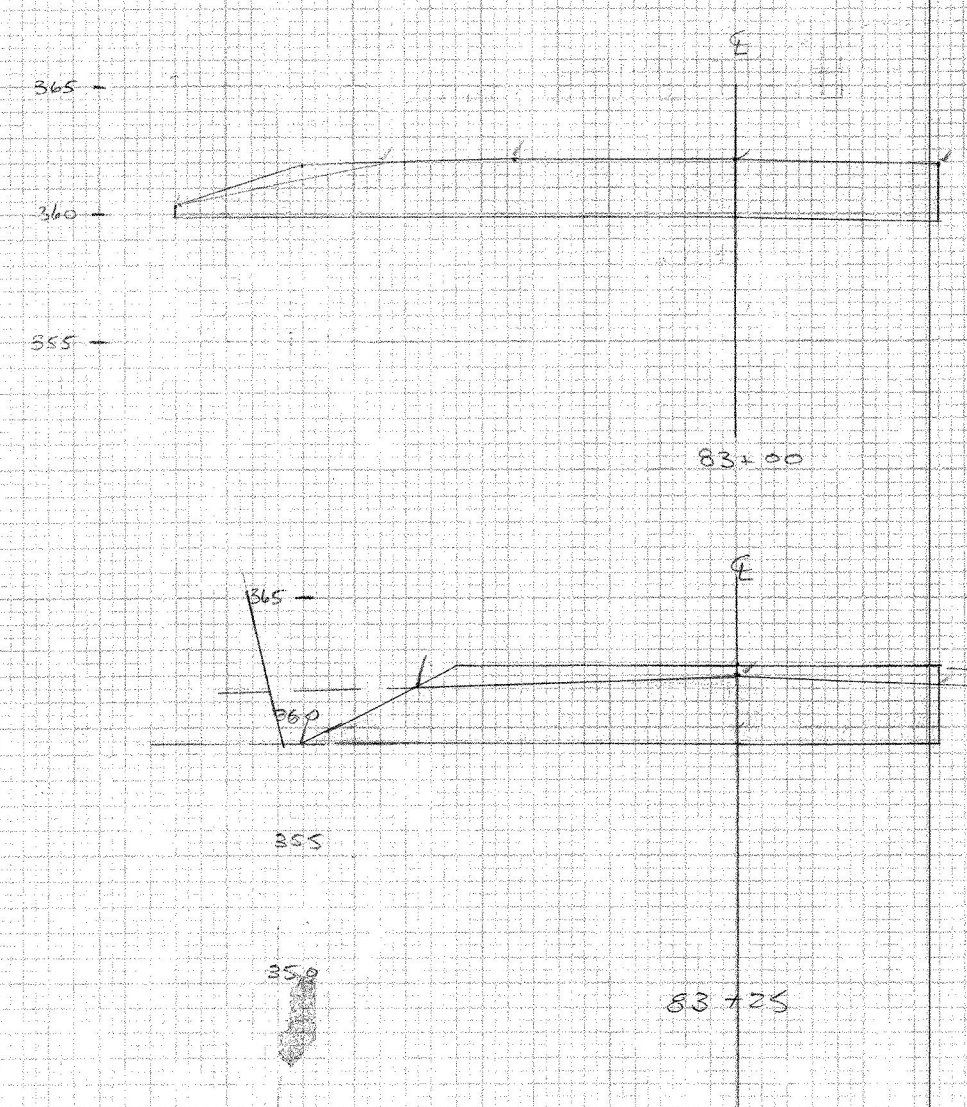

C.P.I.