


STATE OF VERMONT
AGENCY OF TRANSPORTATION



PROPOSED IMPROVEMENT
TOWN OF HANCOCK
COUNTY OF ADDISON
VERMONT ROUTE 100

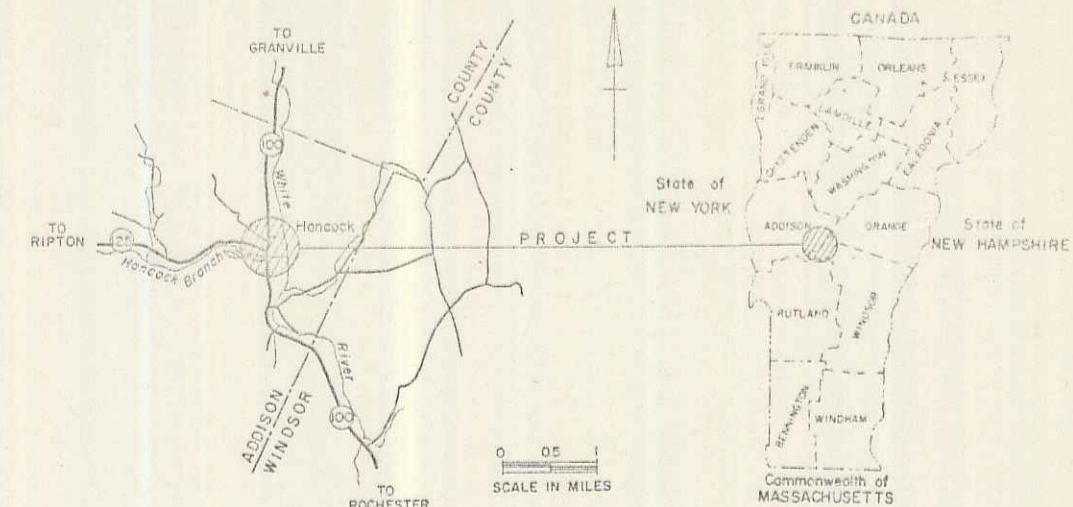

TRAFFIC DATA
1979 AADT = 2030
1989 AADT = 2450
1989 DHV = 370
D = 5.4%
T = 9.5%
V = 40 MPH


BHF 013-4(5)S
BEGINNING AT A POINT 0.049 MILES SOUTH
OF THE INTERSECTION OF VT. RTE. 125 AND VT.
RTE. 100 AND EXTENDING NORTHERLY 0.085 MILES.
LENGTH OF ROADWAY 450 FT. = 0.085 MI.
LENGTH OF BRIDGE 34.39 FT. = 0.065 MI.
LENGTH OF PROJ. 450 FT. = 0.085 MI.
LENGTH OF R.O.W. 550 FT. = 0.104 MI.

HES 013-4(2)S
BEGINNING AT A POINT 0.036 MILES NORTH OF
THE INTERSECTION OF VT. RTE. 125 AND VT. RTE.
100 AND EXTENDING NORTHERLY 0.085 MILES.
LENGTH OF PROJ. 450 FT. = 0.085 MI.
LENGTH OF R.O.W. 575 FT. = 0.109 MI.

TRAFFIC DATA
1979 AADT = 1380
1989 AADT = 1660
1989 DHV = 250
D = 5.7%
T = 9.5%
V = 40 MPH
5 Year Accidents = 4

R.O.W. PLANS

CONVENTIONAL SIGNS
COUNTY LINE
TOWN LINE
LIMITS OF ACCESS
POINT OF ACCESS
FENCE LINE
STONE WALL
TRAVELED WAY
GUARD RAIL
RAILROAD
SURVEY LINE
CULVERT
POWER POLE
TELEPHONE POLE
TREES
CONTROL OF ACCESS
PROPERTY LINE
ROW TAKING LINE
SLOPE RIGHTS
TOP OF CUT
TOE OF SLOPE

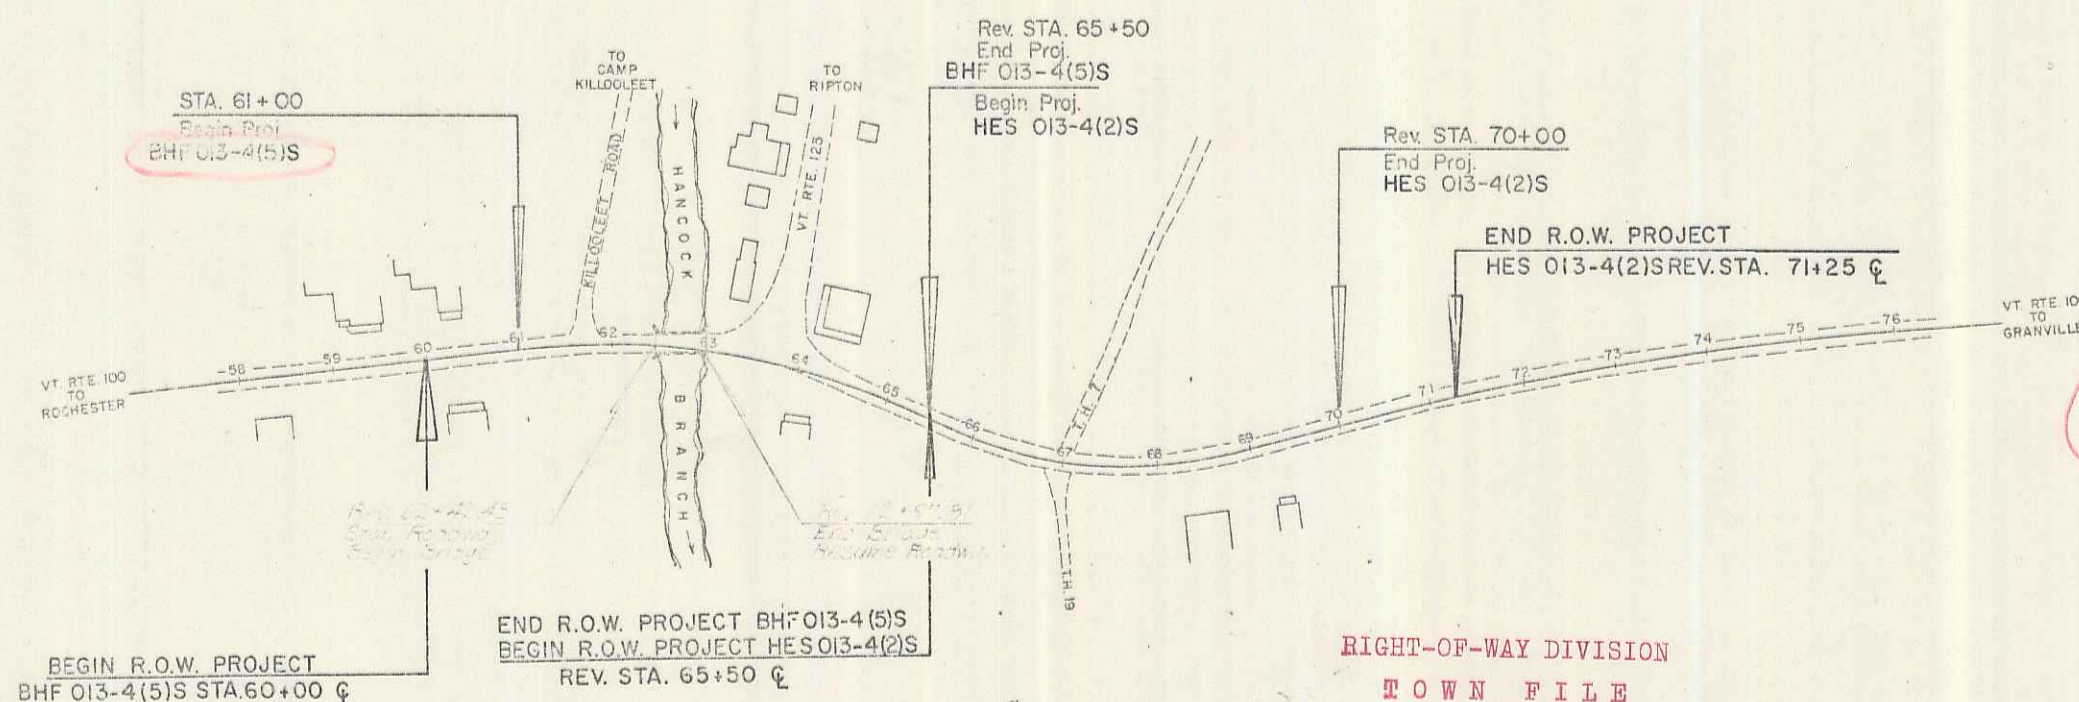

RIGHT-OF-WAY DIVISION
TOWN FILE
PERPETUAL
Town of Vt 100
(To Be Returned To R.O.W. Division)

MP 1.15 to 1.32

DATE: 12/15/78
PROJECT BHF 013-4(5)S
PIN: 90A001

DEC 21 1981

PROJECT PROCESSED UNDER
SECONDARY ROAD PLAN

SUBMITTED BY ORDER OF THE STATE TRANSPORTATION BOARD	
APPROVED: <i>[Signature]</i>	DATE: 12-15-78
DIRECTOR OF ENGINEERING AND CONSTRUCTION	
DEPARTMENT OF TRANSPORTATION	
FEDERAL HIGHWAY ADMINISTRATION	
APPROVED: _____	DATE: _____
DIVISION ADMINISTRATOR	
PROJECT: HES 013-4(2)S	
BHF 013-4(5)S	
SHEET: 1	OF 6 SHEETS
D-10	SRS 12/17/73

STATE OF VERMONT DEPARTMENT OF HIGHWAYS RIGHT-OF-WAY PLANS DETAIL SHEET

TABLE OF PROJECT PROPERTY ACQUISITION

PARCEL NO.	GRANTOR	SHEET NO.	BEGINNING STATION	ENDING STATION	TAKING	REM.	RIGHTS	TITLE TAKEN	DATE	TOWN OR CITY RECORDED	BK.	PG.	REMARKS
1	TAYLOR, RAMA B. TAYLOR, GEORGE A.	5	REV. 61 + 50 RT. REV. 61 + 25 RT.	REV. 62 + 80 RT. REV. 62 + 80 RT.	0.09 A.		CONST. EASE.(T) (0.03 A.)	WDOE	6-13-79	HANCOCK	17	215/6	(3750 S.F.) (1400 S.F.)
2A	TOWN OF HANCOCK	5, 6	REV. 61 + 40 LT. REV. 61 + 60 LT.	REV. 61 + 95 LT.			CULVERT (P) APPROACH (T)	OPTION WDOE	6-17-79 7-23-79	HANCOCK HANCOCK	17 17	216/7 234	T.H. NO. 20 T.H. NO. 7
B			REV. 67 + 00 LT.				APPROACH (T)						
3	WHITTIER, EVAN C. & MARGARET W.	5	REV. 61 + 95 LT. REV. 61 + 95 LT. REV. 62 + 00 LT.	REV. 62 + 00 LT. REV. 62 + 80 LT. REV. 62 + 60 LT.			CULVERT (P) CONST. EASE. (T) (0.02 A.) DRAINAGE (P)	WDOE	5-31-79	HANCOCK	17	205	(850 S.F.)
4	HODSKINS, PHILIP W. & FRANKFUL I.	5	REV. 62 + 78 RT. REV. 62 + 80 RT. REV. 63 + 50 RT. REV. 63 + 87 RT. REV. 67 + 00 RT.	REV. 64 + 95 RT. REV. 63 + 80 RT. REV. 64 + 60 RT. REV. 67 + 35 LT.	0.05 A.		CONST. EASE.(T) (0.02 A.) SLOPE (T) (150 S.F.) DRIVE (T) ALL R.T. & L.	WDOE	6-26-79	HANCOCK	17	207	(2150 S.F.) (900 S.F.) UNUSED LEAD WATERPIPE - CAST IRON WATER PIPE SLEEVE, (PLASTIC THROUGH SLEEVE) FORMERLY - OSBORNE & GLISERMAN
5	DELETED												
6	CENTRAL VERMONT PUBLIC SERVICE CORP.												UTILITY
7	NEW ENGLAND TELEPHONE & TELEGRAPH CO.												UTILITY

TABLE OF REVISIONS

REVISION NO.	SHEET NO.	DESCRIPTION OF REVISION	DATE	MADE BY	APPROVED BY
1	5	PARCEL #2, T.H. OF HANCOCK & PARCEL #3, WHITTIER, RELOCATED CULVERT ON T.H. #20 & INCREASED LENGTH. PER REVISED DESIGN P.C.D. # 4135	1-5-79	P.J.H.	T.P.M.
2	3, 5	DELETED PARCEL #5 PER C.D. #4322	4-20-79	S.J.B.	T.P.M.

DEC 21 1981

MADE BY: P.J.H. DATE 12/8/78
CHECKED BY: W.E.B. DATE 12/8/79

DR. RT. - DRAINAGE RIGHT
DIT. RT. - DITCHING RIGHT
CH. RT. - CHANNEL RIGHT
DRIVE RT. - DRIVE RIGHT
CUL. RT. - CULVERT RIGHT
D - DEMOLITION OR REMOVAL
W - WATER SOURCES

PRESENT R.O.W.
TAKING WITHOUT ACCESS
TAKING WITHOUT ACCESS ALONG PROPERTY LINES
TAKING WITH ACCESS
PERMANENT EASEMENT
TEMPORARY EASEMENT

LEGEND
CONST. EASE. - CONST. EASEMENT
SR - SLOPE RIGHTS
P - PROPERTY LINE
TOP OF CUT
TOE OF SLOPE

APPROVED: *Thomas R. Moore* DATE 12-15-79
CHIEF OF PLANS IN TITLE

PROJECT HANCOCK
NO. BHE 013-4(5)S
SHEET 3 OF 6

