

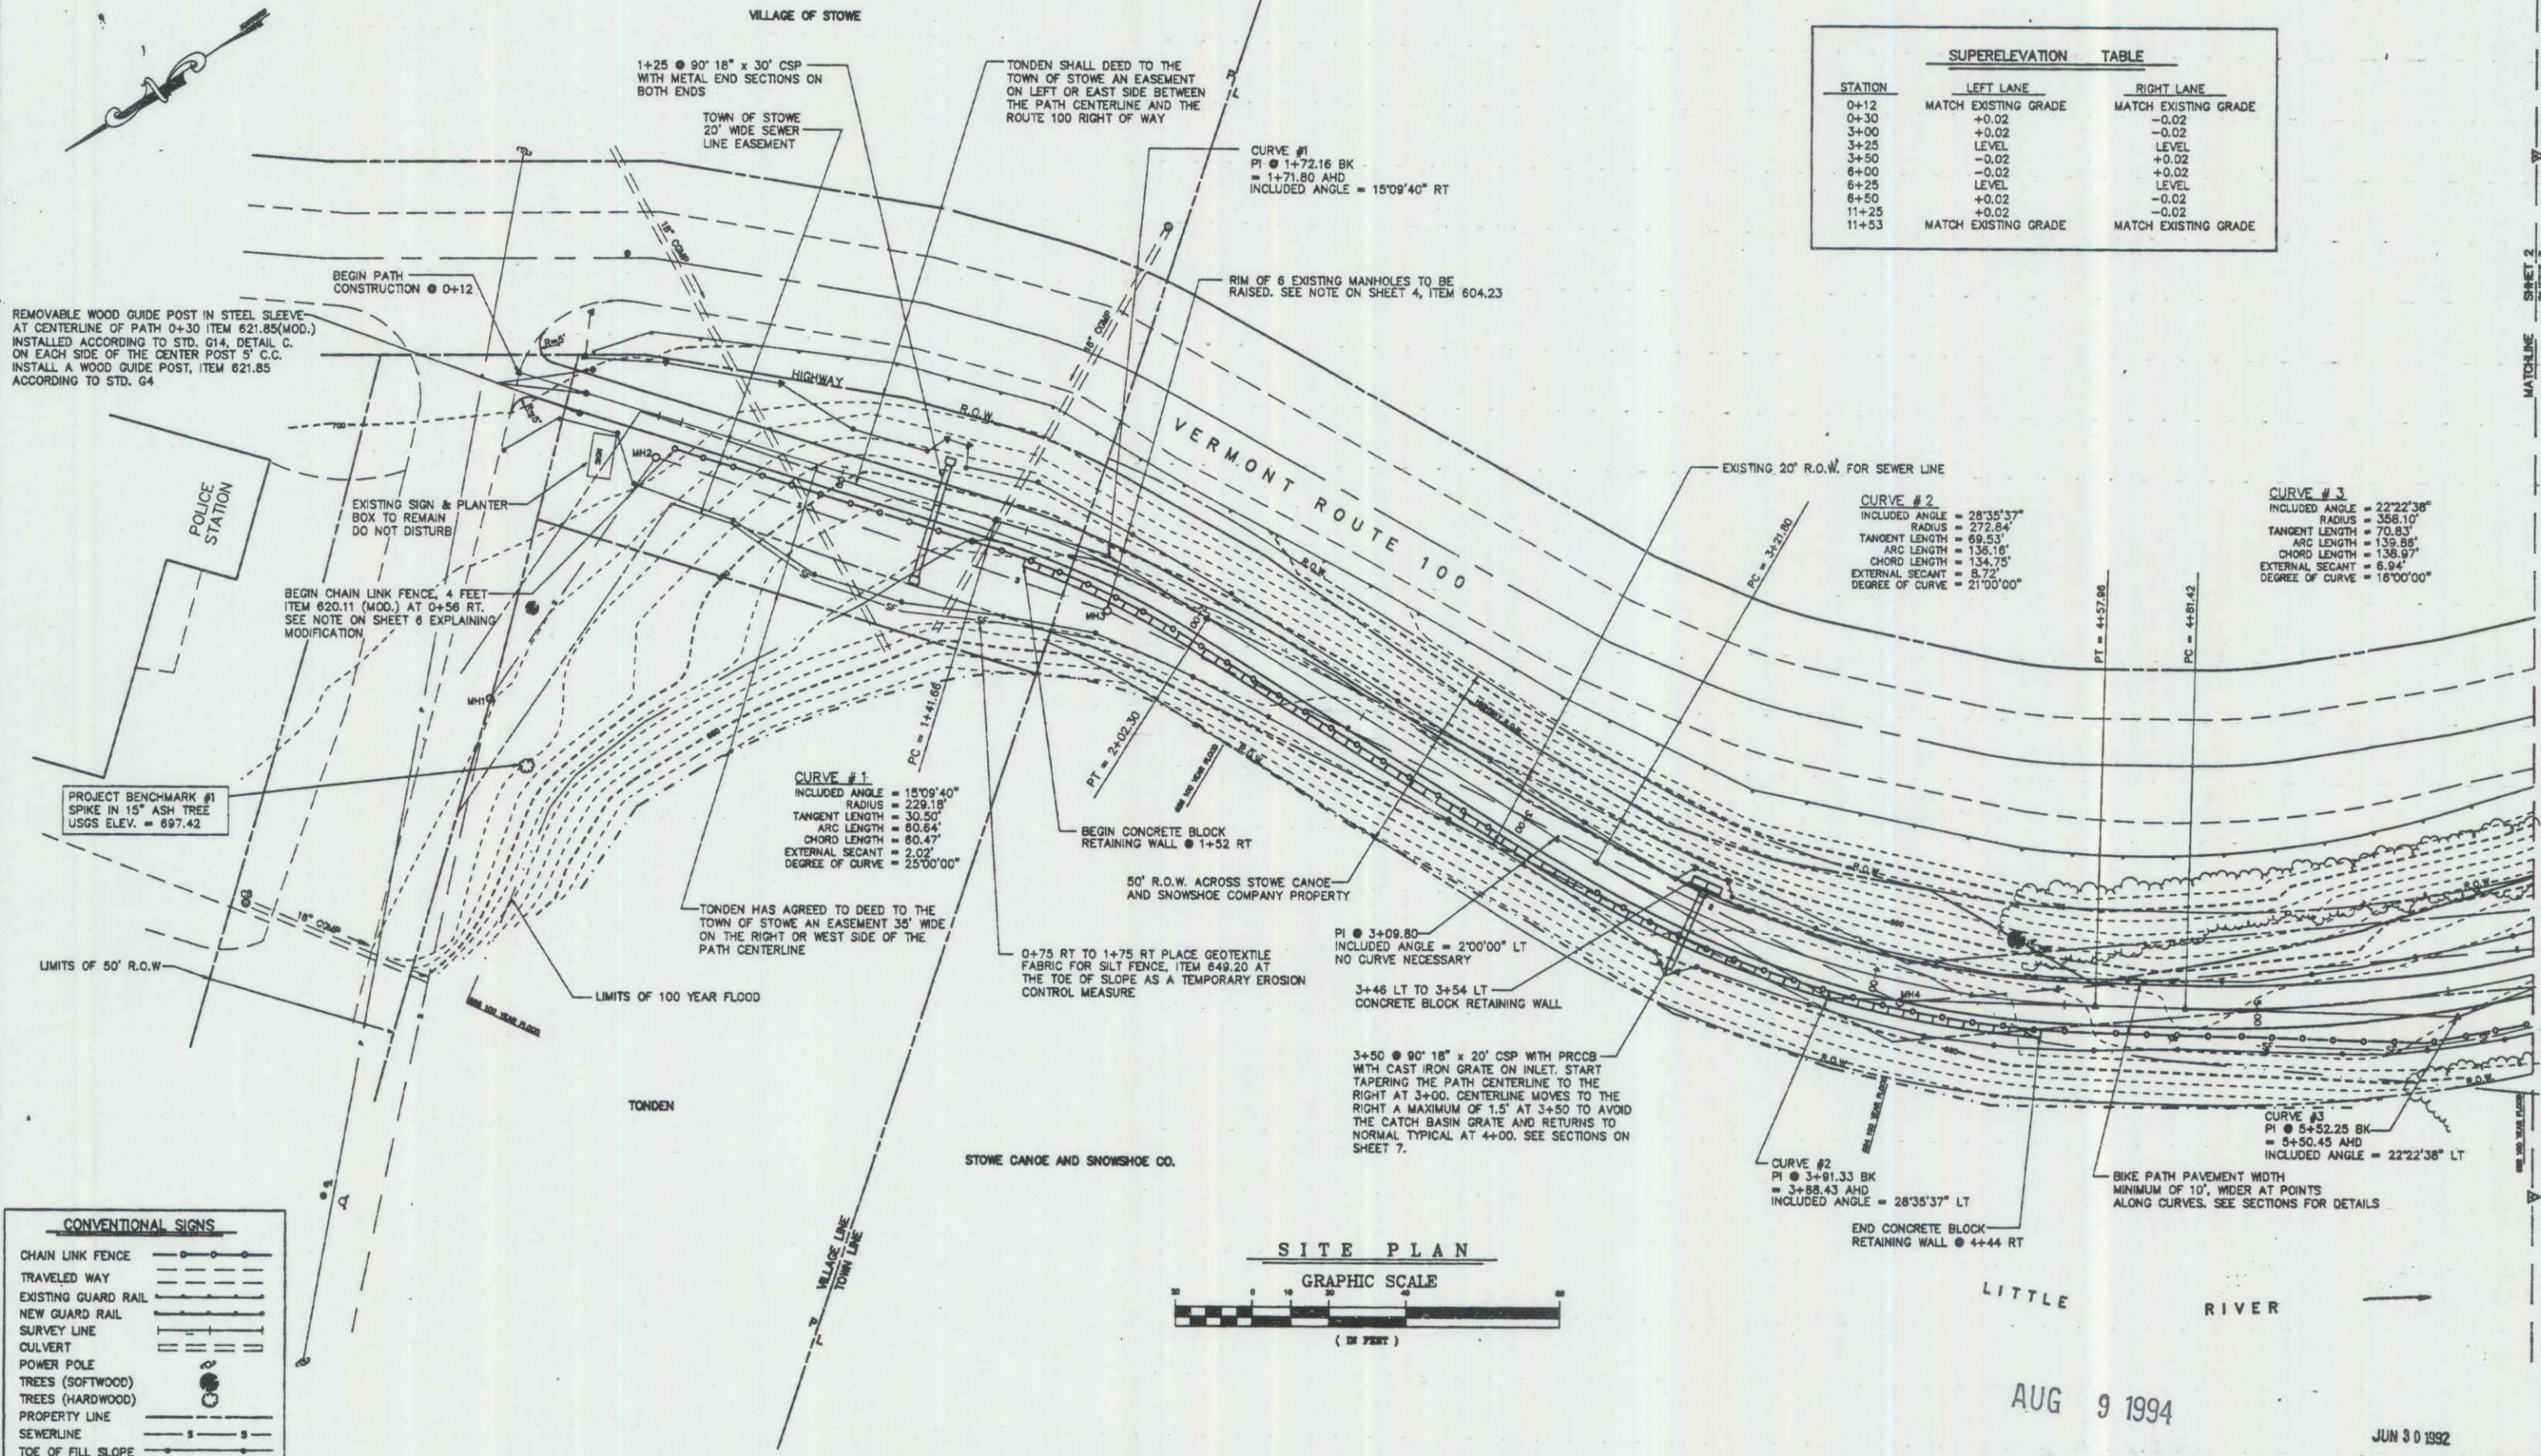


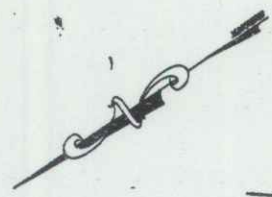

SUPERELEVATION TABLE		
STATION	LEFT LANE	RIGHT LANE
0+12	MATCH EXISTING GRADE	MATCH EXISTING GRADE
0+30	+0.02	-0.02
3+00	+0.02	-0.02
3+25	LEVEL	LEVEL
3+50	-0.02	+0.02
6+00	-0.02	+0.02
6+25	LEVEL	LEVEL
6+50	+0.02	-0.02
11+25	+0.02	-0.02
11+53	MATCH EXISTING GRADE	MATCH EXISTING GRADE

CONVENTIONAL SIGNS	
CHAIN LINK FENCE	---
TRAVELED WAY	---
EXISTING GUARD RAIL	---
NEW GUARD RAIL	---
SURVEY LINE	---
CULVERT	---
POWER POLE	---
TREES (SOFTWOOD)	---
TREES (HARDWOOD)	---
PROPERTY LINE	---
SEWERLINE	---
TOE OF FILL SLOPE	---
TOP OF CUT SLOPE	---
RIGHT OF WAY	---
SILT FENCE	---

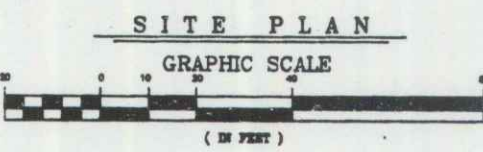

Charles Grenier
CONSULTING ENGINEER, P.C.
BOX 445, WATERBURY, VERMONT
244-6413

TOWN OF STOWE - RIVER WALK
"SITE PLAN 0+00 TO 5+80"

CHARLES GRENIER
CONSULTING ENGINEER, P.C.
BOX 445, WATERBURY, VERMONT
244-6413

DATE 10-25-91
DRN BY T.J.M.
SCALE 1"=20'
SHT 3 OF 32

AUG 9 1994

JUN 30 1992

BW-RS-BKE (29)

5/8/92 - REVISED STOWE CANOE R.O.W.