

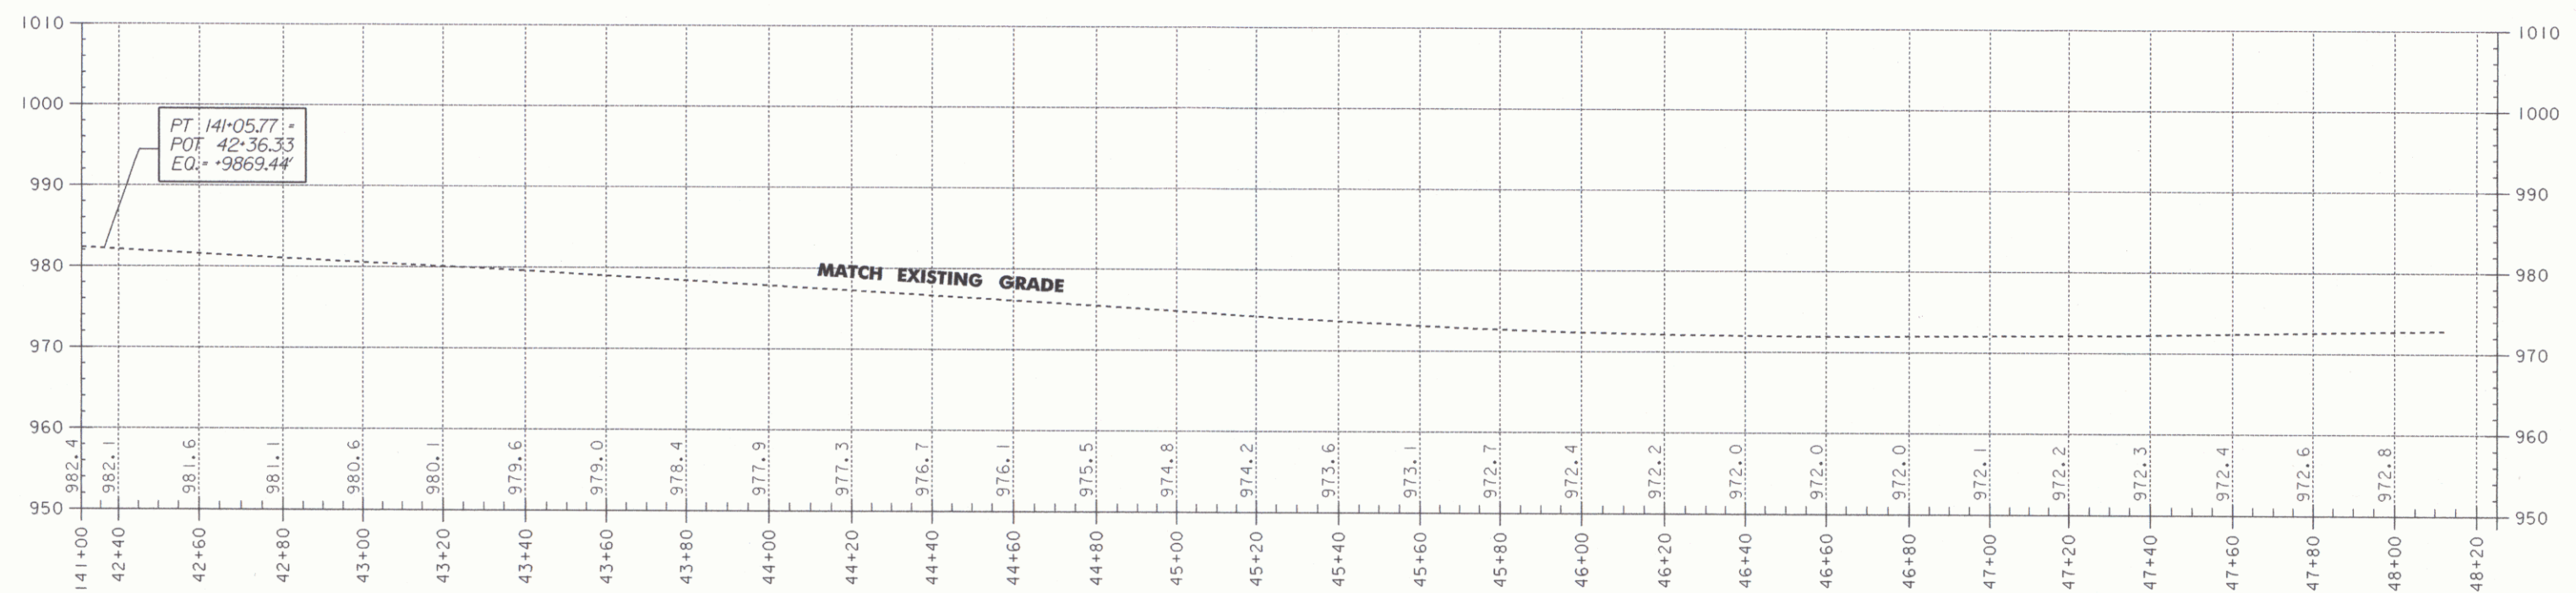


Profile

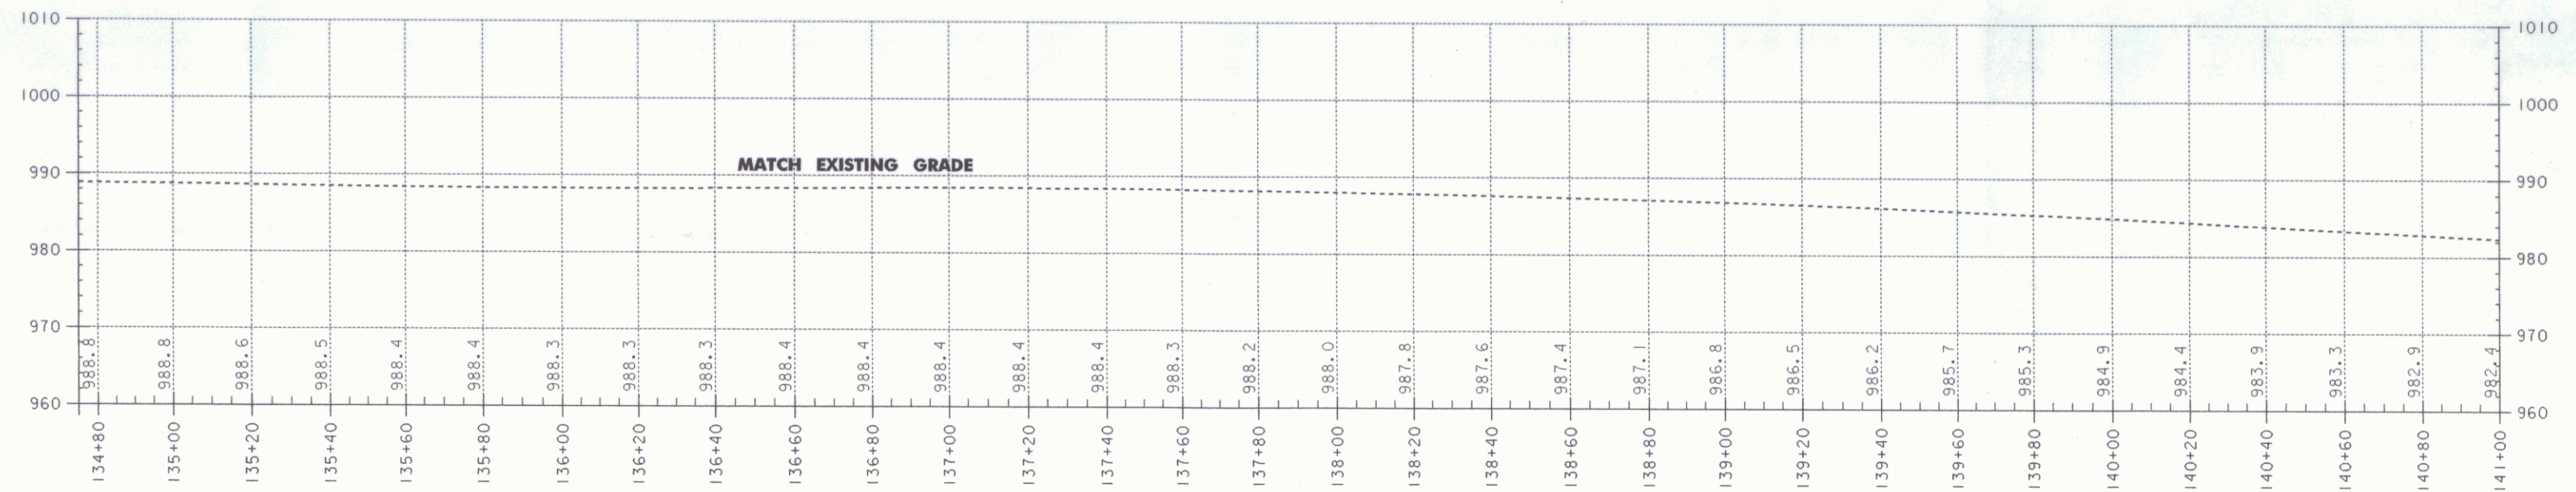

DATUM
VERTICAL NAVD83
HORIZONTAL NAD83 (92)

SCALES IN FEET

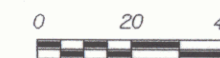

FEB 21 2001

PROJECT:	LUDLOW	PROJECT NO.:	NH 025-11381S
DESIGN FILE NAME:	/S0DB/91B076/DB076WRK.DGN	PLOT DATE:	24-MAR-1999
IPARM FILE NAME:	DB076PI	SURVEY DATE:	9/15/97
SURVEYED BY:	ORVIS	DRAWN BY:	SQUAD B
SQUAD LEADER:	DELLA SANTA		
	R. O. W. SHEET 3 OF 8 SHEETS		