



LANDSCAPE DETAILS

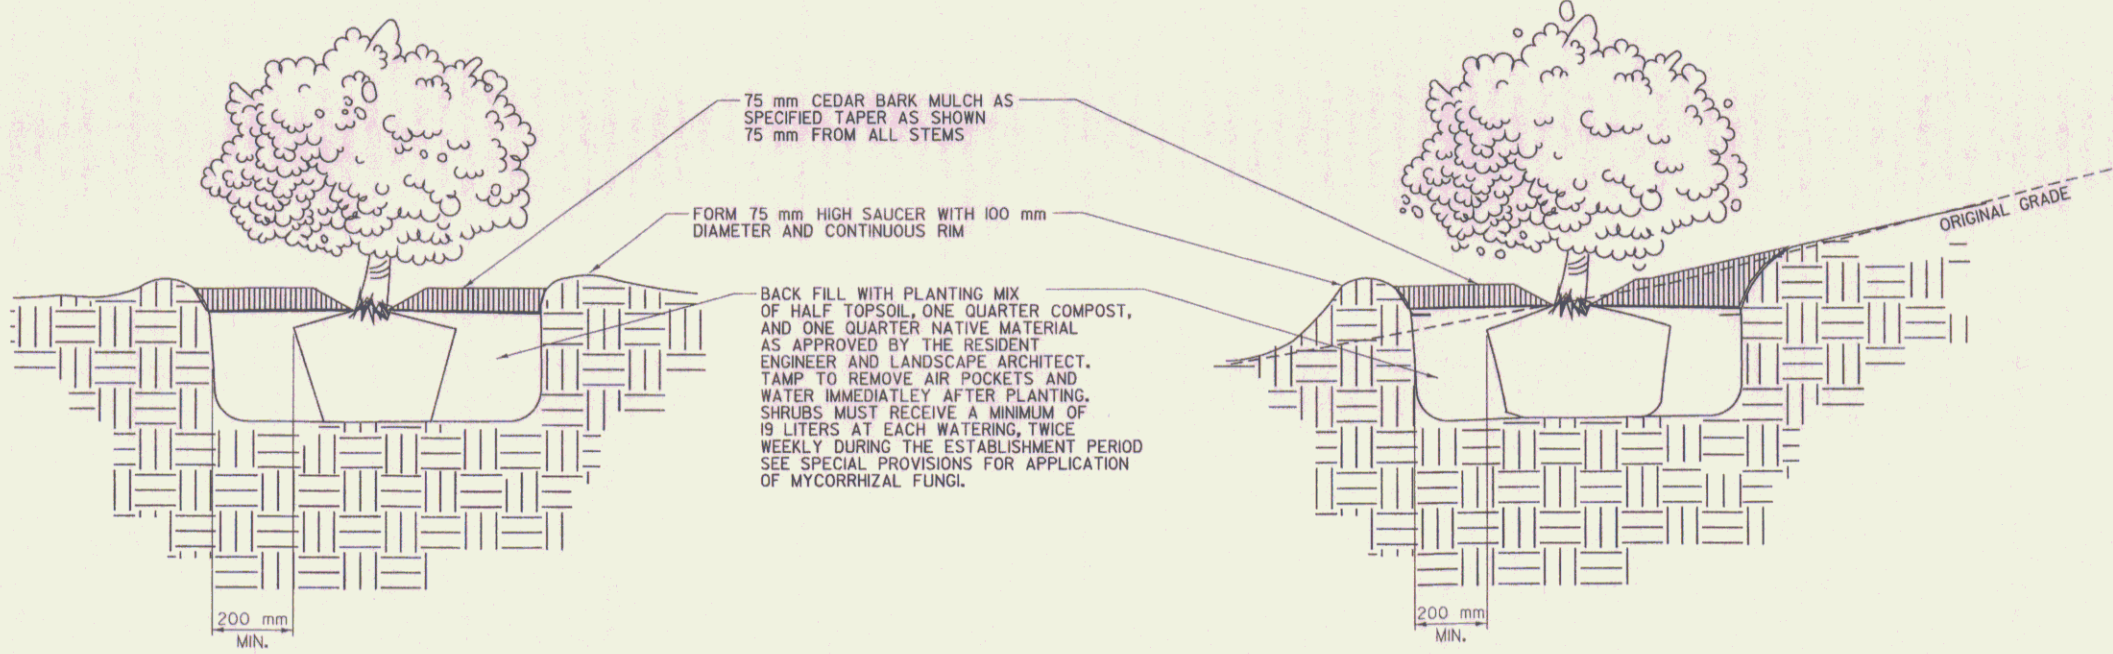

SHRUB PLANTING DETAIL
NOT TO SCALE

SHRUB PLANTING ON SLOPES DETAIL
NOT TO SCALE

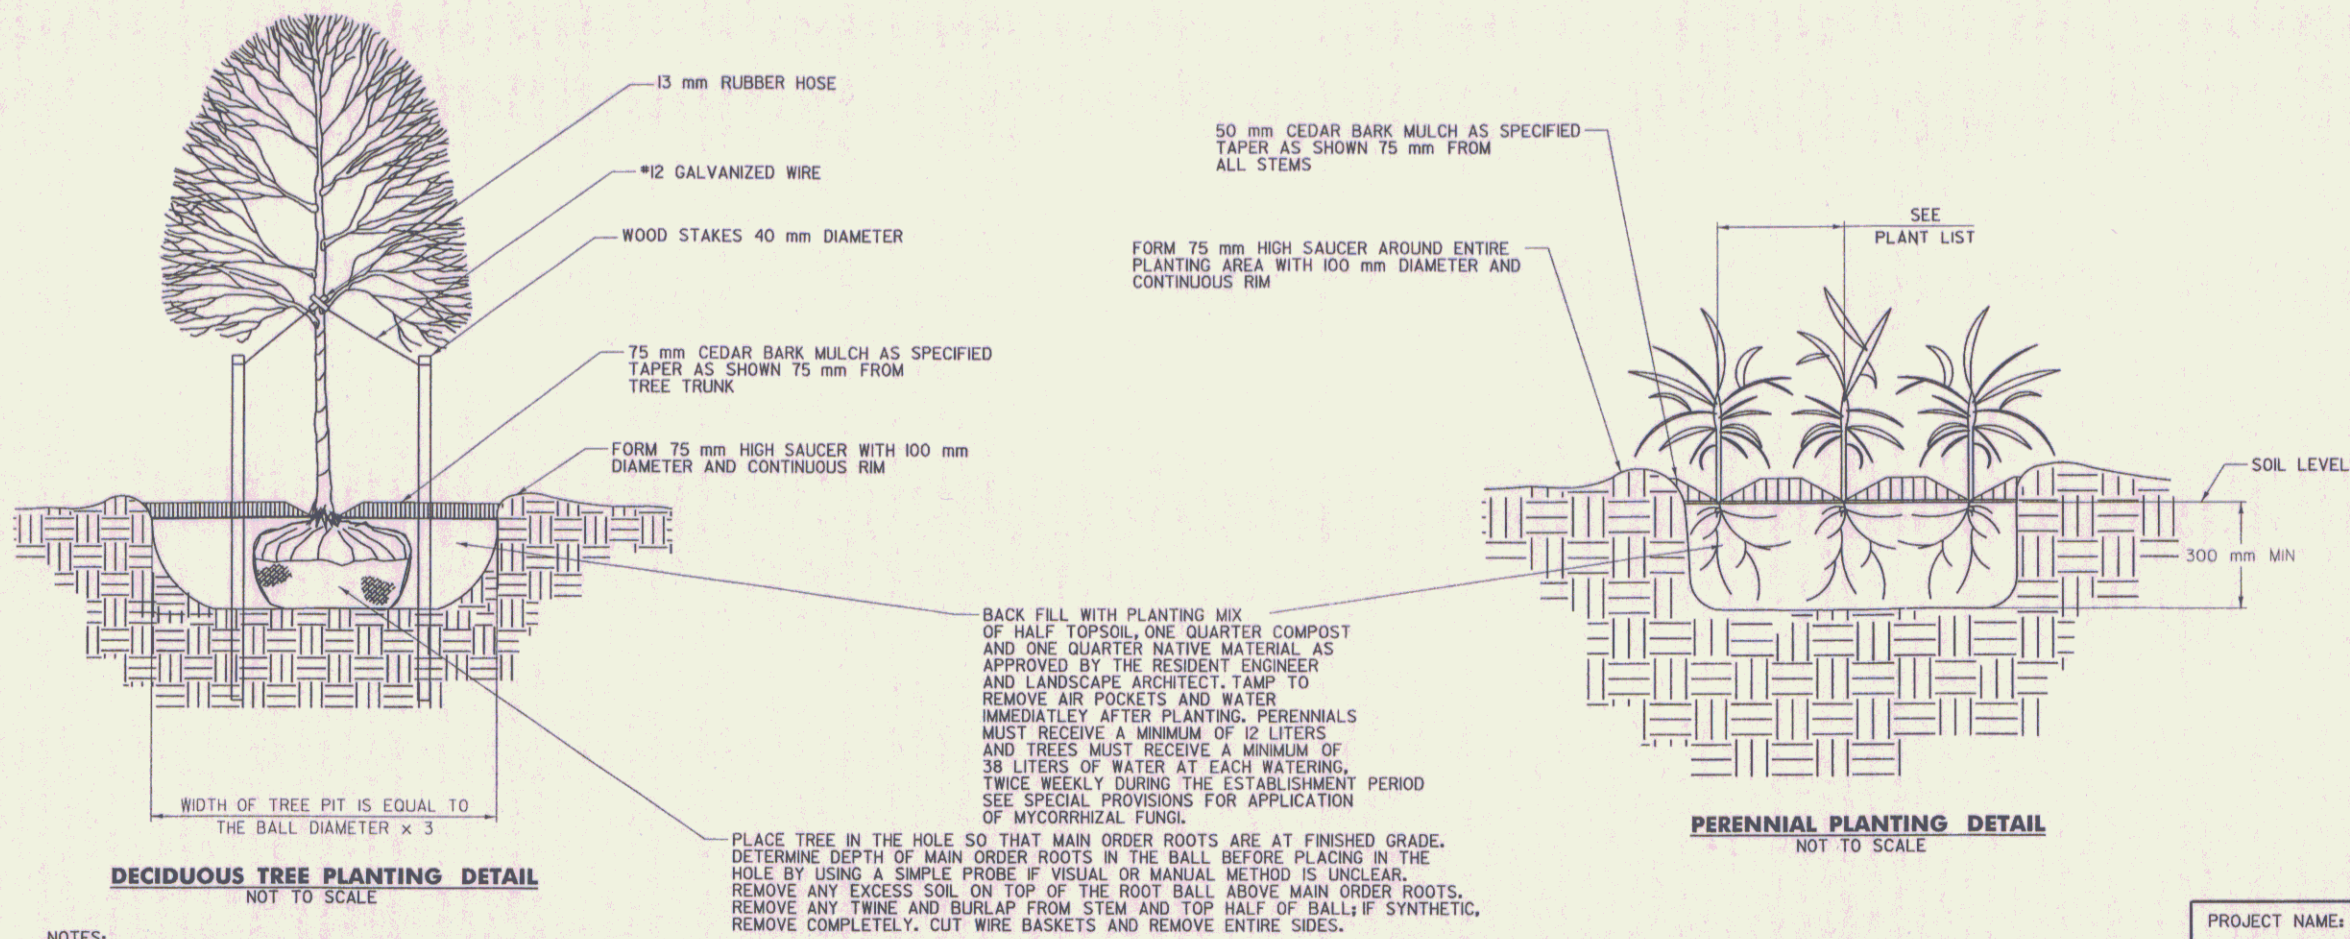

DECIDUOUS TREE PLANTING DETAIL
NOT TO SCALE

PERENNIAL PLANTING DETAIL
NOT TO SCALE

- NOTES:
1. STAKE ONLY THOSE TREES PLANTED IN WINDY, EXPOSED LOCATIONS WHERE THEY MIGHT BE BLOWN OVER OR VANDALIZED AS DETERMINED BY RESIDENT ENGINEER OR LANDSCAPE ARCHITECT.
 2. COMPLETELY REMOVE ALL GUY WIRES, RUBBER HOSE, AND STAKES ONE YEAR AFTER PLANTING.

- PLANT SOURCES ARE LISTED BELOW:
- HORSEFORD GARDENS & NURSERY
211 GREENBUSH RD.
CHARLOTTE, VT 05445
802-425-2811
LORITAXTER
- HIGH REACH FARM
2847 TAMPICO RD.
DANVILLE, VT 05828
802-748-3512
STEVE PARKER & SUSANNE TERRY
- COBBLE CREEK NURSERY
WHOLESALE GROWERS
RD #2, BOX 3850
BRISTOL, VT 05433
802-453-3889
JOHN PADUA
- ELMORE ROOTS NURSERY
PO BOX 171
ELMORE, VT 05657
1-800-42PLANT OR 888-3305
WWW.ELMOREROOTS.COM
DAVID L. FRIED
- 4 SEASONS GARDEN CENTER
427 MARSHALL AVENUE
WILLISTON, VT 05495
802-862-6036
COMMERCIAL@4SEASONS.GC.COM

PROJECT NAME:	EAST MONTPELIER
PROJECT NUMBER:	STPG 028-3(35)S
FILE NAME:	98b028/traff/ab028LSC.dgn
PROJECT LEADER:	JLS
DESIGNED BY:	J Brown
PLOT DATE:	01-JUL-2008
DRAWN BY:	JFG
CHECKED BY:	
ROW SHEET	23 OF 37