


VERTICAL GRANITE CURB
 U.S. ROUTE 7 STA. 18+00 TO 19+40, LT.
 GEOTEXTILE FOR SILT FENCE
 U.S. ROUTE 7 STA. 17+60 TO 19+00, LT.

- NOTE
 1. ASSUMED 4-ROD RIGHT-OF-WAY
 2. SILT FENCE TO BE PLACED WITHIN RIGHT-OF-WAY
 3. SEE VT-TRANS STANDARD C-1 FOR CURB END TREATMENT DETAILS

~~(15) U.S. ROUTE 7 STA. 17+60 TO 18+00, LT.
 NEW 6" X 40" UNDERDRAIN CARRIER PIPE,
 INV. IN = 223.02, INV. OUT = 222.75~~
~~(16) U.S. ROUTE 7 STA. 18+00 TO 19+40, LT.
 NEW 6" X 40" UNDERDRAIN,
 INV. IN = 222.75, INV. OUT AT STA. 22+50 = 216.28~~

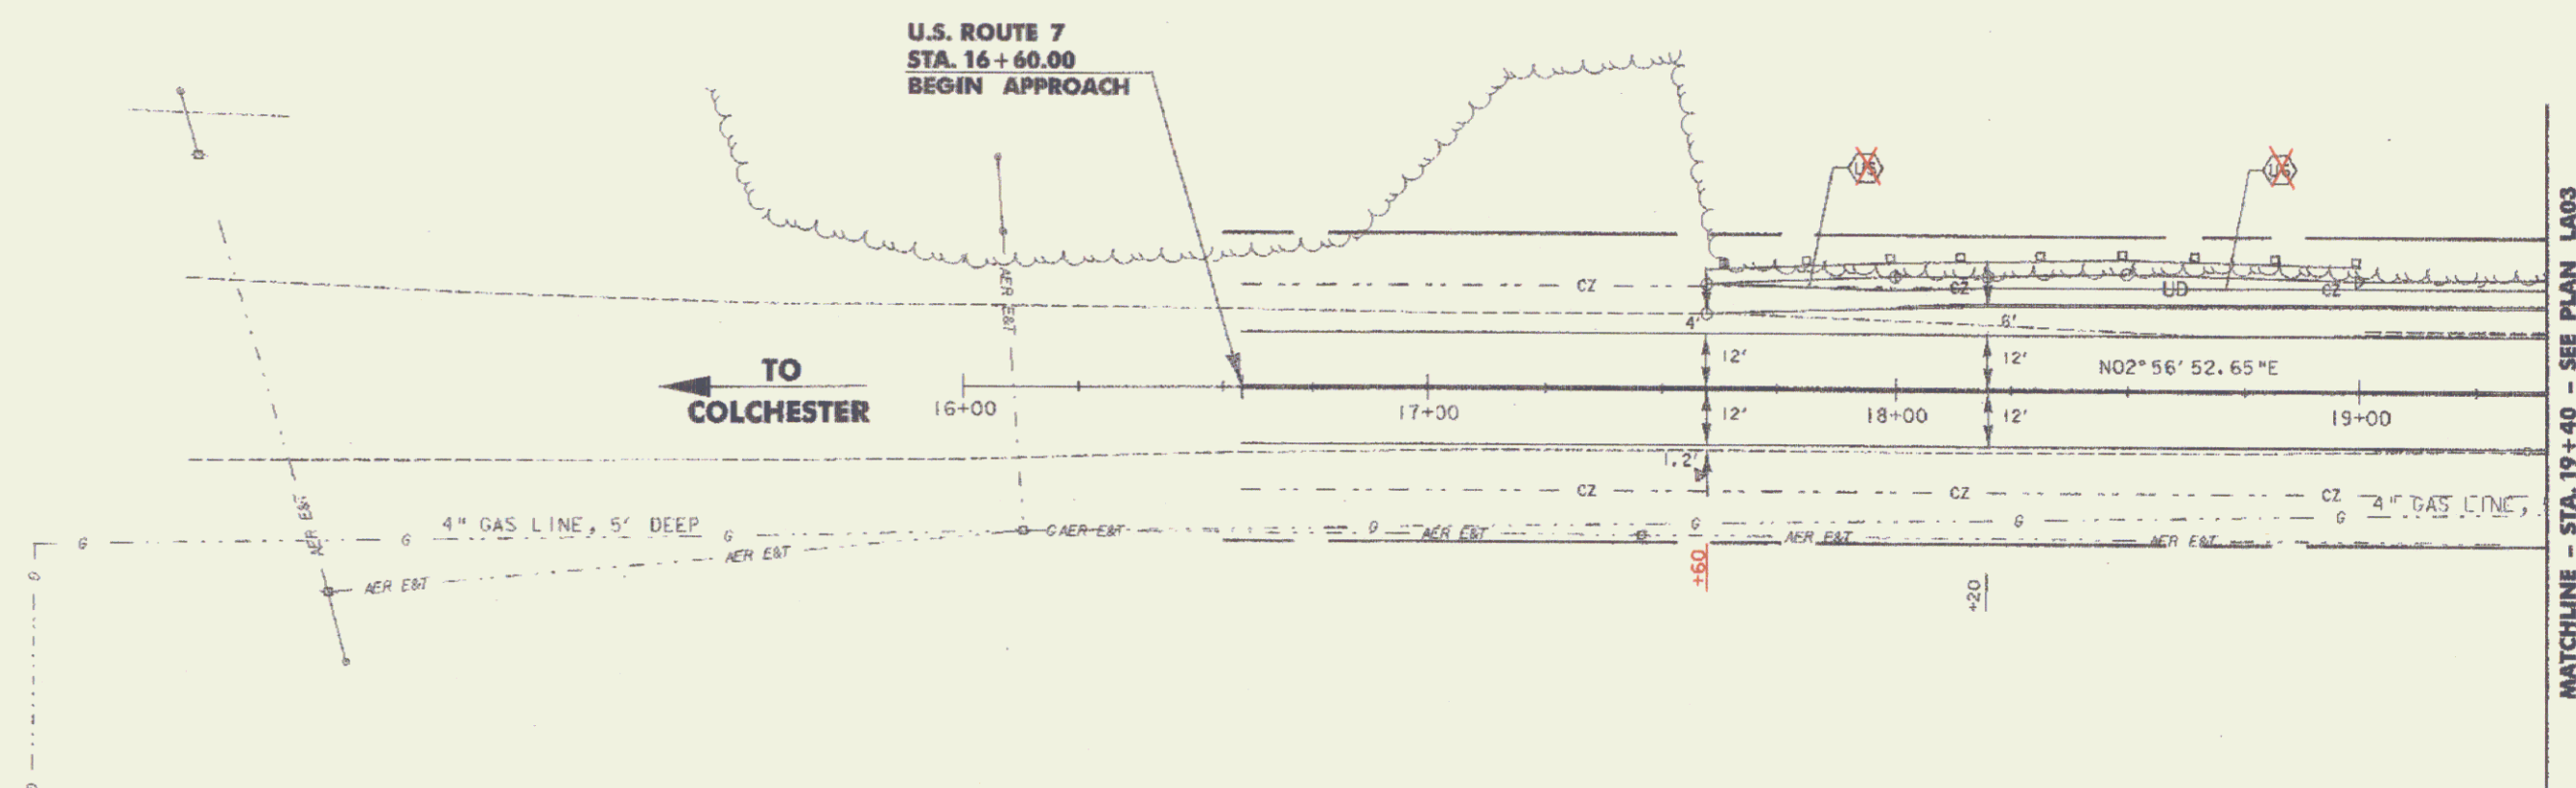

DH Dufresne-Henry	PROJECT NAME: COLCHESTER PARK-AND-RIDE	
	PROJECT NUMBER: CMG PARK(15)S	
	FILE NAME: LA02.PTF	PLOT DATE: 07/09/02
	PROJECT LEADER: WLD	DRAWN BY: CGG
	DESIGNED BY: CSP	CHECKED BY: GAE
	RTE. 7 LAYOUT & EROSION LA02	SHEET (12) OF 56