


Point	Kind of Instrument	Date of Instrument	Operator	Course	Recorded	Remarks
A	W.D.	11-11-33	Harold Young	St of V.L.	12-1-33	
Culvert #1	W.D.	6-15-34	H.R. Young	"	29 193 6-20-34	Culvert cullet Sta 7+63

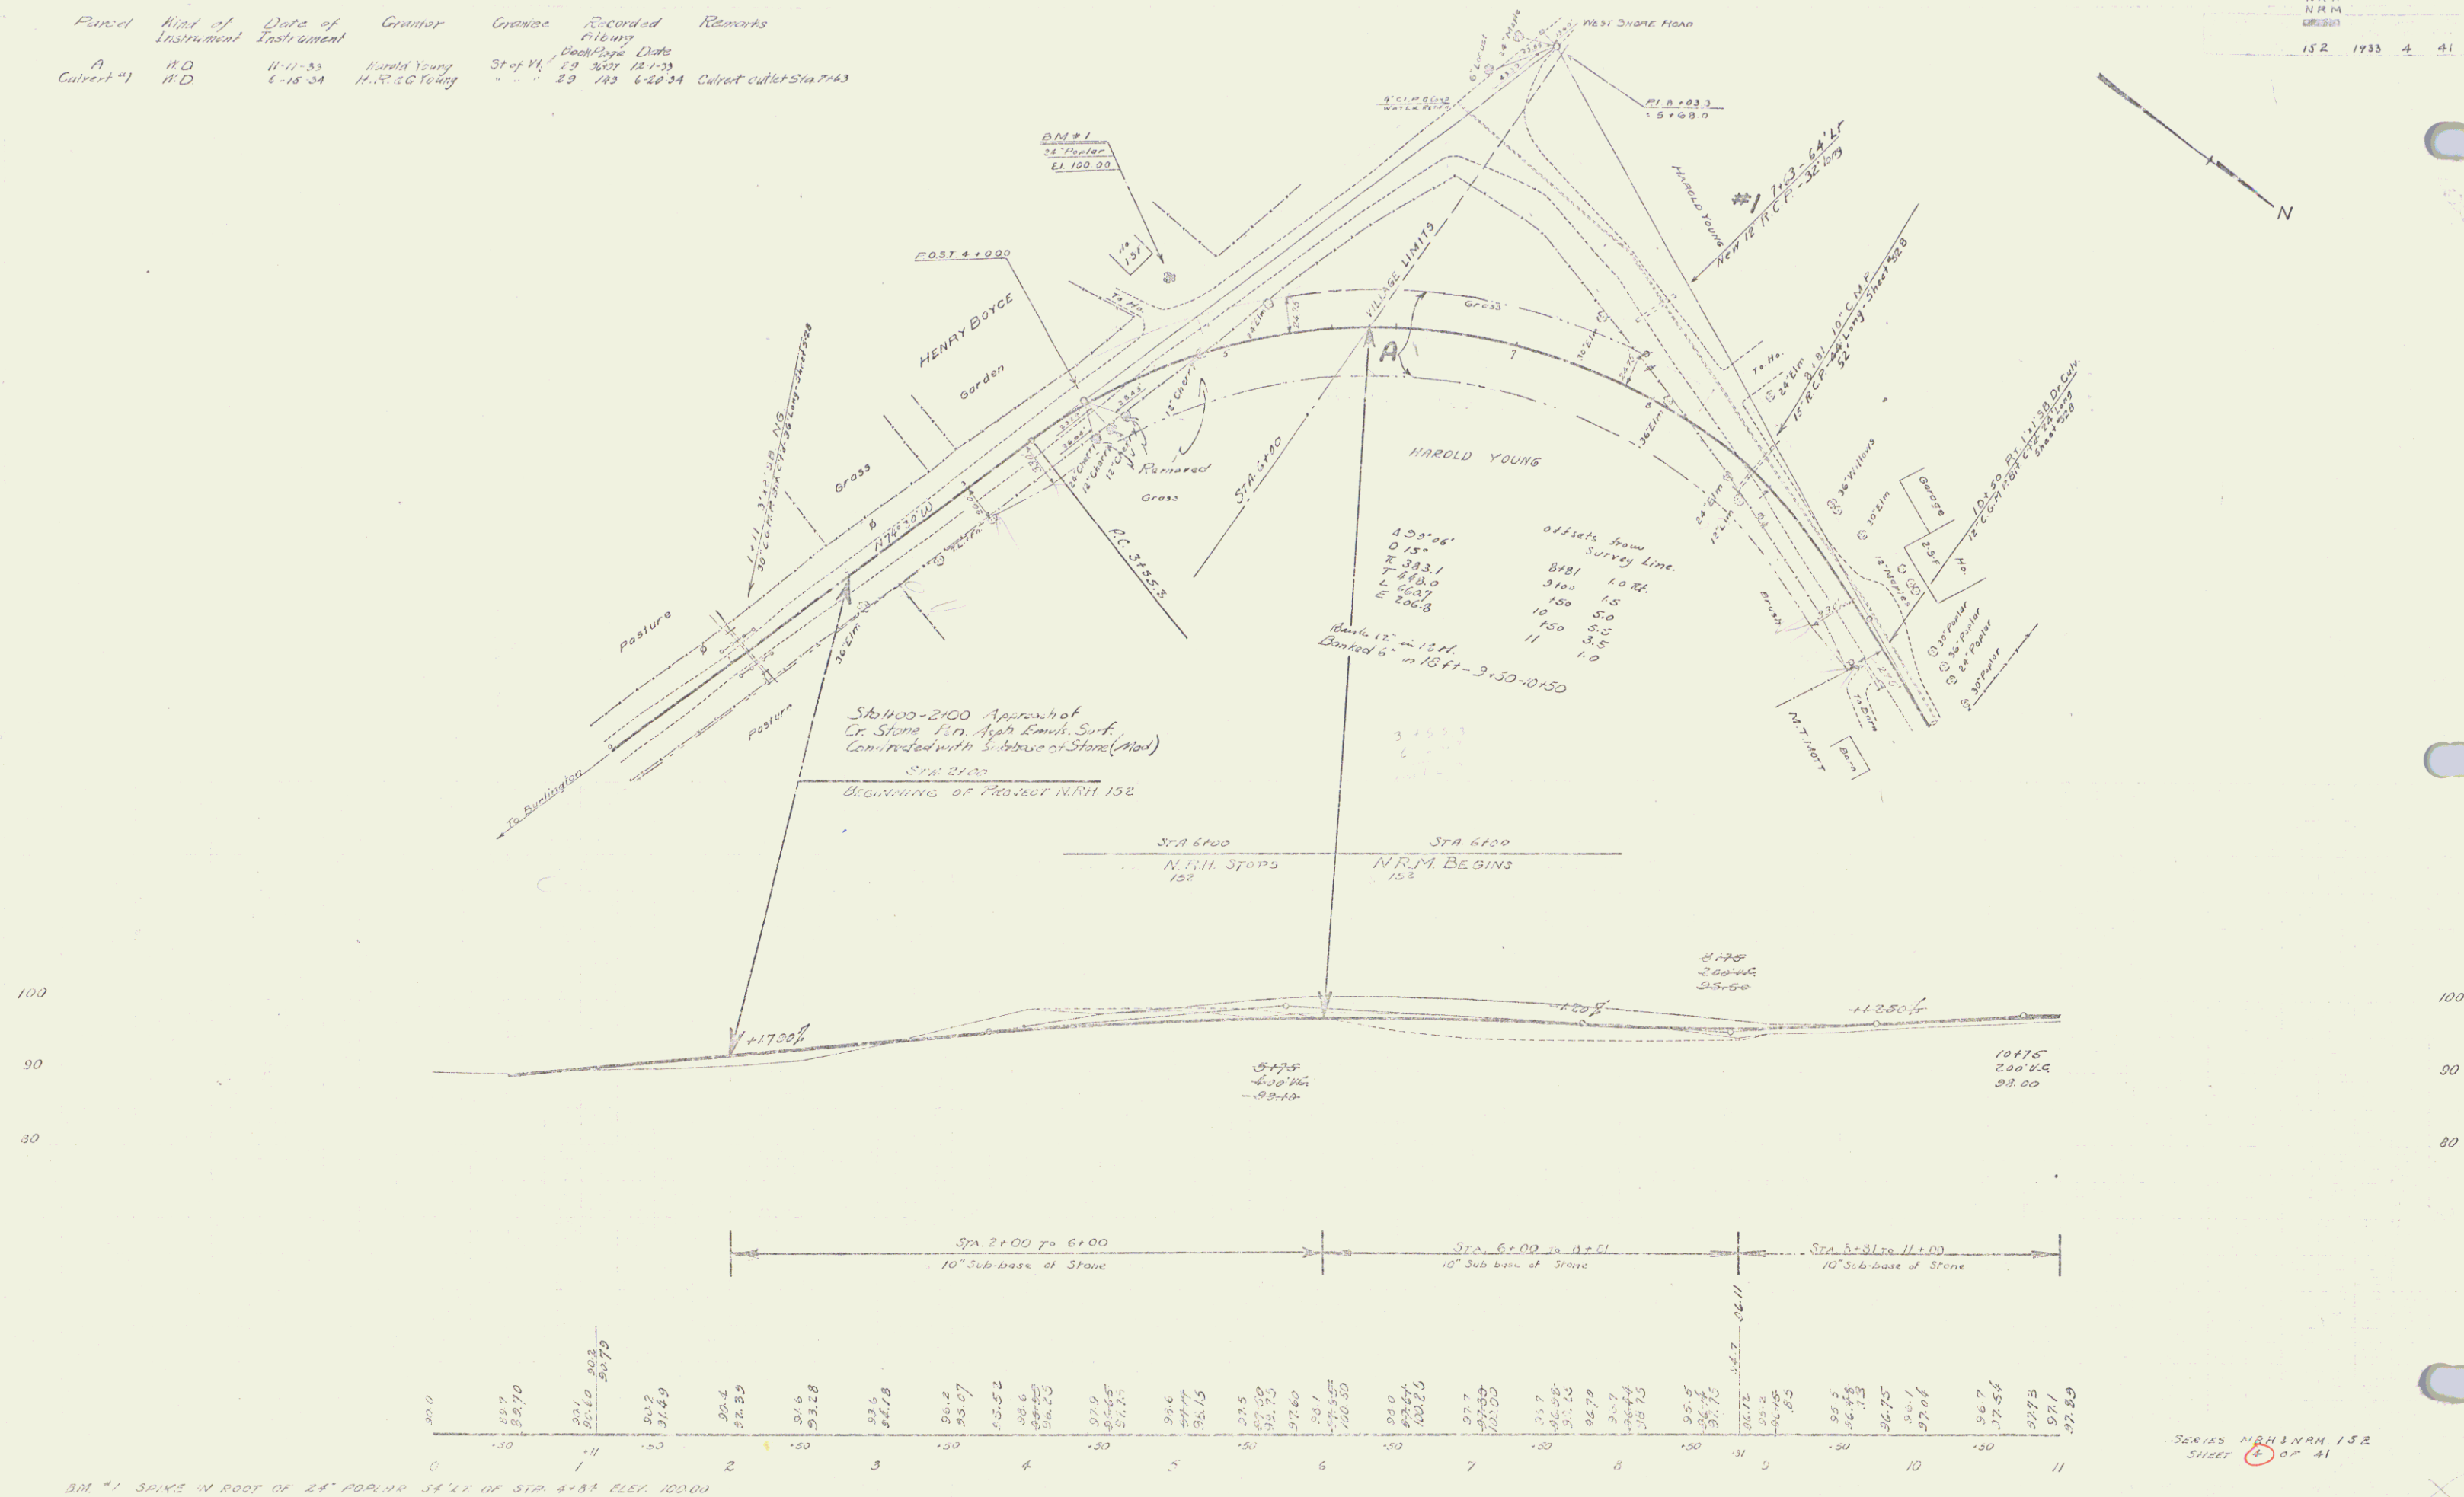

BM #1 SPIKE IN FOOT OF 24" PIPING 34.17 OF STA 4+83 ELEV. 100.00

SERIES NRH 152
SHEET 4 OF 41