




PARCEL	INSTRUMENT	DATE	GRANTOR	GRANTEE	RECORDED	REMARKS
A-B-C	Q.C.D.	9-8-37	JOHN ARNOLD	ST. OF VT.	338K 35 200-51	DATE 7-6-37

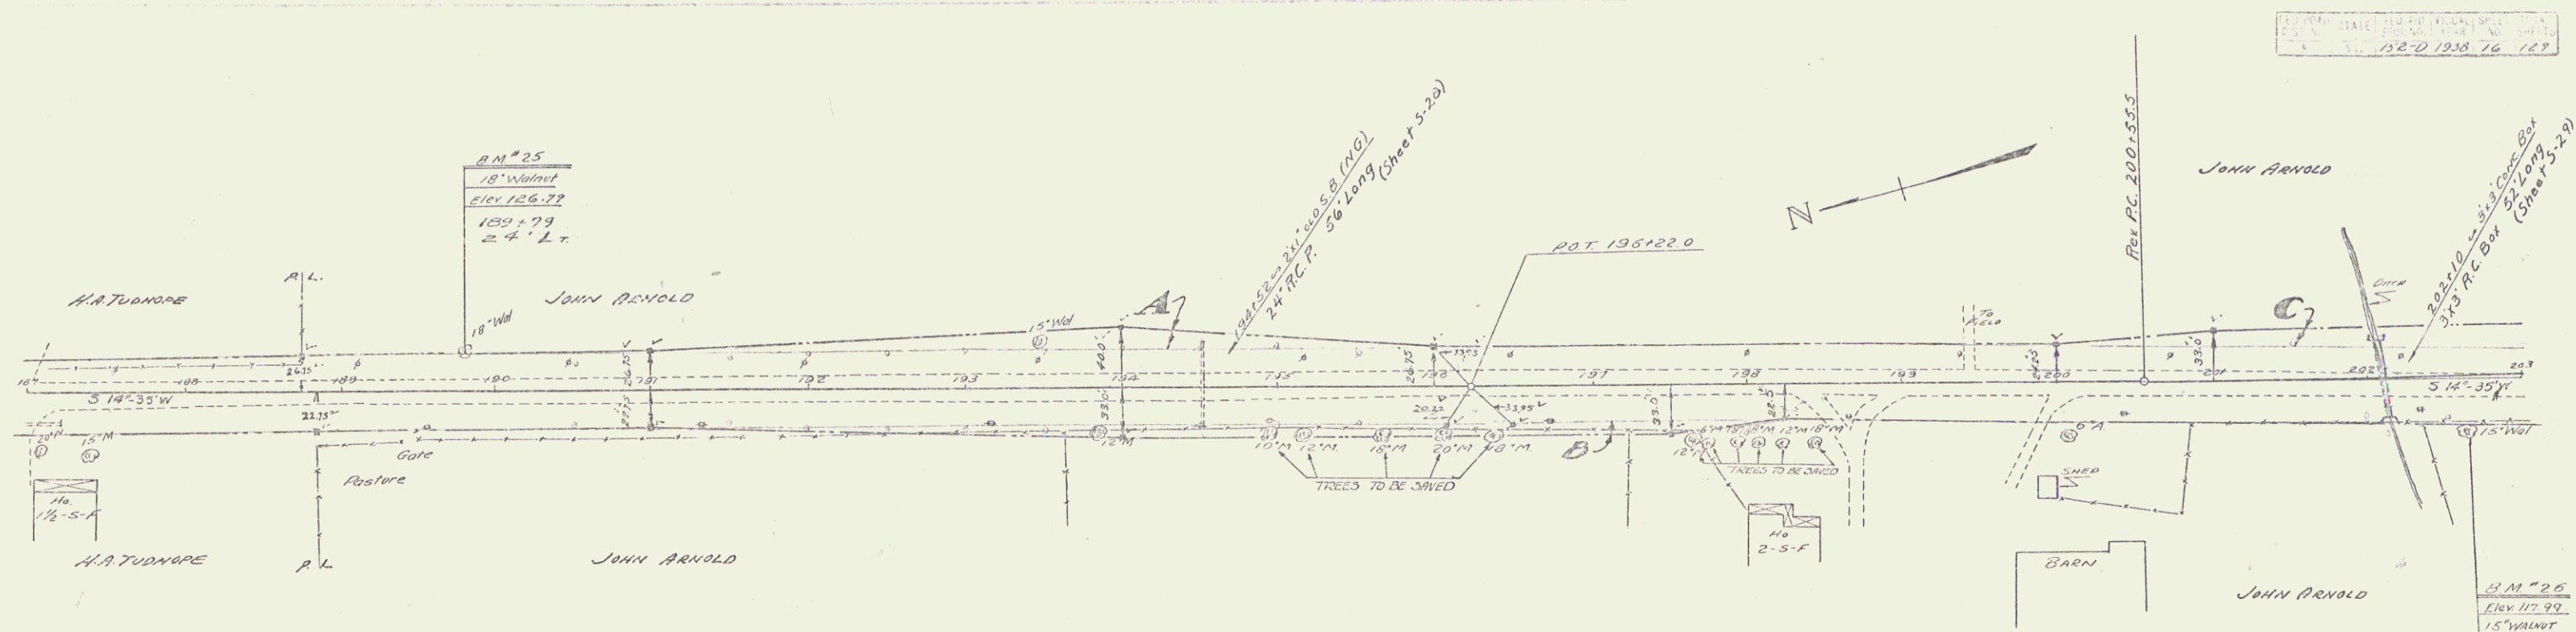