

PROJECT NAME & NUMBER TYPE PAVEMENT AREA
WATERBURY-BOLTON I-89-2(7) CONC. - 74,608 S.Y.

RECORD PLANS

MATERIALS

SUBBASE OF GRAVEL - CATCHPAW PIT - BOLTON, VERMONT.
SUBBASE OF SAND - CHAMPNEY PIT - BOLTON, VERMONT.
SUBBASE OF CRUSHED ROCK, CRUSHED STONE - BASE COURSE & PEA STONE -
DEMERS QUARRY - WINOOSKI, VERMONT.

GRAVEL FOR SHOULDERS - FULLER PIT - BOLTON, VERMONT.

REFINED TAR - TRIMOUNT BITUMINOUS PRODUCTS CO. - EVERETT, MASS.

ASPHALT - ESSO STANDARD - EVERETT, MASS. & PROVIDENCE, R.I.

BITUMINOUS CONCRETE - L.M. PIKE & SONS (PLANT) - DUXBURY, VERMONT.

CONCRETE CLASS "B" - A.G. ANDERSON CO. - WATERBURY, VERMONT.

REINFORCING STEEL - JOHN T. RYERSON & SONS INC. - BOSTON, MASS.

REINFORCED CONCRETE PIPE & PRECAST REINFORCED CONCRETE PIPE DROP INLETS
WITH COVERS - AMERICA - MARIETTA CO. - WINDSOR, VT.

ASPHALT COATED CORRUGATED GALVANIZED METAL PIPE - WHEELING
CORRUGATED METAL CULVERT CO. - BOSTON, MASS.

CAST IRON PIPE UNDERDRAIN FLUSHING BASINS - W/COVERS - VERMONT STRUCT-
URAL STEEL CO. - BURLINGTON, VERMONT.

CABLE GUARD RAIL, STEEL MARKER POSTS & PROPERTY LINE FENCE -
MAINLINE FENCE CO. - WESTBROOK, MAINE.

SIGNS & REFLECTORS - STANDARD SIGNS & SIGNAL CO. - CLINTON, MASS.

CONTRACTOR - MORRISON-KNUDSEN INC. - NEW YORK, N.Y.

RESIDENT ENGINEER - J.R. PHALEN.

SUPERVISOR - E. THORNE & R. FITZGERALD.

RECORD PLANS - J.R. PHALEN, E. THORNE, & R. FITZGERALD.

CONTRACT

DATED: APRIL 29, 1960.

STARTED: MAY 27, 1960.

COMPLETED: NOV. 16, 1961.

ACCEPTED: NOV. 16, 1961.

STATE OF VERMONT
DEPARTMENT OF HIGHWAYS

Proposed Improvement

INTERSTATE PROJECT

TOWNS OF WATERBURY - BOLTON

COUNTIES OF WASHINGTON & CHITTENDEN

Interstate 89 PROJECT I 89-2 (7)

CONTRACT NO. 3

BEGINNING AT A POINT APPROXIMATELY 2.714 MILES NORTHWESTERLY OF THE
WATERBURY-BOLTON TOWN LINE AND EXTENDING NORTHWESTERLY 1.058 MILES.

BEGINNING AT A POINT 3.567 MILES EASTERLY OF THE WATERBURY
BOLTON TOWN LINE AND EXTENDING WESTERLY 7.379 MILES.

LENGTH OF ROADWAY 77,998.16 FEET = 7.184 MILES
LENGTH OF BRIDGES 1,035.24 FEET = 0.193 MILES
LENGTH OF PROJECT 79,033.40 FEET = 7.377 MILES

5,391.59 FEET = 1.021 MILES
408.42 FEET = 0.077 MILES
5,800.00 FEET = 1.098 MILES

DESIGN DESIGNATION

ADT (1950) = 2550

ADT (1975) = 4775

DHV (1975) = 695

D 57.5 %

T 8.0 %

V 70 MPH

STA. 810+00
END PROJECT I 89-2 (6) BEGIN PROJECT I 89-2 (7)

U.S. RELOCATION NO. 5

U.S. RELOCATION NO. 6

U.S. RELOCATION NO. 7

U.S. RELOCATION NO. 221


U.S. RELOCATION NO. 222

U.S. RELOCATION NO. 223


U.S. RELOCATION NO. 224

U.S. RELOCATION NO. 225

U.S. RELOCATION NO

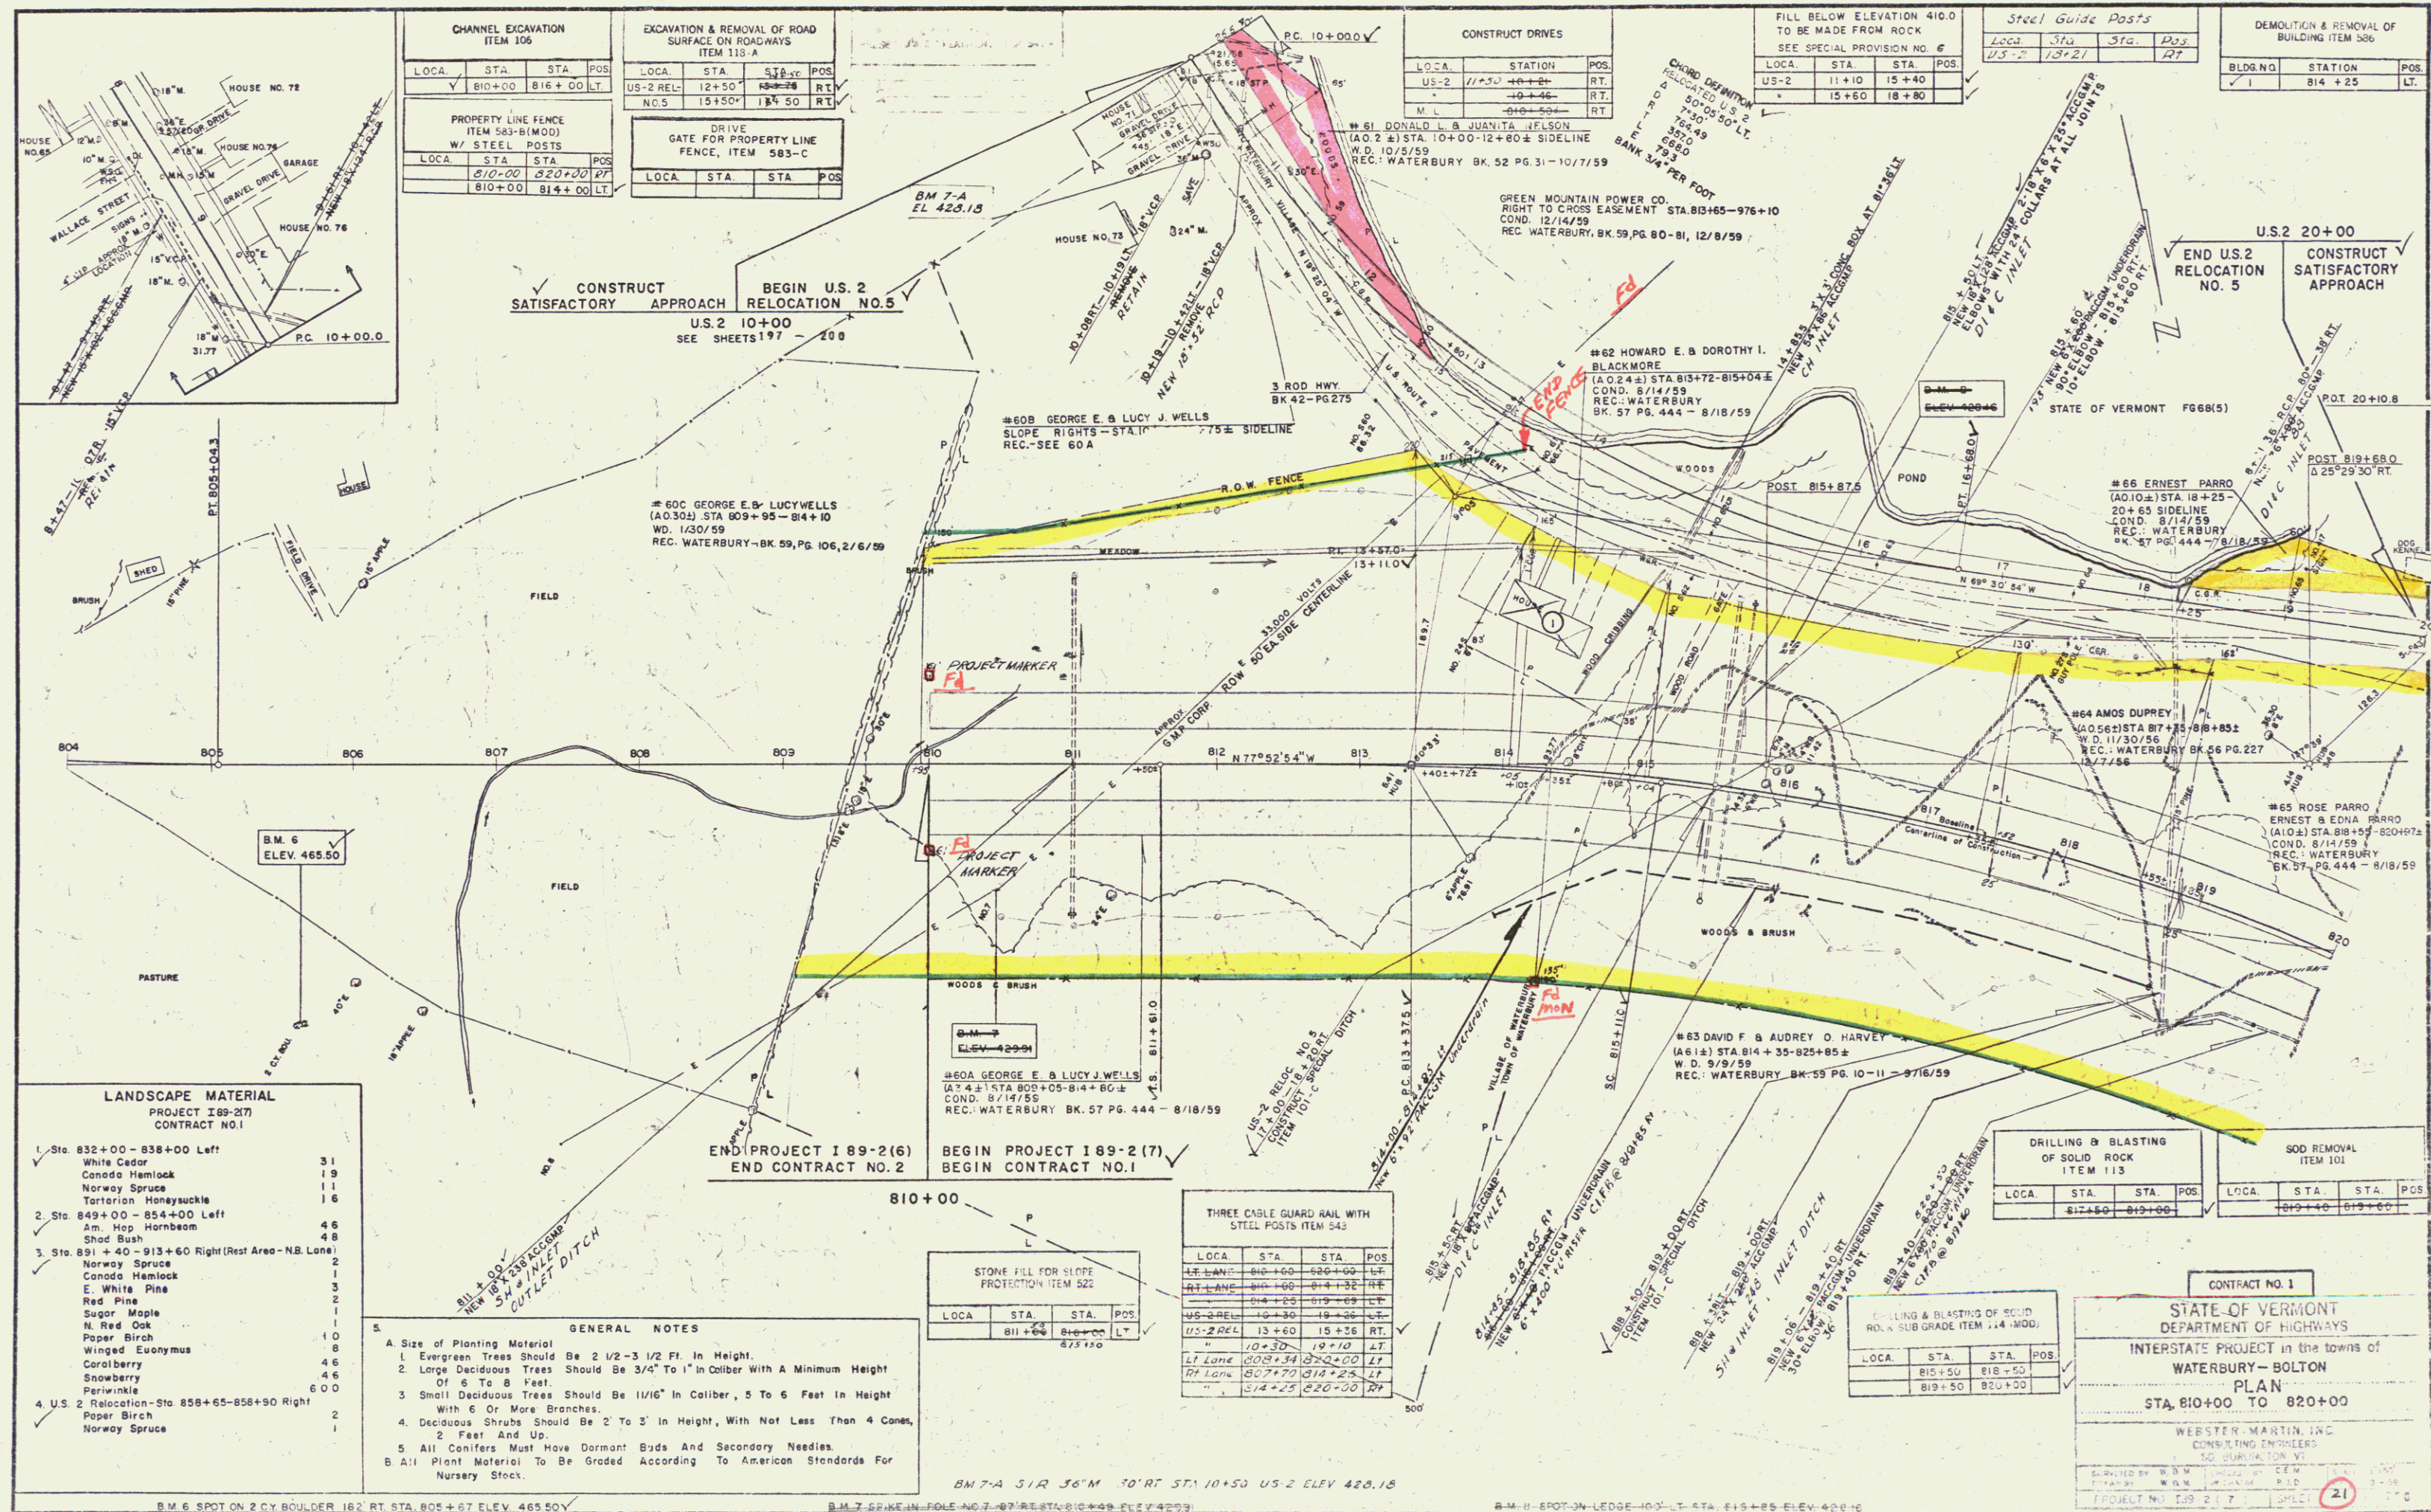

const
2

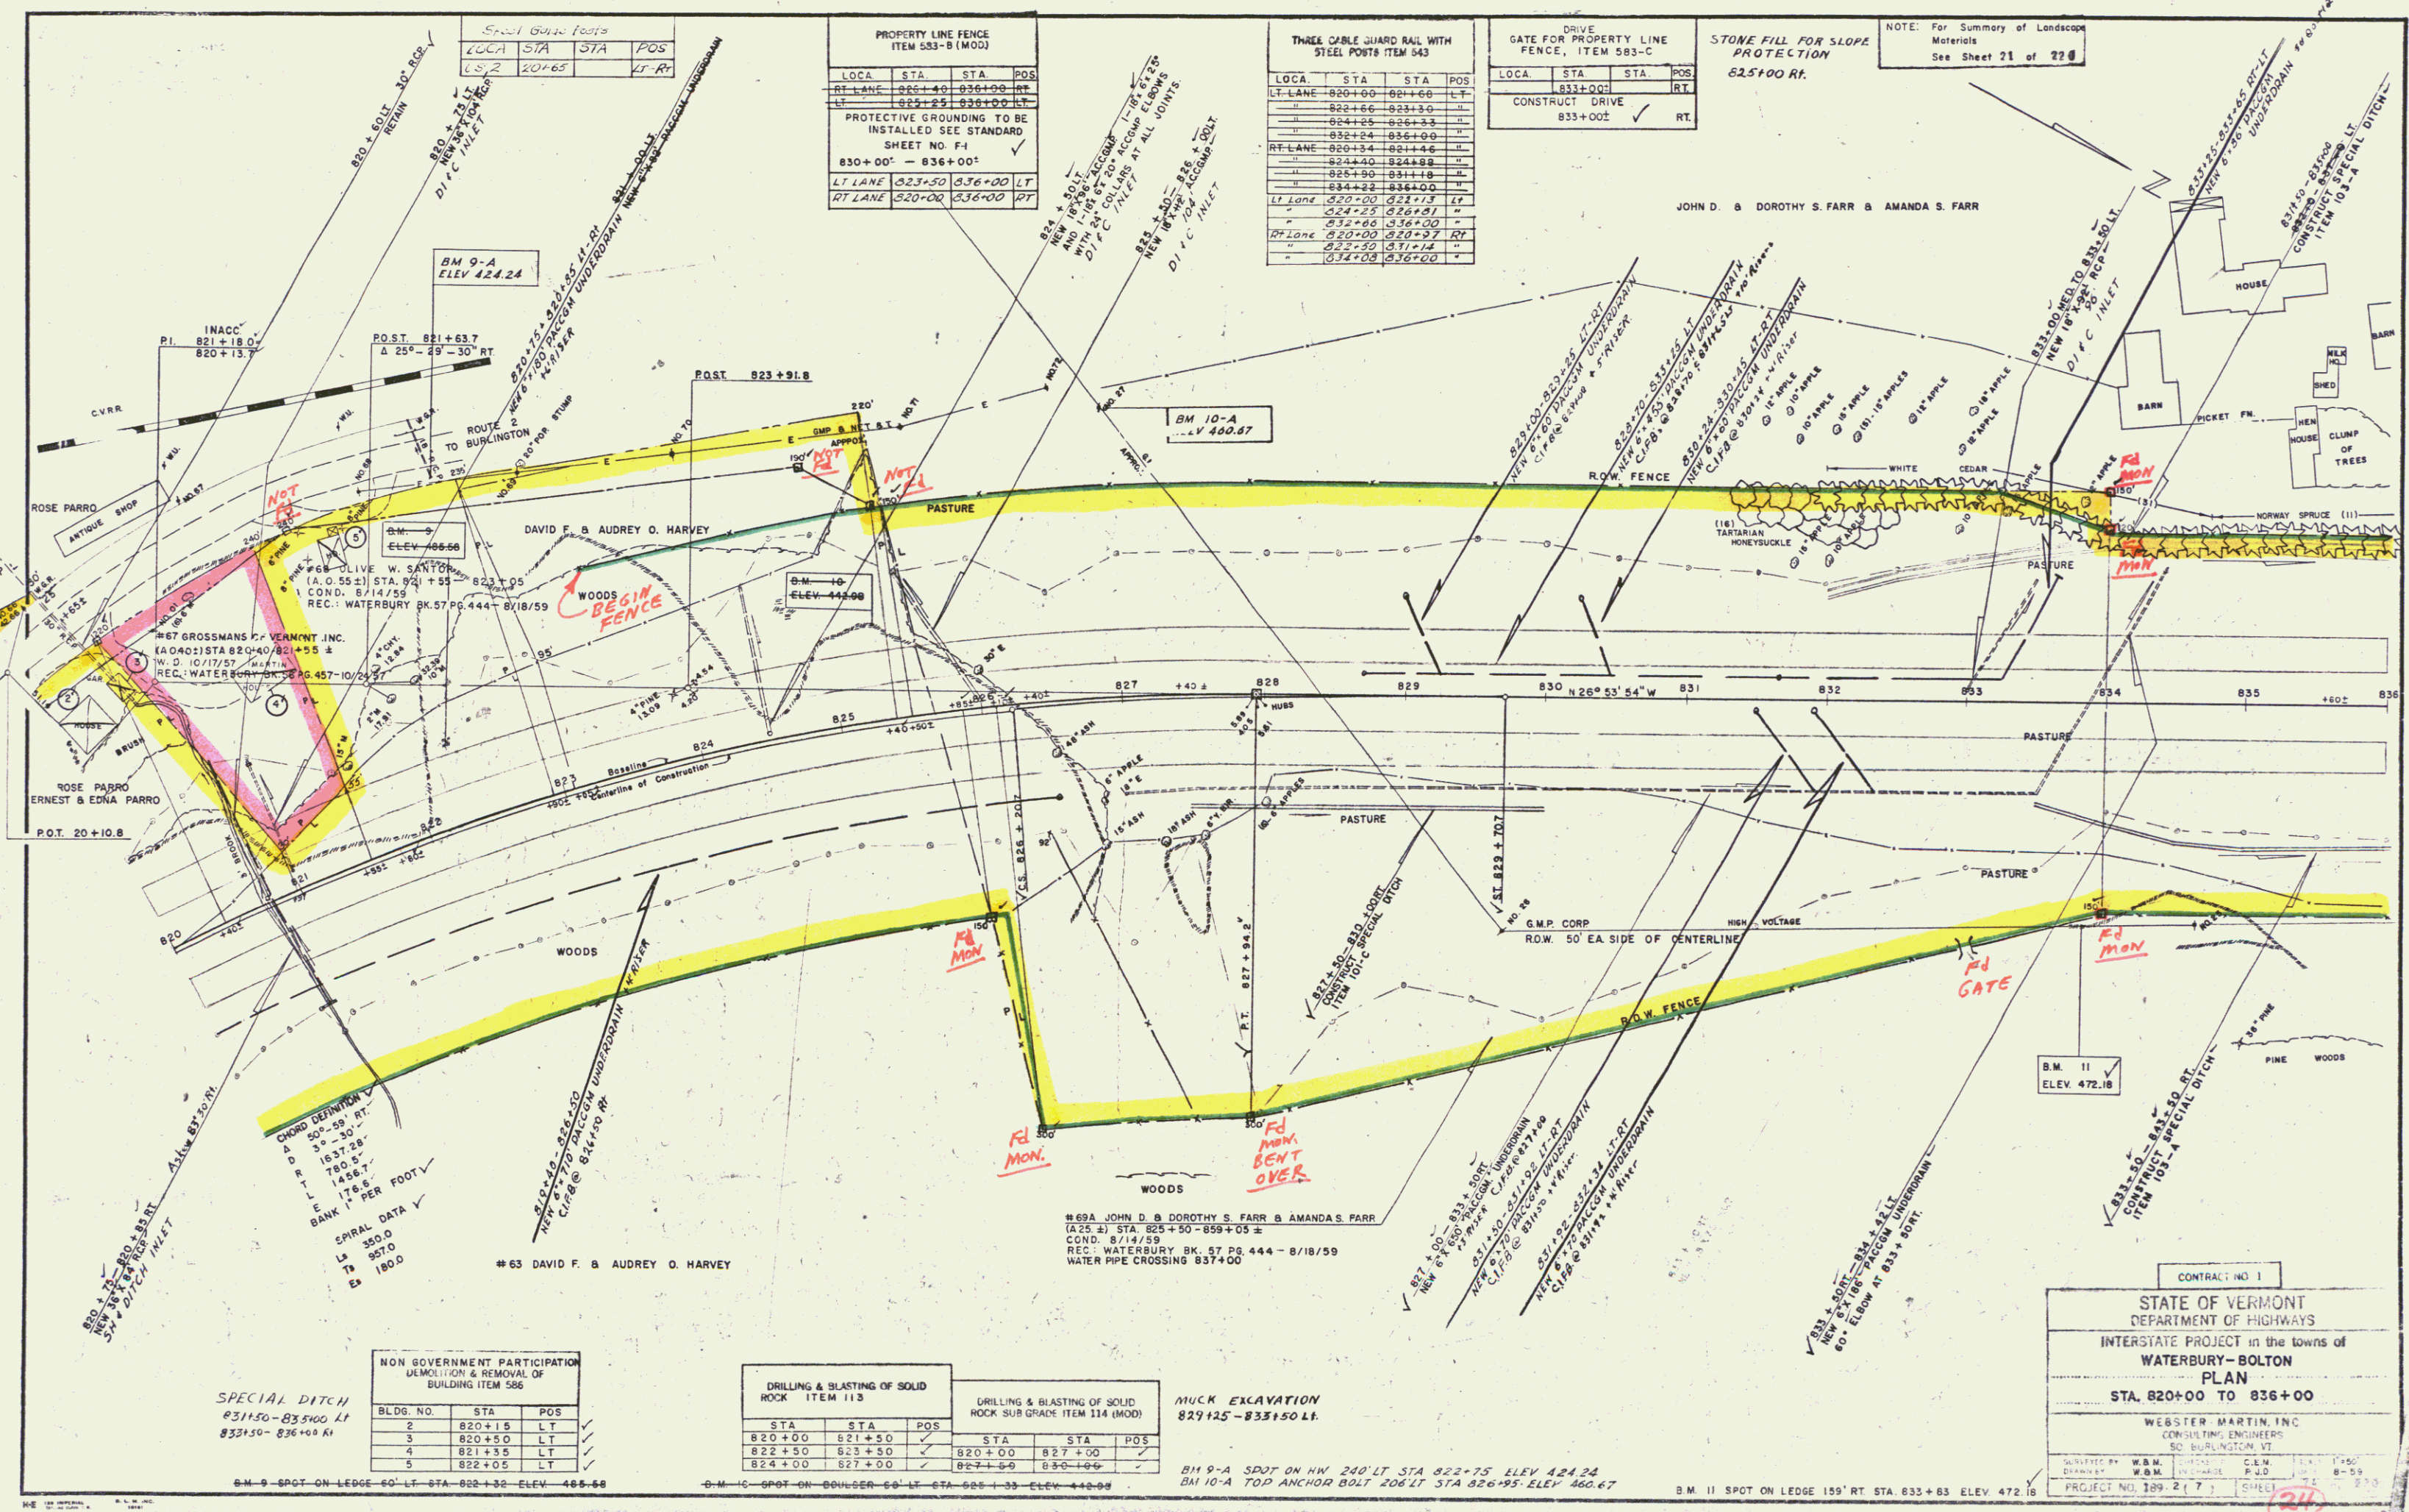

Special Guide Posts

LOCA	STA	STA	POS
CS 2	20+65		LT RT

PROPERTY LINE FENCE
ITEM 583-B (MOD)

LOCA	STA	STA	POS
RT LANE	820+00	826+00	RT
LT LANE	820+00	826+00	LT
RT LANE	827+00	836+00	RT
LT LANE	827+00	836+00	LT

PROTECTIVE GROUNDING TO BE
INSTALLED SEE STANDARD
SHEET NO. F-1

THREE CABLE GUARD RAIL WITH
STEEL POSTS ITEM 543

LOCA	STA	STA	POS
RT LANE	820+00	821+00	RT
LT LANE	820+00	821+00	LT
RT LANE	821+00	822+00	RT
LT LANE	821+00	822+00	LT
RT LANE	822+00	823+00	RT
LT LANE	822+00	823+00	LT
RT LANE	823+00	824+00	RT
LT LANE	823+00	824+00	LT
RT LANE	824+00	825+00	RT
LT LANE	824+00	825+00	LT
RT LANE	825+00	826+00	RT
LT LANE	825+00	826+00	LT

DRIVE
GATE FOR PROPERTY LINE
FENCE, ITEM 583-C

LOCA	STA	STA	POS
CONSTRUCT DRIVE	833+00		RT

STONE FILL FOR SLOPE
PROTECTION
825+00 RT.

NOTE: For Summary of Landscaping
Materials
See Sheet 21 of 22

CONTRACT NO. 1

STATE OF VERMONT
DEPARTMENT OF HIGHWAYS

INTERSTATE PROJECT in the towns of
WATERBURY-BOLTON

PLAN
STA. 820+00 TO 836+00

WEBSTER MARTIN, INC.
CONSULTING ENGINEERS
50 BURLINGTON ST.
BURLINGTON, VT.

DESIGNED BY: W.B.M. IN CHARGE: C.E.M. SCALE: 1"=40'
DRAWN BY: W.B.M. CHECKED: P.J.D. DATE: 8-59

PROJECT NO. 189-2 (7) SHEET 21

NON GOVERNMENT PARTICIPATION
DEMOLITION & REMOVAL OF
BUILDING ITEM 586

BLDG. NO.	STA	POS
2	820+15	LT
3	820+50	LT
4	821+35	LT
5	822+05	LT

DRILLING & BLASTING OF SOLID
ROCK ITEM 113

STA	STA	POS
820+00	821+50	
822+50	823+50	
824+00	827+00	


DRILLING & BLASTING OF SOLID
ROCK SUB GRADE ITEM 114 (MOD)

STA	STA	POS
820+00	827+00	
827+00	830+00	

MUCK EXCAVATION
829+25 - 833+50 LT.

BH 9-A SPOT ON HW 240' LT STA 822+75 ELEV 424.24
BH 10-A TOP ANCHOR BOLT 206' LT STA 826+95 ELEV 460.67

B.M. 11 SPOT ON LEDGE 159' RT STA 833+63 ELEV 472.18

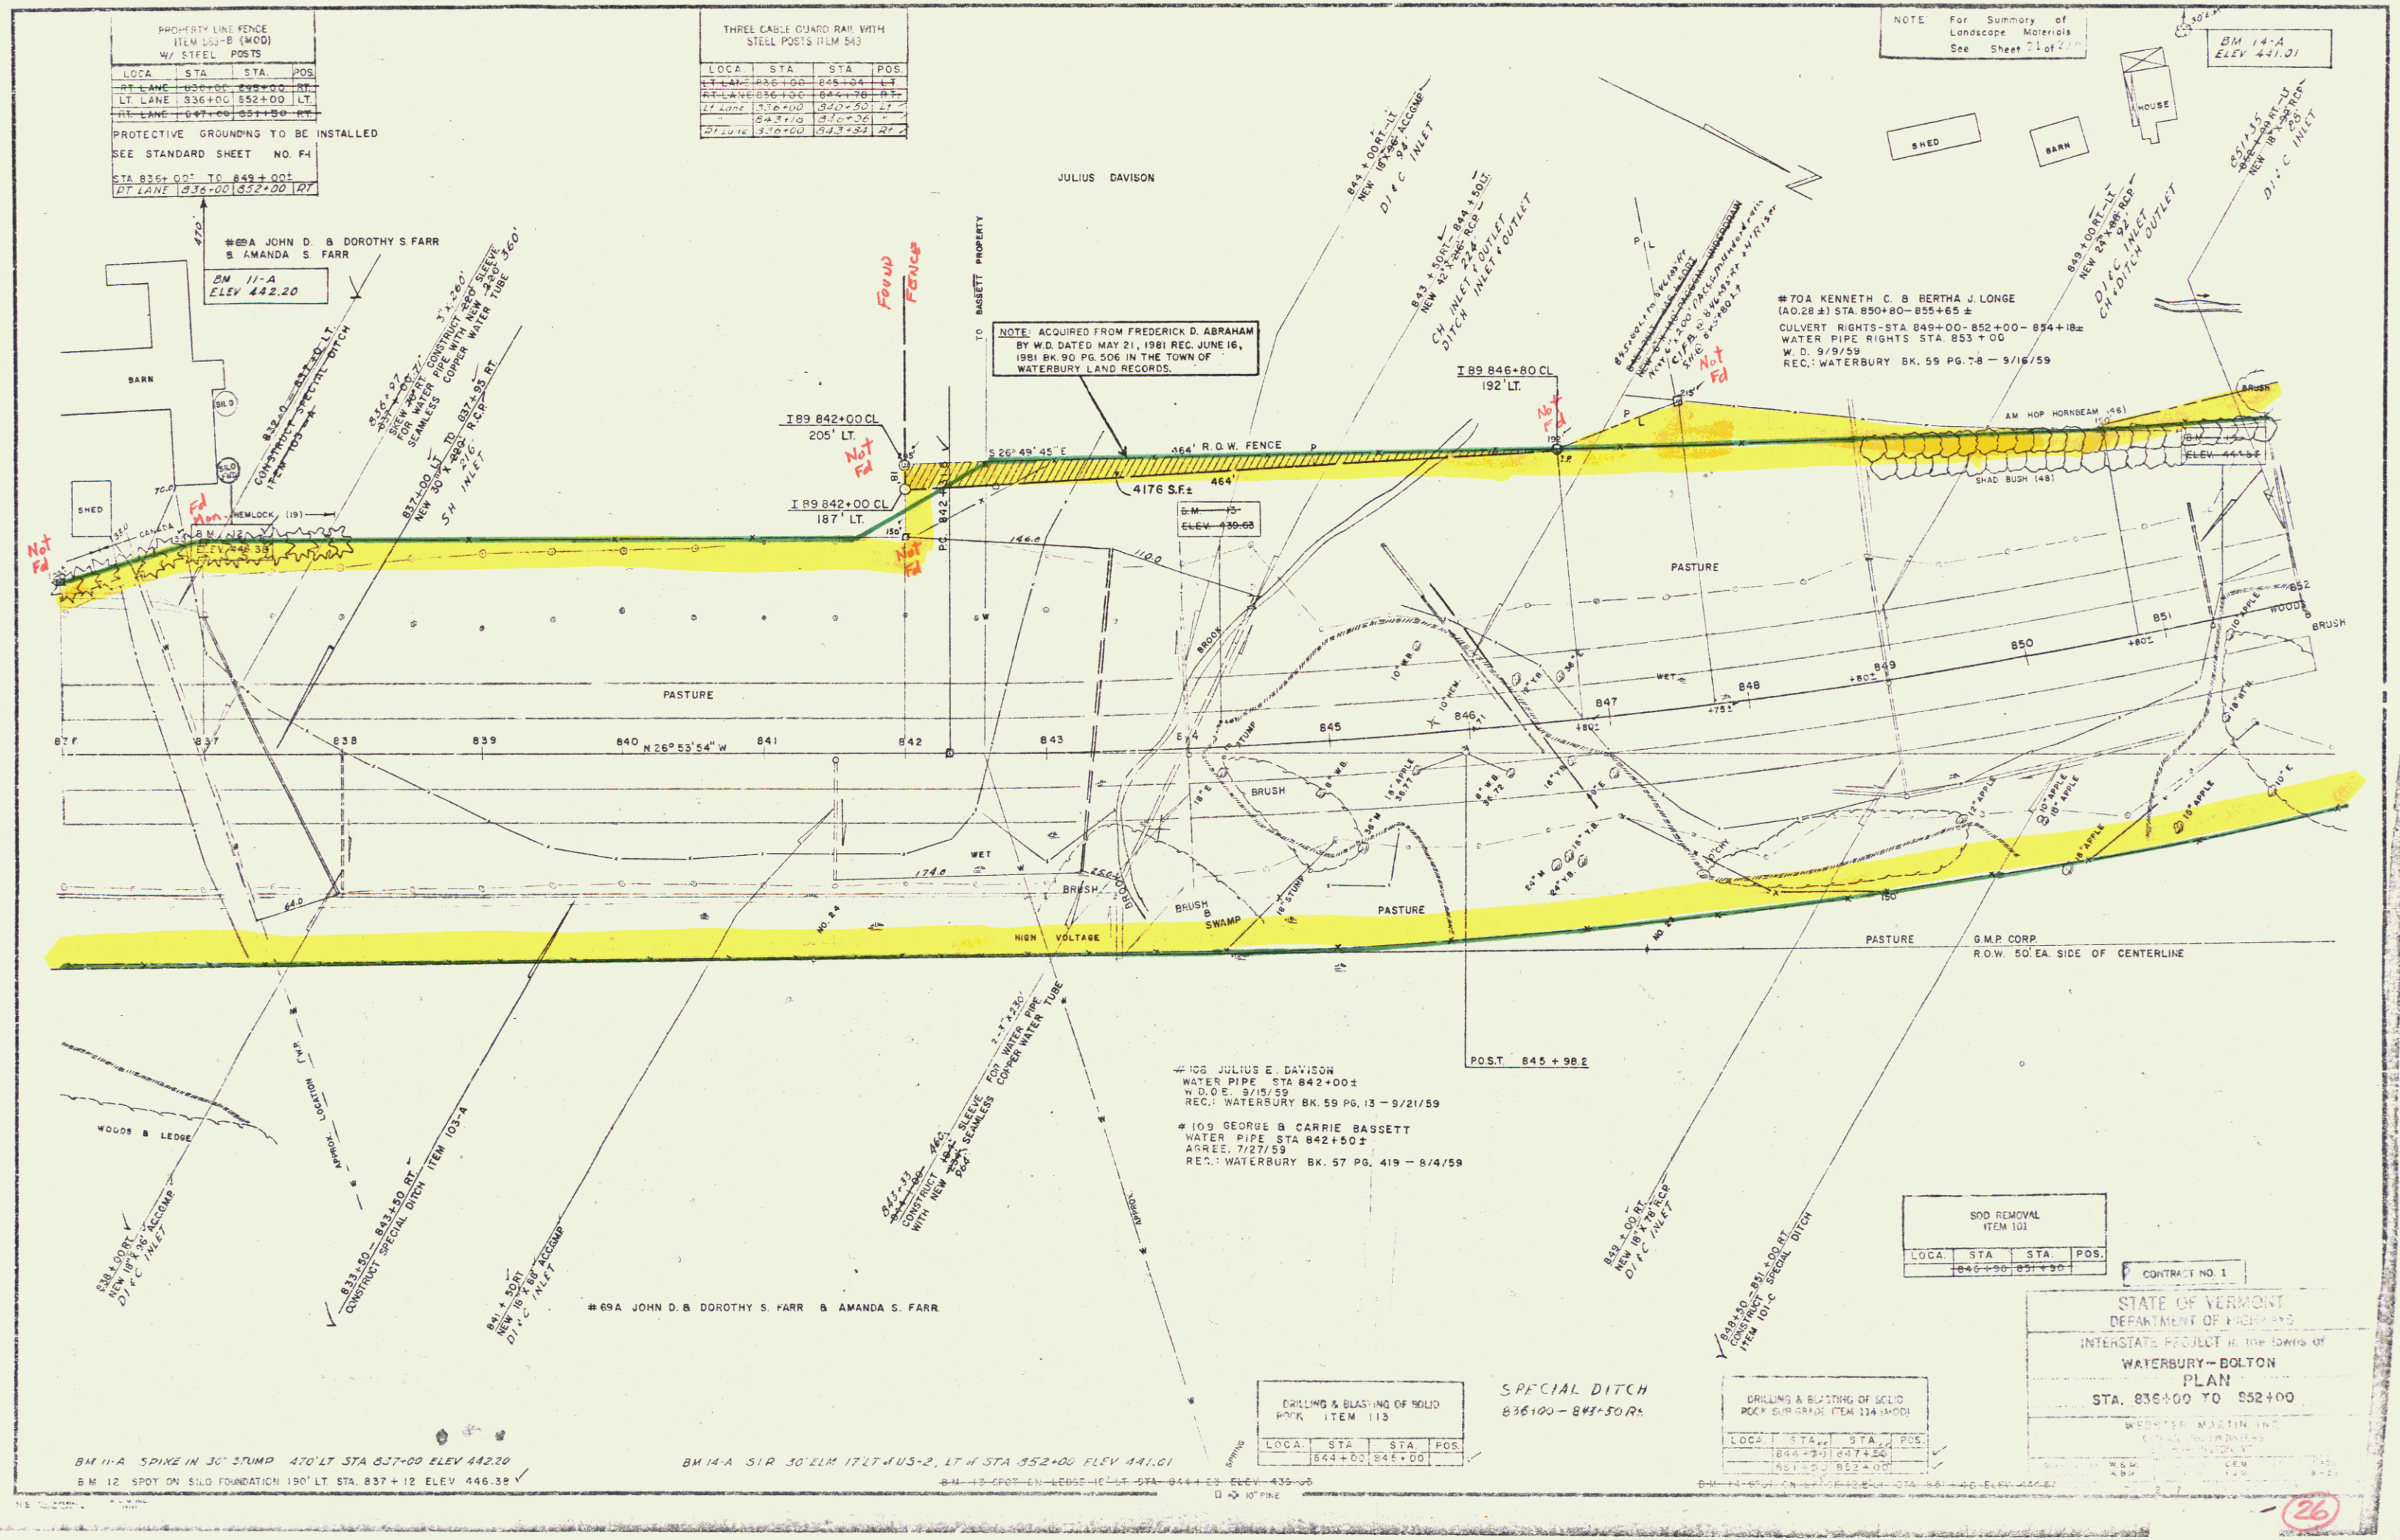

PROPERTY LINE FENCE
ITEM 103-B (MOD)
W/ STEEL POSTS

LOC	STA	STA	POS
RT LANE	836+00	838+00	RT
LT LANE	836+00	852+00	LT
RT LANE	847+00	851+00	RT

PROTECTIVE GROUNDINGS TO BE INSTALLED
SEE STANDARD SHEET NO. F4

STA 836+00 TO 842+00
RT LANE 836+00 TO 842+00

THREE CABLE GUARD RAIL WITH
STEEL POSTS ITEM 543

LOC	STA	STA	POS
RT LANE	842+00	848+04	RT
LT LANE	842+00	844+76	LT
RT LANE	846+00	850+50	RT
LT LANE	846+00	850+50	LT

NOTE For Summary of
Landscape Materials
See Sheet 21 of 22

BM 14-A
ELEV 441.01

NOTE: ACQUIRED FROM FREDERICK D. ABRAHAM
BY W.D. DATED MAY 21, 1981 REC. JUNE 16,
1981 BK. 90 PG. 506 IN THE TOWN OF
WATERBURY LAND RECORDS.

*70A KENNETH C. & BERTHA J. LONGE
(AO.28) STA 850+80-855+65 ±
CULVERT RIGHTS STA 849+00-852+00-854+18 ±
WATER PIPE RIGHTS STA 853+00
W.D. 9/9/59
REC. WATERBURY BK. 59 PG. 78 - 9/16/59

*108 JULIUS E. DAVISON
WATER PIPE STA 842+00 ±
W.D.O.E. 8/15/59
REC. WATERBURY BK. 59 PG. 13 - 9/21/59

*109 GEORGE & CARRIE BASSETT
WATER PIPE STA 842+50 ±
W.D.O.E. 7/27/59
REC. WATERBURY BK. 57 PG. 419 - 8/4/59

SOD REMOVAL
ITEM 101

LOC	STA	STA	POS
RT LANE	846+00	851+30	RT

CONTRACT NO. 1

STATE OF VERMONT
DEPARTMENT OF HIGHWAYS
INTERSTATE PROJECT IN THE TOWN OF
WATERBURY-BOLTON
PLAN
STA. 836+00 TO 852+00
WEDDIE MARTIN INC.
CIVIL ENGINEERS
100 NORTH STREET
WATERBURY, VT 05671

DRILLING & BLASTING OF SOLO
POCK ITEM 113

LOC	STA	STA	POS
RT LANE	844+00	845+00	RT

SPECIAL DITCH
836+00 - 841+50 ±

DRILLING & BLASTING OF SOLO
POCK SUB GRADE ITEM 114 (MOD)

LOC	STA	STA	POS
RT LANE	844+00	847+50	RT
LT LANE	847+50	852+00	LT

BM 11-A SPIKE IN 30' STUMP 470' LT STA 837+00 ELEV 442.20
BM 12 SPOT ON SLO FOUNDATION 190' LT STA 837+12 ELEV 446.38

BM 14-A S/P 30' ELM 172' LT STA 852+00 ELEV 441.01

BM 13 SPOT ON LEASE 10' LT STA 844+12 ELEV 439.05

LAND TO BE ACQUIRED FROM FREDERICK ABRAHAM

I 89 846+80 CL
192' LT.

"C"
IP

S 50° 44' 45" E
95.20'

IP

N 50° 02' 50" E
222.92'

24.75'
IP

4176 S.F.

464'

S 26° 49' 45" E
464'

"D"

I 89 842+00 CL
187' LT.

DISTANCE FROM "A" TO "B" IS 255'
DISTANCE FROM "C" TO "D" IS 400.01'

I 89 842+00 CL
205' LT.

S 60° 26' 20" W
255'

24.75'
IP


512.50'
N 29° 20' 15" W

CENTER LINE U.S. RT. 2

← TO BOLTON

TO WATERBURY VILLAGE →

- ⊙ IRON PIN
- CONCRETE BOUND
- x— EXISTING R.O.W. FENCE
- — — PROPERTY LINE

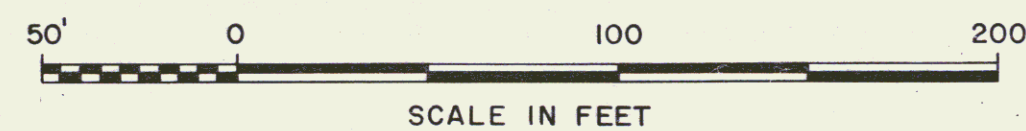

STATE OF VERMONT
AGENCY OF TRANSPORTATION


TOWN OF WATERBURY

REF. WATERBURY I 89-2(7)

APPROX SCALE " 50' DATE 5-11-81 DRAWN BY JDP

26A


THREE CABLE GUARD RAIL WITH STEEL POSTS ITEM 543				CONSTRUCT ROCK FILL SEE SPECIAL PROVISION NO. 6				FILLS ON EXISTING RIVER BANK TO BE MADE FROM ROCK SEE SPECIAL PROVISION NO. 6				STONE FILL FOR SLOPE PROTECTION ITEM 522				EXCAVATION & REMOVAL OF ROAD SURFACE ON ROADWAYS ITEM 118-A				CHANNEL EXCAVATION ITEM 106				PROPERTY LINE FENCE ITEM 583-B (MOD) W/ STEEL POSTS			
LOCA	STA	STA	POS	LOCA	STA	STA	POS	LOCA	STA	STA	POS	LOCA	STA	STA	POS	LOCA	STA	STA	POS	LOCA	STA	STA	POS	LOCA	STA	STA	POS
RT LANE	859+93	863+37	RT	US-2	855+00	864+60	LT	US-2	859+00	862+00	LT	US-2	859+00	862+00	LT	US-2	859+00	862+00	LT	US-2	859+00	862+00	LT	US-2	859+00	862+00	LT
RT LANE	859+93	863+37	RT	US-2	855+00	864+60	LT	US-2	859+00	862+00	LT	US-2	859+00	862+00	LT	US-2	859+00	862+00	LT	US-2	859+00	862+00	LT	US-2	859+00	862+00	LT

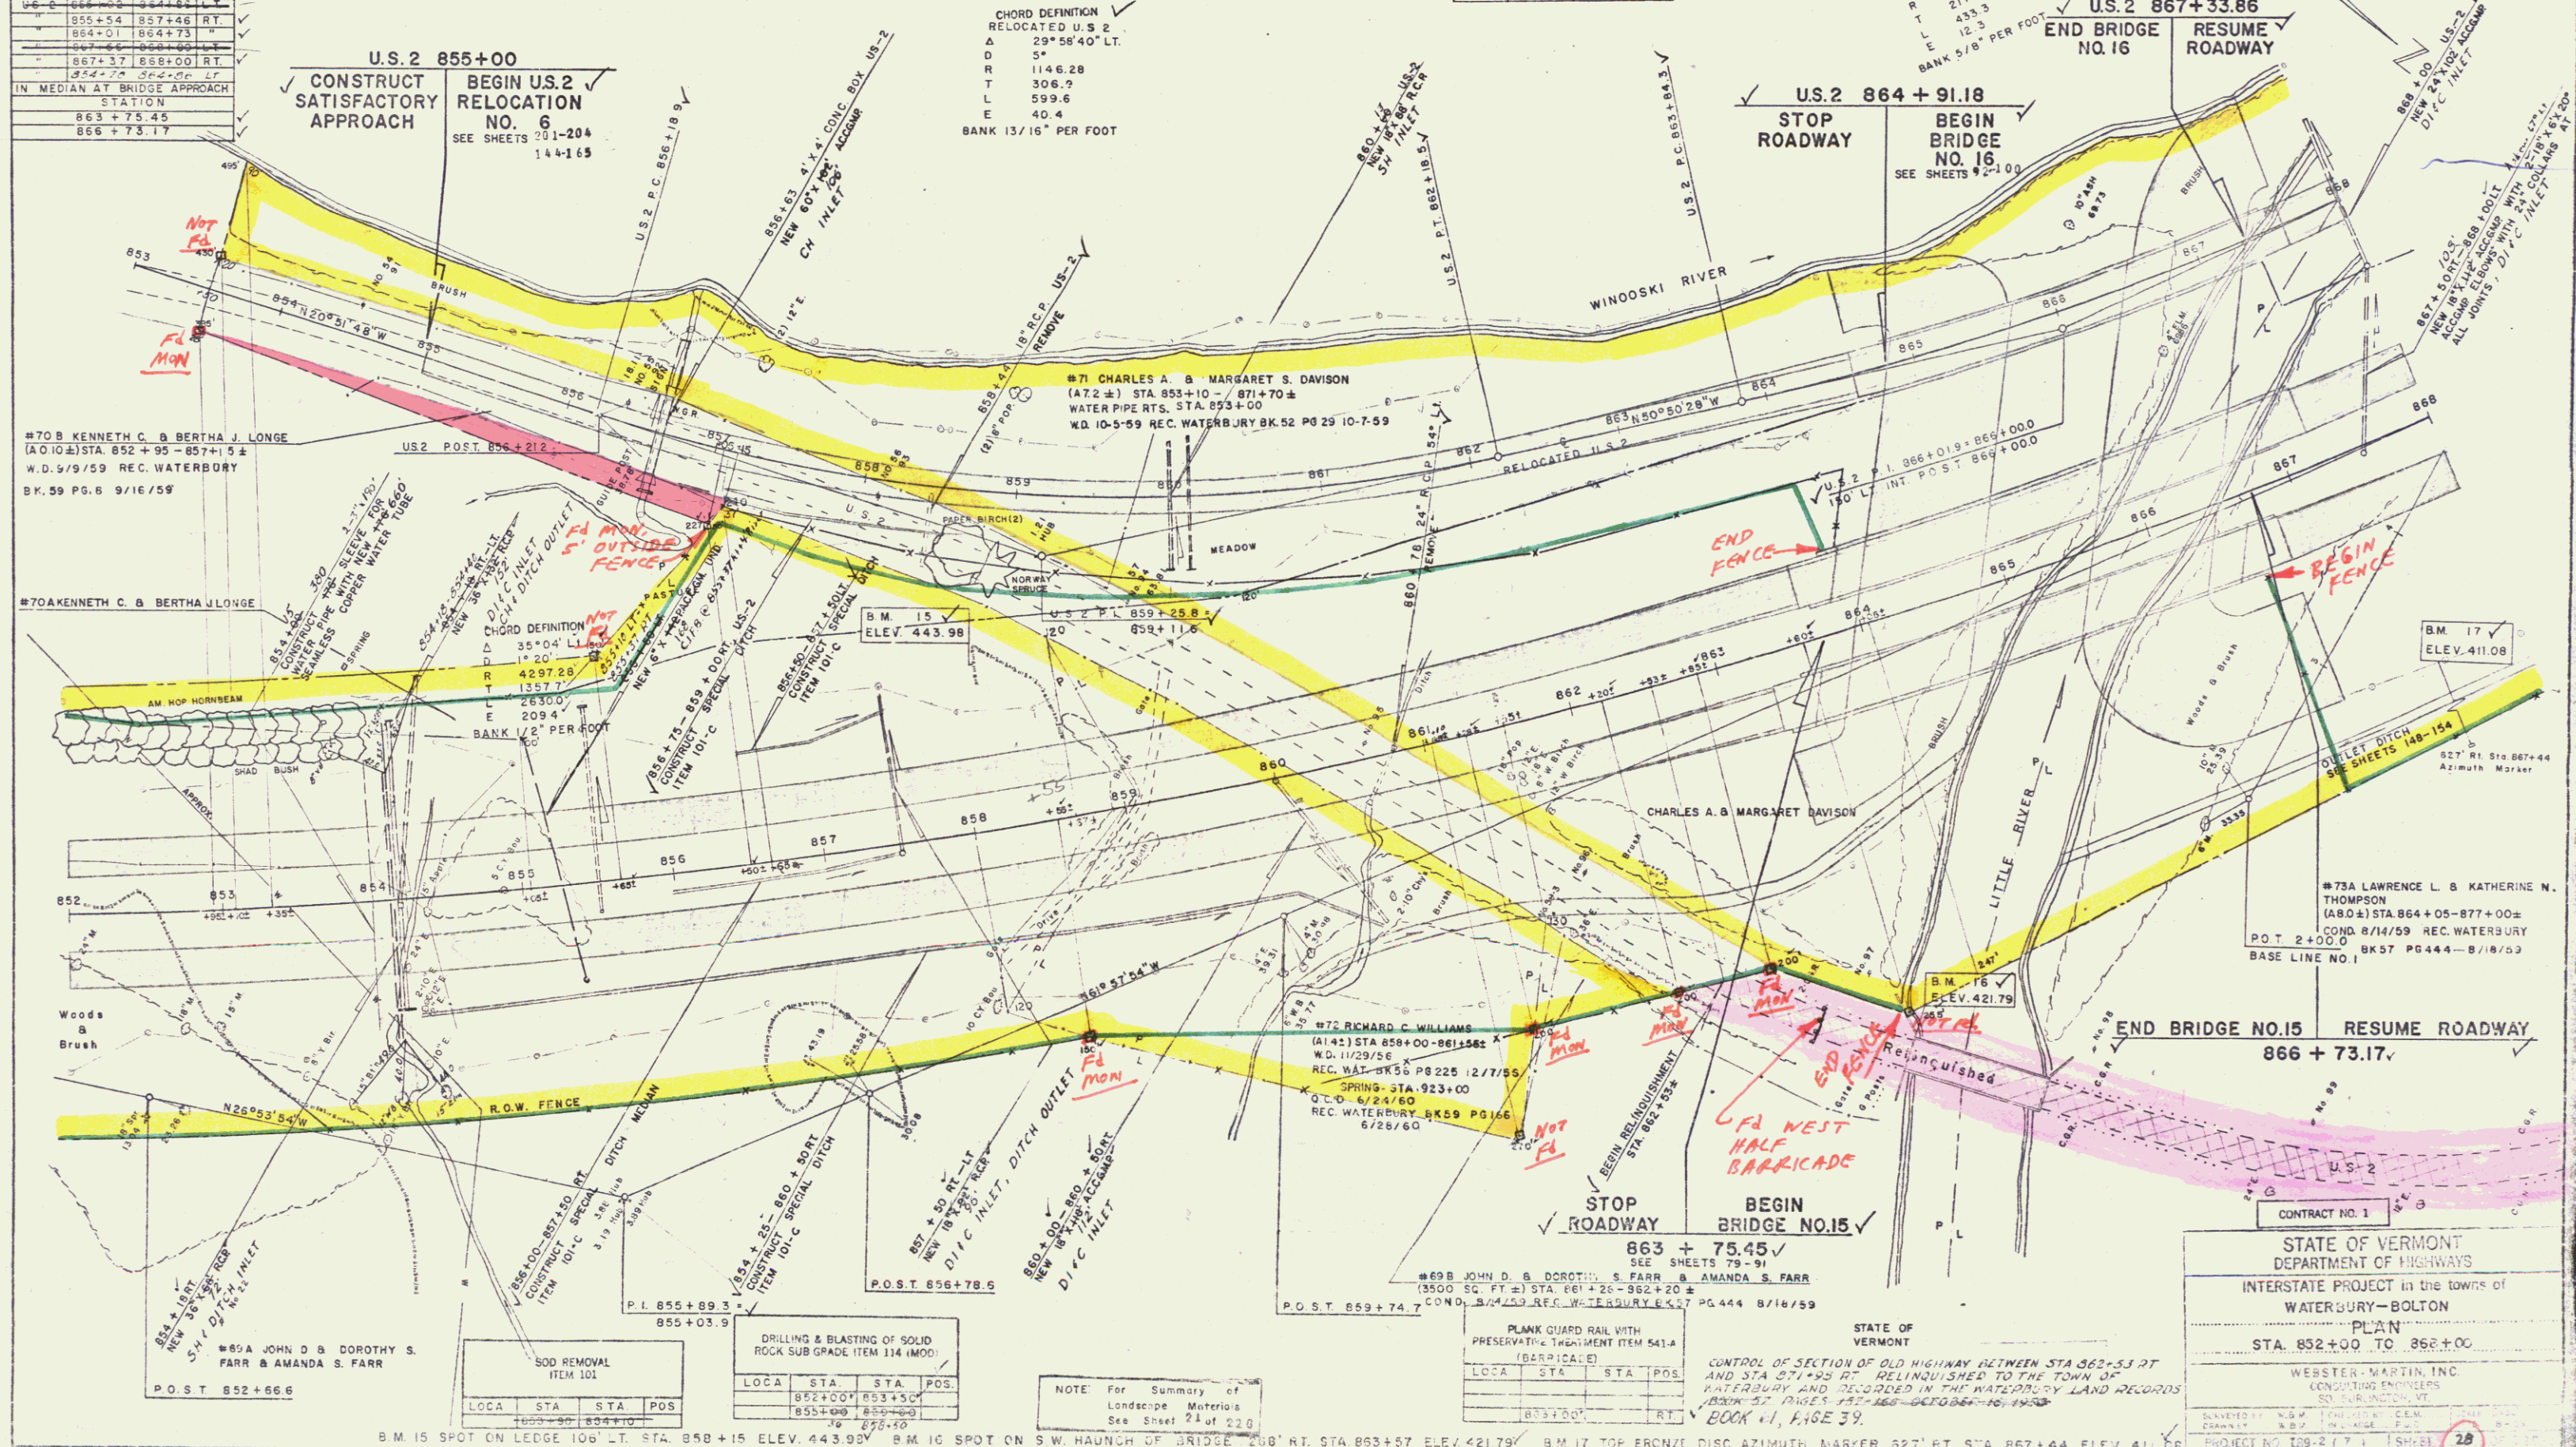

STATE OF VERMONT
DEPARTMENT OF HIGHWAYS
INTERSTATE PROJECT in the towns of
WATERBURY-BOLTON
PLAN
STA. 852+00 TO 867+00
WEBSTER, MARTIN, INC.
CONSULTING ENGINEERS
300 RICHMOND ST.
BURLINGTON, VT.
PROJECT NO. 129-2 (7-1) SHEET 28

NOTE: For Summary of Landscape Materials See Sheet 21 of 22

CONTROL OF SECTION OF OLD HIGHWAY BETWEEN STA 863+53 PT AND STA 871+95 RT RELINQUISHED TO THE TOWN OF WATERBURY AND RECORDED IN THE WATERBURY LAND RECORDS BOOK 37, PAGE 457-462-463-464-999-1000

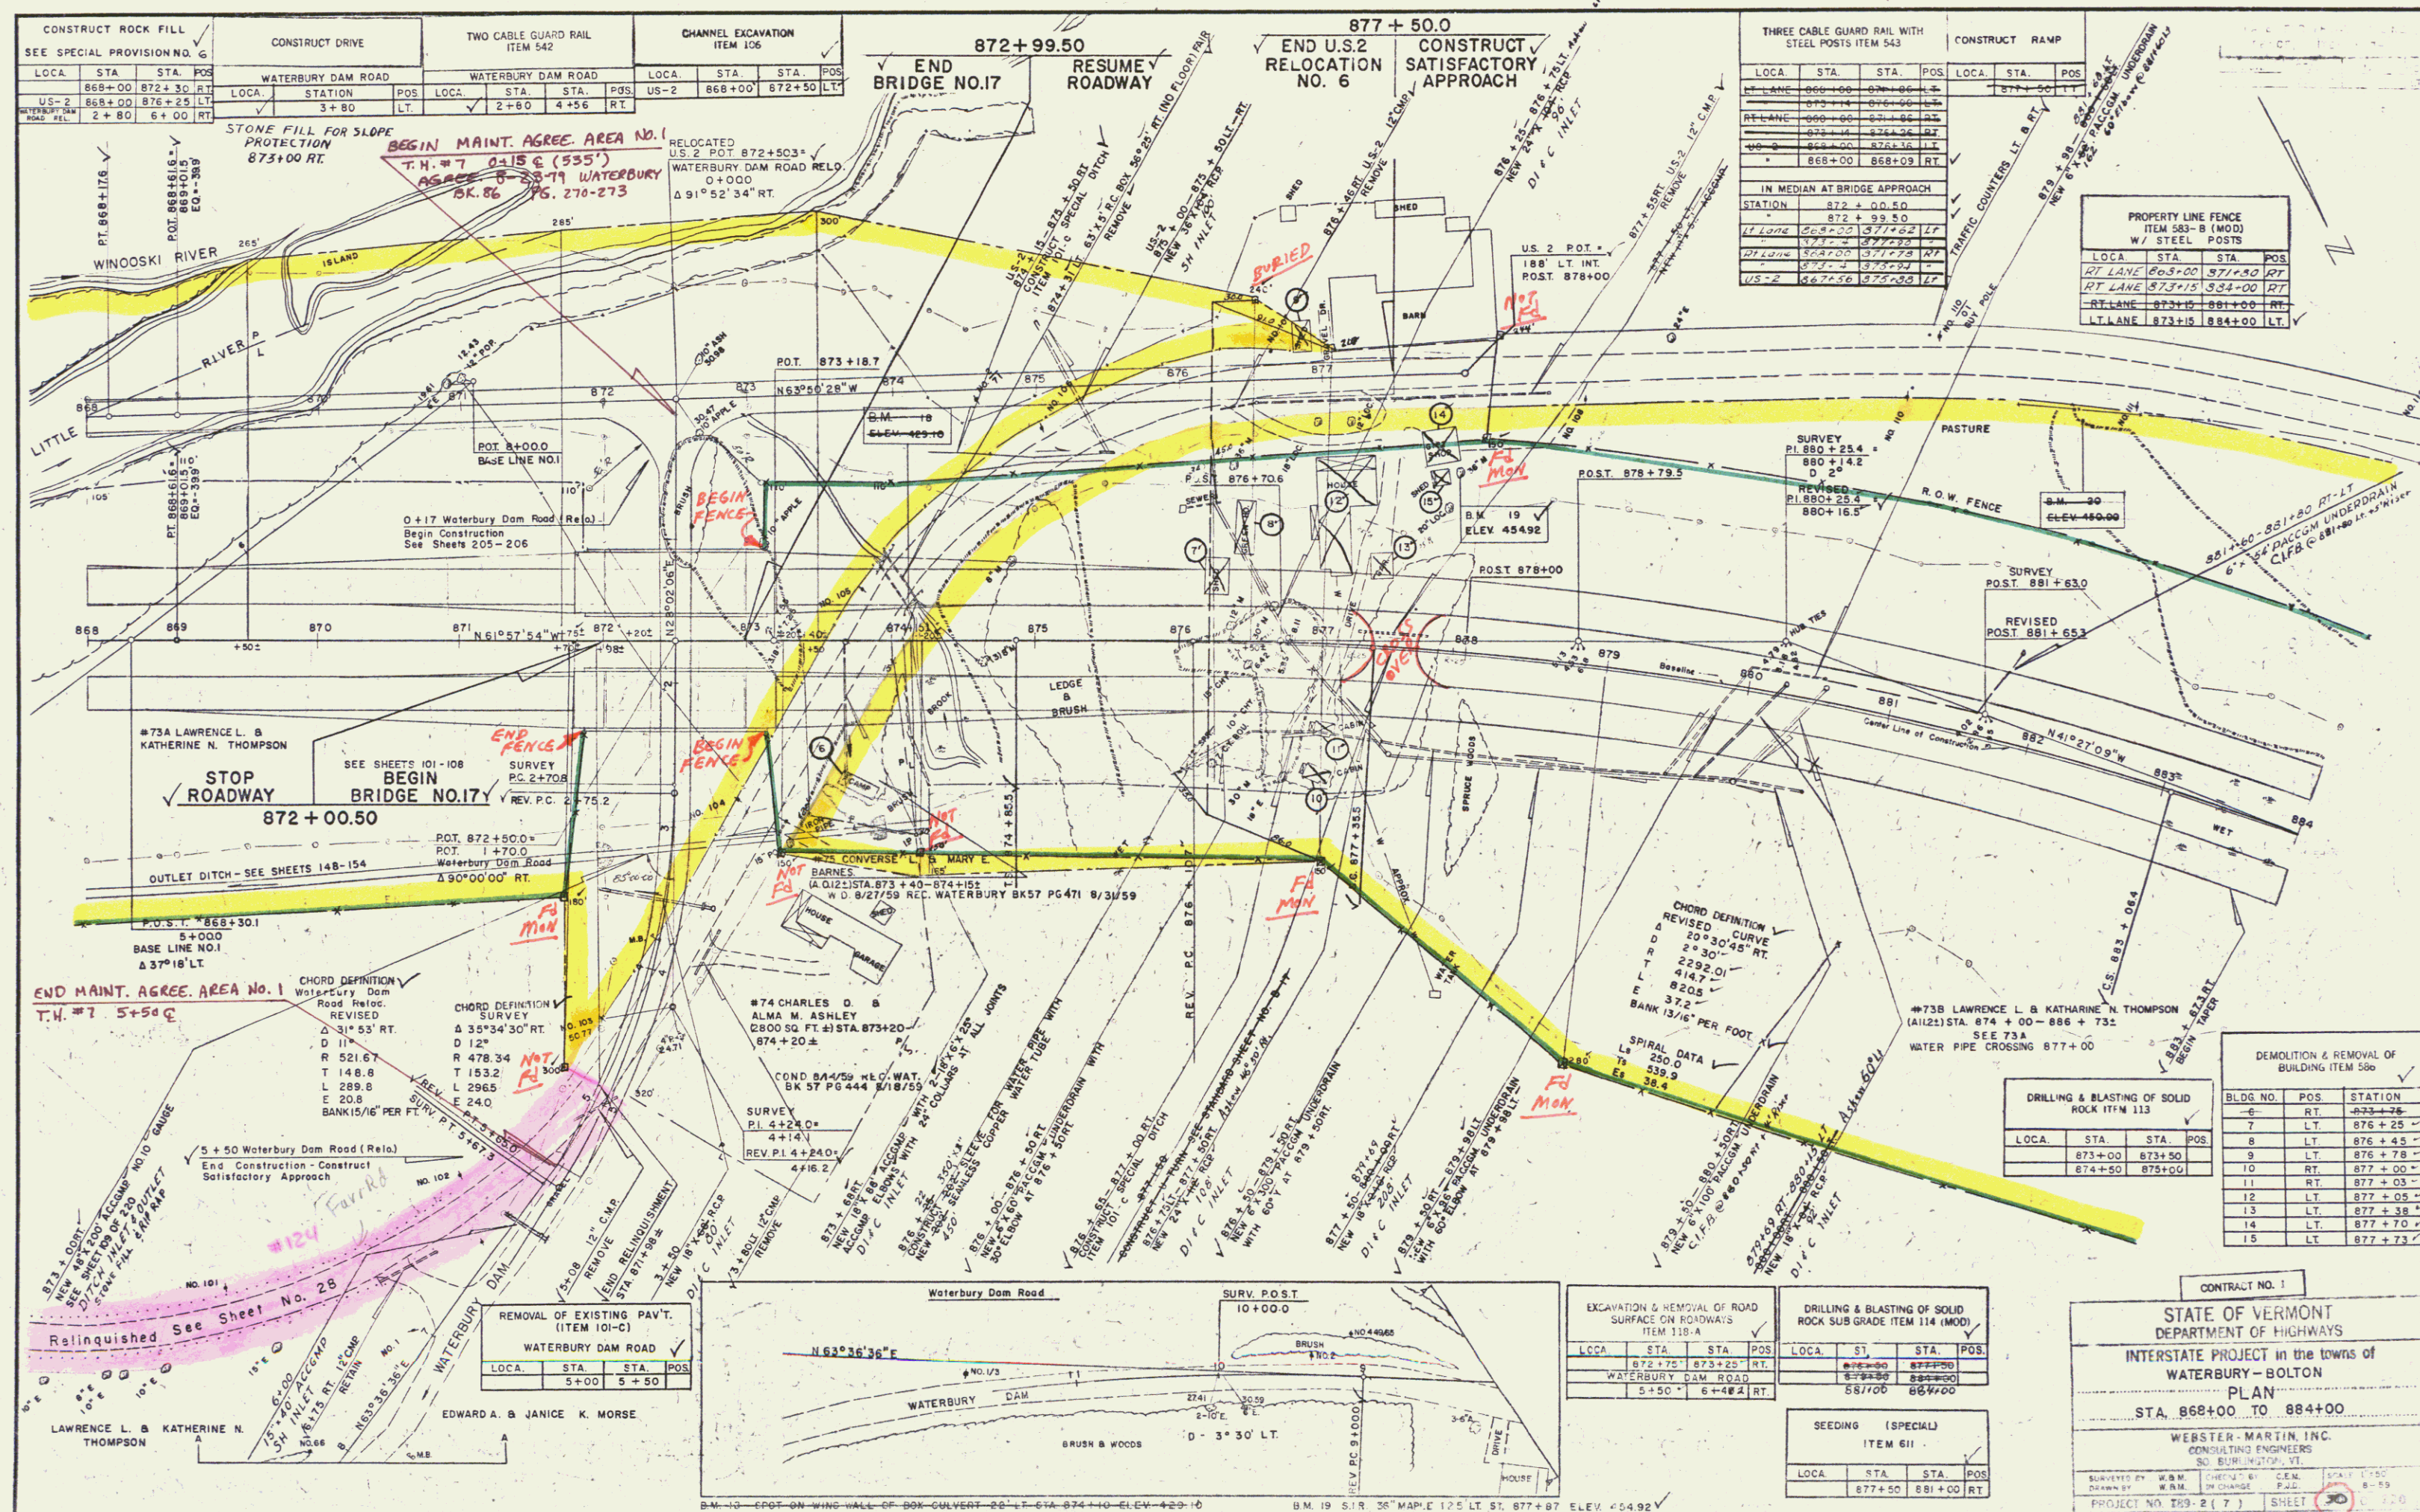

BLDG. NO.	STATION	POS.	LOC.	STA.	STA.	POS.
16	887+43	LT.	RT. LANE	887+00	891+40	LT.
				895+00	900+00	LT.
			RT. LANE	899+00	900+00	RT.
			LT. LANE	889+12	893+72	LT.

THREE CABLE GUARD RAIL WITH
STEEL POSTS ITEM 543

DEMOLITION AND REMOVAL OF
BLDG. ITEM 592


TOPSOIL & SEEDING
ITEMS 621 & 611

LOC.	STA.	STA.	POS.
	889+58	893+92	RT.

PROPERTY LINE FENCE
ITEM 553-B (MOD)

LOC.	STA.	STA.	POS.
	884+00	900+00	RT.
	884+00	900+00	LT.
	884+00	900+00	RT.

STONE FILL FOR SLOPE
PROTECTION
893+22 RT. FL.

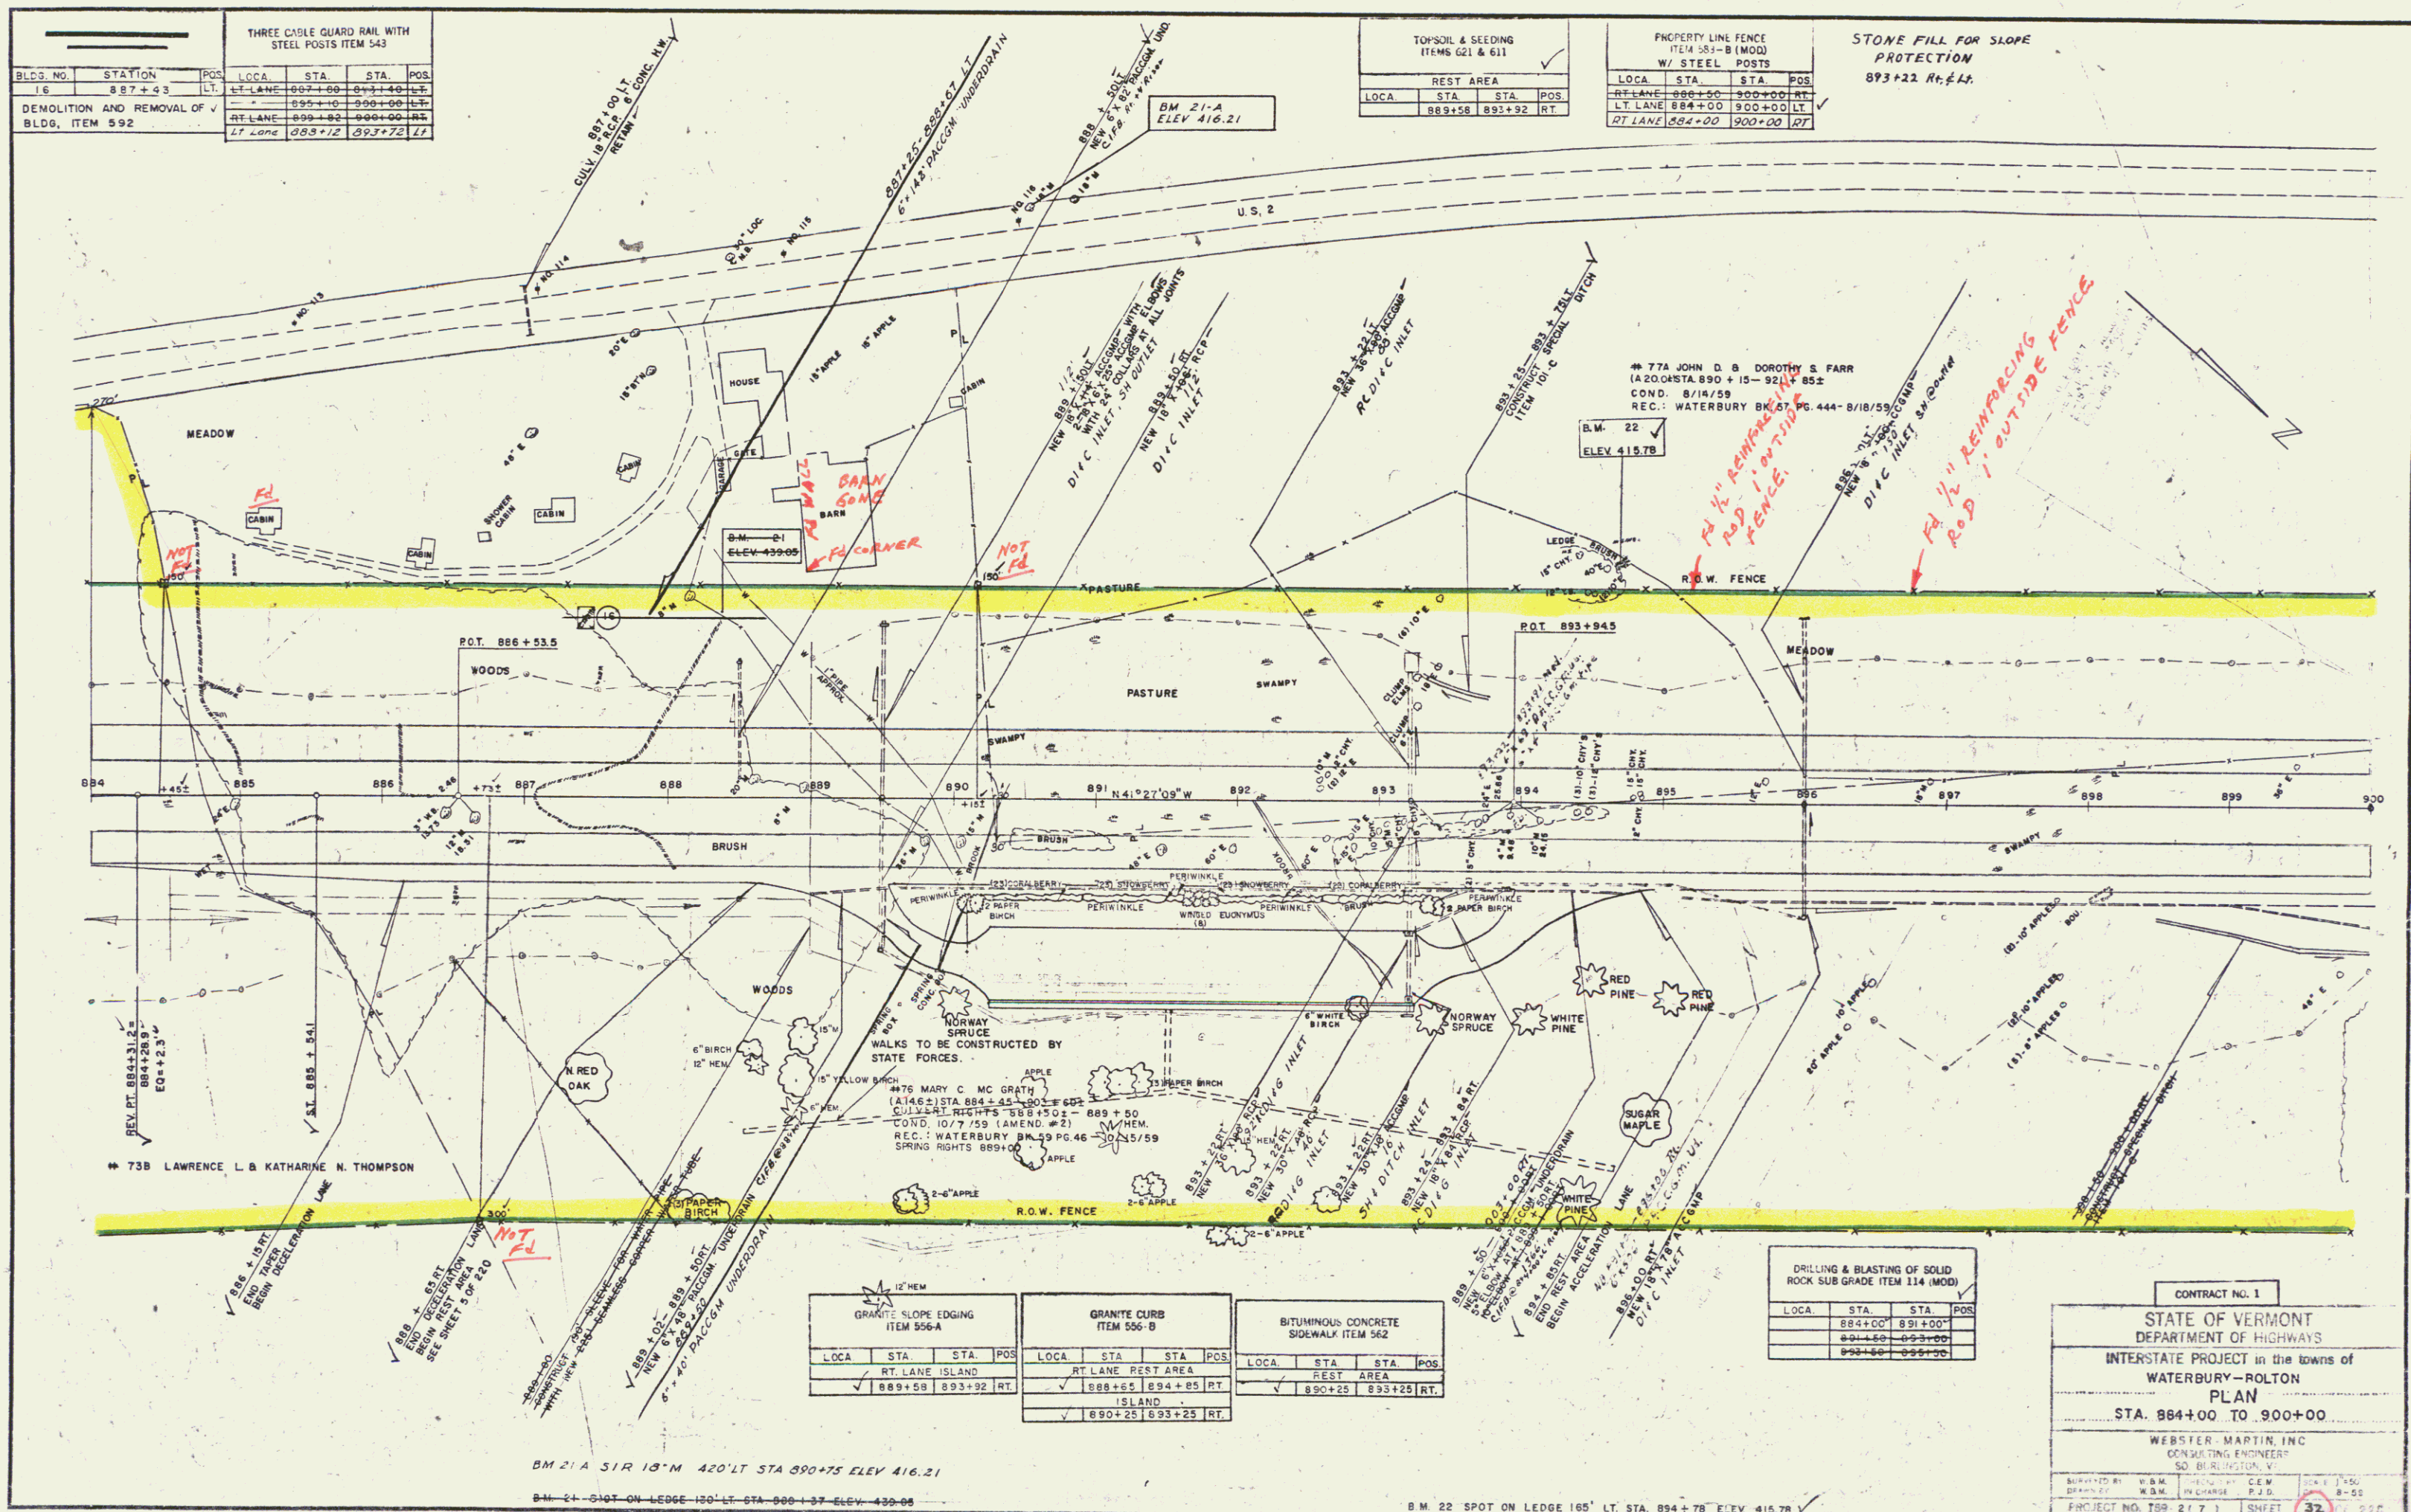

CONTRACT NO. 1

STATE OF VERMONT
DEPARTMENT OF HIGHWAYS


INTERSTATE PROJECT in the towns of
WATERBURY-POLTON

PLAN
STA. 884+00 TO 900+00

WEBSTER MARTIN, INC.
CONSULTING ENGINEER
50 BRISTOL ST., WASHINGTON, V.

DESIGNED BY: W.B.M. DRAWN BY: W.B.M. CHECKED BY: C.E.W. IN CHARGE: P.J.D. DATE: 1/50


PROJECT NO. 199-2(7) SHEET 32 OF 220

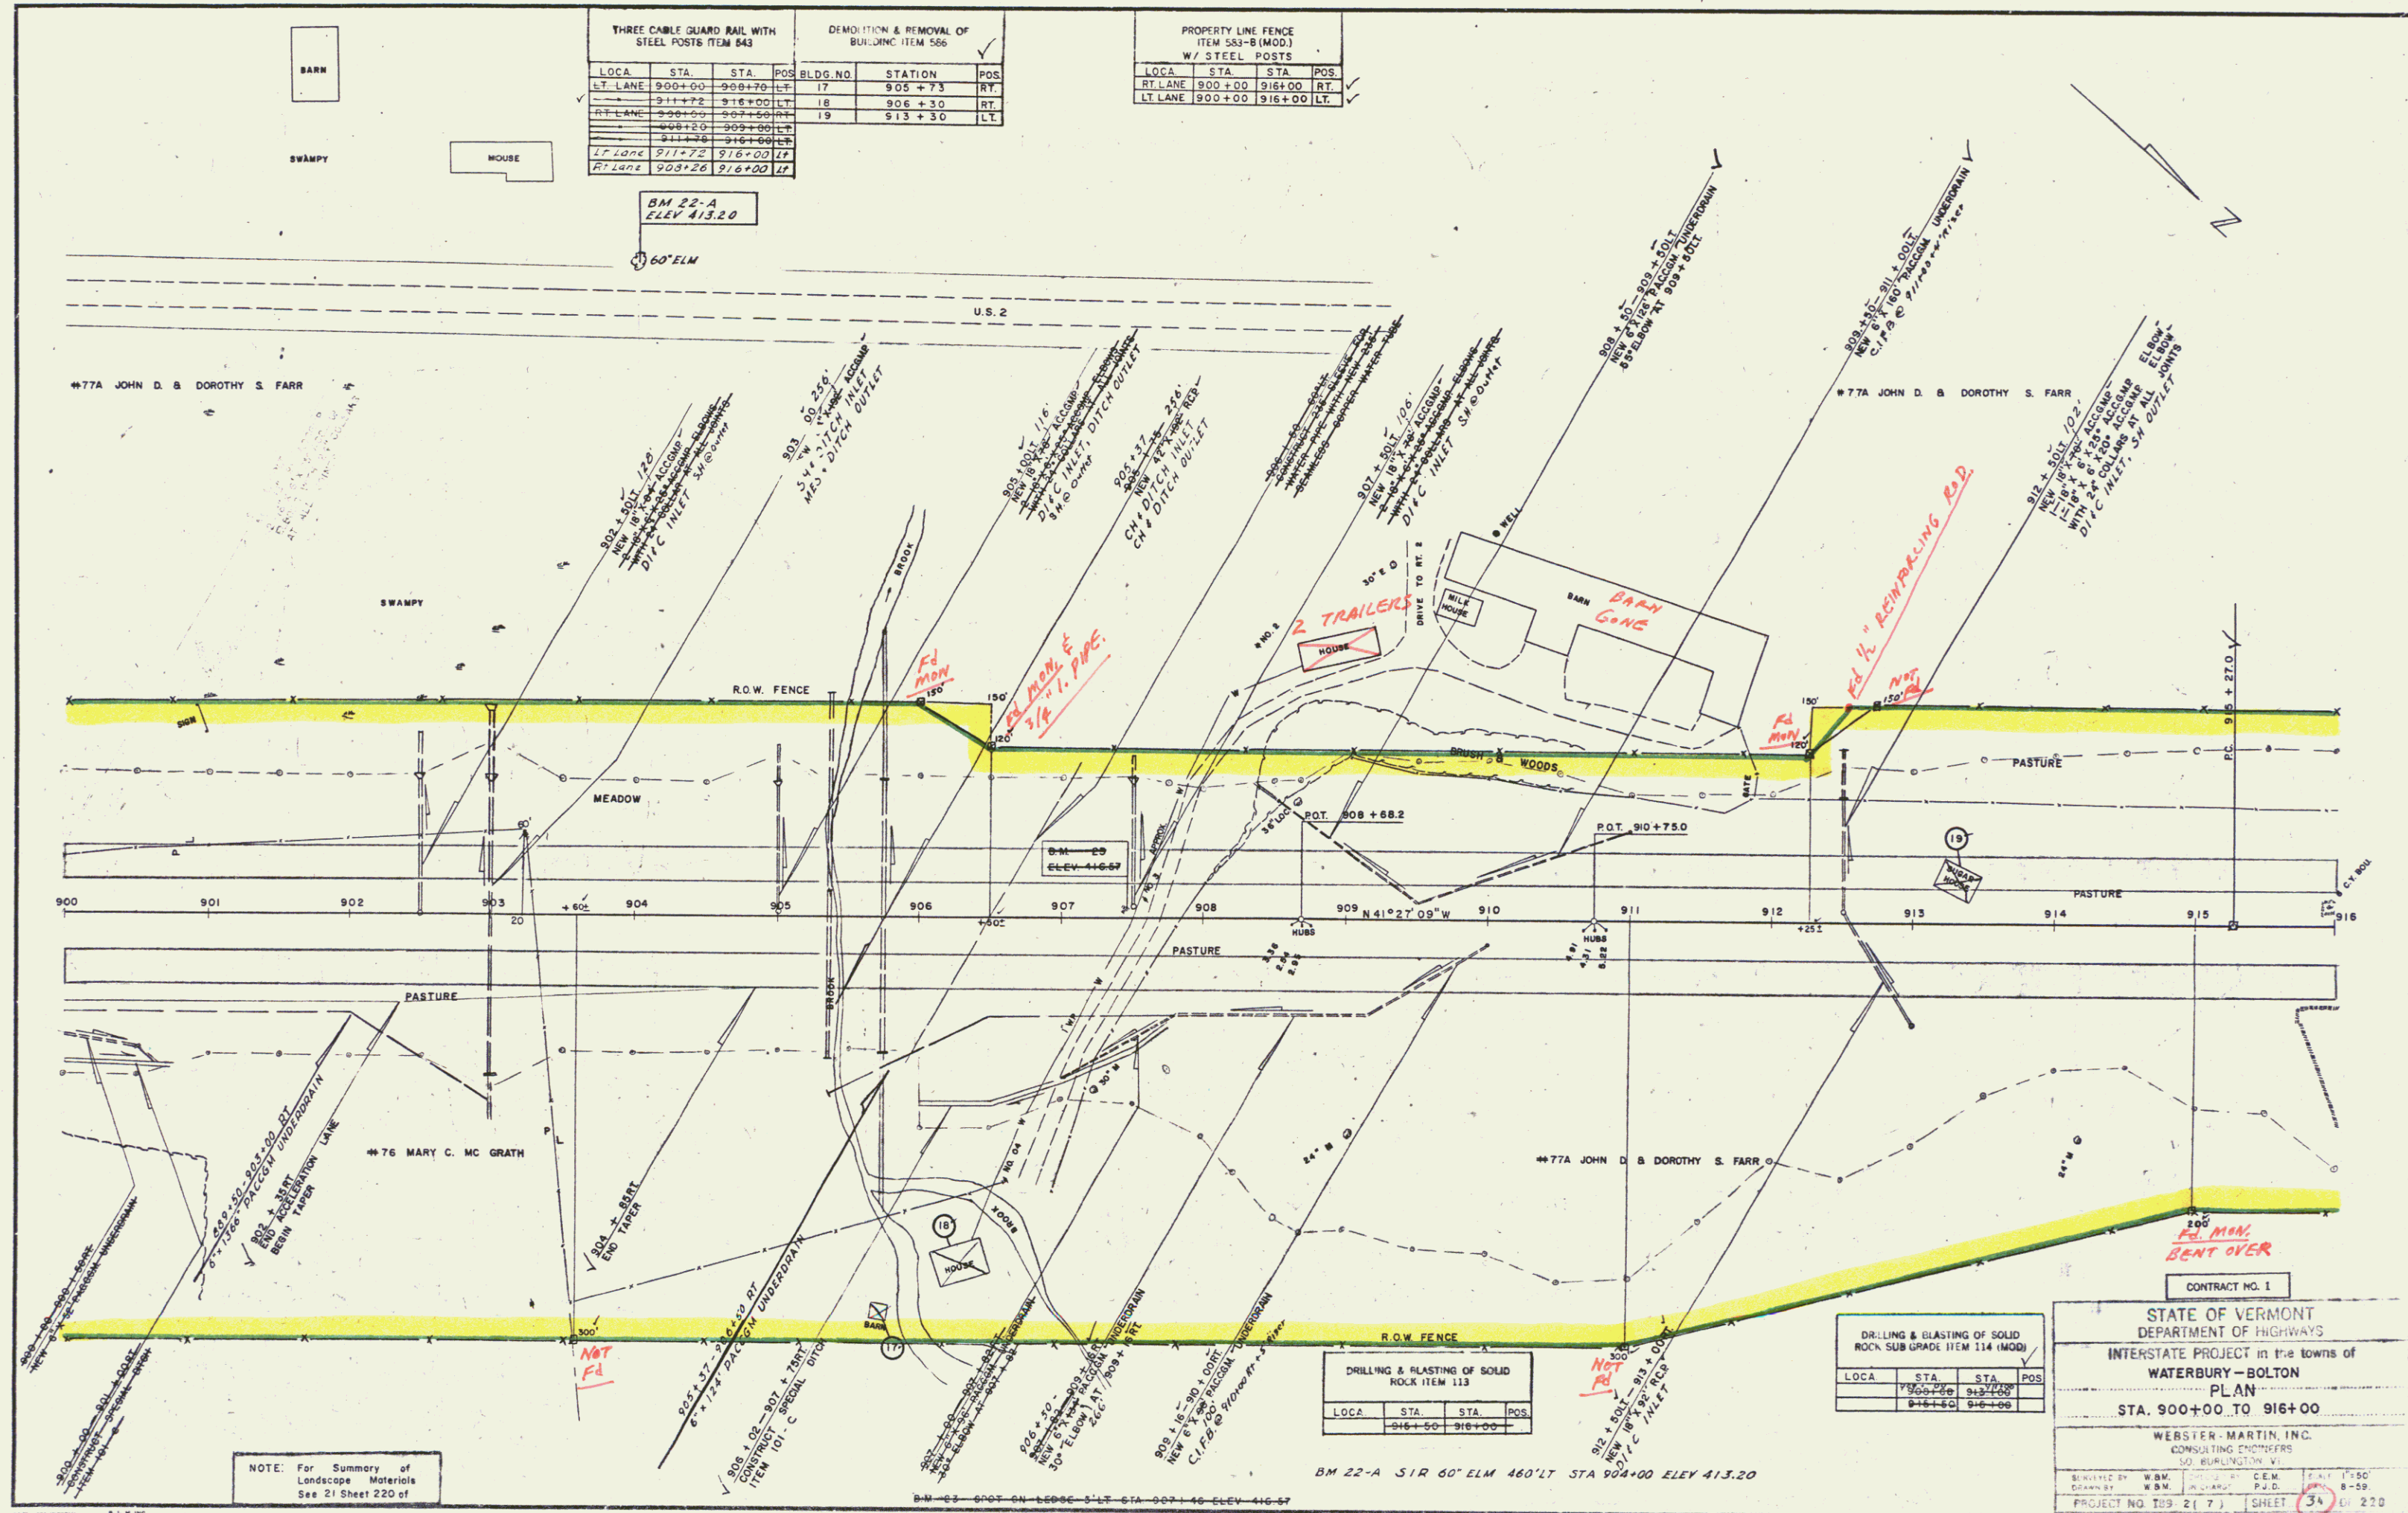

THREE CABLE GUARD RAIL WITH STEEL POSTS ITEM 543				DRILLING & BLASTING OF SOLID ROCK SUBGRADE ITEM 114 (MOD)				SOIL REMOVAL ITEM 101				PROPERTY LINE FENCE ITEM 543-B (MOD) W/STEEL POSTS			
LOC.	STA.	STA.	POS.	LOC.	STA.	STA.	POS.	LOC.	STA.	STA.	POS.	LOC.	STA.	STA.	POS.
LT. LANE	916+00	922+28	7		916+00	919+00			916+00	930+00			916+00	930+00	RT
RT. LANE	916+00	918+50	1		919+00	920+28			916+00	927+50			916+00	927+50	LT
					921+75	924+00									
					924+00	930+00									

CONTRACT NO. 2
MAINTENANCE OF TRAFFIC
CONSTRUCT TEMP. ROADWAY
STA. 9+00 - STA. 11+50 LT
SEE SPECIAL PROVISION NO. 5
SEE SHEETS TO

THREE CABLE GUARD RAIL WITH STEEL POSTS ITEM 543			
LOC.	STA.	STA.	POS.
RT. LANE	931+84	932+00	LT
US-2	10+00	11+50	LT

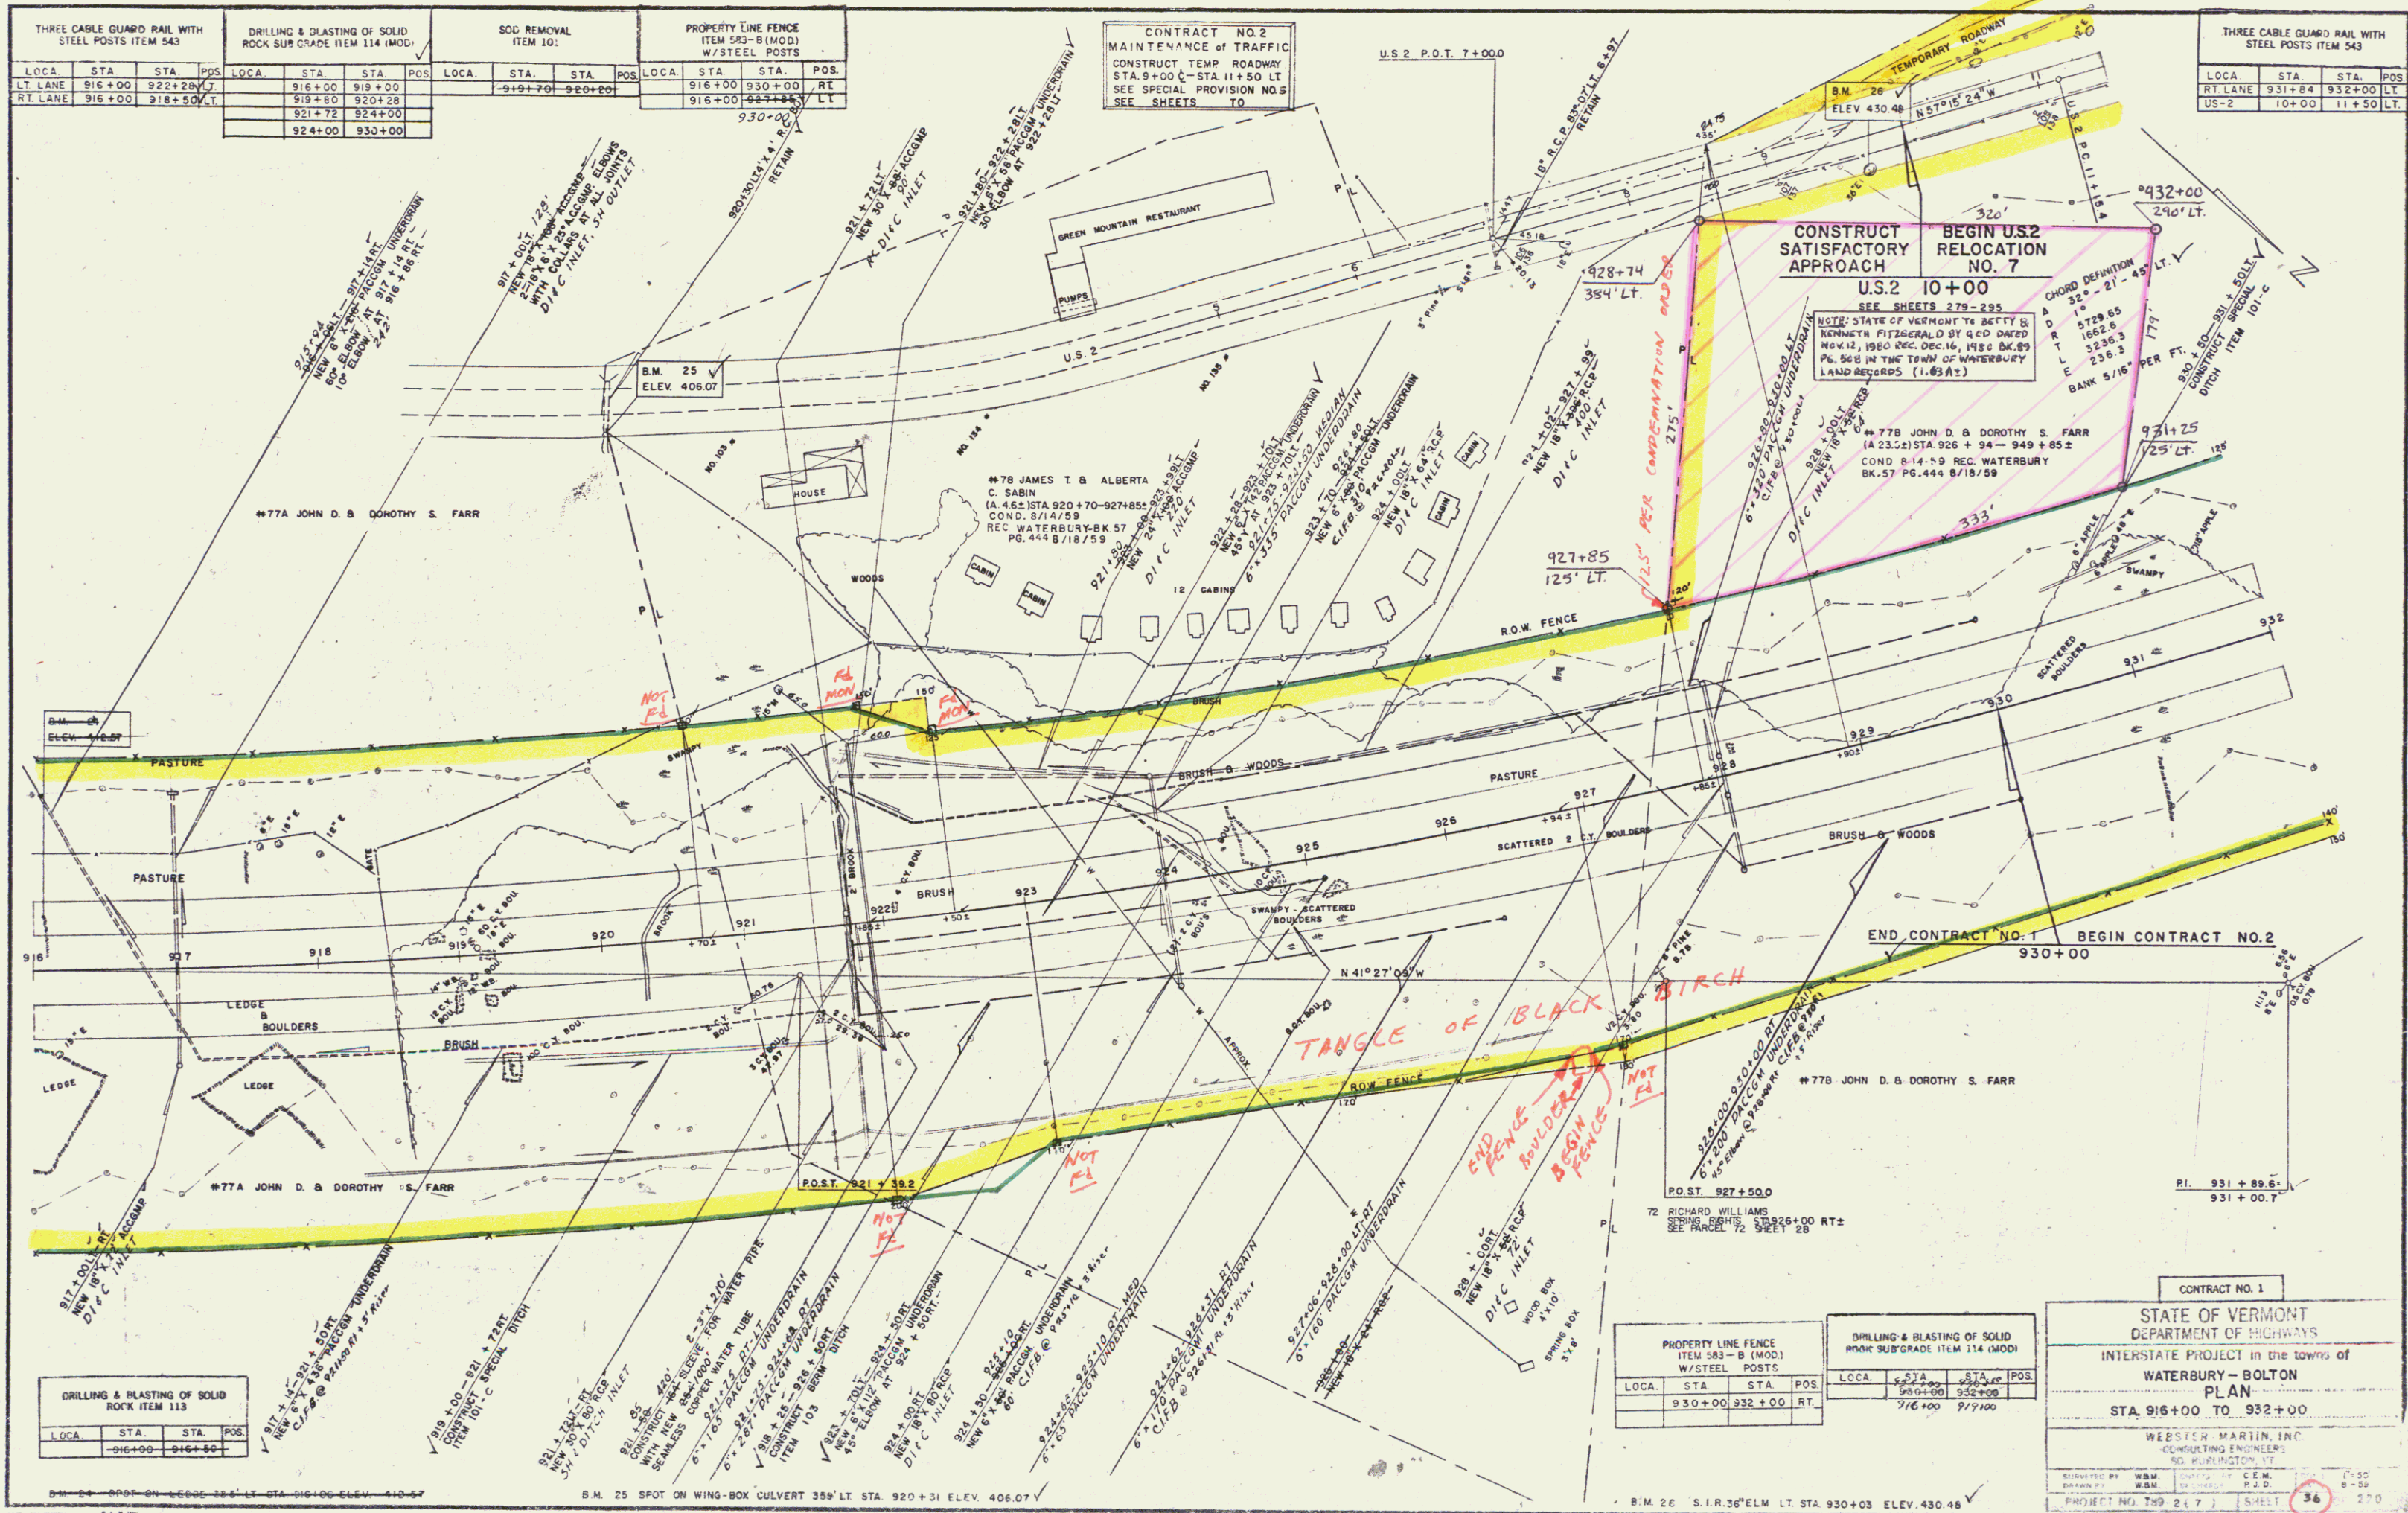

PROPERTY LINE FENCE ITEM 543-B (MOD) W/STEEL POSTS			
LOC.	STA.	STA.	POS.
	930+00	932+00	RT

DRILLING & BLASTING OF SOLID ROCK SUBGRADE ITEM 114 (MOD)			
LOC.	STA.	STA.	POS.
	916+00	932+00	

CONTRACT NO. 1

STATE OF VERMONT
DEPARTMENT OF HIGHWAYS

INTERSTATE PROJECT in the town of
WATERBURY - BOLTON


PLAN
STA. 916+00 TO 932+00


WEBSTER MARTIN, INC.
CONSULTING ENGINEERS
50 WASHINGTON ST.
BURLINGTON, VT.

DESIGNED BY: W.M. CHECKED BY: C.E.M.
DRAWN BY: W.M. P.L.D.

PROJECT NO. 759 (217) SHEET 36 OF 270

ACQUIRED FROM JOHN D. & DOROTHY S. FARR BY COND.
ON AUGUST 14, 1959. RECORDED IN BK. 57, PG. 444 ON
AUGUST 18, 1959, TOWN OF WATERBURY.

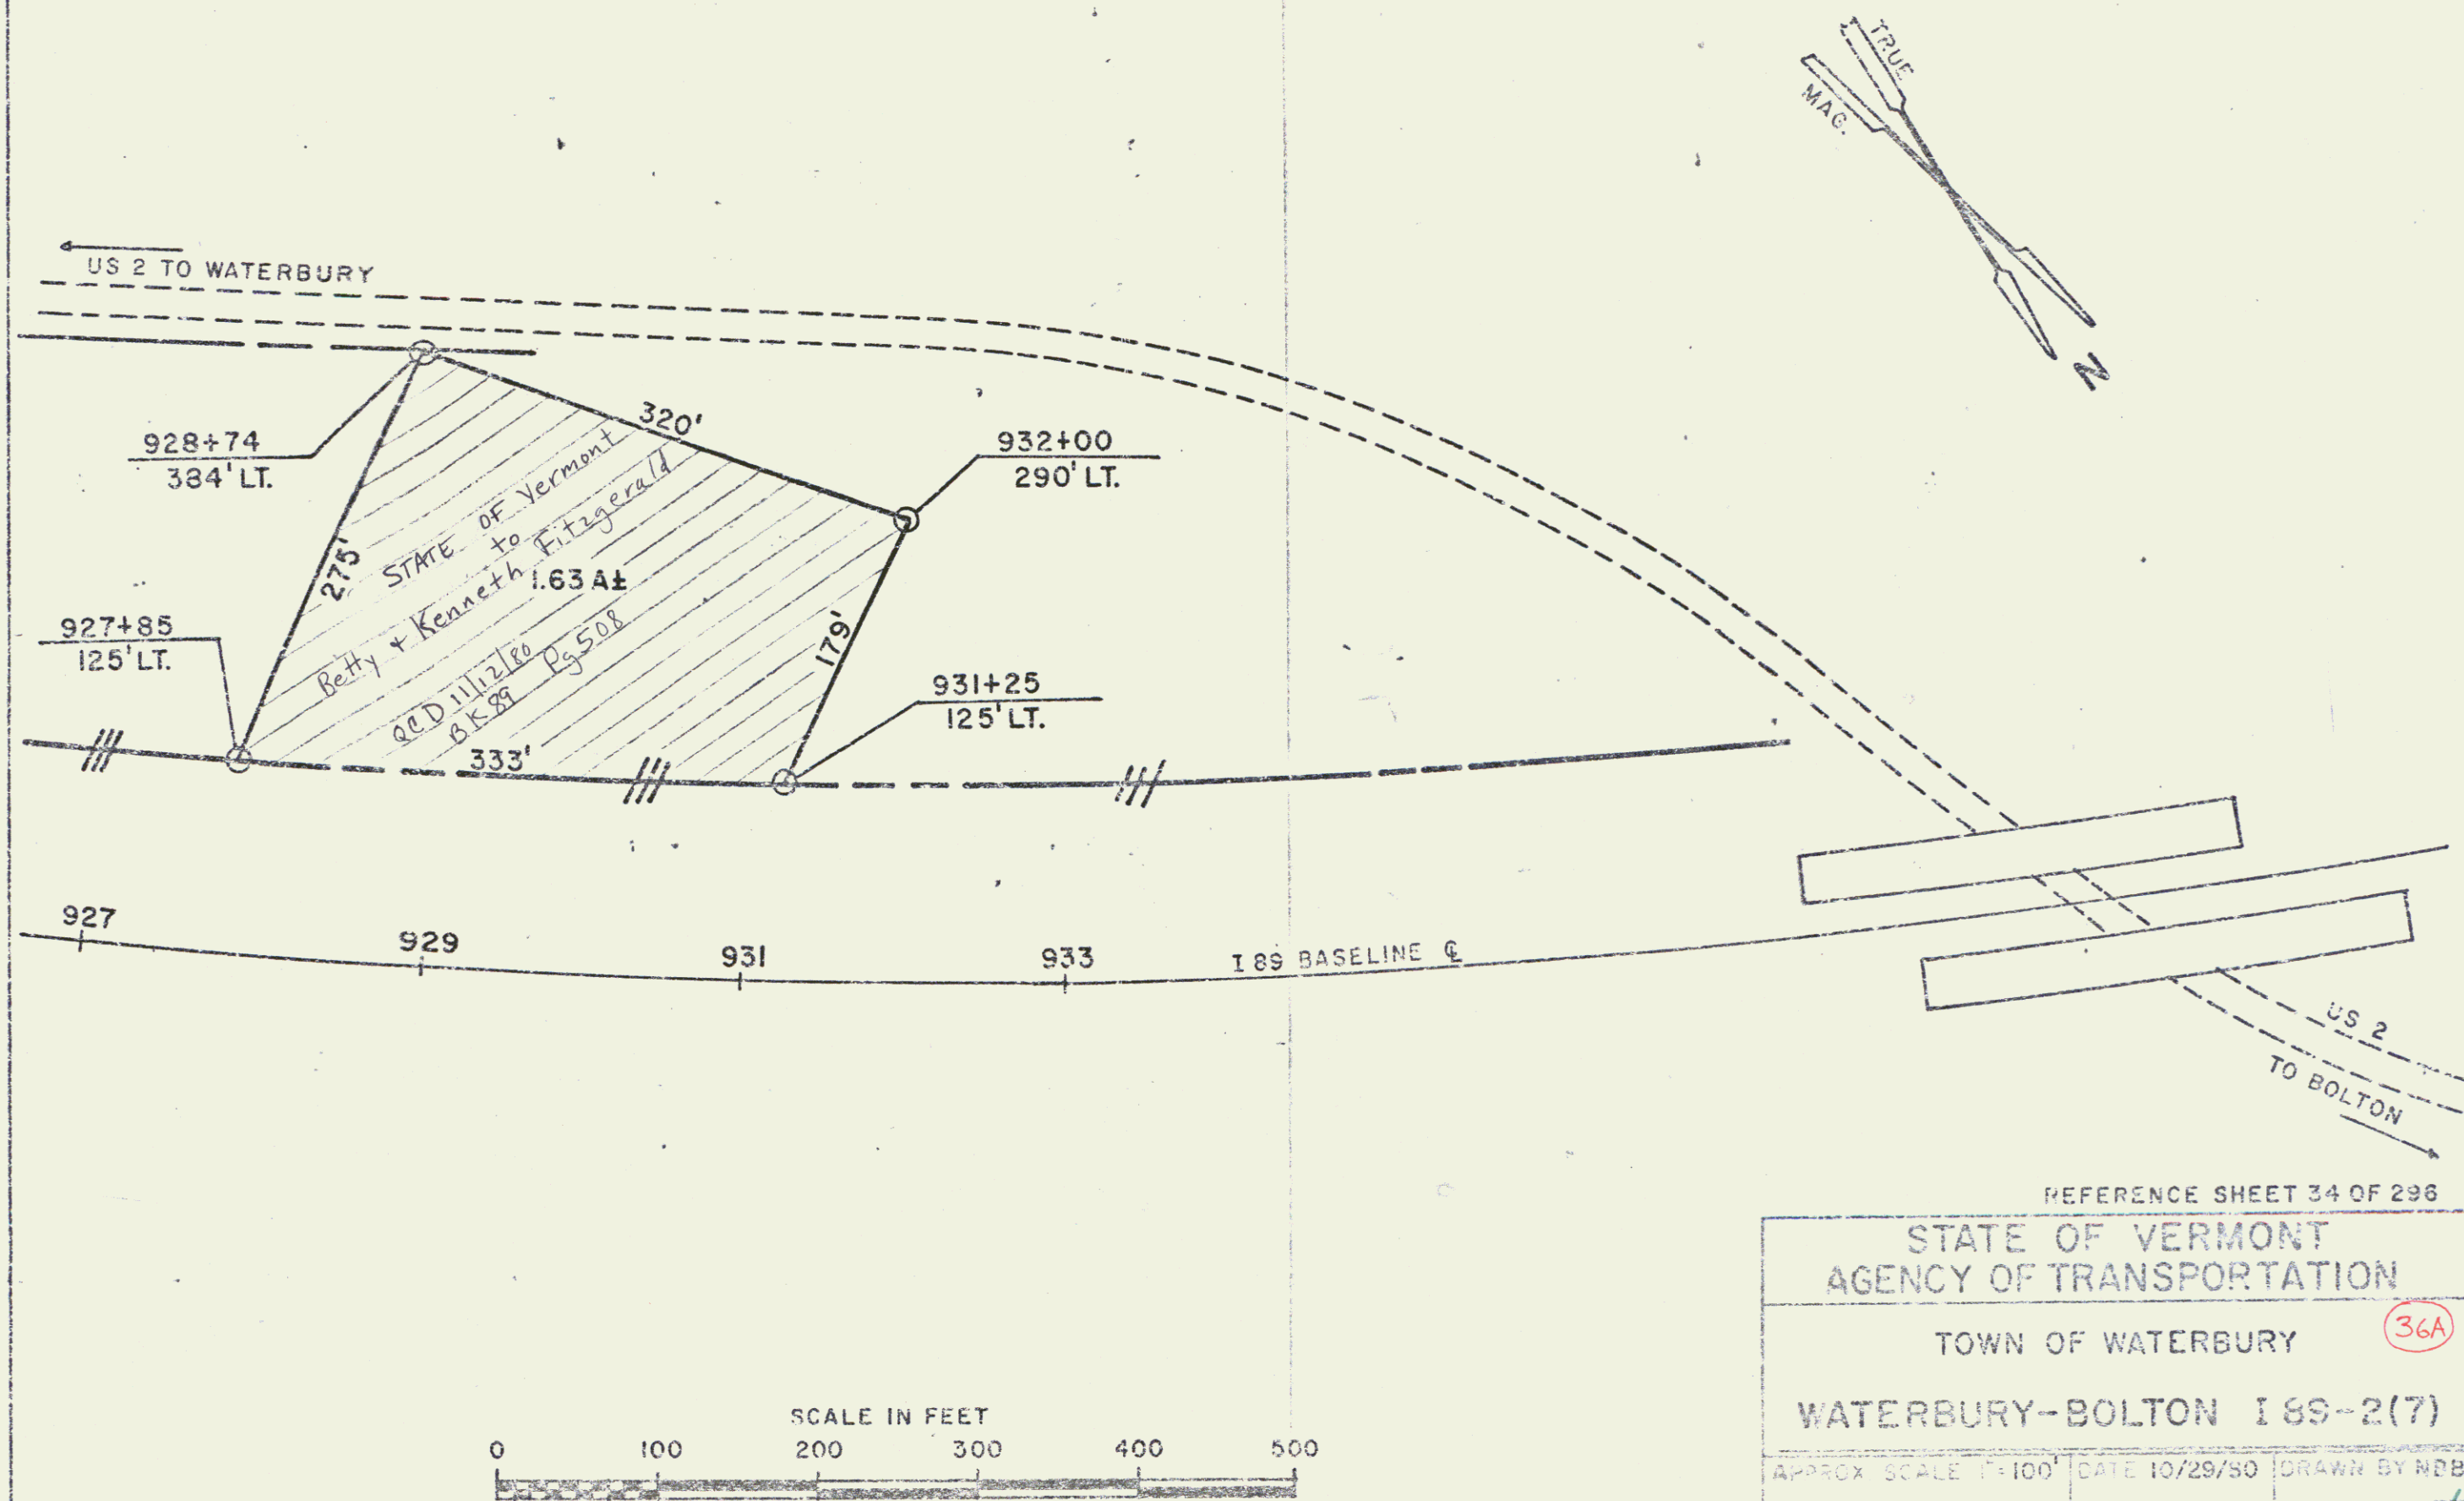

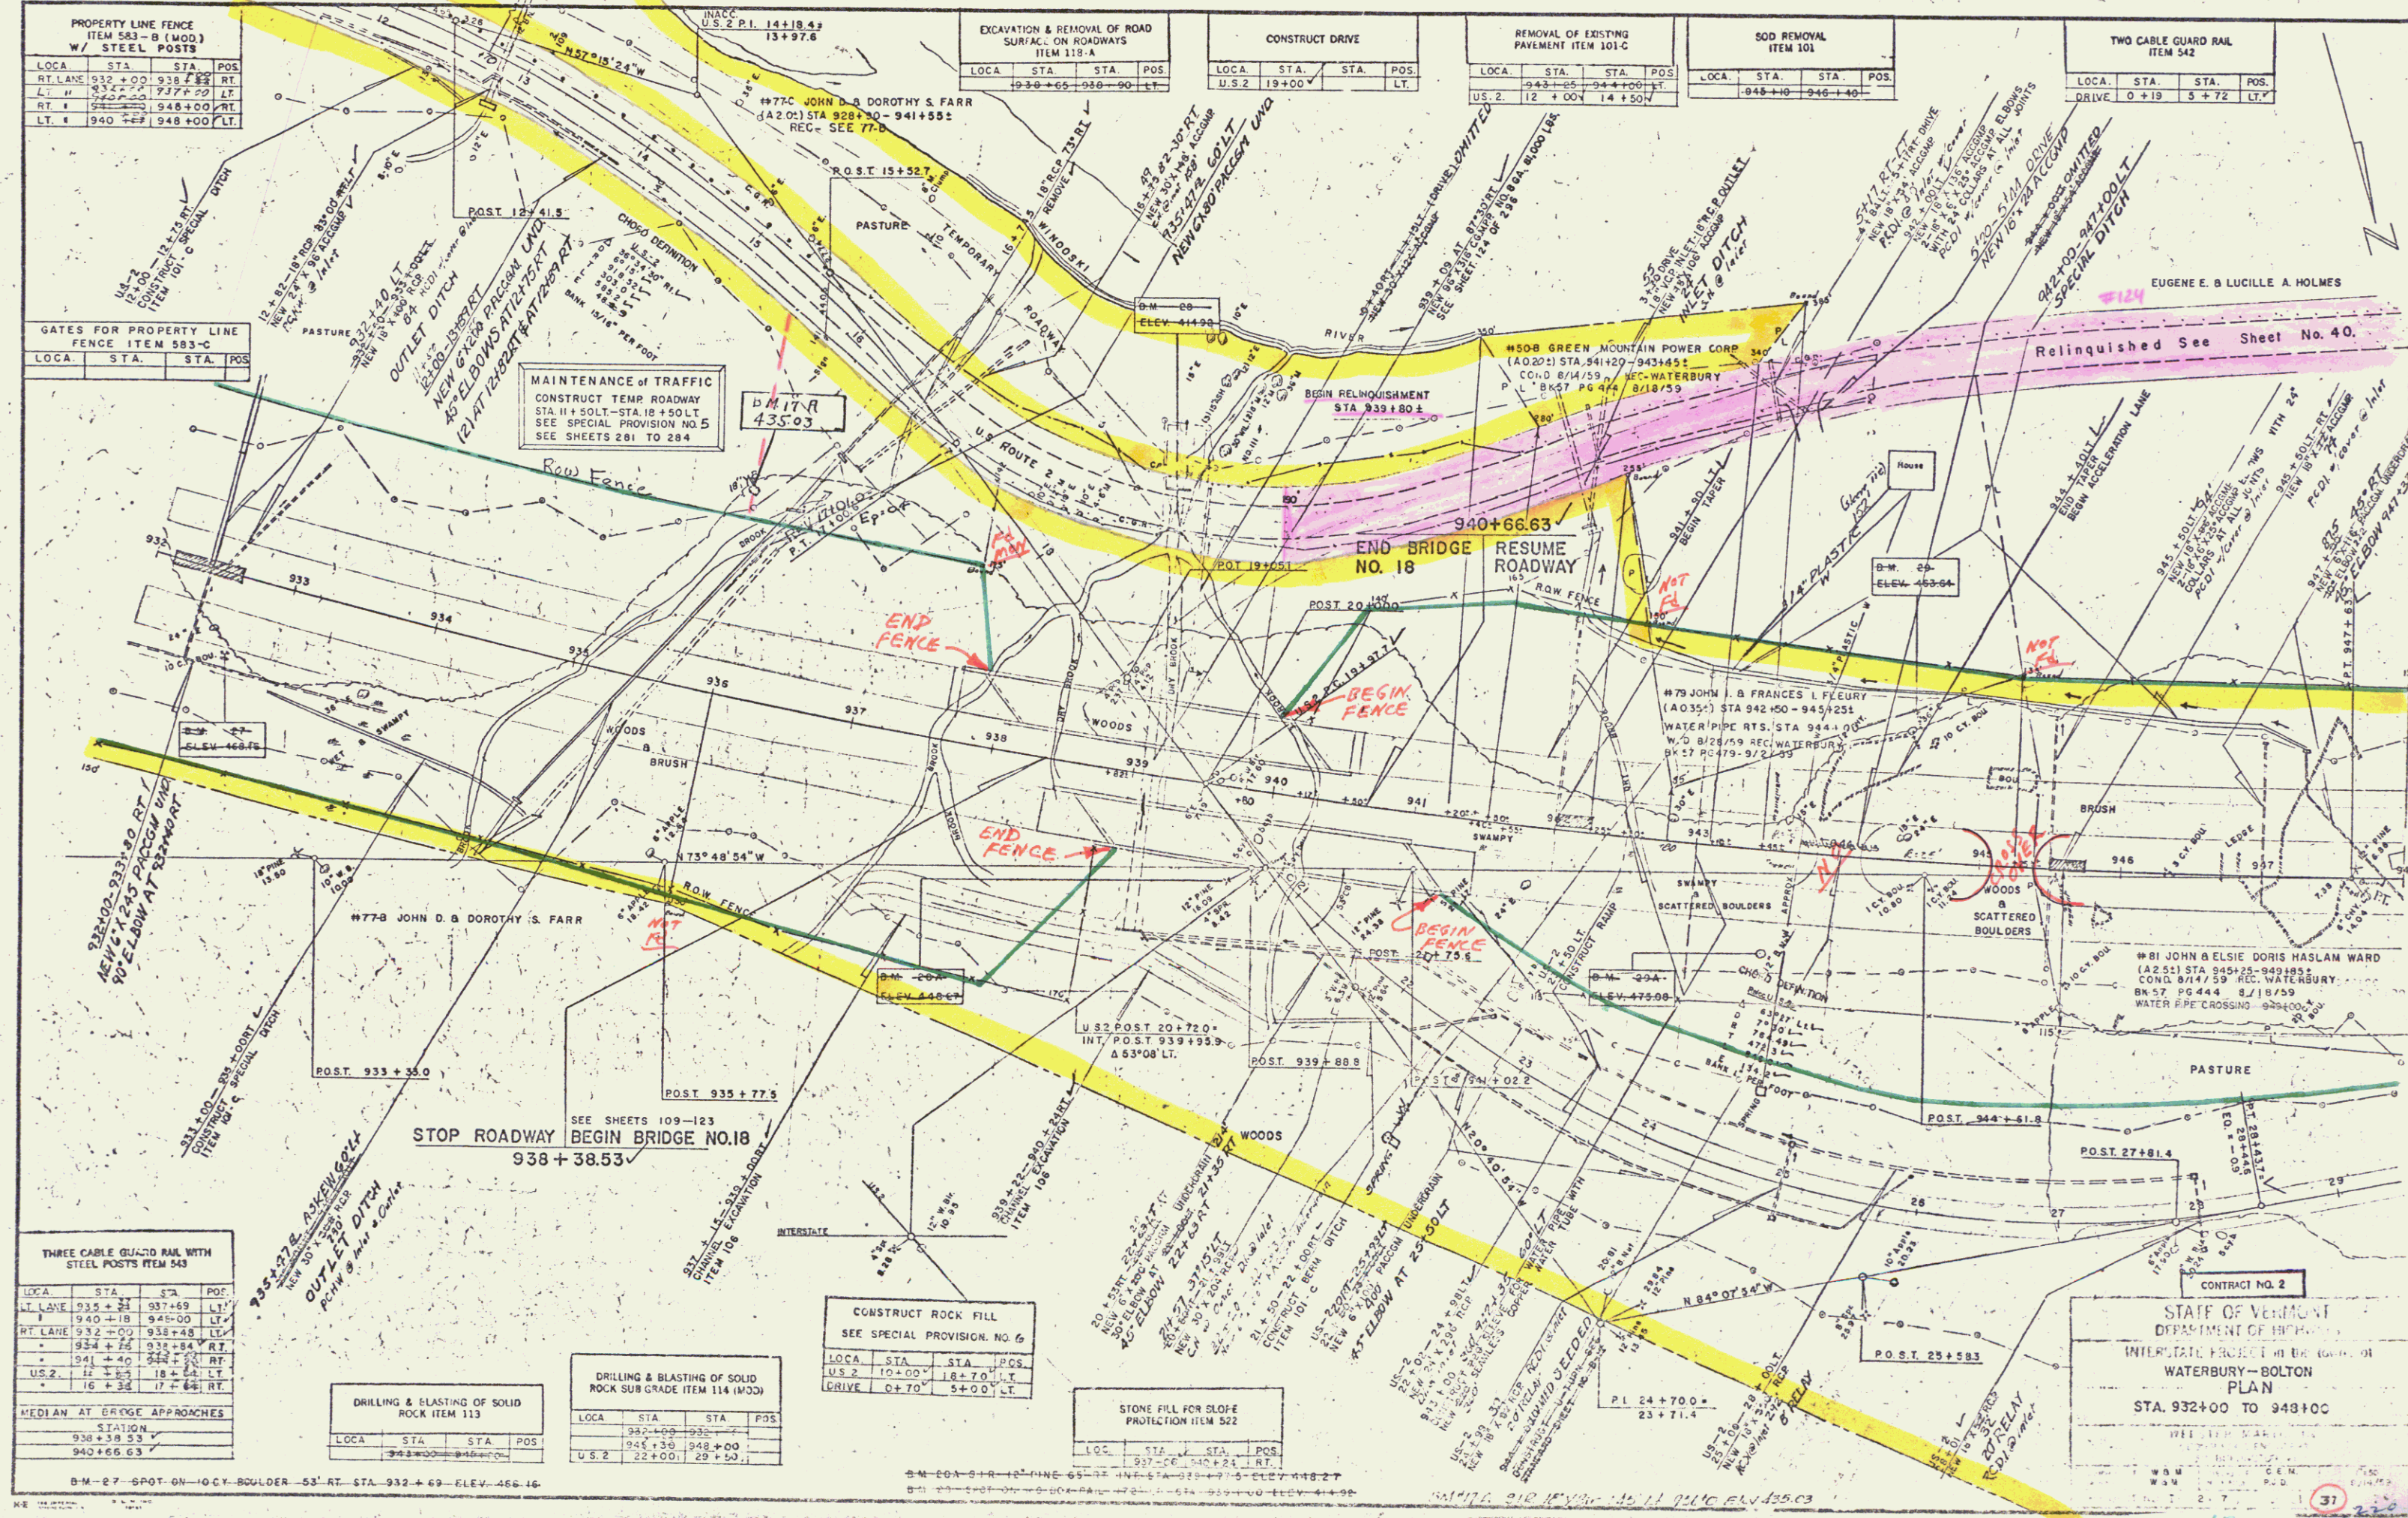

CONTRACT NO. 2
 STATE OF VERMONT
 DEPARTMENT OF HIGHWAYS
 INTERSTATE PROJECT in the town of
 WATERBURY - BOLTON
 PLAN
 STA. 932+00 TO 949+00


DEMOLITION & REMOVAL OF BUILDING ITEM 566				PROPERTY LINE FENCE ITEM 563-B (MOD.) W/ STEEL POSTS				PROPERTY LINE FENCE ITEM 563-B (MOD.) W/ STEEL POSTS			
BLDG. NO.	STA.	POS.	LOC.	STA.	POS.	LOC.	STA.	POS.	LOC.	STA.	POS.
NO. 20	948+00	LT.	RT. LANE	948+00	RT.	RT. LANE	948+00	LT.	RT. LANE	948+00	RT.

NOTE: For Summary of Landscape Materials See Sheet 34 of 296

EUGENE E. & LUCILLE A. HOLMES

PLANK GUARD RAIL WITH PRESERVATIVE TREATMENT ITEM 541-A (BARRICADE)			
LOCATION	STA.	POS.	LOC.
	959+00	LT.	

Control of section of U.S. Route 2 beginning at a point in the center line of said highway, 1.193 miles easterly from the believed Waterbury-Bolton Town Line, 190 feet southwesterly from survey sta. 939+80 and 152 southwesterly at right angle from side line survey sta. 13+80 of Highway Project 1 89-2(2) Montpelier-Williston, thence 2.218 miles westerly along Rte. 2 survey sta. 961+80 is hereby relinquished to the Town of Waterbury and recorded in Book 61, Page 39.

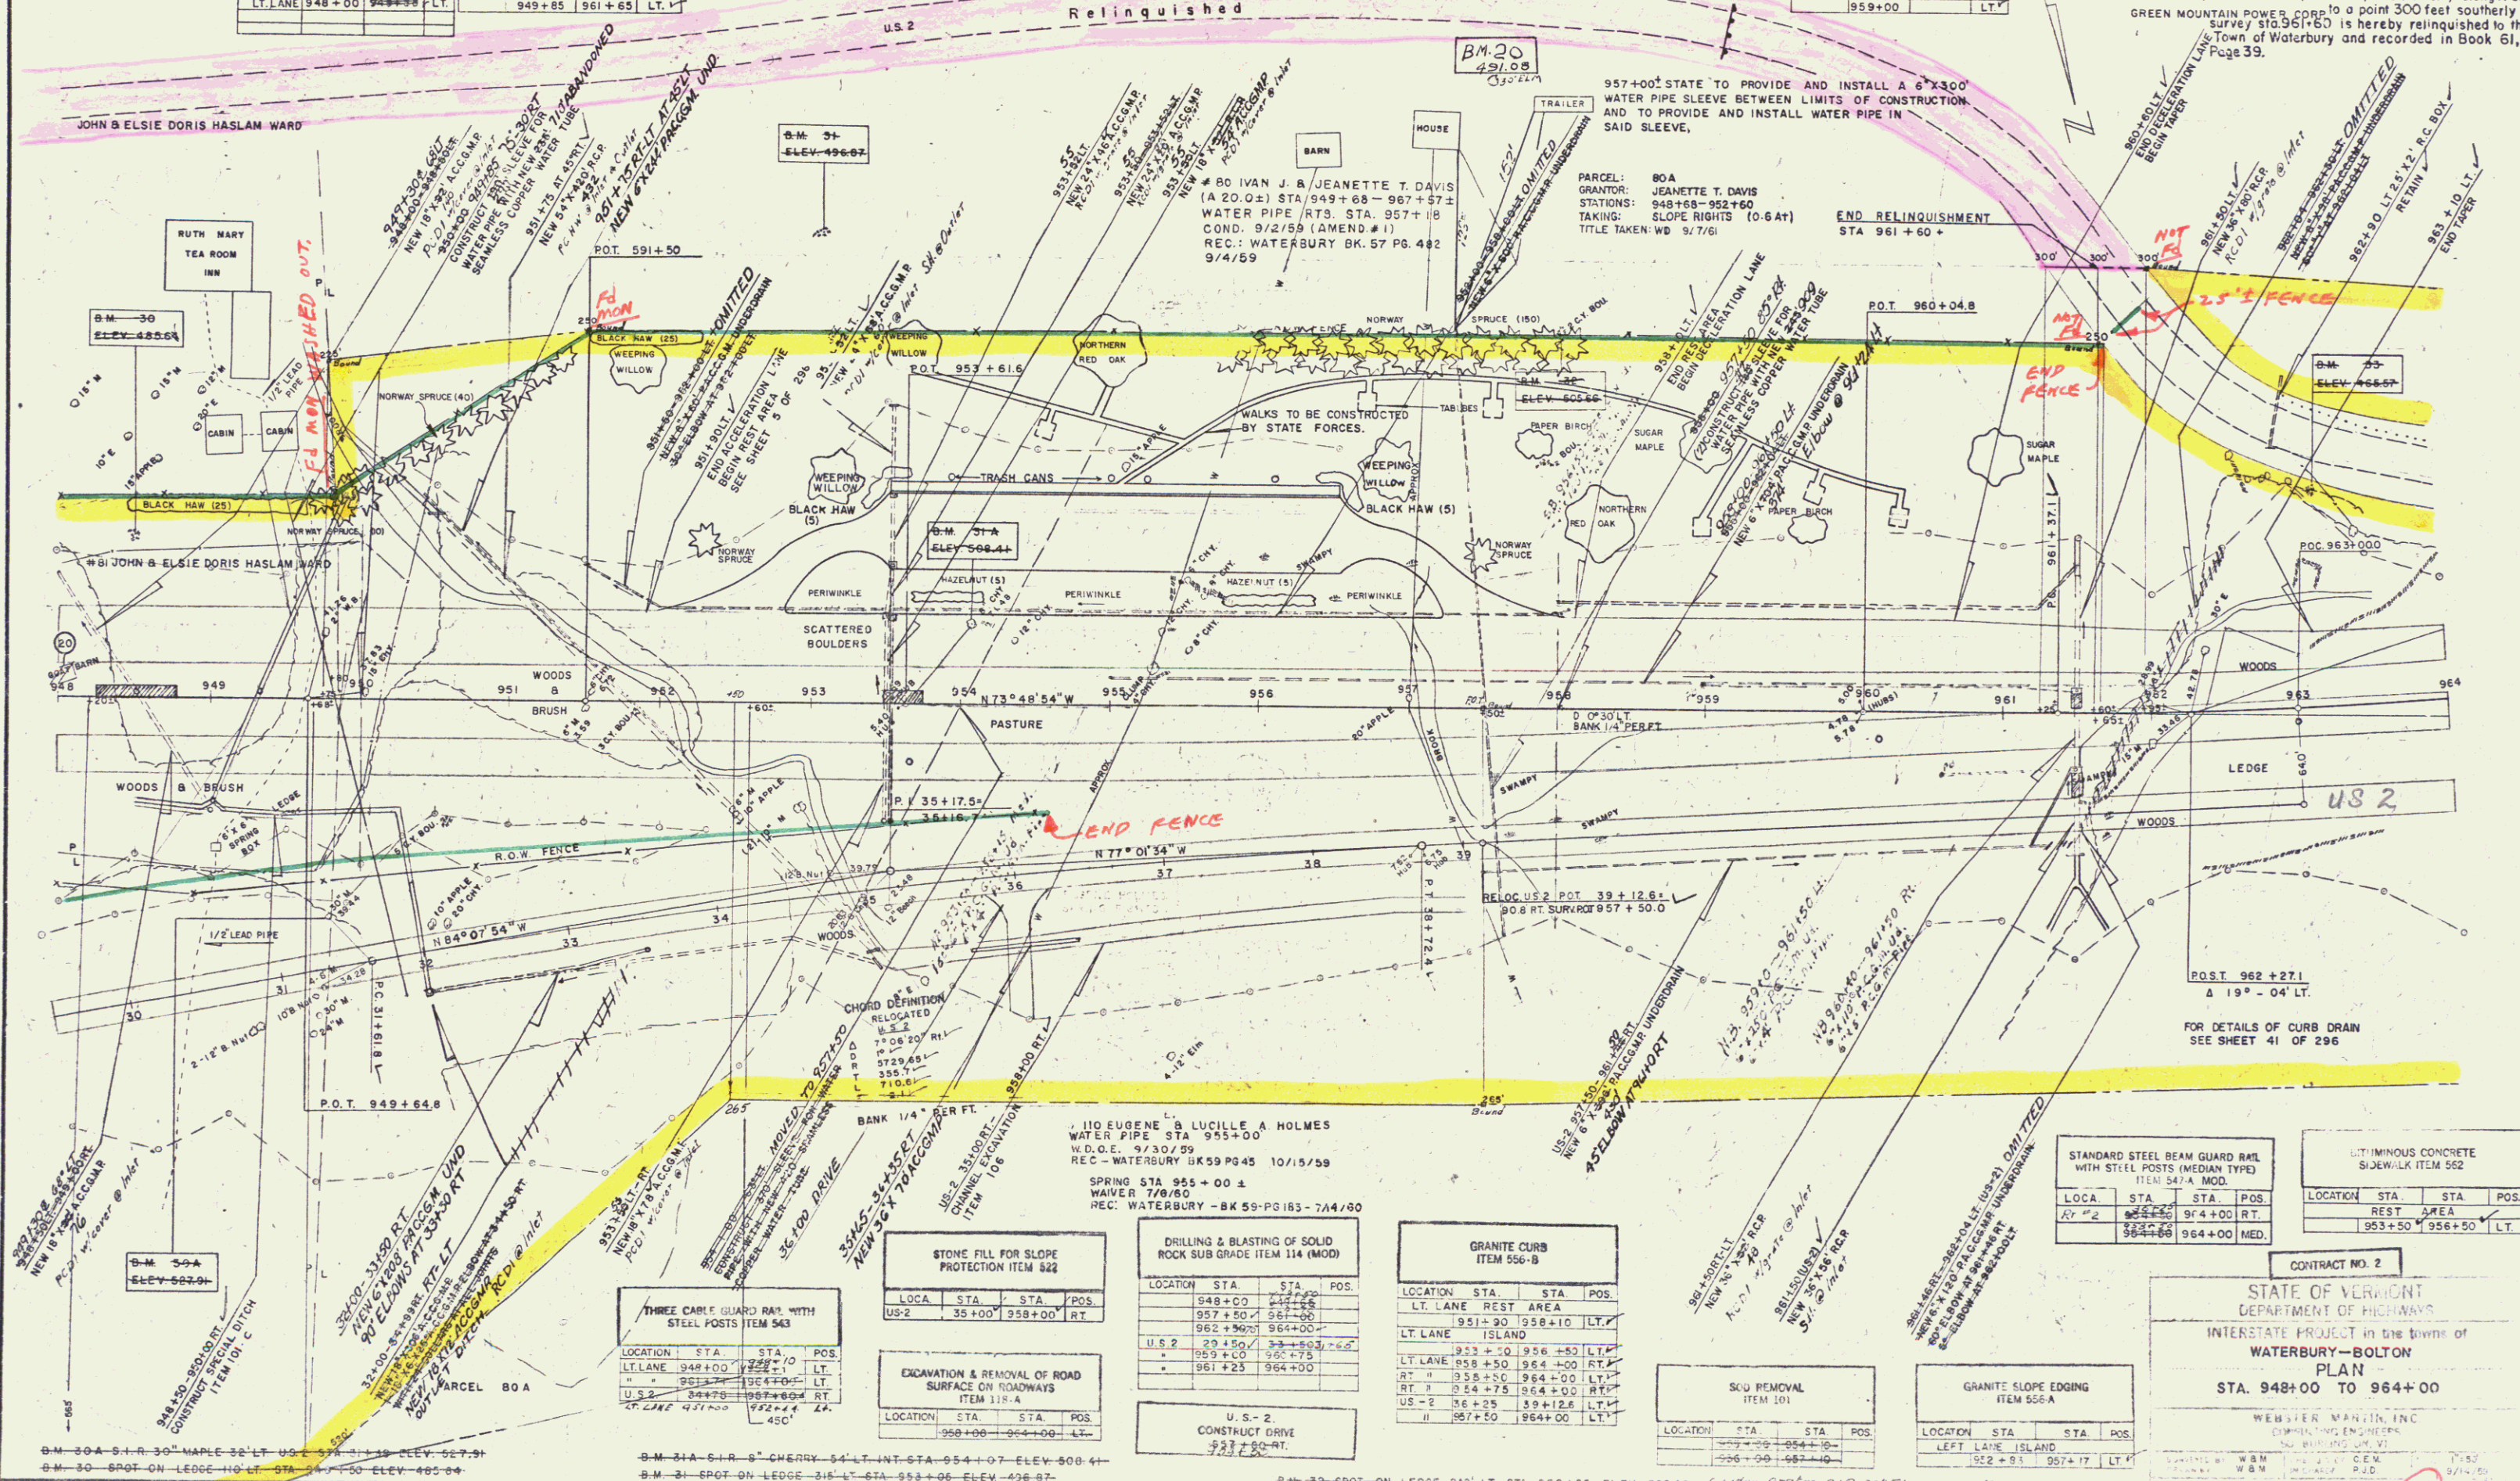



STANDARD STEEL BEAM GUARD RAIL WITH STEEL POSTS (MEDIAN TYPE) ITEM 547-A MOD.			
LOC.	STA.	POS.	LOC.
RT. LANE	954+00	RT.	
	954+00	MED.	

CONTINUOUS CONCRETE SIDEWALK ITEM 562			
LOCATION	STA.	POS.	LOC.
	953+50	RT.	
	953+50	LT.	


CONTRACT NO. 2
STATE OF VERMONT
DEPARTMENT OF HIGHWAYS
INTERSTATE PROJECT IN THE TOWNS OF
WATERBURY-BOLTON
PLAN
STA. 948+00 TO 964+00

WEBSTER MARTIN, INC.
CONSULTING ENGINEER
NO. 100 Rte. 100
WATERBURY, VT. 05671
DATE: 9/14/59
PROJECT NO. 1-89-2(2) SHEET 40

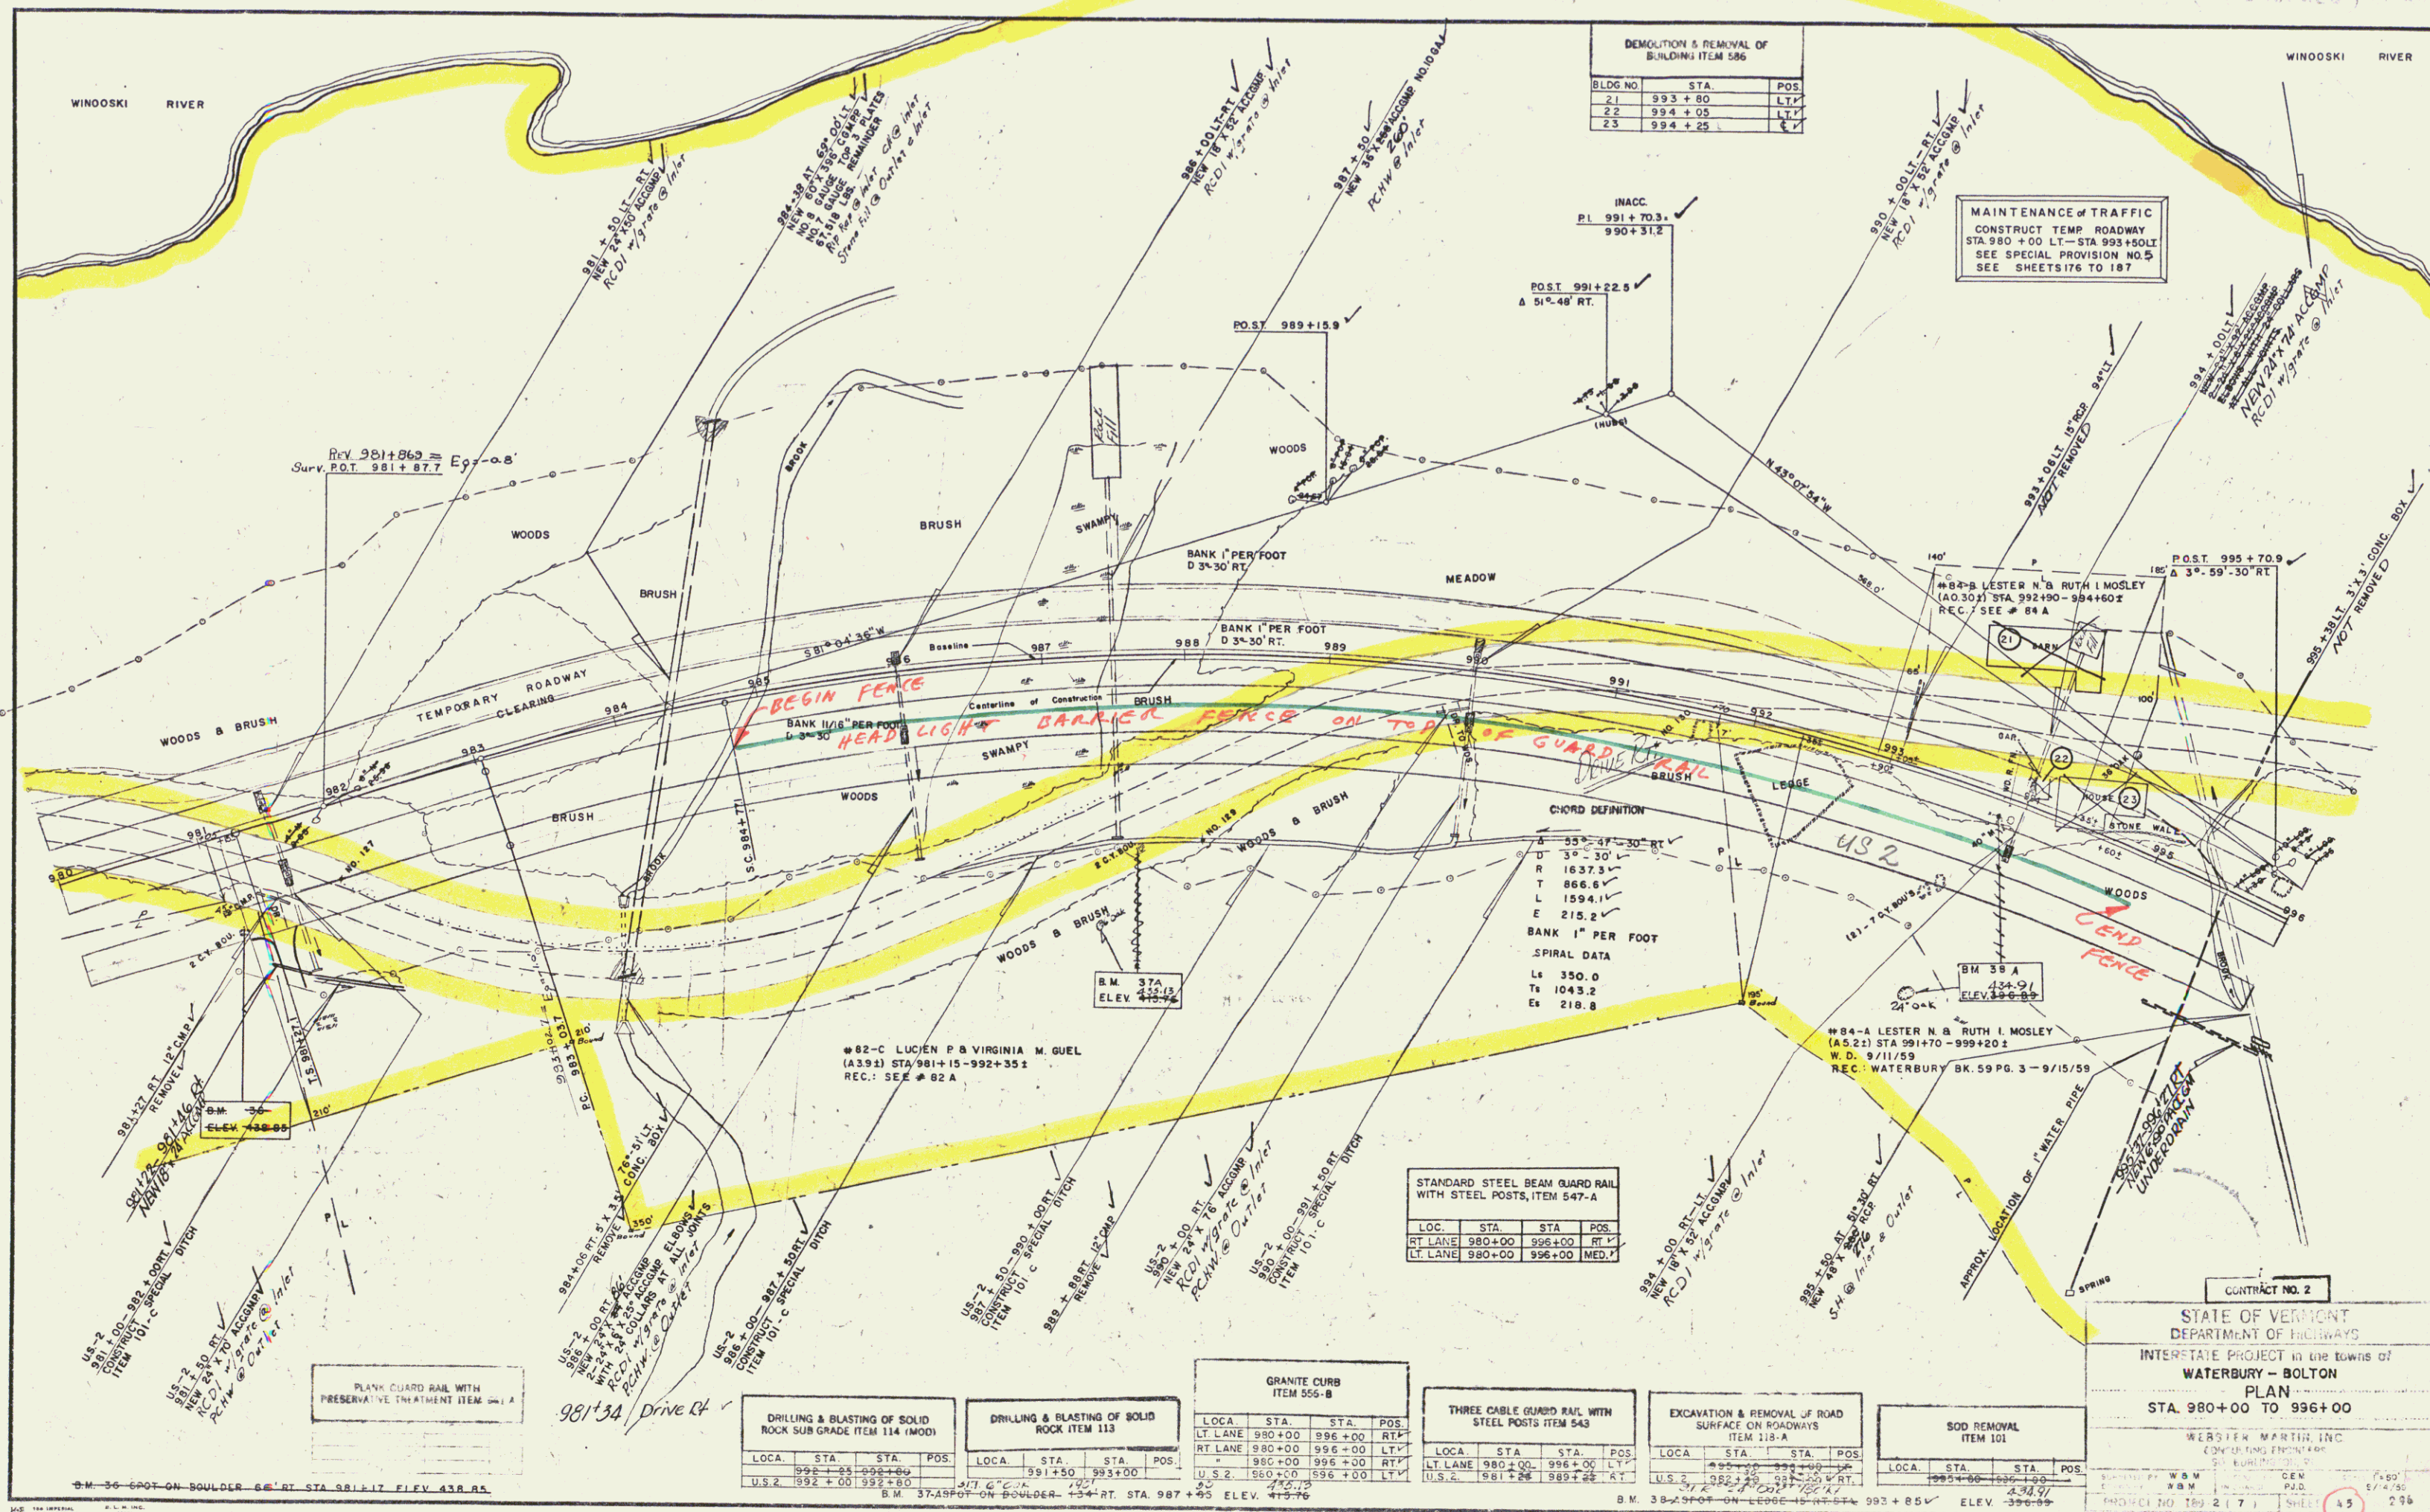

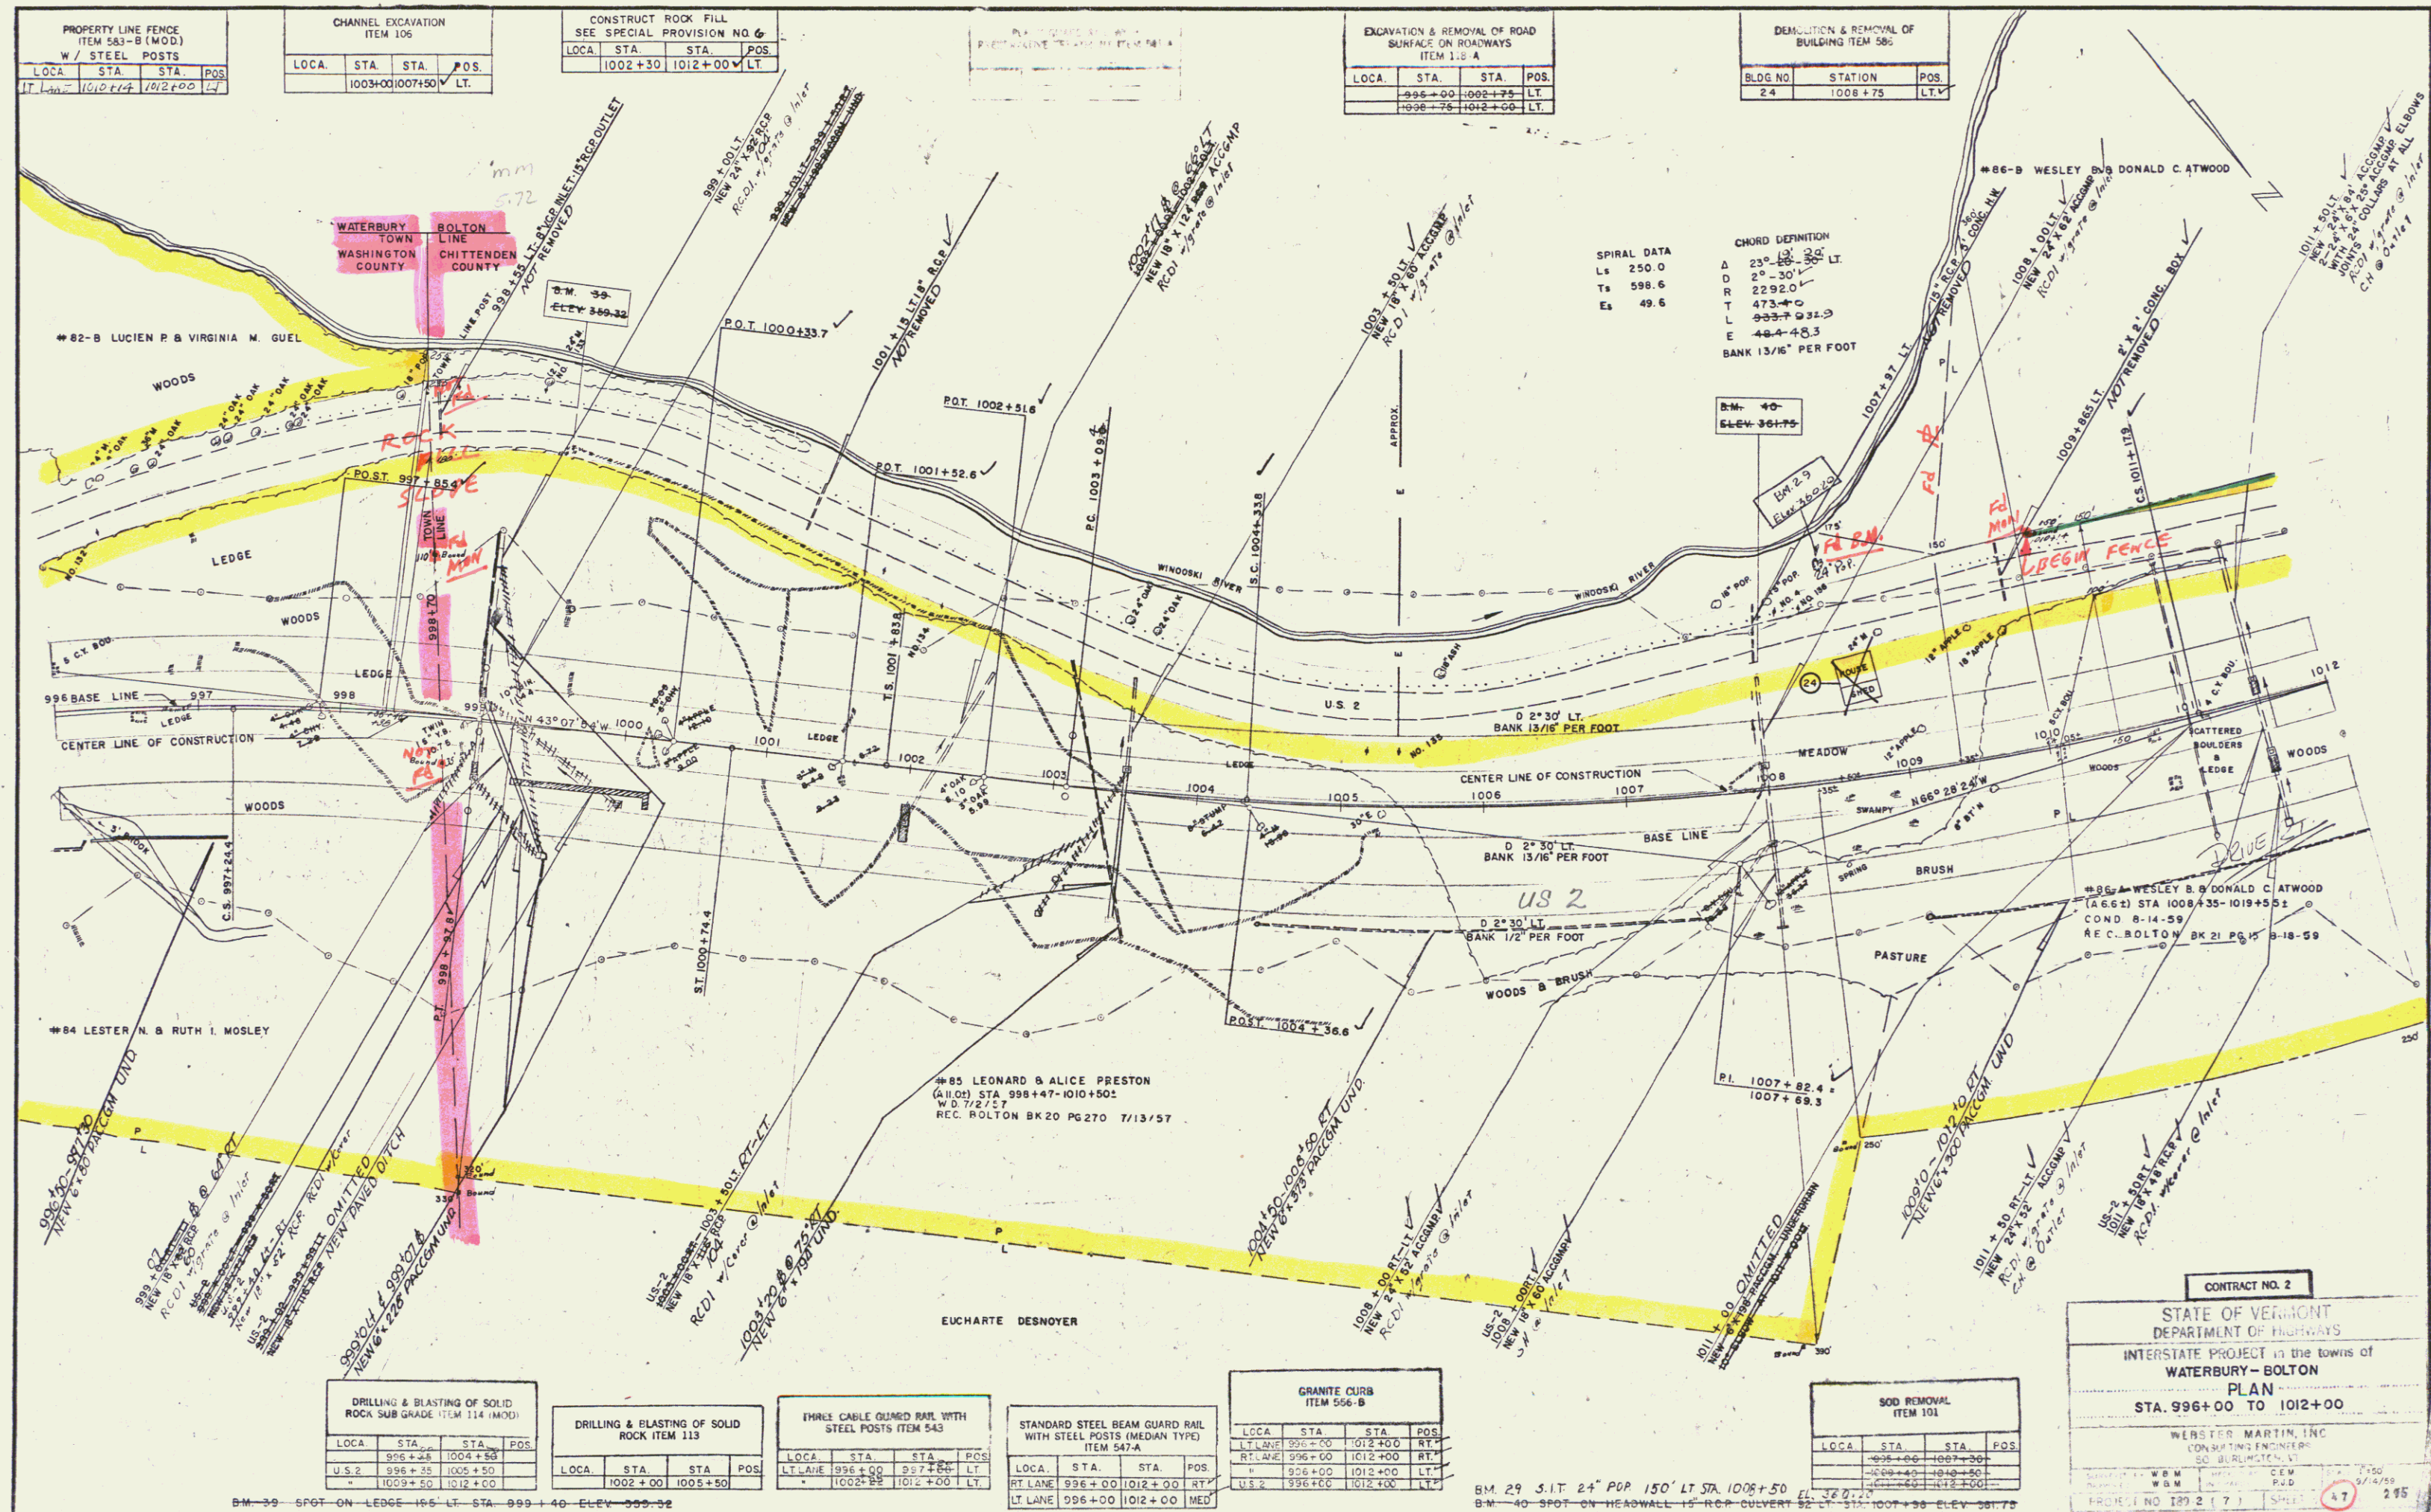




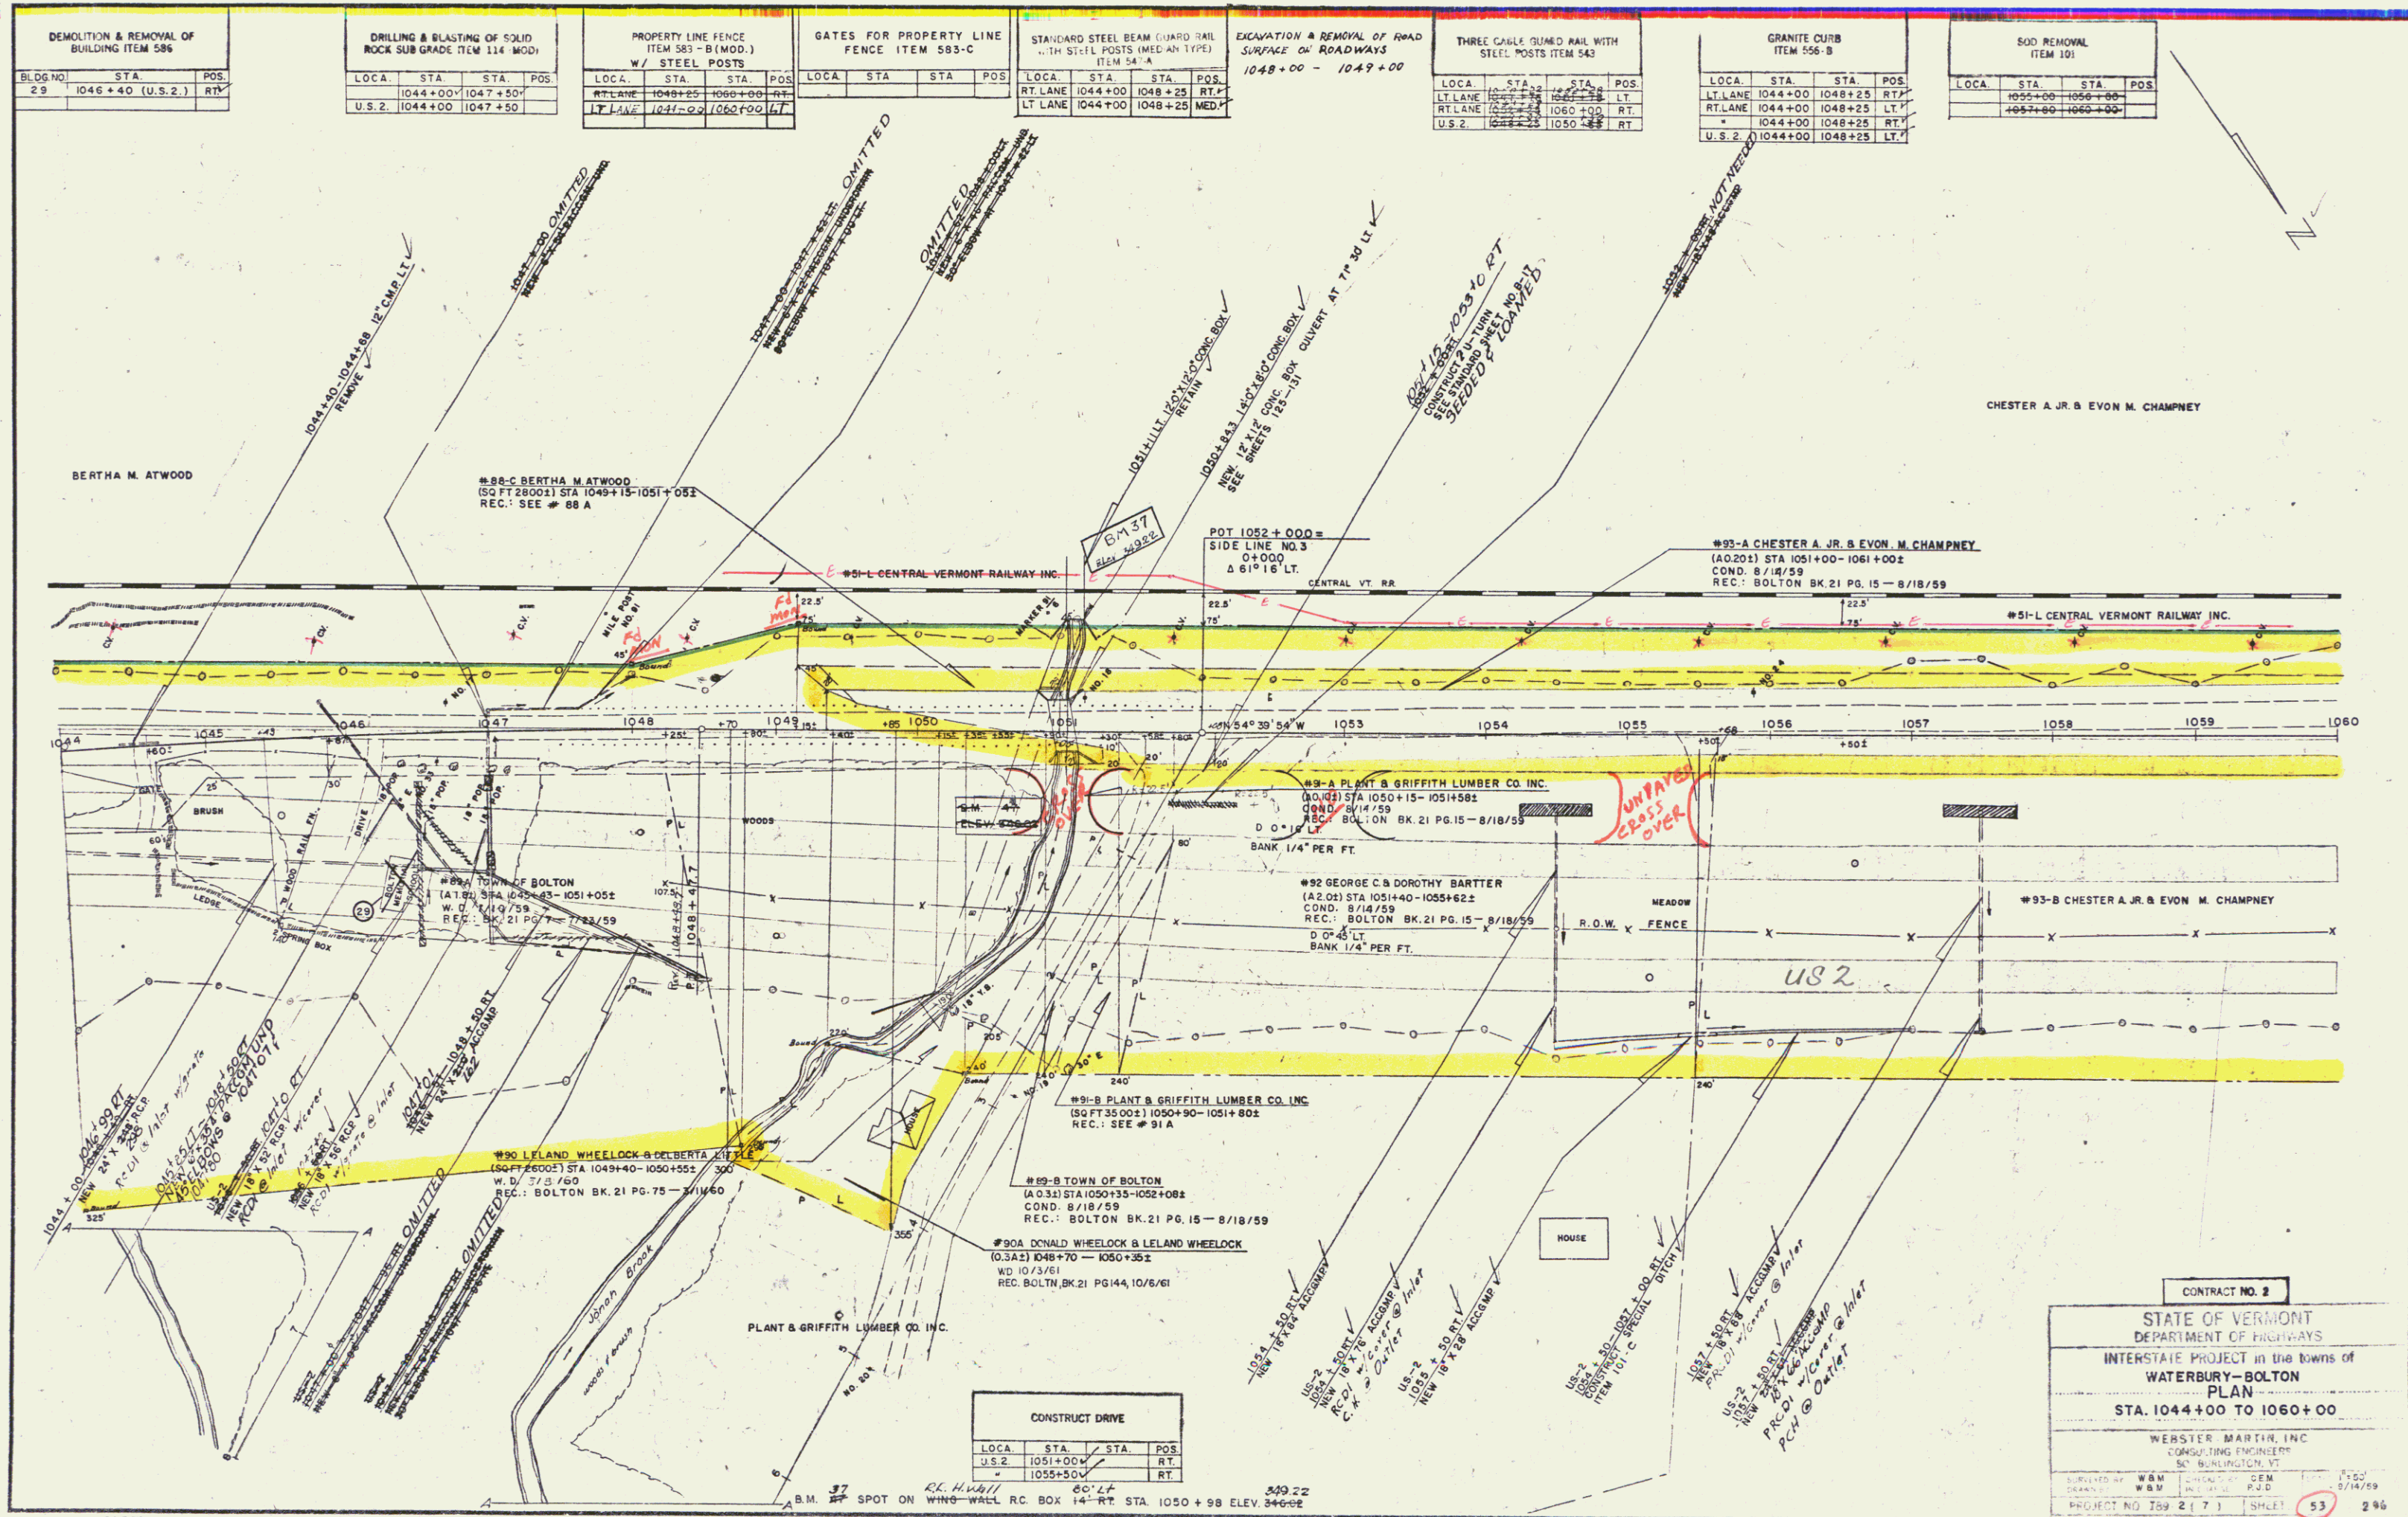

PROPERTY LINE FENCE ITEM 583-B (MOD) W/ STEEL POSTS			
LOCA	STA	STA	POS
LT LANE	1060+00	1076+00	LT

SOD REMOVAL ITEM 101			
LOCA	STA	STA	POS
	1060+00	1060+60	
	1065+50	1067+80	
	1069+40	1072+80	

THREE CABLE GUARD RAIL WITH STEEL POSTS ITEM 543			
LOCA	STA	STA	POS
LT LANE			LT
RT LANE	1060+00	1076+00	RT

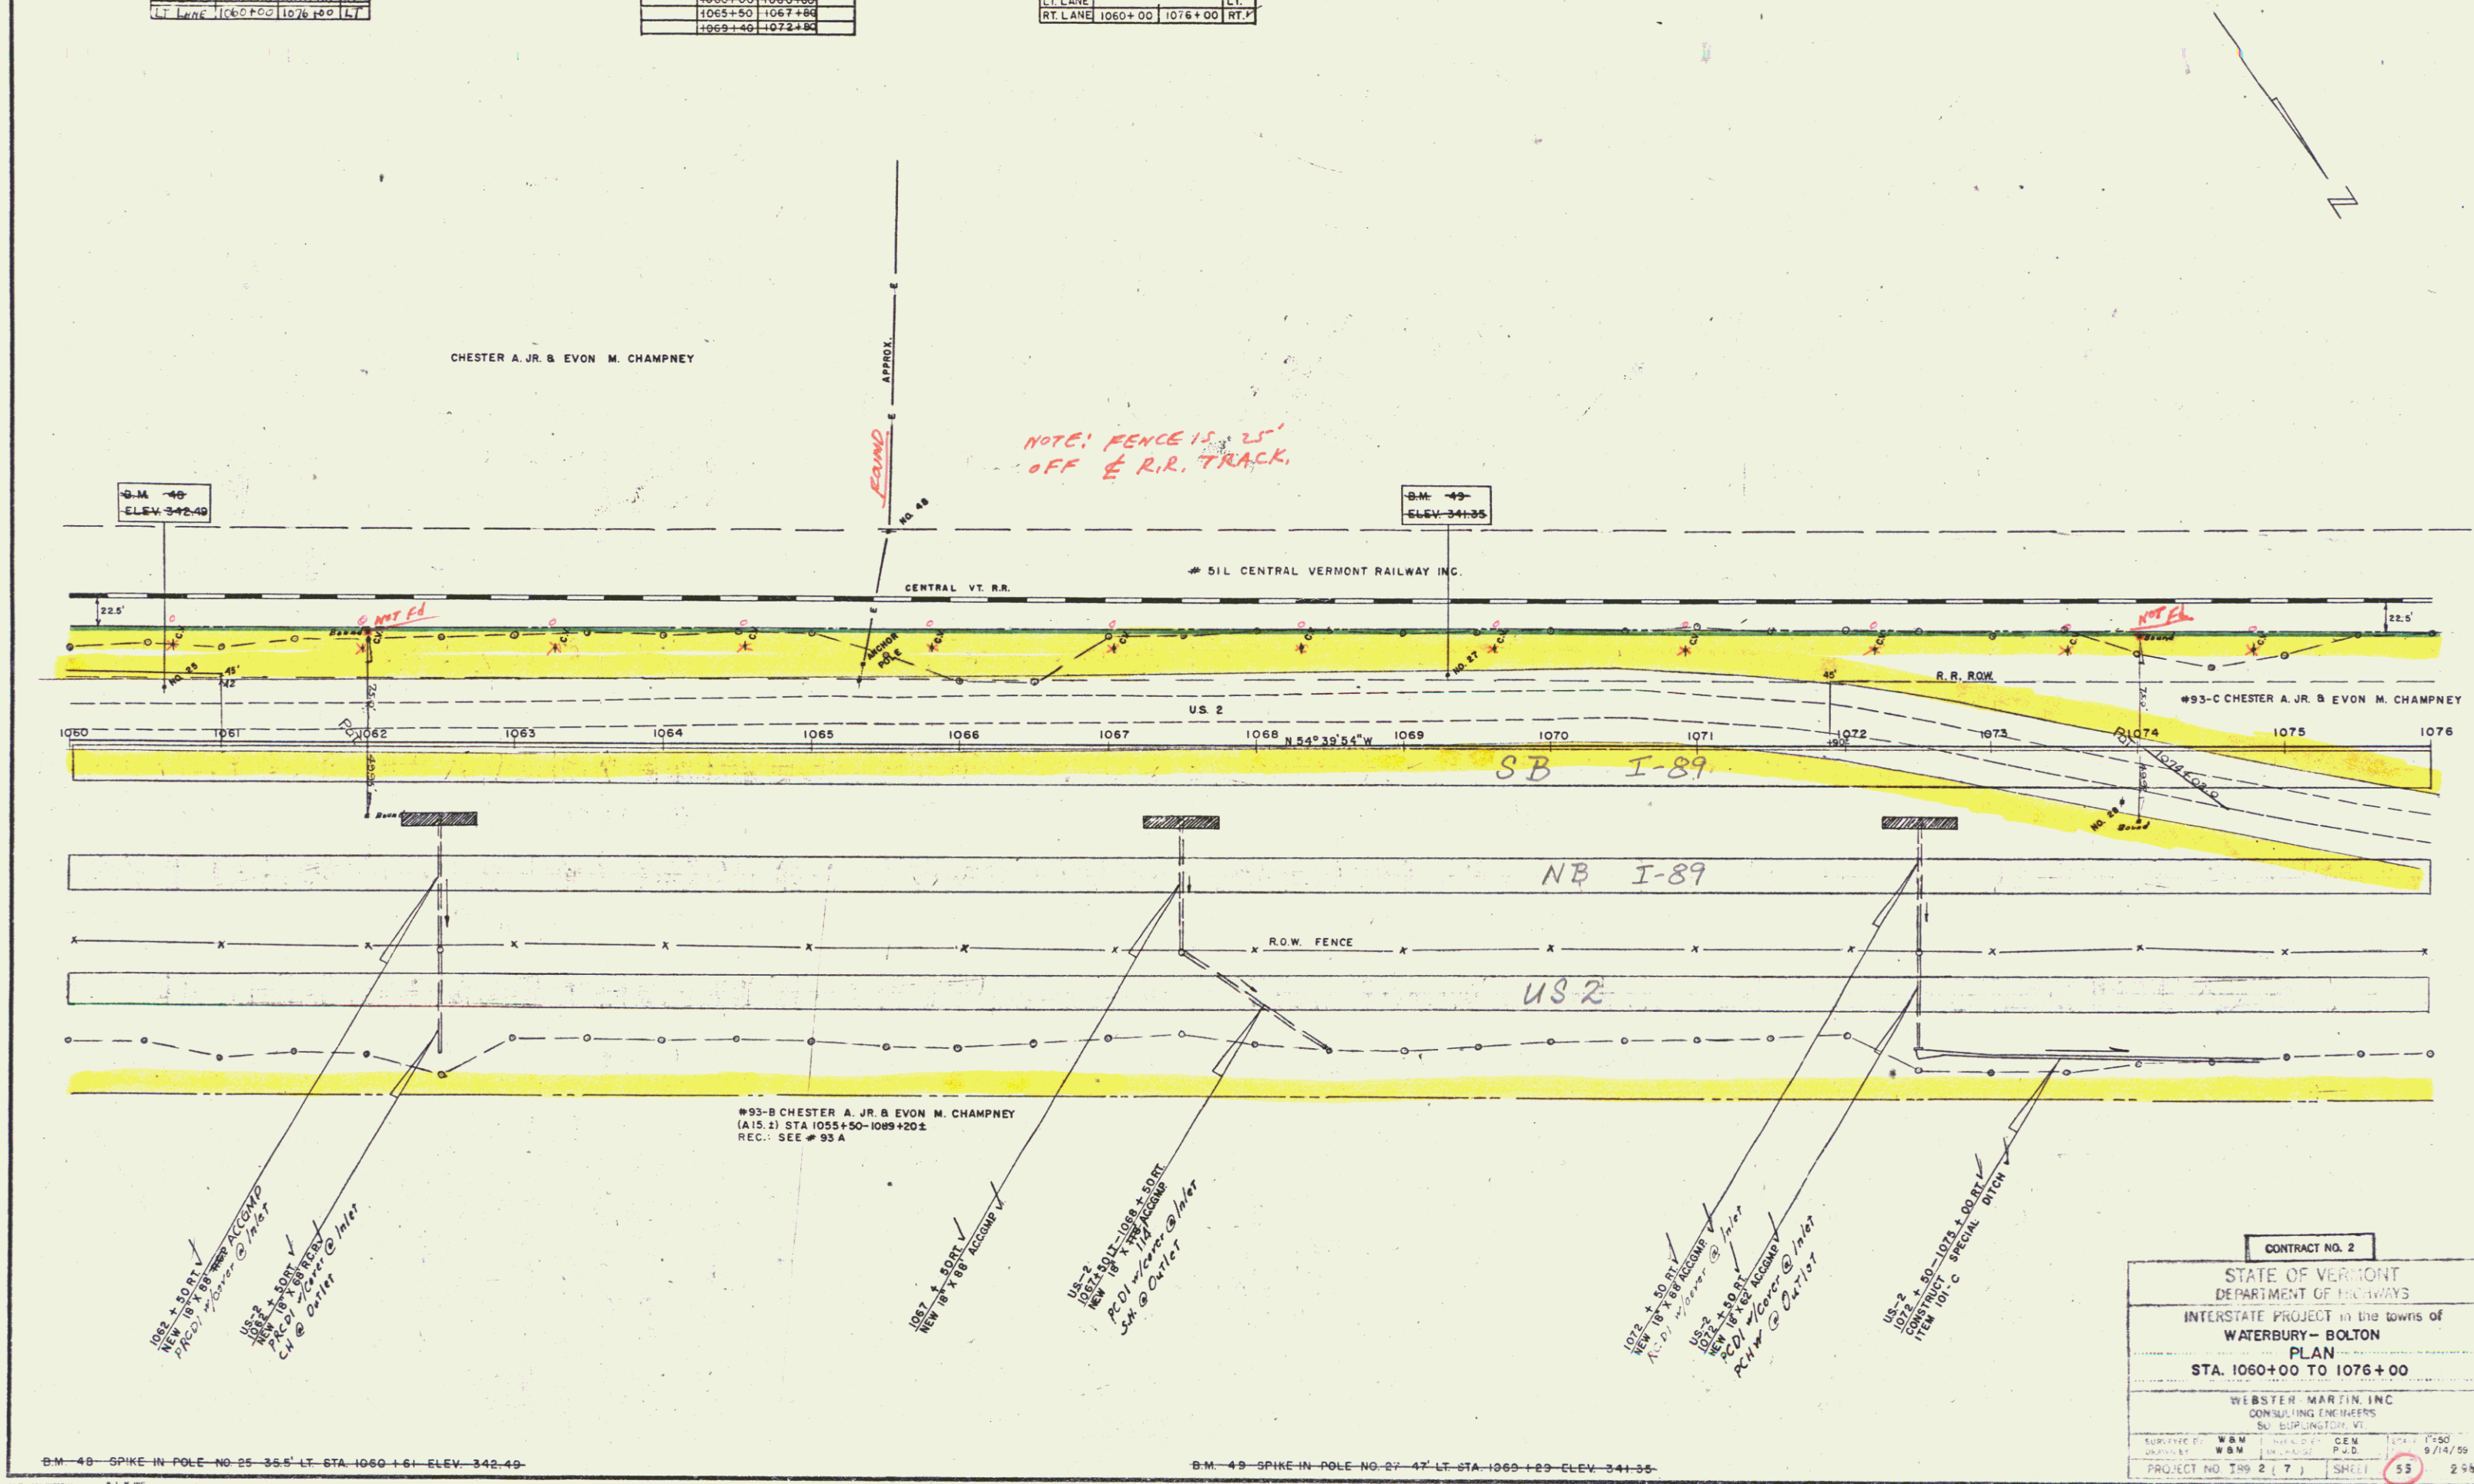


CONTRACT NO. 2			
STATE OF VERMONT DEPARTMENT OF HIGHWAYS			
INTERSTATE PROJECT in the towns of WATERBURY-BOLTON			
PLAN STA. 1060+00 TO 1076+00			
WEBSTER MARTIN, INC. CONSULTING ENGINEERS 50 DORCHESTER ST. BURLINGTON, VT.			
DESIGNED BY	WBM	CEN	DATE
DRAWN BY	WBM	PJD	9/14/59
PROJECT NO.	189-2	SHEET	55
			255

DRILLING & BLASTING OF SOLID ROCK SUB GRADE ITEM 114 (MOD.)			
LOCA	STA.	STA.	POS.
US-2	1092+00	1094+50	

PLANK GUARD RAIL WITH PRESERVATIVE TREATMENT ITEM 541-A (BARRICADE)			
LOCA	STATION	POS.	
	1101+50	LT	

THREE CABLE GUARD RAIL WITH STEEL POSTS ITEM 543			
LOCA	STA.	STA.	POS.
LT LANE	1107+25	1108+00	LT
RT LANE	1107+25	1108+00	RT
US-2	1095+25	1096+25	LT

PROPERTY LINE FENCE ITEM 543-B (MOD.) W/ STEEL POSTS			
LOCA	STA.	STA.	POS.
LT LANE	1092+00	1108+00	RT
RT LANE	1092+00	1108+00	LT

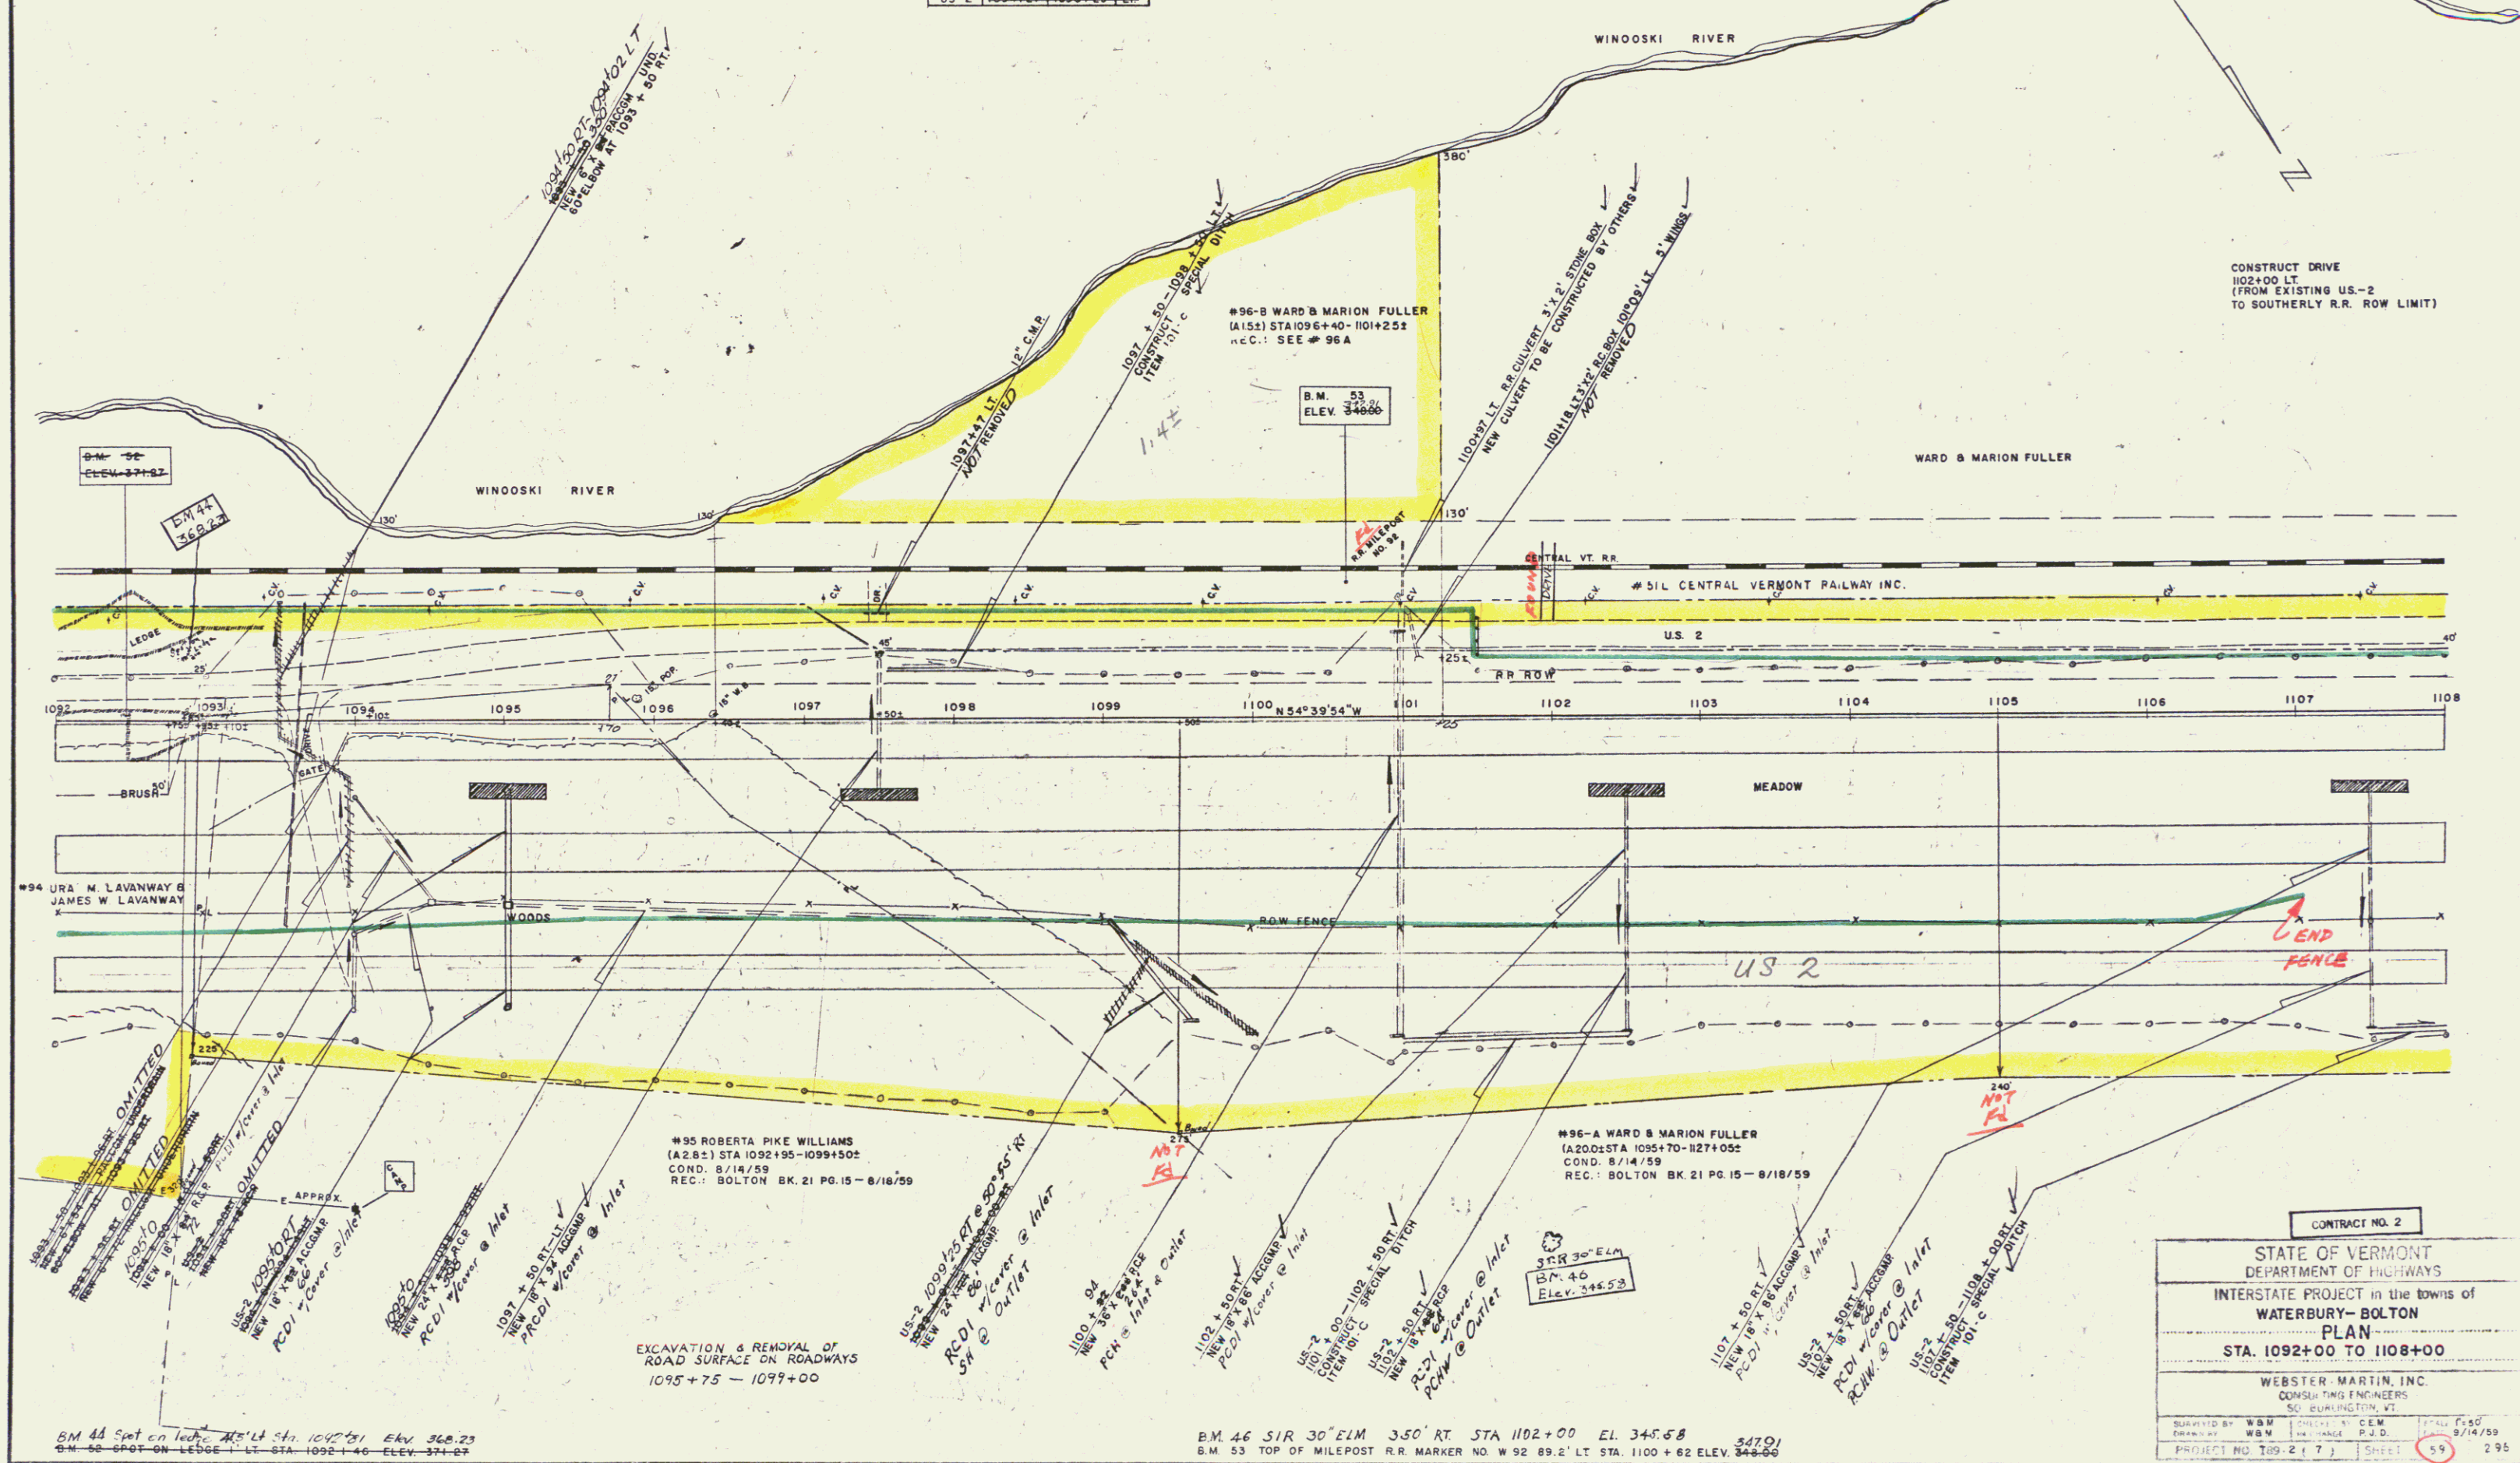

CONTRACT NO. 2


STATE OF VERMONT
DEPARTMENT OF HIGHWAYS

INTERSTATE PROJECT in the towns of
WATERBURY-BOLTON


PLAN
STA. 1092+00 TO 1108+00

WEBSTER MARTIN, INC.
CONSULTING ENGINEERS
50 BURLINGTON, VT

DESIGNED BY WSM CHECKED BY CEM
DRAWN BY WSM IN CHARGE PJD
PROJECT NO. 109-2 (7) SHEET 59 295

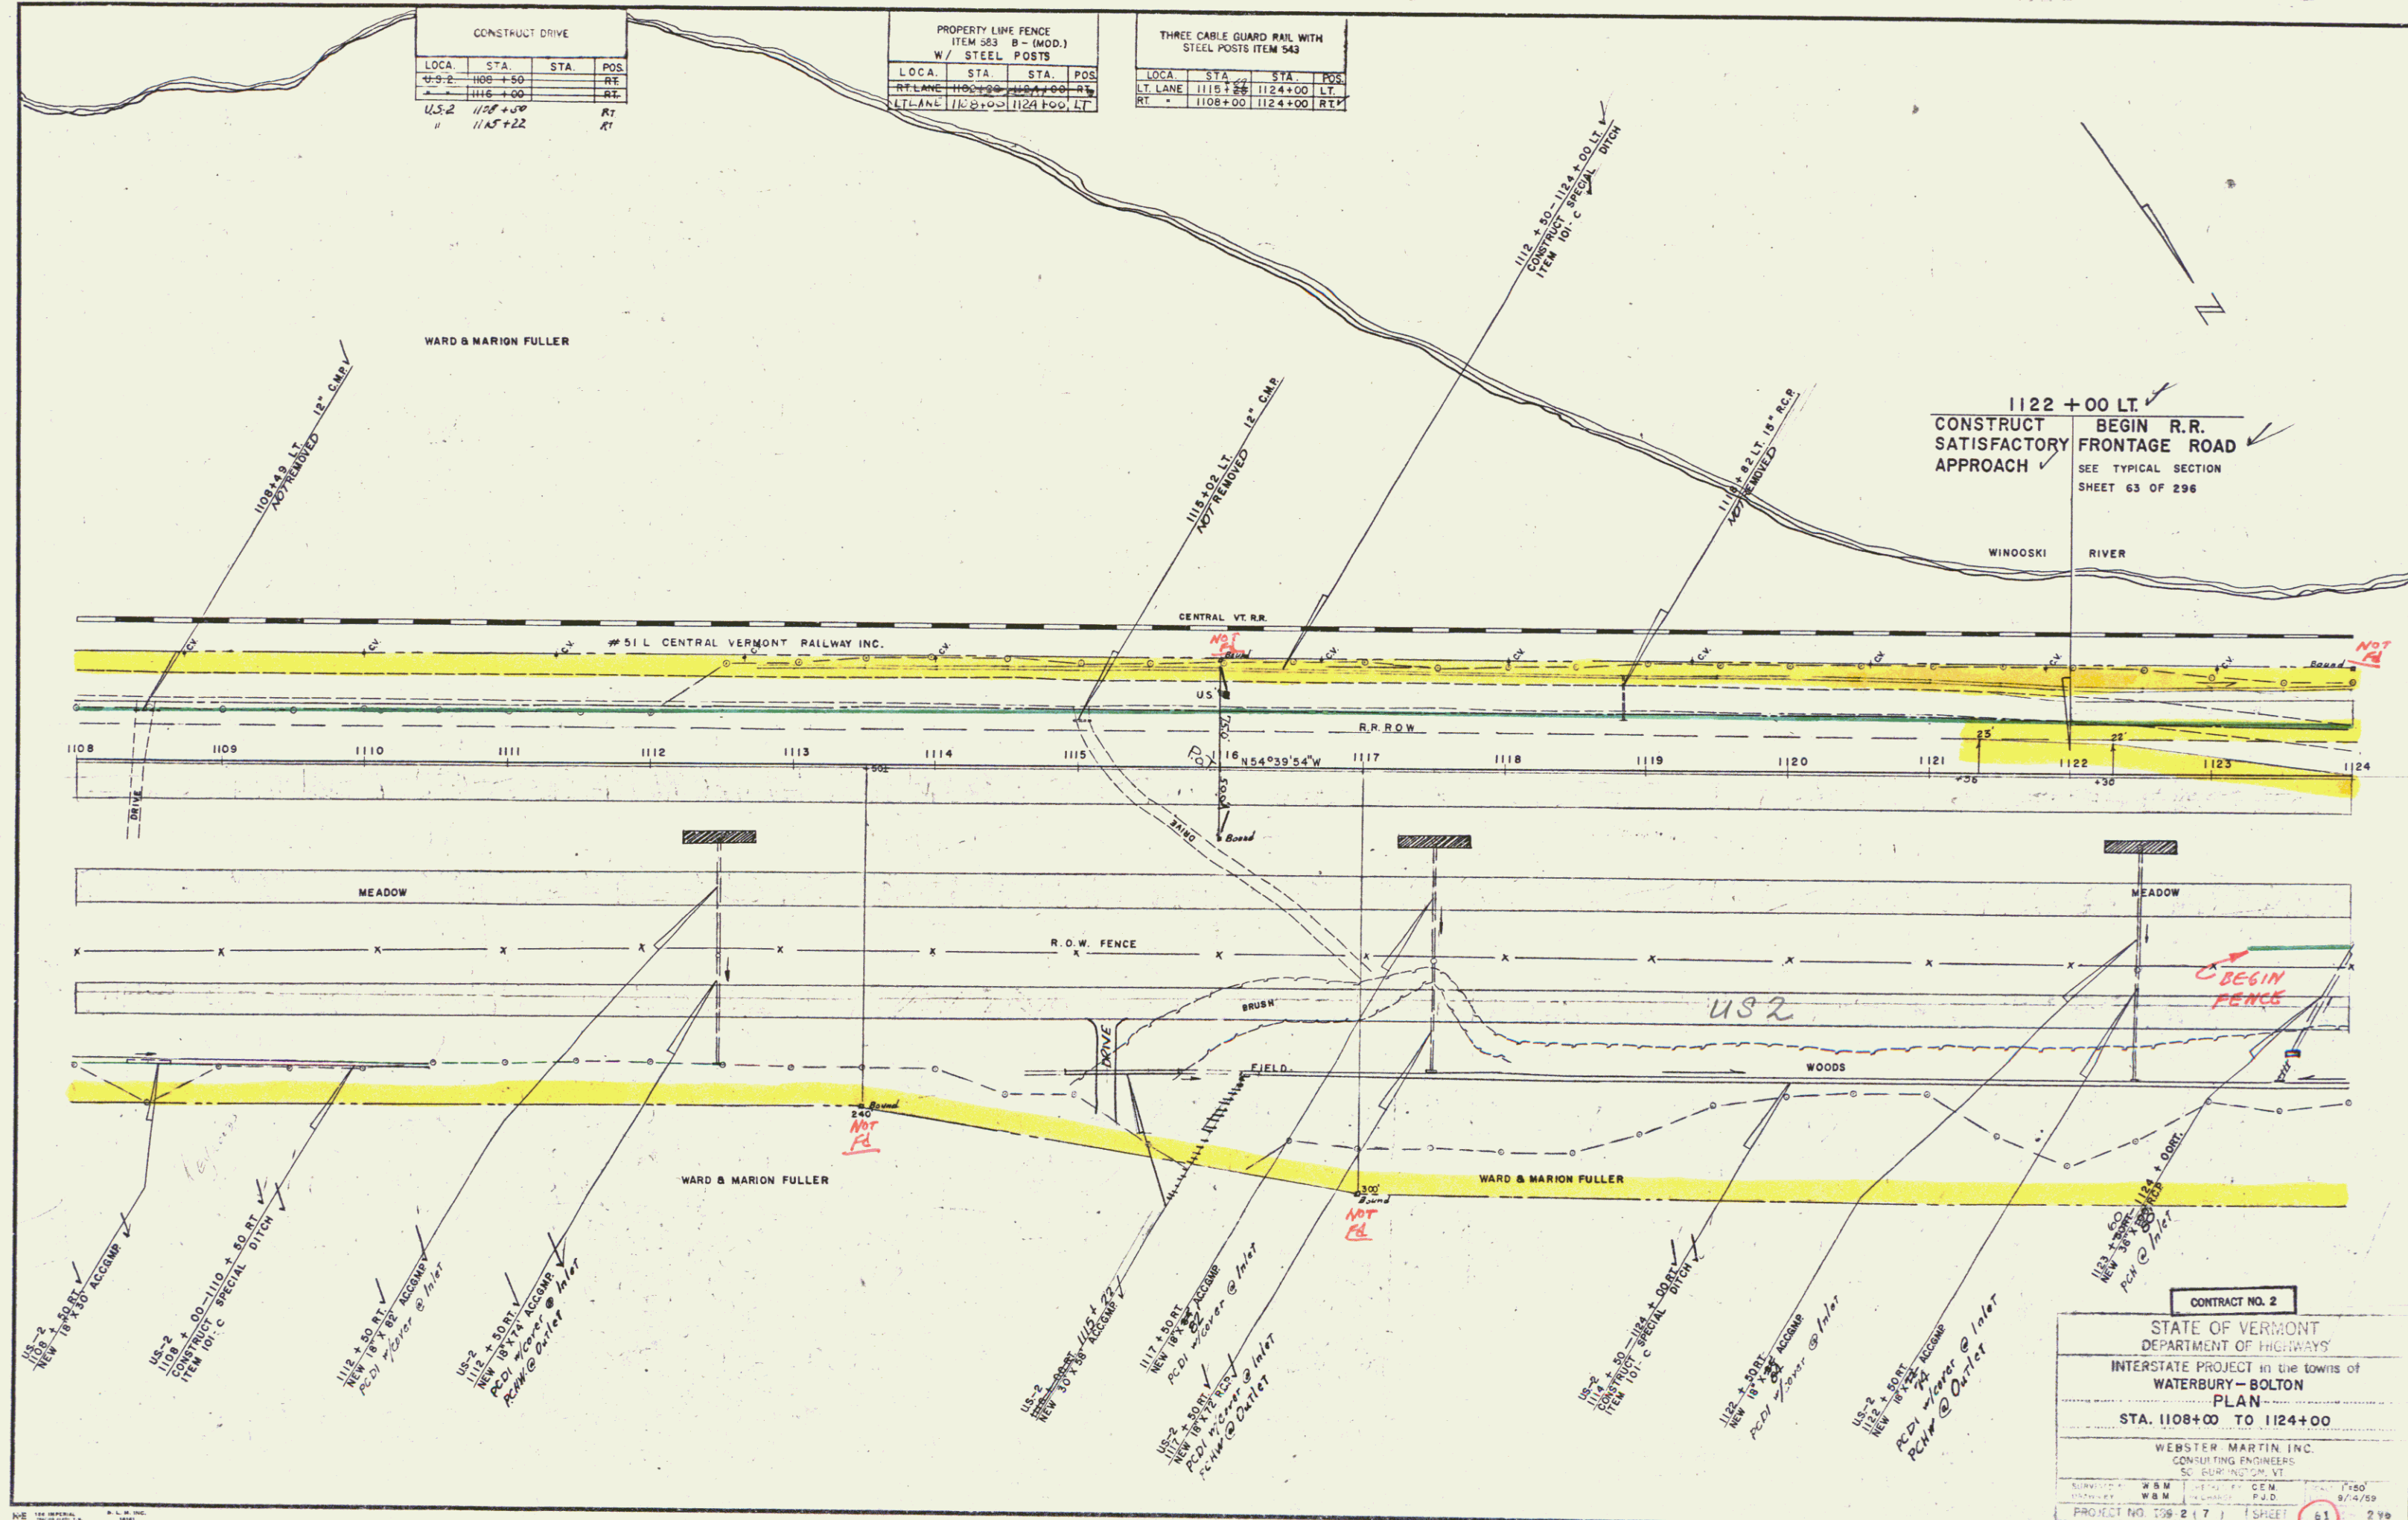



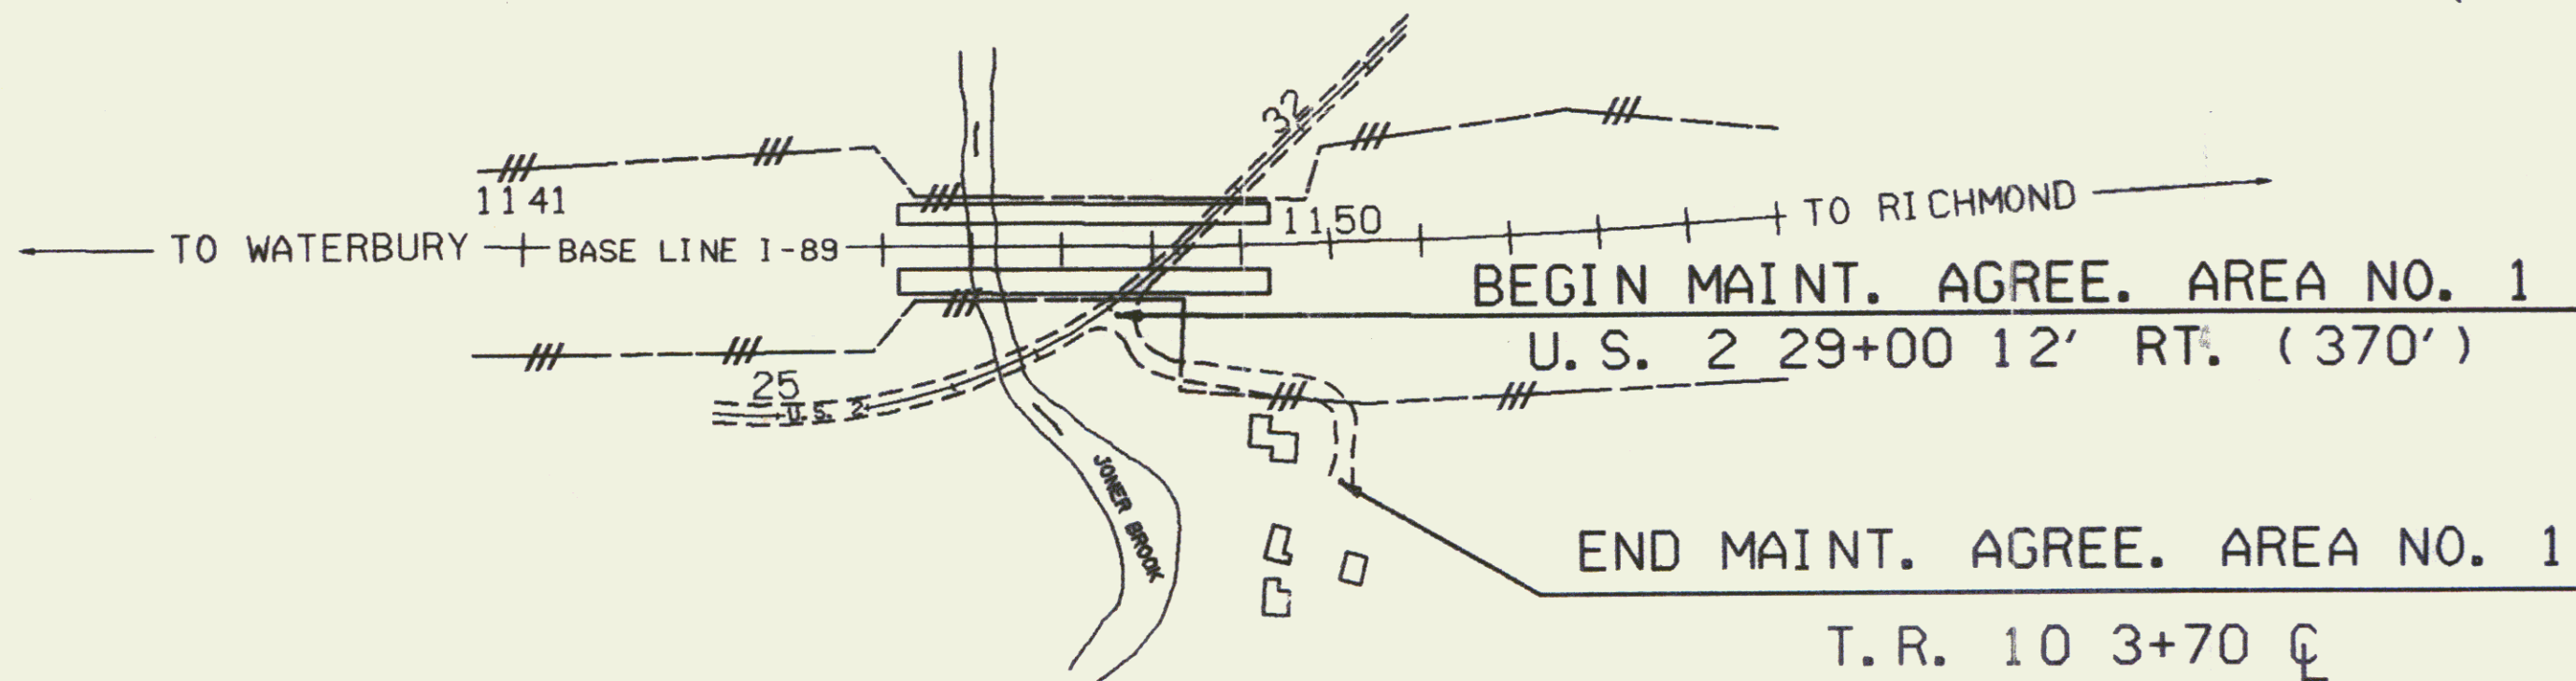

RIGHT-OF-WAY DIVISION
TOWN FILE
PERPETUAL


Town of Bolton
(To Be Returned To R.O.W. Division)

Recorded 11/6/88 in BK 37, Pg 49-52

STATE OF VERMONT AGENCY OF TRANSPORTATION	
RELINQUISHMENT & MAINTENANCE PLATS	
TOWN OF BOLTON	
TOWN ROAD NO. 10	
PROJECT: WATERBURY-BOLTON I-89-2(7)	
APPROX. SCALE 1"=200'	DATE 8-3-87 DRAWN BY M.J.R.



65A

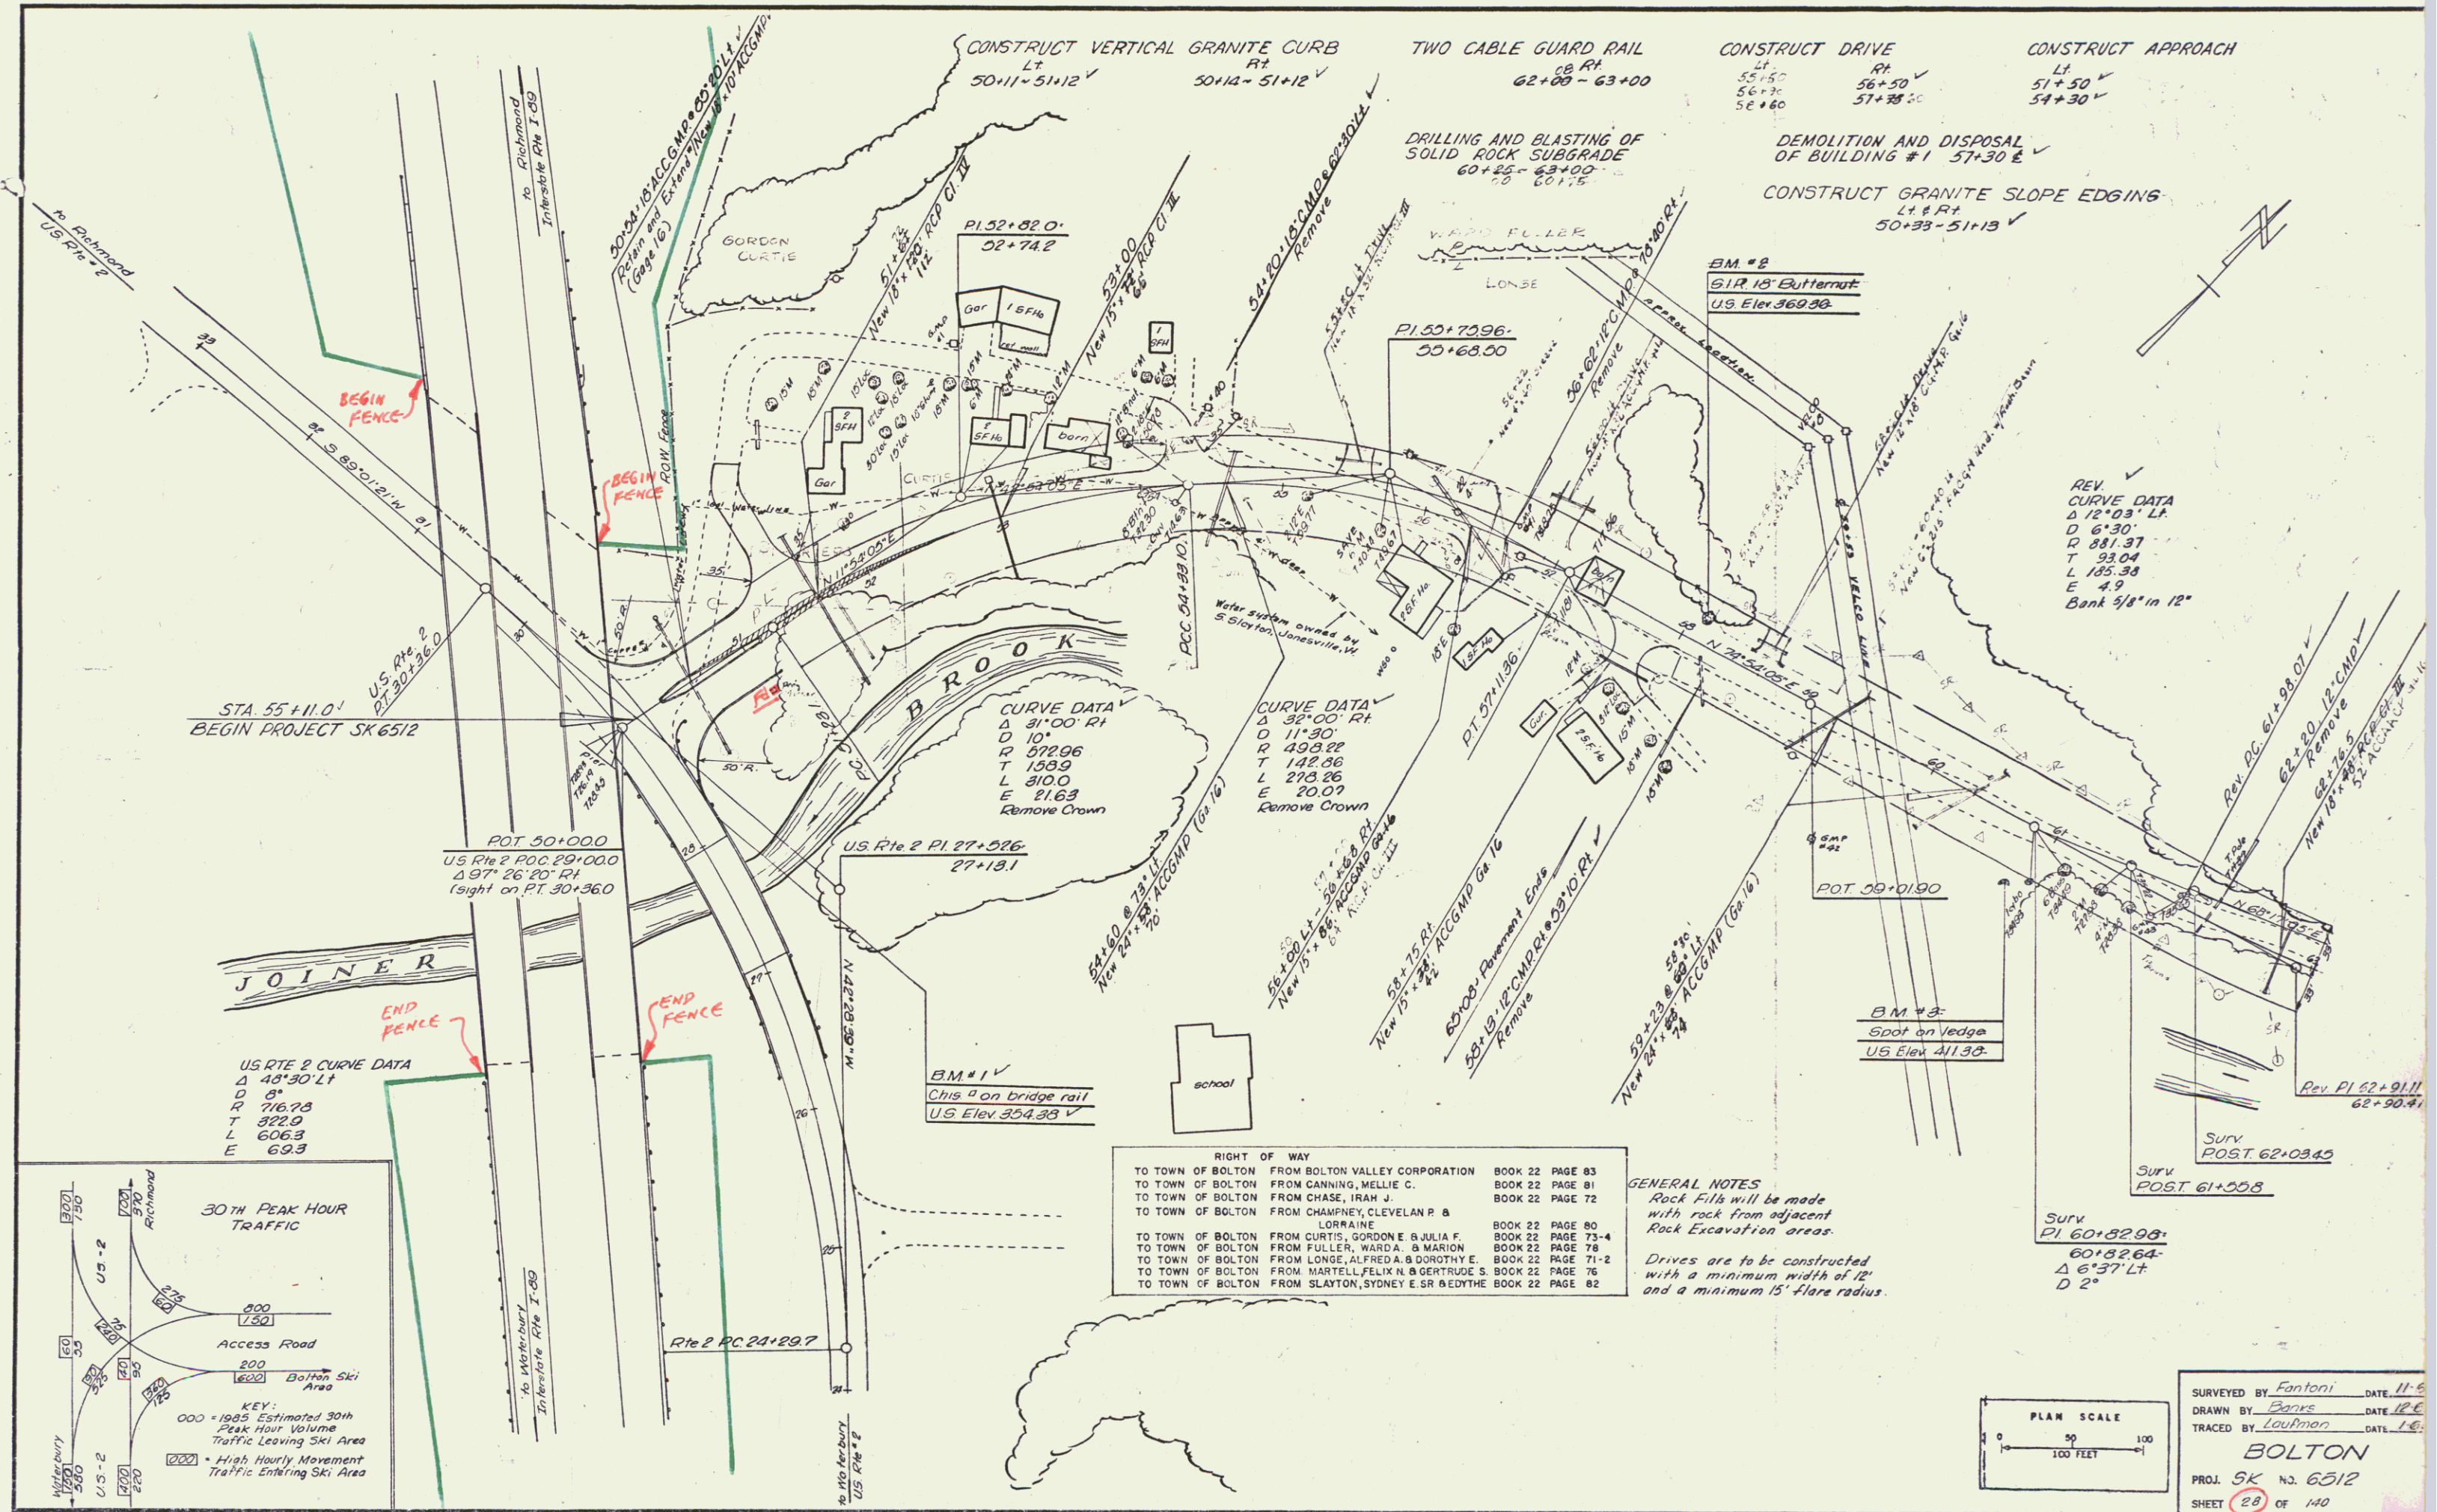


MUCK EXCAVATION ITEM 116			
LOCA	STA	STA	POS
1173+75	1182+25		

SEEDING SPECIAL ITEM 58			
LOCA	STA	STA	POS
1172+00	1182+00		

DRILLING & BLASTING SOLID ROCK
SUBGRADE
STA. 1186+21 - 1187+00 RT.

THREE CABLE GUARD RAIL WITH STEEL POSTS ITEM 543			
LOCA	STA	STA	POS
1172+00	1182+00		
LT LANE	1185+10	1190+00	LT

U.S. 2

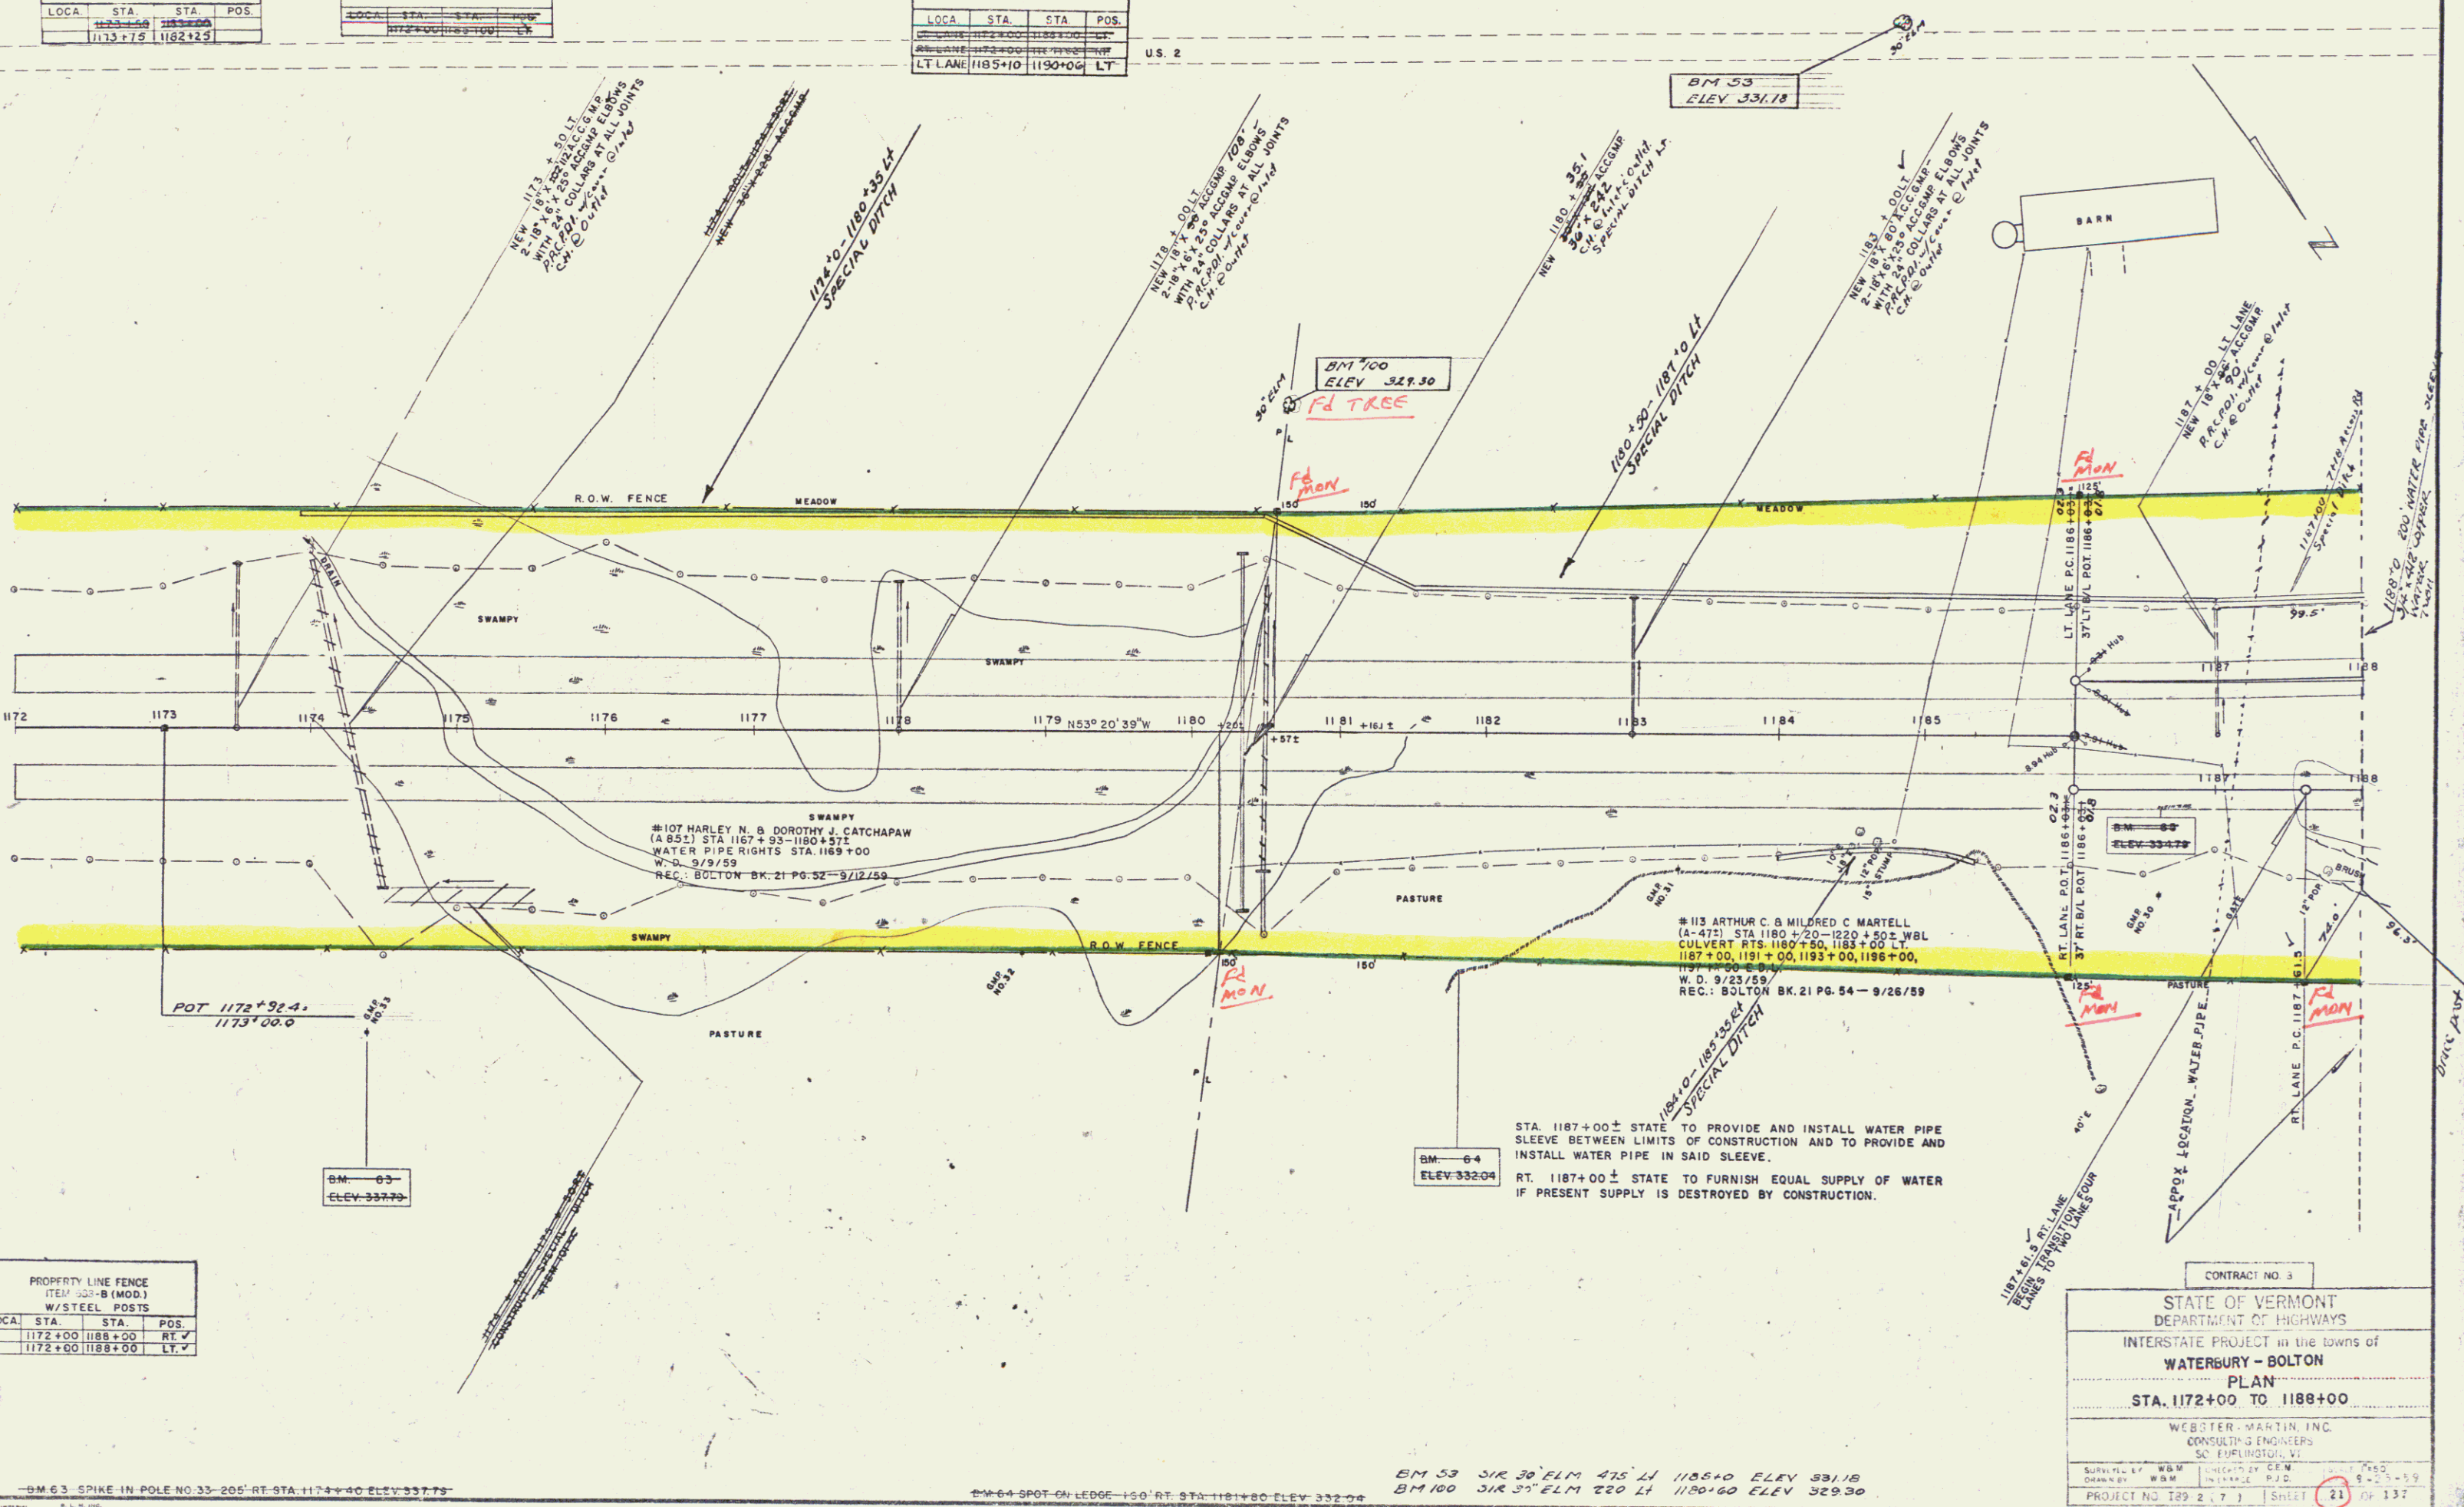

PROPERTY LINE FENCE (ITEM 20-B (MOD.) W/STEEL POSTS			
LOCA	STA	STA	POS
1172+00	1188+00		RT ✓
1172+00	1188+00		LT ✓

BM 63 SPIKE IN POLE NO. 33-205 RT STA 1174+00 ELEV 337.75

BM 64 SPOT ON LEDGE - 150' RT STA 1181+80 ELEV 332.55

BM 53 312 30' ELM 475' LT 1185+00 ELEV 331.18
BM 100 312 30' ELM 220' LT 1180+60 ELEV 329.30

CONTRACT NO. 3

STATE OF VERMONT
DEPARTMENT OF HIGHWAYS

INTERSTATE PROJECT in the towns of
WATERBURY - BOLTON

PLAN
STA. 1172+00 TO 1188+00

WEBSTER MARTIN, INC.
CONSULTING ENGINEERS
50 EURLINGTON, VT

SURVEYED BY: WBM
DRAWN BY: WBM
CHECKED BY: CEM
IN CHARGE: PJC
DATE: 8-2-59

PROJECT NO. 189-2-7-1 SHEET 23 OF 137

