
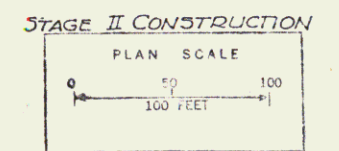


WATER SOURCES, TR.35
 Type Station Offset
 Spring area 34+00-35+00 100'RT-100'LT

CONSTRUCT DRIVE
 T.D. #6 42+21 RT.

TWO CABLE GUARD RAIL
 w/ WOOD POSTS, ITEM 541
 T.D. 35
 32+55 - 34+94 LT. ✓
 34+20 - 34+94 RT. ✓
 33+98 -

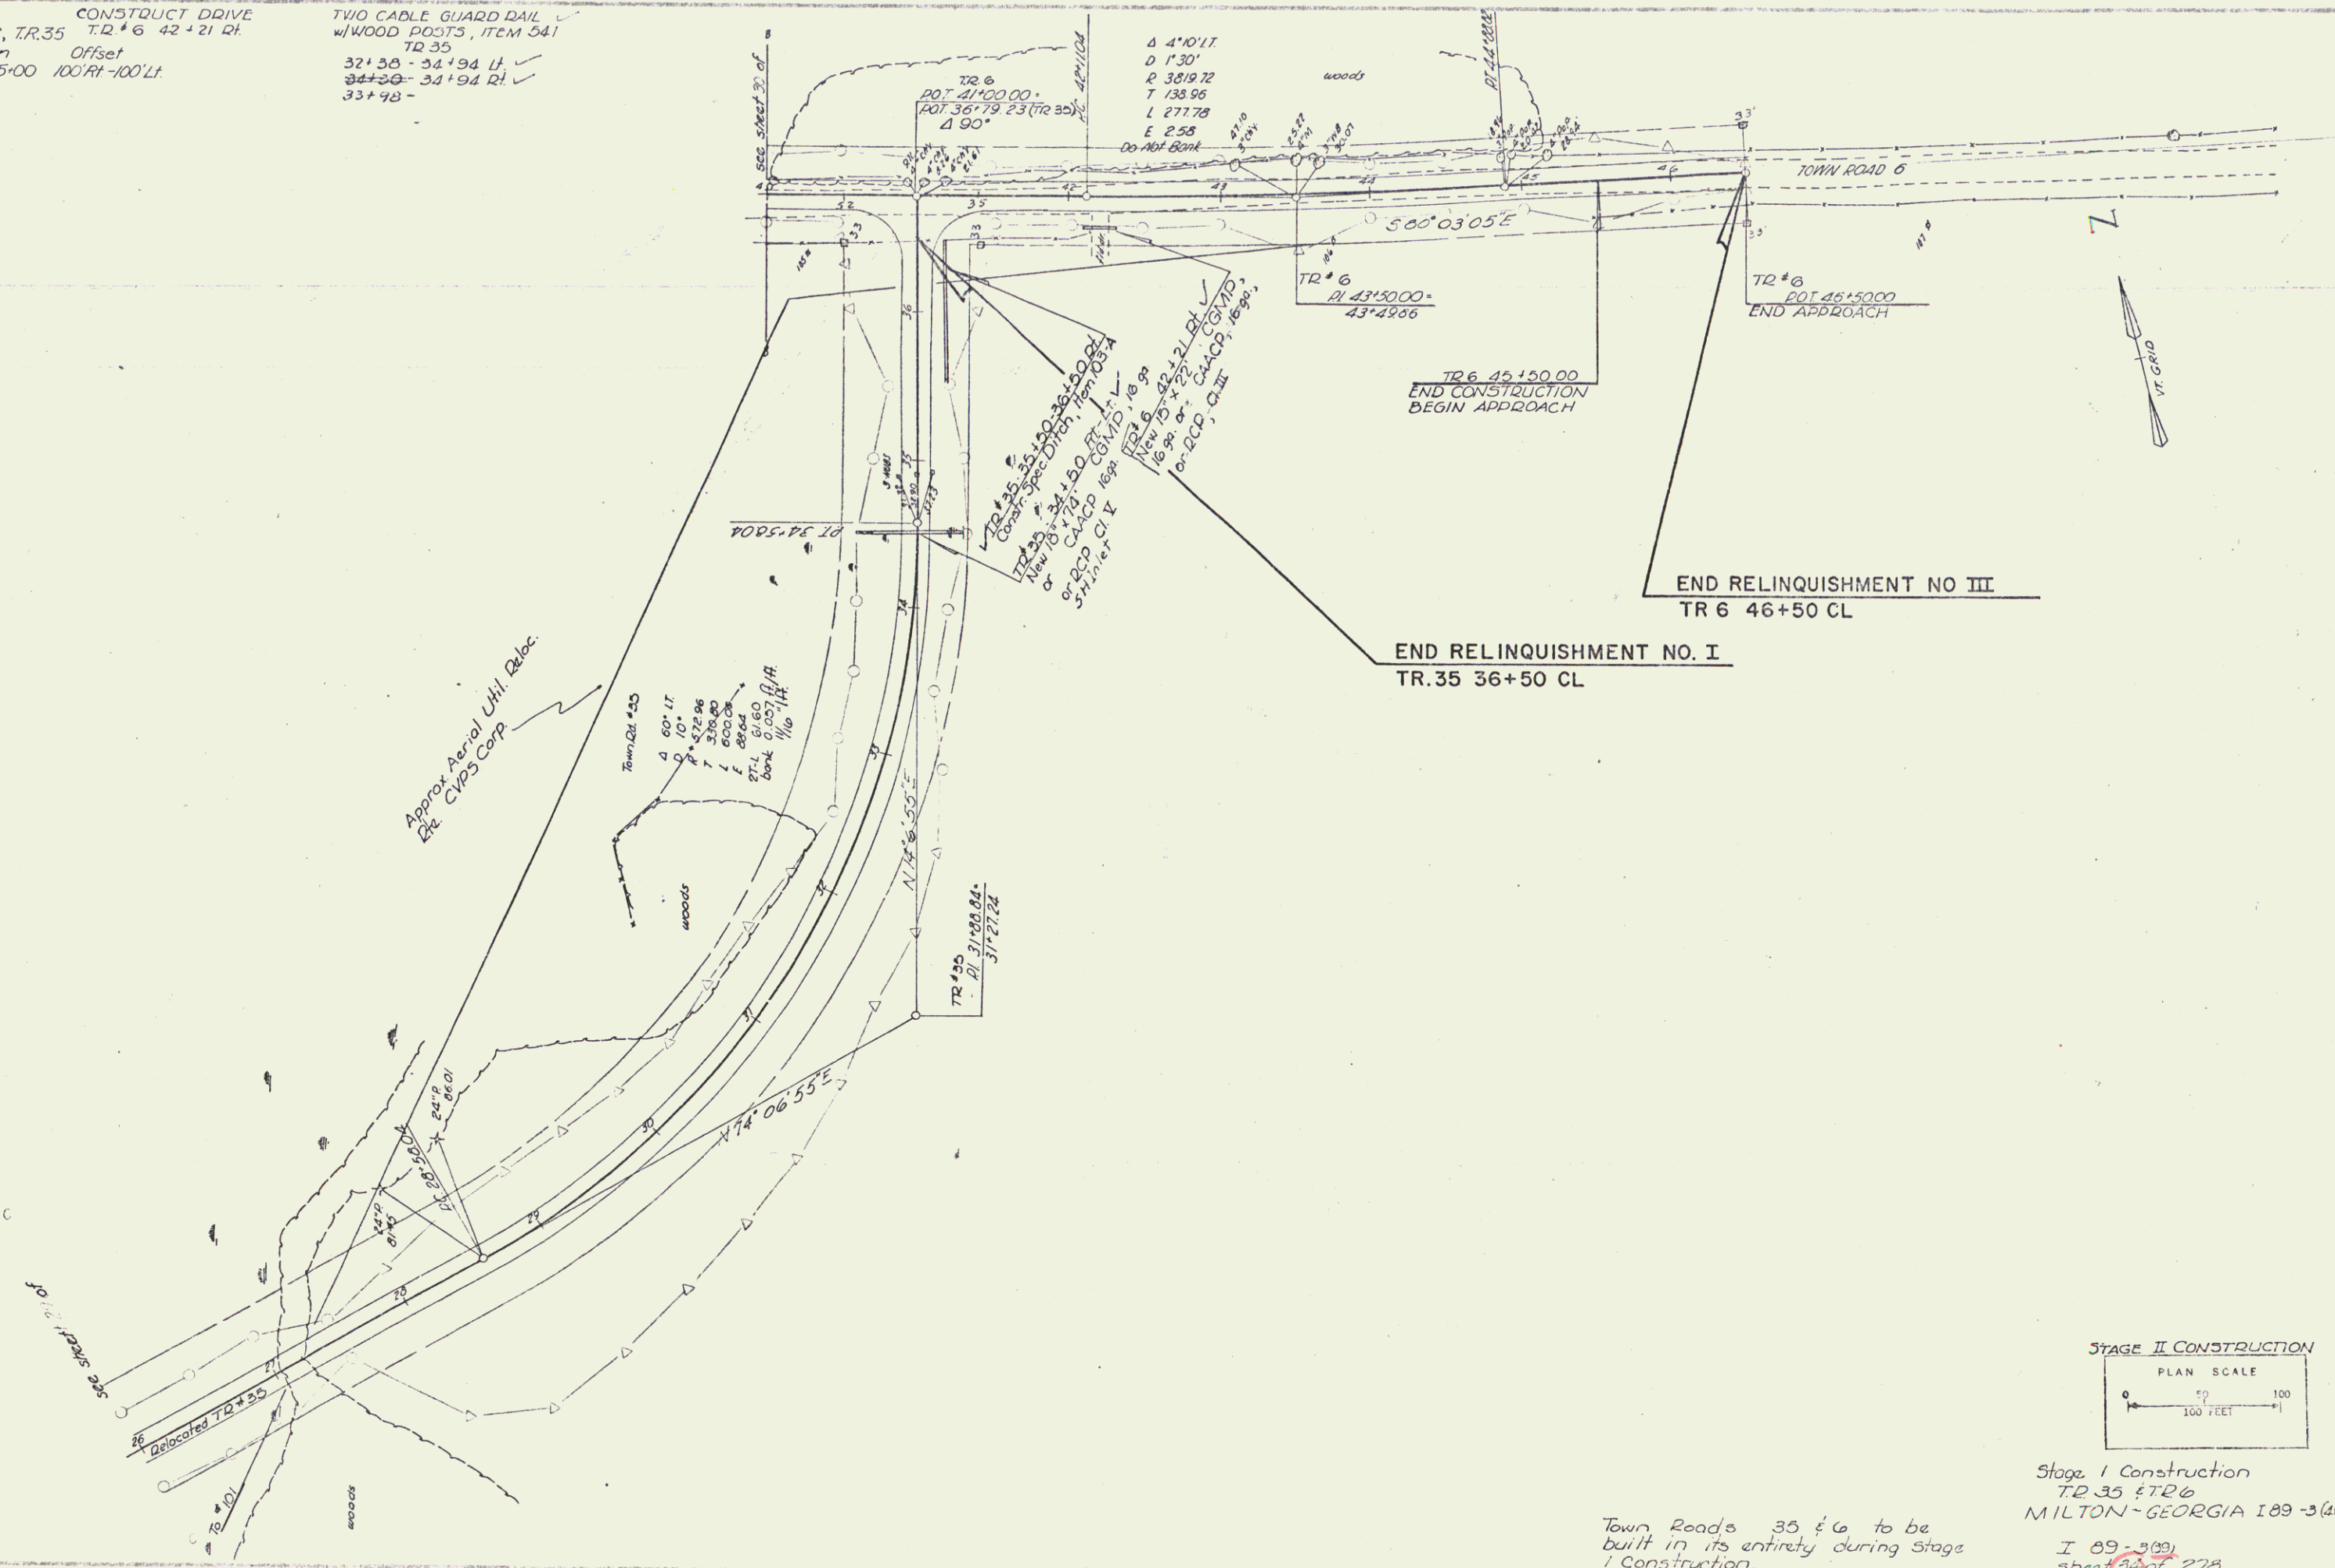

Town Road 35 & 6 to be
 built in its entirety during Stage
 I Construction.

Stage I Construction
 TR.35 & TR.6
 MILTON-GEORGIA 109-3(40)
 I 09-309
 sheet 34 of 273