


INDEX OF SHEETS

STATE OF VERMONT
DEPARTMENT OF HIGHWAYS
PROPOSED IMPROVEMENT

INTERSTATE PROJECT
TOWNS OF ST. ALBANS-SWANTON
COUNTY OF FRANKLIN
INTERSTATE ROUTE 89
BURLINGTON-PHILIPSBURG, QUE. ROAD
COMPOSITE

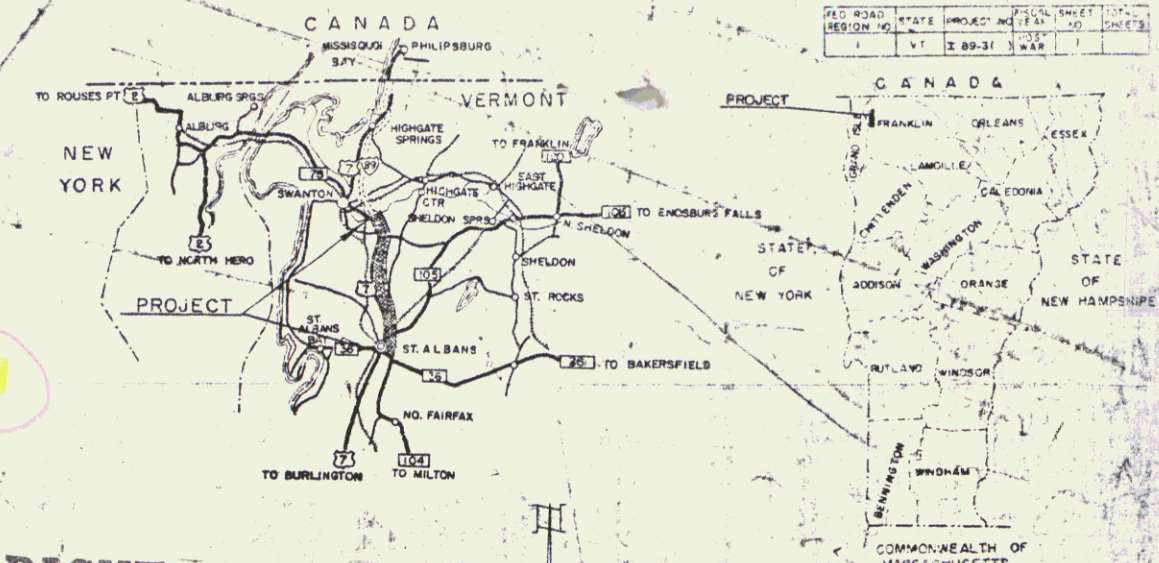


RIGHT-OF-WAY
PLANS

Pin # 99R030

ROW PLANS

BEGINNING AT A POINT 3.795 MILES SOUTHERLY OF THE
ST. ALBANS-SWANTON TOWN LINE AND EXTENDING NORTHERLY FOR
A DISTANCE OF 8.049 MILES.

LENGTH OF ROADWAY FEET = MILES
LENGTH OF BRIDGES FEET = MILES
LENGTH OF PROJECT FEET = 8049 MILES

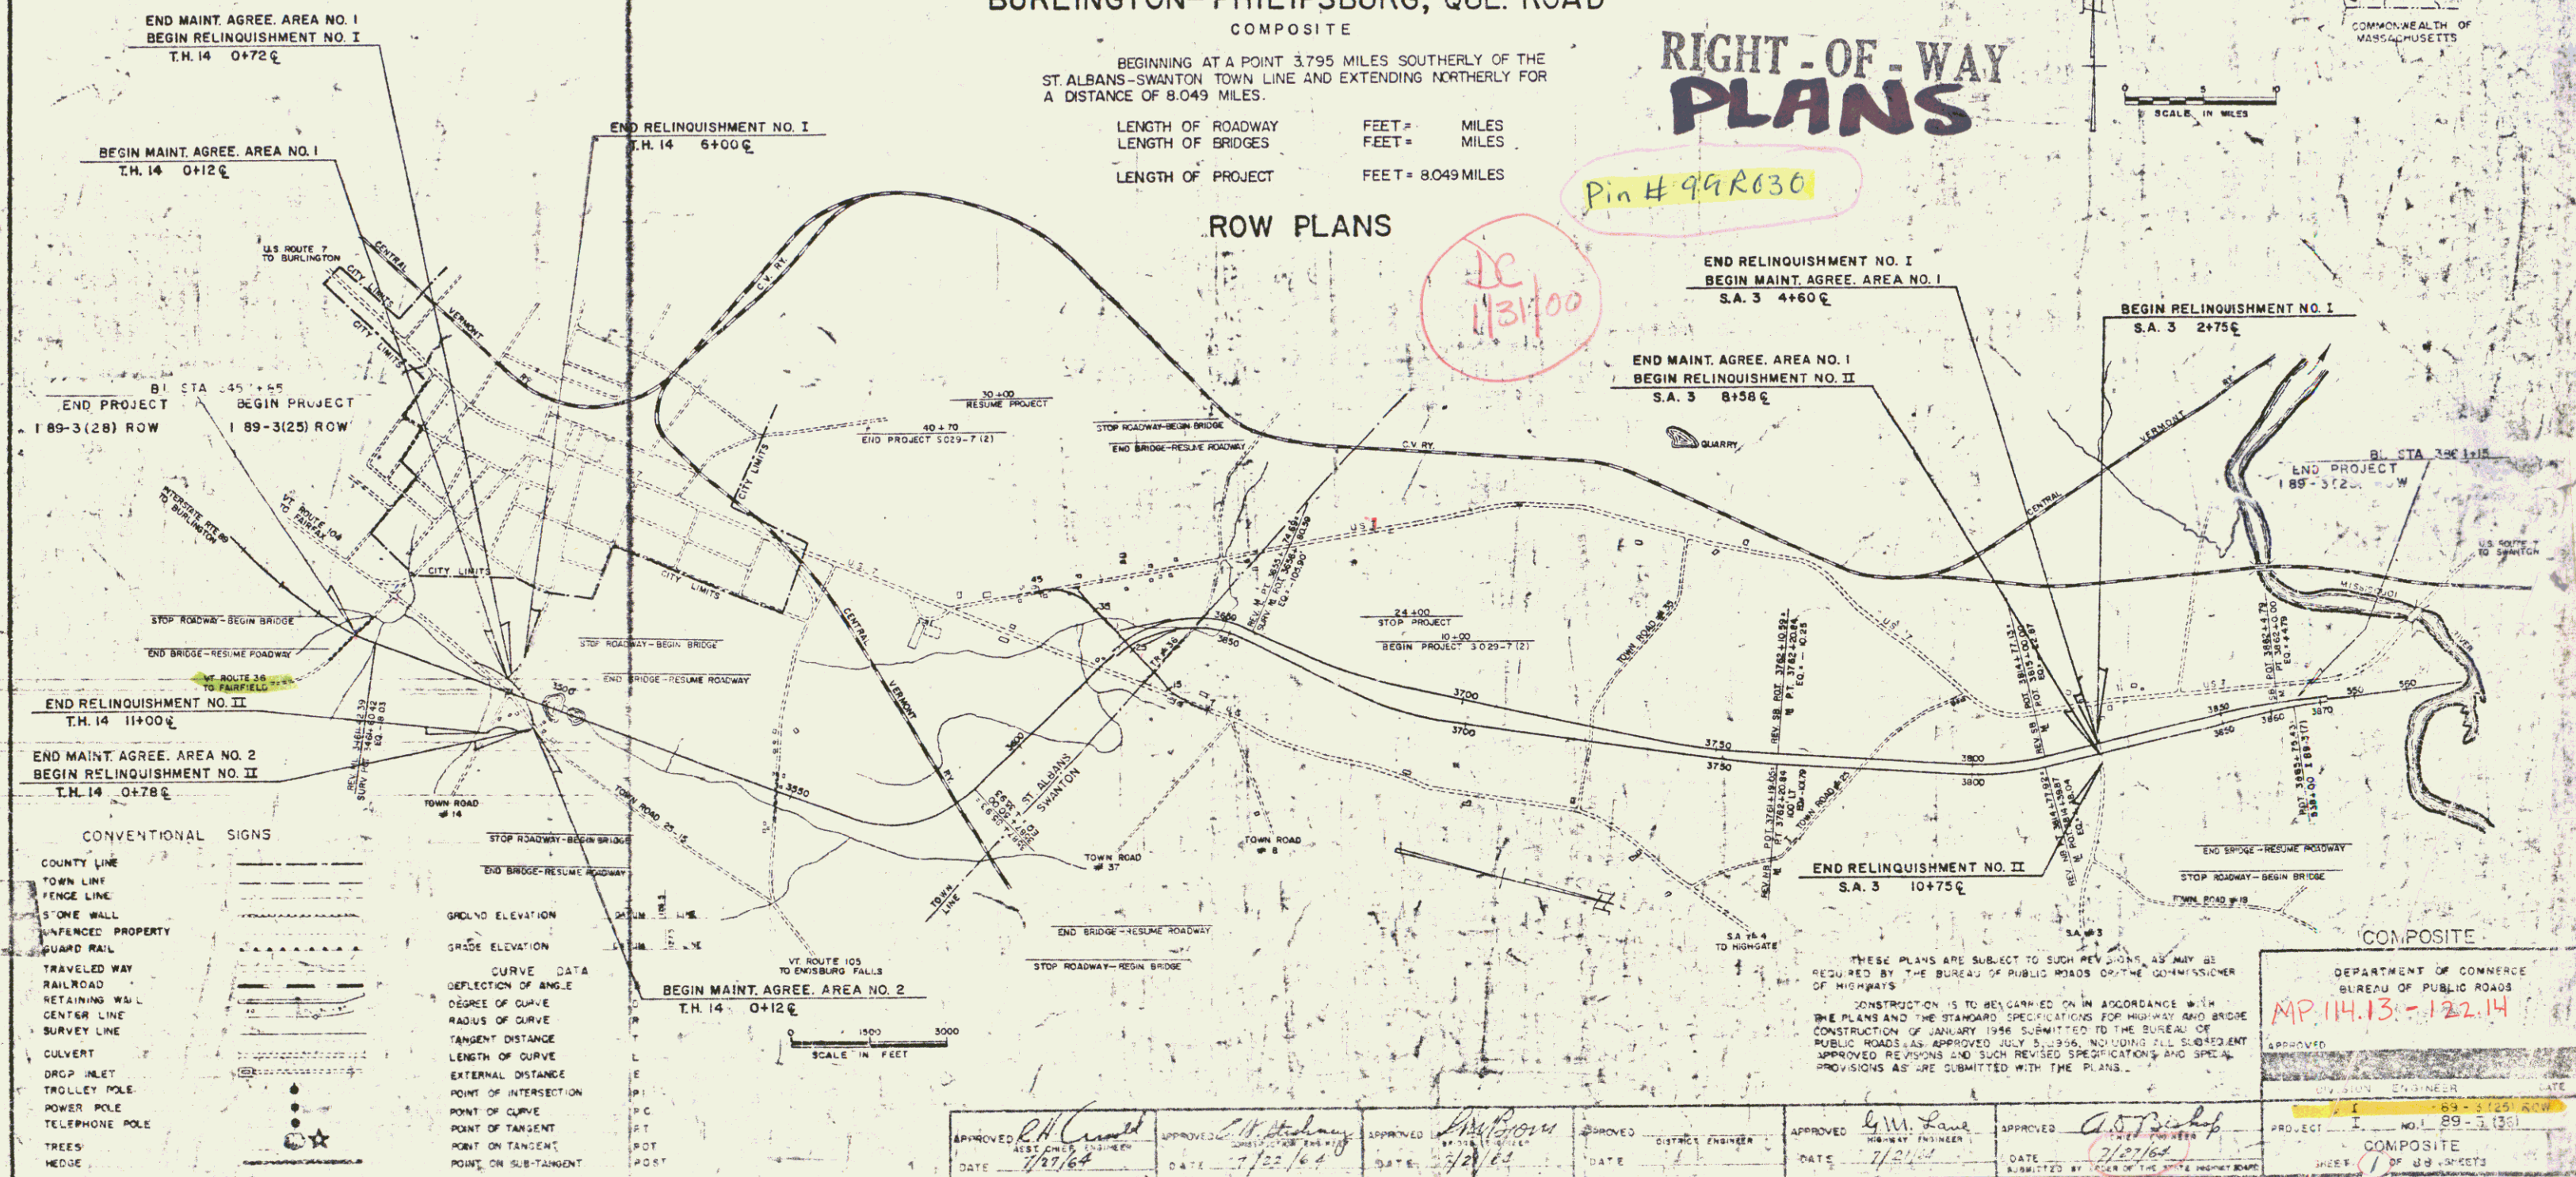

THESE PLANS ARE SUBJECT TO SUCH REVISIONS, AS MAY BE
REQUIRED BY THE BUREAU OF PUBLIC ROADS OR THE COMMISSIONER
OF HIGHWAYS.

CONSTRUCTION IS TO BE CARRIED ON IN ACCORDANCE WITH
THE PLANS AND THE STANDARD SPECIFICATIONS FOR HIGHWAY AND BRIDGE
CONSTRUCTION OF JANUARY 1936, SUBMITTED TO THE BUREAU OF
PUBLIC ROADS AND APPROVED JULY 5, 1936, INCLUDING ALL SUBSEQUENT
APPROVED REVISIONS AND SUCH REVISED SPECIFICATIONS AND SPECIAL
PROVISIONS AS ARE SUBMITTED WITH THE PLANS.

COMPOSITE

DEPARTMENT OF COMMERCE
BUREAU OF PUBLIC ROADS
MP. 114.13-122.14

APPROVED DATE 7/27/64	APPROVED DATE 7/27/64	APPROVED DATE 7/27/64	APPROVED DATE 7/27/64	APPROVED DATE 7/27/64	APPROVED DATE 7/27/64	APPROVED DATE 7/27/64	APPROVED DATE 7/27/64	APPROVED DATE 7/27/64	APPROVED DATE 7/27/64
ASSISTANT ENGINEER	ASSISTANT ENGINEER	ASSISTANT ENGINEER	ASSISTANT ENGINEER	ASSISTANT ENGINEER	ASSISTANT ENGINEER	ASSISTANT ENGINEER	ASSISTANT ENGINEER	ASSISTANT ENGINEER	ASSISTANT ENGINEER
PROJECT NO. 89-3(25) ROW	PROJECT NO. 89-3(25) ROW	PROJECT NO. 89-3(25) ROW	PROJECT NO. 89-3(25) ROW	PROJECT NO. 89-3(25) ROW	PROJECT NO. 89-3(25) ROW	PROJECT NO. 89-3(25) ROW	PROJECT NO. 89-3(25) ROW	PROJECT NO. 89-3(25) ROW	PROJECT NO. 89-3(25) ROW
SHEET 1 OF 10 SHEETS	SHEET 1 OF 10 SHEETS	SHEET 1 OF 10 SHEETS	SHEET 1 OF 10 SHEETS	SHEET 1 OF 10 SHEETS	SHEET 1 OF 10 SHEETS	SHEET 1 OF 10 SHEETS	SHEET 1 OF 10 SHEETS	SHEET 1 OF 10 SHEETS	SHEET 1 OF 10 SHEETS

Row Plan

STATE OF VERMONT
DEPARTMENT OF HIGHWAYS
RIGHT-OF-WAY PLANS
DETAIL SHEET 1 OF 5

TABLE OF PROJECT PROPERTY ACQUISITION

PARCEL NO.	GRANTOR	SHEET NO.	BEGINNING STATION	ENDING STATION	TAKING	REM.	RIGHTS	TITLE TAKEN	DATE	TOWN OR CITY RECORDED	BK.	PG.	REMARKS
1. A B C	CARLTON P. SOULE & D. FRANCIS HOURIGAN	18.21 19 20	3457+37 2+00 Vt 36 3459+50 BL 20+00 Vt 36	3469+41 3458+40 BL 1.5A 20+00 Vt 36 2.0A	7.7A LA 123.8A		DRAINAGE " "	COND	11-22-65	ST. ALBANS	21	36-40	SPRING HOUSE
2. A B C	EQUITIES, INC.	21.22 23.25 24	3468+90 0+50 TR 25 8+44 TR 14	3496+23 3492+50 BL 5.0A 11+00 TR 14 0.1A	19.6A LA 450.3A		(0.1A) SLOPE RIGHTS DRAINAGE DITCHING DRAINAGE " DITCHING DRAINAGE " (0.2A) SLOPE RIGHTS DRAINAGE "	COND	11-22-65	ST. ALBANS	21	36-40	DREDGE PRESENT STREAM
3.	GUIDO, DAVID J. & JEANE M.	22.26	3490+53 4+50 TR 14 19+90 TR 15	3493+11 20+85 TR 15 4+00 TR 14 6+90 TR 14	0.6A LA 1.4A		DRIVE (1500 sq. ft.) SLOPE RIGHTS DRAINAGE & DITCHING WATER LINE CROSSING	COND	11-22-65	ST. ALBANS	21	36-40	
4.	RAINE, LEO W. & CAROL E.	24	6+35 TR 14 6+90 TR 14				DRIVE WATER LINE CROSSING	W.D.	8-2-65	ST. ALBANS	20	487	
5. A B	GRATTON, ALPHONSE W. & ALMA L.	25.27 28	3501+30 11+00 TR 14 0+73 TR 14	3534+59 24+42 TR 15 4+25 TR 14 8+00 TR 14 20+85 TR 15 3+00 TR 14 4+00 TR 14 3509+00 LT 3511+71 LT 3516+00 RT 3520+00 RT 3525+63 RT 3529+00 RT 3533+00 RT 7+60 TR 14 RT	20.8A LA 31.1A 1.8A		(0.2A) SLOPE RIGHTS (150 sq. ft.) " " (0.4A) " " DITCHING DRAINAGE " " " " " " (1,395 S.F.) SLOPE RIGHTS	COND	11-22-65	ST. ALBANS	21	36-40	LOSS OF ACCESS 54.2A

TABLE OF REVISIONS

REVISION NO.	SHEET NO.	DESCRIPTION OF REVISION	DATE	MADE BY	APPROVED BY
1	18	13+00 Vt 36 RT Pipe Note revised			
2	18	13+00 Vt 36 Lt. Pipe Note revised			
3	18	15+20 Vt 36 Lt. Pipe Note revised			
4	18	3457+00 P.O.S.T. added			
5	19	6+50 Vt 36 RT. Pipe Note revised			
6	19	6+50 Vt 36 Lt. Pipe Note revised			
7	20	13+00 Vt 36 Lt. Pipe Note revised			
8	20	15+20 Vt 36 Lt. Pipe Note revised			
9	20	13+00 Vt 36 RT. Pipe Note revised			
10	20	3461+00 & Lt. Added to Pipe Note			
11	21	Added gage no. & changed length of pipe at 3459+88 NB-3461+60 SB			
12	21	Added gage no. to pipe at 3461+60 &			
13	21	Added gage to pipe at 3465+00 SB			
14	21	Added gage to pipe at 3465+00 NB			
15	21	Added gage to pipe at 3468+92 SB			
16	21	Added gage to pipe at 3468+92 SB	10-6-66	Chase	ADG
17	22	Added sideline stationing, topo, construction & two design notes.			
18	23	3+79 - 4+07 Lt. Changed pipe specs.			
19	23	3+89 - 4+16 Rt. Changed pipe specs.			
20	23	9+00 Changed pipe specs.			
21	24	7+85 Rt - 8+07.5 Lt. Changed Pipe Specs.			
22	24	4+00 Changed pipe specs.			
23	24	0+30 Changed pipe specs.			
24	24	20+95 RT - 21+05 Lt. Changed pipe specs.			
25	25	2+31.2 Changed pipe specs.			
26	25	5+50 Changed Pipe specs.			
27	26	Added gage to pipe at 3498+50 N.B.			
28	26	Added gage to pipe 3502+00 N.B.			
29	26	Added gage & changed pipe size at 3505+50 NB & 5.0			
30	26	Added gage to pipe at 3506+00 N.B.			
31	29	Added item no. to pipe at 3542+00 - 3544+00			
32	29	Added P.O.T. Note			
33	29	11+05 - 14+90 Vt 105 Lt. Added special ditch.			
34	30	Same as rev. No. 33			

LEGEND

MADE BY: MMG. DATE: 9/18/64

CHECKED BY: [Signature] DATE: 9/18/64

--- TAKING WITHOUT ACCESS
--- TAKING WITHOUT ACCESS ALONG PROPERTY LINES
--- TAKING WITH ACCESS

--- SR --- SR --- SLOPE RIGHTS
--- PROPERTY LINE
--- Δ --- Δ --- TOP OF CUT
--- ○ --- ○ --- TOE OF SLOPE

APPROVED: J.C. Bernatchez DATE: 9/21/64
APPROVED: [Signature] DATE: 9/21/64
APPROVED: [Signature] DATE: 9/21/64
ST. ALBANS - SWANTON
SHEET 25 OF 42

STATE OF VERMONT
DEPARTMENT OF HIGHWAYS
RIGHT-OF-WAY PLANS
DETAIL SHEET 2 OF 5

TABLE OF PROJECT PROPERTY ACQUISITION

PARCEL NO.	GRANTOR	SHEET NO.	BEGINNING STATION	ENDING STATION	TAKING	REM.	RIGHTS	TITLE TAKEN	DATE	TOWN OR CITY RECORDED	BK.	PG.	REMARKS
6A	GARCEAU, GASTON J. & THERESA D.	24	23+14 TR 15	24+42 TR 15	0.1A±	0.4A±	(753 sq ft.) SLOPE RIGHTS	COND.	11-22-65	ST. ALBANS	21	36-40	
7A	SPORTSMAN'S CLUB OF FRANKLIN COUNTY, INC.	26	34+95+51	3502+60	4.3A±	9.3A±	DRAINAGE (200 sq ft.) SLOPE RIGHTS	COND.	11-22-65	ST. ALBANS	21	36-40	6.9A± LOSS OF ACCESS
B		24	34+95+51 BL 21+05 TR 15	23+35 TR 15	1.1A±								
8A	BRODEUR, PHILIP C. & IRENE M.	28	3533+80	3538+33	2.3A±	132.5A±	DRAINAGE DRIVE	COND.	11-22-65	ST. ALBANS	21	36-40	
B		29, 30	11+04 Vt 105	15+50 Vt 105	0.5A±								
9A	COLLINS, ALWIN D. & MARTHA D.	29	3542+08	3546+61	0.3A±	4.4A±	DRAINAGE DRIVE	COND.	11-22-65	ST. ALBANS	21	36-40	
B		29	3545+93 BL 3+00 Vt 105	2+27 Vt 105	0.3A±								
10A	TESSIER, LEON L. & ROSE M.	28, 29	3537+52	3549+60	7.4A±	6.3A±	DRAINAGE	COND.	11-22-65	ST. ALBANS	21	36-40	HOUSE, BARN
B		29, 30	3546+72	15+50 Vt 105	1.5A±								0.8A± LOSS OF ACCESS
11A	COLLINS, ALWIN D. & MARTHA D.	29	3548+80	3549+72	0.2A±	4.4A±	(503 sq ft.) SLOPE RIGHTS DRIVE	COND.	11-22-65	ST. ALBANS	21	36-40	SPRING HOUSE
B		29	2+37 Vt 105	3547+50 BL 3+60 Vt 105	0.4A±								
12	ROCHELEAU, HARRIET M.	29, 31	3549+04	3583+59	20.2A±	199.8A±	DRAINAGE	COND.	11-22-65	ST. ALBANS	21	36-40	
		32	3554+75 Rt				"						
			3557+00 Rt				"						
			3560+00 Rt				"						
			3564+50 Rt				"						
			3568+00 Rt				"						
			3572+00 Rt				"						
			3576+00 Lt				"						
			3579+00 Lt				"						
13	CENTRAL VERMONT RAILWAY, INC.	32	3583+37	3583+77	0.1A±	NA	CROSSING EASEMENT (300 sq ft.) SLOPE RIGHTS (3500 sq ft.)	COND.	11-22-65	ST. ALBANS	21	36-40	
			3583+55	3584+25									
			3583+59 Rt	3583+72 Lt									
			3583+93 Rt	3584+25 Lt									

TABLE OF REVISIONS

REVISION NO.	SHEET NO.	DESCRIPTION OF REVISION	DATE	MADE BY	APPROVED BY
35	30	14+00 LT - 14+50 RT Changed pipe length			
36	32	Added gage to pipe at 3579+00 SB			
37	33	Added gage to pipe at 3588+00 SB			
38	33	Added gage & Elbows to pipe at 3592+00 SB			
39	35	Added interchanged, Topo, Constr. design notes			
40	37	Added gage no. & Changed pipe length on pipe at 3650+75 NB			
41	37	Added gage no. & Changed pipe length on pipe at 3651+95 SB			
42	37	Added gage to pipe at 3660+00 NB			
43	38	Deleted pipe at 3667+00 N.B.			
44	38	Deleted underdrain at 3675+50 - 3680+00 NB LT			
45	38	Added gage to pipe at 3675+00 SB			
46	40	Added gage to pipe at 3699+00 N.B.			
47	46	Added bearing			
48	46	Added Guard rail Note			
49	50	Chgd pipe to 3854+50 NB			
50	50	Deleted pipe at 3854+93 NB			
51	50	Deleted pipe at 3858+00 N.B.			
52	50	Added to Curve Data Note			
53	51	Chgd const. limits rt. d 3860+50 - 3865+00 N.B.			
54	28, 29	Chgd PL between parcels 8 & 10			
55	29	Parcel 11 sold to owner of Parcel 9	1-14-65	Silver	1-2
56	22, 24, 26	Change in ownership (Parcel #3)			
57	24	PARCEL #5B DECREASED TAKE(0.2A) AND ADDED SLOPE RIGHTS PER BPR LETTER (4-6-65)	4-14-65	MMG	1-2
58	26, 27	Parcel #5A "Loss of Access" increased 4.9A± per recomputation and Change Order #139	9-1-65	MMG	1-2
59	24	Parcel #6 Property line changed, slope rts. reduced (200 sq ft), no change in area of take or remainder, per Change Order #152	9-16-65	MMG	1-2
60	24, 26	Parcel #7A & B Property line changed for ROW of drive, slope rts. added (200 sq ft), no change in area of take or remainder per Change Order #152	9-16-65	MMG	1-2

LEGEND

MADE BY: M.M.G. DATE: 9/18/64

CHECKED BY: G.M. Egan DATE: 9/18/64

--- TAKING WITHOUT ACCESS
--- TAKING WITHOUT ACCESS ALONG PROPERTY LINES
--- TAKING WITH ACCESS

--- SR --- SR --- SLOPE RIGHTS
--- PROPERTY LINE
--- Δ --- Δ --- TOP OF CUT
--- ○ --- ○ --- TOE OF SLOPE

APPROVED: T.C. Bernatchey DATE: 9/21/64
APPROVED: B.M. Lang DATE: 9/21/64
APPROVED: [Signature] DATE: 9/21/64
ST. ALBANS - SWANTON
SHEET 68 OF 112 I 89-3(29)

STATE OF VERMONT
DEPARTMENT OF HIGHWAYS
RIGHT-OF-WAY PLANS
DETAIL SHEET 3 OF 5

TABLE OF PROJECT PROPERTY ACQUISITION

PARCEL NO.	GRANTOR	SHEET NO.	BEGINNING STATION	ENDING STATION	TAKING	REM.	RIGHTS	TITLE TAKEN	DATE	TOWN OR CITY RECORDED	BK.	PG.	REMARKS
14	Laurie, Erdine M., Laurie, Jesse M., Laurie, Richard M.	32, 33, 34, 35	3584+03 3572+00LT 3576+00RT 3600+00RT 3604+00RT 3601+65LT 3604+30RT 3619+30LT 3620+35LT 3588+00LT	3622+11 3620+00 3621+32 BL 3604+40RT 3618+30RT 3604+00RT 3621+10LT 3640+65NBRT	24.8A±LA 1.2A±LA 1.8A±LA	20.2A±	DRAINAGE " " DITCHING " DRAINAGE DITCHING DRAINAGE	COND.	11-22-65	ST. ALBANS	21	36-40	18.5A± Loss of Access DREDGE PRESENT STREAM DREDGE PRESENT STREAM DREDGE PRESENT STREAM
15 A B C	Dussault, Mary L.	34, 35, 36	3605+80 3620+00 3621+32 BL 3604+40RT 3618+30RT 3604+00RT 3621+10LT 3640+65NBRT	3645+52 3628+00 30+00 SR 4 3605+00RT 3619+00RT 3621+60LT 3640+65NBRT	25.0A±LA 1.2A±LA 1.8A±LA	115.0A±	DITCHING " DRAINAGE DITCHING DRAINAGE	COND.	11-22-65	ST. ALBANS	21	36-40	15.0A± REMAINDER INCLUDES LANDS ON PROJECT 5029-7(2) 15.0A± HOUSEGAR NON-PARTICIPATING DREDGE PRESENT STREAM 15.0A± NON-PARTICIPATING DREDGE PRESENT STREAM
16 A B C D	TOWN OF SWANTON	36, 41, 44, 47	3642+22 NB 3724+67 BL 3778+13 3825+07	3645+52 BL 3723+74 NB 3780+90 3825+43			TR 36 RIGHT TITLE INTEREST TR 35 RIGHT TITLE INTEREST TR 25 RIGHT TITLE INTEREST SR 3 RIGHT TITLE INTEREST	COND.	11-20-65	SWANTON	76	417-19	
17	HUBBARD, Ralph C & Patricia P.	36, 37	3642+22 NB 3651+75 BLT 3661+00 BLT	3644+38 BL	16.1A±LA	109.9A±	DRAINAGE & DITCHING DRAINAGE	COND.	11-20-65	SWANTON	76	417-19	15.7A± Loss of Access
18	SALISBURY, Ernest E & HUDAK, VIRGINIA	36	3646+79 BL	3651+07 BL	0.8A±LA	169.2A±		COND.	11-20-65	SWANTON	76	417-19	13.7A± Loss of Access
19	HUBBARD, George F & EUGENIA N.	37, 38	3660+77 NB 3665+00 BLT 3670+00 BLT	3673+56 BL	10.2A±LA	129.8A±	DRAINAGE "	COND.	11-20-65	SWANTON	76	417-19	
20	WILDER, Wilcox P & CAROLYN M.	38, 39	3669+75 NB 3675+00 BLT 3681+50 NBRT 3683+50 NBRT 3685+50 BLT 3679+50 BLT 3684+00 BLT	3691+93 BL	26.4A±LA	98.6A±	DRAINAGE " " " "	COND.	11-20-65	SWANTON	76	417-19	7.2A± Loss of Access

TABLE OF REVISIONS

REVISION NO.	SHEET NO.	DESCRIPTION OF REVISION	DATE	MADE BY	APPROVED BY
61	4344	Parcel #24 P/L Relocated, taking reduced (12.7A±) and remainder reduced (20.5A±) and loss of access reduced (21.0A±) per C.O. #162.	9-17-65	M.N.D.	4PR
62	4344	Parcel #26 P/L Relocated, taking increased (12.7A±) and remainder increased (20.5A±) per C.O. #163.	9-17-65	M.N.D.	4PR
63	49, 50	Parcel #30A and Parcel #34 - correction of property line, no change in taking area, per Change Order #177.	9-30-65	MMB	1/2
64	4243 44	Parcel #24 Change in total area acreage; increased (17.2A±) per Change Order #181.	10-5-65	MMG	1/2
65	18, 19 20, 21	Parcel #1 Change of ownership per Change Order #191.	10-18-65	MMG	1/2
66	49	Parcel #24 Proposed future farm pond shown with relocated Special Ditch serving as outlet per Change Order #200.	11-18-65	MMG	1/2

LEGEND

MADE BY: WGS DATE: 9/14/64
CHECKED BY: J.M. Pene DATE: 9/18/64

--- TAKING WITHOUT ACCESS
--- TAKING WITHOUT ACCESS ALONG PROPERTY LINES
--- TAKING WITH ACCESS

SR SR SLOPE RIGHTS
--- PROPERTY LINE
--- TOP OF CUT
--- TOE OF SLOPE

APPROVED: T.C. Bernatchez DATE: 9/21/64
APPROVED: J.M. Pene DATE: 9/21/64
APPROVED: Max Wright DATE: 9/21/64
ST. ALBANS-SWANTON 189-3(25)
SHEET 27 OF 88 SHEETS

DETAIL SHEET 4 OF 5

TABLE OF REVISIONS

REVISION NO.	SHEET NO.	DESCRIPTION OF REVISION	DATE	MADE BY	APPROVED BY

APPROVED T.C. Bernatchez DATE 8/21/64
 APPROVED G. M. Lane DATE 8/21/64
 APPROVED Max Sargent DATE 9/21/64
ST. ALBANS - SWANTON
 8 88
 20 of 412 I 89-362

STATE OF VERMONT
DEPARTMENT OF HIGHWAYS
RIGHT-OF-WAY PLANS

TABLE OF PROJECT PROPERTY ACQUISITION

PARCEL NO.	GRANTOR	SHEET NO.	BEGINNING STATION	ENDING STATION	TAKING	REM.	RIGHTS	TITLE TAKEN	DATE	TOWN OR CITY RECORDED	BK.	PG.	REMARKS
30.A B C	SEARS, ALBERT A. SEARS, EDWARD T.	47.49 50.51 98	3825+07 3859+35 NB 3824+87 3837+50 BL 3840+50 BL	3842+65 3864+90 BL 3825+41	8.7A:LA 2.2A:LA 0.2A:	371.9A:		COND.	11/20/65	SWANTON	76	417.19	
							DRAINAGE "						
31.A B	BUSHEY, ROBERT R. & GERALDINE J.	47.49 47	3825+16 3825+43	3832+88 3825+98	4.1A:LA 0.1A:	4.7A:		COND.	11-20-65	SWANTON	76	417.19	
32.	BERTHIAUME, FRANCOIS T. & ANTONIA H.	47	3825+19	3825+64	3200±	244.0A:		COND.	11-20-65	SWANTON	76	417.19	
33.	BABY, HENRI & AUDREY A.	49	3831+45 3831+50 LT	3836+15	1.2A:LA	6.8A:		COND.	11-20-65	SWANTON	76	417.19	
							DRAINAGE " "						
34.	HOWRIGAN, W. P.	49.30 51	3837+05 BL 3852+40 BL 3858+03 BL 3844+23 BL	3862+98 BL	20.5A:LA	40.6A:		COND.	11-20-65	SWANTON	76	417.19	32.0A* LOSS OF ACCESS BARN, SHED, MILK HOUSE, GARAGE, SPRING.
35.	BELLROSE, LAWRENCE J. & MERCEDES C.	51	3859+97 BL	3861+96 BL	0.1A:LA	0.9A:		COND.	11-20-65	SWANTON	76	417.19	
36.	WAITE, FRANCES M.	51	3861+95 BL	3864+19 BL	2200±	1.0A:		COND.	11-20-65	SWANTON	76	417.19	
37.A B C D	TOWN OF ST. ALBANS	22 22 25 35	3490+53 3487+00 3490+79.87 3621+32	3490+79.87 3490+79.87 20+00 TR 15 3622+70			TR 1/4, RIGHT, TITLE, & INTEREST TR 25, " " " TR 15, " " " SA 4, " " "	COND.	11-22-65	ST. ALBANS	21	3640	

TABLE OF REVISIONS

REVISION NO.	SHEET NO.	DESCRIPTION OF REVISION	DATE	MADE BY	APPROVED BY

MADE BY: MMG. DATE 9/18/64

CHECKED BY: John Davis DATE 9/18/64

LEGEN

 TAKING WITHOUT ACCESS
 TAKING WITHOUT ACCESS ALONG PROPERTY LINE
 TAKING WITH ACCESS

-----SR-----SR----- SLOPE RIGHTS
 ----- PROPERTY LINE
 ----- Δ ----- Δ ----- Δ ----- TOP OF CUT
 ----- ○ ----- ○ ----- ○ ----- TOE OF SLOPE

APPROVED T.C. Bernatchez DATE 7/21/64

APPROVED G. M. Lane DATE 9/21/64

APPROVED Max Lighty DATE 9/21/64

ST. ALBANS - SWANTON
SHEET 9 OF 88 SHEETS I 89-1

SHEET 9 OF 88 SHEETS 189-
 Plot #12

STATE OF VERMONT
DEPARTMENT OF HIGHWAYS
RIGHT-OF-WAY PLANS
DETAIL SHEET

TABLE OF PROJECT PROPERTY ACQUISITION

PARCEL NO	GRANTOR	SHEET NO.	BEGINNING STATION	ENDING STATION	TAKING	REM.	RIGHTS	TITLE TAKEN	DATE	TOWN OR CITY RECORDED	BK.	P.G.	REMARKS
	RELINQUISHMENT NO. I	25	0+72 E	6+00 E				AGREE	10-1-79	ST. ALBANS TOWN	34	192-195	T.H. 25 (FORMERLY T.H. 14)
	RELINQUISHMENT NO. II	24	0+78 E	11+00 E				AGREE	10-1-79	ST. ALBANS TOWN	34	192-195	T.H. 14
	MAINTENANCE AGREEMENT AREA NO. 1	25	0+12 E	0+72 E				AGREE	10-1-79	ST. ALBANS TOWN	34	192-195	T.H. 25 (FORMERLY T.H. 14)
	MAINTENANCE AGREEMENT AREA NO. 2	24	0+12 E	0+78 E				AGREE	10-1-79	ST. ALBANS TOWN	34	192-195	T.H. 14
	RELINQUISHMENT NO. I	47,48	2+75 E	4+60 E				AGREE	10-1-79	SWANTON	96	271-272	S.A. 3
	RELINQUISHMENT NO. II	47,48	8+58 E	10+75 E				AGREE	10-1-79	SWANTON	96	271-272	S.A. 3
	MAINTENANCE AGREEMENT AREA	47,48	4+60 E	8+58 E				AGREE	10-1-79	SWANTON	96	271-272	S.A. 3

TABLE OF REVISIONS

[illegible]

MADE BY: NBB DATE 10-5-79

CHECKED BY: _____ DATE _____

DR. RT. - DRAINAGE RIGHT
DT. RT. - DITCHING RIGHT
OH. RT. - CHANNEL RIGHT
DRIVE RT. - DRIVE RIGHT
CL. RT. - CULVERT RIGHT
D () - DEMOLITION OR
REMOVAL
W - WATER SOURCES

_____ PRESENT R.O.W.
 - - - - -
 /// - - - - - TAKING WITHOUT ACCESS
 - - - - -
 - - - - - P - - - - - TAKING WITHOUT ACCESS ALONG PROPERTY LINES
 - - - - - L - - - - -
 _____ TAKING WITH ACCESS

 (P) PERMANENT EASEMENT
 (T) TEMPORARY EASEMENT


LEGEND


---	CONST EASE	---	CONST EASEMENT
—SR—	SR	—SR—	SLOPE RIGHTS
—P—	P	—P—	PROPERTY LINE
—Δ—	Δ	—Δ—	TOP OF CUT
—○—	○	—○—	TOE OF SLOPE

APPROVED _____ DATE _____
CHIEF OF PLANS & TITLES

PROJECT ST. ALBANS-SWANTON
NO. I 89-3(25)
SHEET 9A OF 88

ROW

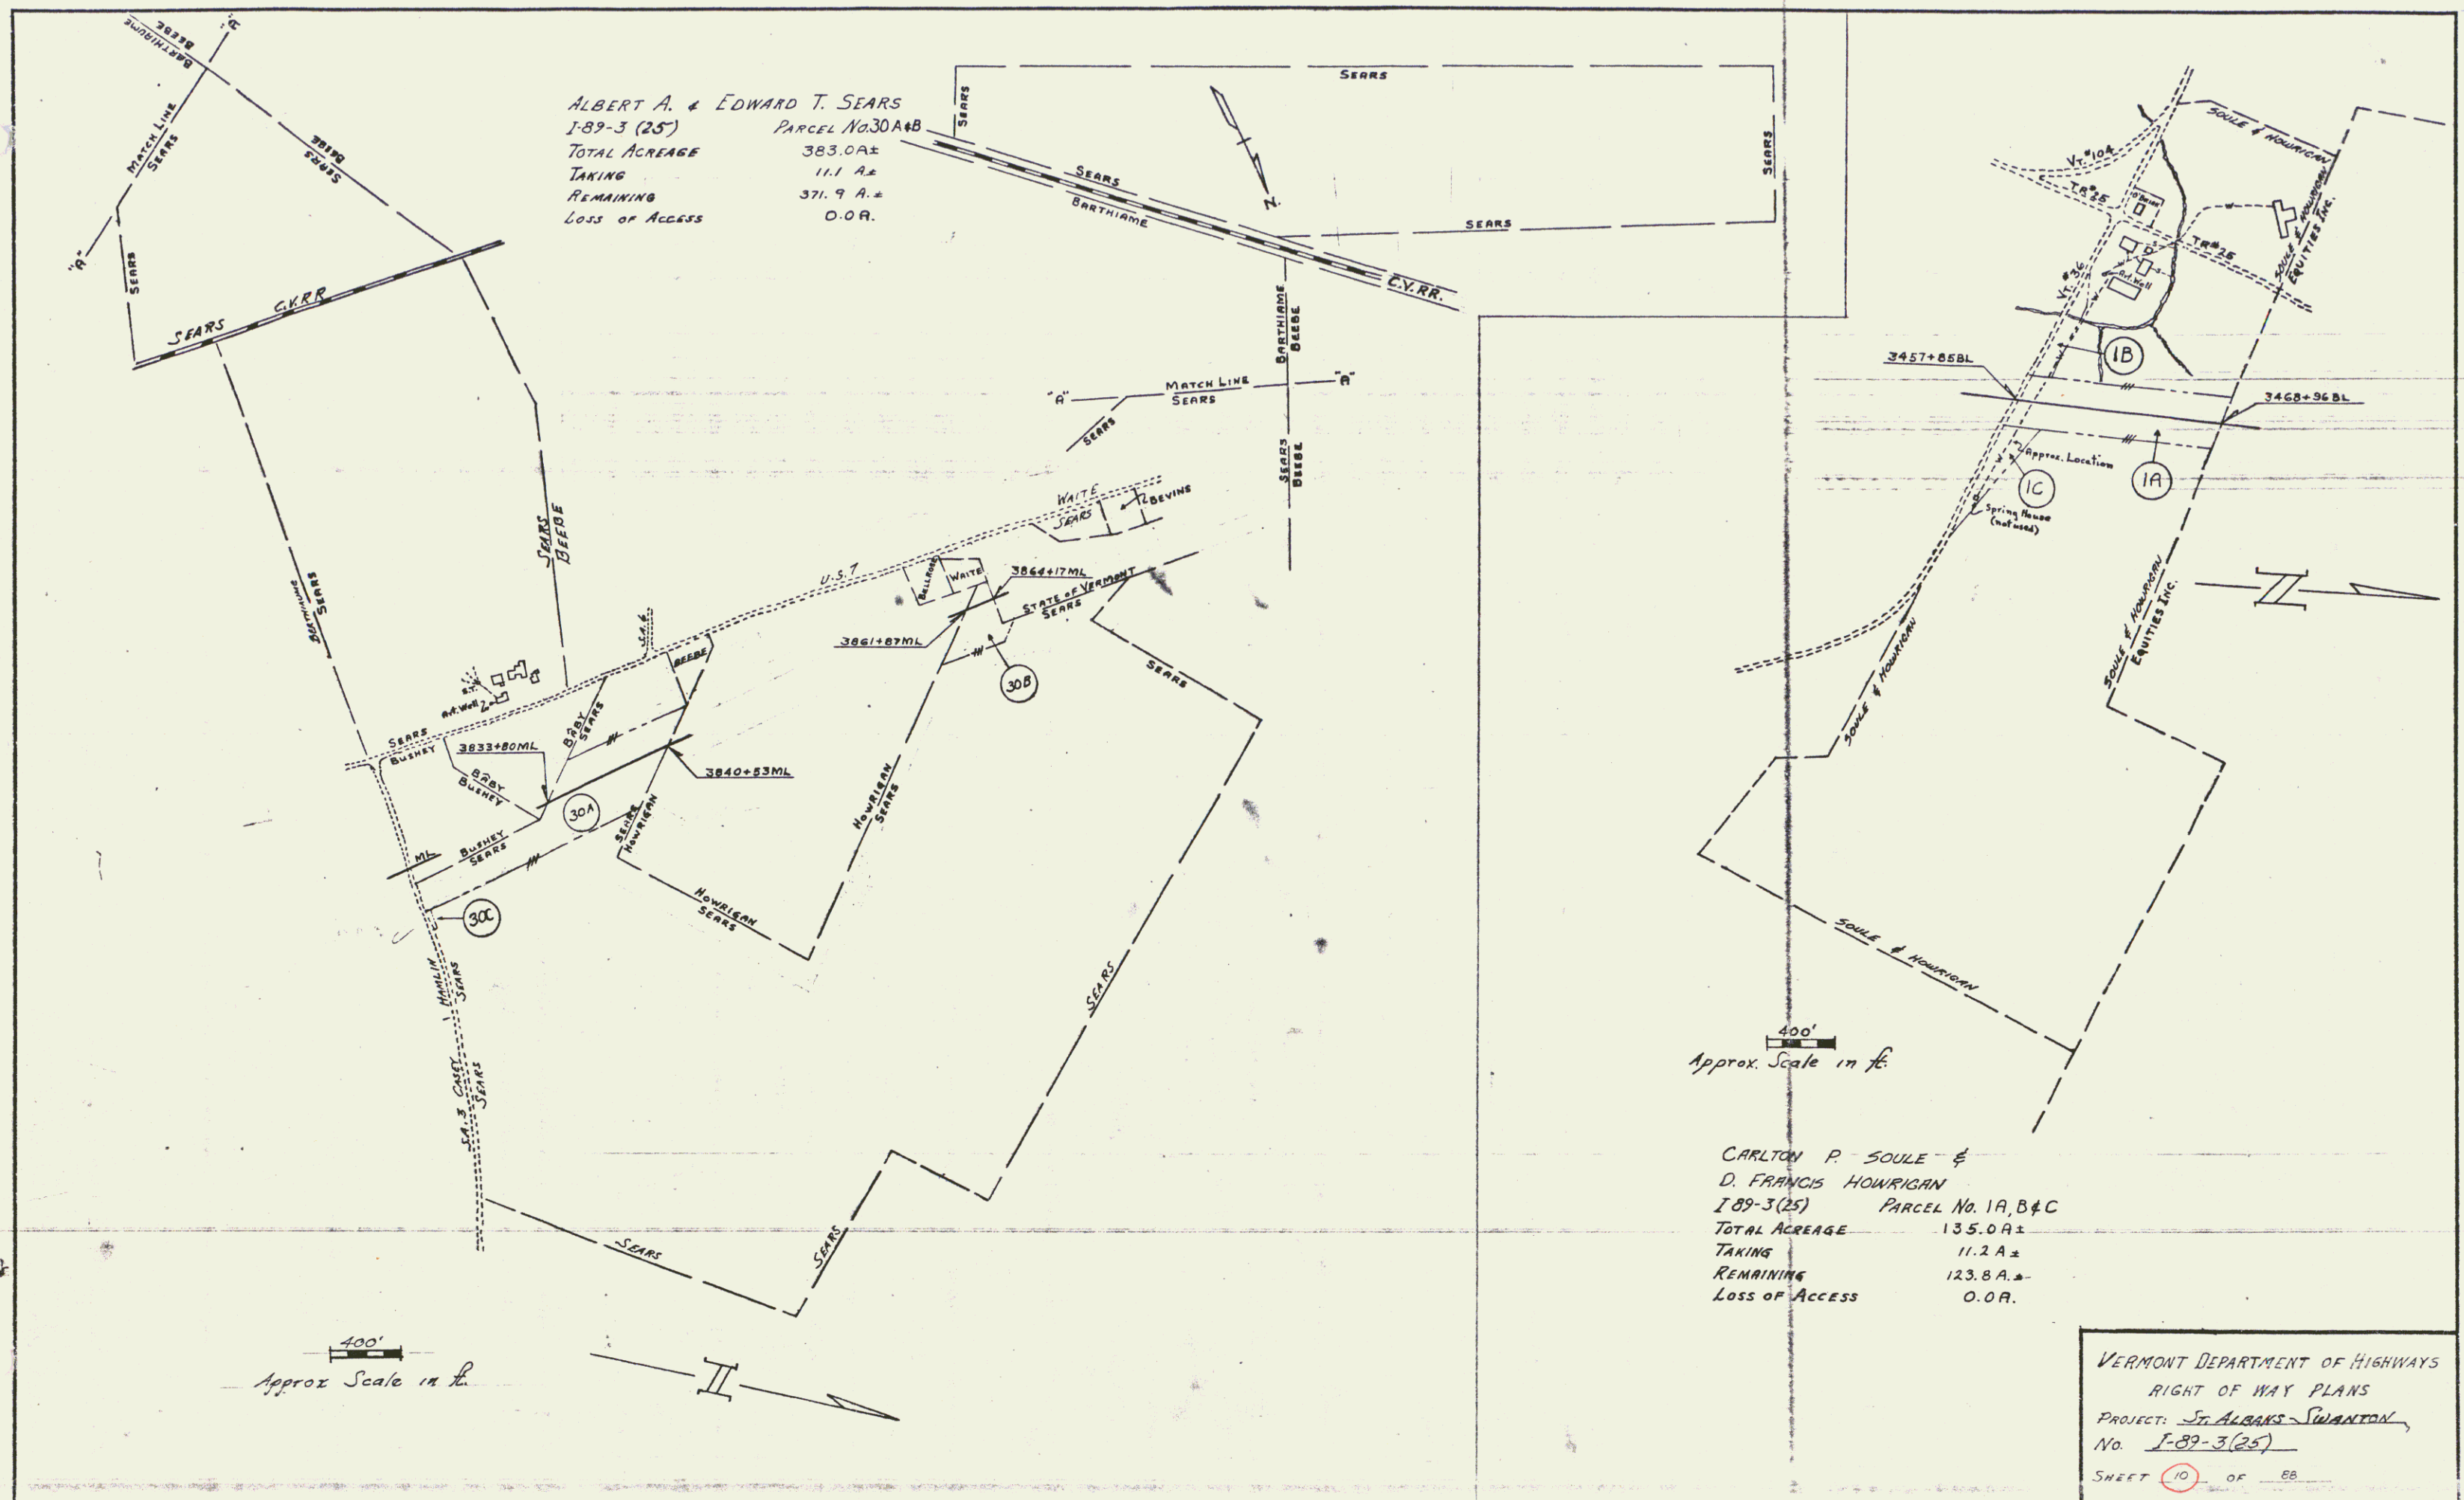

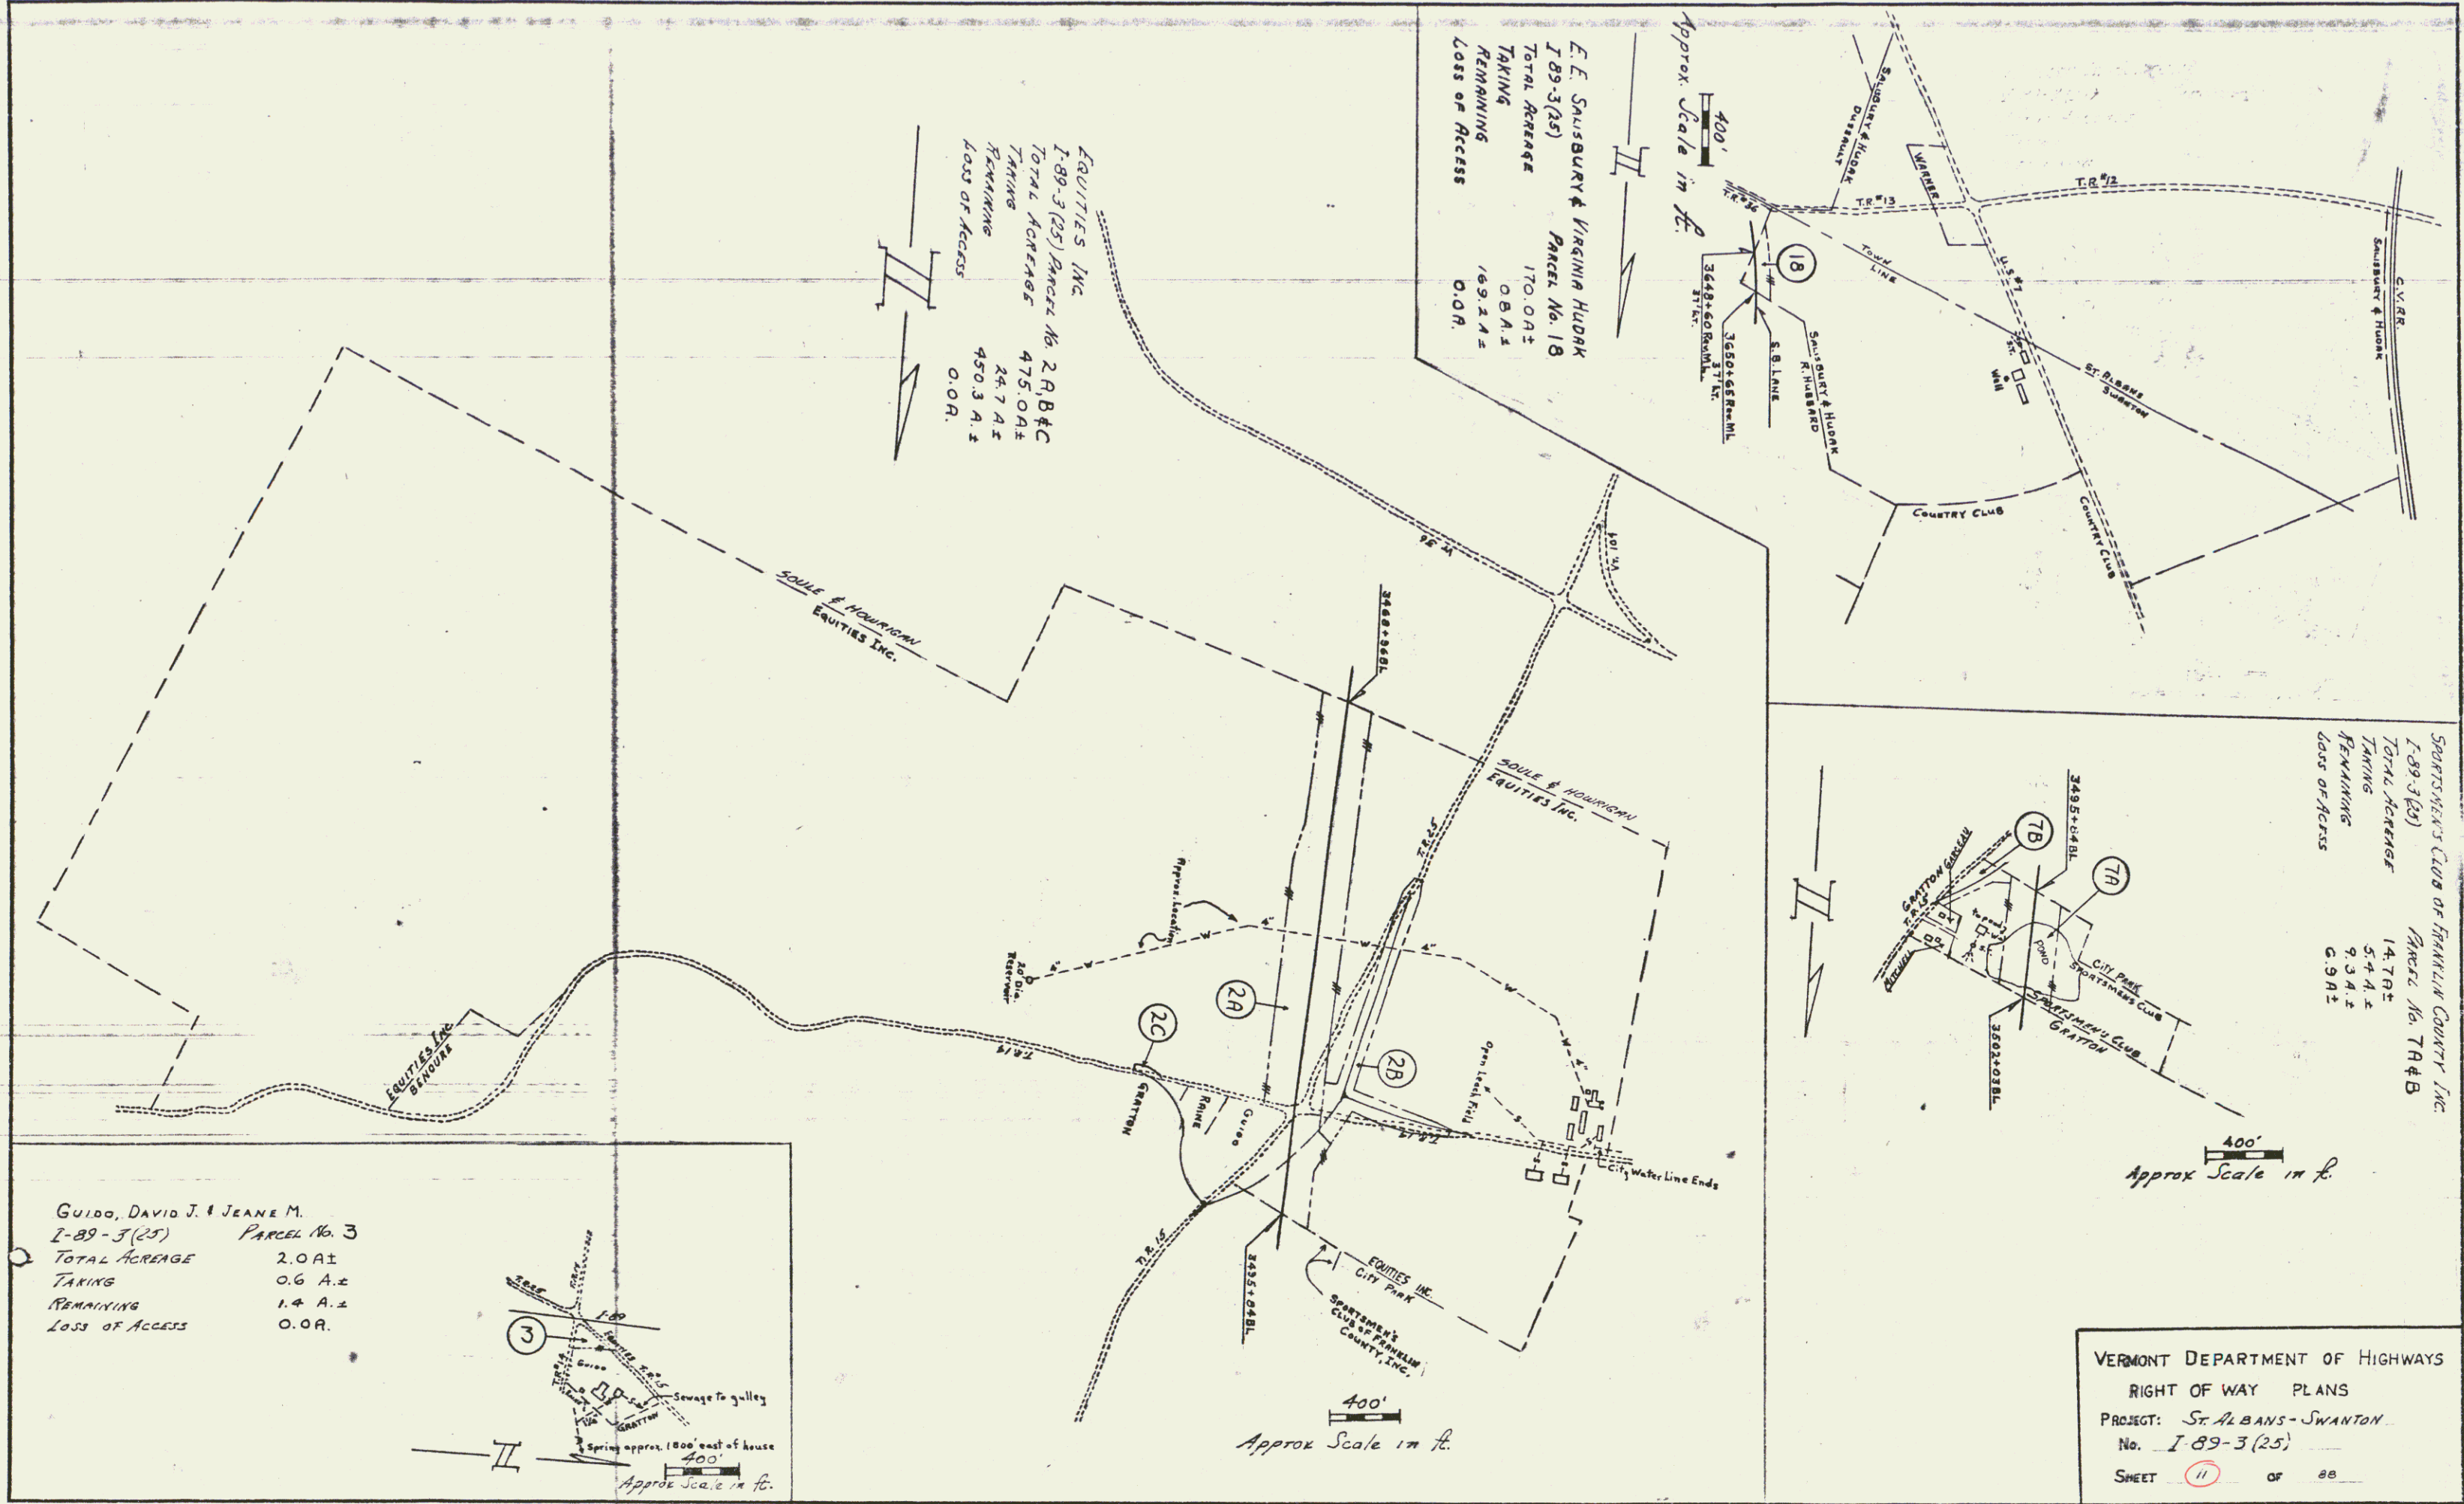


E. E. SAUSBURY & VIRGINIA HUDAK
I-89-3(25) Parcel No. 18
TOTAL ACREAGE 170.0 A±
TAKING 0.8 A±
REMAINING 169.2 A±
LOSS OF ACCESS 0.0 A±

EQUITIES INC.
I-89-3(25) Parcel No. 2, 2B & C
TOTAL ACREAGE 475.0 A±
TAKING 24.7 A±
REMAINING 450.3 A±
LOSS OF ACCESS 0.0 A±

SPORTSMEN'S CLUB OF FRANKLIN COUNTY INC.
Parcel No. 7A & B
TOTAL ACREAGE 14.7 A±
TAKING 5.4 A±
REMAINING 9.3 A±
LOSS OF ACCESS 0.9 A±

GUIDO, DAVID J. & JEANE M.
I-89-3(25) Parcel No. 3
TOTAL ACREAGE 2.0 A±
TAKING 0.6 A±
REMAINING 1.4 A±
LOSS OF ACCESS 0.0 A±


VERMONT DEPARTMENT OF HIGHWAYS
RIGHT OF WAY PLANS
PROJECT: ST. ALBANS - SWANTON
No. I-89-3(25)
SHEET 11 OF 28

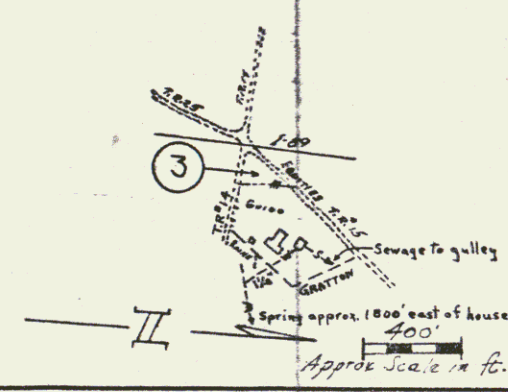



ALPHONSE W. & ALMA L. GRATTON
I-89-3(25) PARCEL No 5A&B
TOTAL ACREAGE 367.0A±
TAKING 22.6A±
REMAINING 344.4A±
LOSS OF ACCESS 54.2A±



PHILIP C. & IRENE M. BRODEUR
I-89-3(25) PARCEL No 8A&B
TOTAL ACREAGE 135.3A±
TAKING 2.8A±
REMAINING 132.5A±
LOSS OF ACCESS 0.0A±

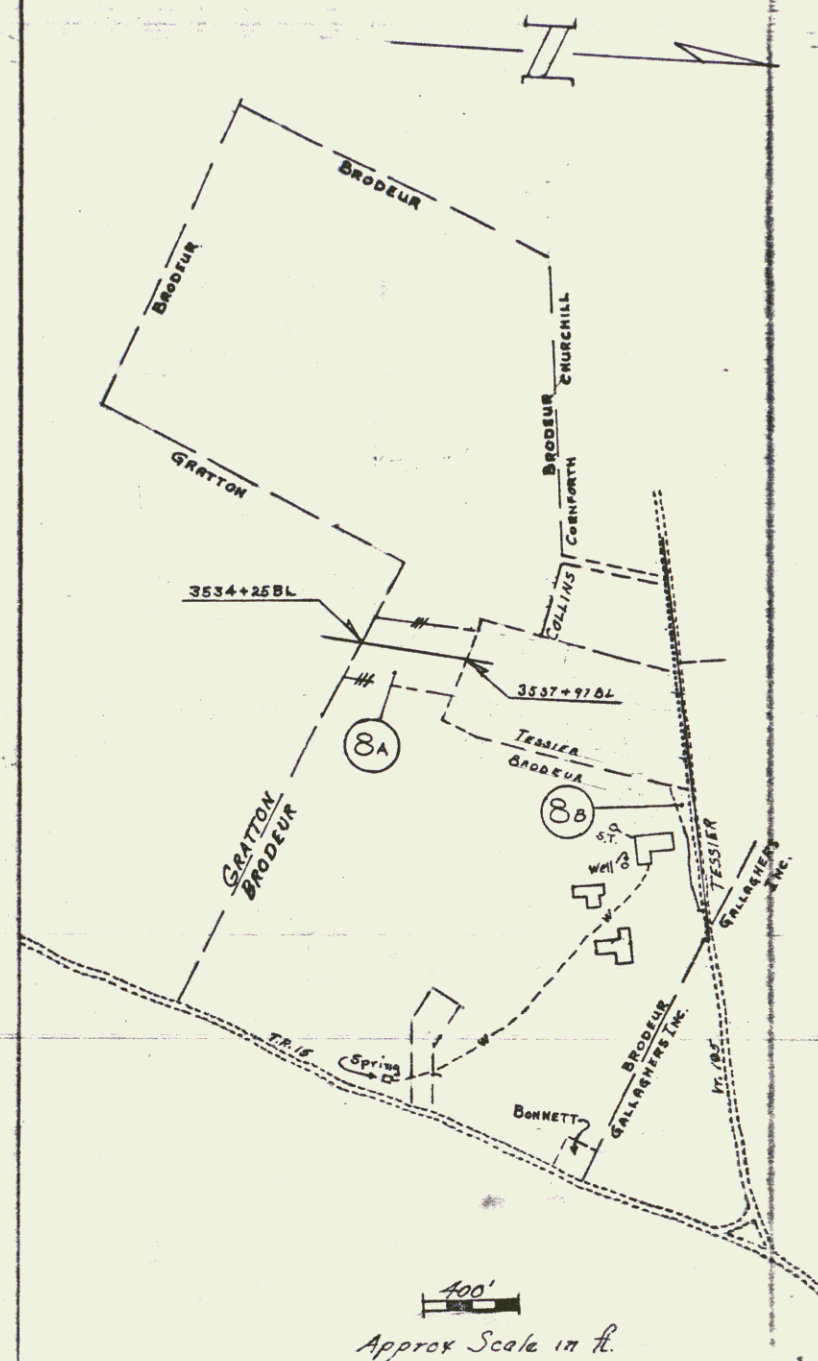


ALWIN D. & MARTHA D. COLLINS
I-89-3(25) PARCEL No 9A&B
TOTAL ACREAGE 5.0A±
TAKING 0.6A±
REMAINING 4.4A±
LOSS OF ACCESS 0.0A±

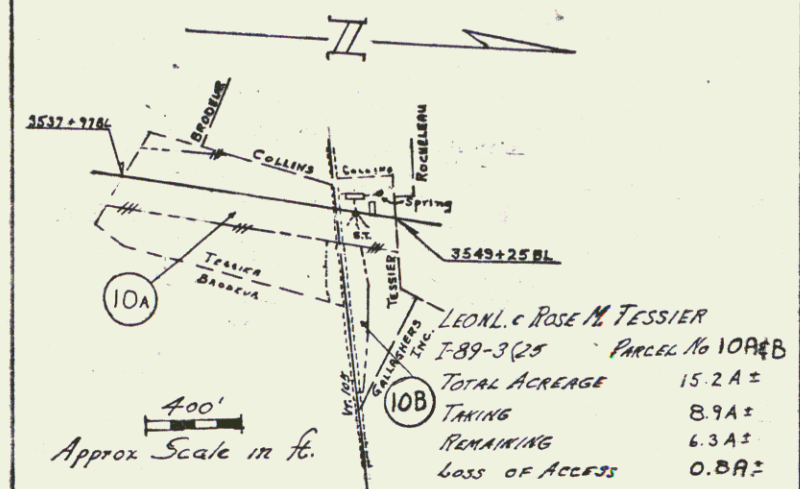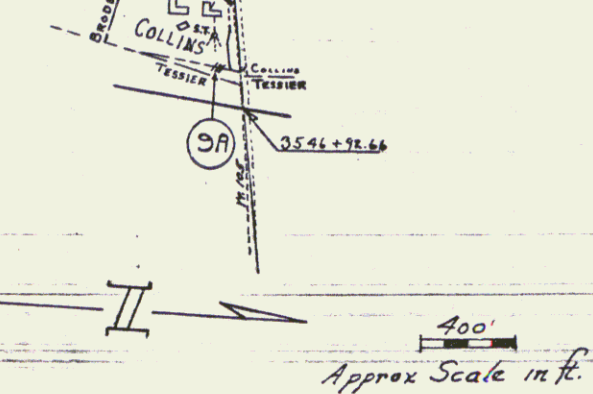

ALWIN D. & MARTHA D. COLLINS
I-89-3(25) PARCEL No 11A&B
TOTAL ACREAGE 5.0A±
TAKING 0.6A±
REMAINING 4.4A±
LOSS OF ACCESS 0.0A±




VERMONT DEPARTMENT OF HIGHWAYS
RIGHT OF WAY PLANS
PROJECT St. Albans - Swanton
No. I-89-3(25)
SHEET 12 OF 20

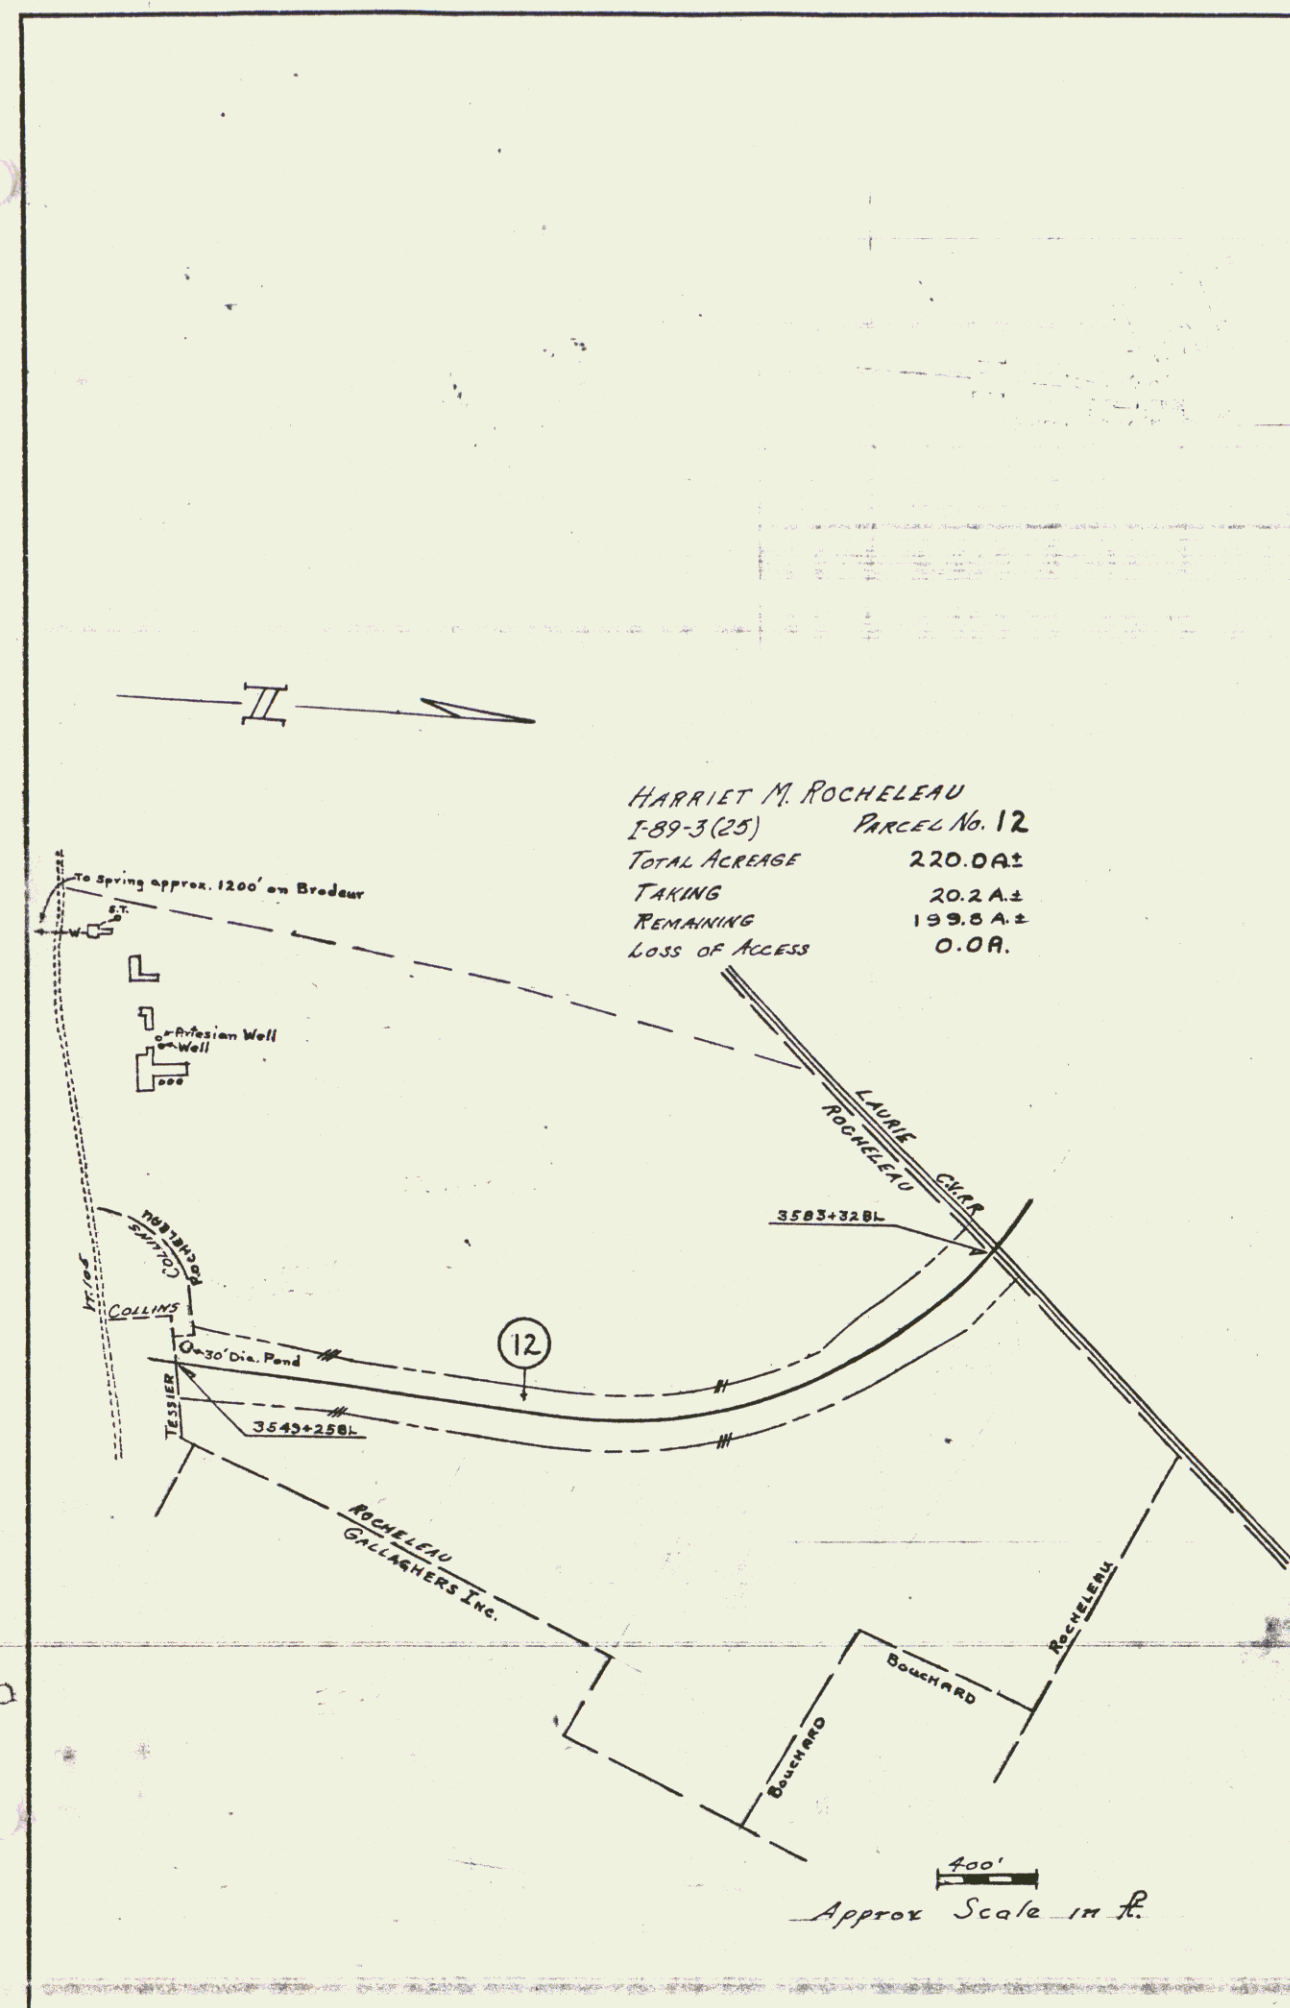


HARRIET M. ROCHELEAU
I-89-3 (25) Parcel No. 12
TOTAL ACREAGE 220.0A±
TAKING 20.2A±
REMAINING 199.8A±
LOSS OF ACCESS 0.0A.

ERDINE M., JESSIE M., RICHARD M. LAURIE
I-89-3 (25) Parcel No. 14
TOTAL ACREAGE 235.0A±
TAKING 24.8A±
REMAINING 210.2A±
LOSS OF ACCESS 18.5A±

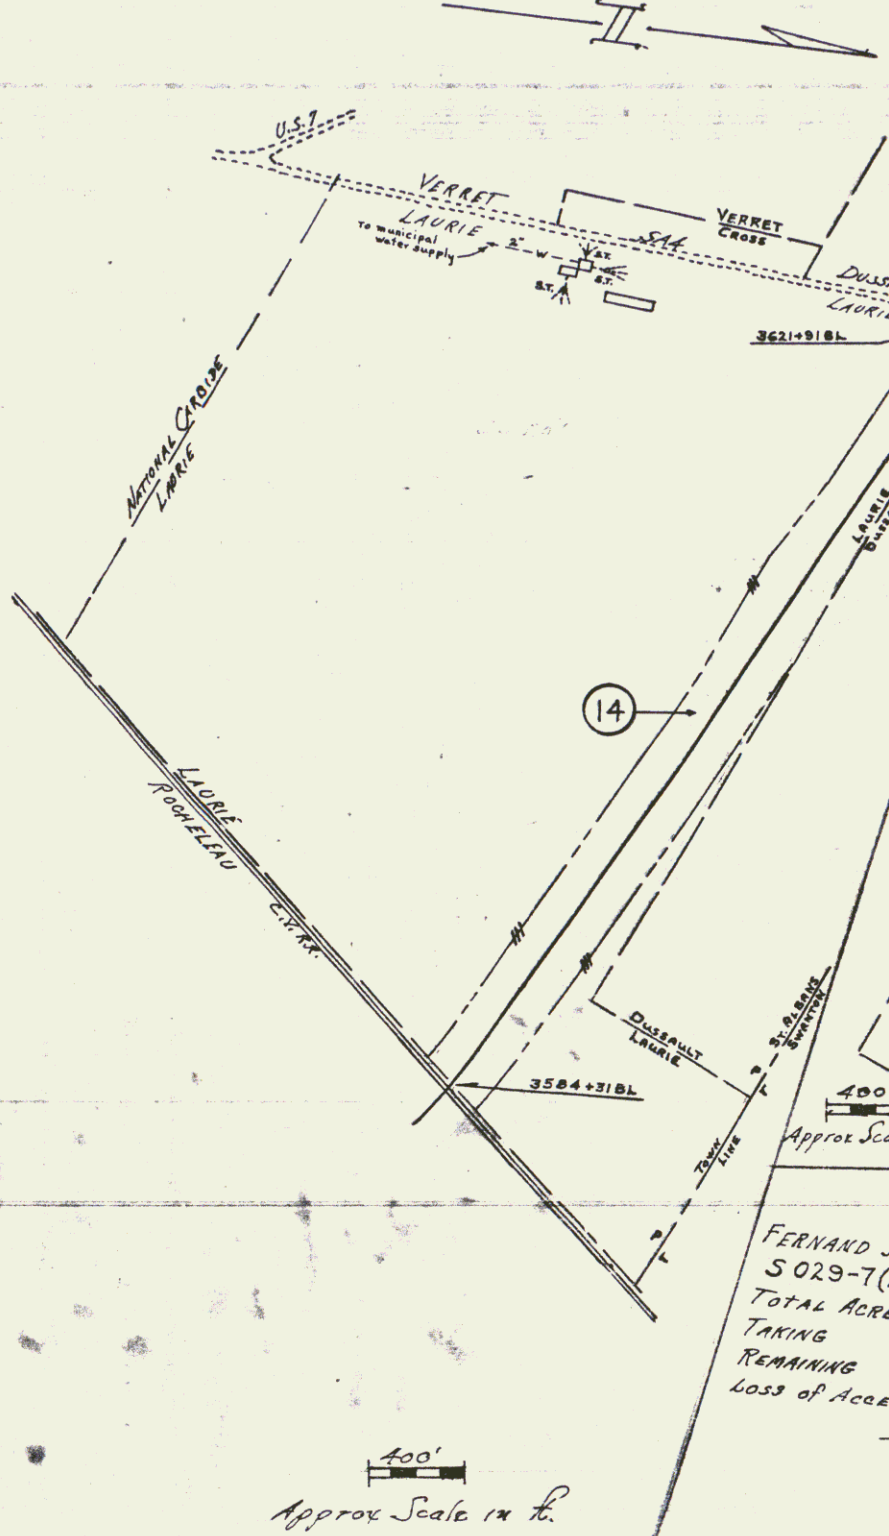


FERNAND J. & GERTRUDE M. VERRET
S 029-7(2) Parcel No.
TOTAL ACREAGE 26.0A±
TAKING 1.4A±
REMAINING 24.6A±
LOSS OF ACCESS 0.4A±

MARY L. DUSSAULT
I 89-3 (25) & S 029-7(2)
TOTAL ACREAGE 143.0A±
TOTAL TAKING 31.75A±
REMAINDER 111.25A±
LOSS OF ACCESS None
TAKING:
I 89-3 (25) Parcel No. 15
A. 25.0A± L.A.
B. 1.2A± L.A.
C. 1.8A± L.A.
S 029-7(2) Parcel No. 3
A. 1.0A±
B. 0.55A± L.A.
C. 2.3A± L.A.

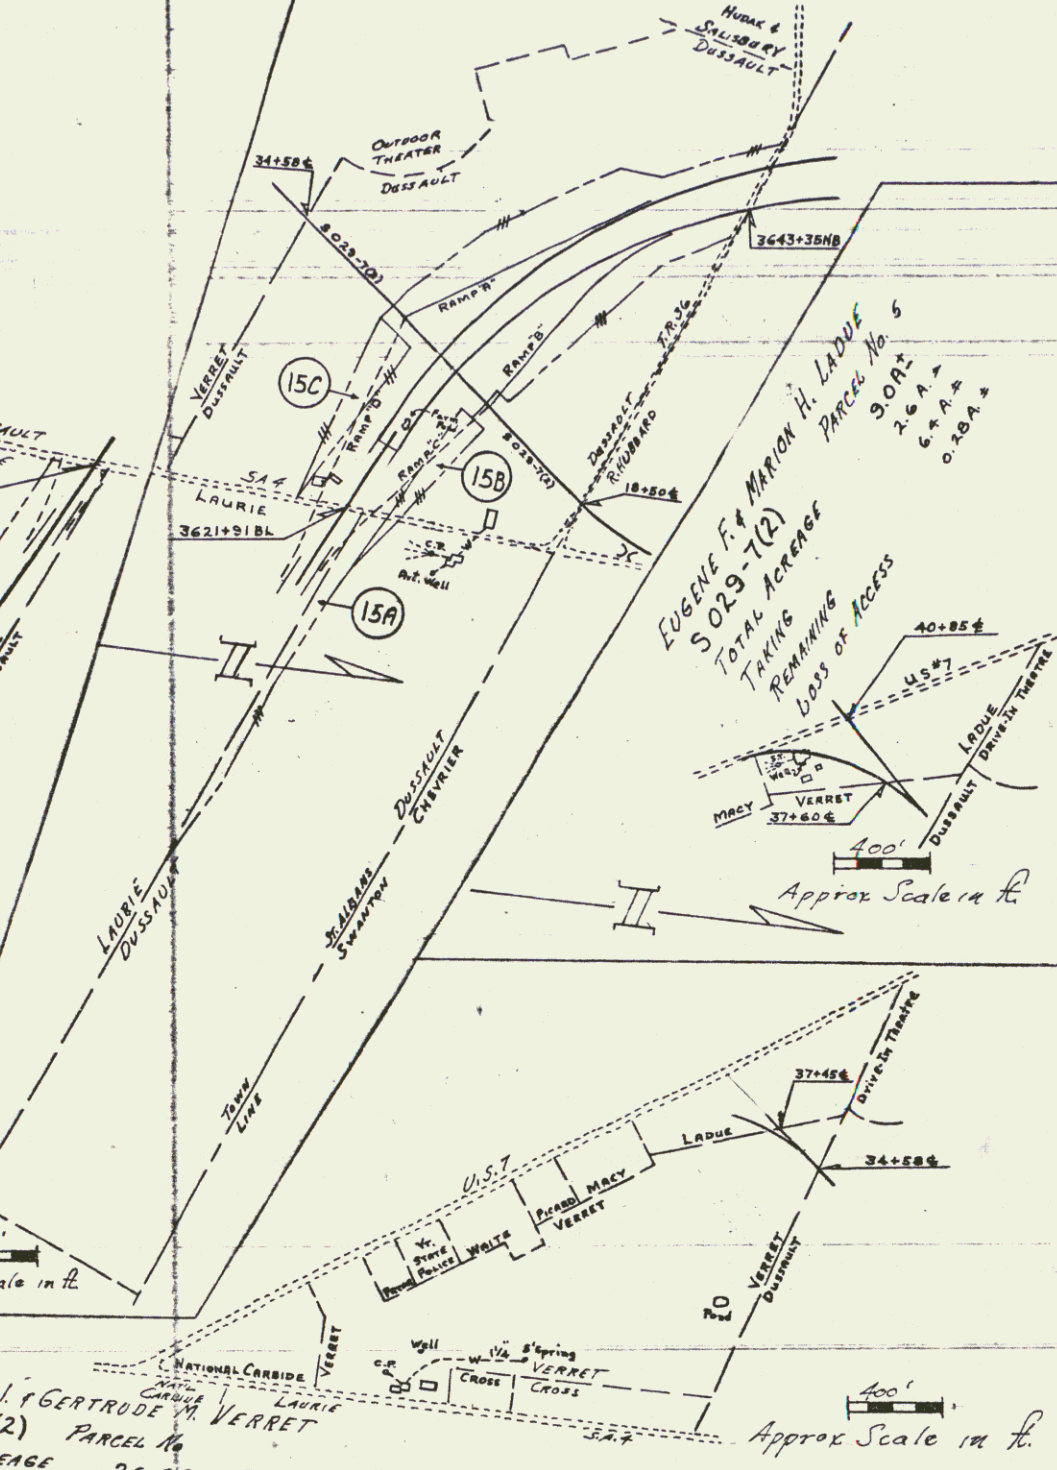


VERMONT DEPARTMENT OF HIGHWAYS
RIGHT OF WAY PLANS
PROJECT: ST. ALBANS-SWANTON
No. I 89-3 (25)
SHEET 13 OF 58

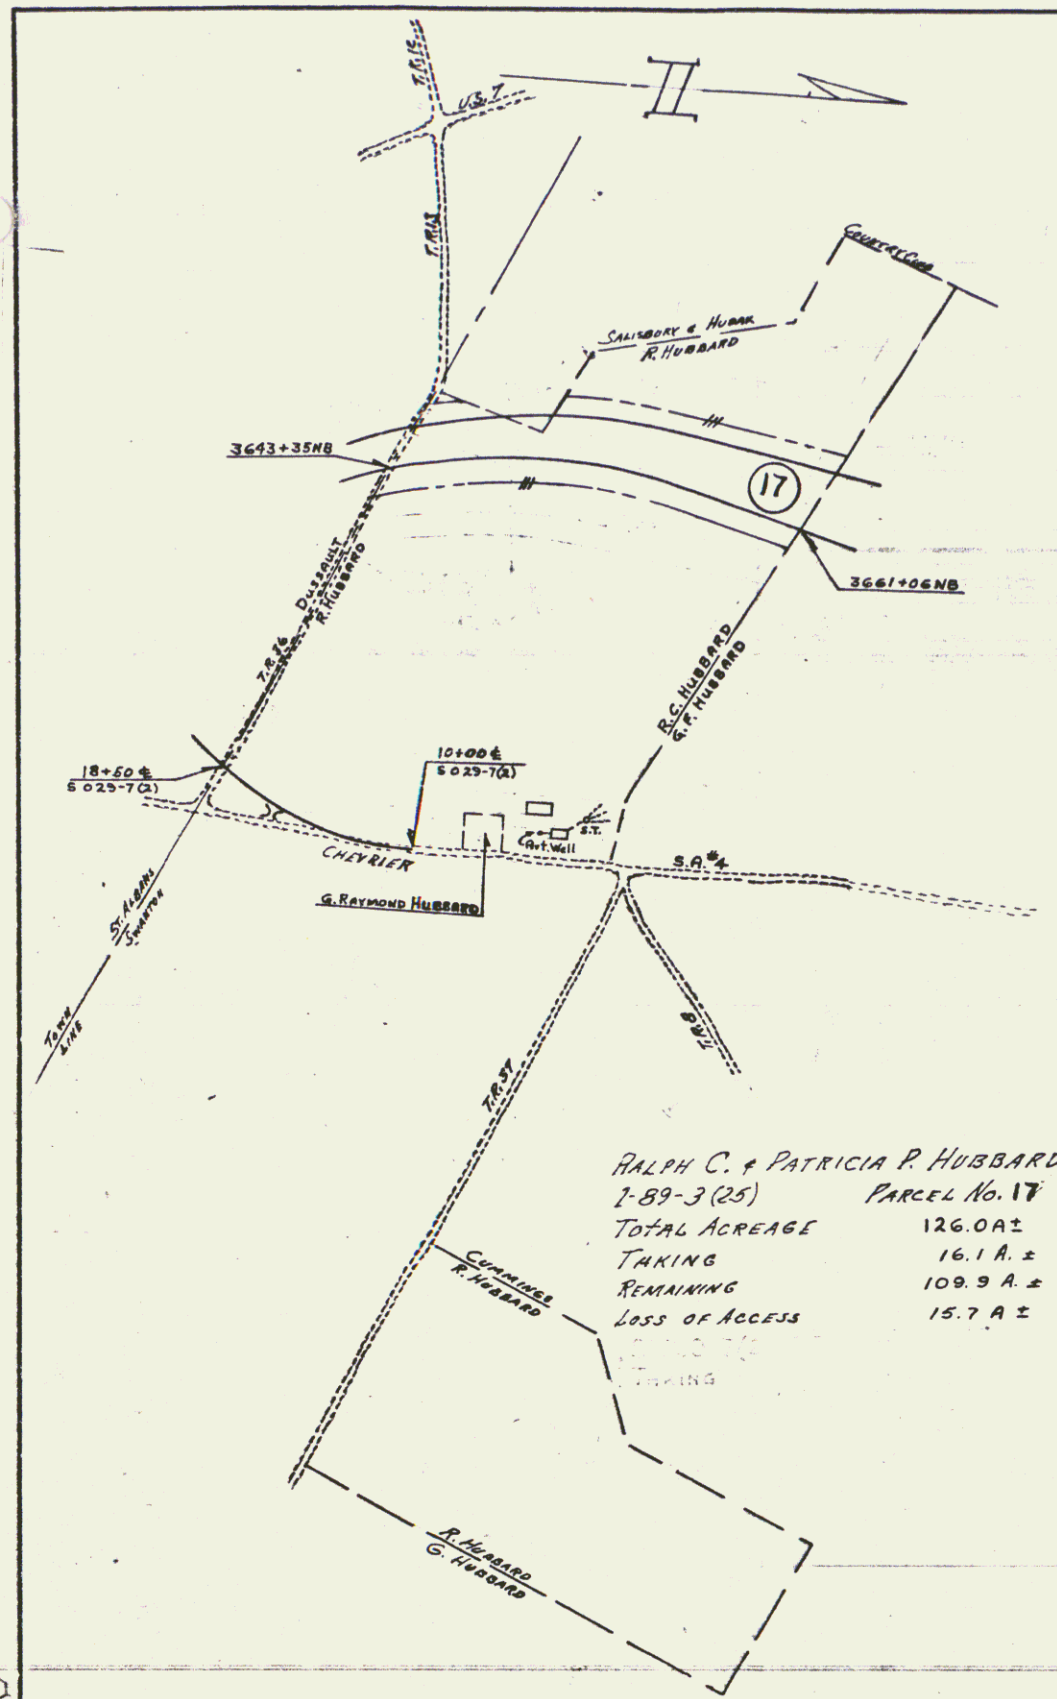

RALPH C. & PATRICIA P. HUBBARD
 7-89-3 (25) PARCEL No. 17
 TOTAL ACREAGE 126.0A±
 TAKING 16.1A±
 REMAINING 109.9A±
 LOSS OF ACCESS 15.7A±


400'
 Approx Scale in ft.

GEORGE F. & EUGENIA N. HUBBARD
 7-89-3 (25) PARCEL No. 19
 TOTAL ACREAGE 140.0A±
 TAKING 10.2A±
 REMAINING 129.8A±
 LOSS OF ACCESS 13.7A±

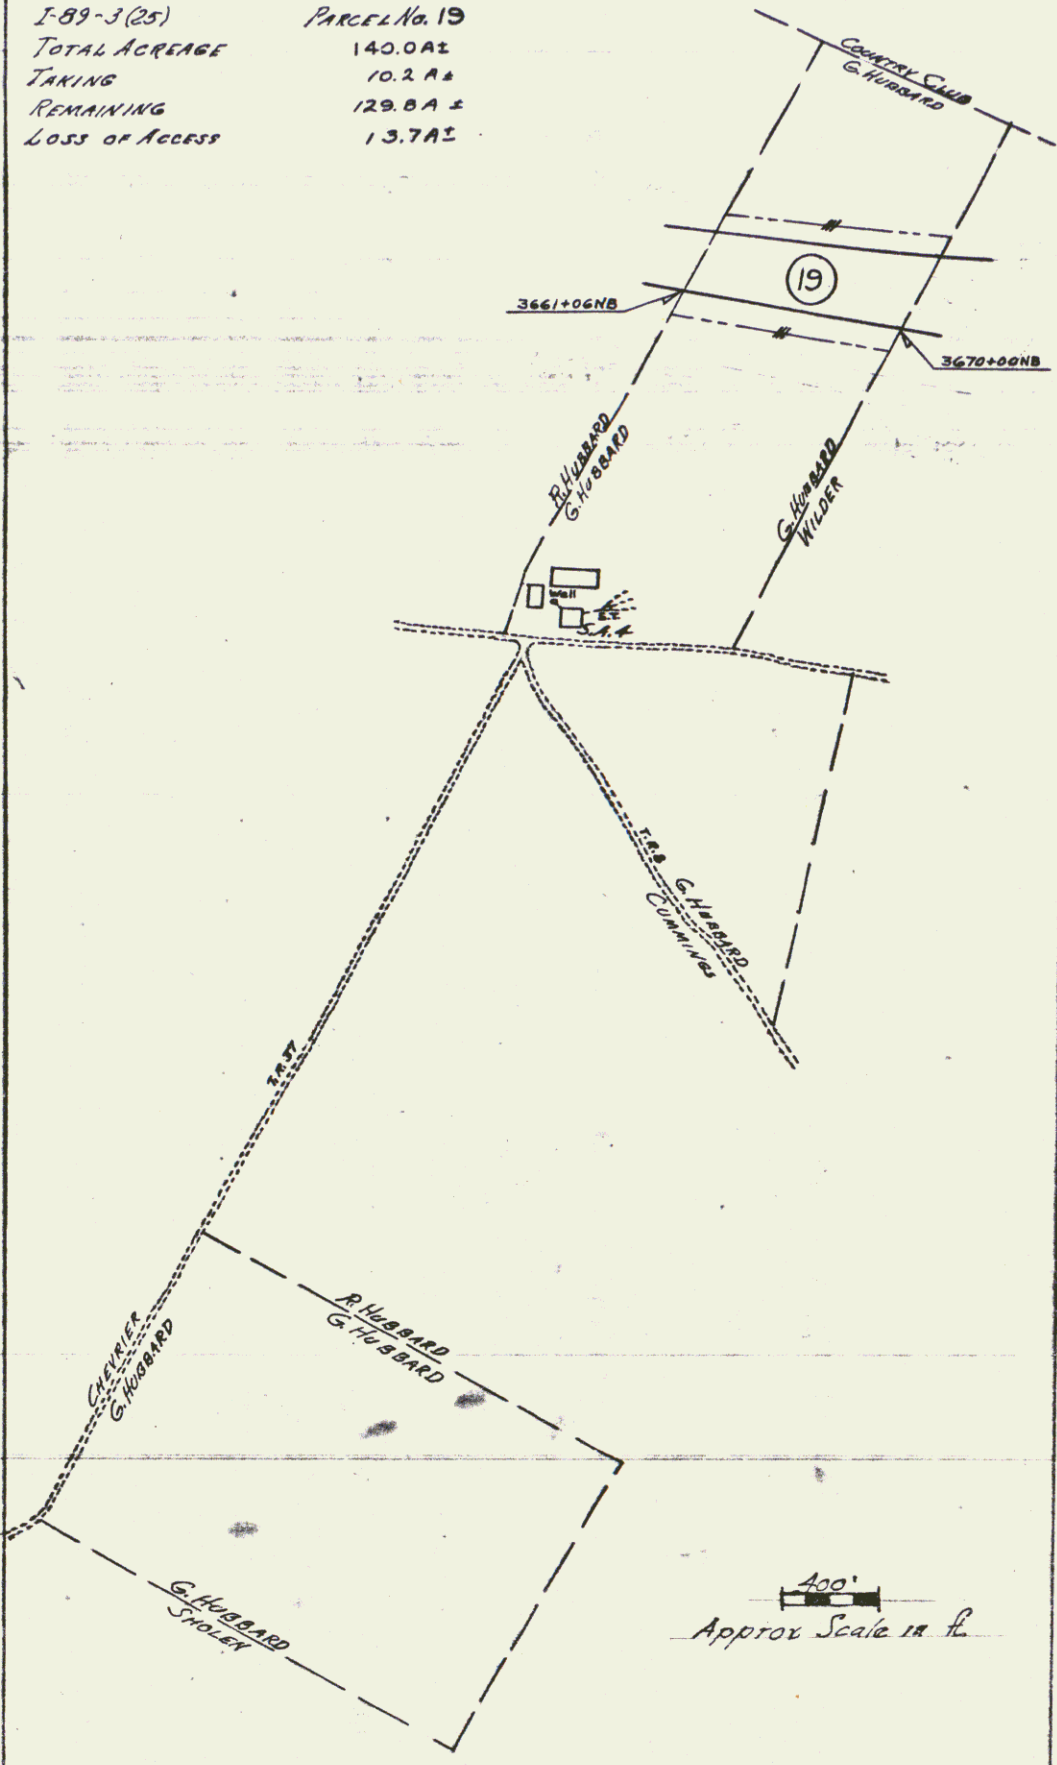

400'
 Approx Scale in ft.

FRANCIS T. & ANTONIA H. BERTHAUNE
 7-89-3 (25) PARCEL No. 32
 TOTAL ACREAGE 244A±
 TAKING 3200 Sq. Ft. ±
 REMAINING 244.0A±
 LOSS OF ACCESS 0.0A±

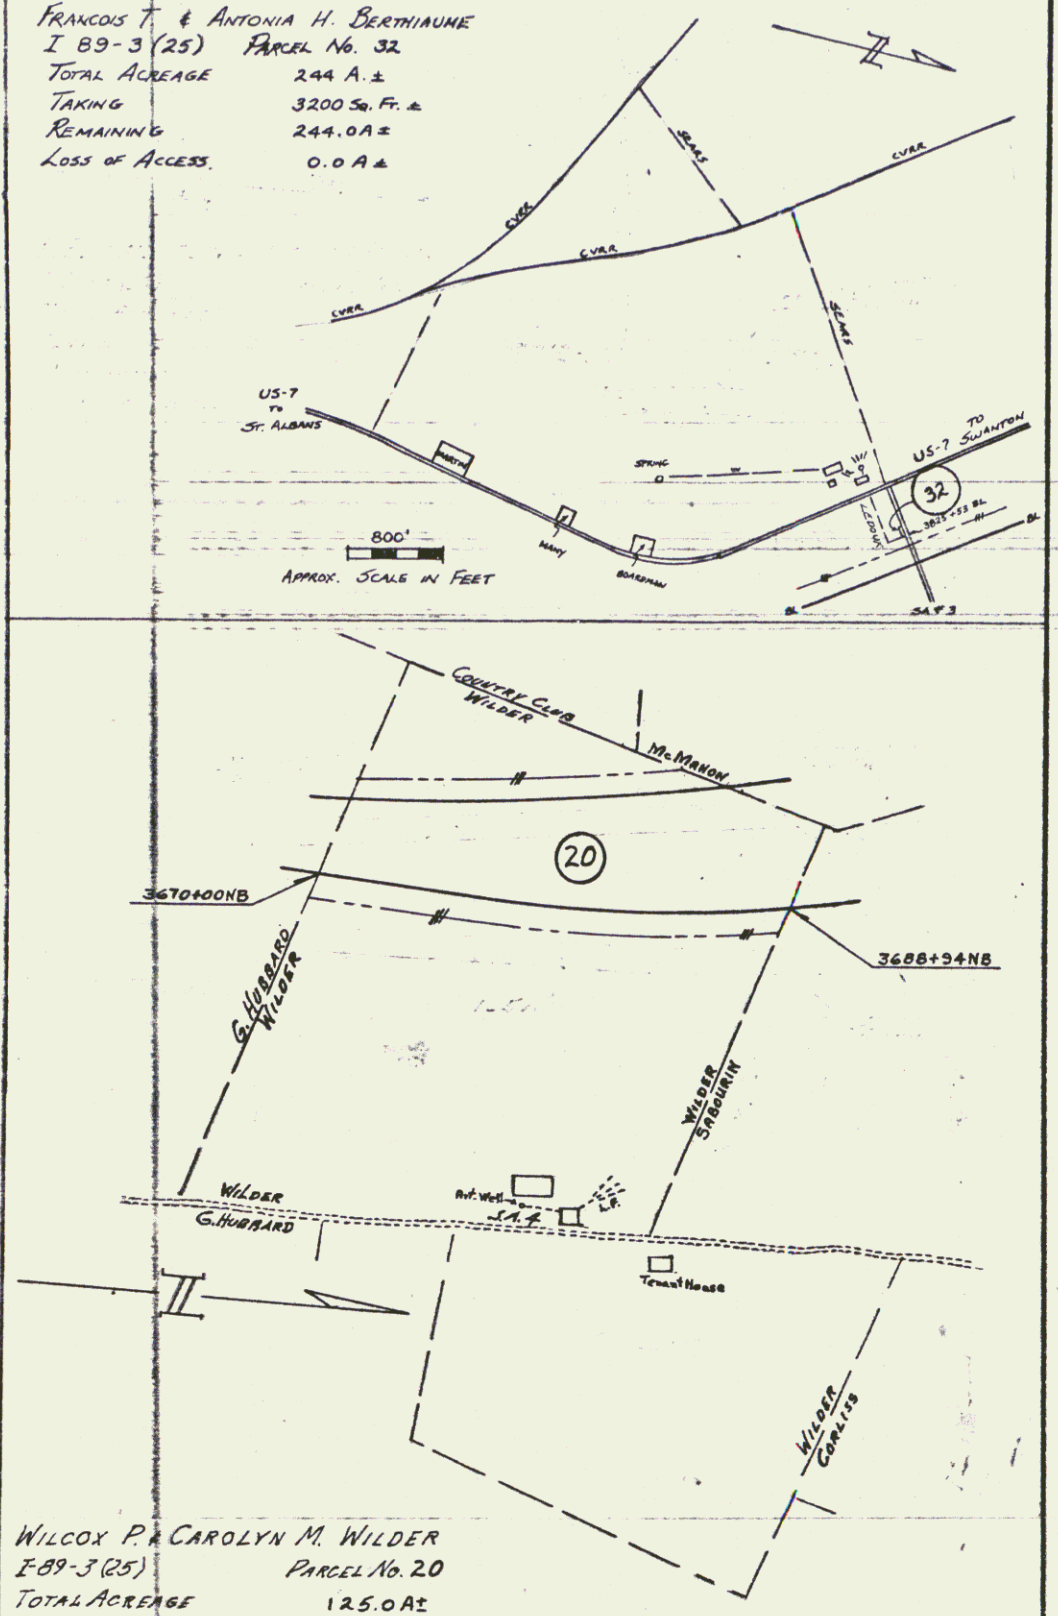

WILCOX P. & CAROLYN M. WILDER
 7-89-3 (25) PARCEL No. 20
 TOTAL ACREAGE 125.0A±
 TAKING 26.9A±
 REMAINING 98.6A±
 LOSS OF ACCESS 7.2A±


400'
 Approx Scale in ft.

VERMONT DEPARTMENT OF HIGHWAYS
 RIGHT OF WAY PLANS
 PROJECT: ST. ALBANS SWANTON
 No. 7-89-3 (25)
 SHEET 14 OF 88


HOWELL B. & MARY LOUISE SABOURIN
I-89-3 (25) PARCEL No. 22
TOTAL ACREAGE 65.0A±
TAKING 16.5A±
REMAINING 48.5A±
LOSS OF ACCESS 0.0A

MAURICE & LUCILLE RAINVILLE
I-89-3(25) PARCEL No. 23
TOTAL ACREAGE 210.0A±
TAKING 48.2A±
REMAINING 161.8A±
LOSS OF ACCESS 0.0A±


CECIL & WINNIFRED McMAHON
I-89-3(25) PARCEL No. 21
TOTAL ACREAGE 125.0A±
TAKING 11.6A±
REMAINING 113.4A±
LOSS OF ACCESS 0.0A

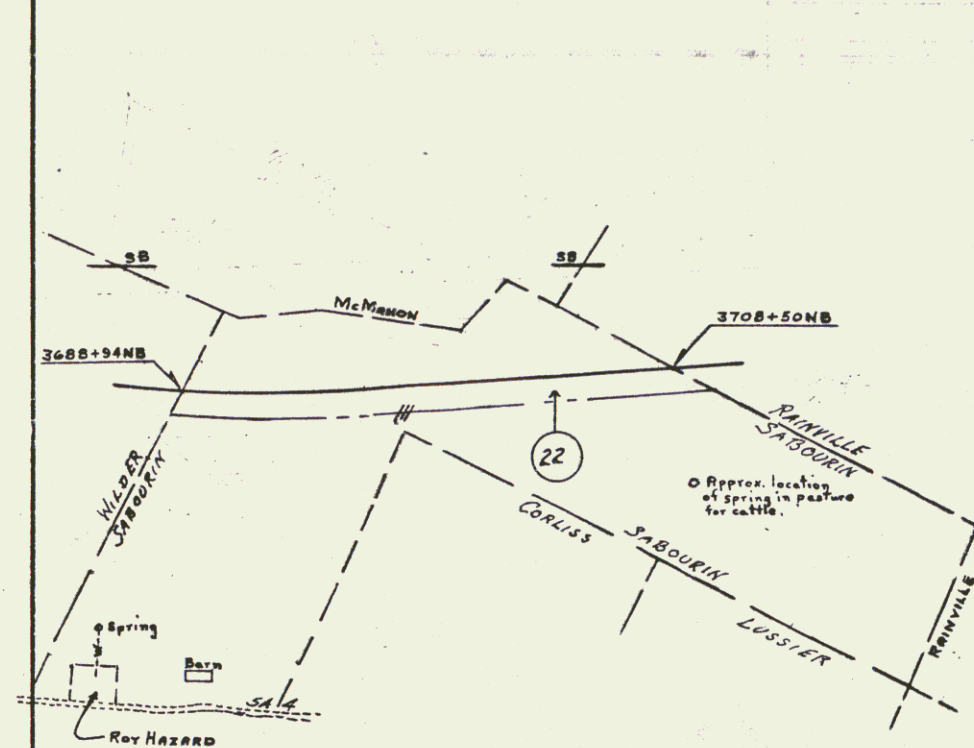

400'
Approx Scale in ft.

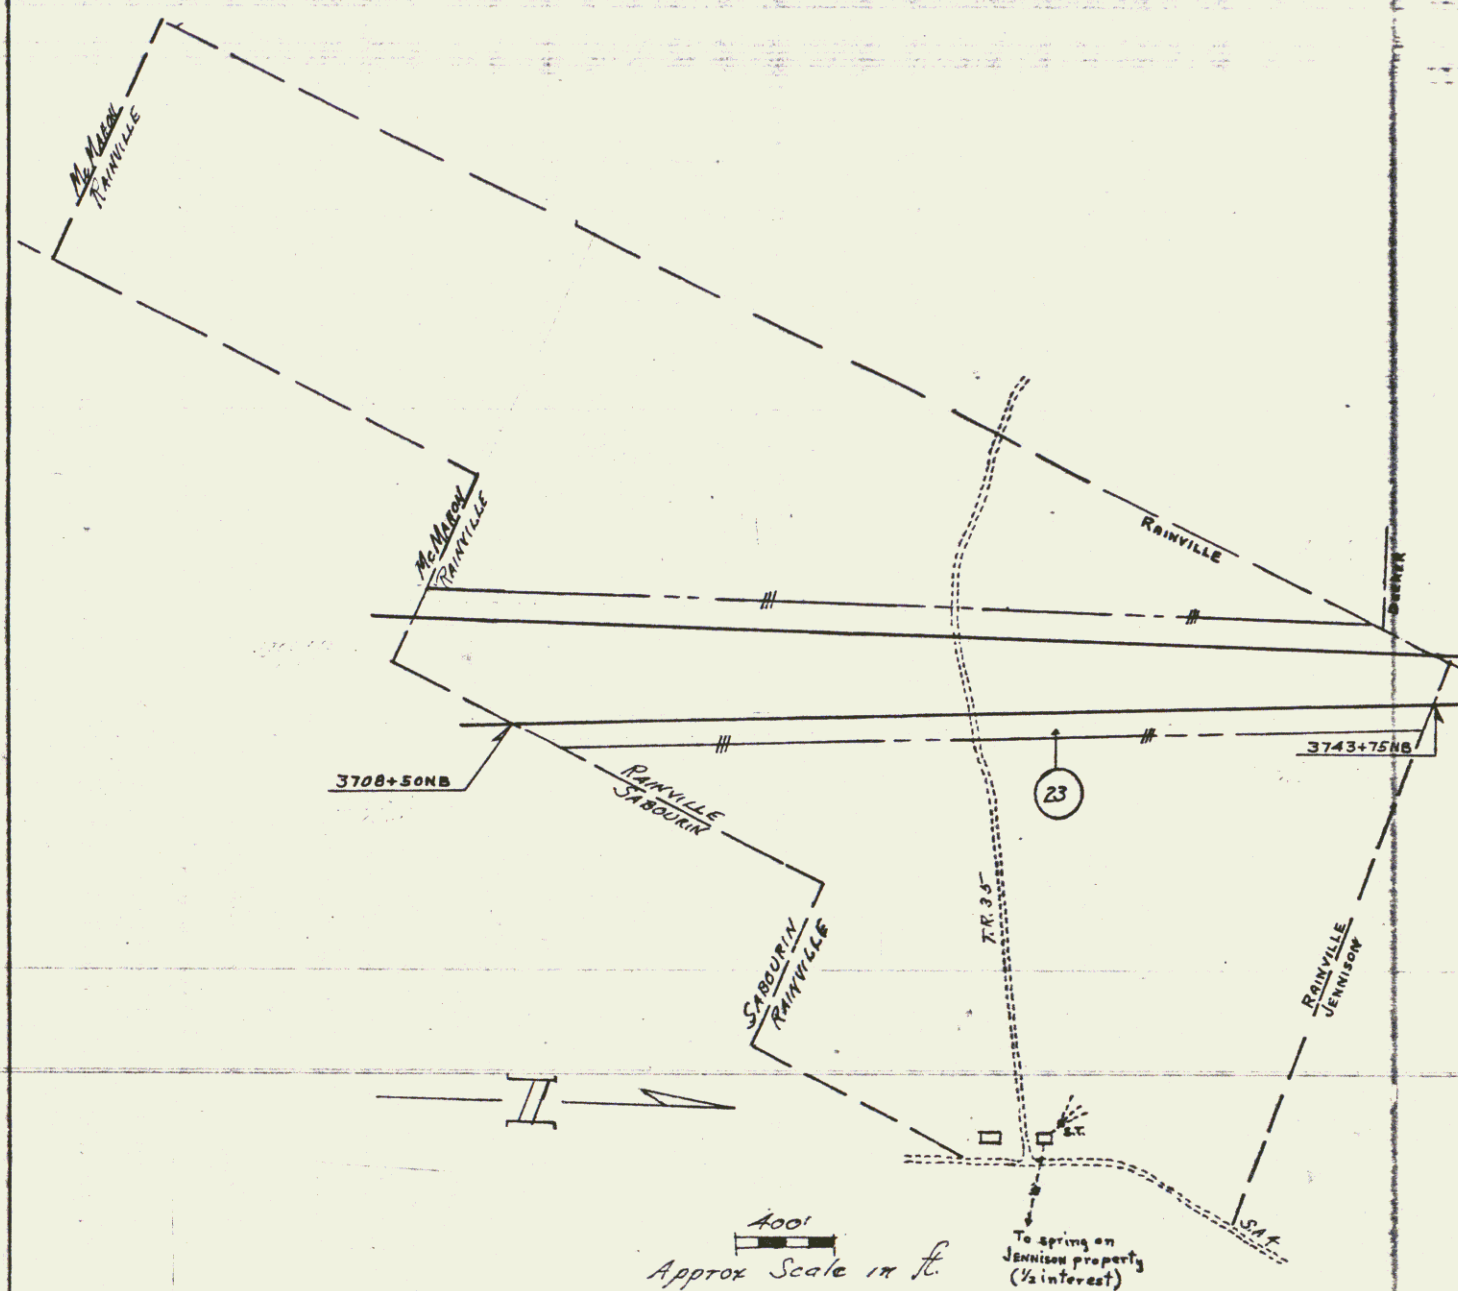


400'
Approx Scale in ft.

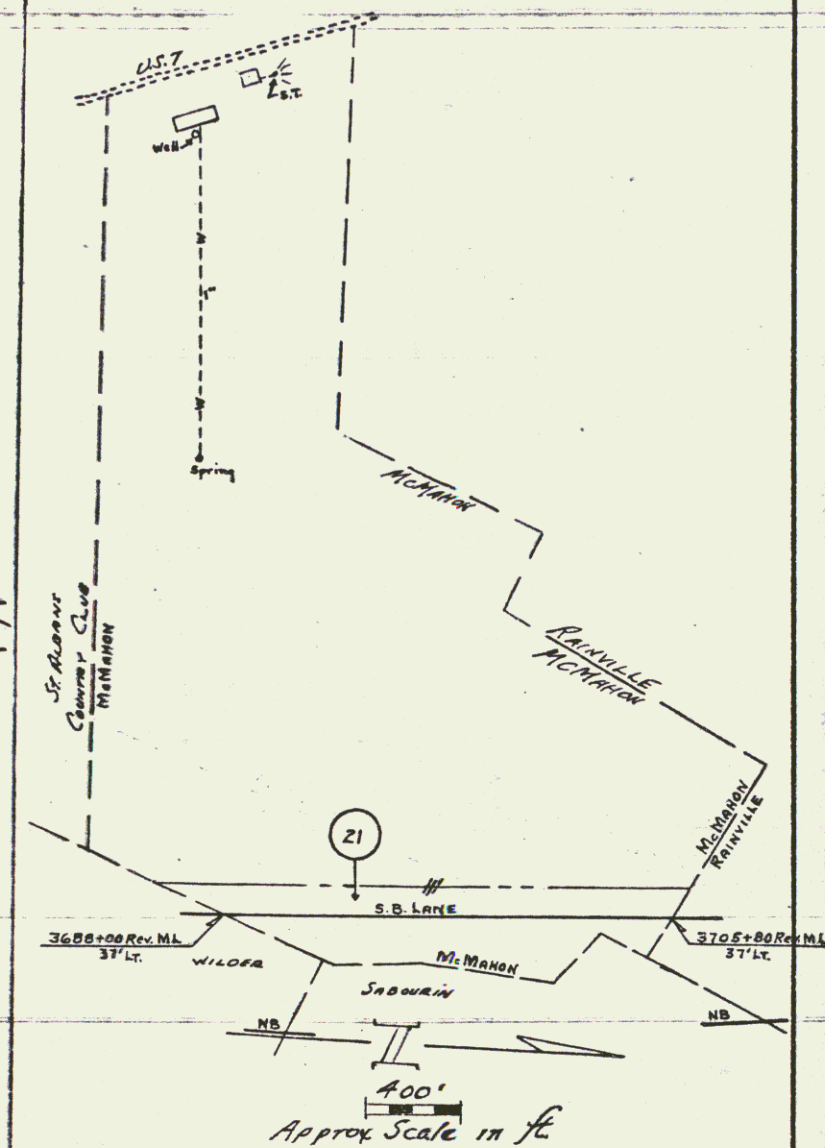


400'
Approx Scale in ft.

VERMONT DEPARTMENT OF HIGHWAYS
RIGHT OF WAY PLANS
PROJECT: ST. ALBANS-SWANTON
No. I-89-3(25)
SHEET 15 OF 68


KEITH, PETER, & KATHERINE (PRATT) JENNISON
 I-89-3(25) PARCEL No. 25
 TOTAL ACREAGE 450.0A ±
 TAKING 1.7A ±
 REMAINING 448.3A ±
 LOSS OF ACCESS 0.0A.

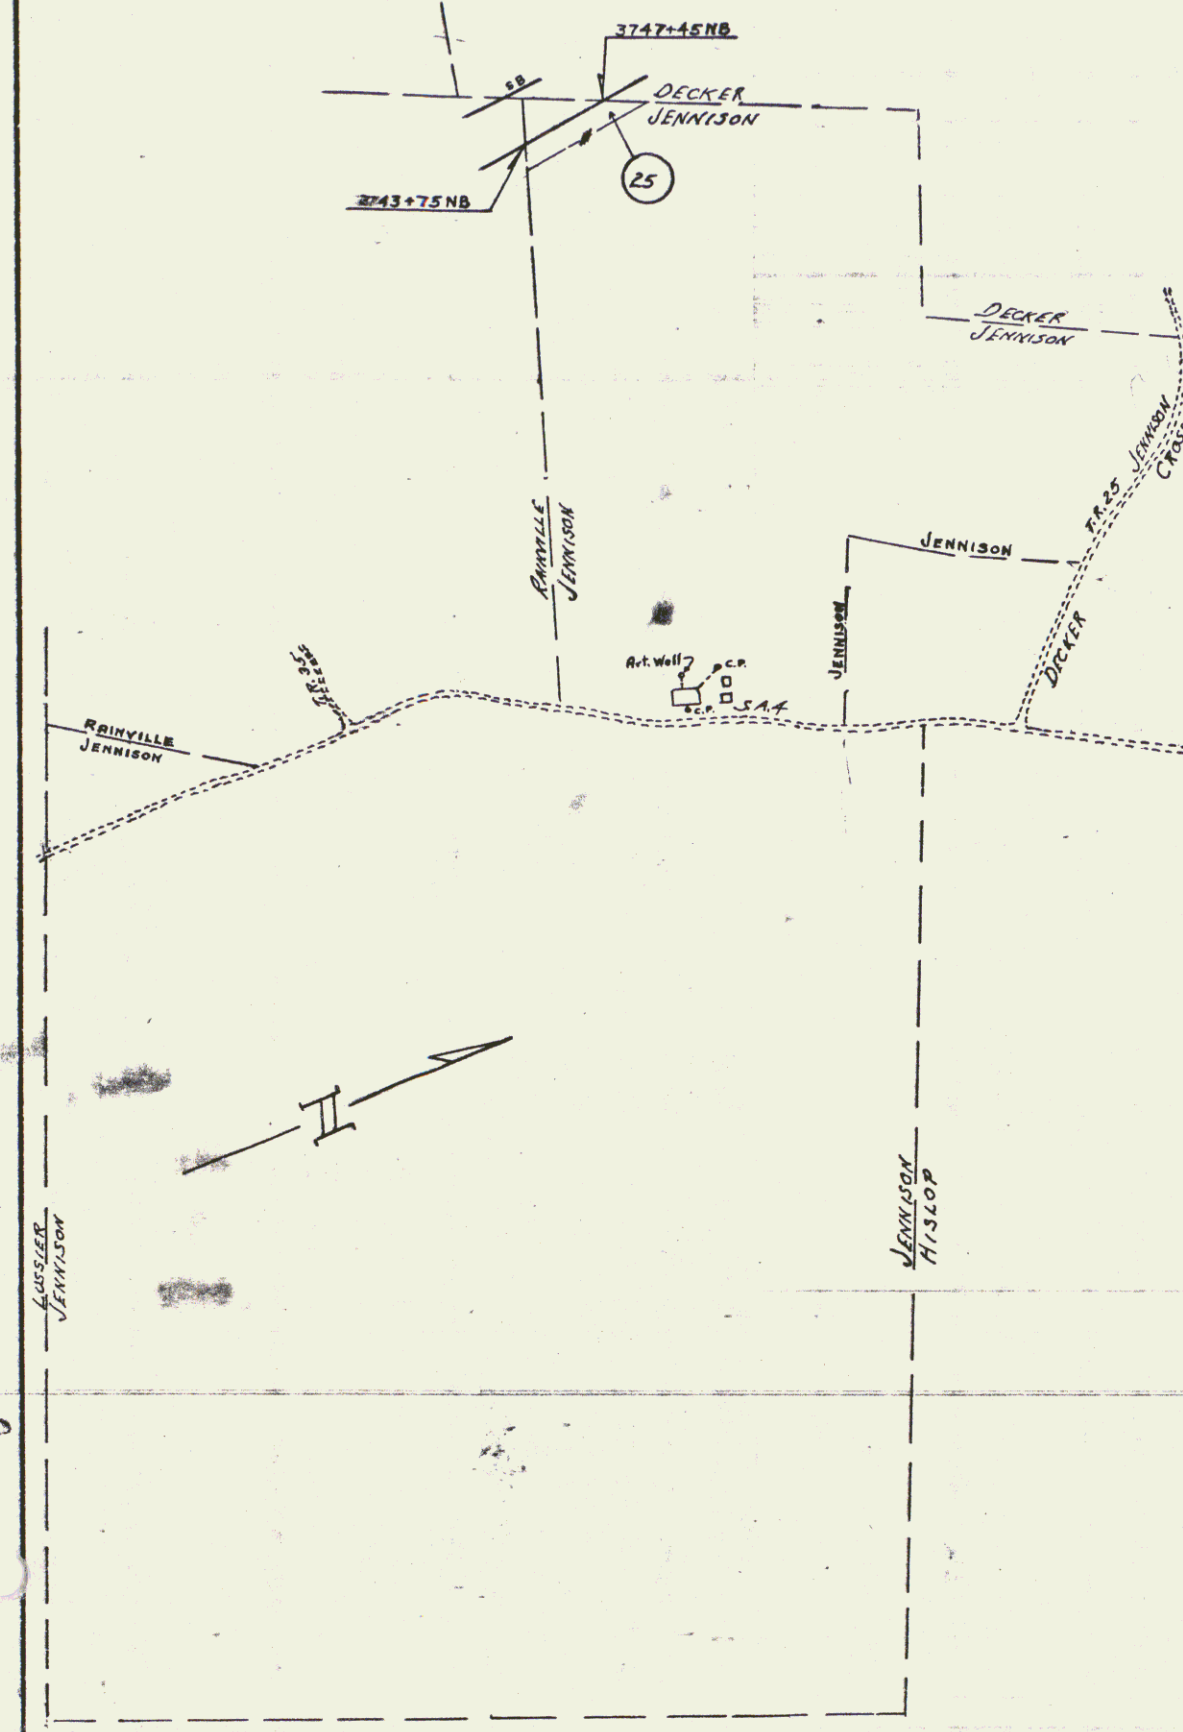

W. PALSTON & ECHO N. DECKER
 I-89-3(25) PARCEL No. 24
 TOTAL ACREAGE 150.0 A. ±
 TAKING 15.5 A. ±
 REMAINING 134.5 A. ±
 LOSS OF ACCESS 12.8 A. ±

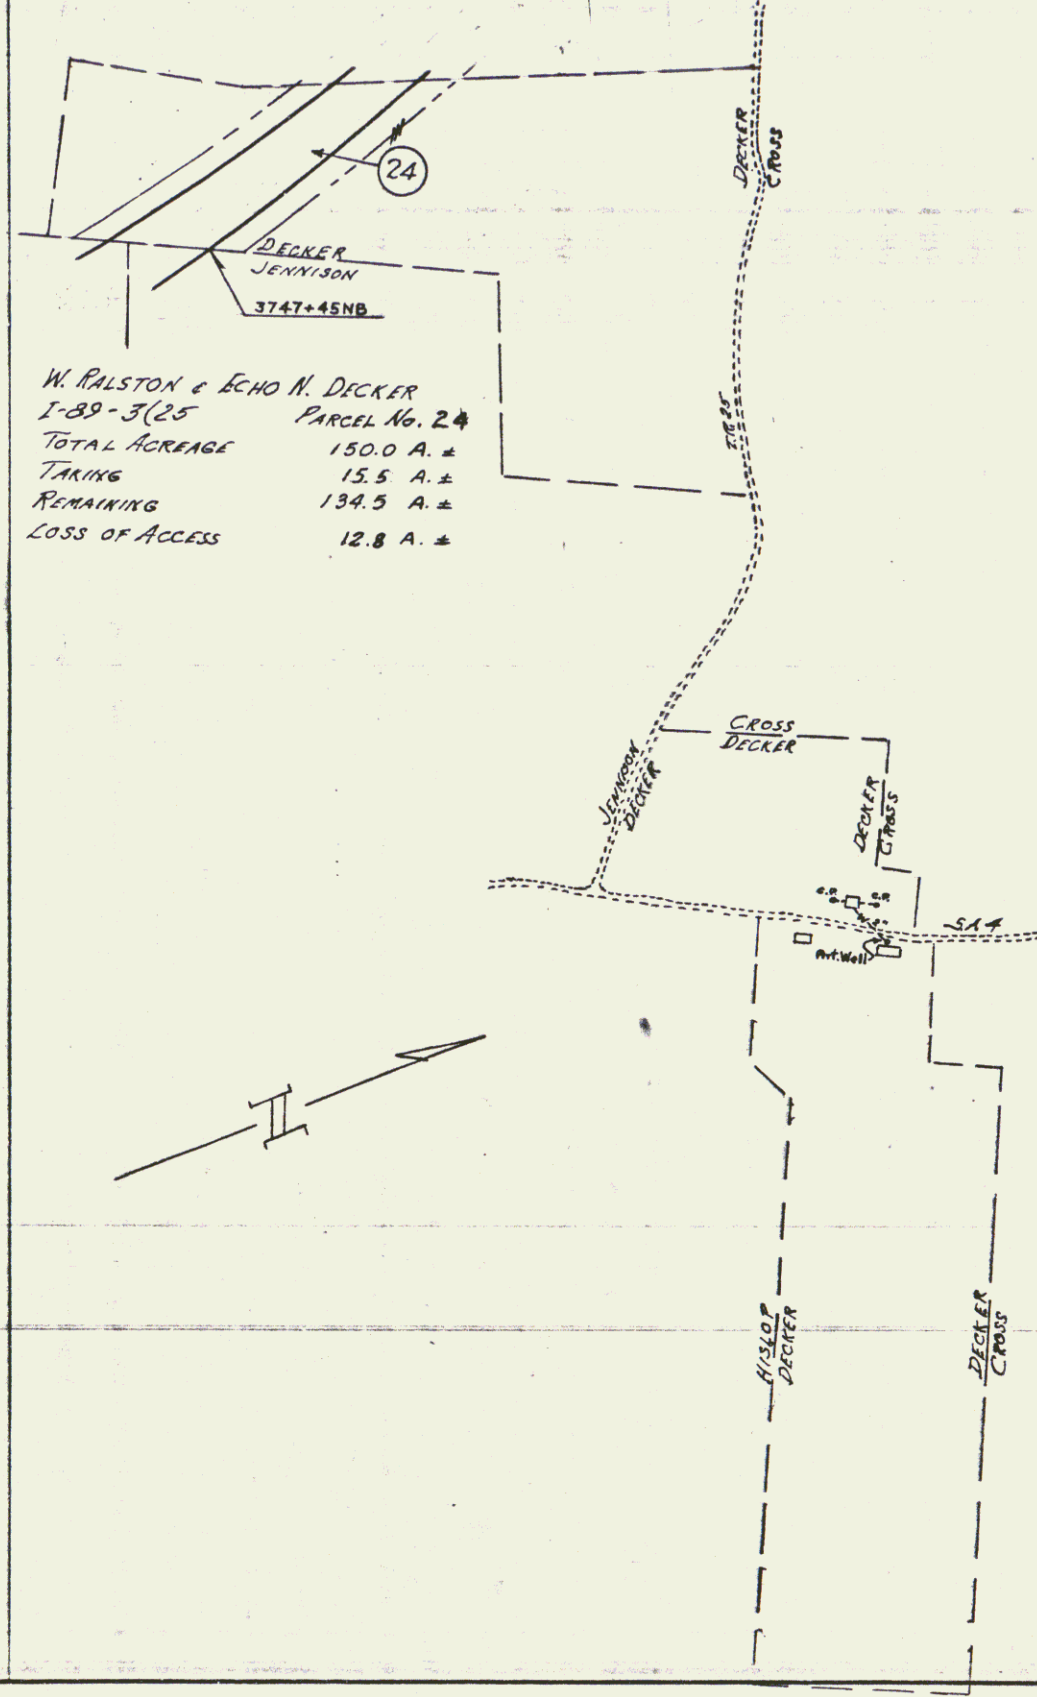


KENNETH F. & IRENE L. CASEY
 I-89-3(25) PARCEL No. 26
 TOTAL ACREAGE 136.0 A. ±
 TAKING 15.2 A. ±
 REMAINING 120.8 A. ±
 LOSS OF ACCESS 0.0A.

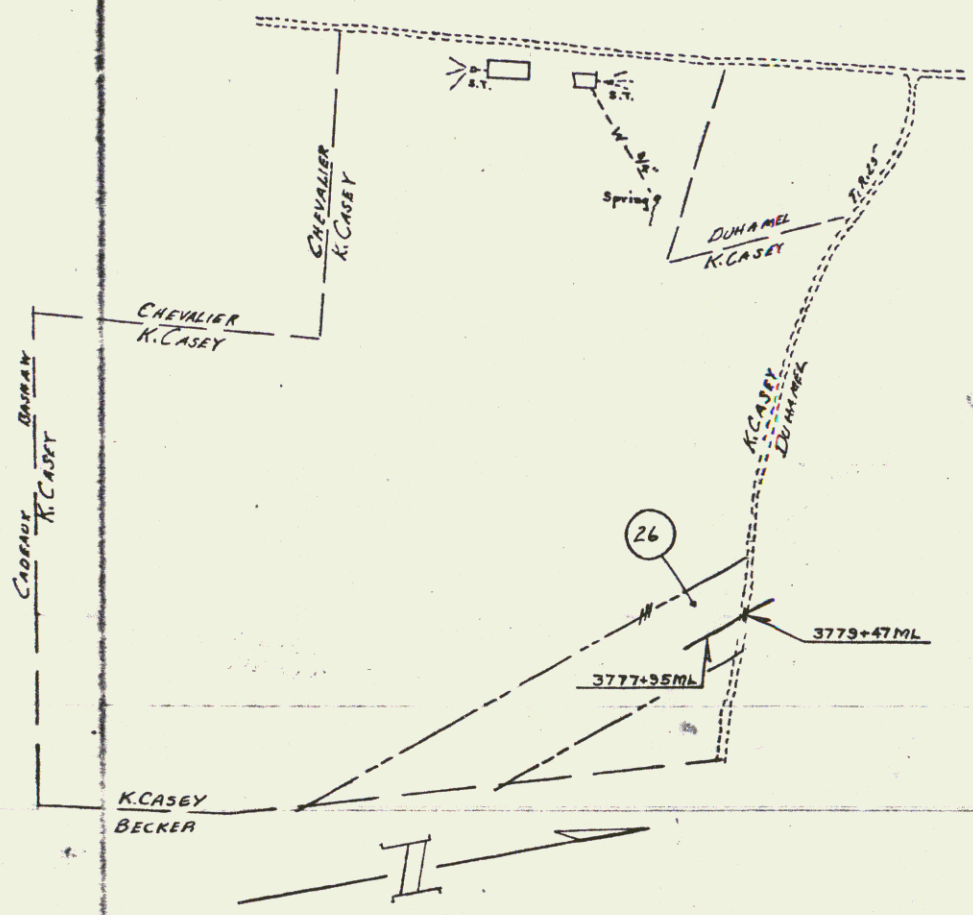


VERMONT DEPARTMENT OF HIGHWAYS
 RIGHT OF WAY PLANS
 PROJECT ST. ALBANS-SWANTON
 No. I-89-3(25)
 SHEET 16 OF 88


EUCLIDE & MELIA G. DUHAMEL
I-89-3(25) PARCEL No. 27
TOTAL ACREAGE 112.0A±
TAKING 12.8A±
REMAINING 99.2A±
LOSS OF ACCESS 0.0A±

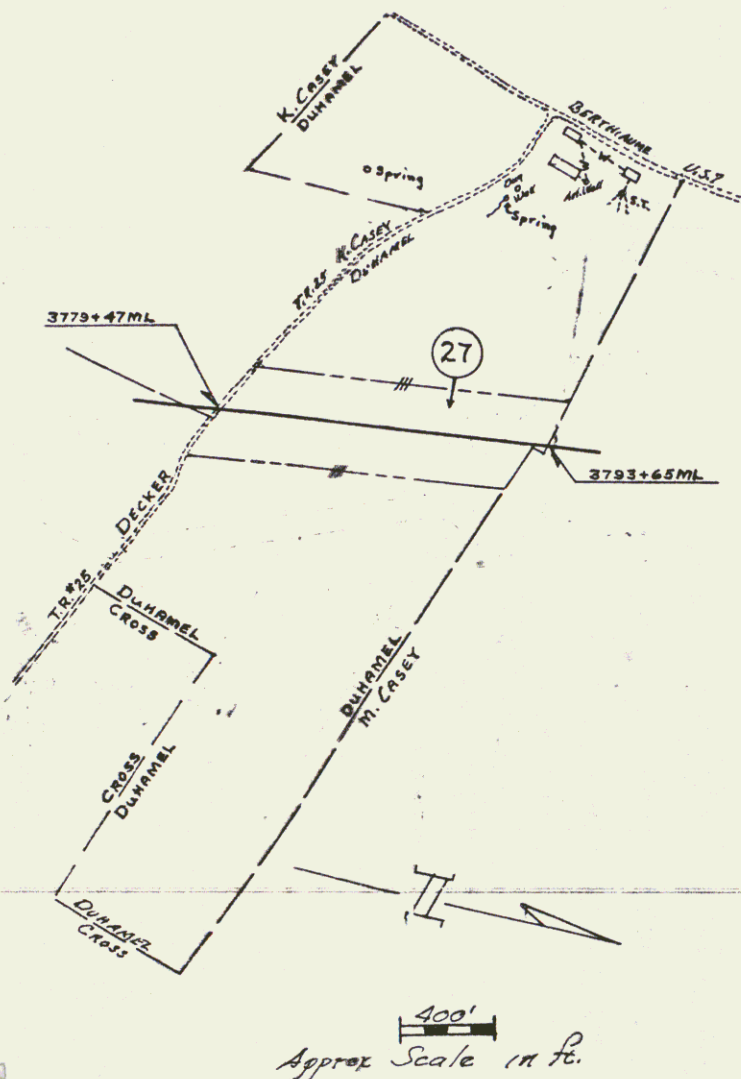


MARK M. & EDNA M. CASEY
I-89-3(25) PARCEL No. 28
TOTAL ACREAGE 200.0A±
TAKING 11.1A±
REMAINING 188.9A±
LOSS OF ACCESS 11.4A±

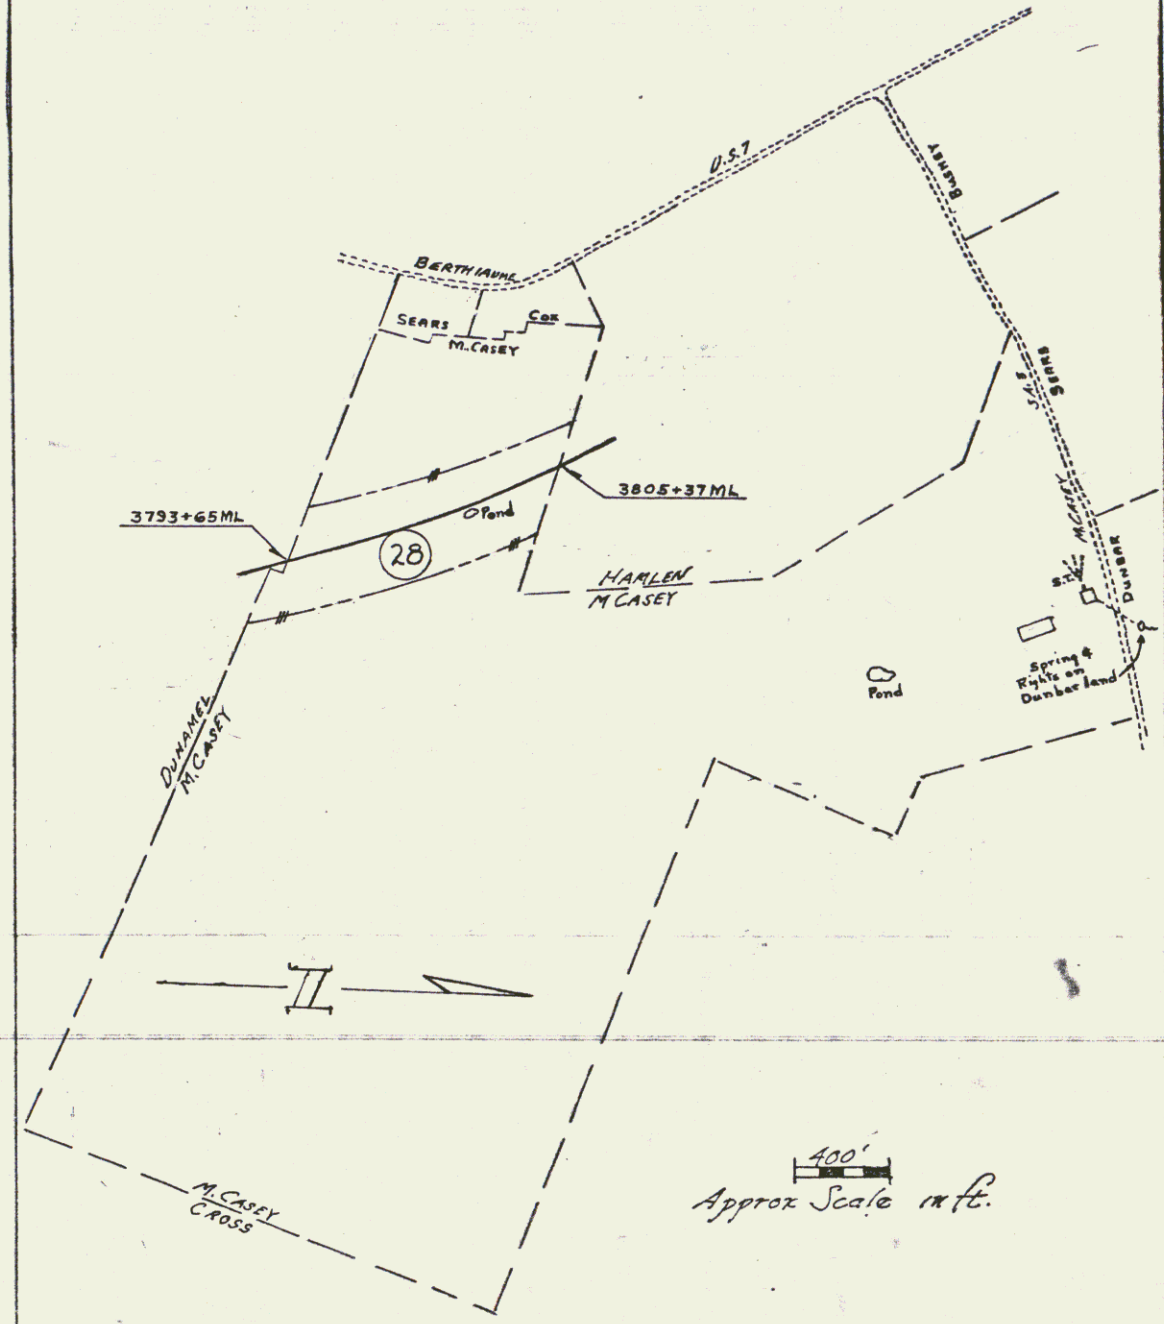

CARLETON L. & RACHEL W. HAMLEN
I-89-3(25) PARCEL No. 29
TOTAL ACREAGE 50.0A±
TAKING 18.3A±
REMAINING 31.7A±
LOSS OF ACCESS 0.0A±

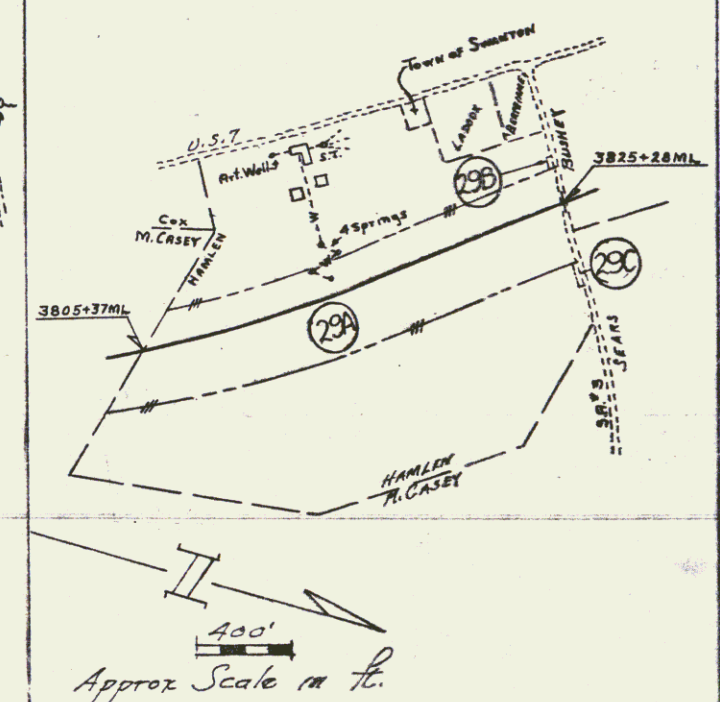

WILL P. HOWRIGAN
I-89-3(25) PARCEL No. 34
TOTAL ACREAGE 61.1A±
TAKING 20.5A±
REMAINING 40.6A±
LOSS OF ACCESS 32.0A±

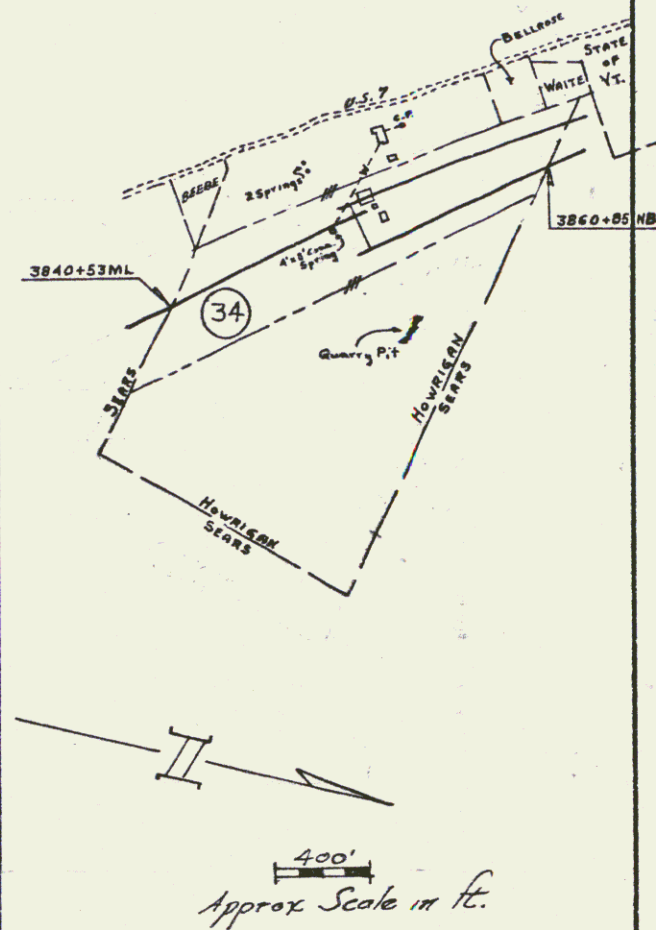

VERMONT DEPARTMENT OF HIGHWAYS
RIGHT OF WAY PLANS
PROJECT: ST. ALBANS-SWANTON
No. I-89-3(25)
SHEET 17 OF 88

VT 36 BITUMINOUS CONCRETE
CURE
24' 6" 30' 8' 72"
24' 6" 30' 8' 90"


VT 36 TREATED TIMBER
CURE
13' 00' 10' 00"
13' 00' 10' 00"

N 3444+00
END PROJECT I 89-3(3w)
BEGIN PROJECT I 89-3(3w)
BEGIN CONTRACT #1



I 8
Surlington
4375 (1751)
Swanton

For Details of
VT 36 see sheet
of sheds.

Approx. location
of water line from
spring house to
house and barn.


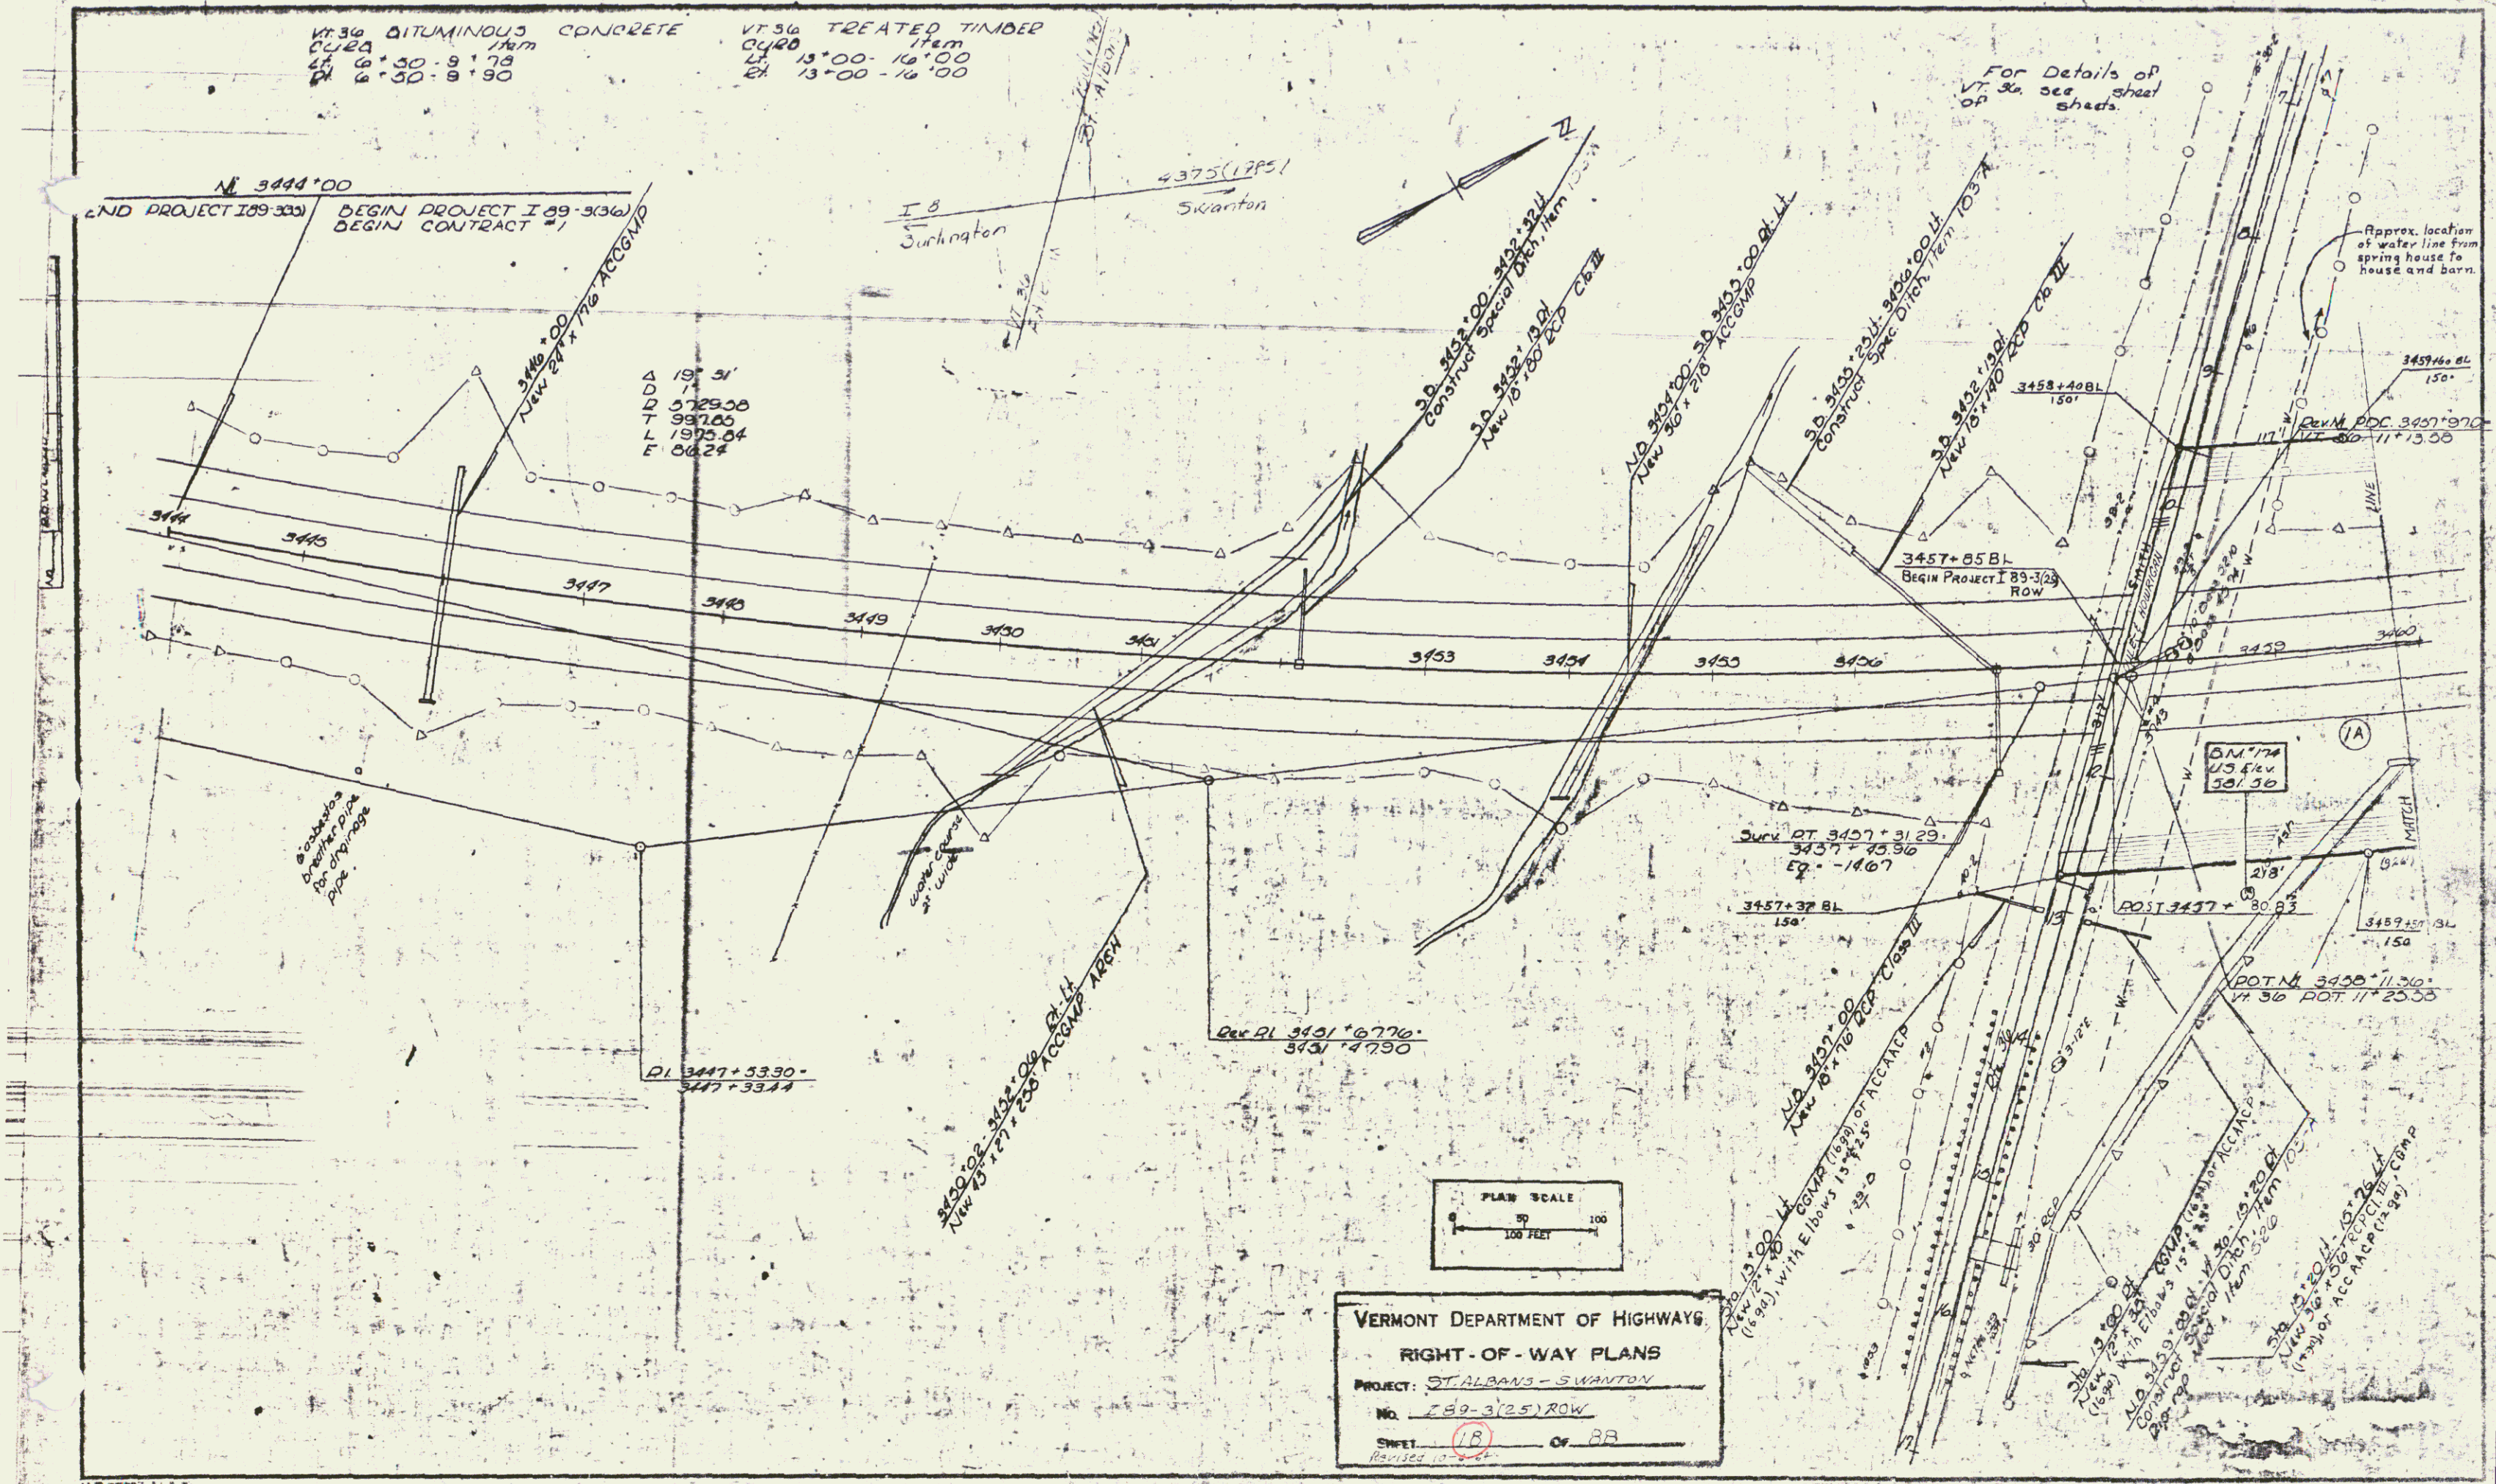


PLAN	SURVEYED	BY	DATE
NOTE BOOK	ADJUSTED	ALFORD	7-25-63
N/O	ALLEN CHECKED		6-1-68
	BOYD CHECKED		

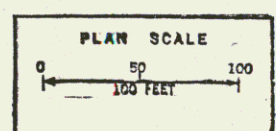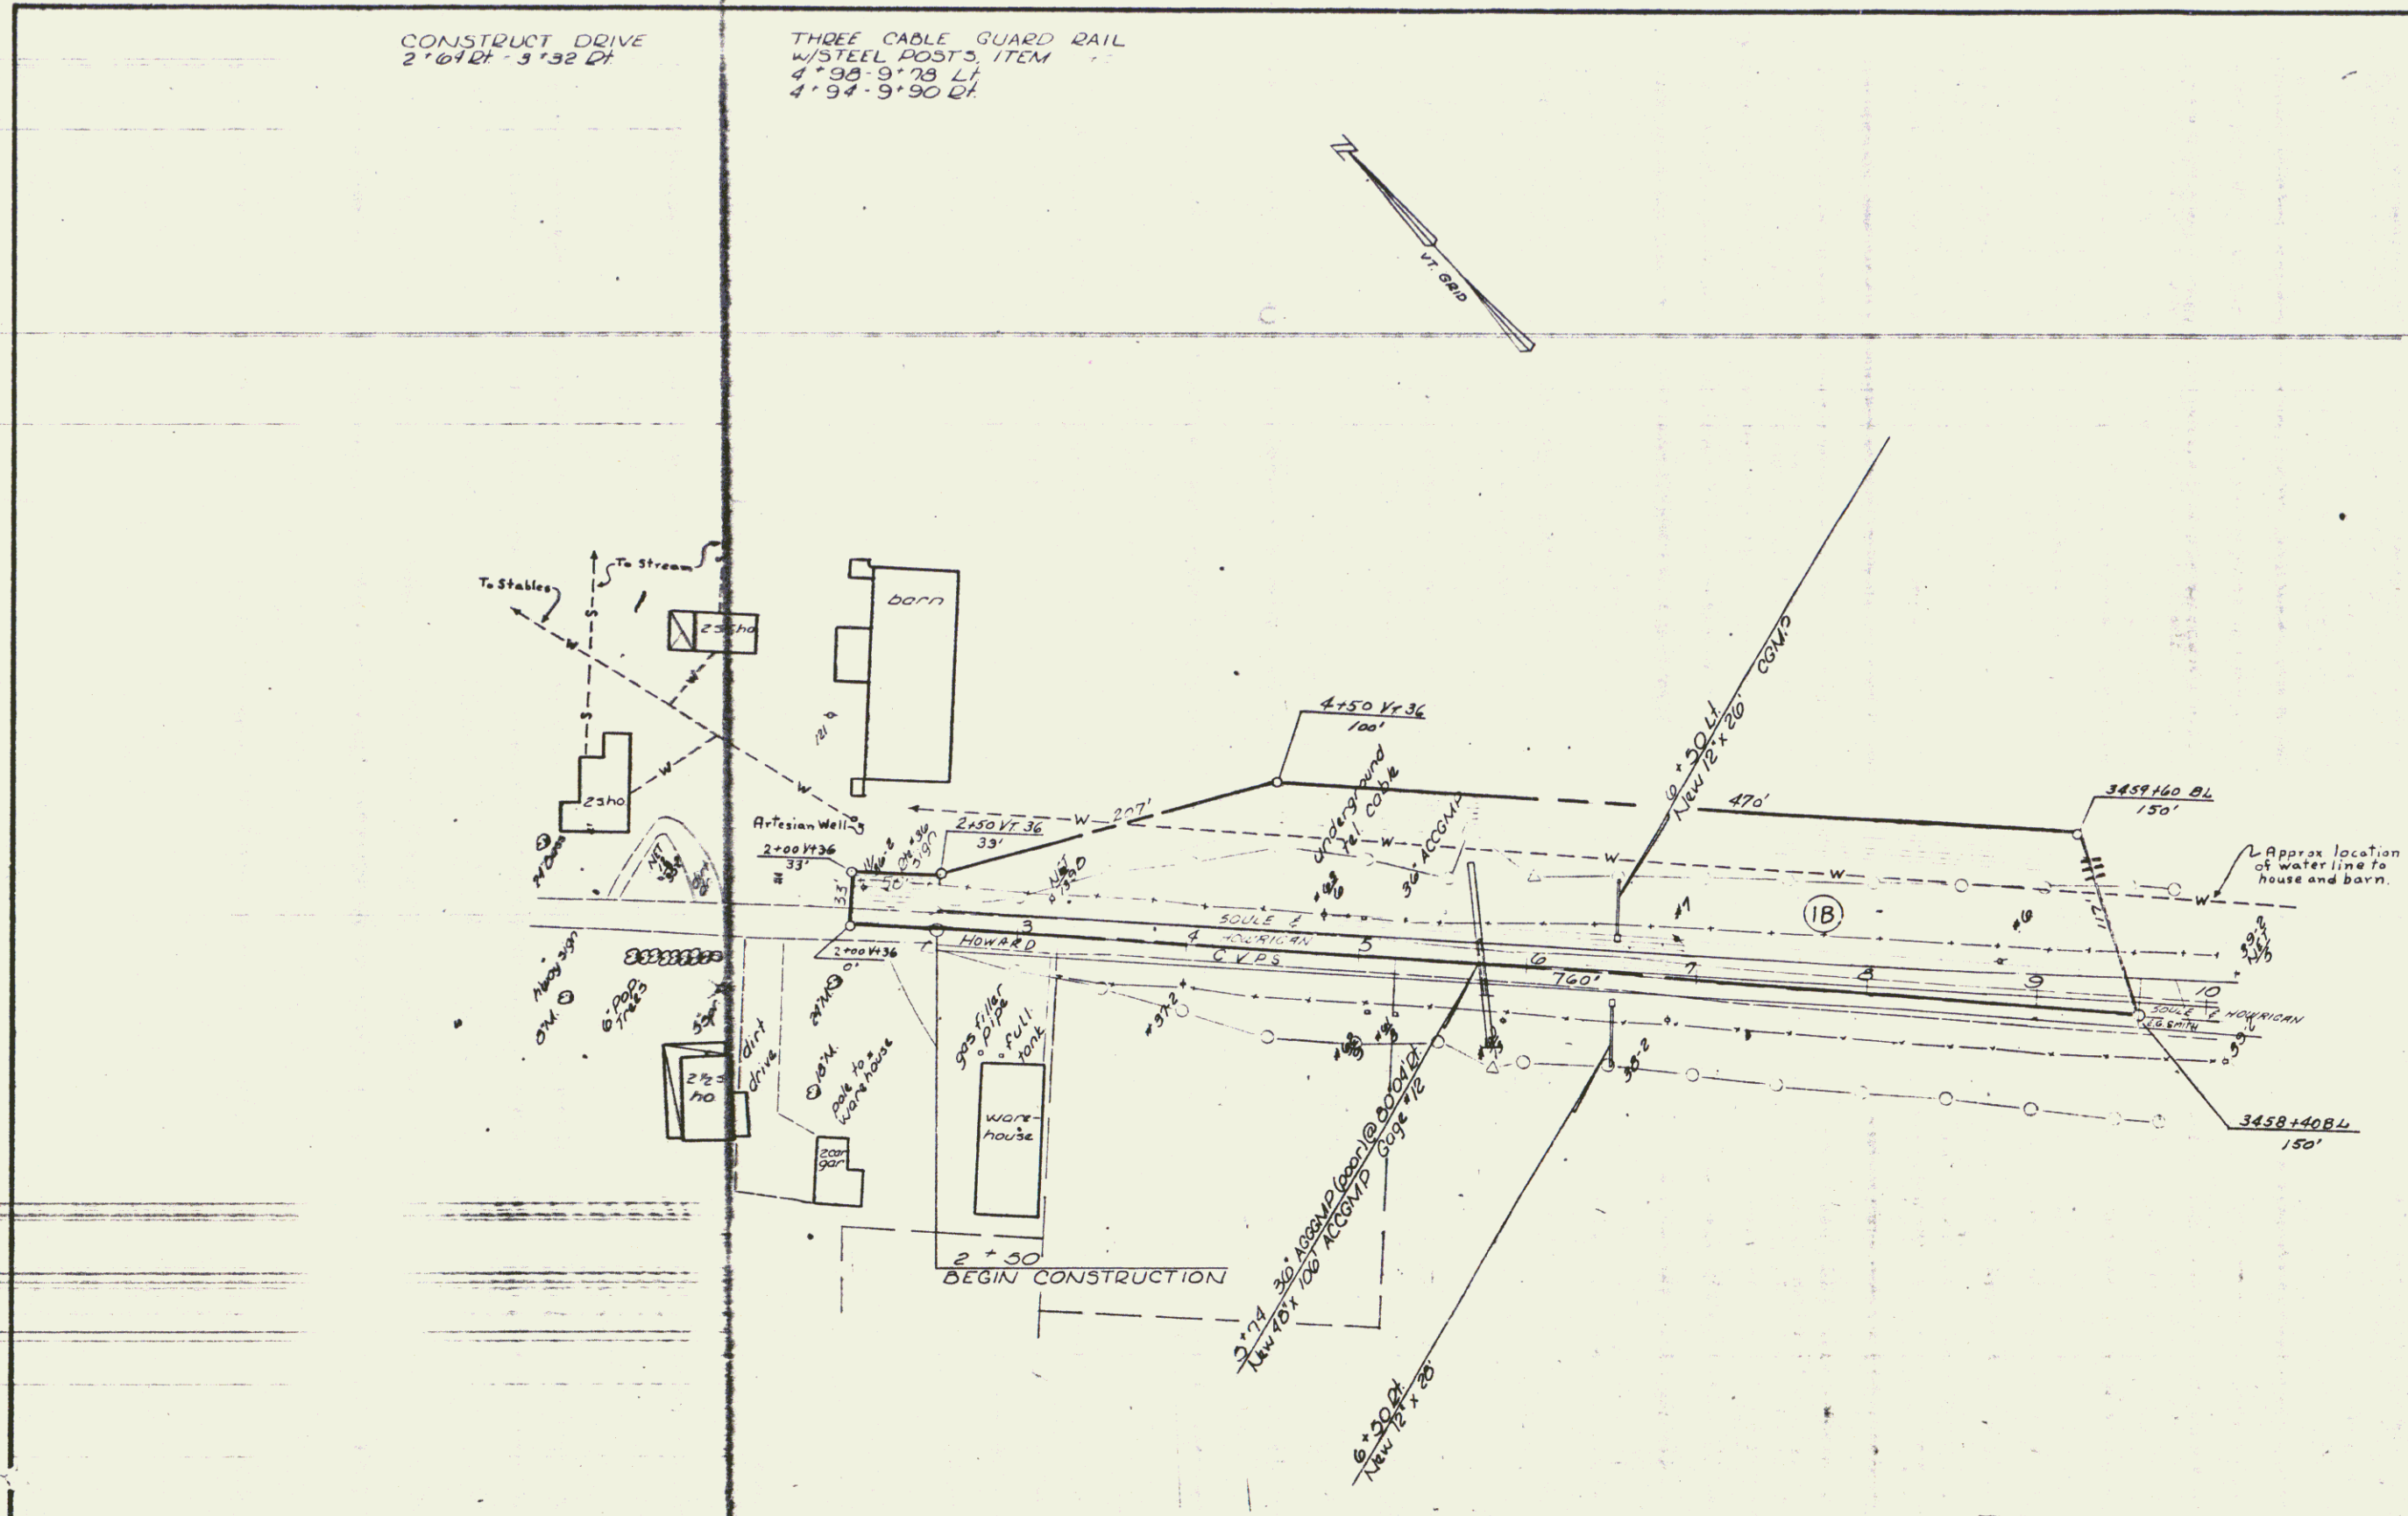


VERMONT DEPARTMENT OF HIGHWAYS
RIGHT-OF-WAY PLANS
PROJECT: ST. ALBANS - SWANTON
NO 189-3(25) ROW
SHEET 19 OF 22
Revised 10-6-60


PLAN
 1/2" = 100'
 1/4" = 50'
 1/8" = 25'
 1/16" = 12.5'

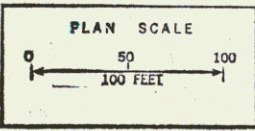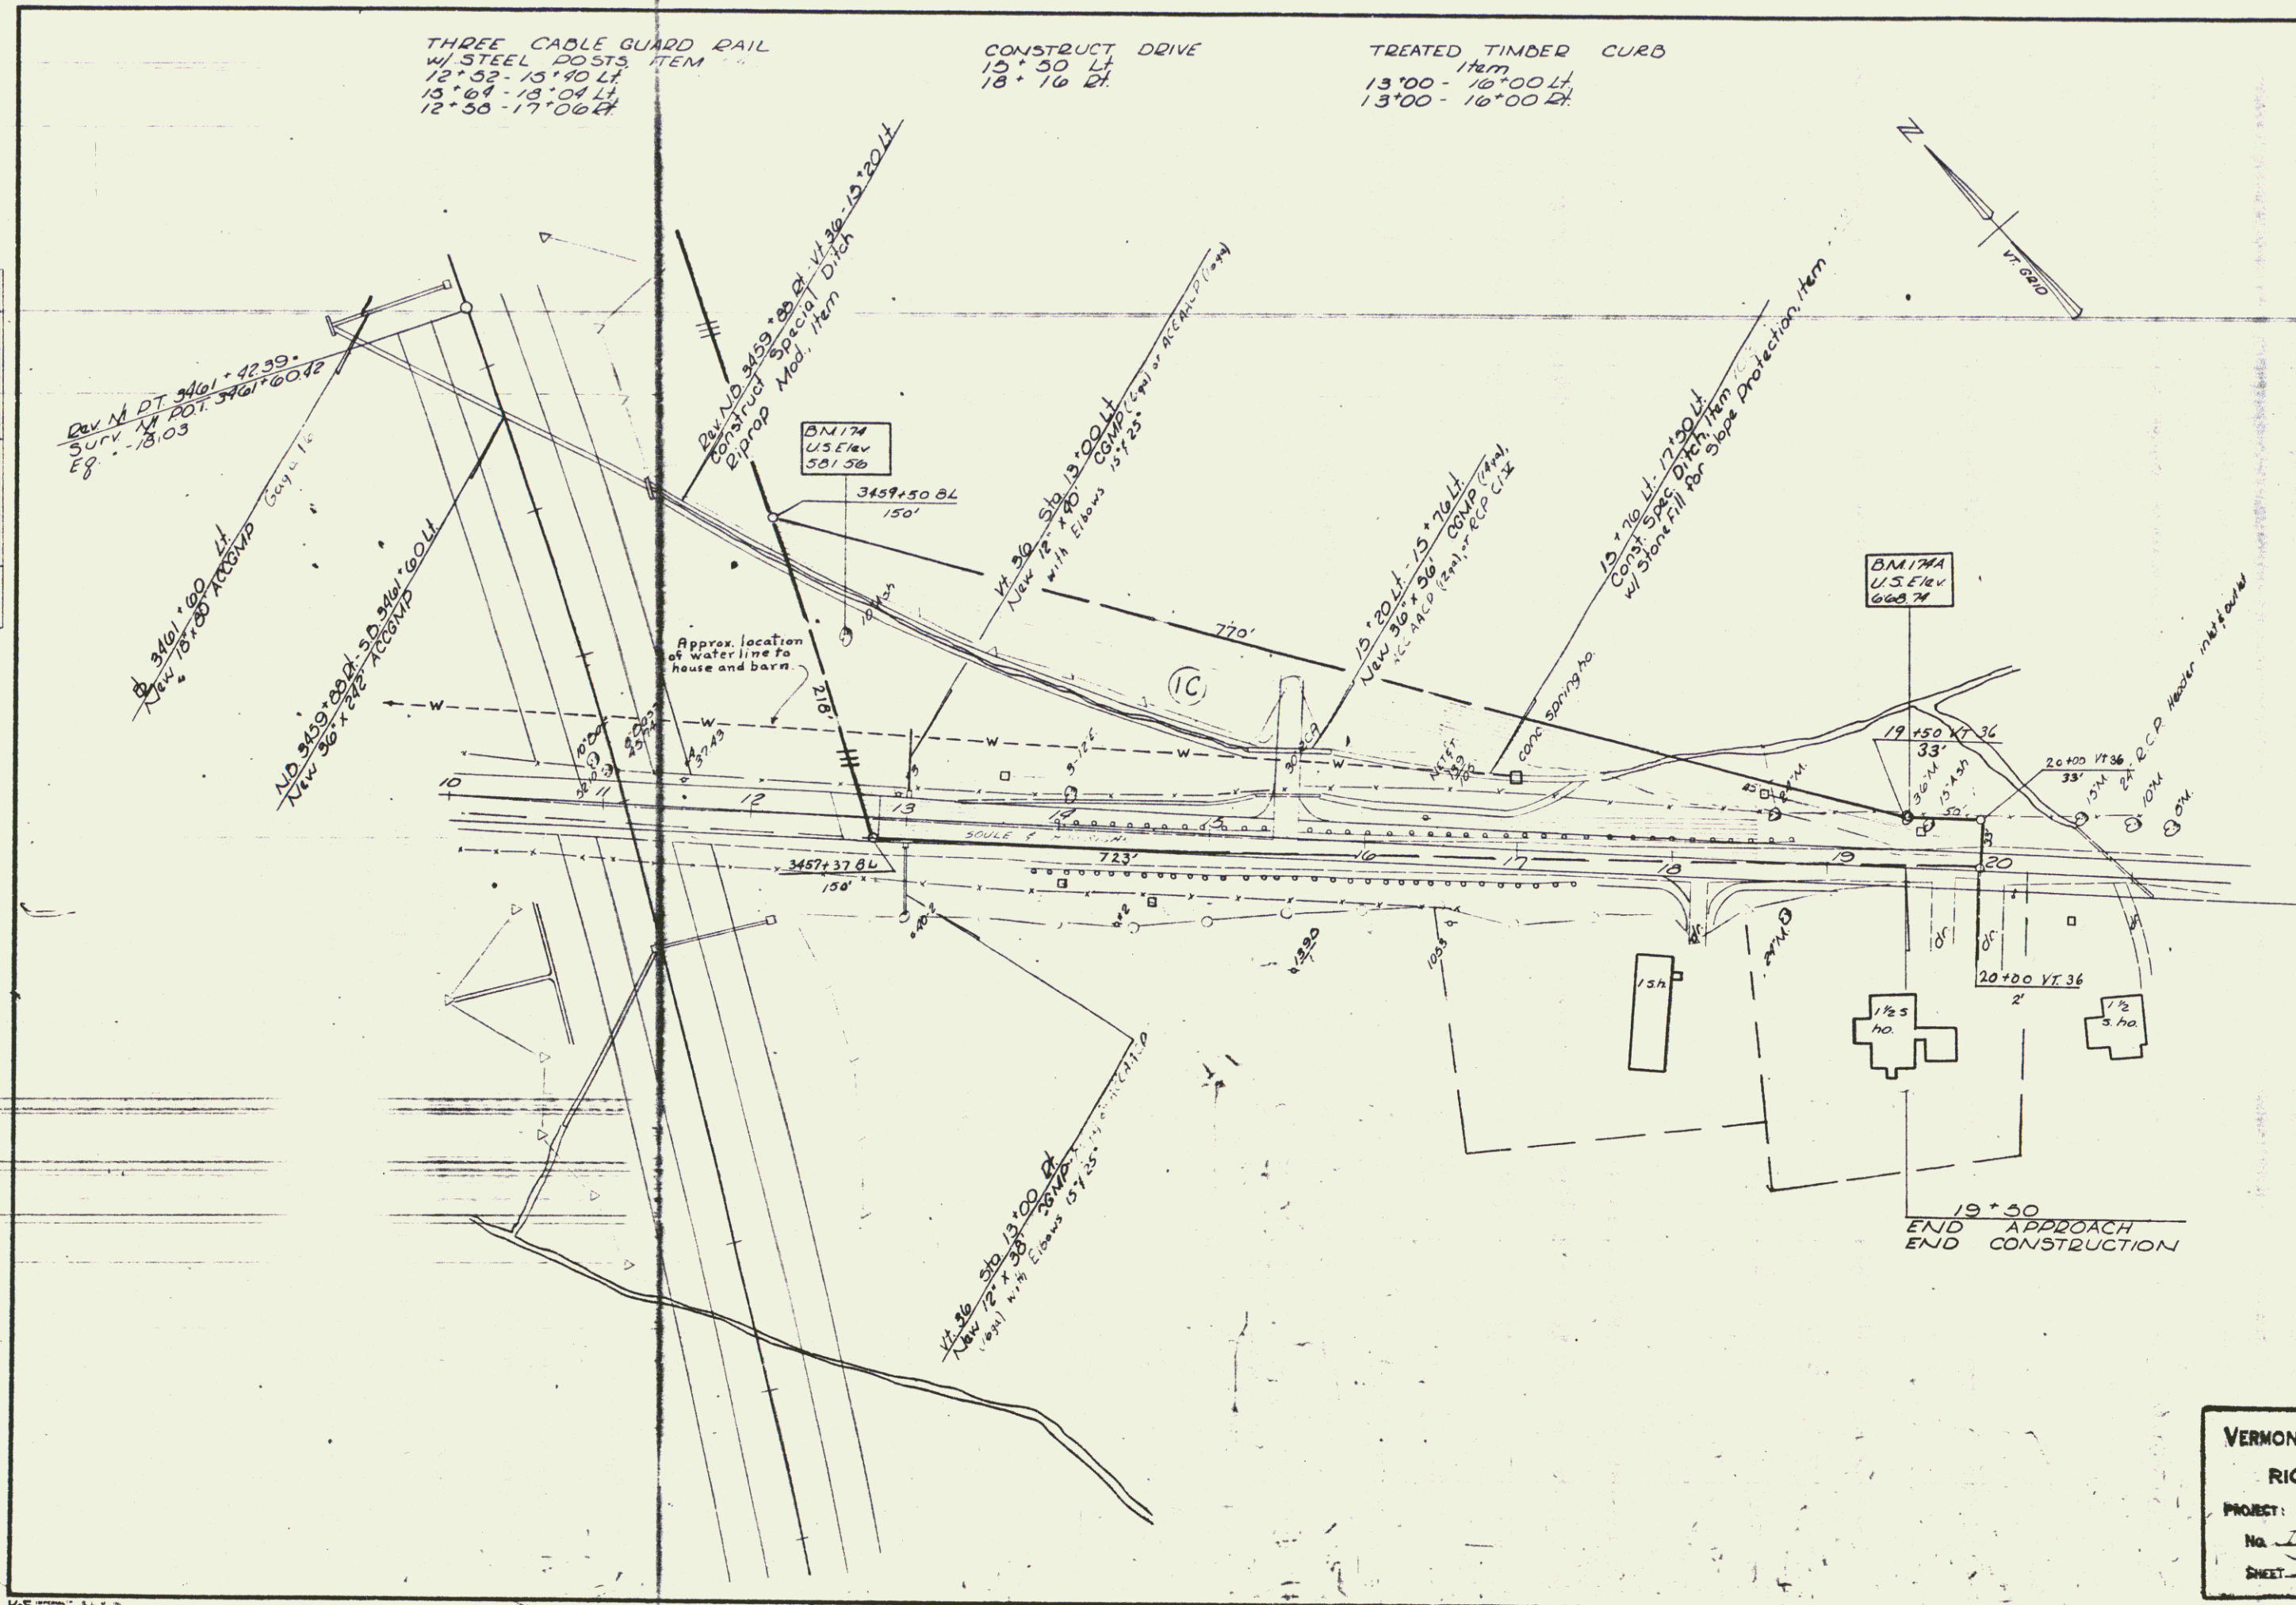


VERMONT DEPARTMENT OF HIGHWAYS
 RIGHT-OF-WAY PLANS
 PROJECT: ST. ALBAN-SWANTON
 No. 187-3(25) ROW
 SHEET: 20 OF 25



PLAN	REVISION	DATE
1	REVISION	1/25/88
2	REVISION	1/25/88
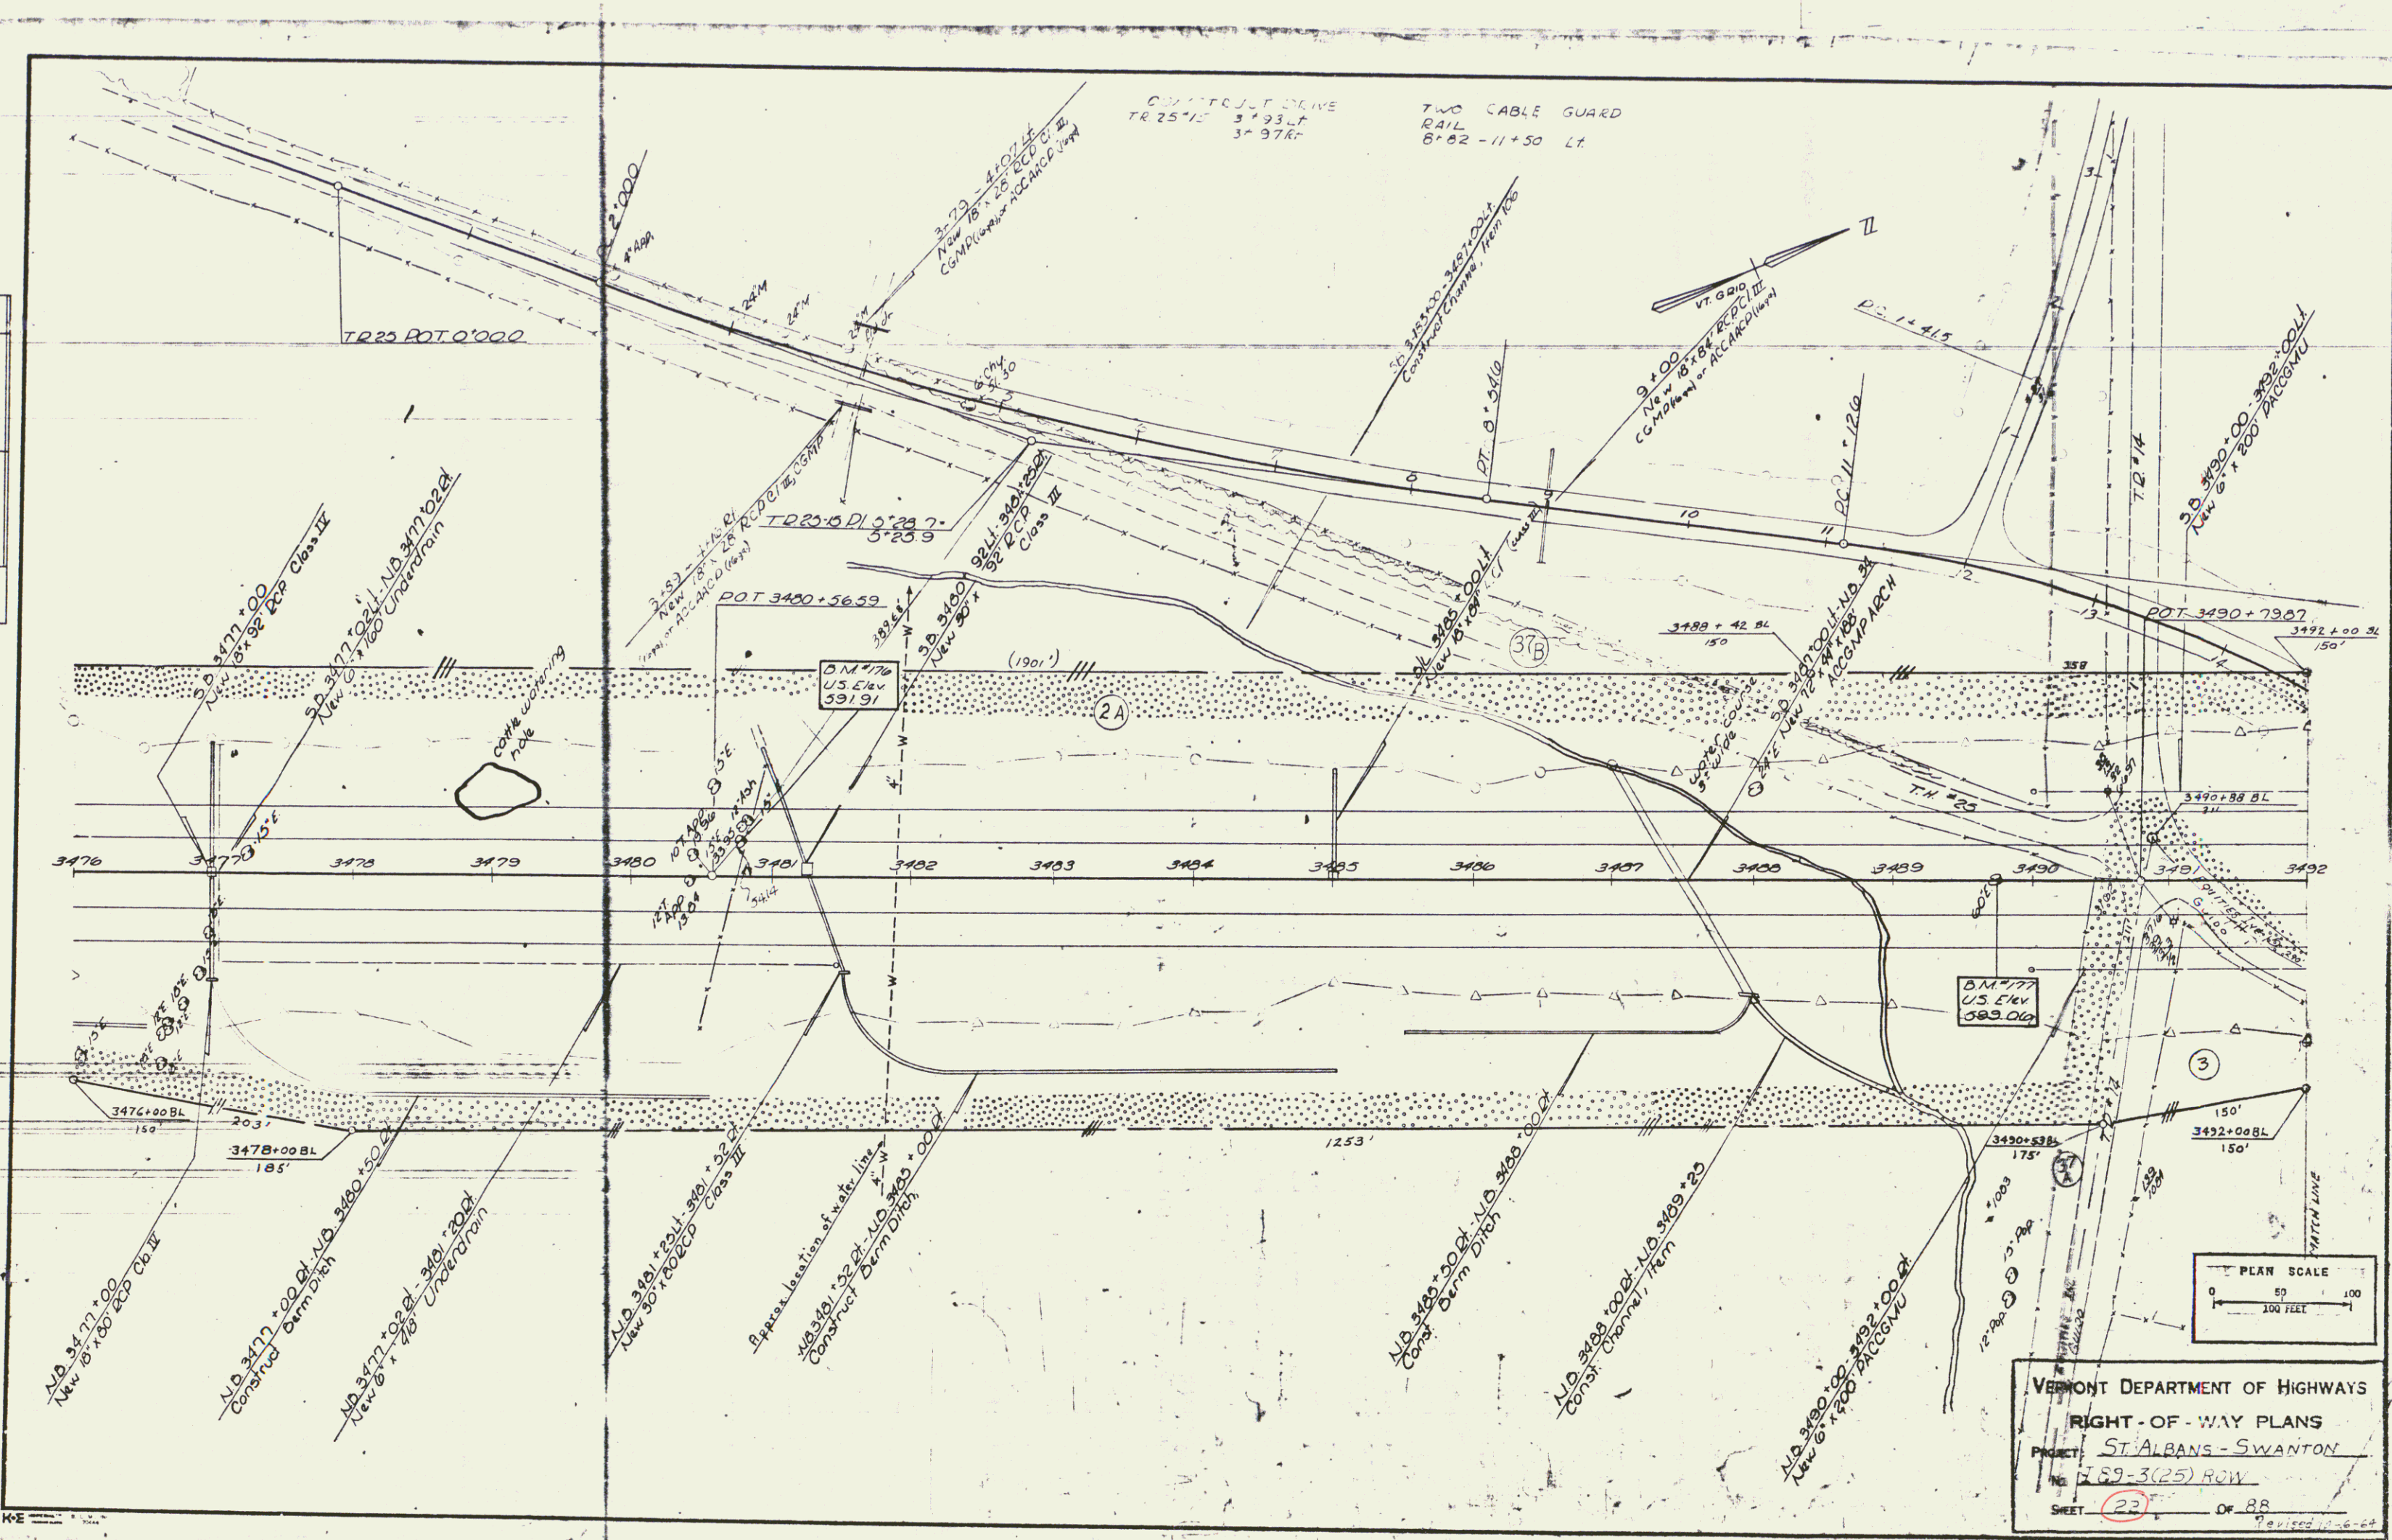

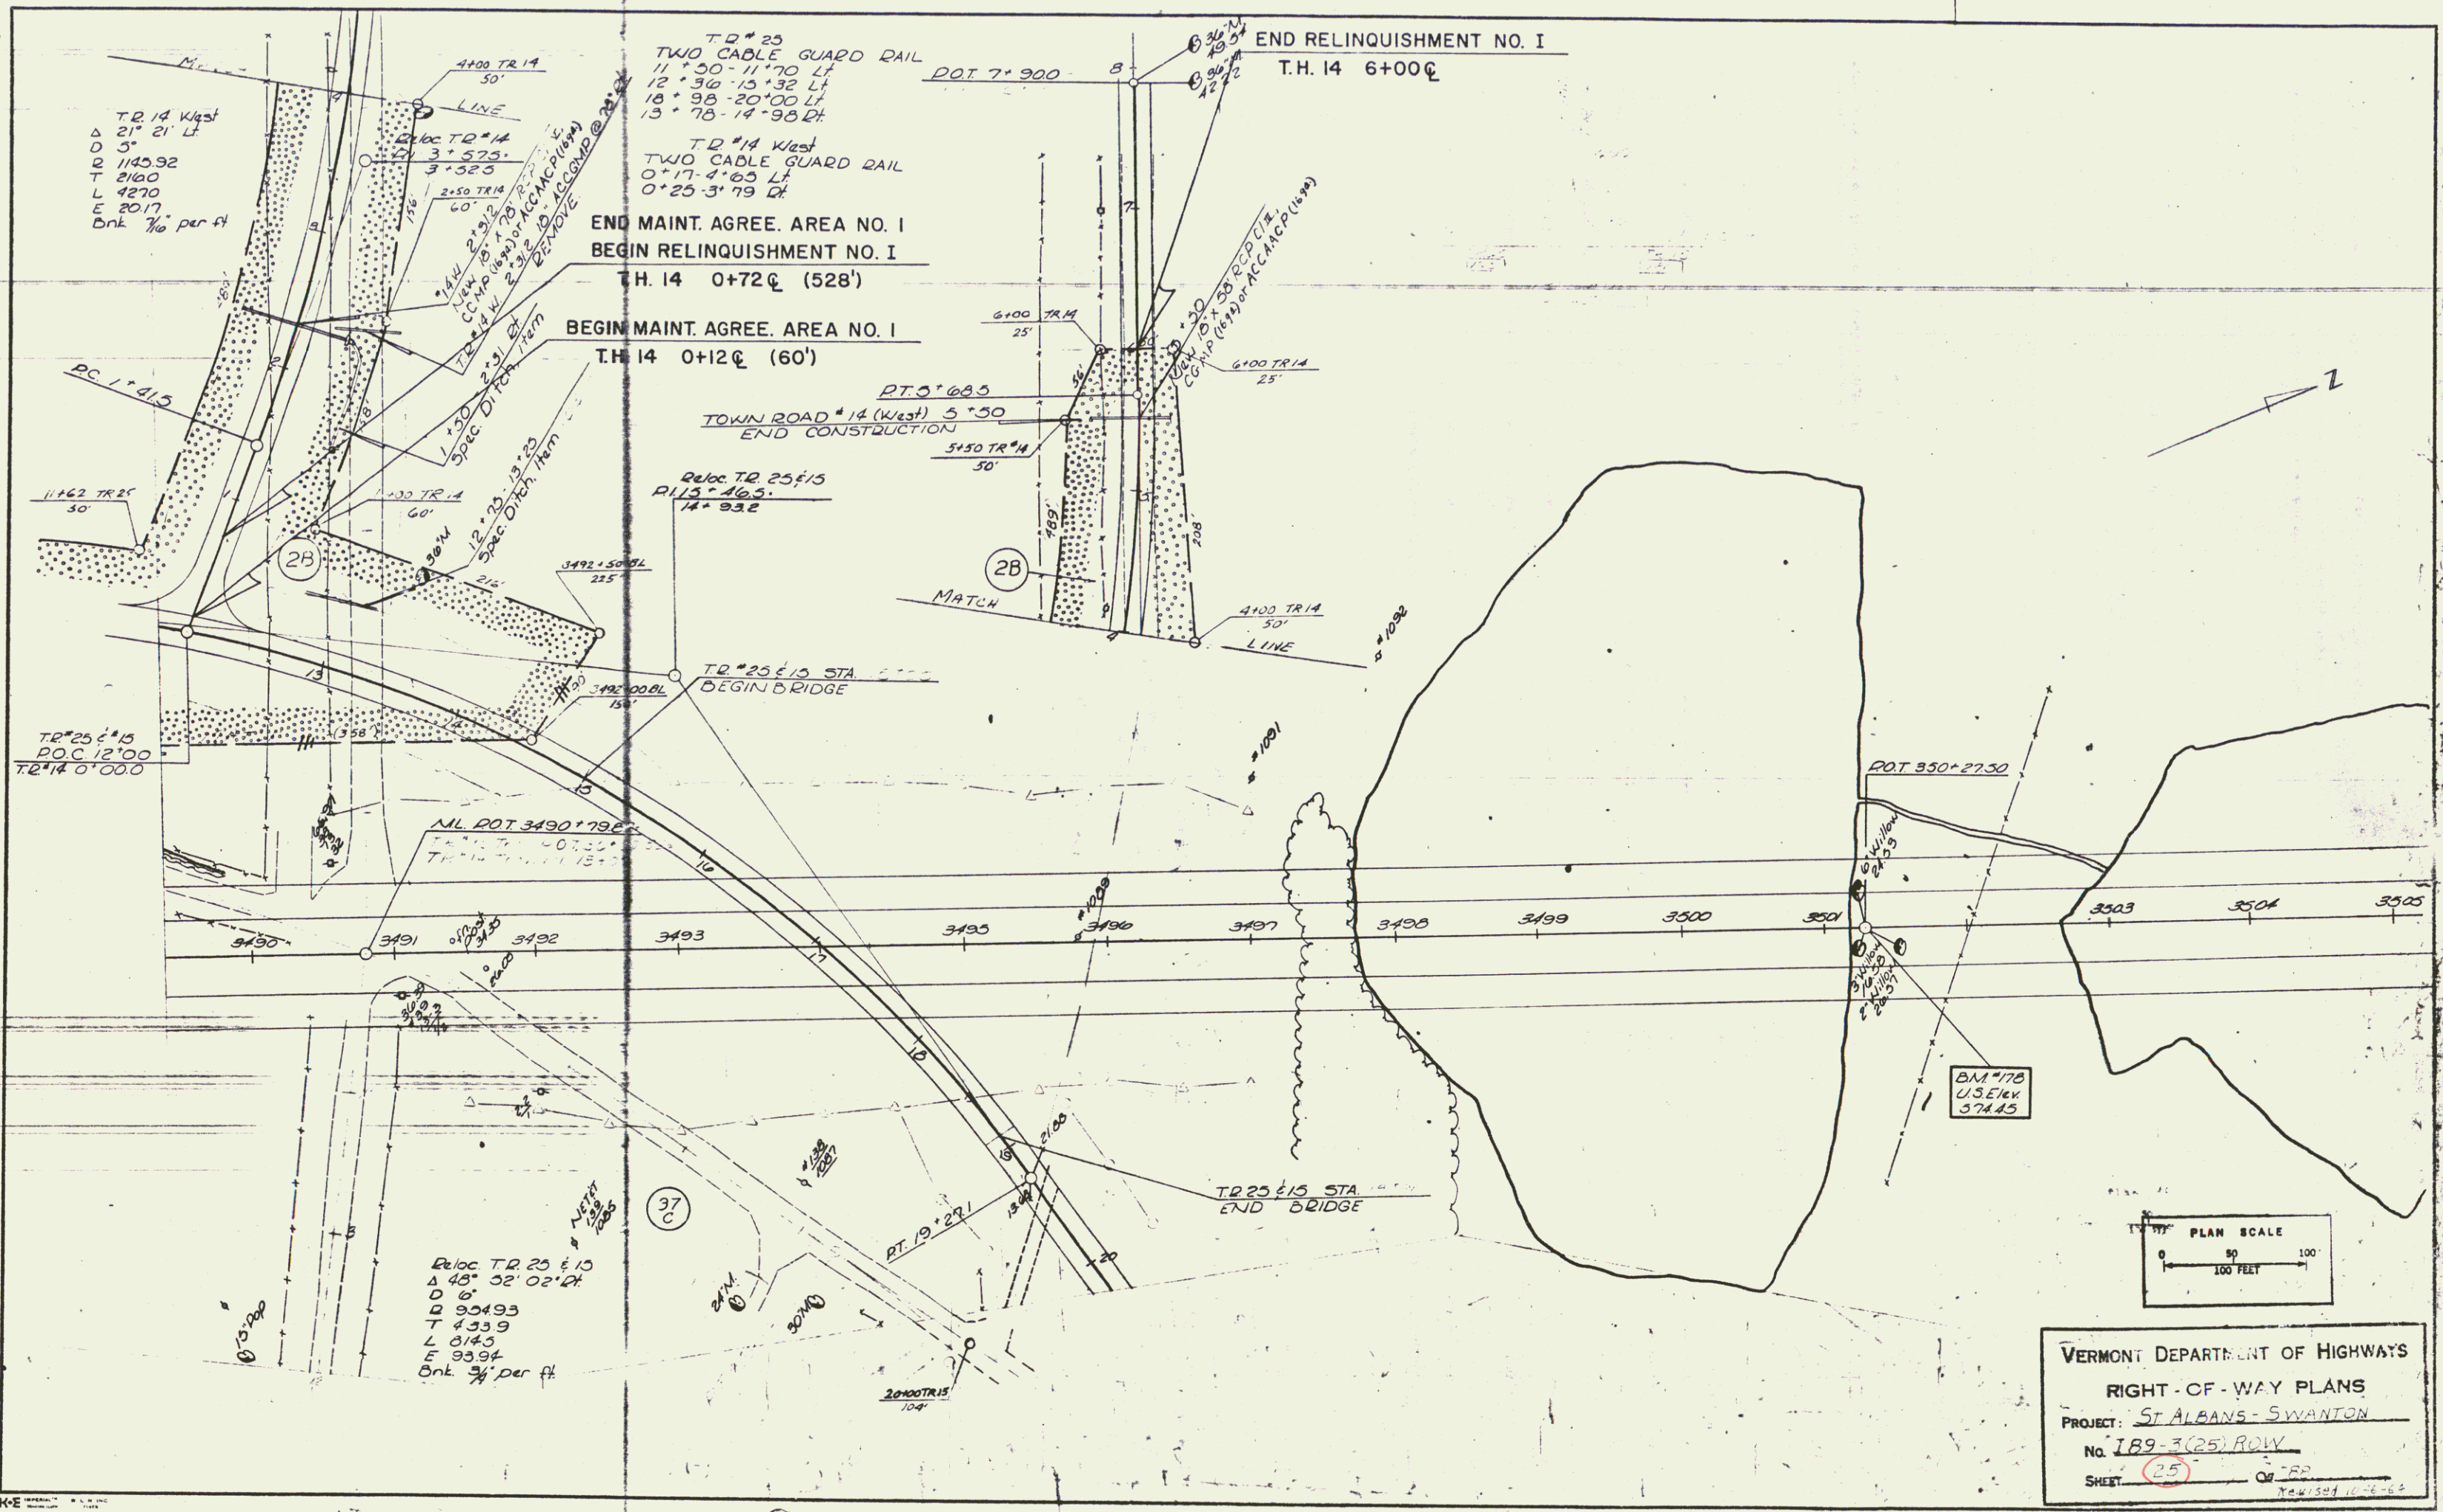

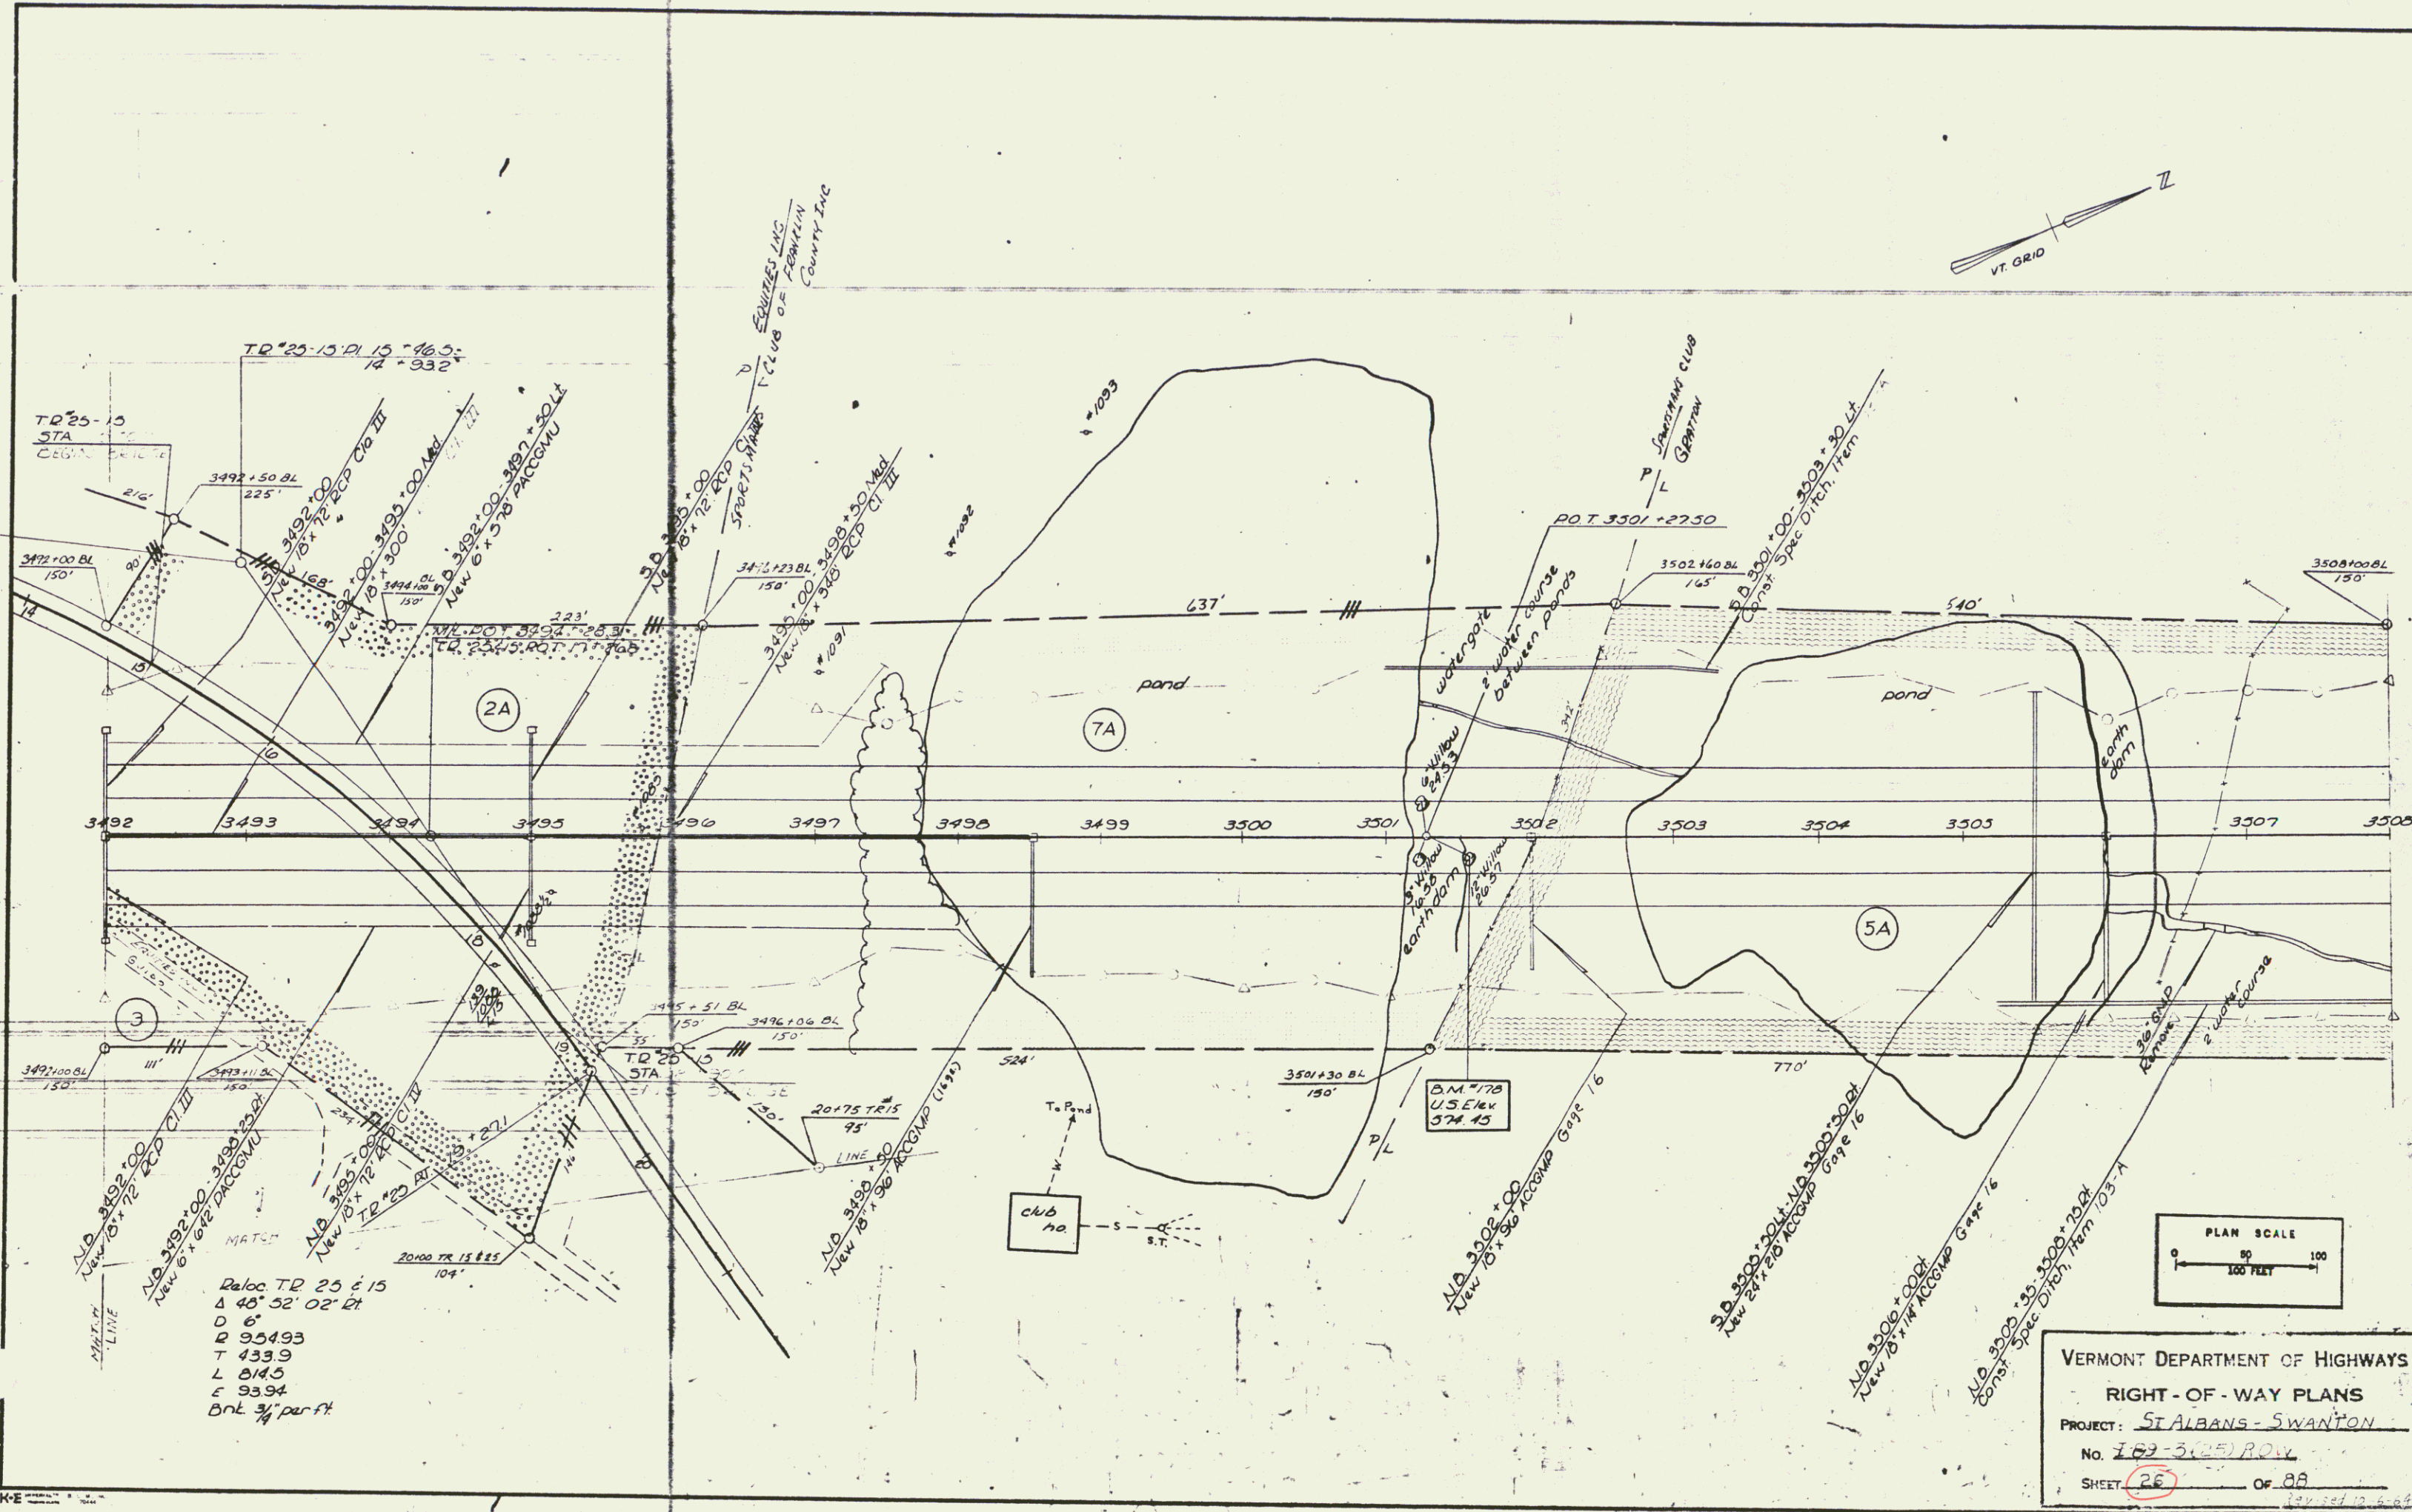

PLAN
 1. 3508+00
 2. 3509+00
 3. 3510+00
 4. 3511+00
 5. 3512+00
 6. 3513+00
 7. 3514+00
 8. 3515+00
 9. 3516+00
 10. 3517+00
 11. 3518+00
 12. 3519+00
 13. 3520+00
 14. 3521+00
 15. 3522+00
 16. 3523+00
 17. 3524+00

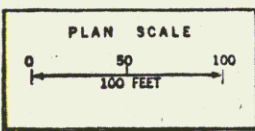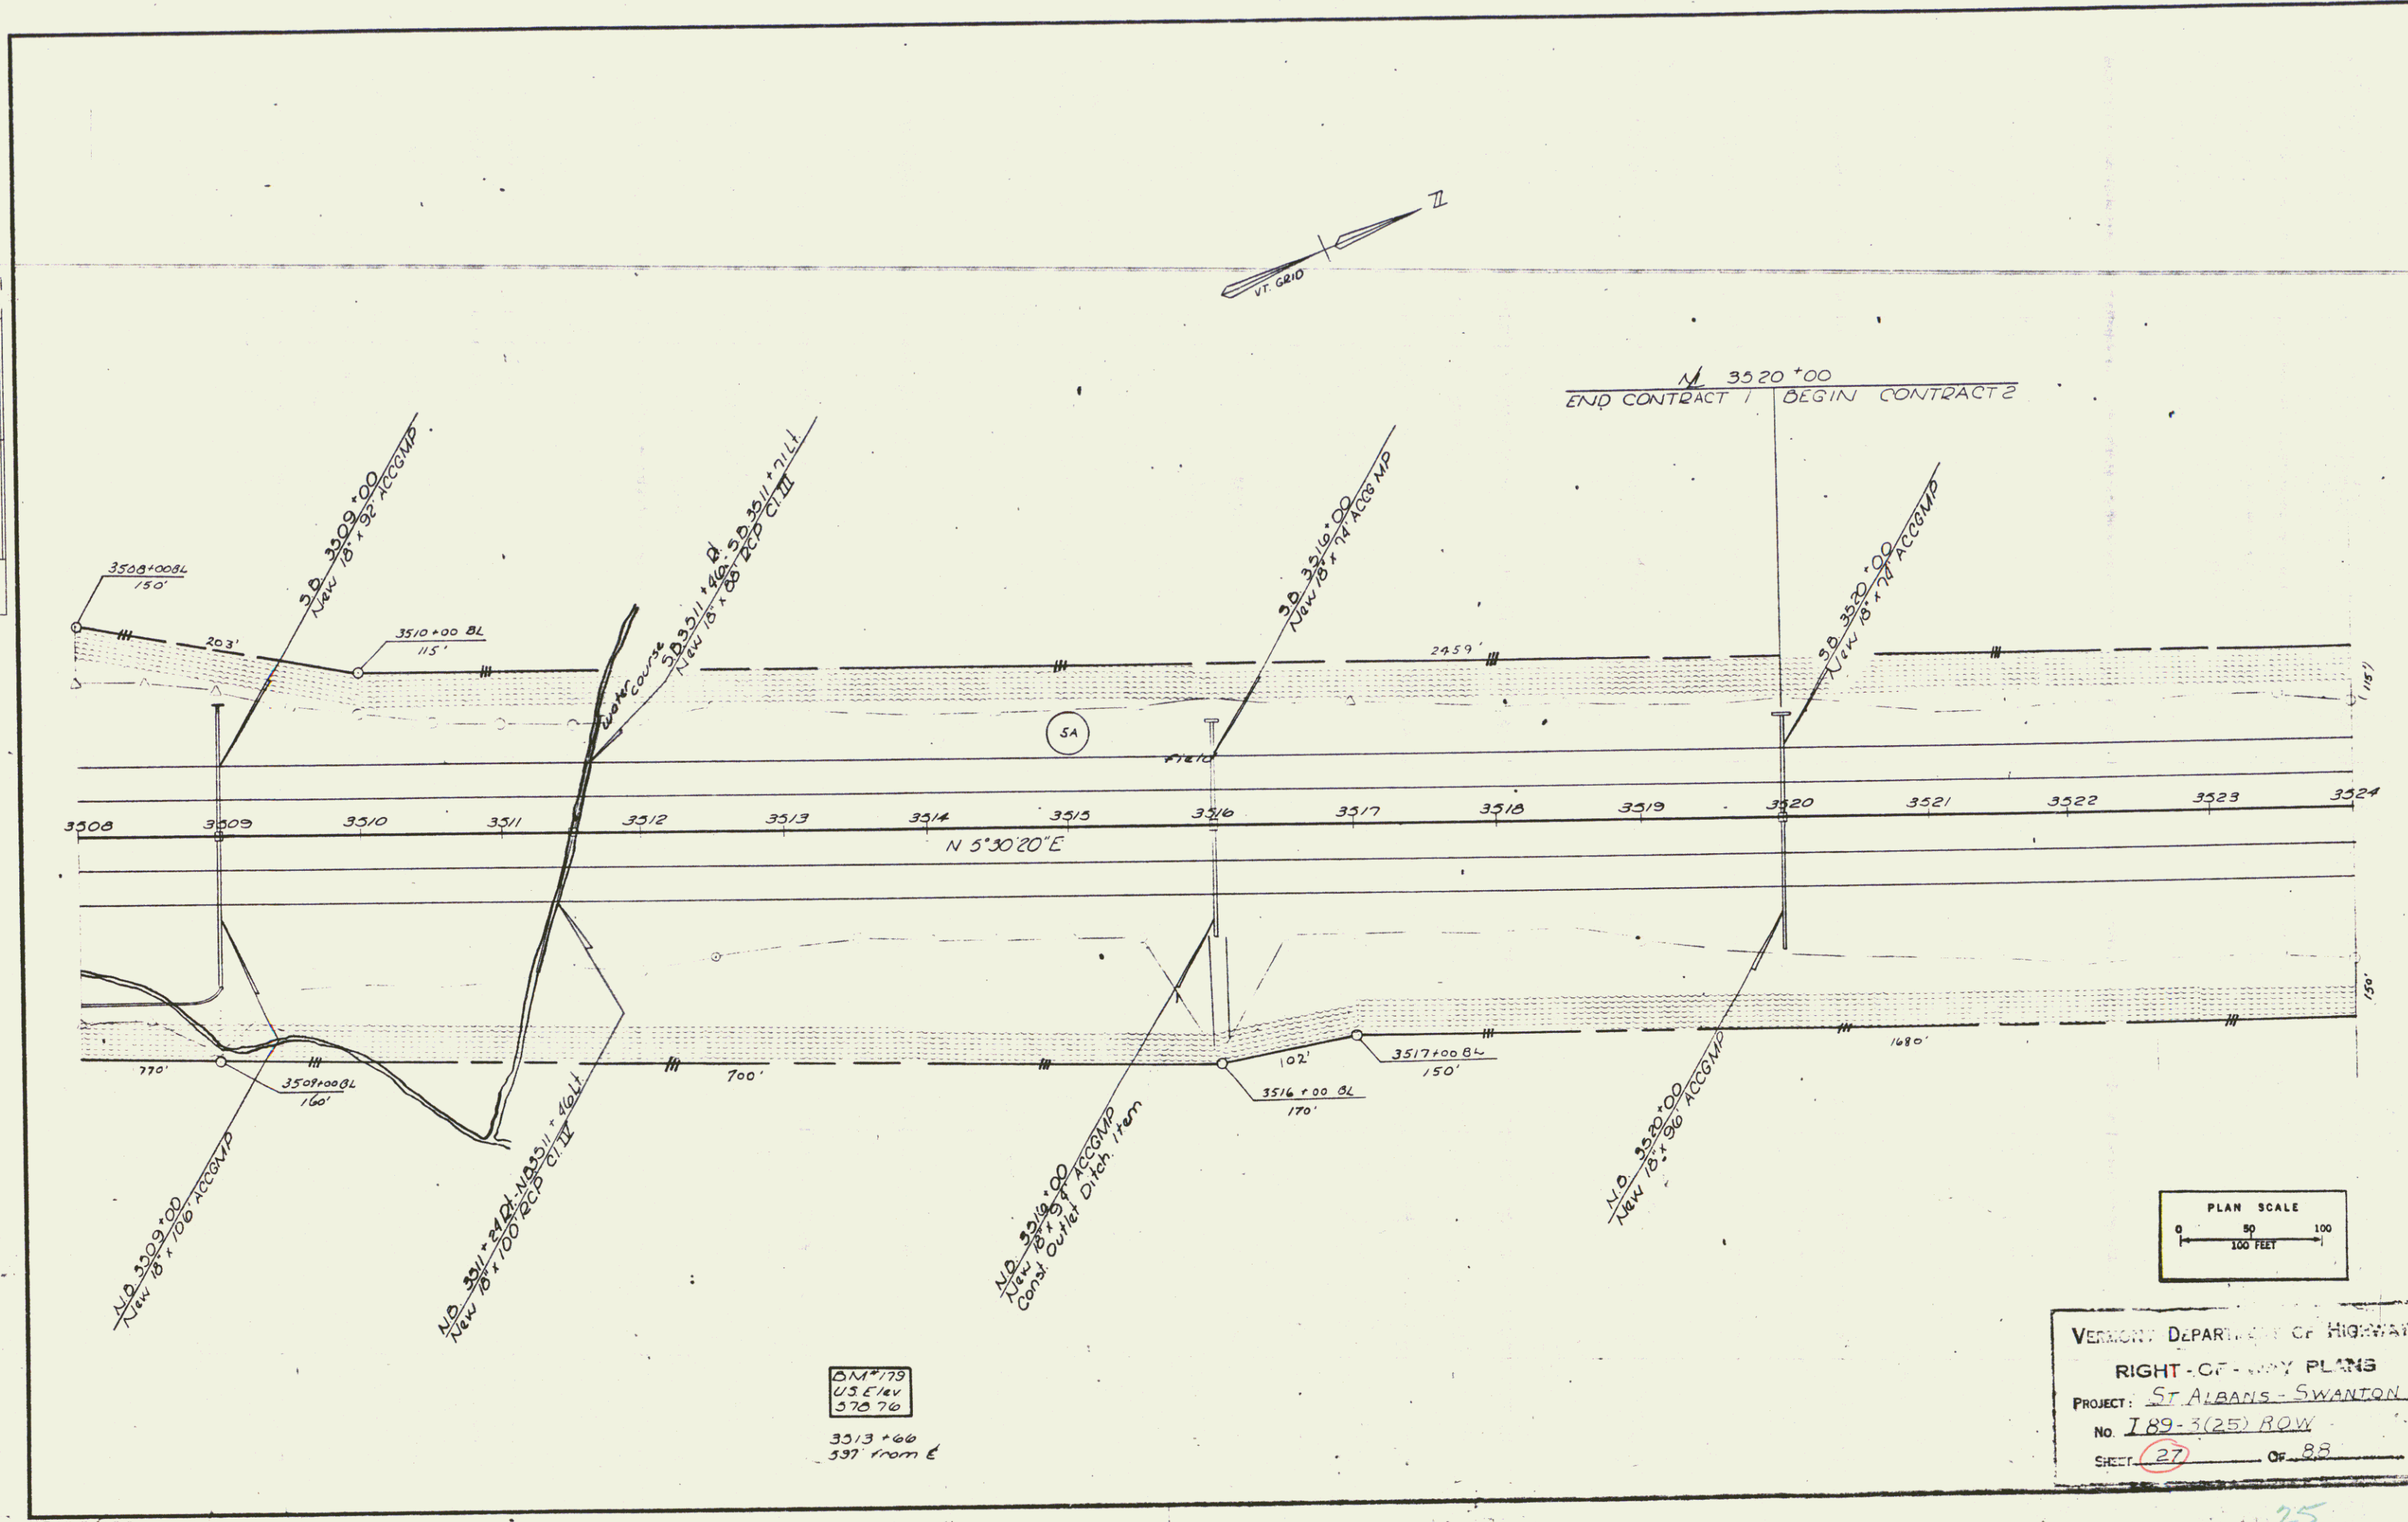


VERMONT DEPARTMENT OF HIGHWAYS
 RIGHT-OF-WAY PLANS
 PROJECT: ST. ALBANS - SWANTON
 No. 189-3(25) ROW
 SHEET 27 OF 88

3513+00
 397' from E

25


PLAN
 SURVEYED
 NOT FOR CONSTRUCTION
 BY
 S. J. L. L. L.
 11/2/54
 11/2/54
 11/2/54

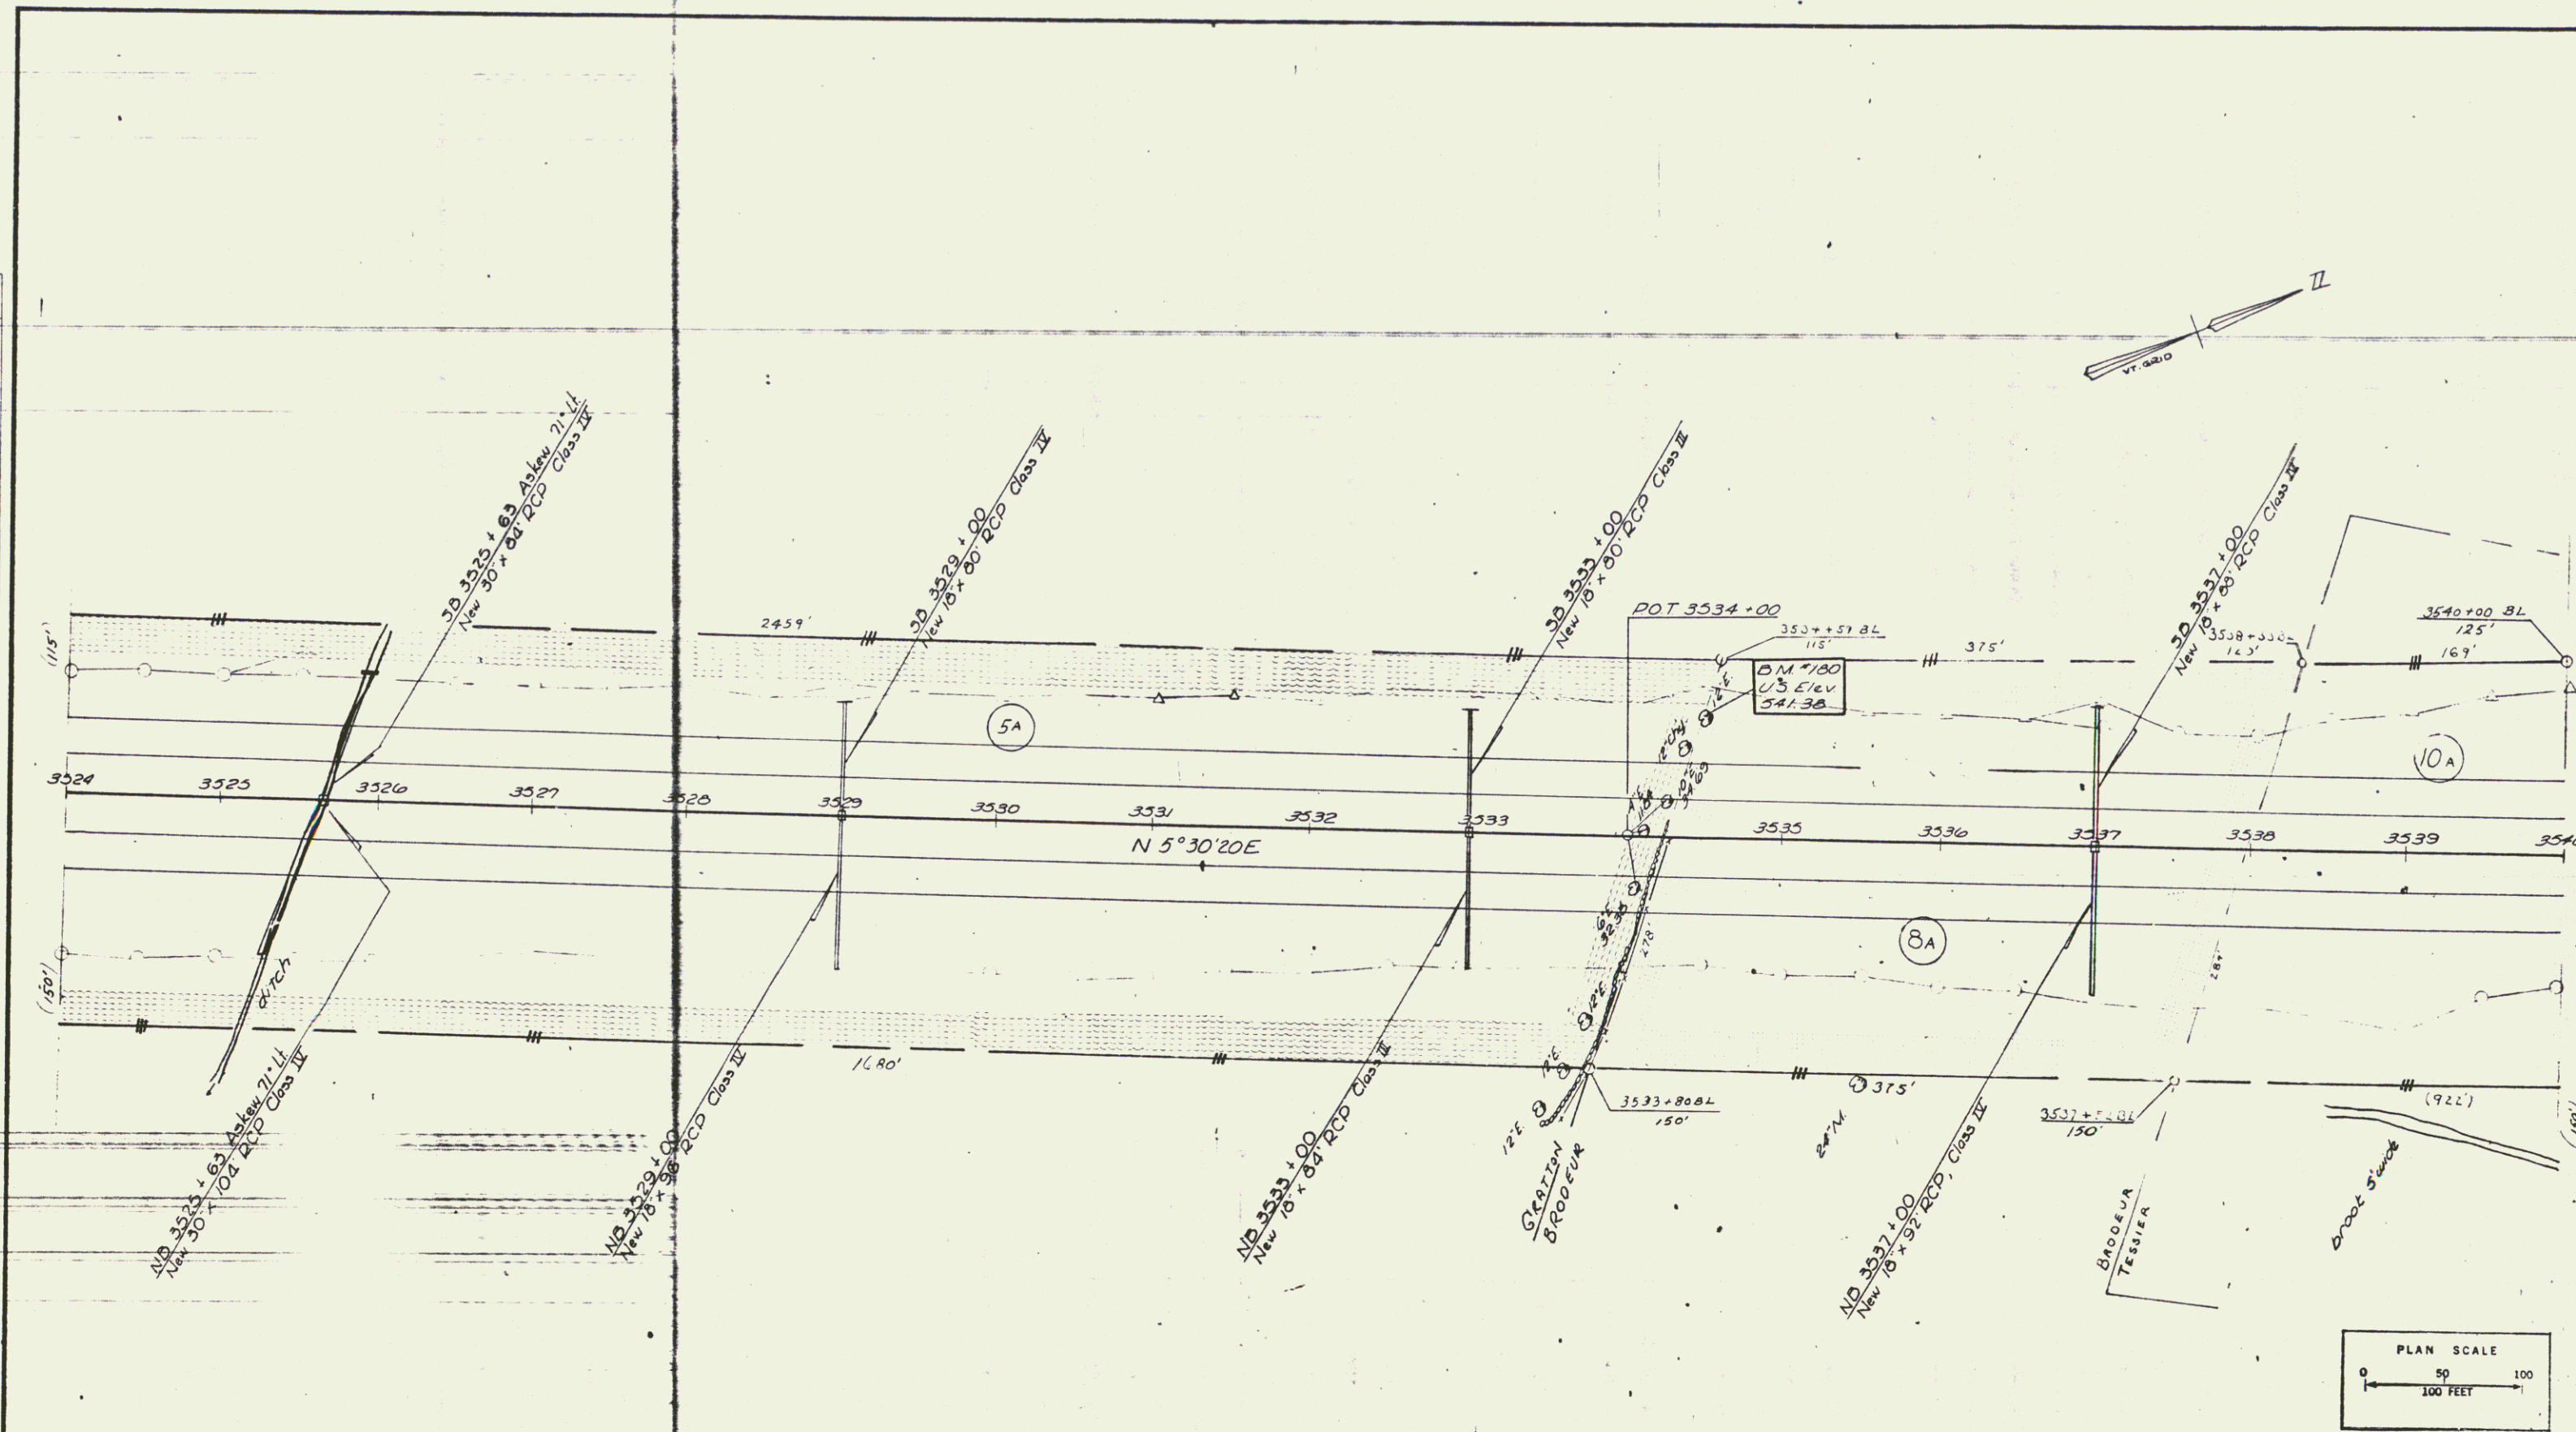


VERMONT DEPARTMENT OF HIGHWAYS
 RIGHT-OF-WAY PLANS
 PROJECT: ST ALBANS - SAVANTON
 No. 189-3(25) ROW
 SHEET 28 OF 66

PLAN
RIGHT-OF-WAY
STALBANS-SWANTON
NO. 189-3(25) ROW
SHEET 23 OF 88
REVISED 10-6-64

THREE CABLE GUARD RAIL
W/ STEEL POSTS ITEM
VT 105
5' 50" - 5' 30" LT
5' 30" - 5' 30" RT
8' 40" - 12' 00" LT
8' 40" - 12' 00" RT

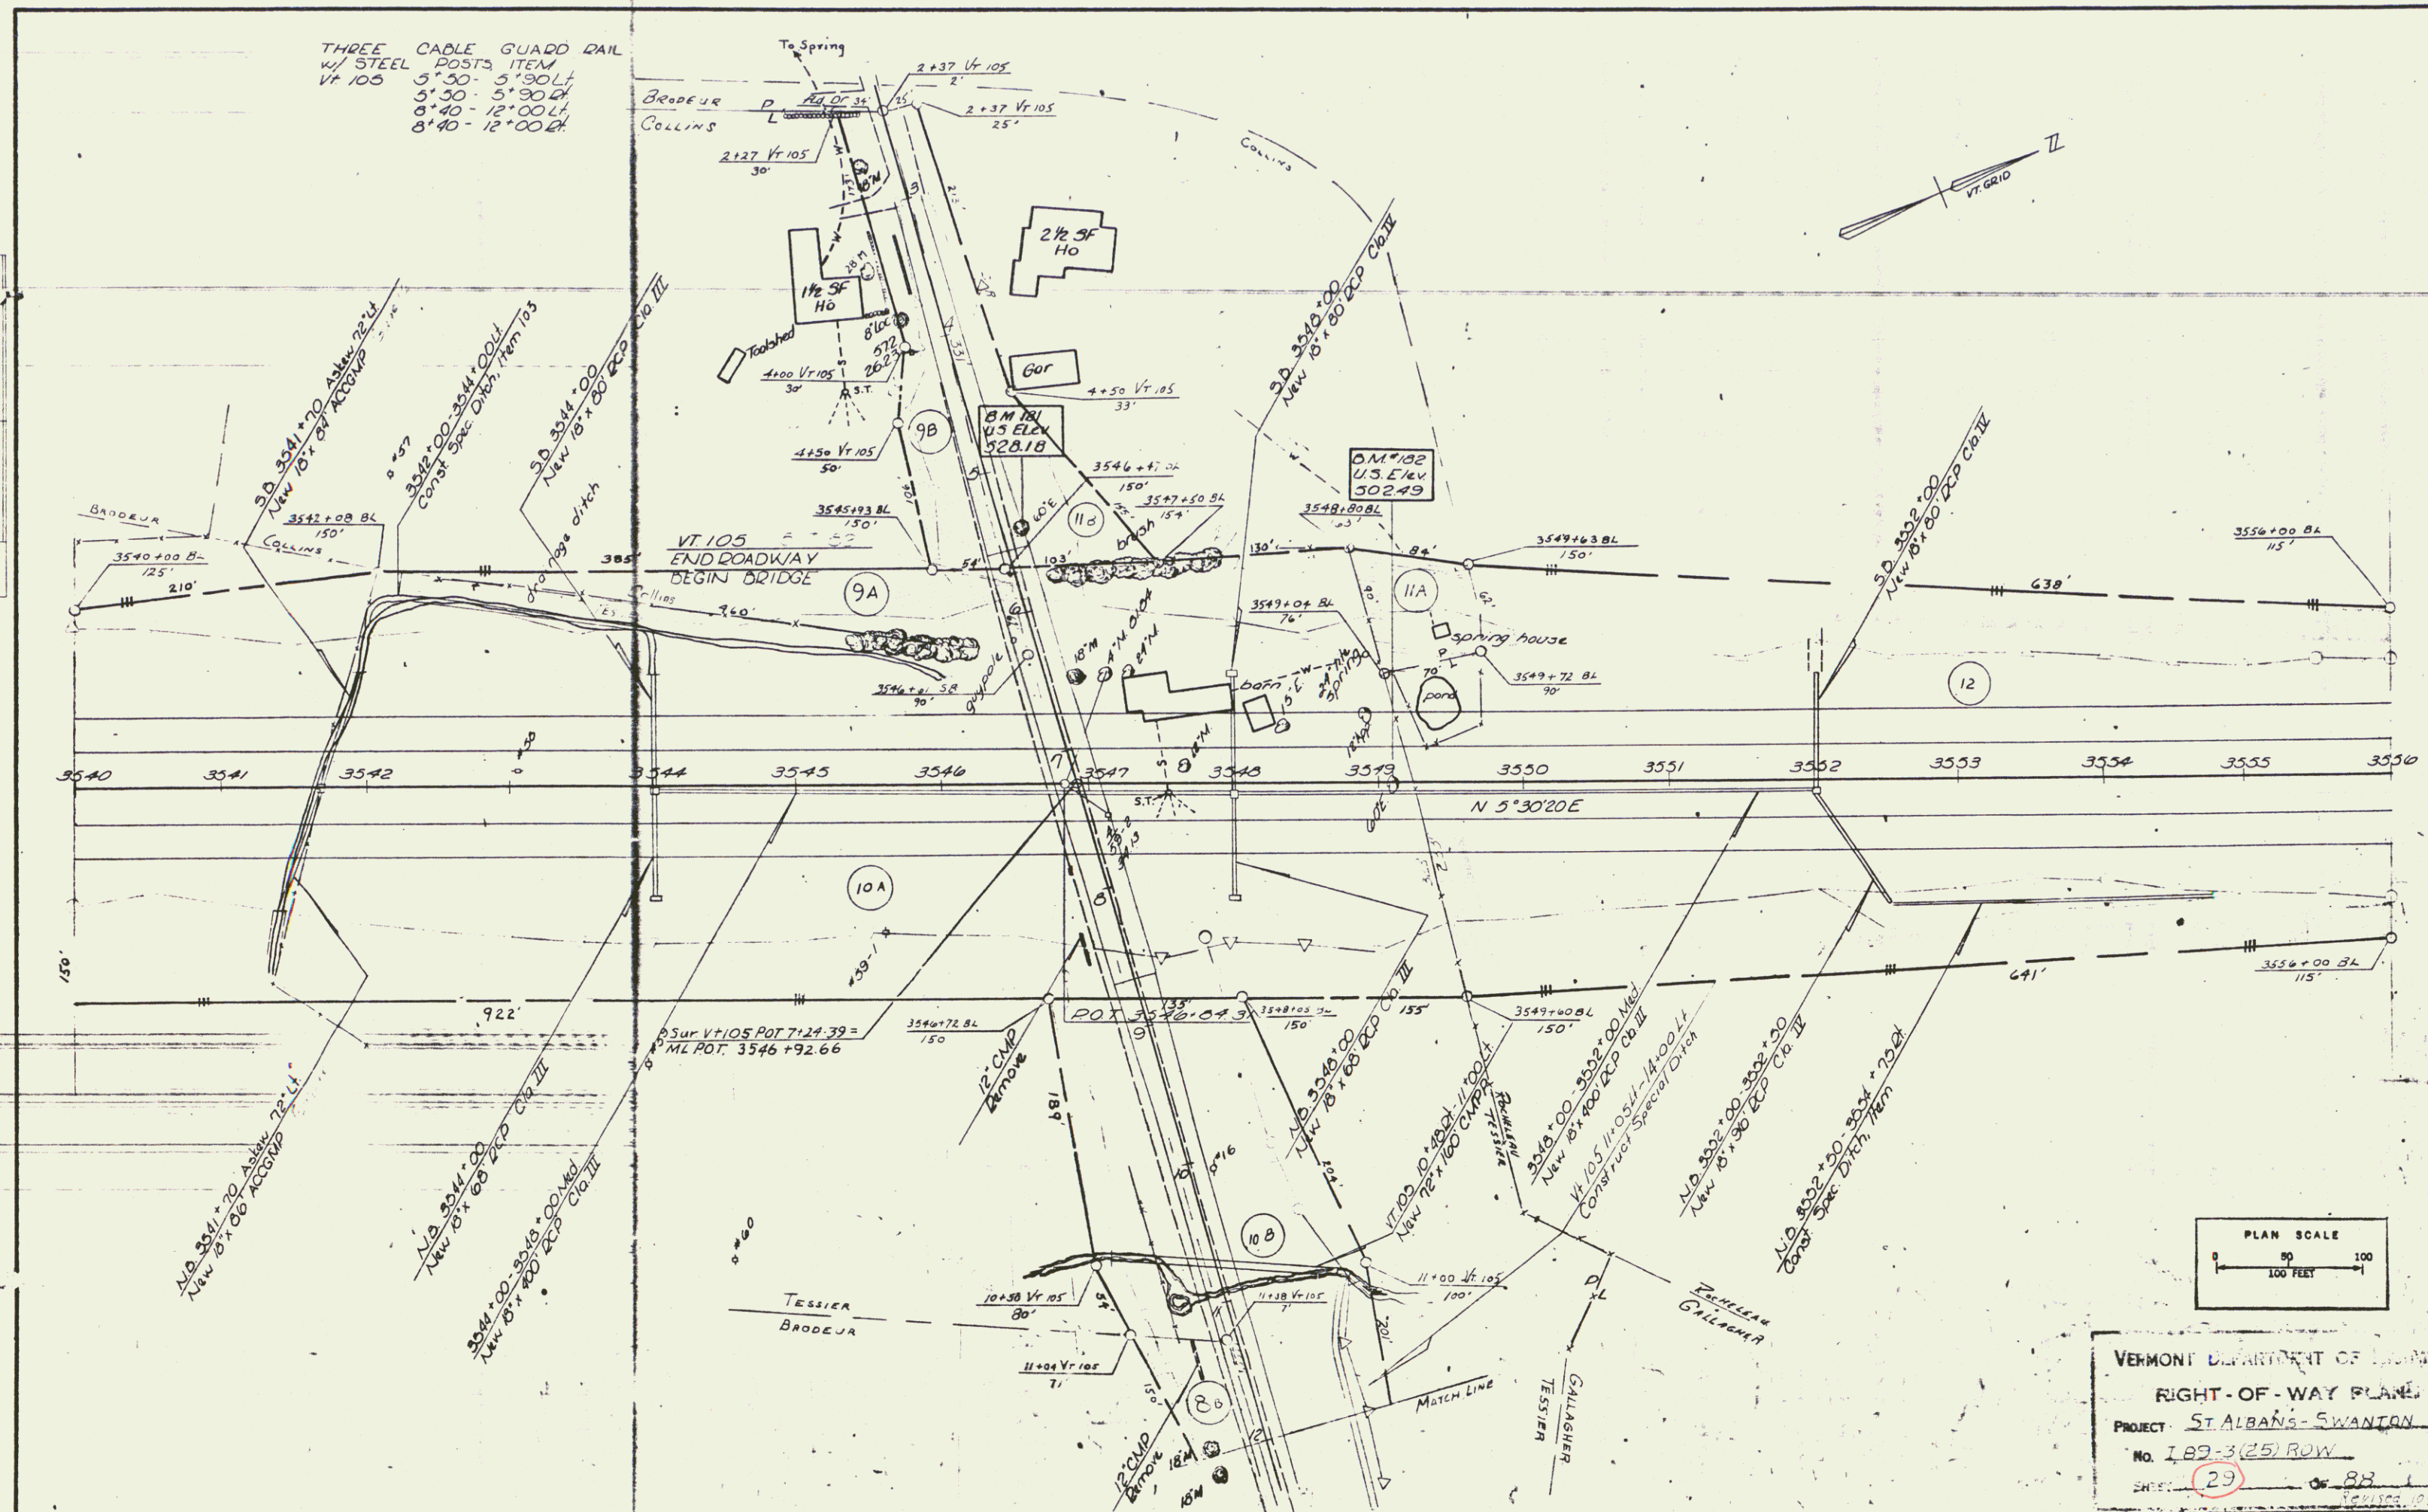

PLAN	SURVIVED	BY	DATE
NOTEBOOK	ROUTED/TRACE	30/01/09	2/02
No.	AUGMENT/CHECKED	6/01/09	5/02
	BOW CHECKED		

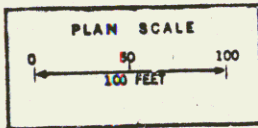



29

PLAN
 DRAWN BY: [illegible]
 CHECKED BY: [illegible]
 DATE: [illegible]

THREE CABLE GUARD RAIL w/ STEEL POSTS
 ITEM
 NB 3572+00 - 3582+63 Q/L
 NB 3582+28 - 3582+38 L/L
 NB 3584+67 - 3584+97 L/L
 NB 3584+62 - 3588+00 Q/L
 SB 3577+27 - 3582+63 L/L
 SB 3582+28 - 3582+38 Q/L
 SB 3584+67 - 3584+97 Q/L
 SB 3584+62 - 3588+00 L/L

Circular Curve Data
 Δ 65° 08' 15" L
 D 2° 30'
 D 2291.83
 T 1463.95
 L 2605.50
 E 427.92
 bank 1 1/2" per ft

Spiral Curve Data

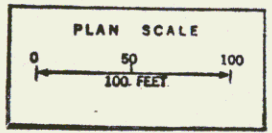
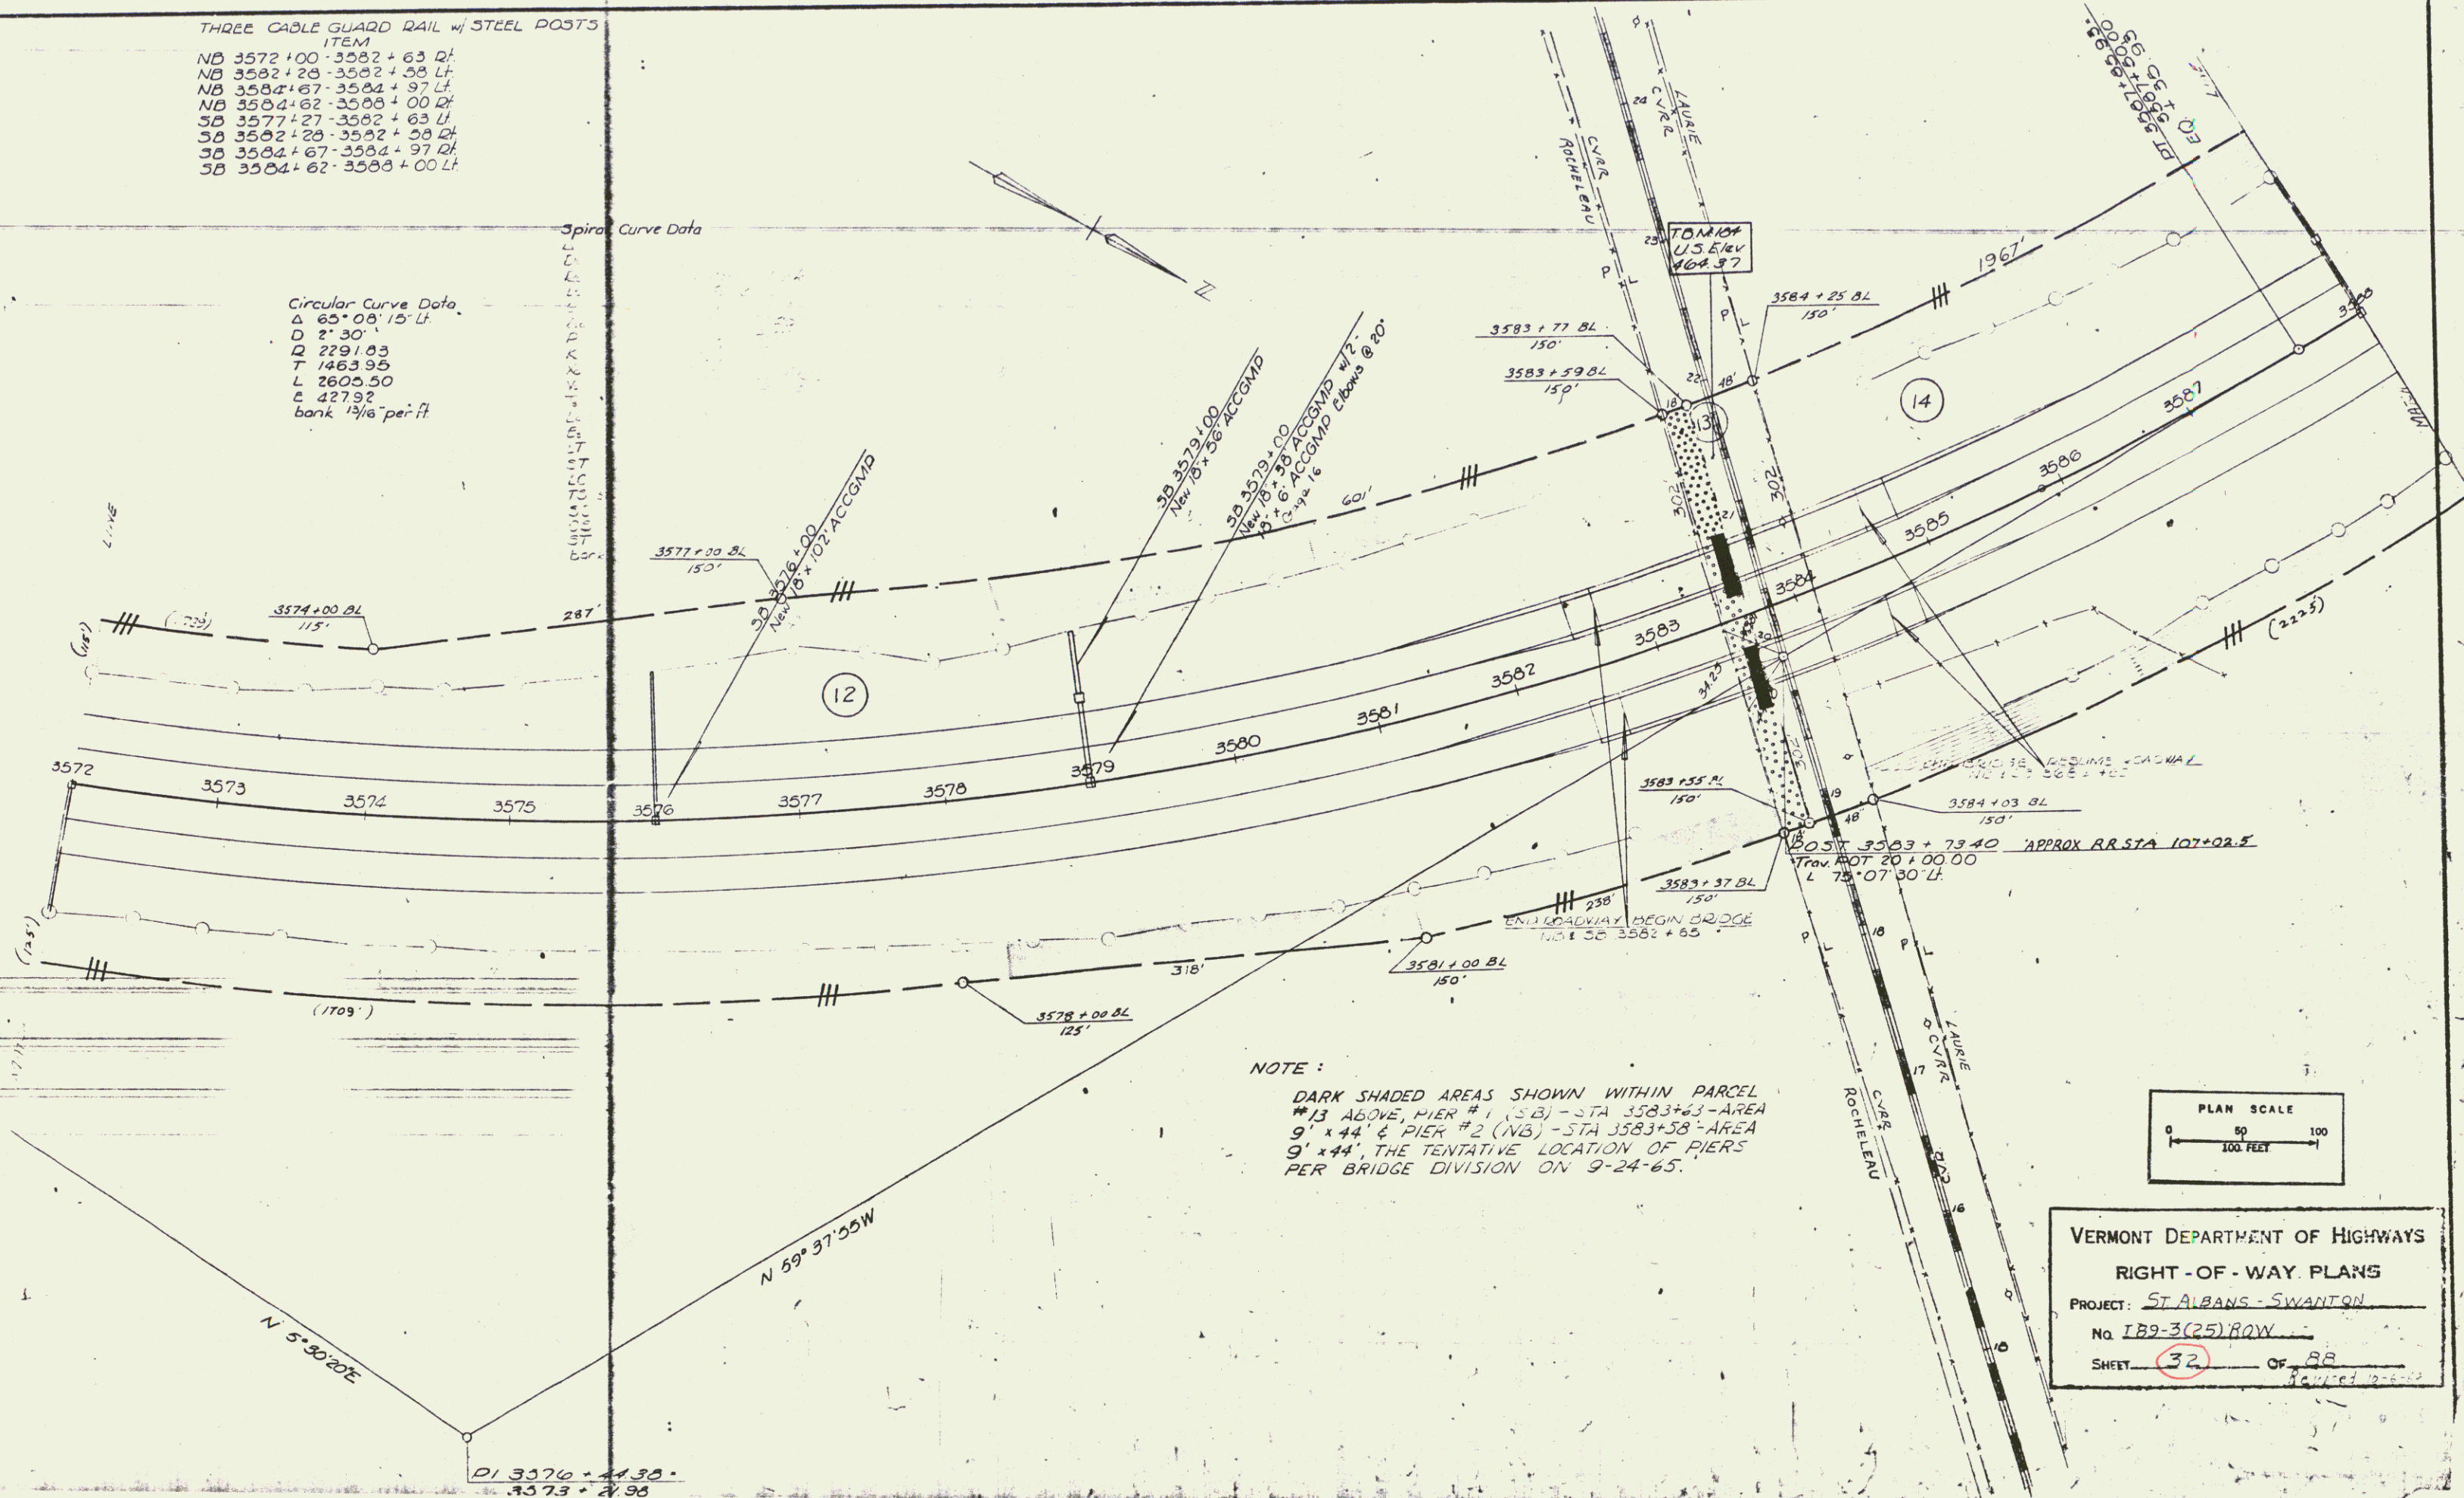


VERMONT DEPARTMENT OF HIGHWAYS
 RIGHT-OF-WAY PLANS
 PROJECT: ST. ALBANS - SWANTON
 No. 189-3(25) ROW
 SHEET 32 OF 88
 DATED 10-6-65

PLAN	DATE	BY	CHKD
ST. ALBANS - SWANTON	10/1/54	W. H. HARRIS	W. H. HARRIS
NO. 189-3425 ROW			

THREE CABLE GUARD RAIL
W/ STEEL POSTS, ITEM
N.D. 3588+00-3602+14.2
S.D. 3588+00-3603+10.6

DID RAP FOR BANK PROTECTION
MOD FOR CULVERT ENDS
N.D. 3604+00.2

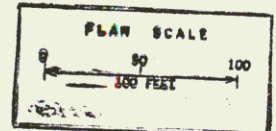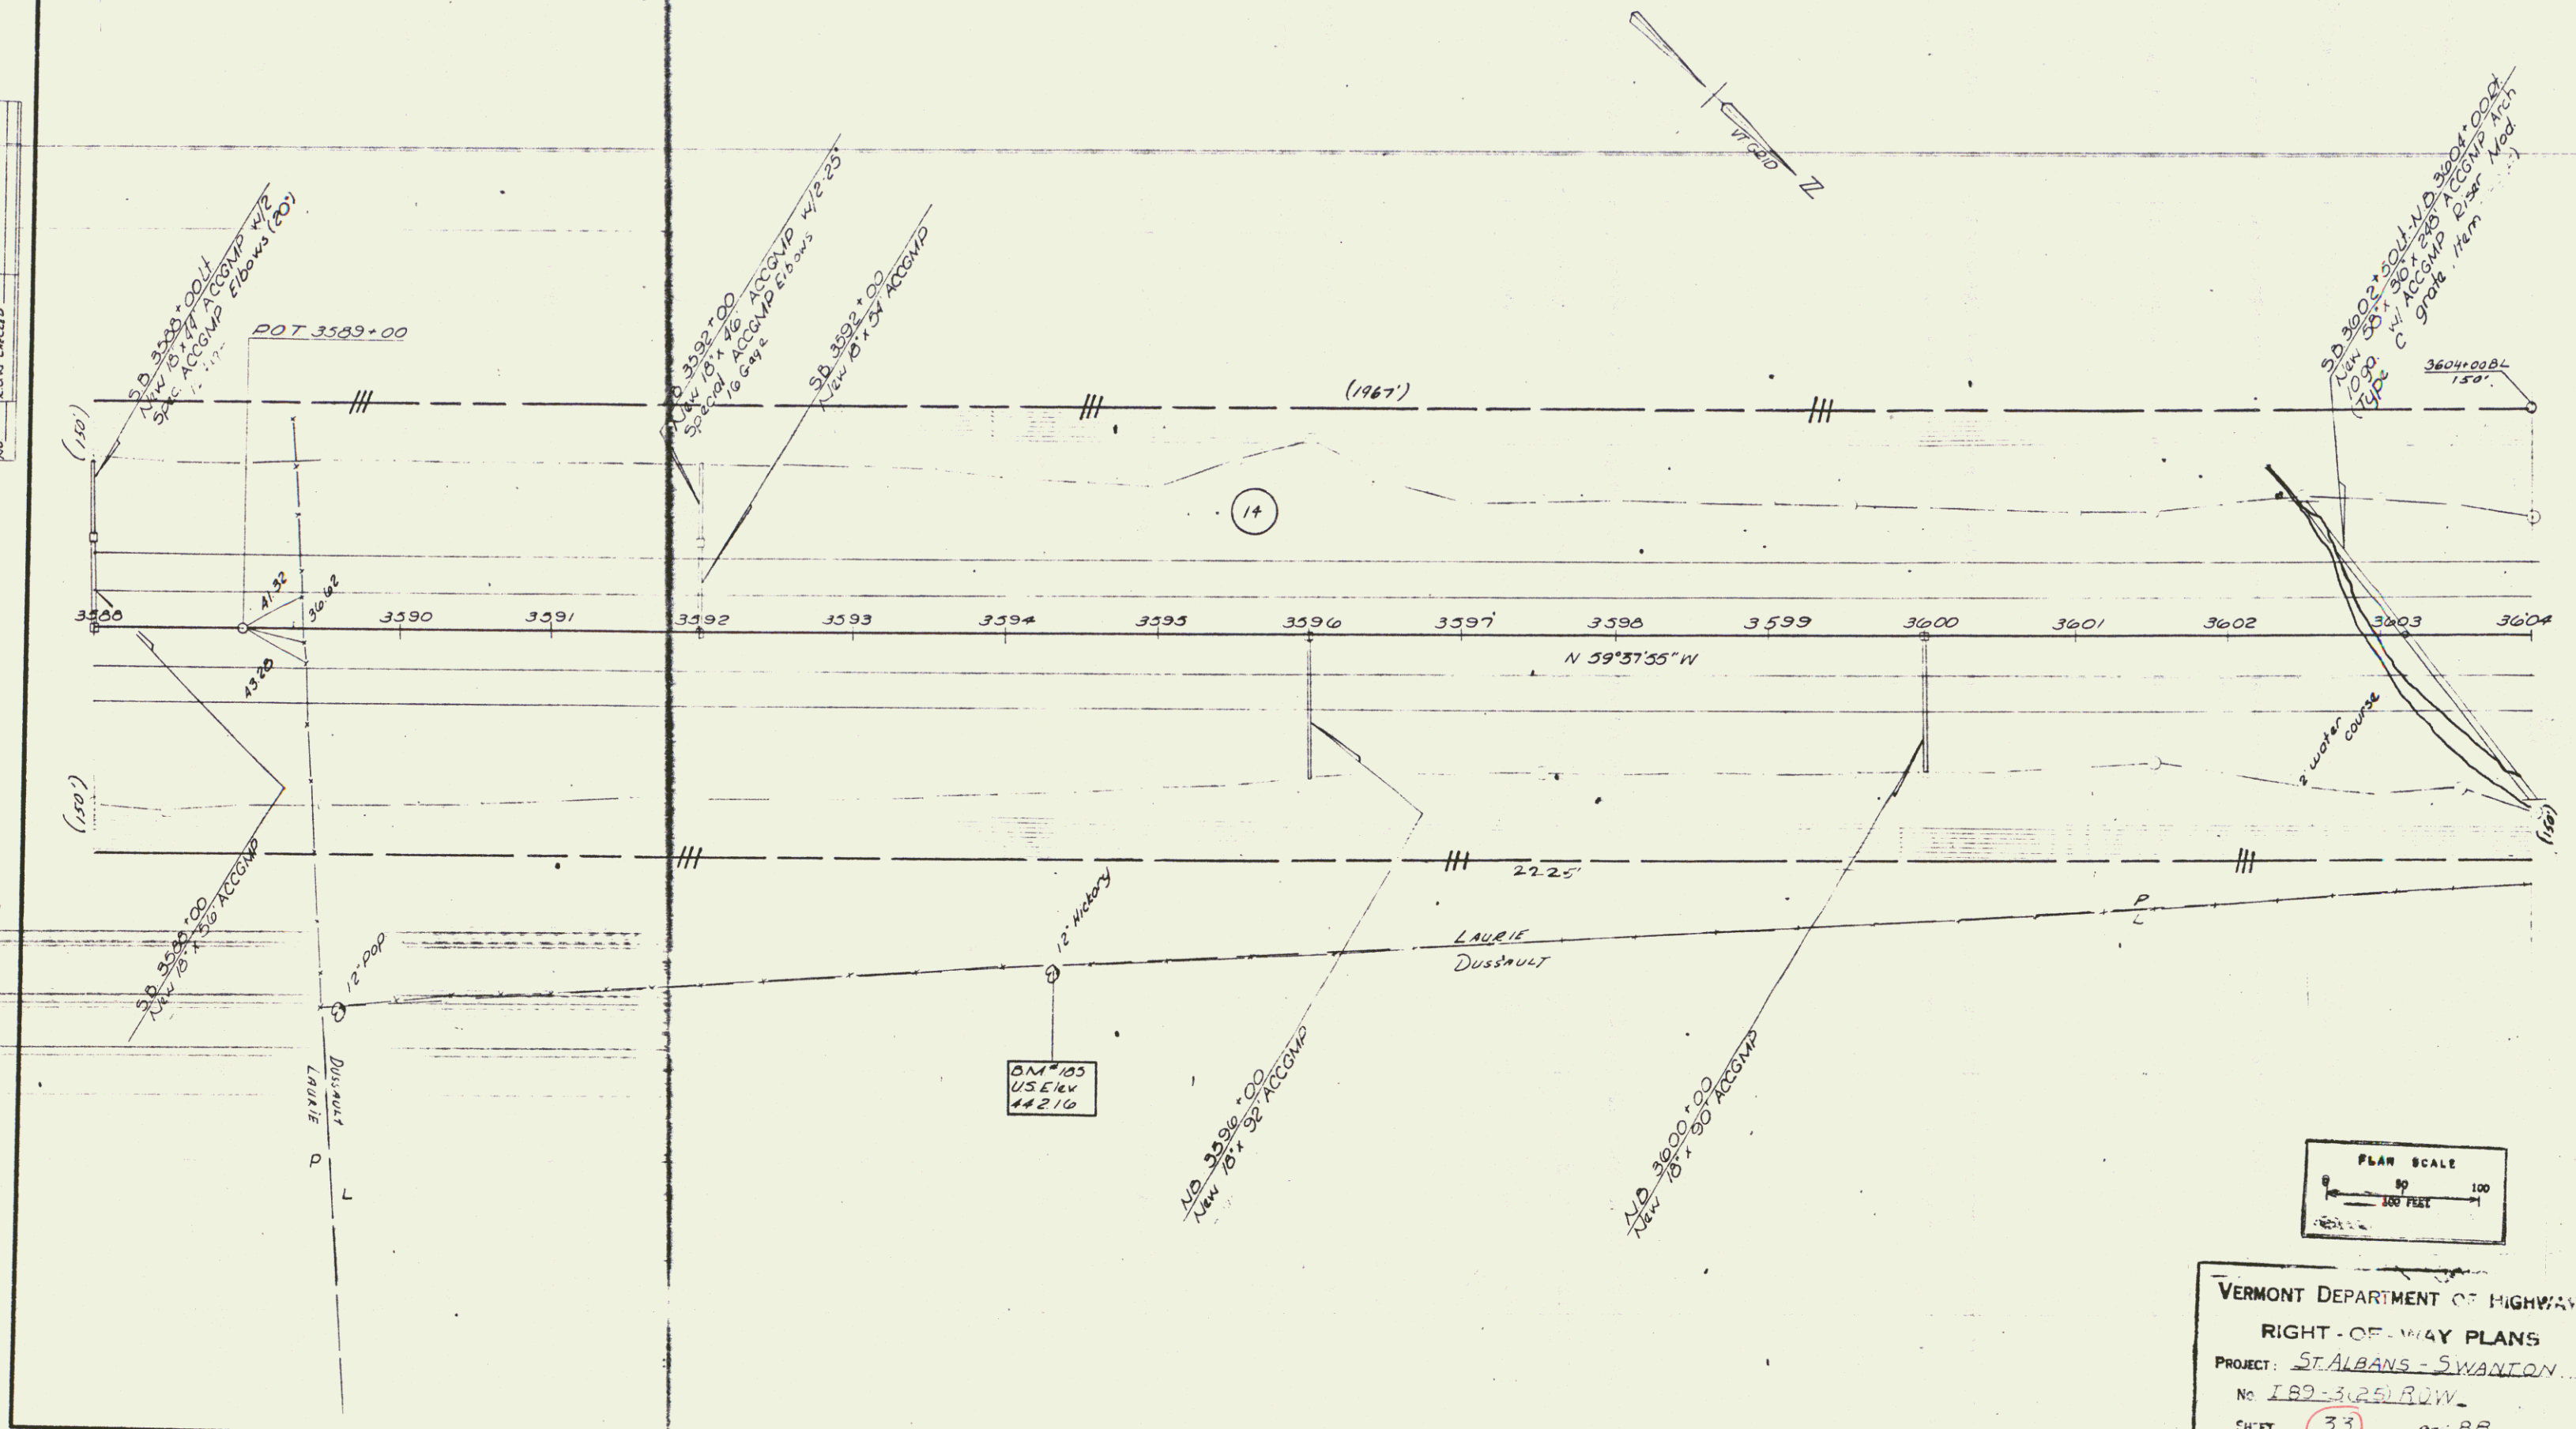



VERMONT DEPARTMENT OF HIGHWAYS
RIGHT-OF-WAY PLANS
PROJECT: ST. ALBANS - SWANTON
No. 189-3425 ROW
SHEET 33 OF 88

PLAN	36019	36020	36021
APPROVED	36019	36020	36021
REVISION	36019	36020	36021
NO.	36019	36020	36021

DIP RAP FOR BANK PROTECTION
MOD FOR CULVERT ENDS
S.D. 3619 + 90 L.F.

THRE CABLE GUARD RAIL
W/ STEEL POSTS. ITEM
S.D. 3614 + 44 L.F. - S.D. 3620 + 00 L.F.
N.D. 3614 + 76 L.F. - N.D. 3620 + 00 L.F.

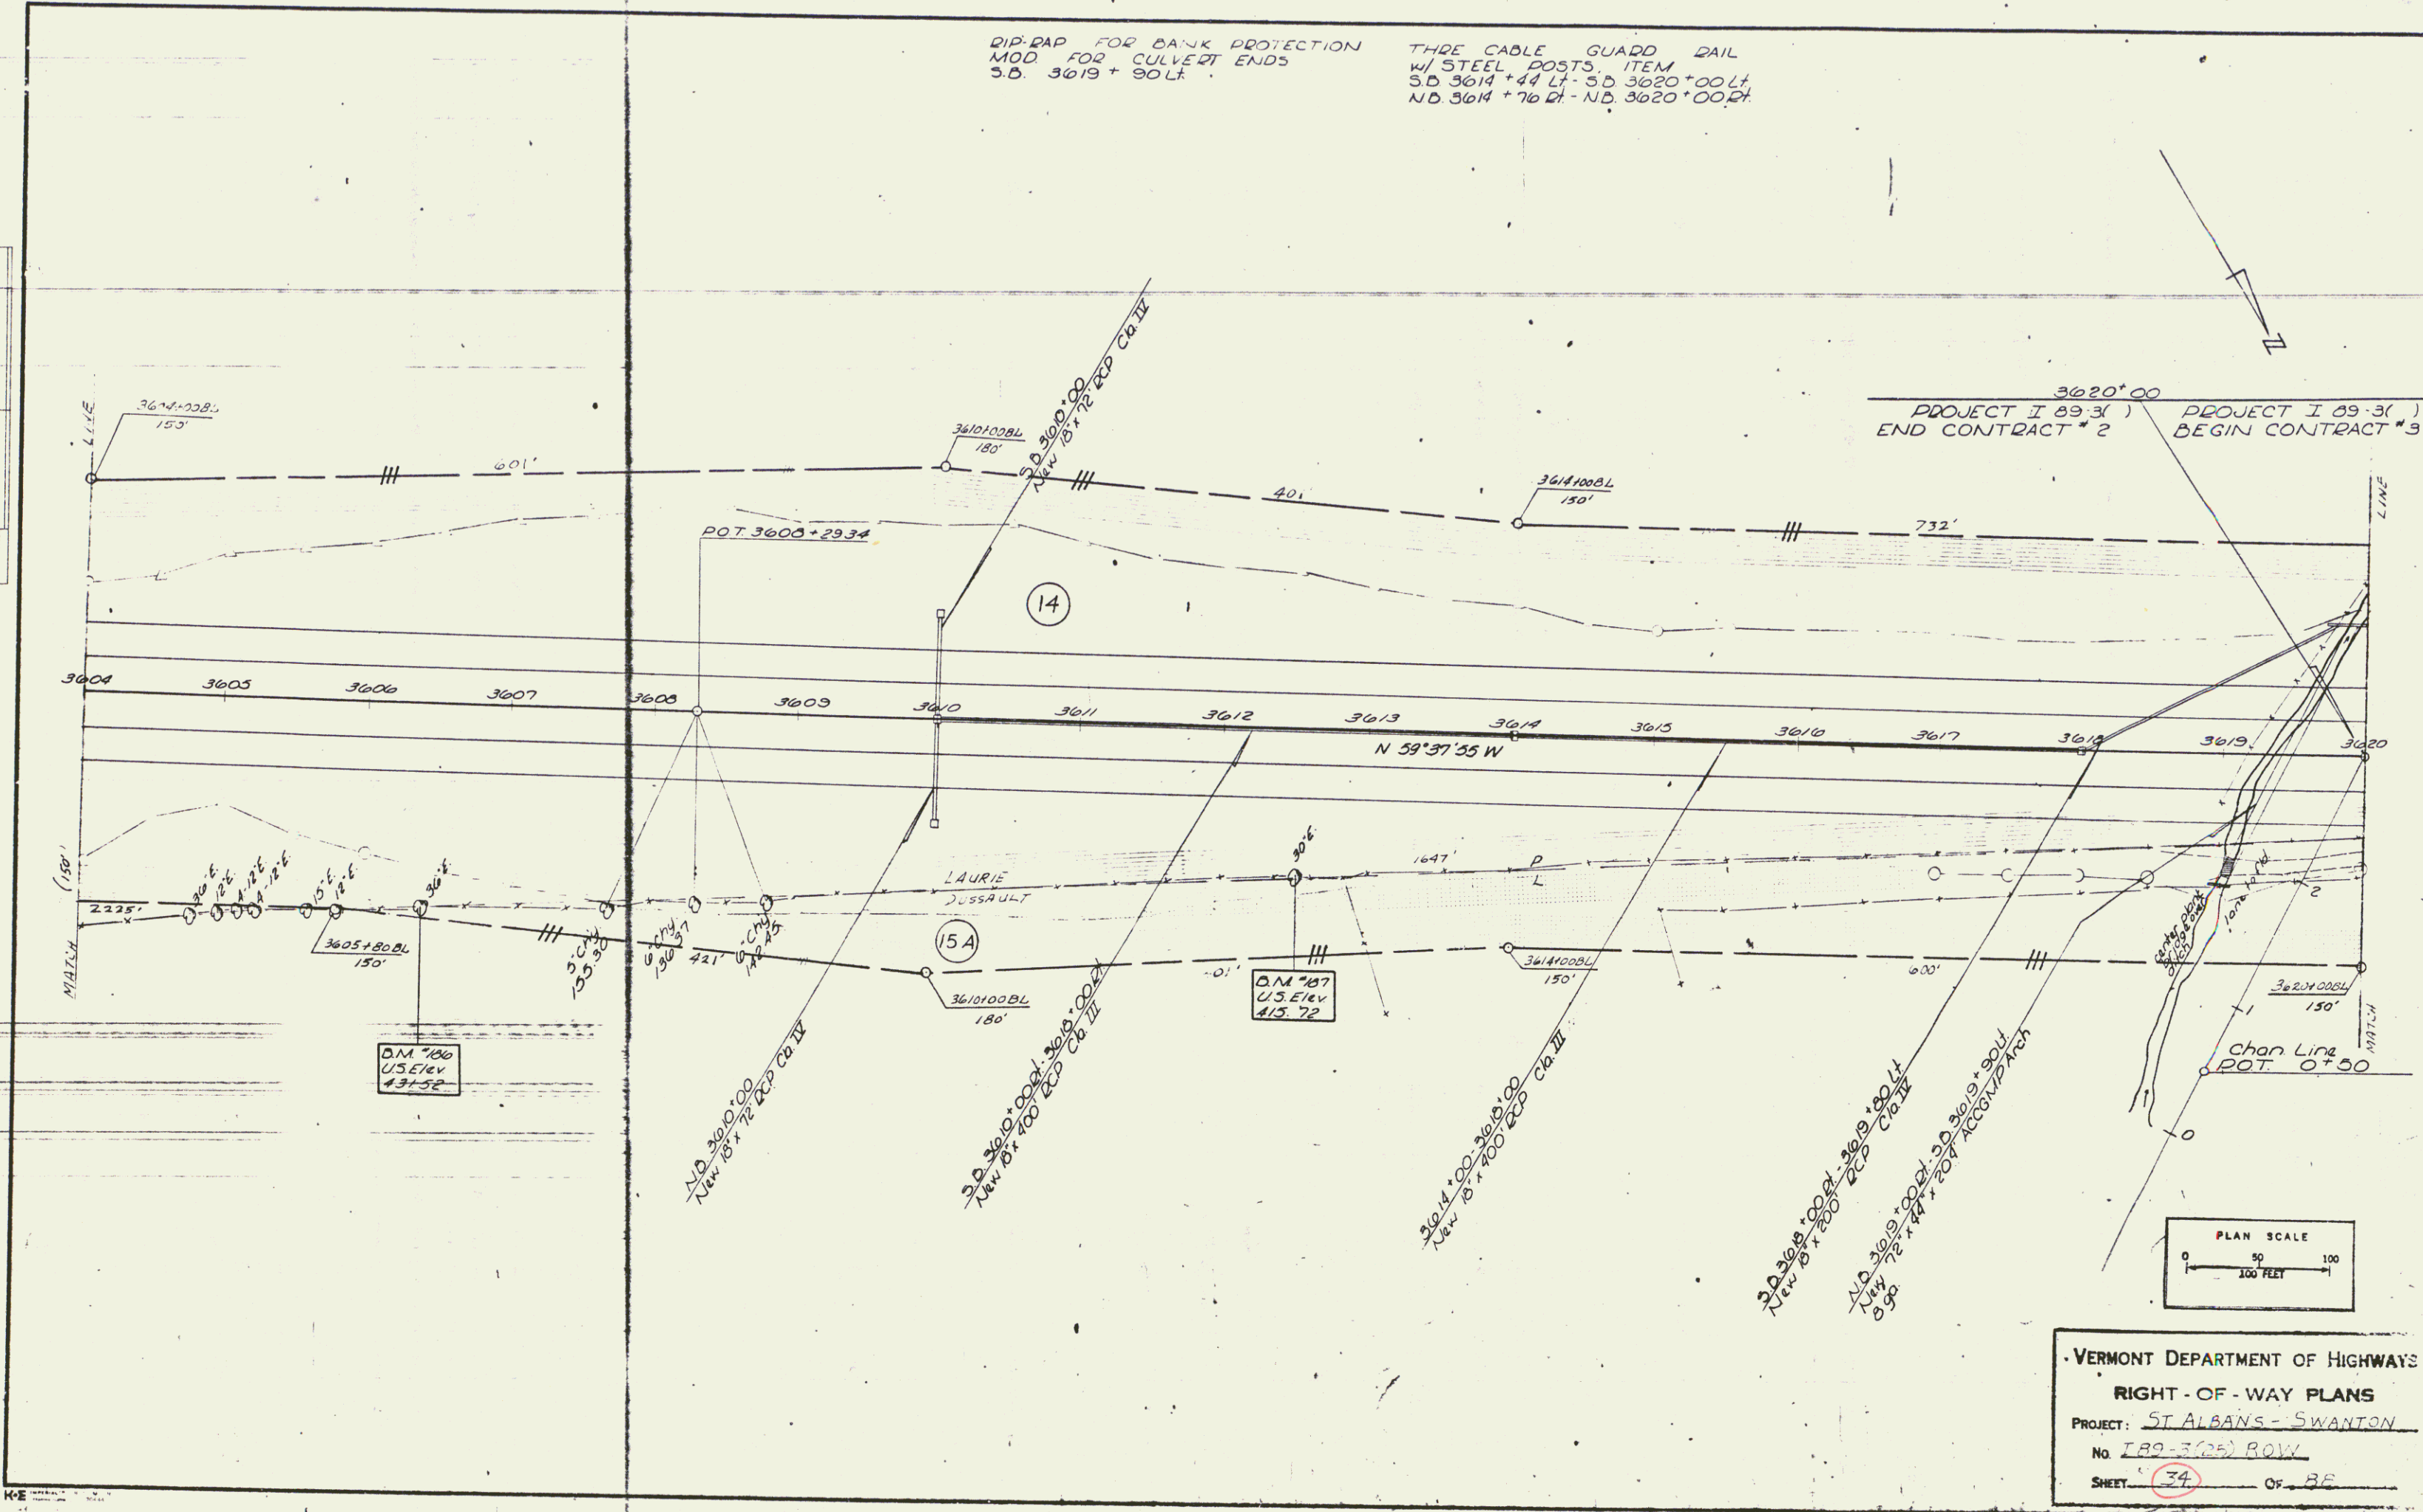

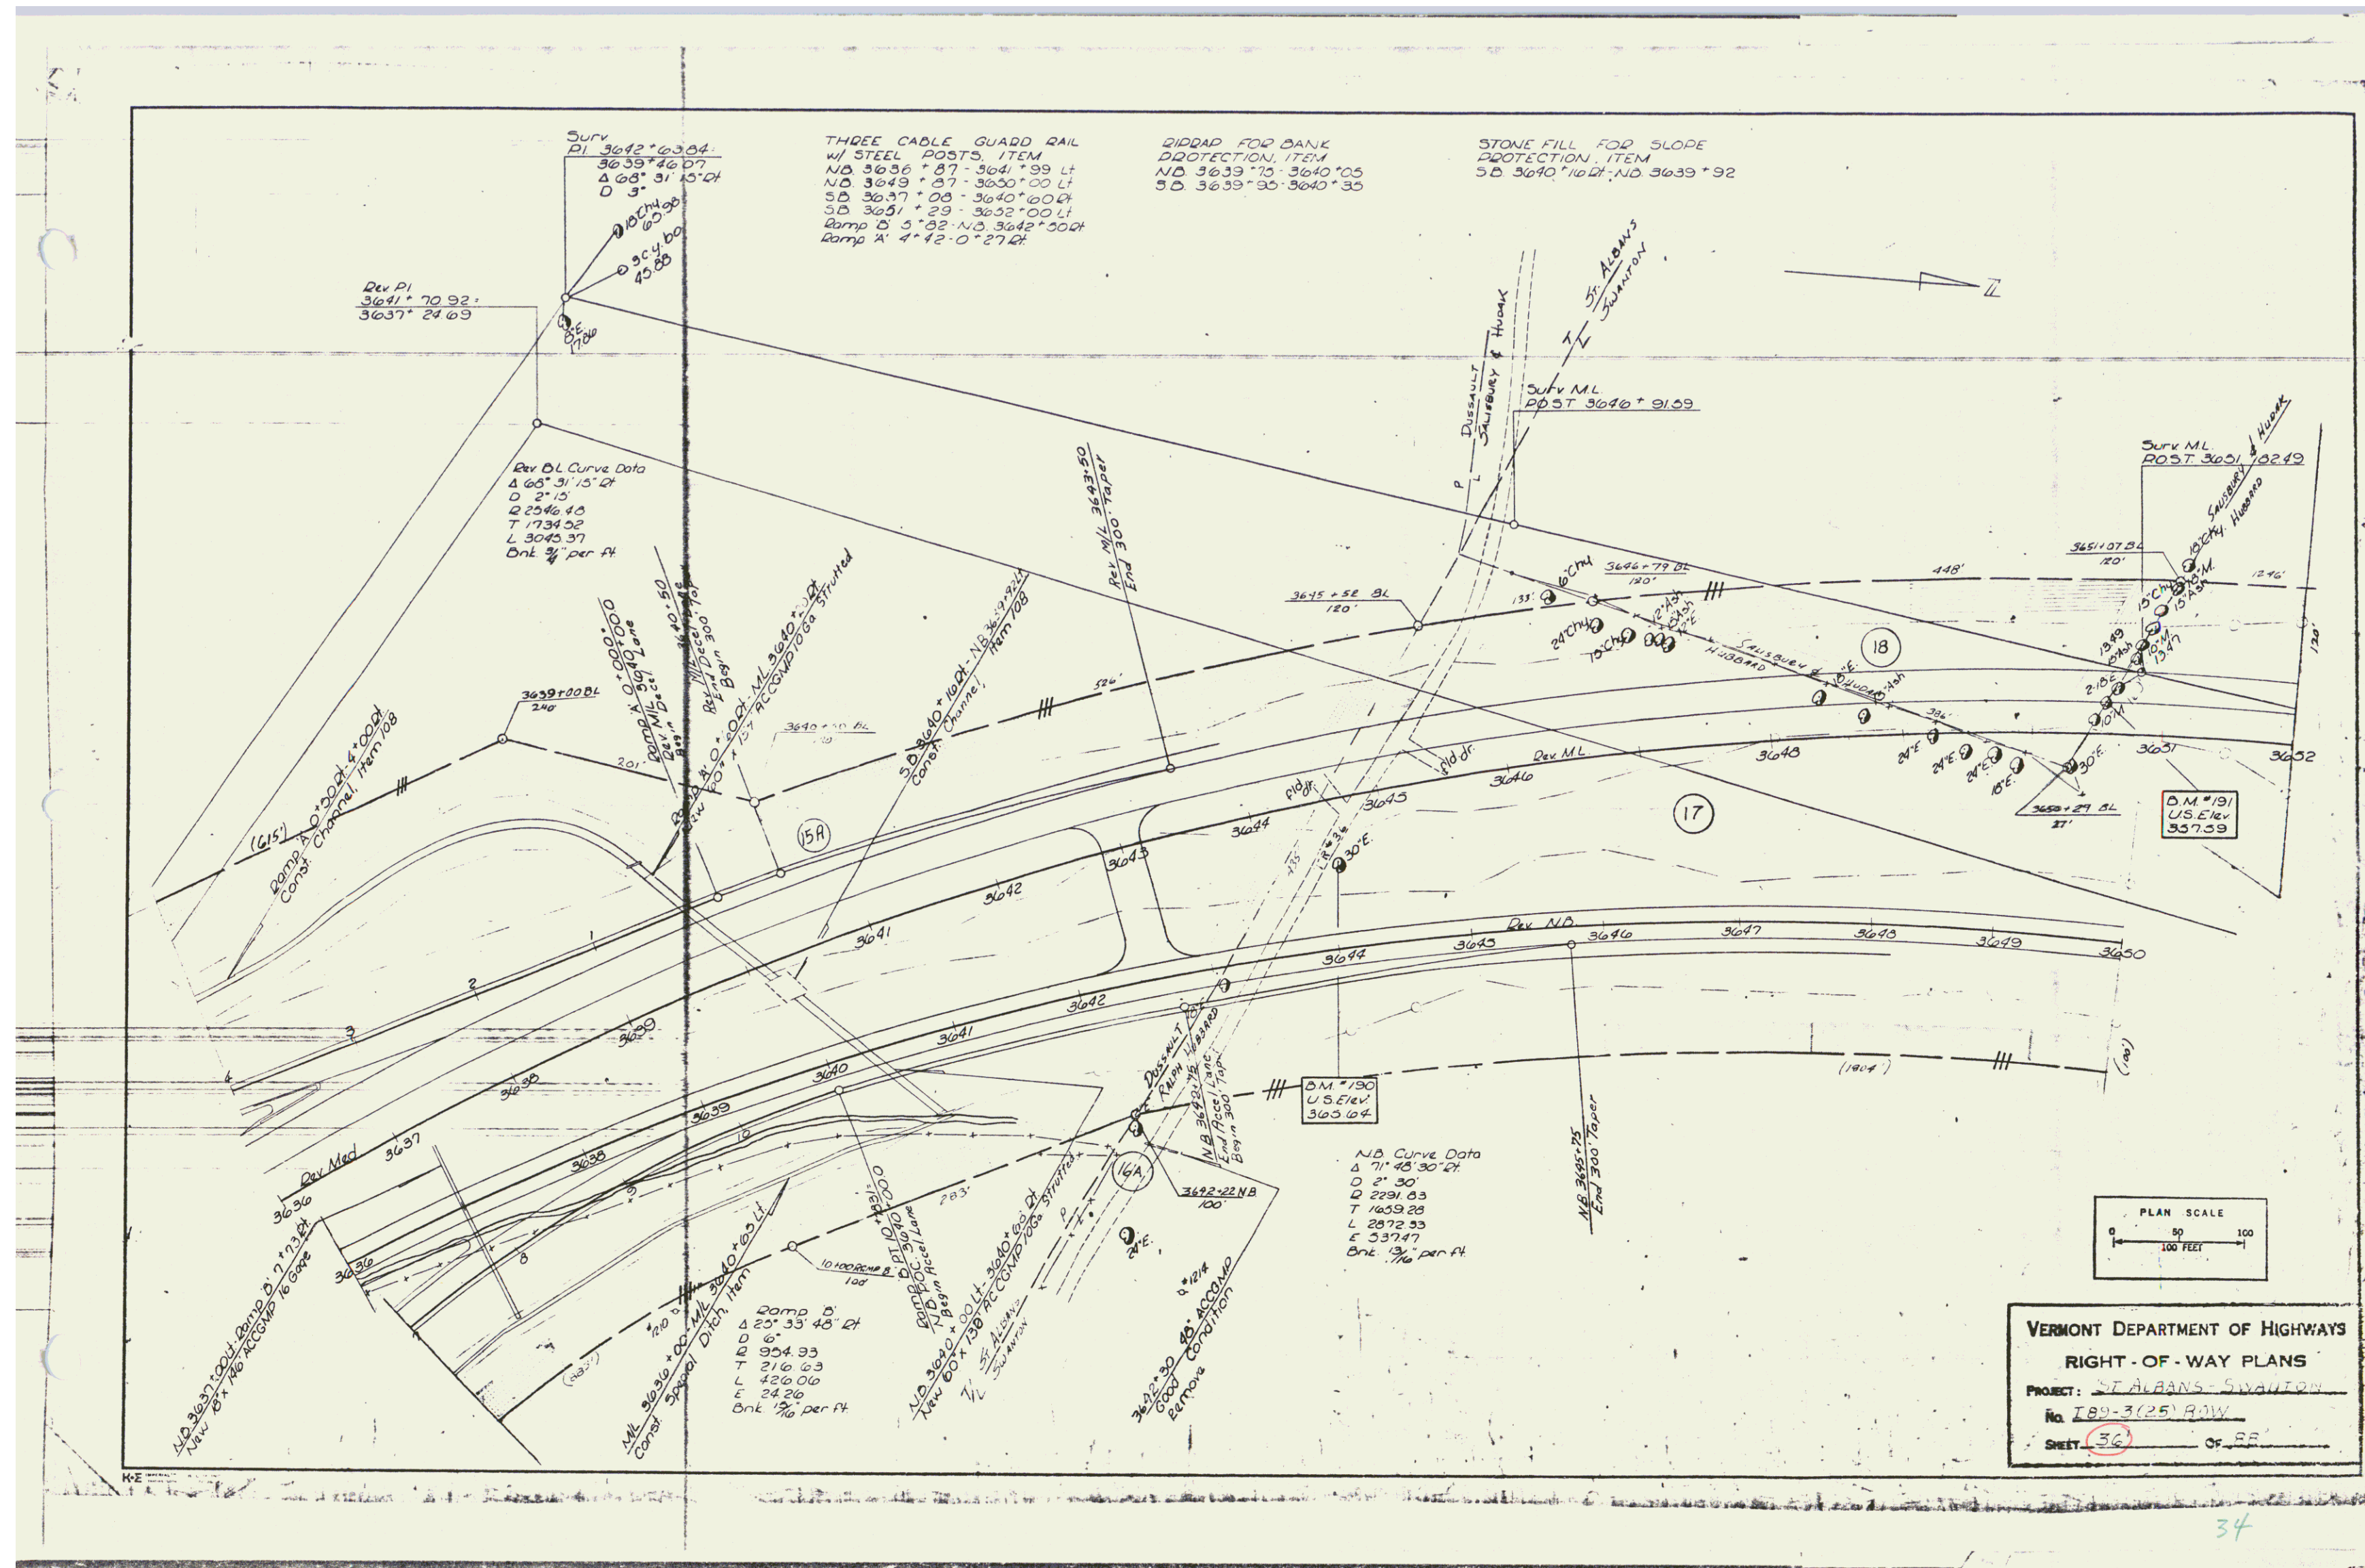


PLAN	SURVEYED	BY	DATE
NOTE BOOK	PLANTED & TRACED	Spaulding	6/13
	ALIGN CHCCECD	Clark	6/23
NO.	ROW CHCCECD		


THREE CABLE GUARD RAIL
W/STEEL POSTS, ITEM
SD 3651 * 29LT - 3653 * 05 LT
NB 3641 LT - 3651 * 03 LT
NB 3650 * 3601 - 3651 * 04 LT
SD 3652 * 00LT - 3653 * LT


MUCK EXCAVATION
2' GRANULAR BORROW
S.D. 3657'50-3659'00

BID RAP FOR BANK PROTECTION
 MOD FOR CULVERT ENDS
 NO. 3630 * 87 Lf
 SB 3631 * 93 Lf

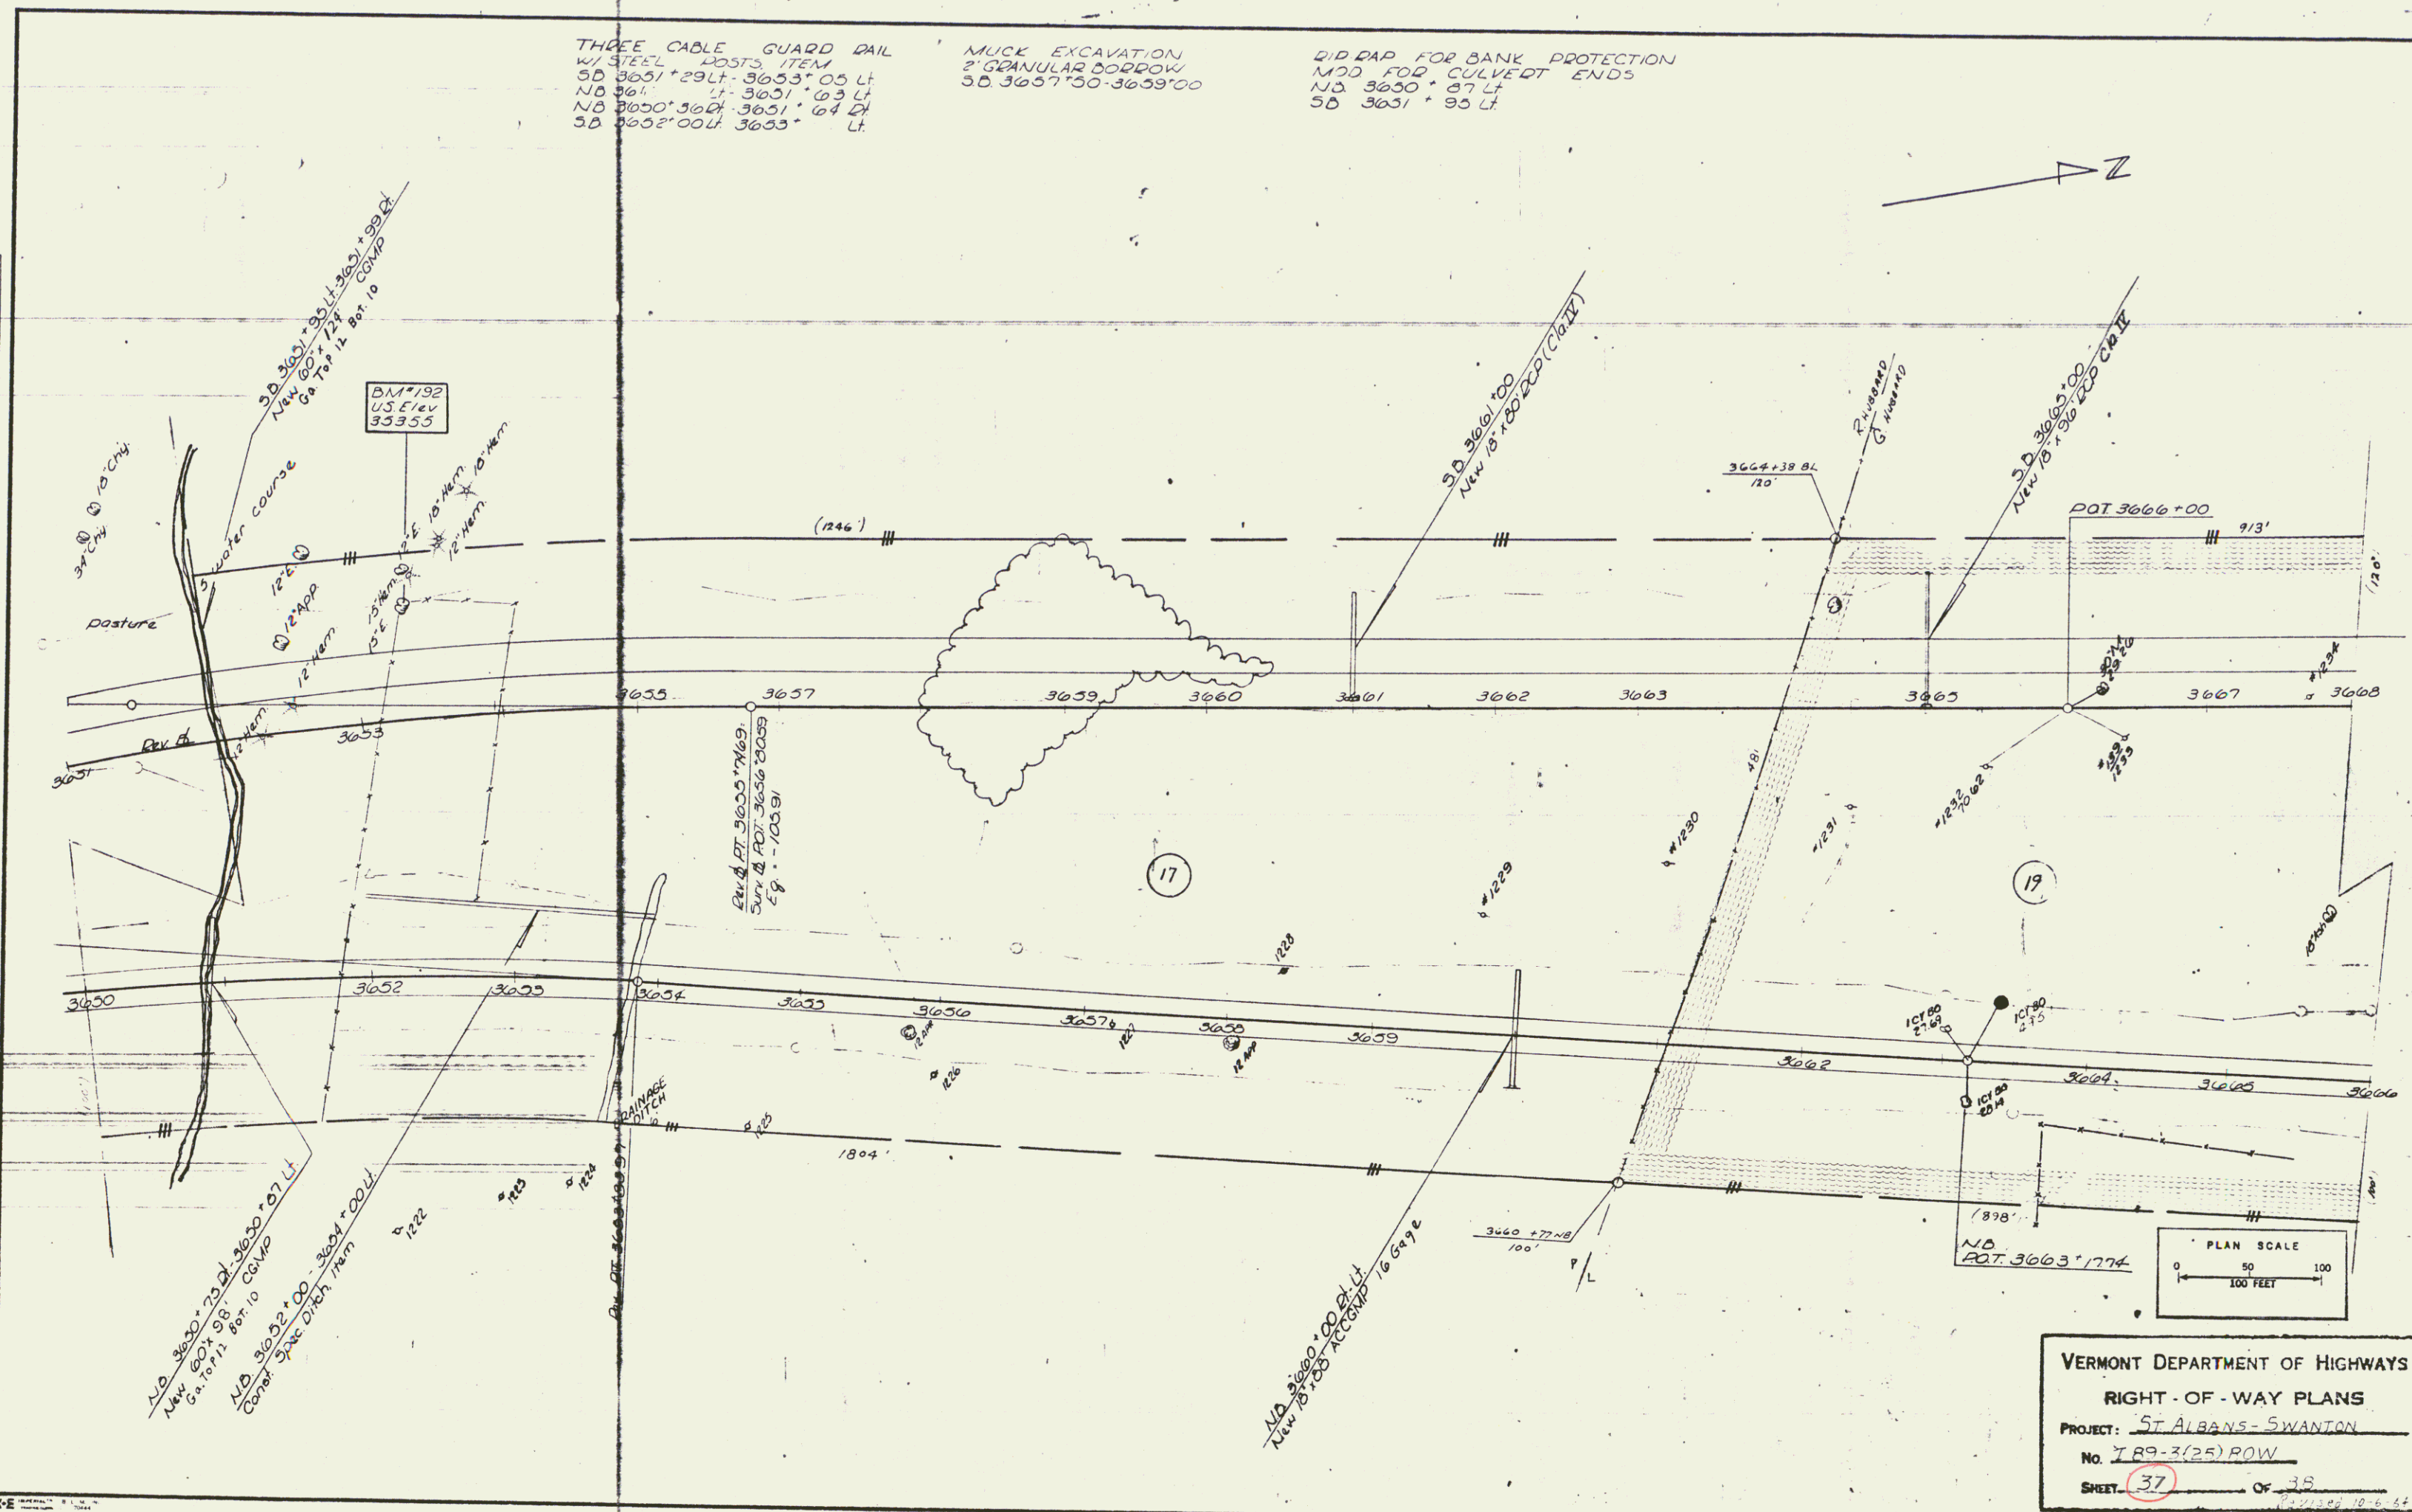


VERMONT DEPARTMENT OF HIGHWAYS
RIGHT-OF-WAY PLANS
PROJECT: ST. ALBANS - SWANTON
NO. T 89-3(25) ROW
SHEET 37 OF 38
Revised 10-6-54

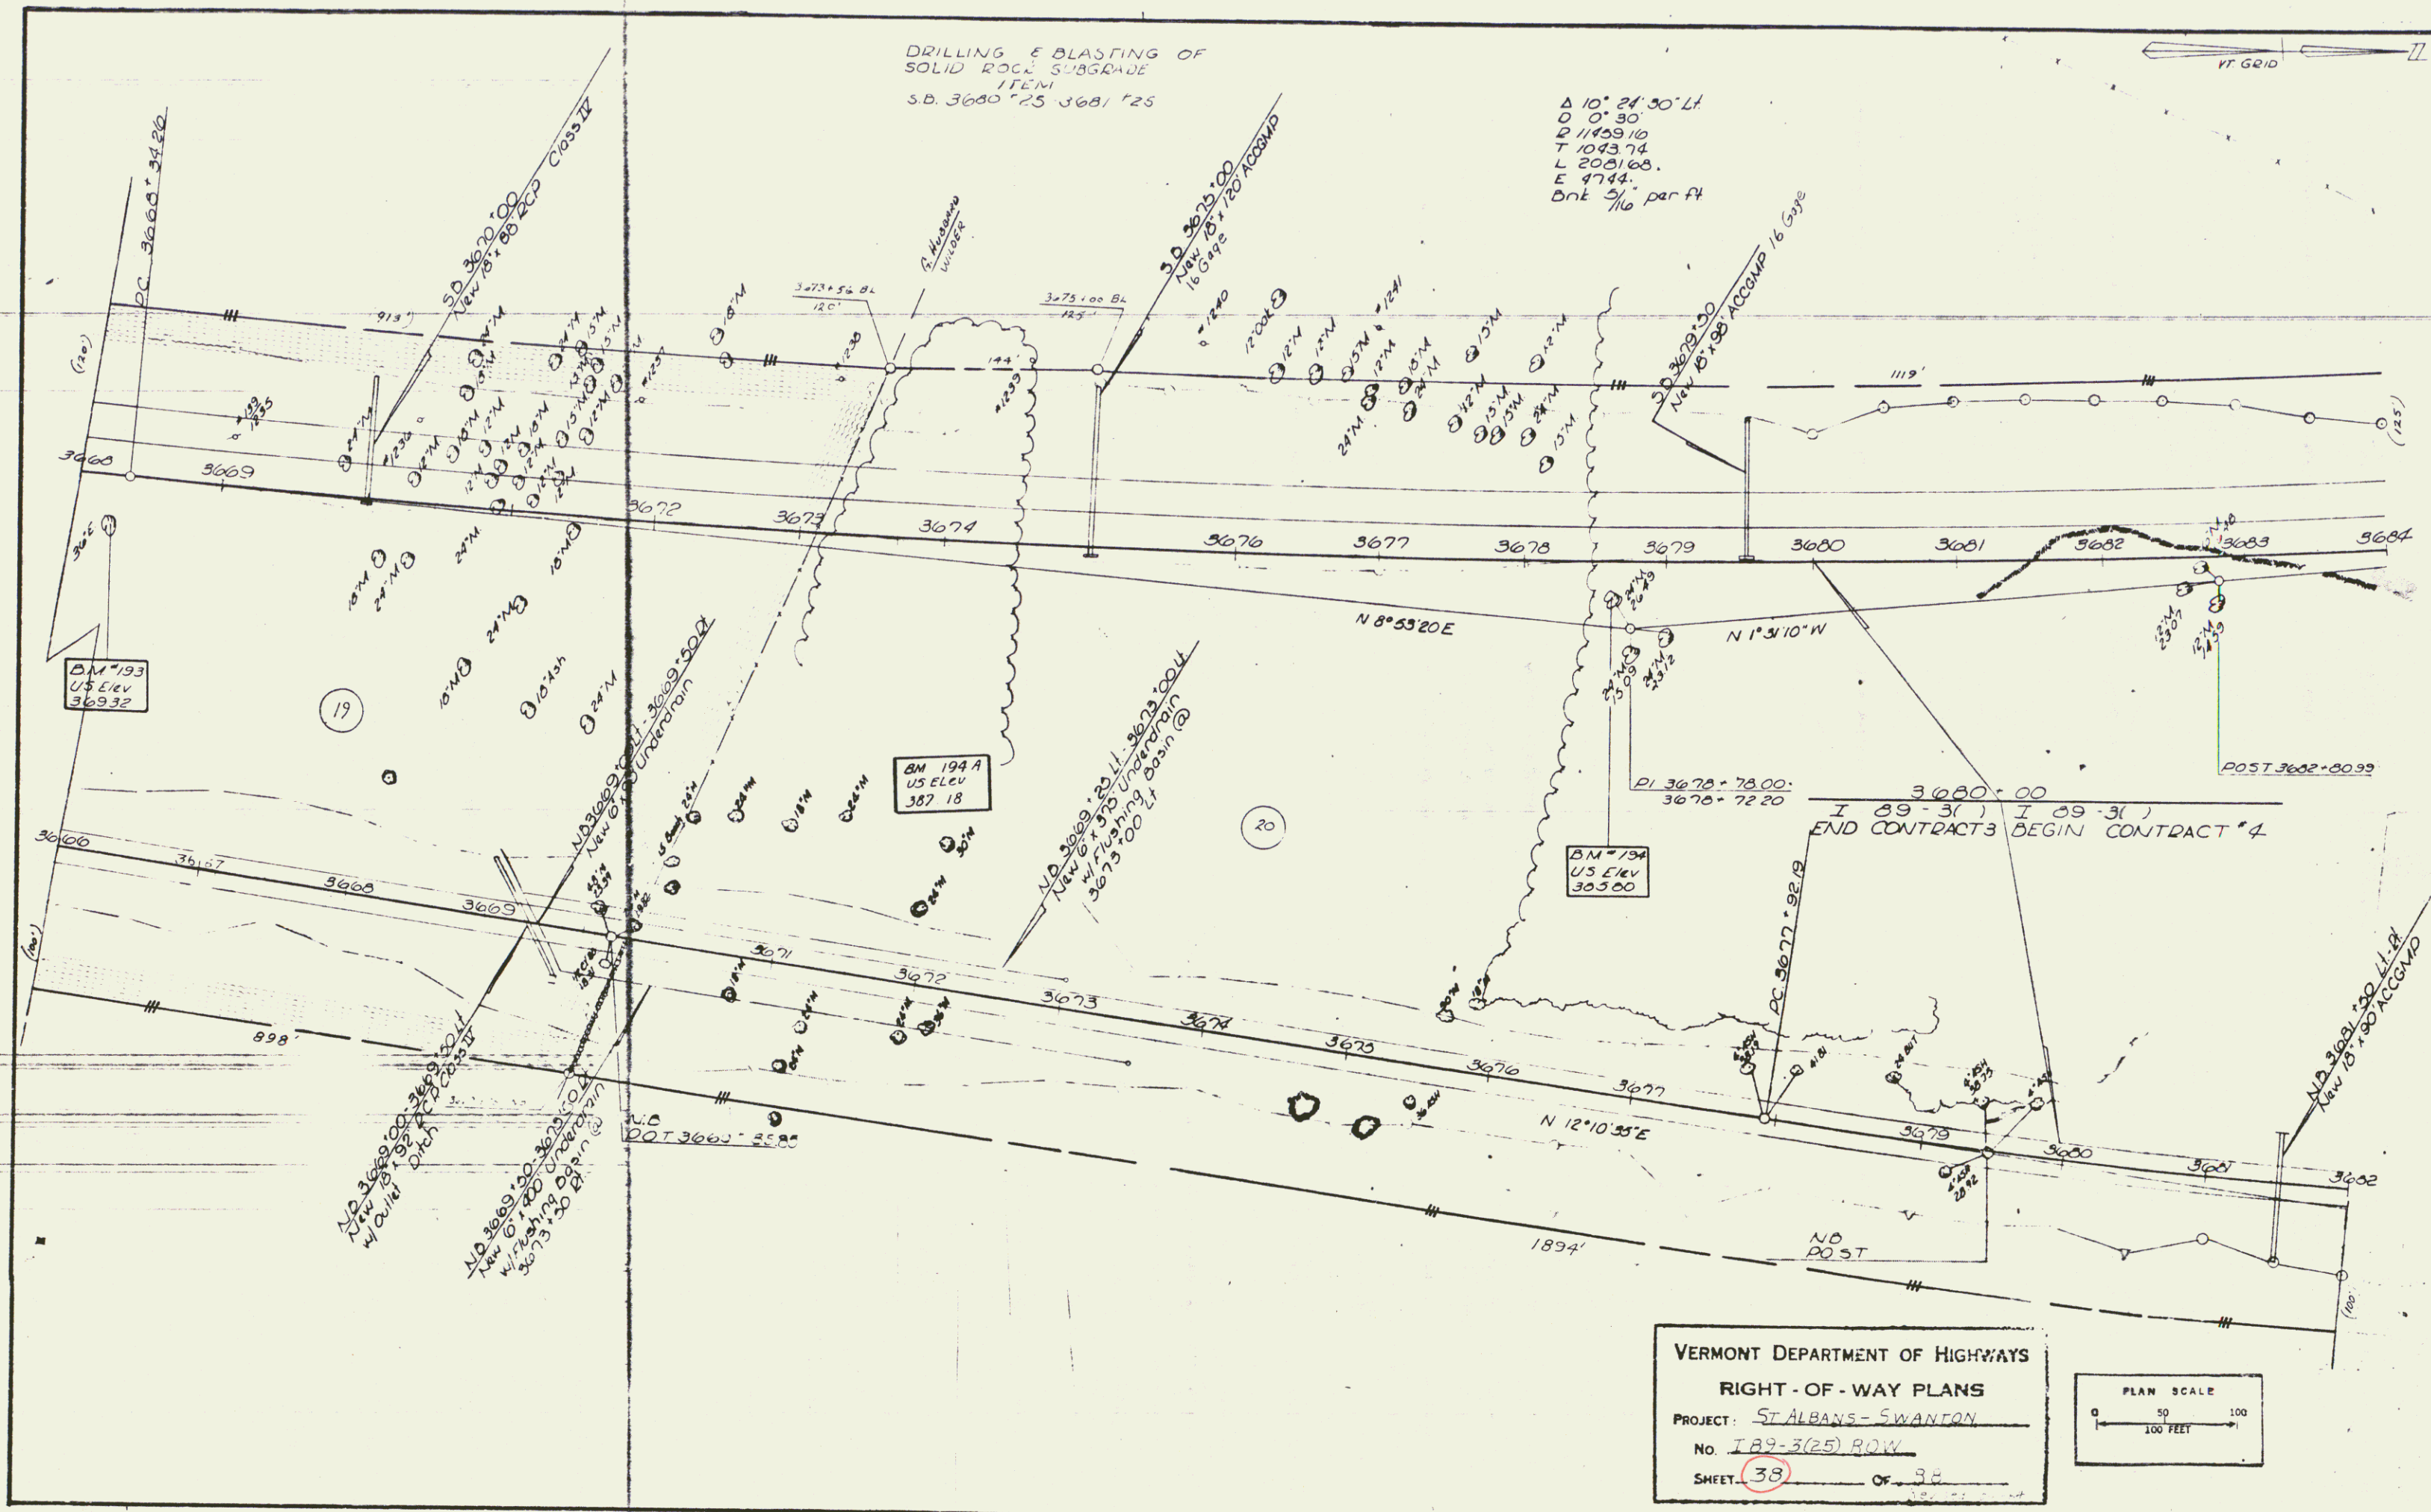

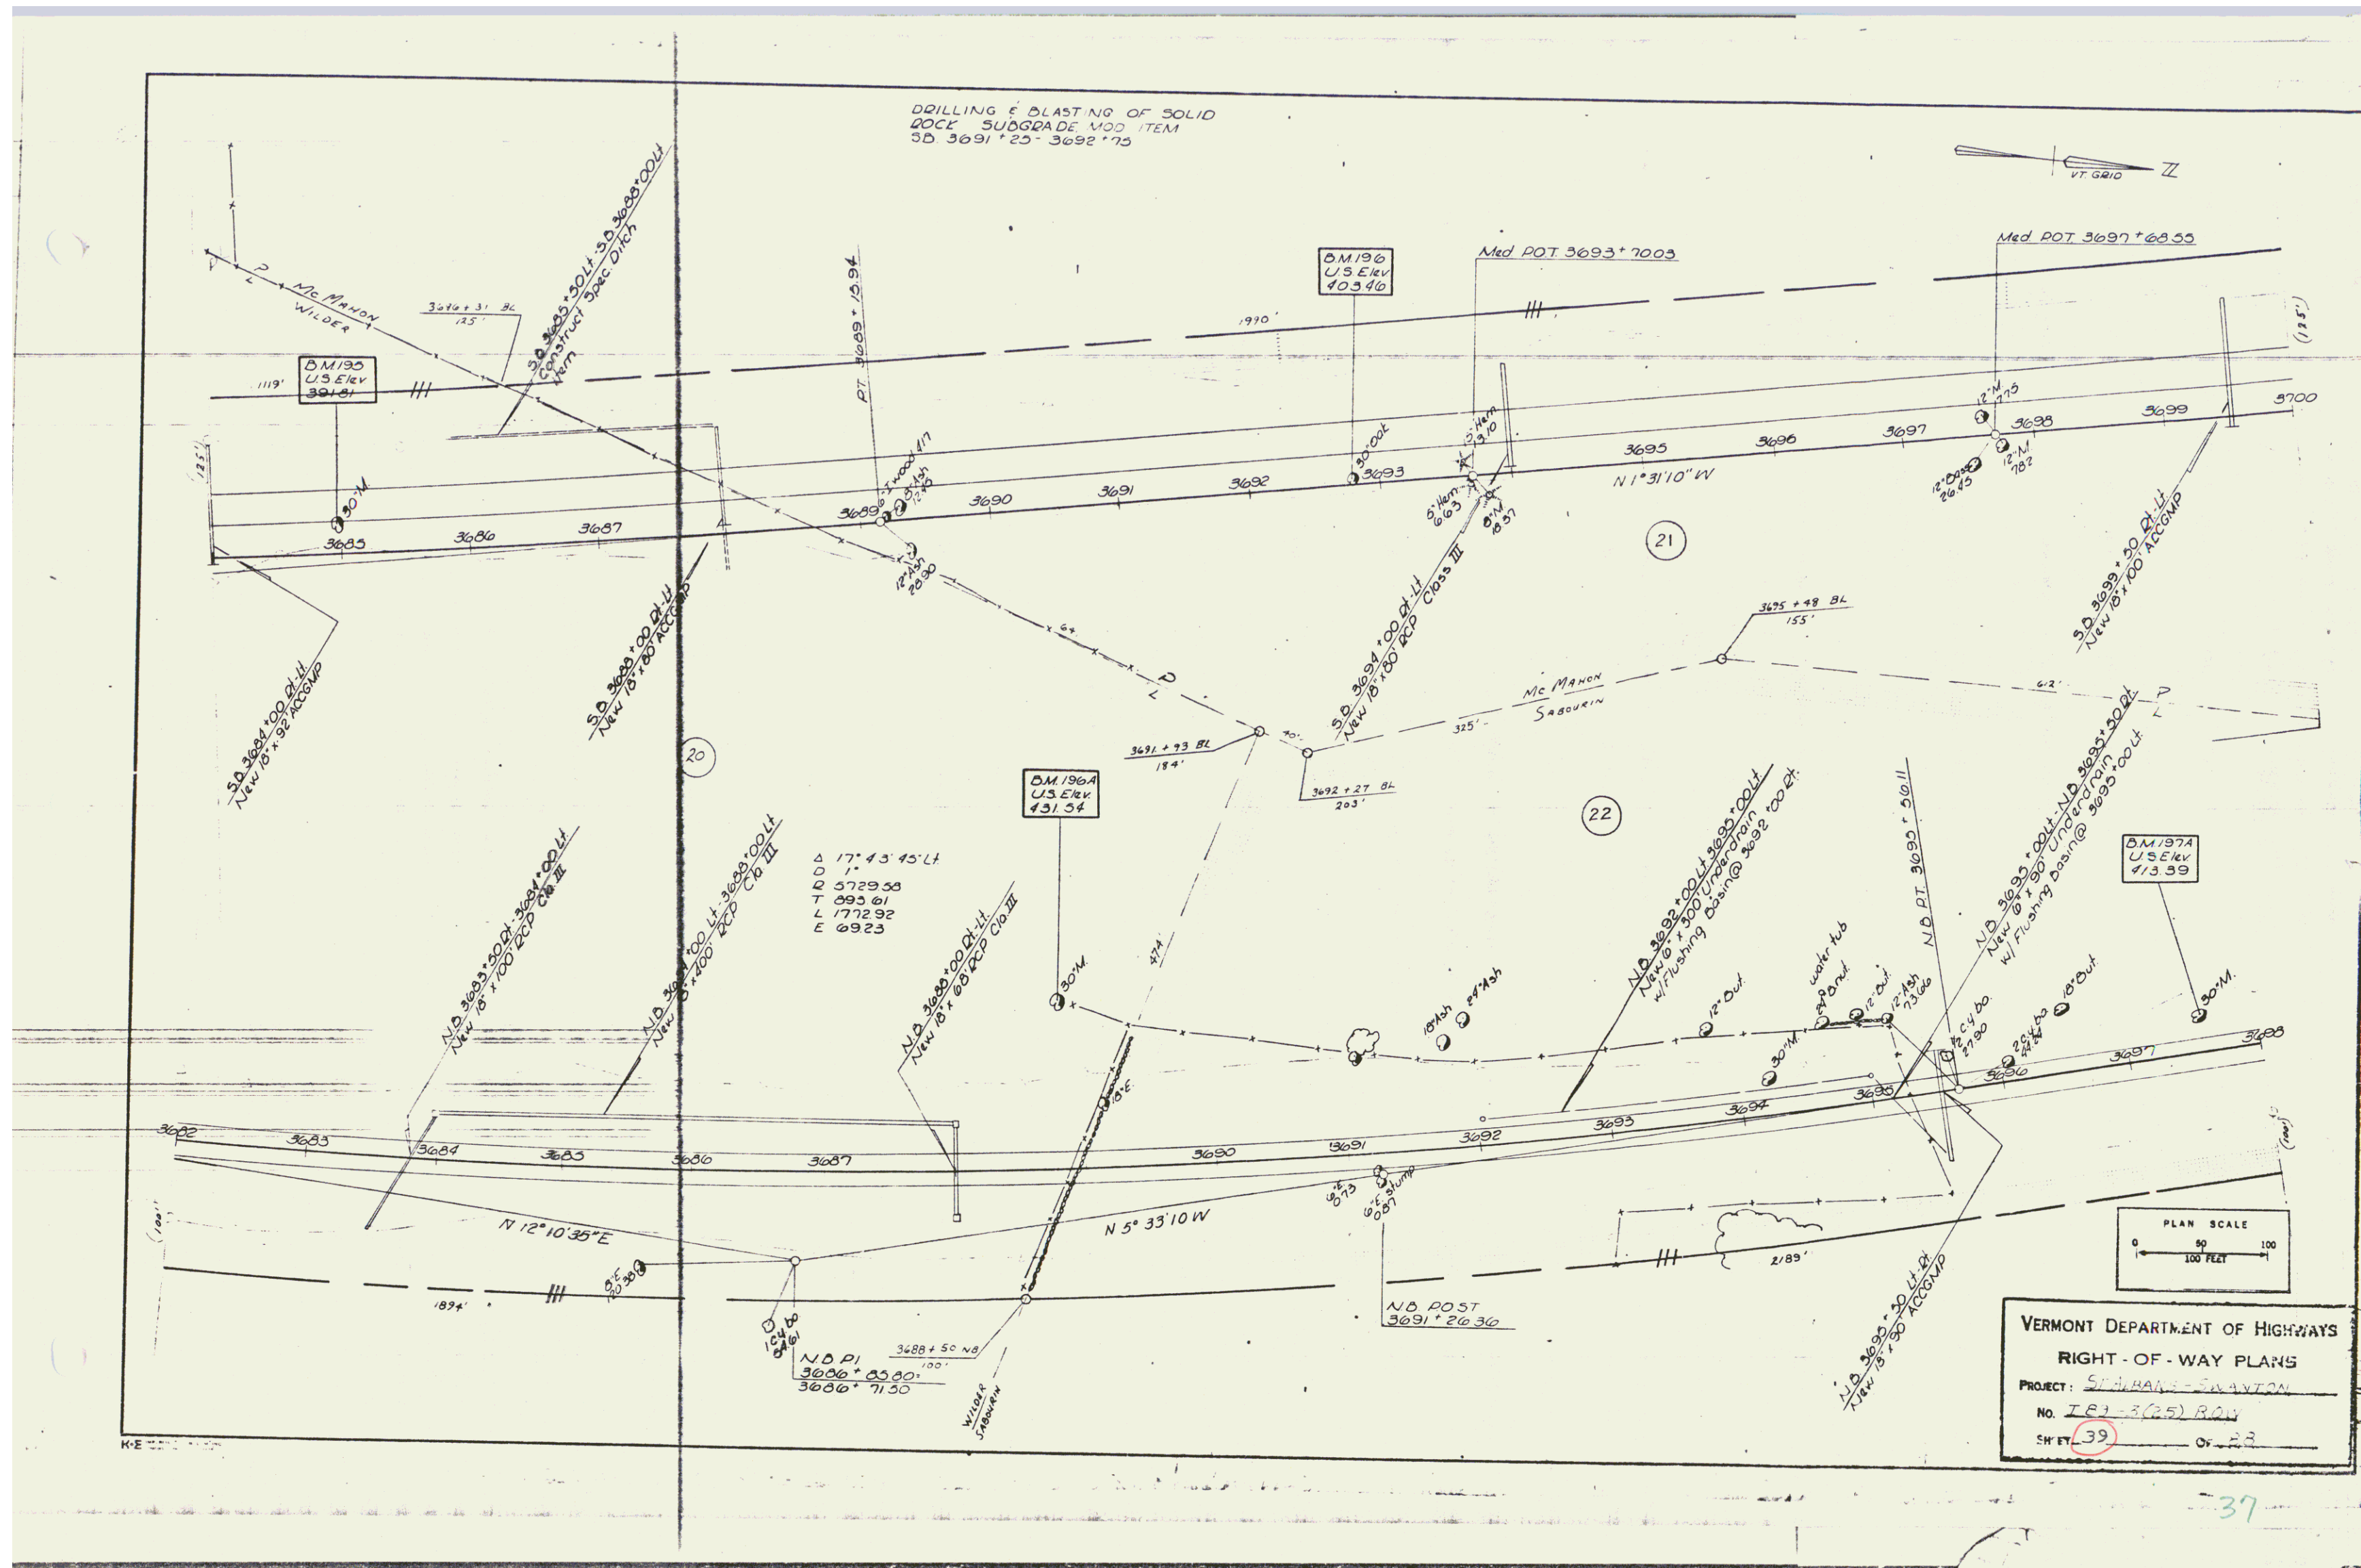


DRILLING & BLASTING OF SOLID
ROCK SUBGRADE, ITEM 114
NB 3699 +75 - 3701 +25
NB 3702 +25 - 3703 +75

MUCK EXCAVATION, ITEM 116
SB 3706 +00 - 3716 +00

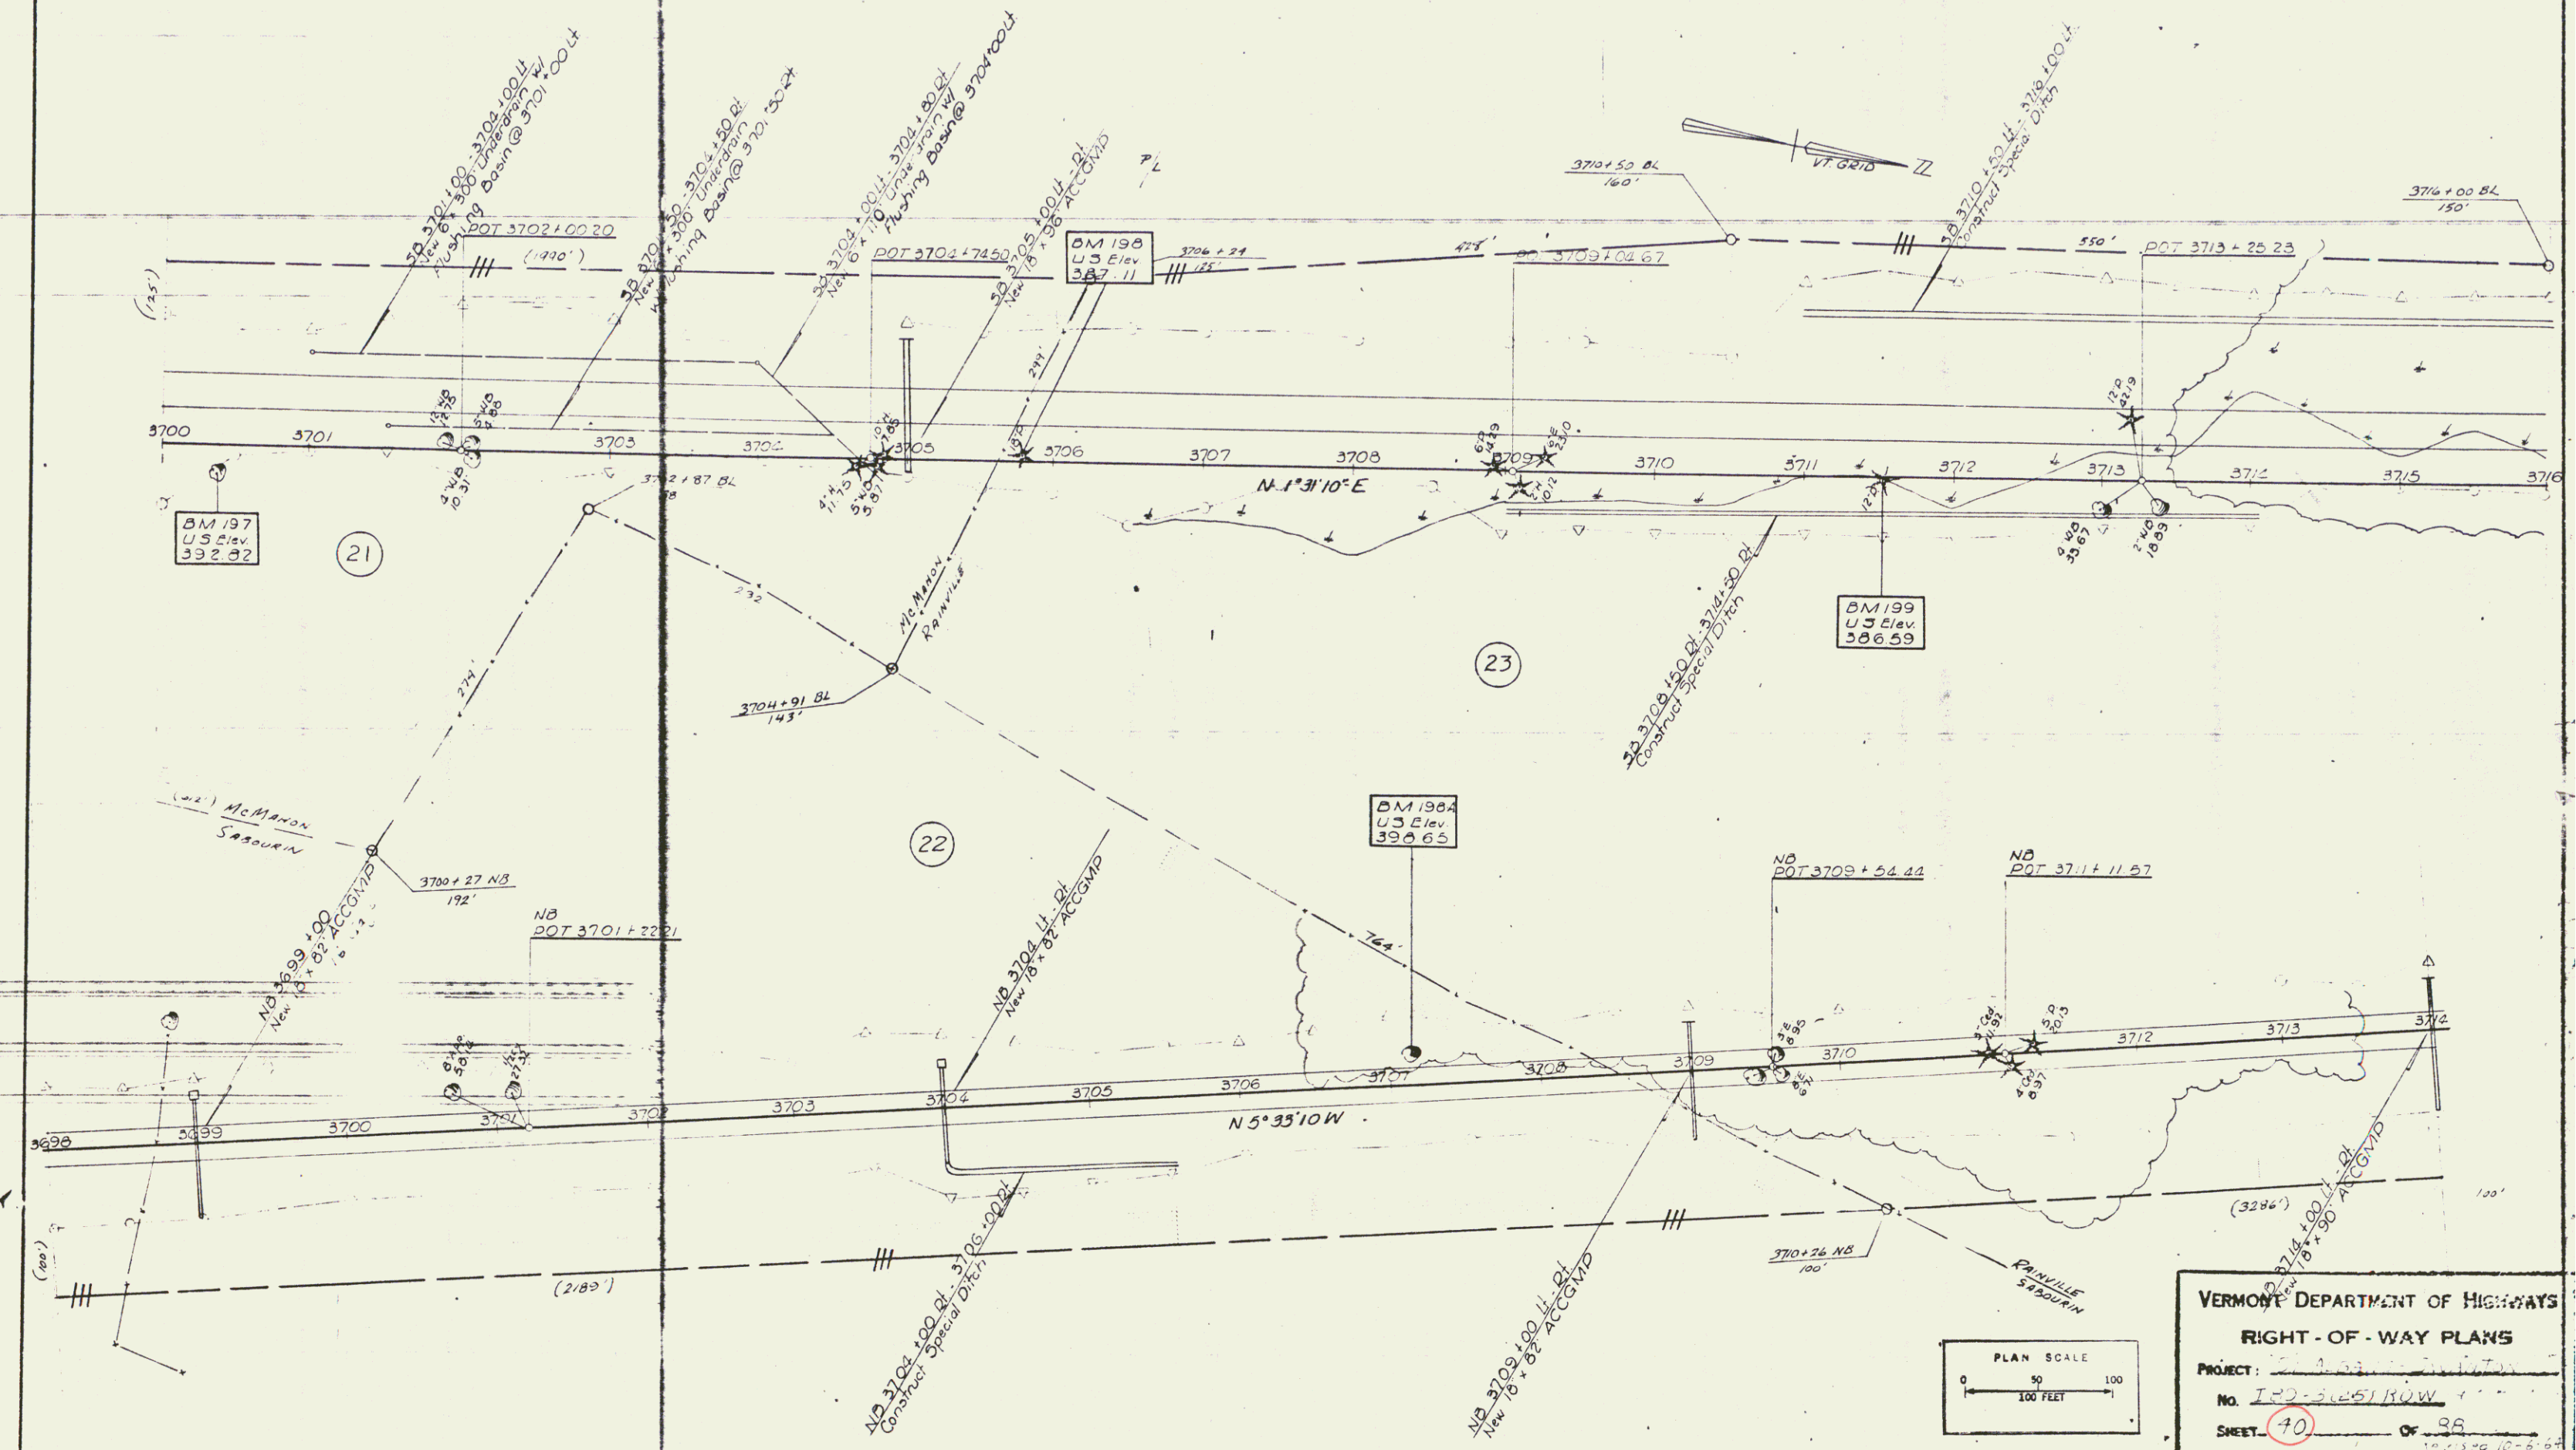

DRILLING & BLASTING OF
SOLID ROCK SUBGRADE, MOD
ITEM
NB 3731 + 25 - 3732 + 75
NB 3734 + 25 - 3742 + 25
SB 3732 + 00 - 3741 + 75

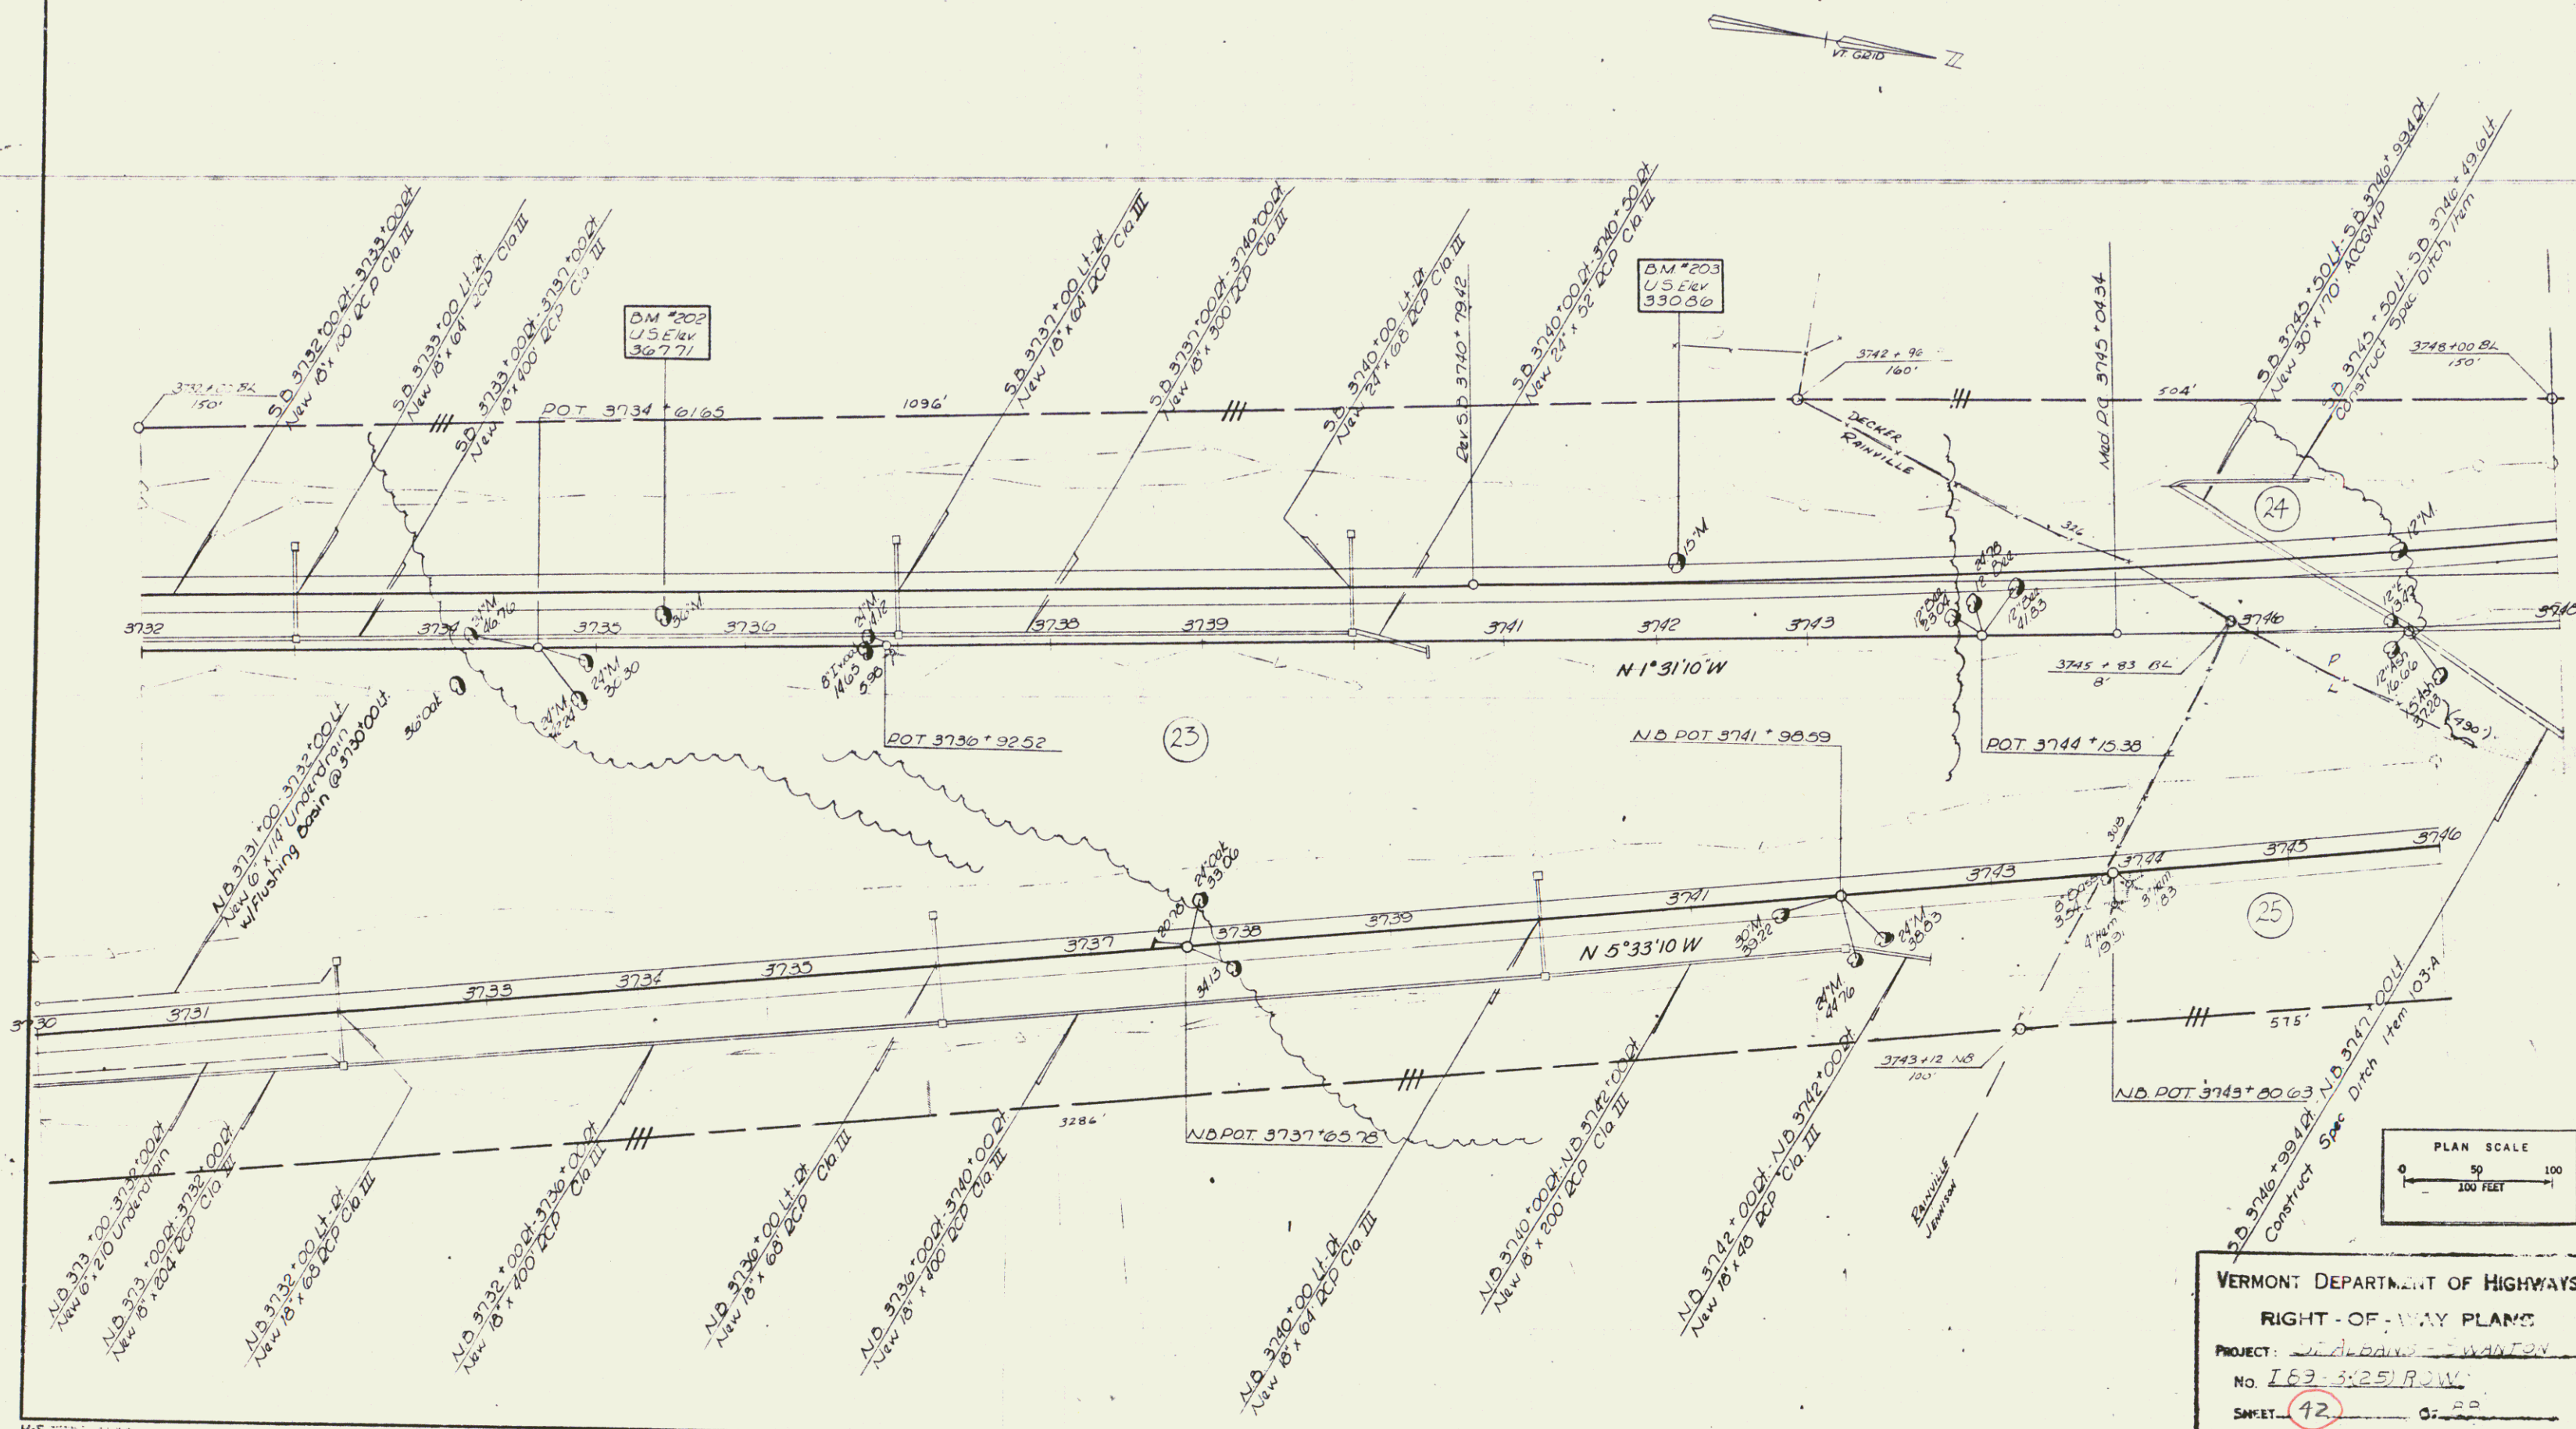


VERMONT DEPARTMENT OF HIGHWAYS
RIGHT-OF-WAY PLANS
PROJECT: OFF ALBANY - SWANTON
No. 169-3-251 R.O.W.
SHEET: 42 OF 40

THREE CABLE GUARD RAIL
W/ STEEL POSTS, ITEM 525
SD 3748+00 - 3748+61.47
NB 3747+00 - 3753+53.47
NB 3747+00 - 3753+60.21


WIDEN FOR BANK PROTECTION MOD
FOR CULVERT ENDS, ITEM 528
NB 3748+00

STONE FILL FOR SLOPE E.C.T. CTION
ITEM 522
NB 3755+00 - 3761+00.2


DRILLING & BASTING OF SOLID
2" CK. SUESSADE, MOD
ITEM 114
SB 3750+75 - 3752+75
SB 3760+75 - 3764+00

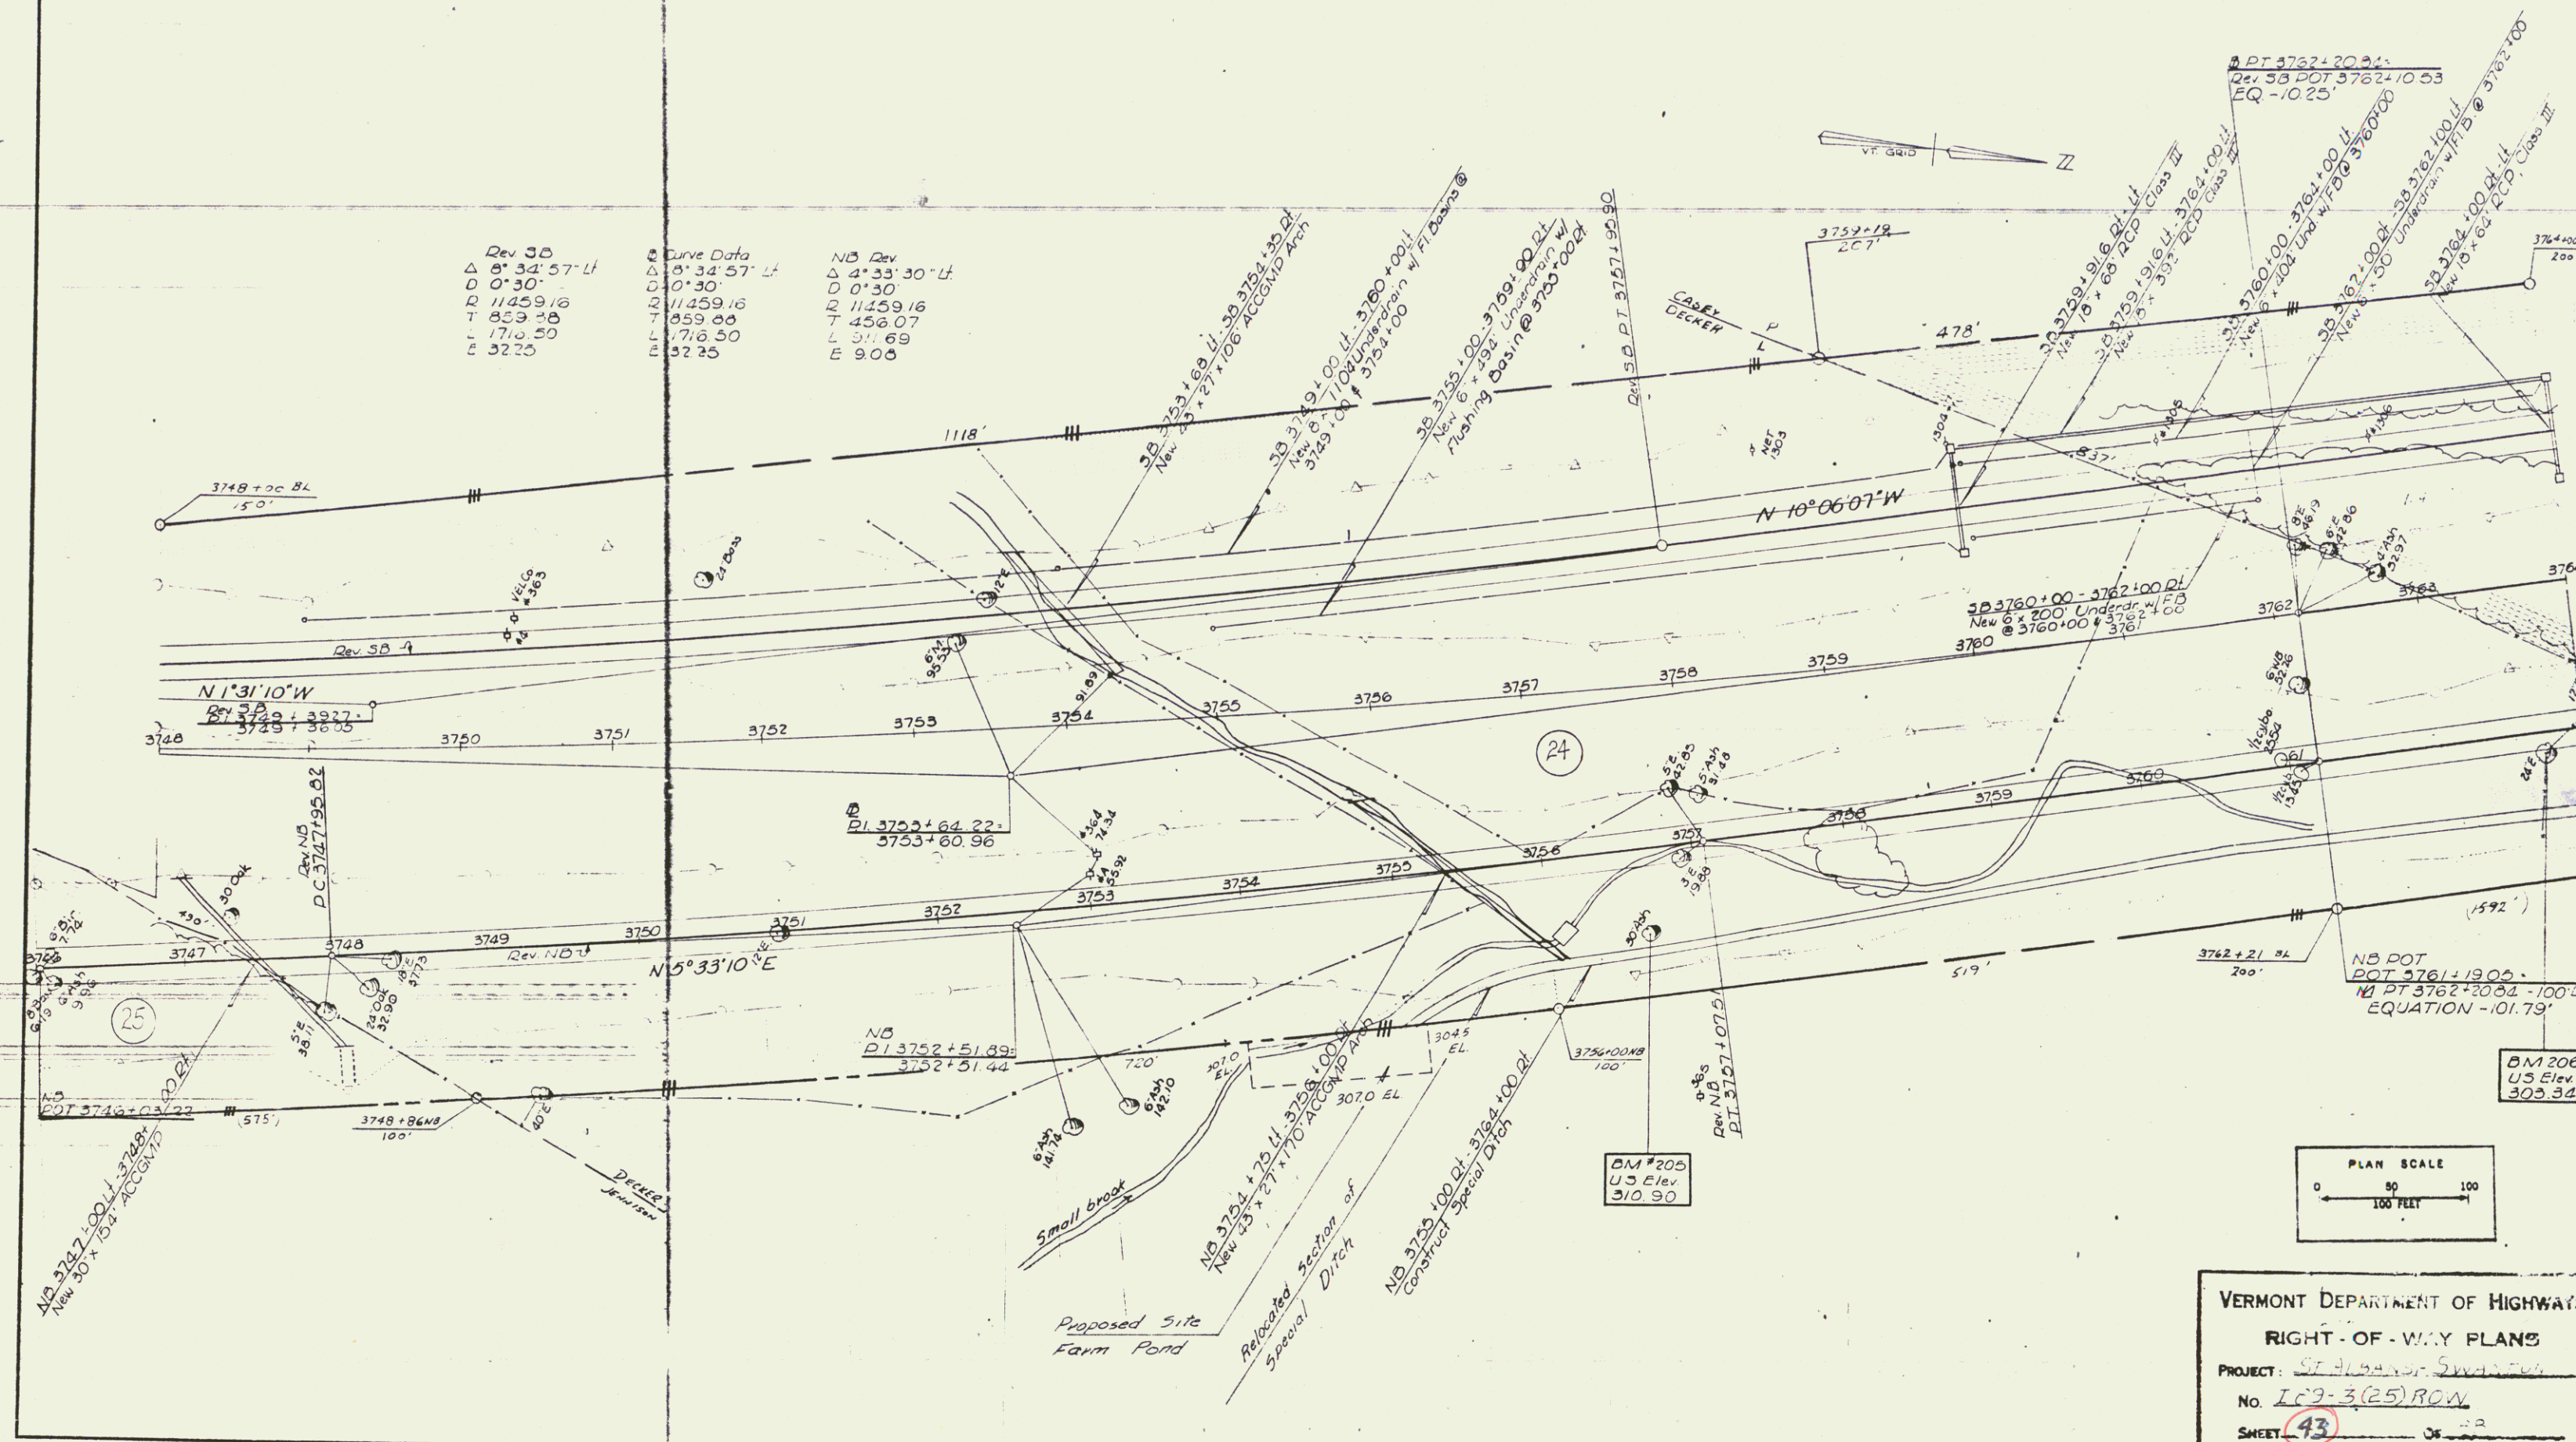

PLAN
 SUBMITTAL
 DATE
 NO.

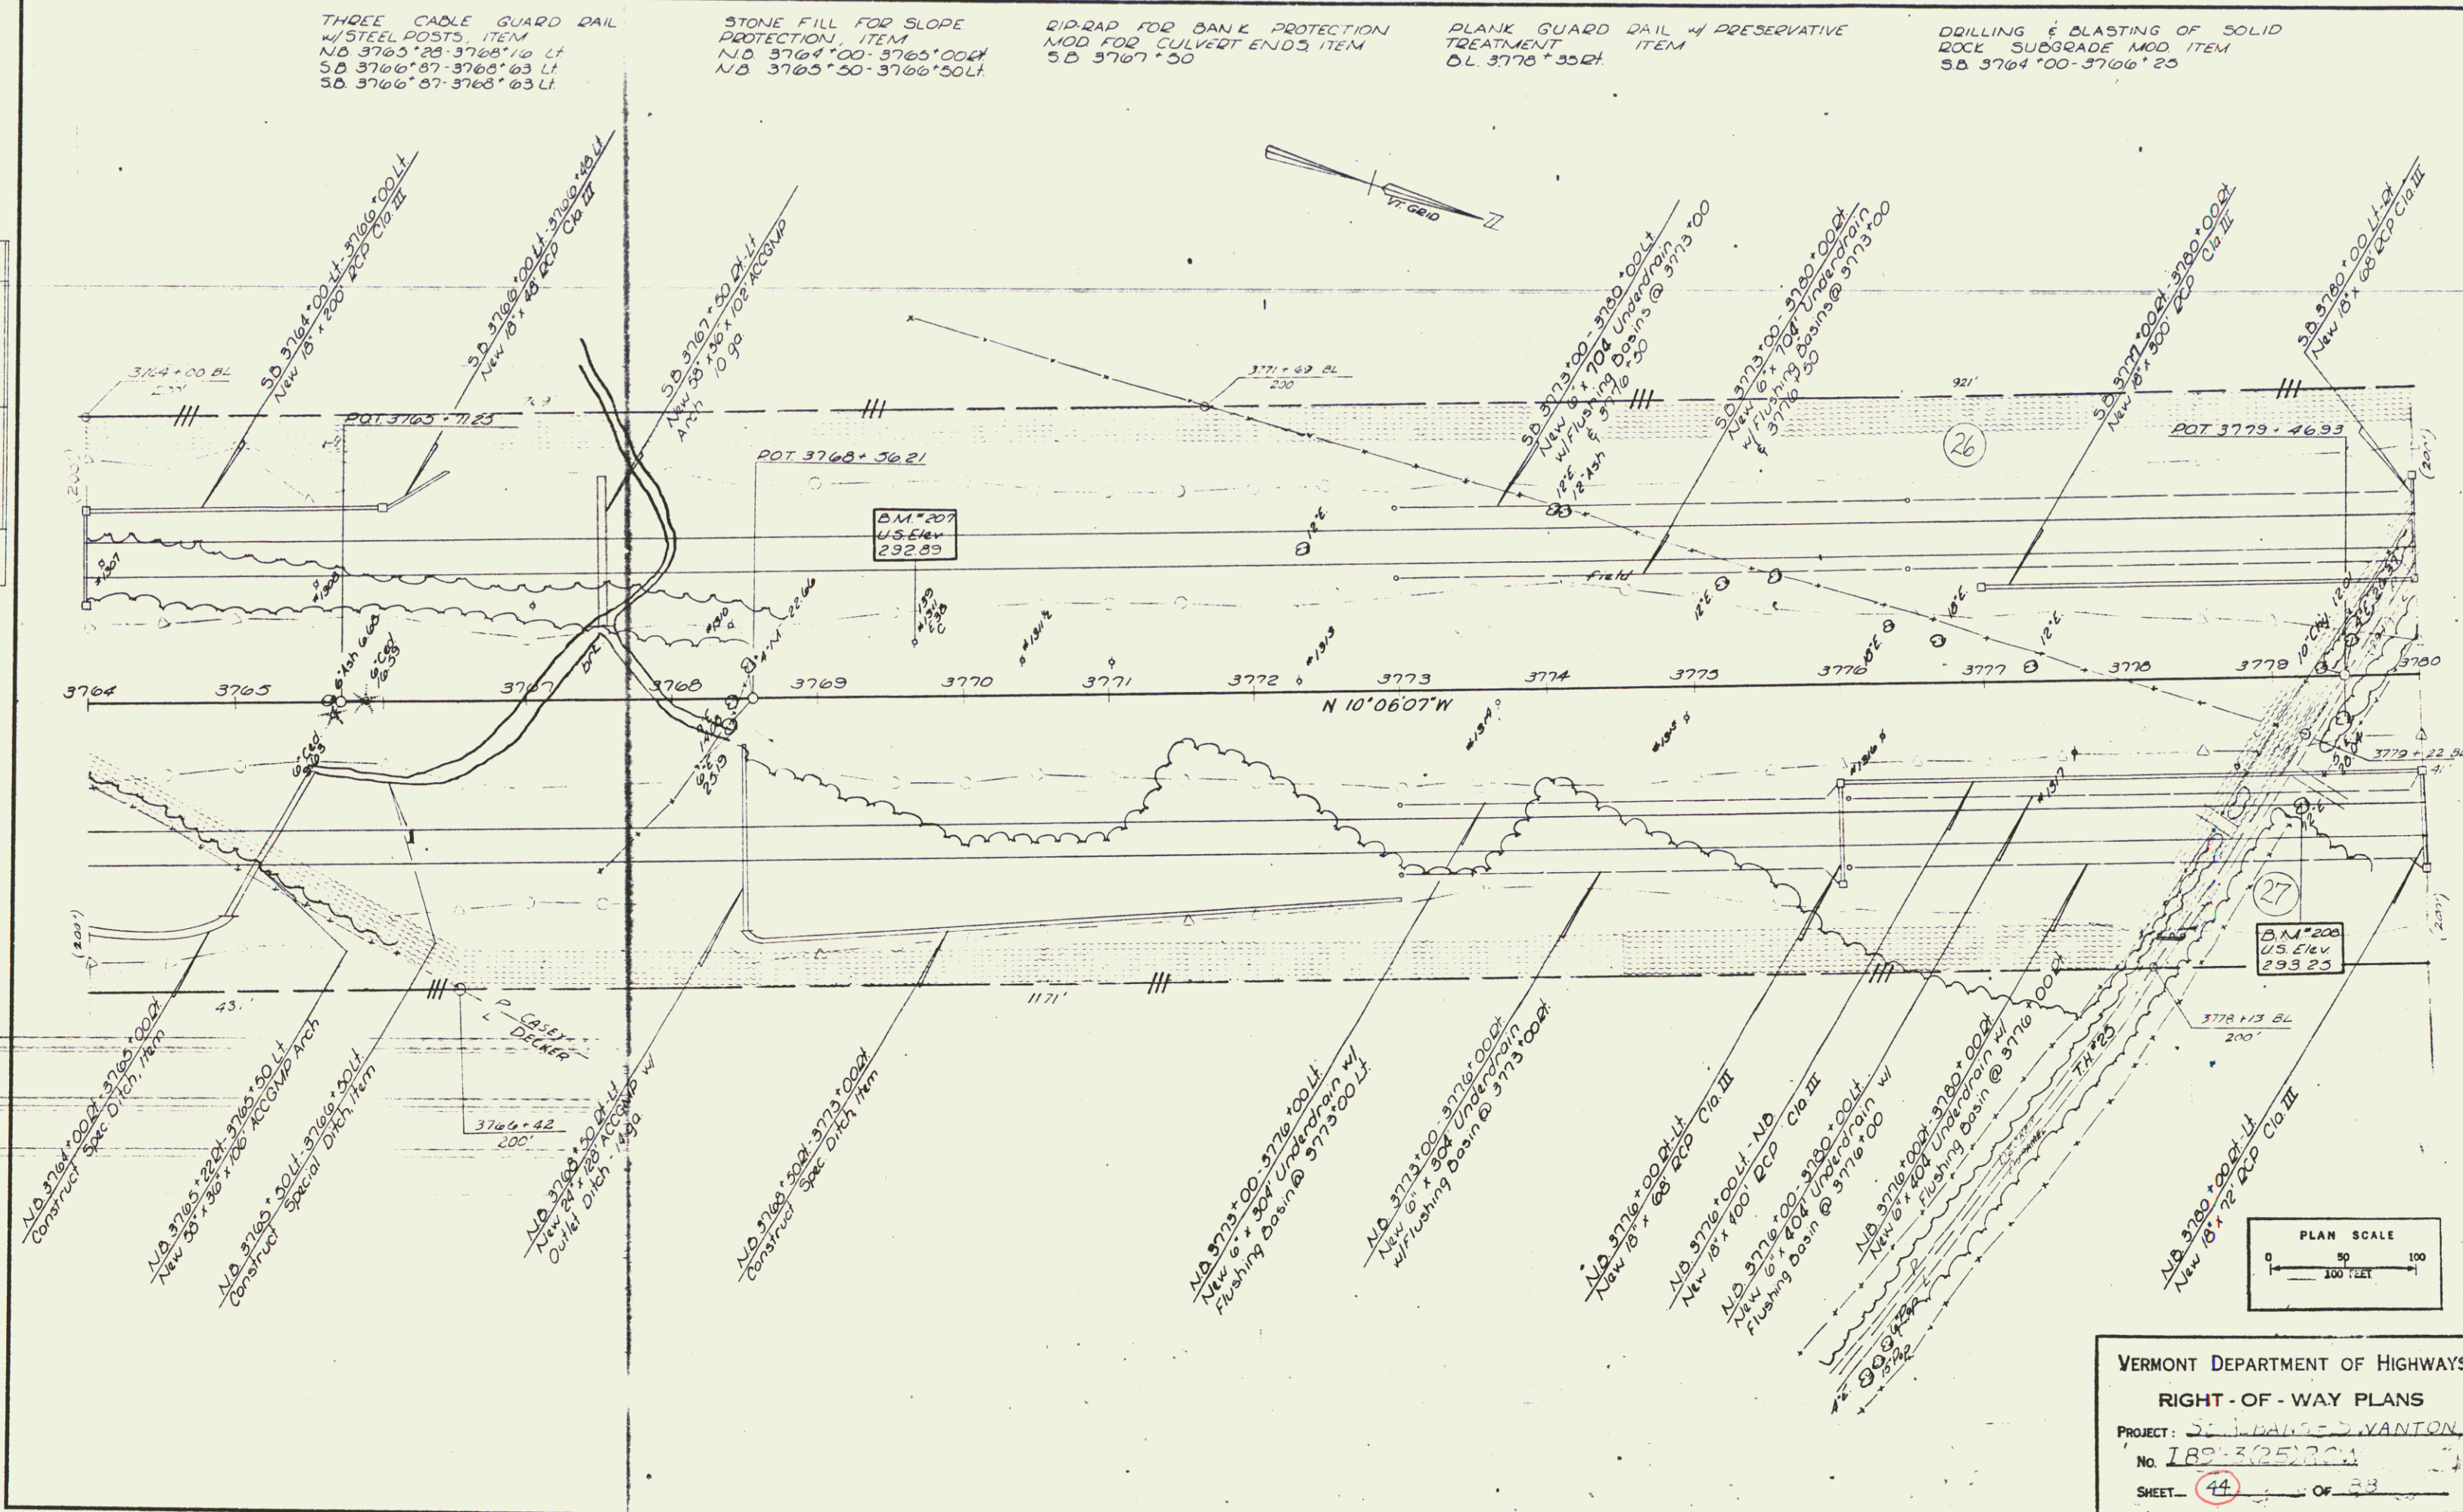


PLAN
SUBMITTER
DATE
NO.

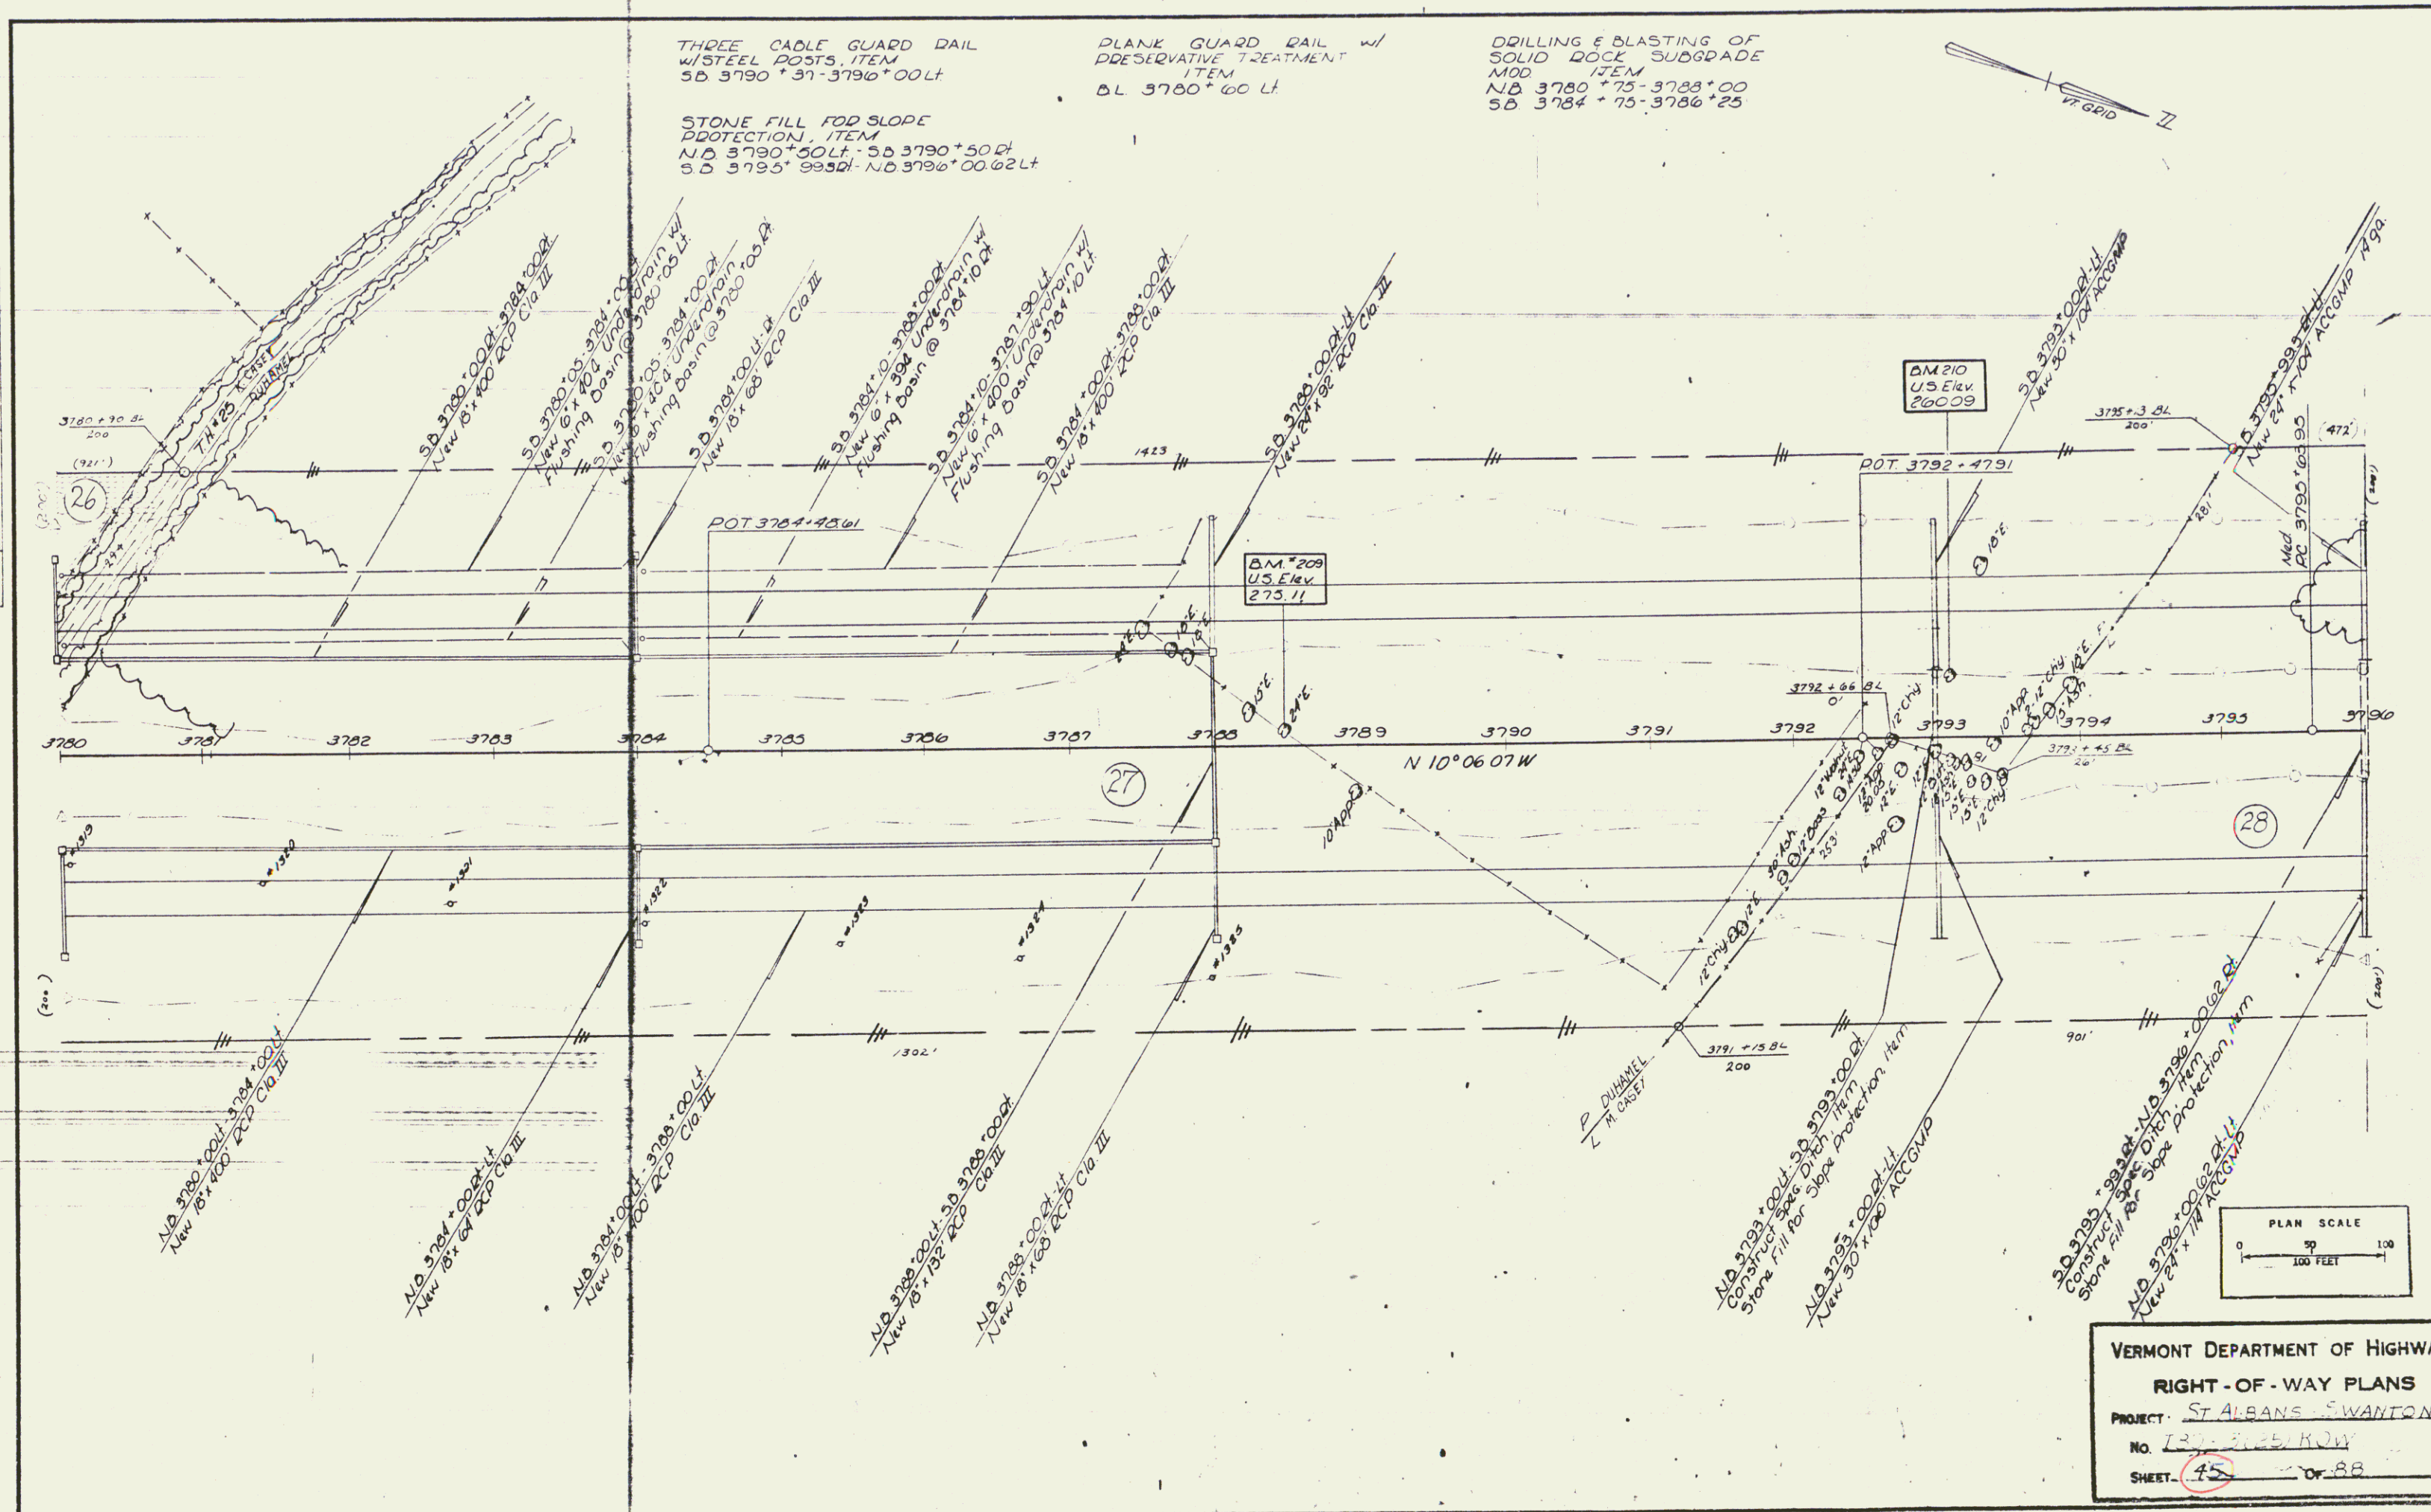

THREE CABLE GUARD RAIL WITH
STEEL POSTS, ITEM
3B 3815 + 37 LT - 3824 + 49 LT
3B 3826 + 01 LT - 3826 + 00 LT
3B 3816 + 01 RT - 3822 + 49 LT
3B 3826 + 01 RT - 3822 + 00 LT
NB 3816 + 49 LT - 3822 + 49 LT
NB 3826 + 01 LT - 3826 + 00 LT
NB 3813 + 09 RT - 3824 + 49 LT
NB 3826 + 01 RT - 3826 + 00 LT

DRILLING & BLASTING OF SOLID ROCK
SUBGRADE
3B 3812 + 00 - 3813 + 00
NB 3812 + 00 - 3814 + 50

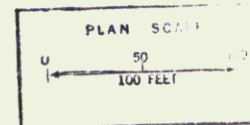


BEGIN RELINQUISHMENT NO. I
S.A. 3 2+75 (185')

VERMONT DEPARTMENT OF HIGHWAYS
RIGHT-OF-WAY PLANS
PROJECT: ST. ALBANS - SWANTON
NO. 187-325 R.W.
SHEET 47 OF 48

END RELINQUISHMENT NO. I
BEGIN MAINT. AGREE. AREA NO. I
S.A. 3 4+60 (398')




END MAINT. AGREE. AREA NO. I
BEGIN RELINQUISHMENT NO. II
S.A. 3 8+58 (217')

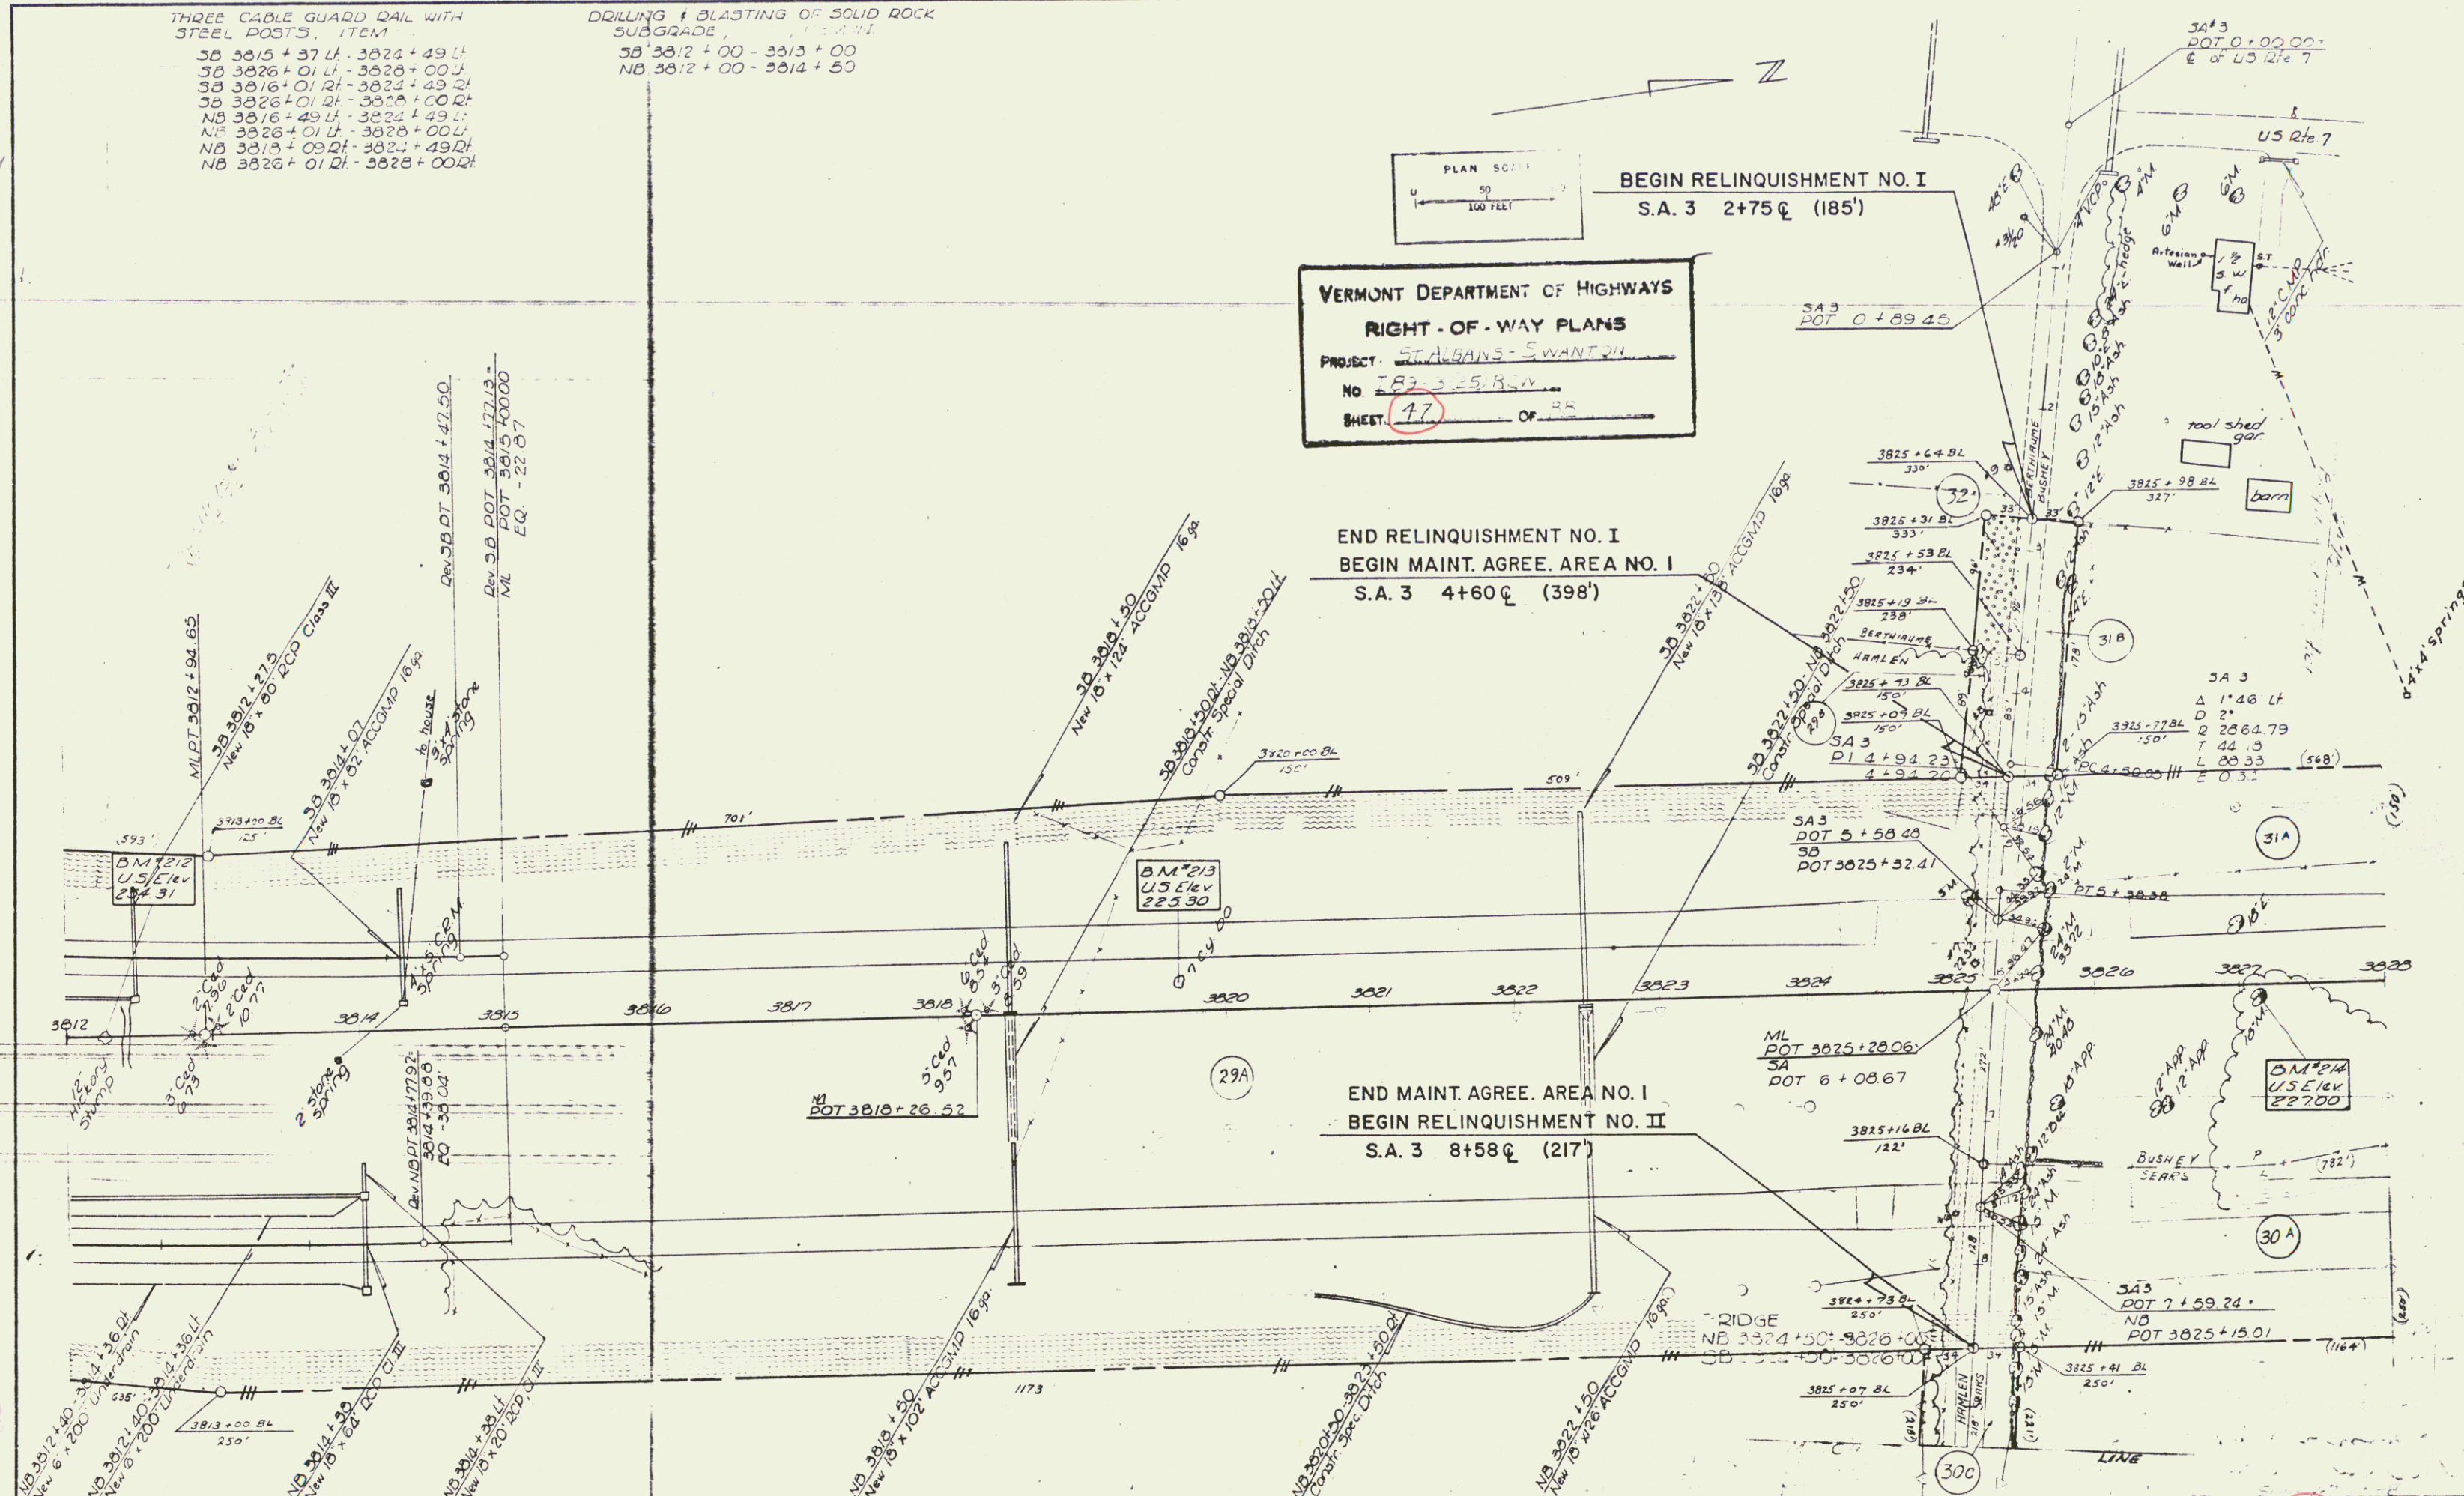

Sheet 47 ROW

PLAN
NOTE BOOK
NO.

PROFILE
NOTE BOOK
NO.

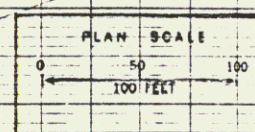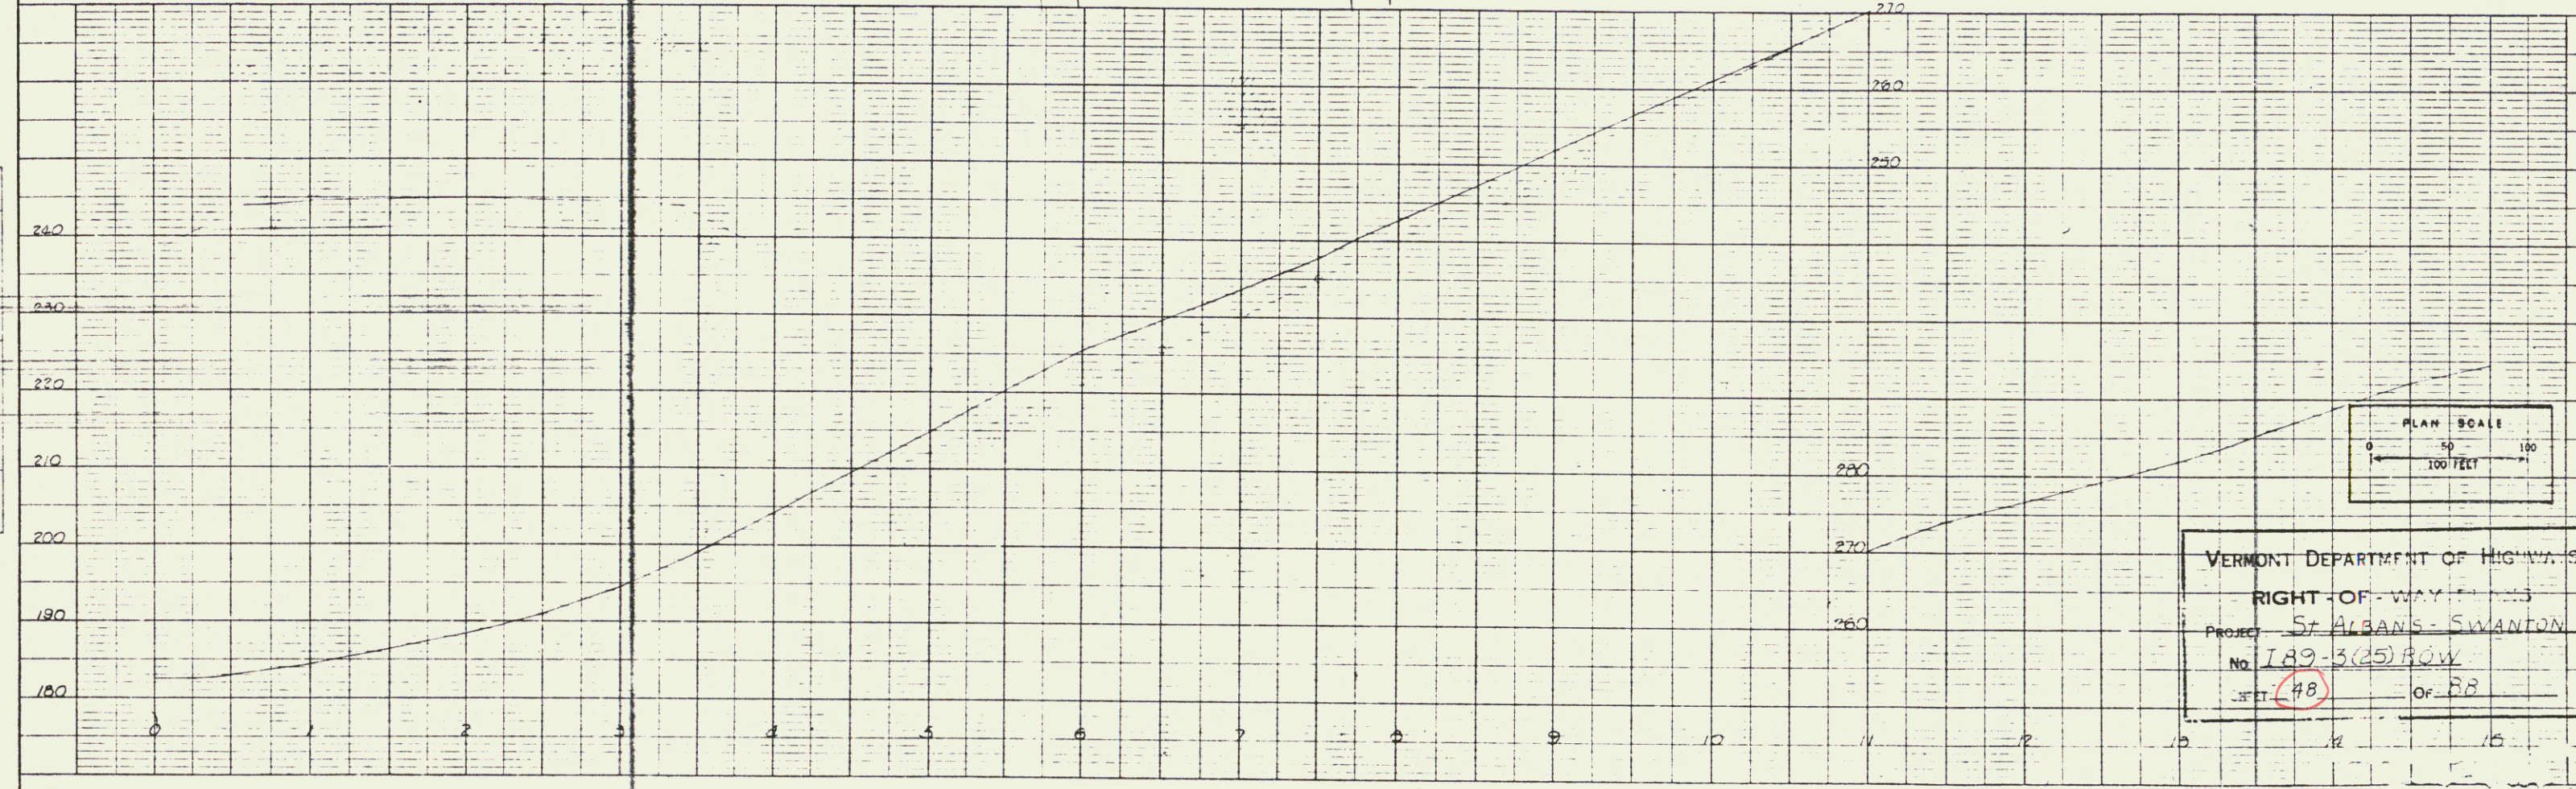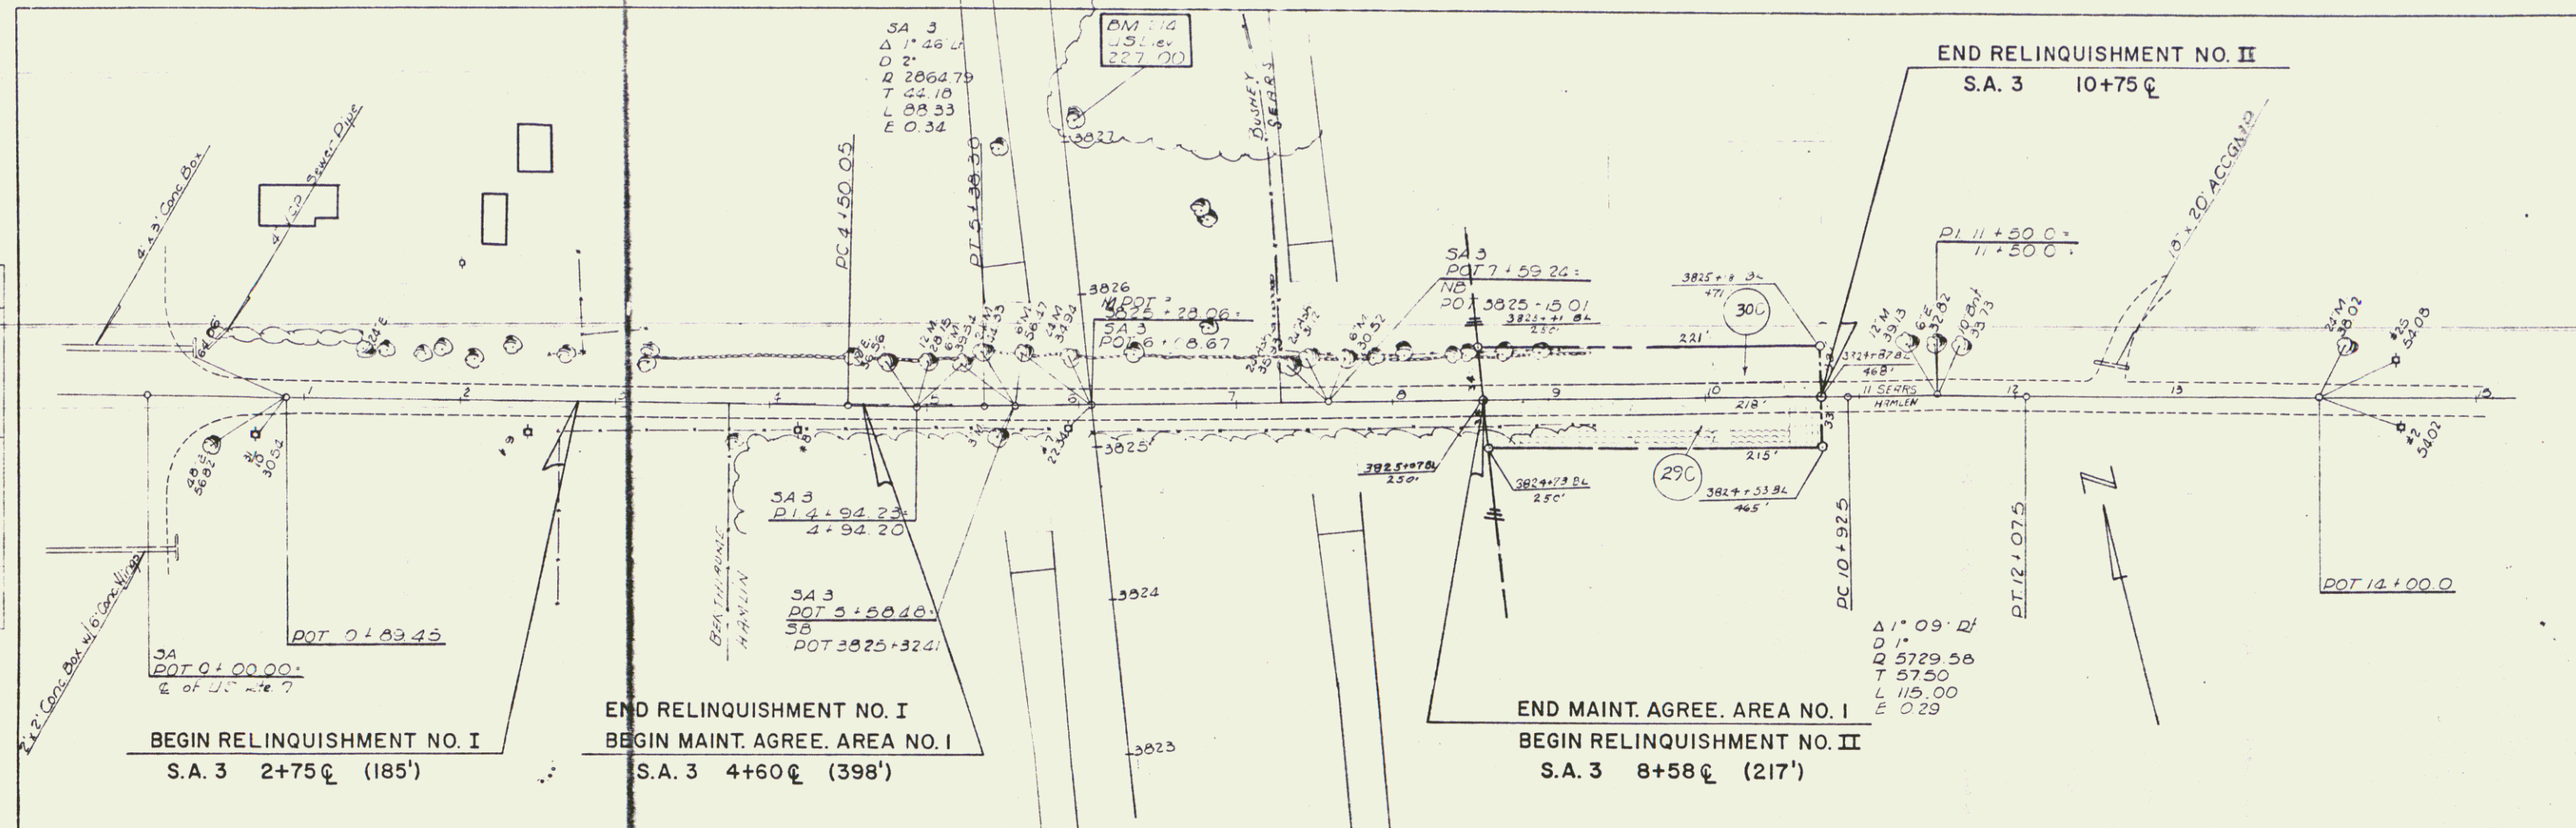


VERMONT DEPARTMENT OF HIGHWAYS
RIGHT-OF-WAY
PROJECT: ST. ALBANS-SWANTON
NO. 189-3(25) ROW
SHEET 48 OF 88

K-E PLATE 1, PLAN PROFILE
HARTMAN ENGINEERING CO.

S.A. # 3



46

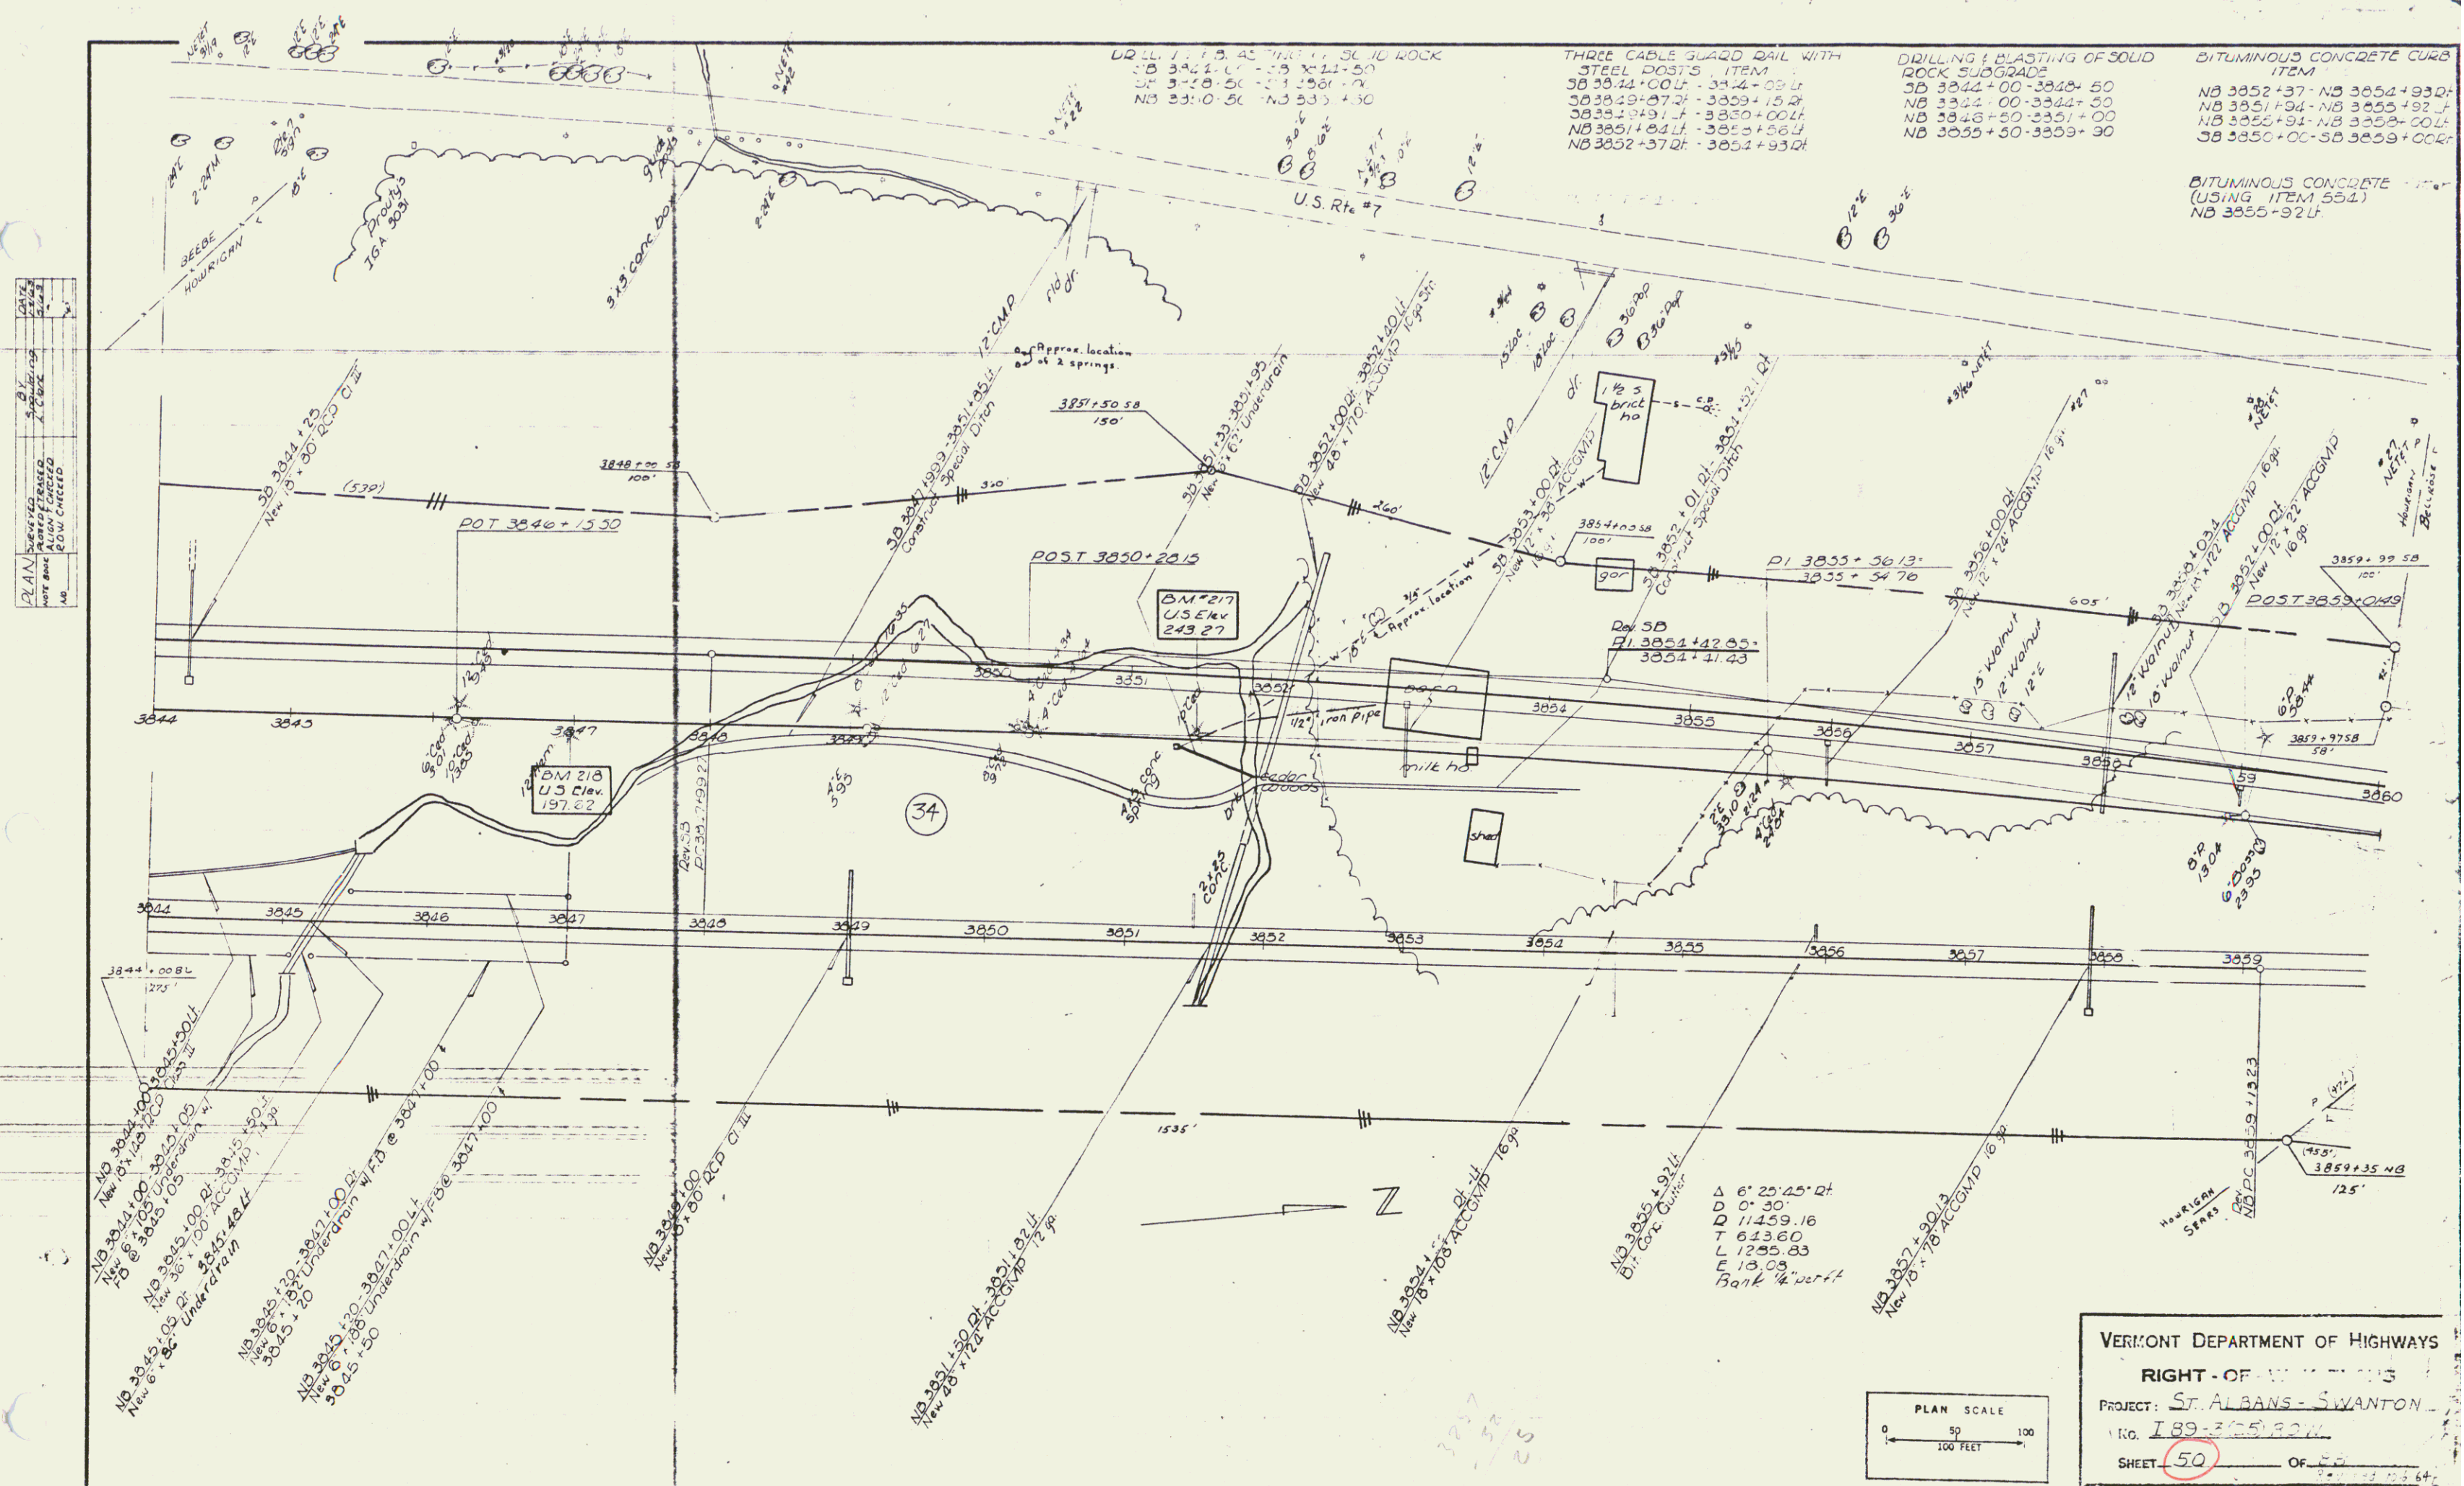

THREE CABLE GUARD RAIL
W/ STEEL POSTS, ITEM
S.D. 3860+00.0 - 3860+63.3L
S.D. 3864+31.1L - 3865+73.43L

DRILLING & BLASTING OF SOLID
ROCK, SUBGRADE, ITEM
S.D. 3860+00 - 3865+73.43
N.D. 3859+90 - 3860+70.43

DRILLING & BLASTING OF
SOLID ROCK, ITEM
S.D. 3860+00 - 3861+00
S.D. 3864+50 - 3865+73.43

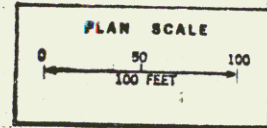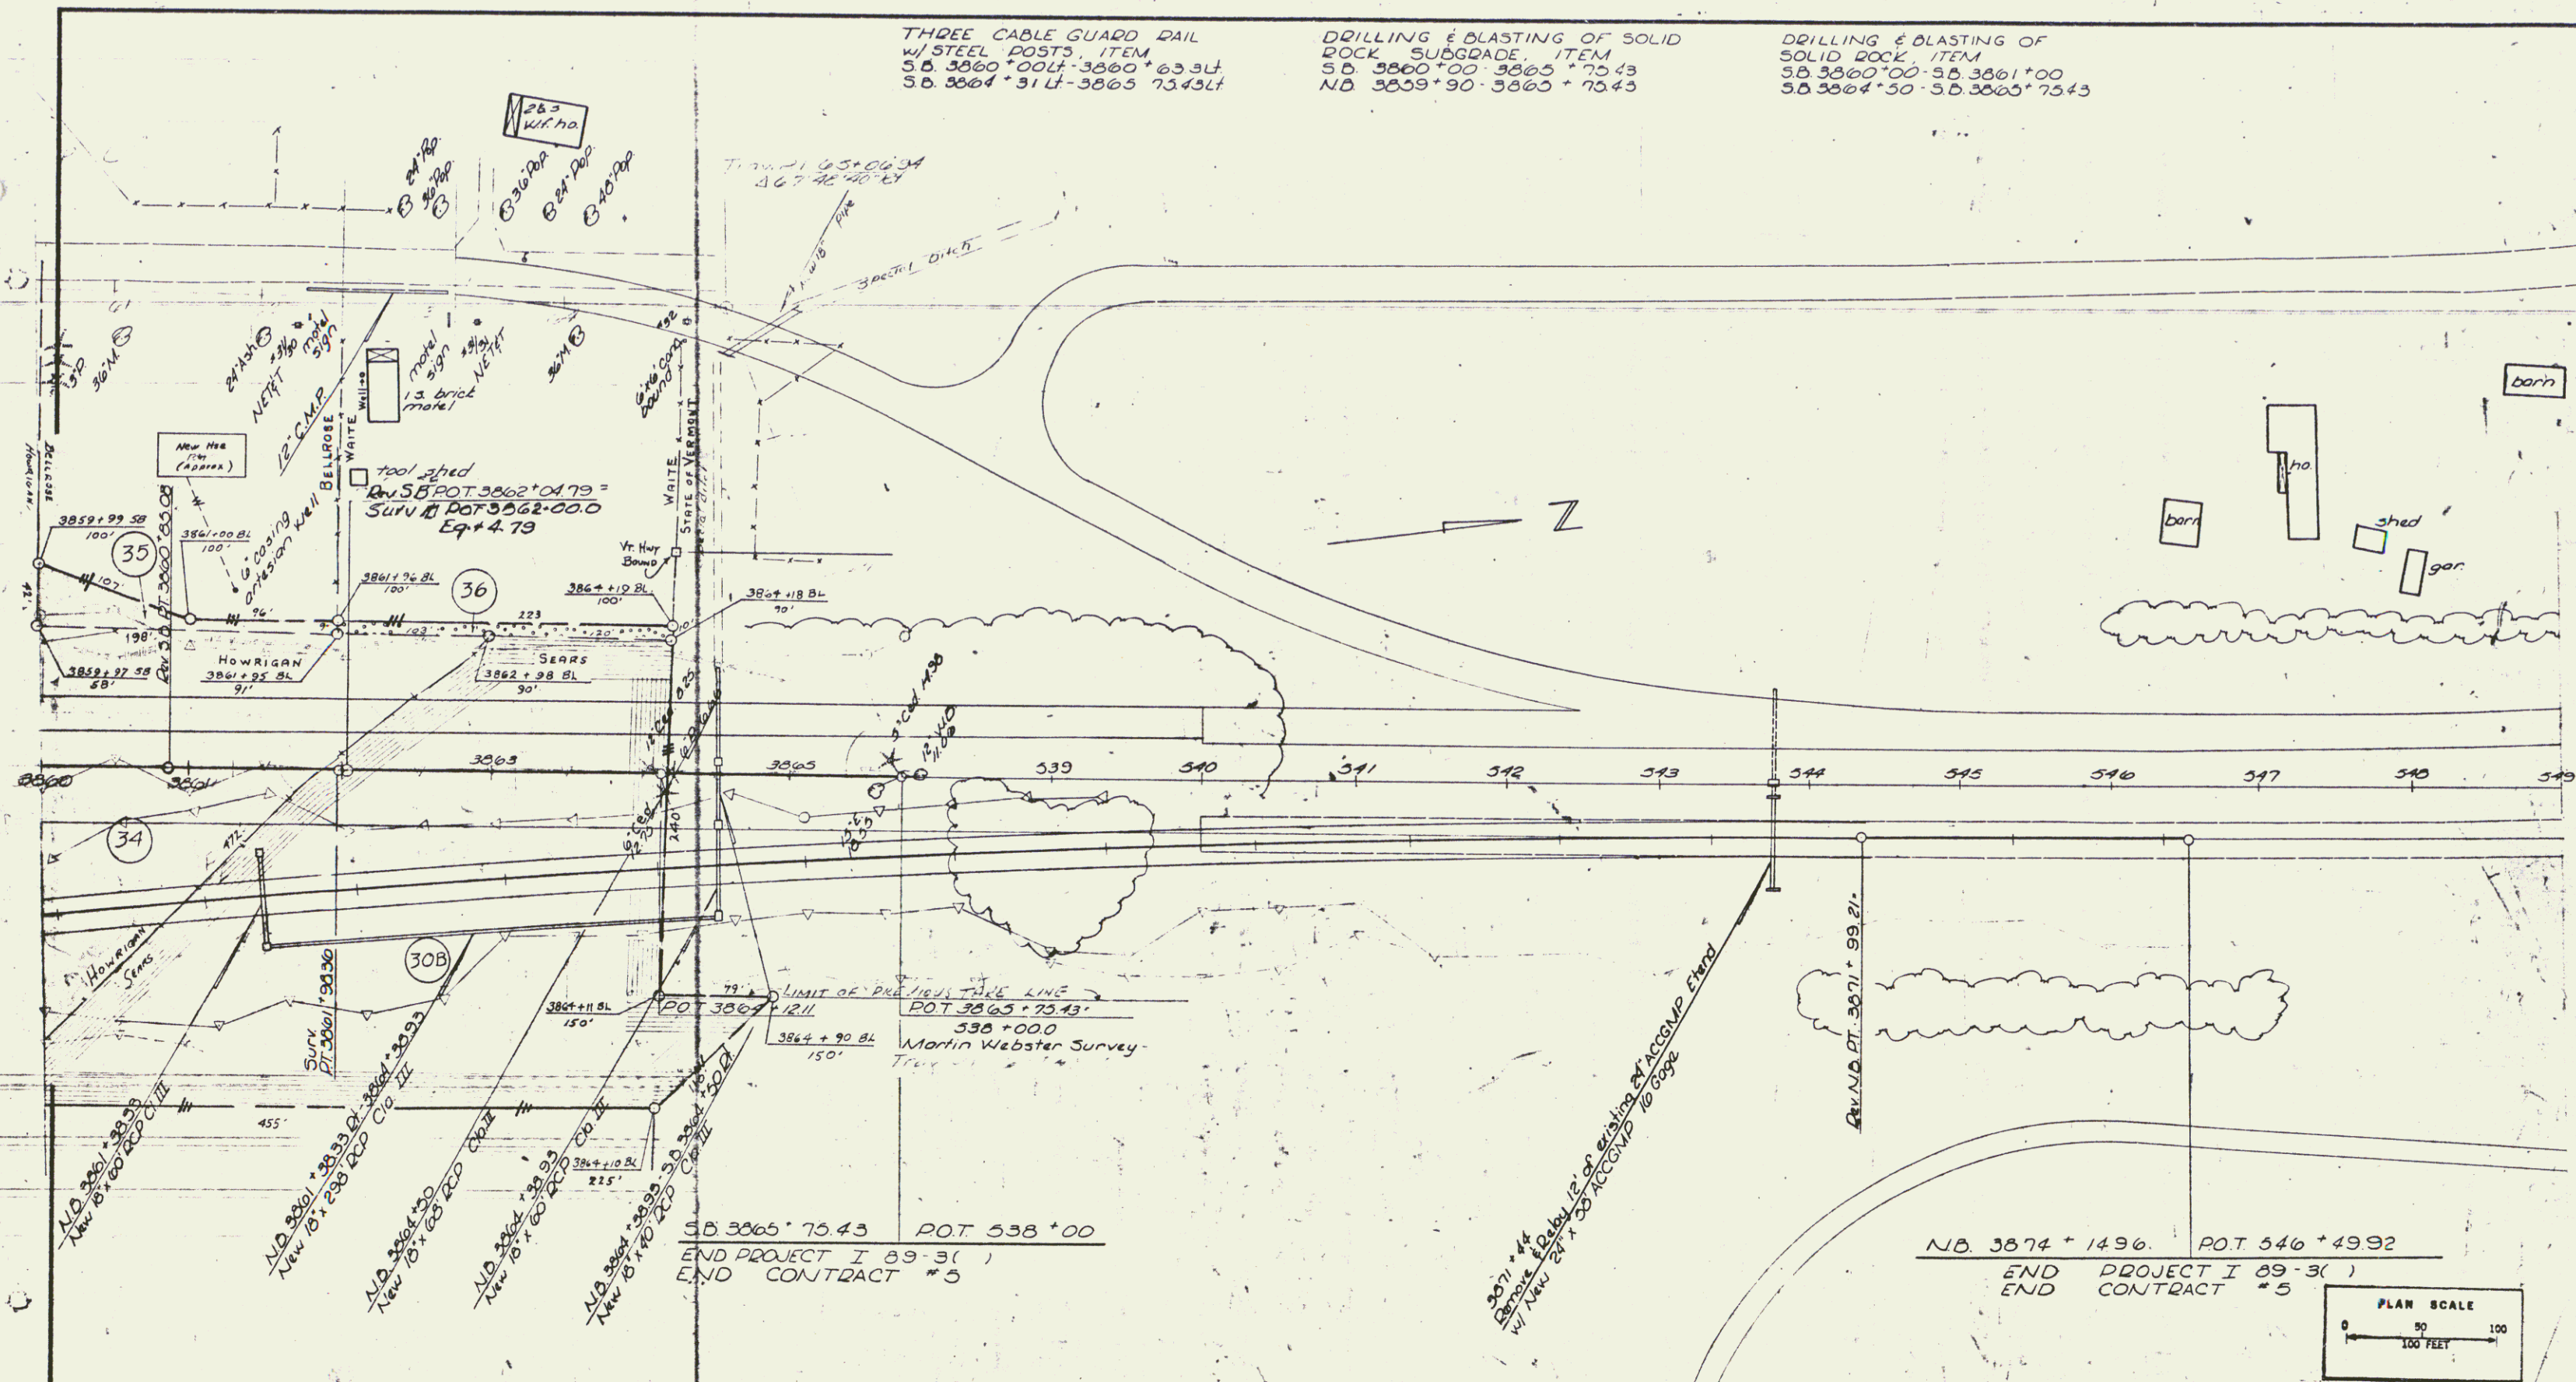




VERMONT DEPARTMENT OF HIGHWAYS
RIGHT-OF-WAY PLANS
PROJECT: ST ALBANS - SWANTON
No. 182-3(25) RDVY
SHEET: 51 OF 83

49

TOWNS OF ST. ALBANS—SWANTON
COUNTY OF FRANKLIN
INTERSTATE ROUTE 89
BURLINGTON—PHILIPSBURG, QUE. ROAD

LENGTH OF CONTRACT 17.61790 FEET= 3.337 MILES

CONSTRUCTION PLANS

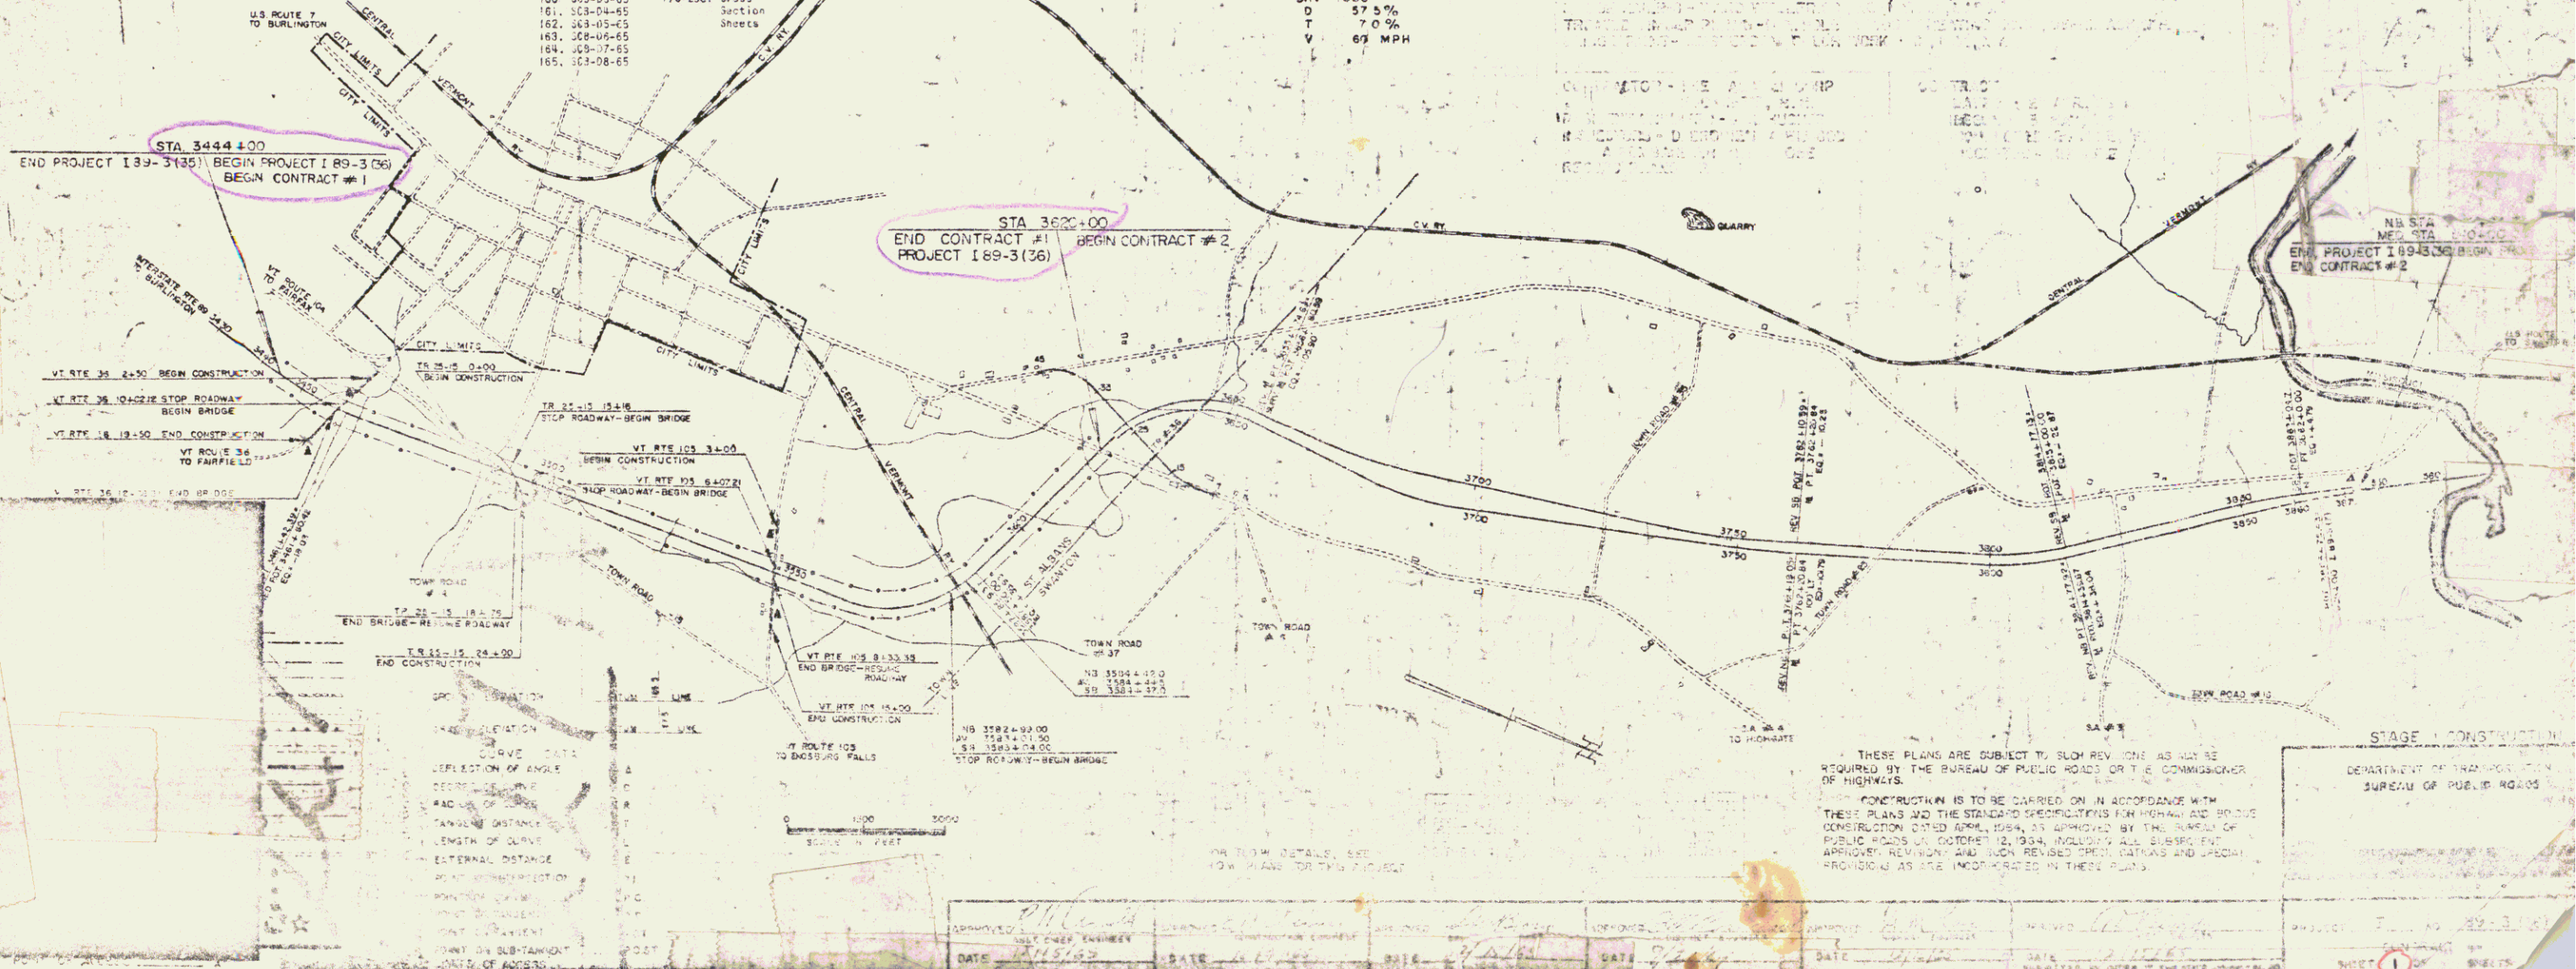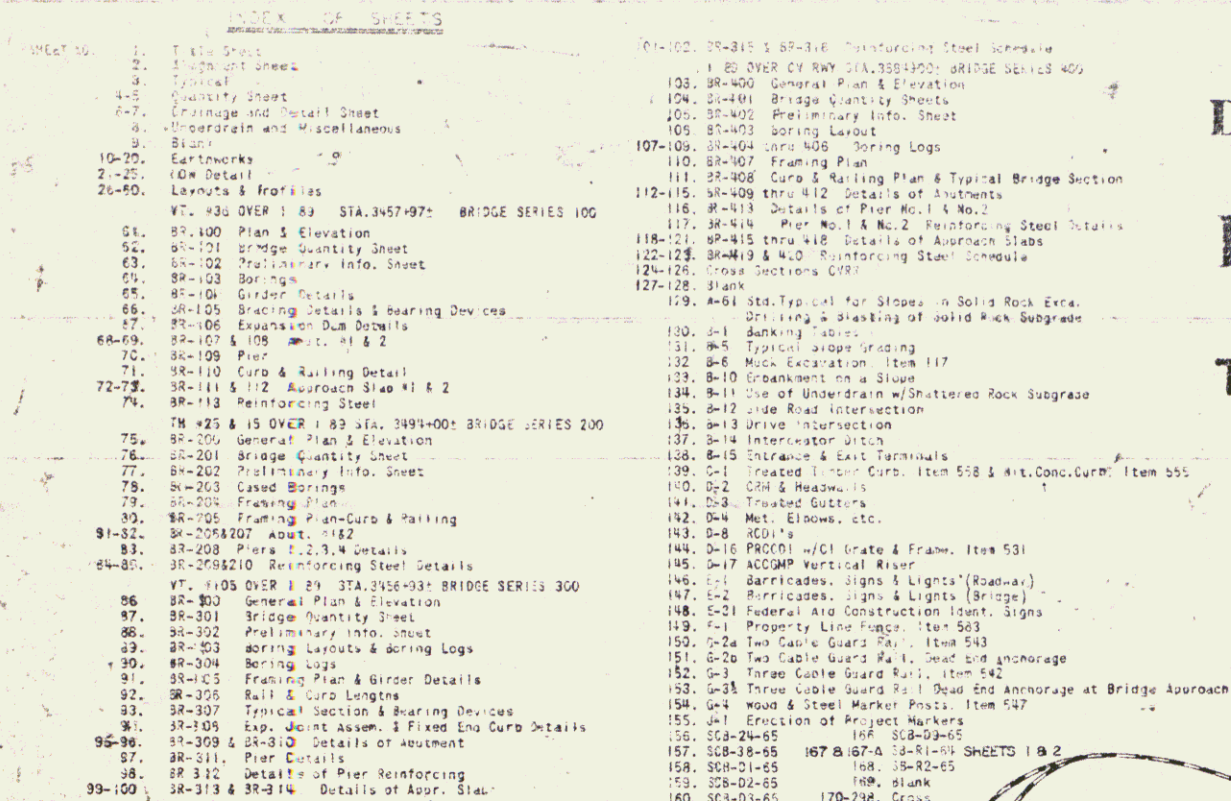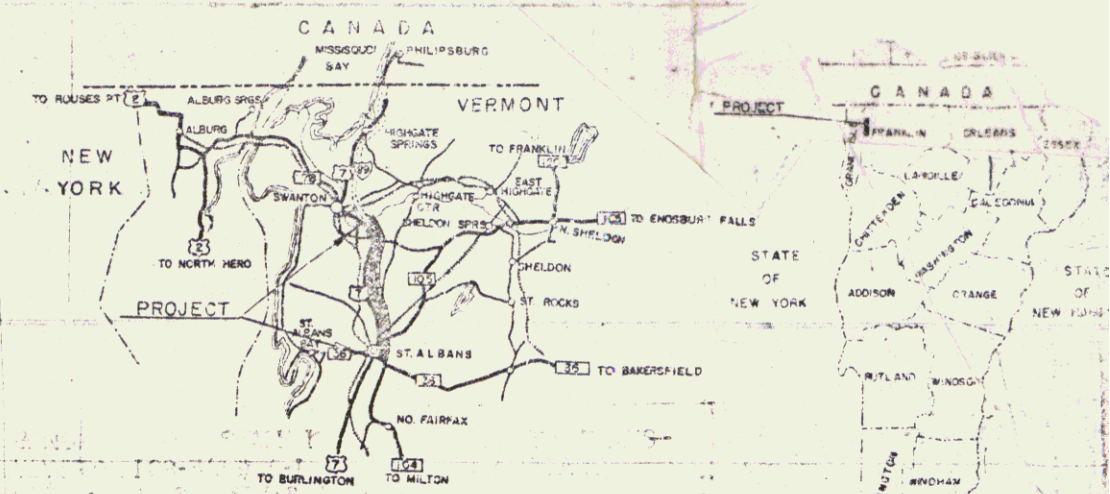

THESE PLANS ARE SUBJECT TO SUCH REVISION AS MAY BE REQUIRED BY THE BUREAU OF PUBLIC ROADS OR THE COMMISSIONER OF HIGHWAYS.

CONSTRUCTION IS TO BE CARRIED ON IN ACCORDANCE WITH THESE PLANS AND THE STANDARD SPECIFICATIONS FOR HIGHWAY AND BRIDGE CONSTRUCTION DATED APRIL, 1934, AS APPROVED BY THE BUREAU OF PUBLIC ROADS ON OCTOBER 12, 1934, INCLUDING ALL SUBSEQUENT APPROVED REVISIONS AND SUCH REVISED SPECIFICATIONS AND SPECIAL PROVISIONS AS ARE INCORPORATED IN THESE PLANS.


STAGE 1 CONSTRUCTION
DEPARTMENT OF TRANSPORTATION
BUREAU OF PUBLIC ROADS

1997, 1998, 1999, 2678, 26

SHEET 1 OF 3 SHEETS

Construction Plan
50

PLAN	SURVEYED ALIGNED & GRADED NOTED & CHECKED LOW CHASED	BY AUSTIN (PHONE)	DATE 2-10-63 6-10-63
NOTE BOOK			
NO.			

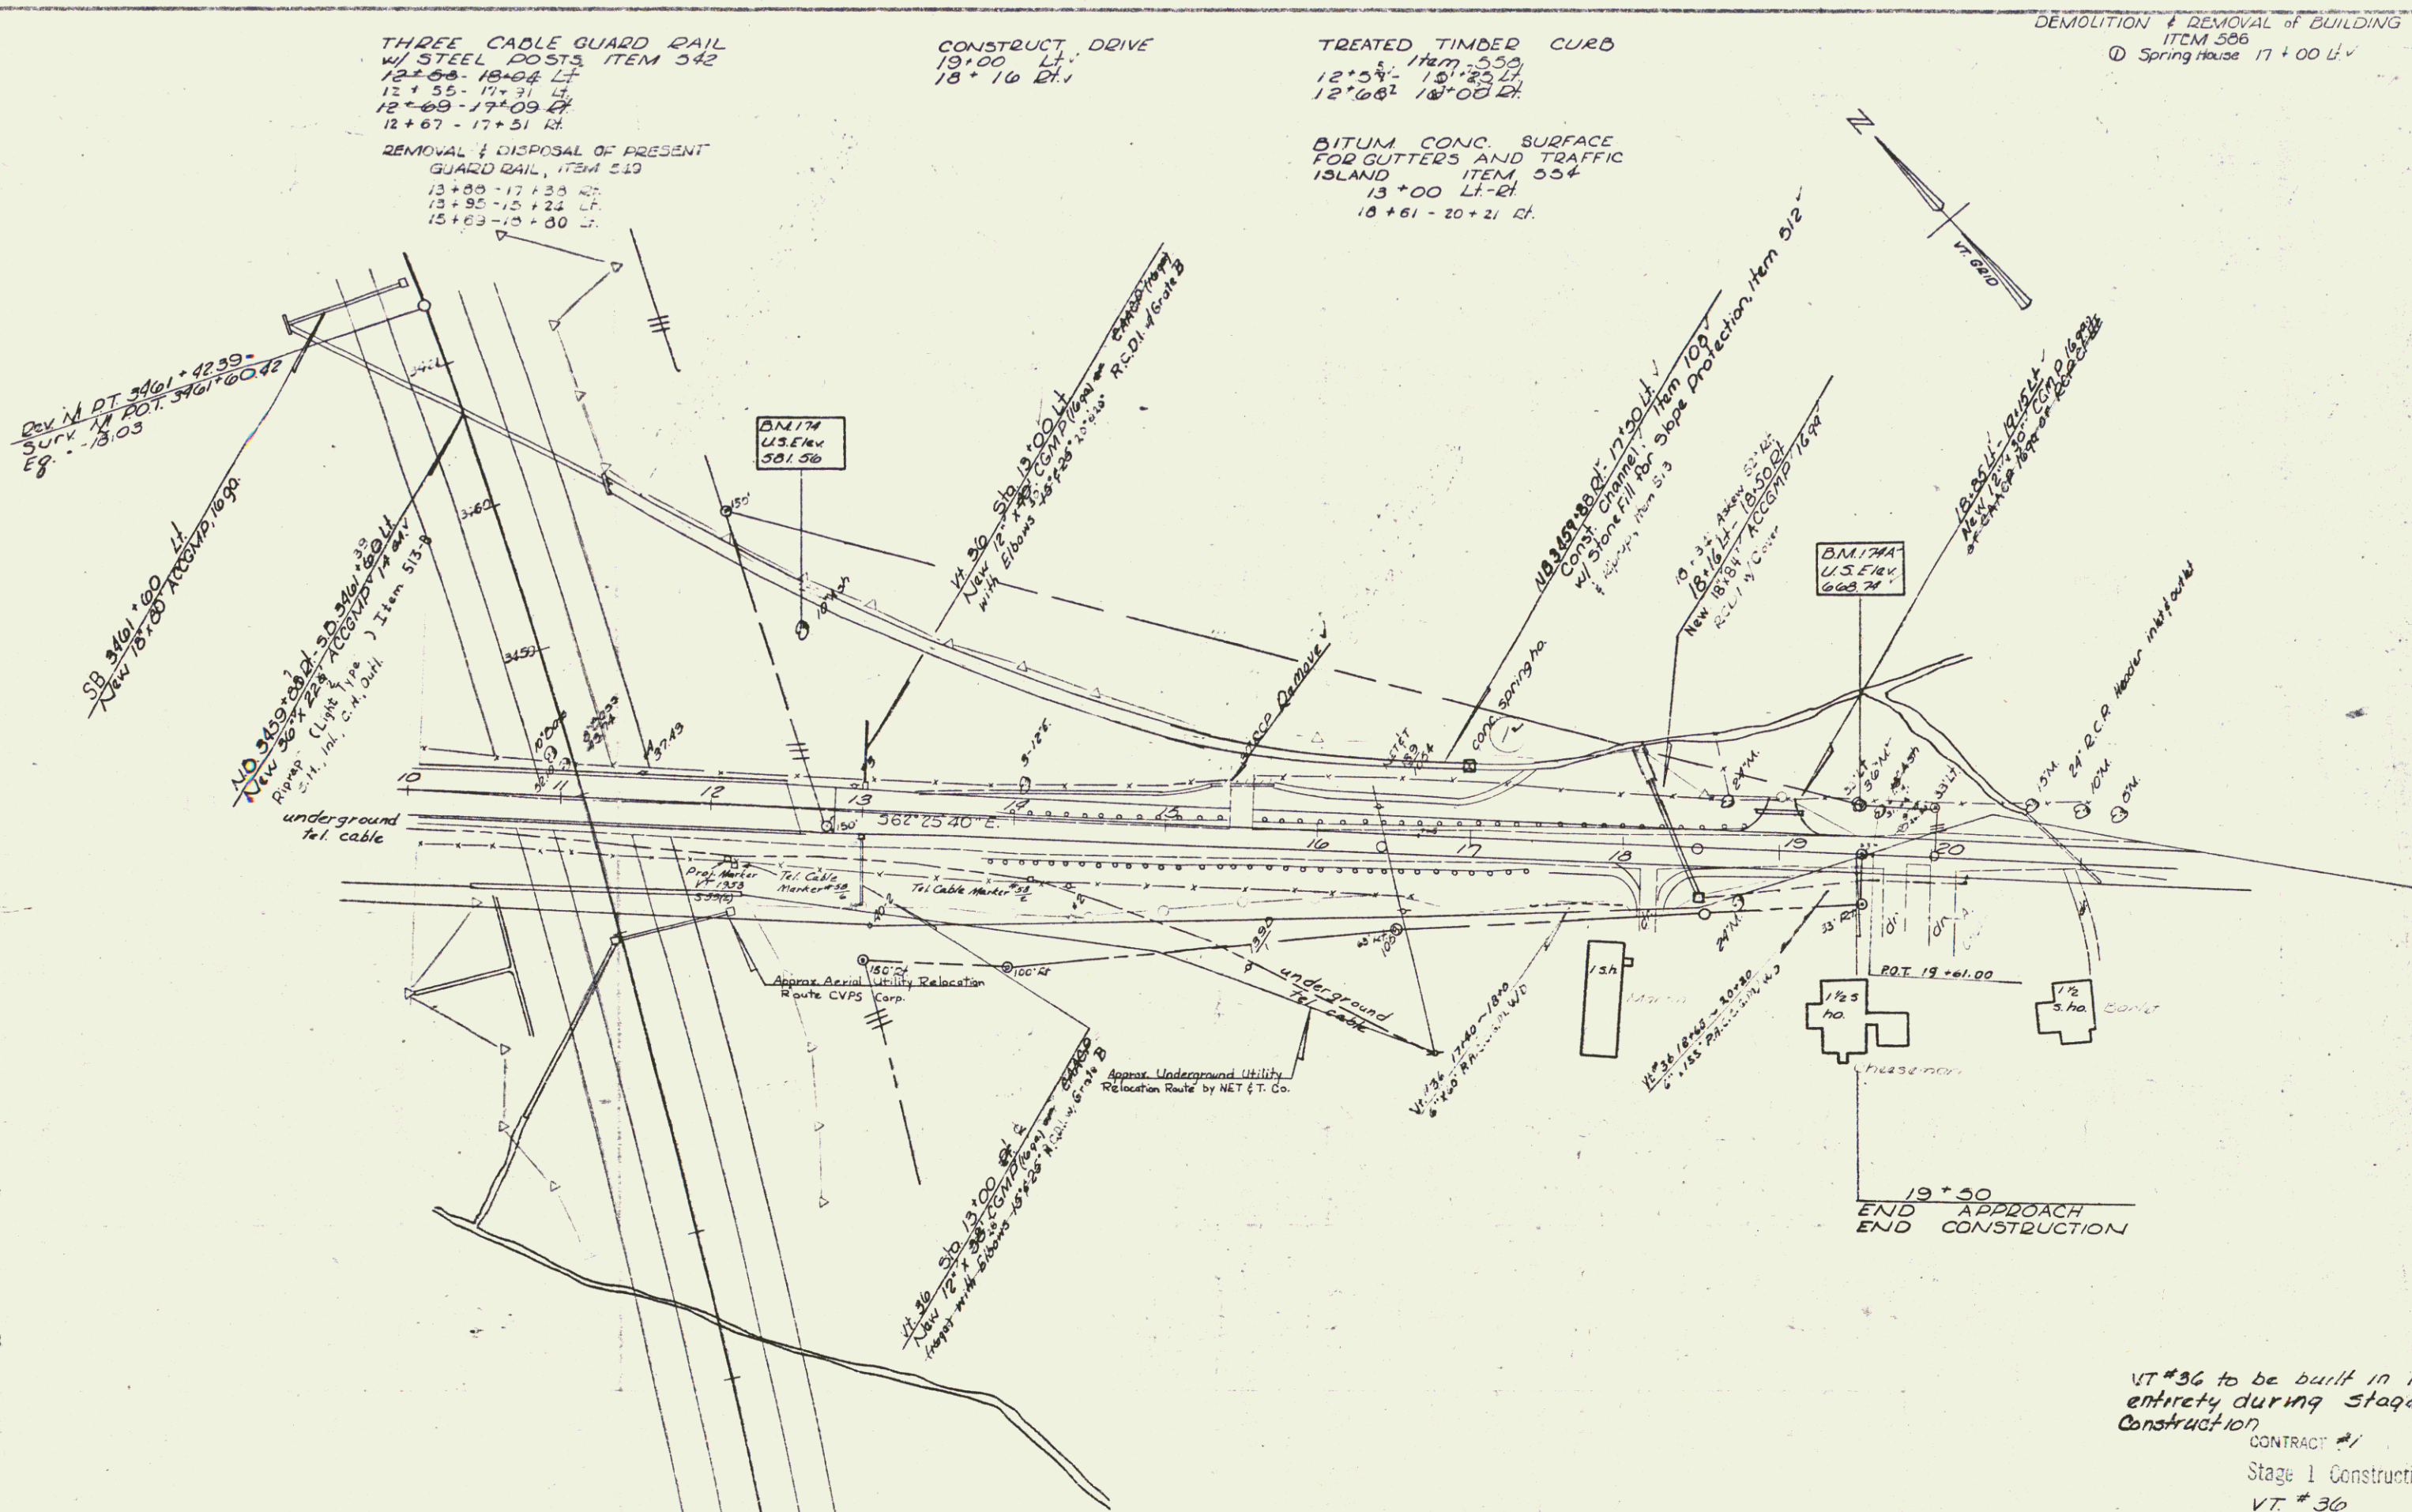

VT #36 to be built in its
entirety during Stage I
Construction

CONTRACT 

Stage 1 Construction:

VT. # 36
ST. ALBANS- SWANTON
I 89 - 3(36)


Sheet 30 of 298

PLAN
STATIONED
7/10/2018
BY
CHECKED
DATE
NO.

* BITUM-CONC. SURFACE FOR
GUTTERS & TRAFFIC ISLANDS
ITEM 554
3461+25-3461+60 Med
3463+25-3463+75 Med
3463+92-3469+17 Med
3474+60-3474+25 Med

PROPERTY LINE FENCE, ITEM 553-I, MOD.
3460+00-3476+00 LI & D.

STA	LOC	DESCRIPT
BL 3460+00	LT	DRILLED WELL
BL 3463+00	LT	DRILLED WELL

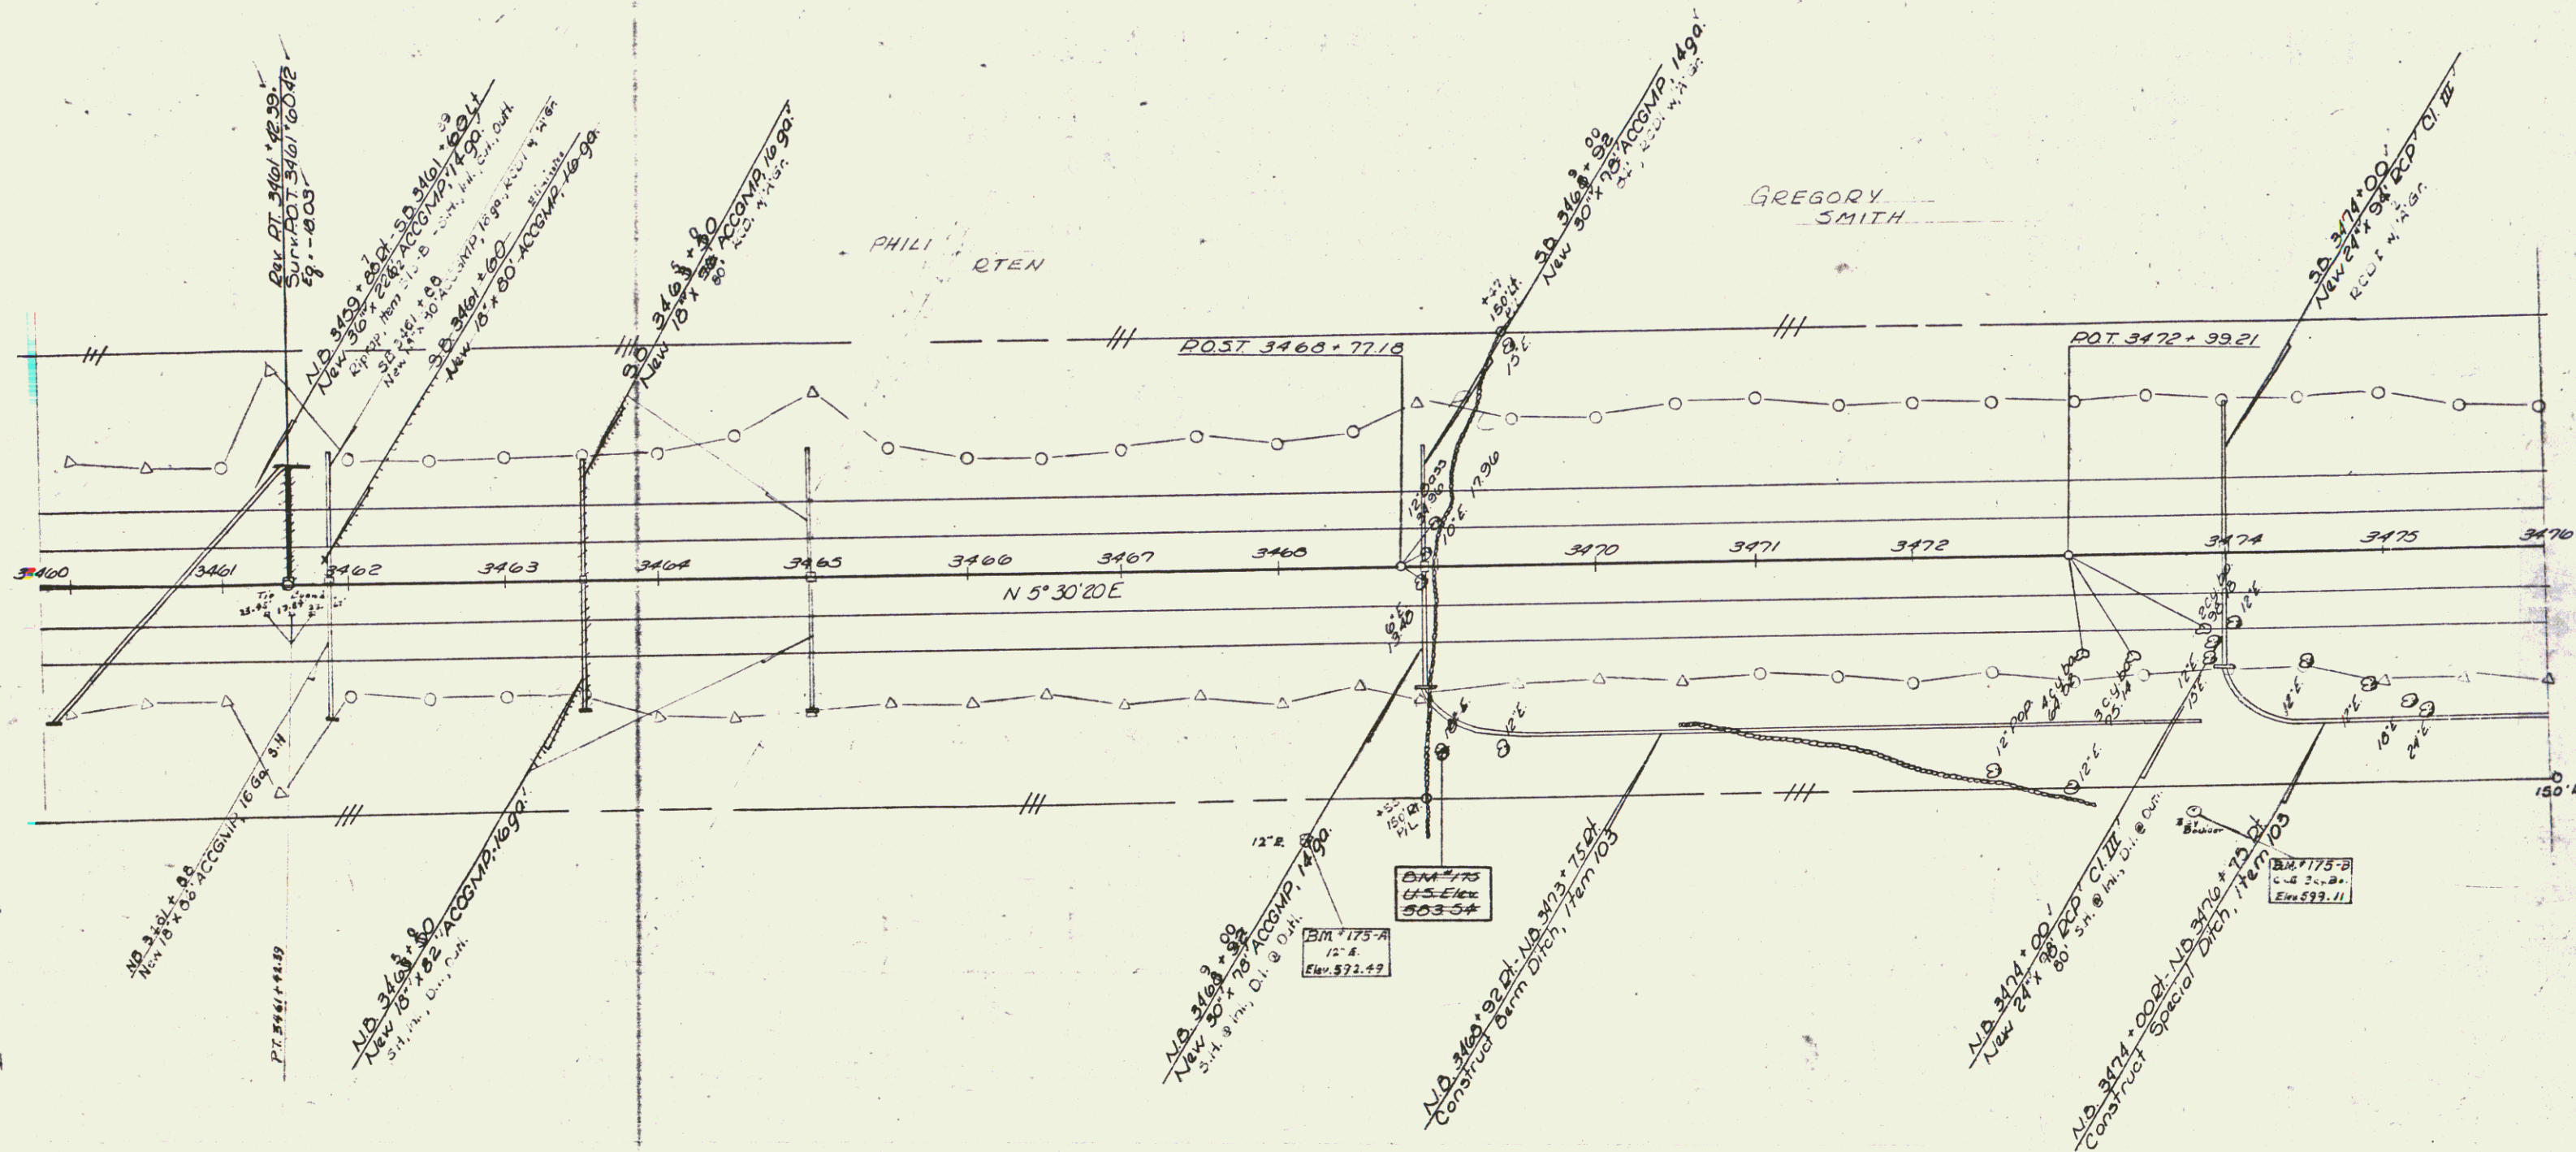


CONTROL OF ACCESS COMPLETE ON THIS SHEET

* STAGE II CONSTRUCTION ITEM

Stage II Construction
STALBANS - SWANTON
I 89 - 31 - 42

Sheet 32 of 153

52

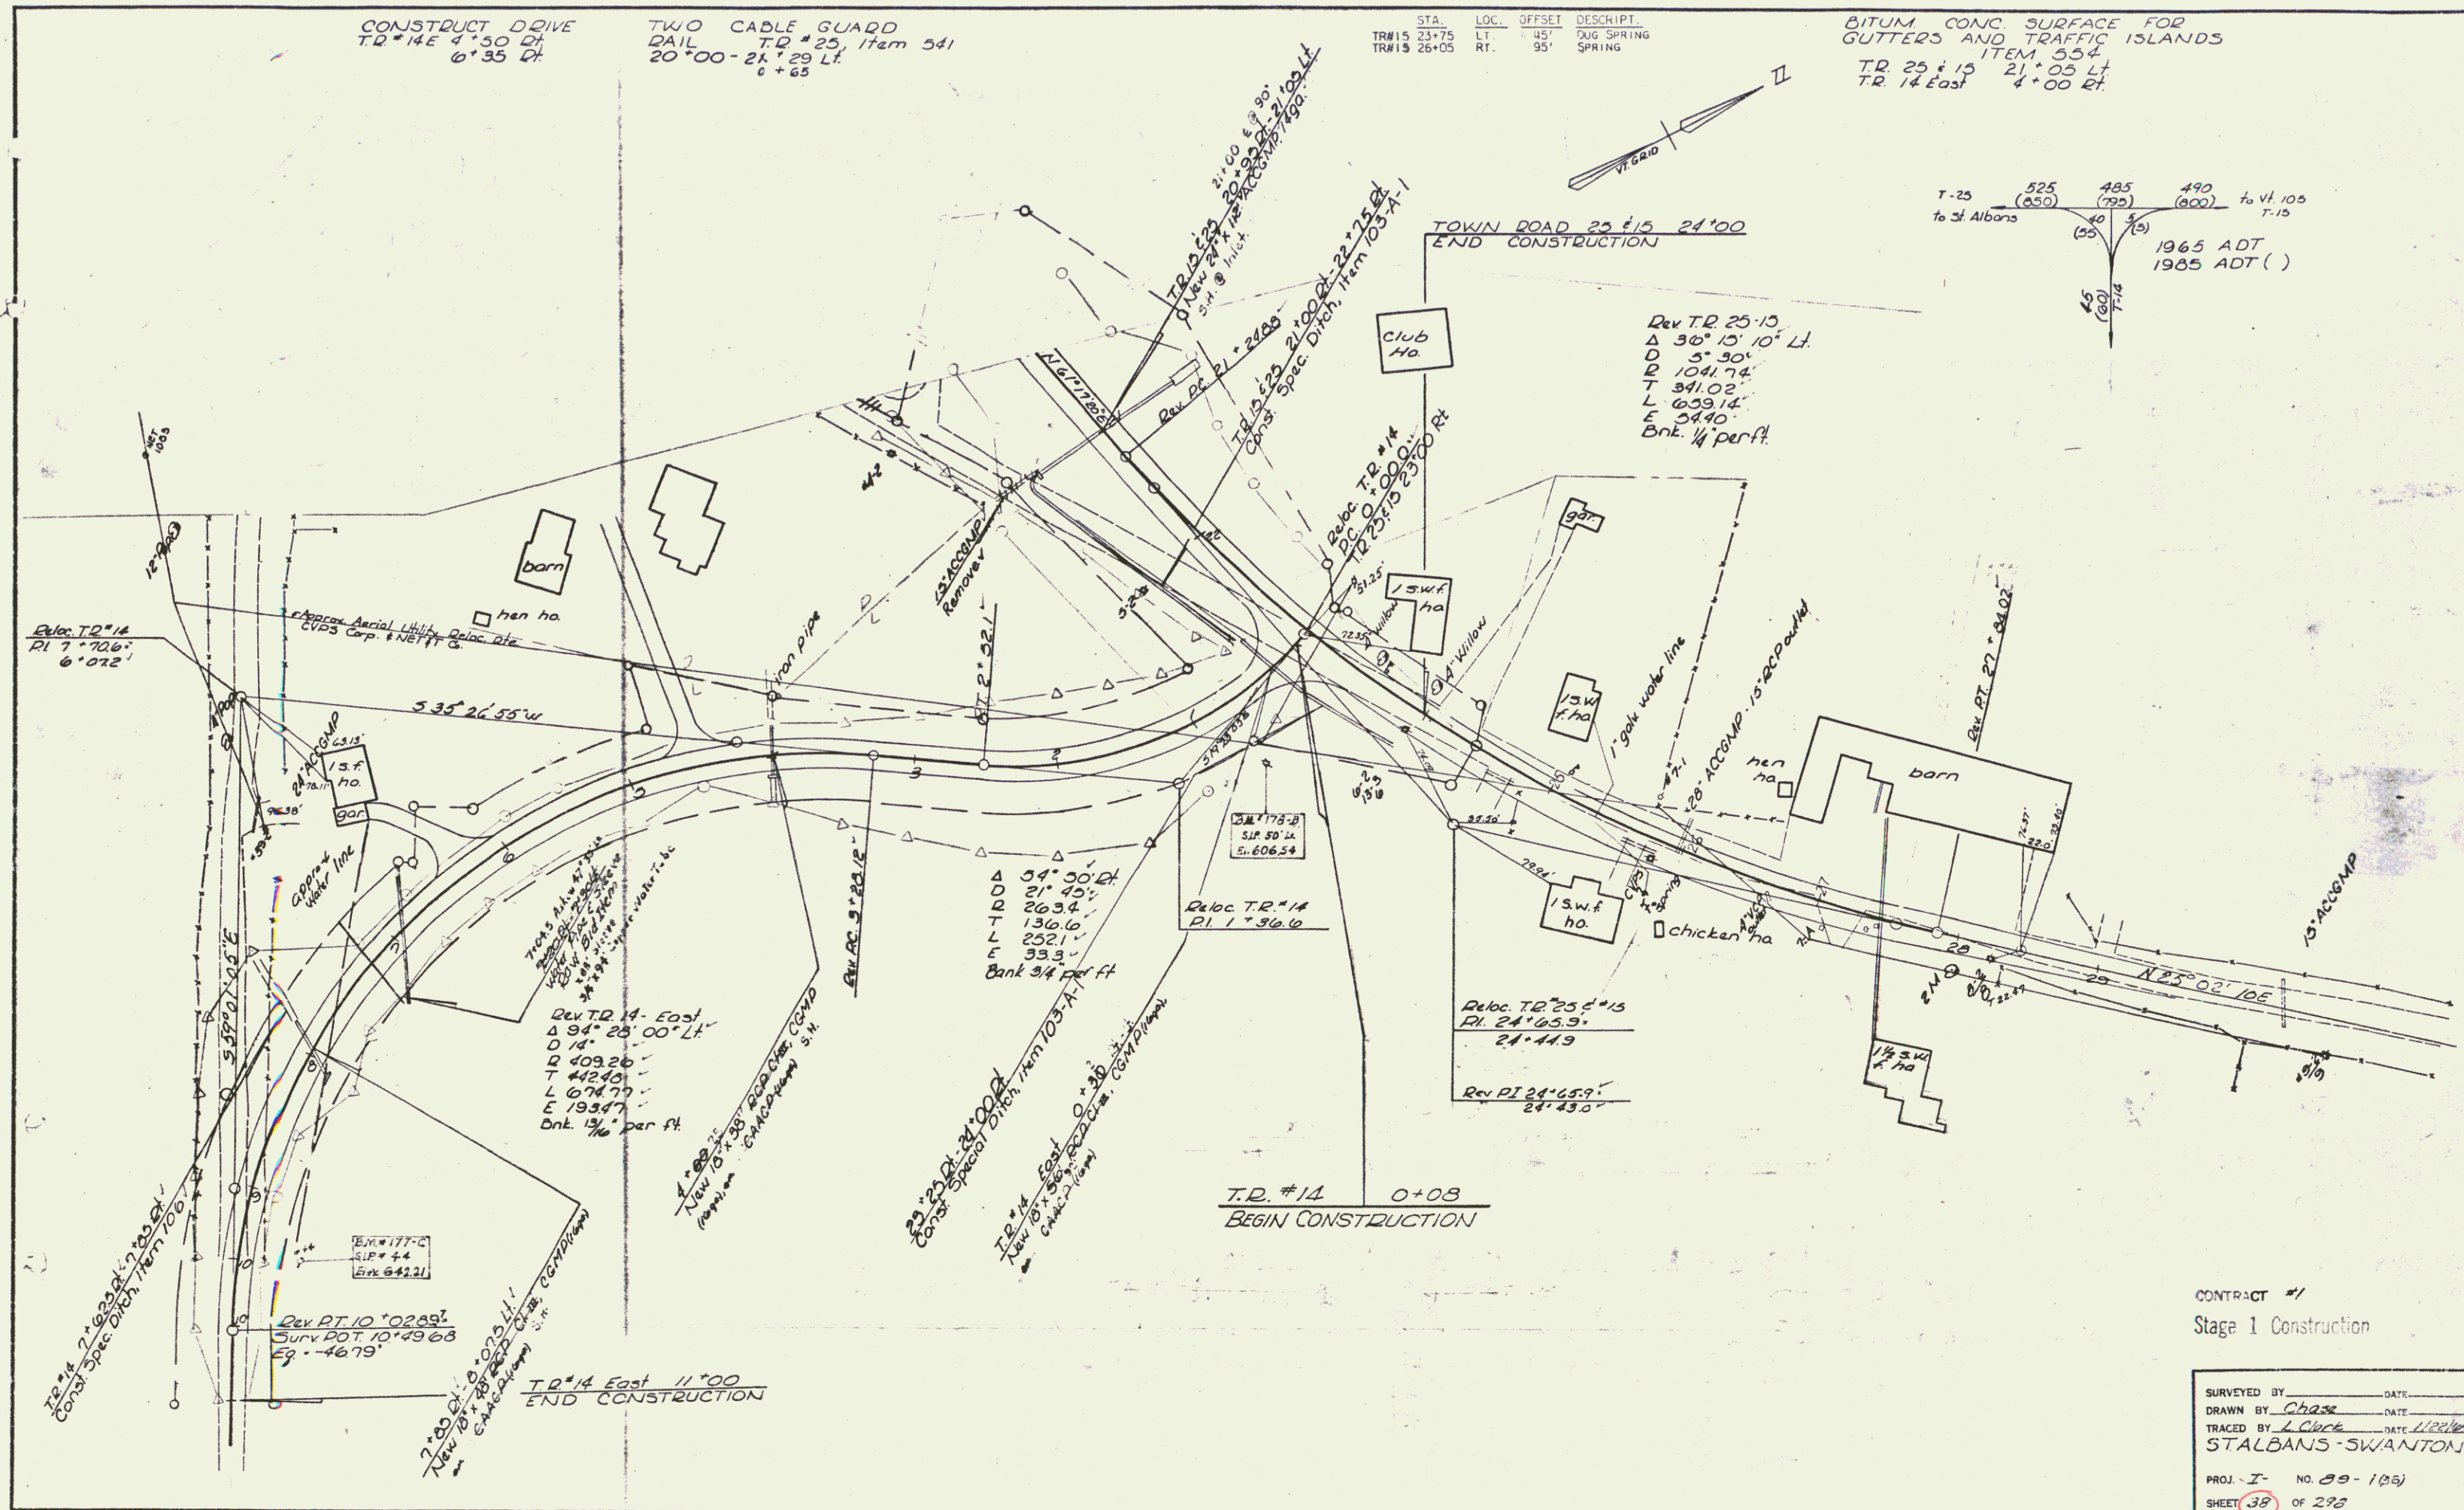

STANDARD STEEL BEAM GUARD
RAIL W/ STEEL POSTS
S.B. 3492+13 - 3494+27 Lt.
S.B. 3492+13 - 3494+27 Rt.
N.B. 3492+13 - 3494+27 Lt.

* STANDARD STEEL BEAM
GUARD RAIL W/ STEEL POSTS
S.B. 3492+13 - 3494+27 Lt.
S.B. 3492+13 - 3494+27 Rt.
N.B. 3492+13 - 3494+27 Lt.

* BITUM. CONC. SURFACE
FOR GUTTERS AND
TRAFFIC ISLANDS - ITEM 554
3494+75 - 3495+100 Med.
3495+25 - 3498+50 Med.
3501+75 - 3502+100 Med.
3505+75 - 3506+100 Med.


PROPERTY LINE FENCE, ITEM 555-II, MOD.
3492+00 Lt. - 3508+100 Lt.
3492+00 Rt. - 3494+50 Rt.
3496+00 Rt. - 3508+00 Rt.

STA.	LOC.	OFFSET	DESCRIPT.
BL 3498+50	RT.	500'	DUG SPRING
BL 3499+75	RT.	800'	SPRING
BL 3504+00	RT.	1500'	DUG SPRING
BL 3506+00	RT.	1500'	SPRING

STANDARD STEEL BEAM GUARD RAIL
W/ STEEL POSTS, ITEM 545-A
Spacing of Posts - 12'-6"
N.B. 3495+55 - 3495+47 Rt.

* STAGE TWO CONSTRUCTION ITEMS

PLAN
STATION
ELEVATION
REMARKS
DATE
BY
CHECKED
DATE
BY

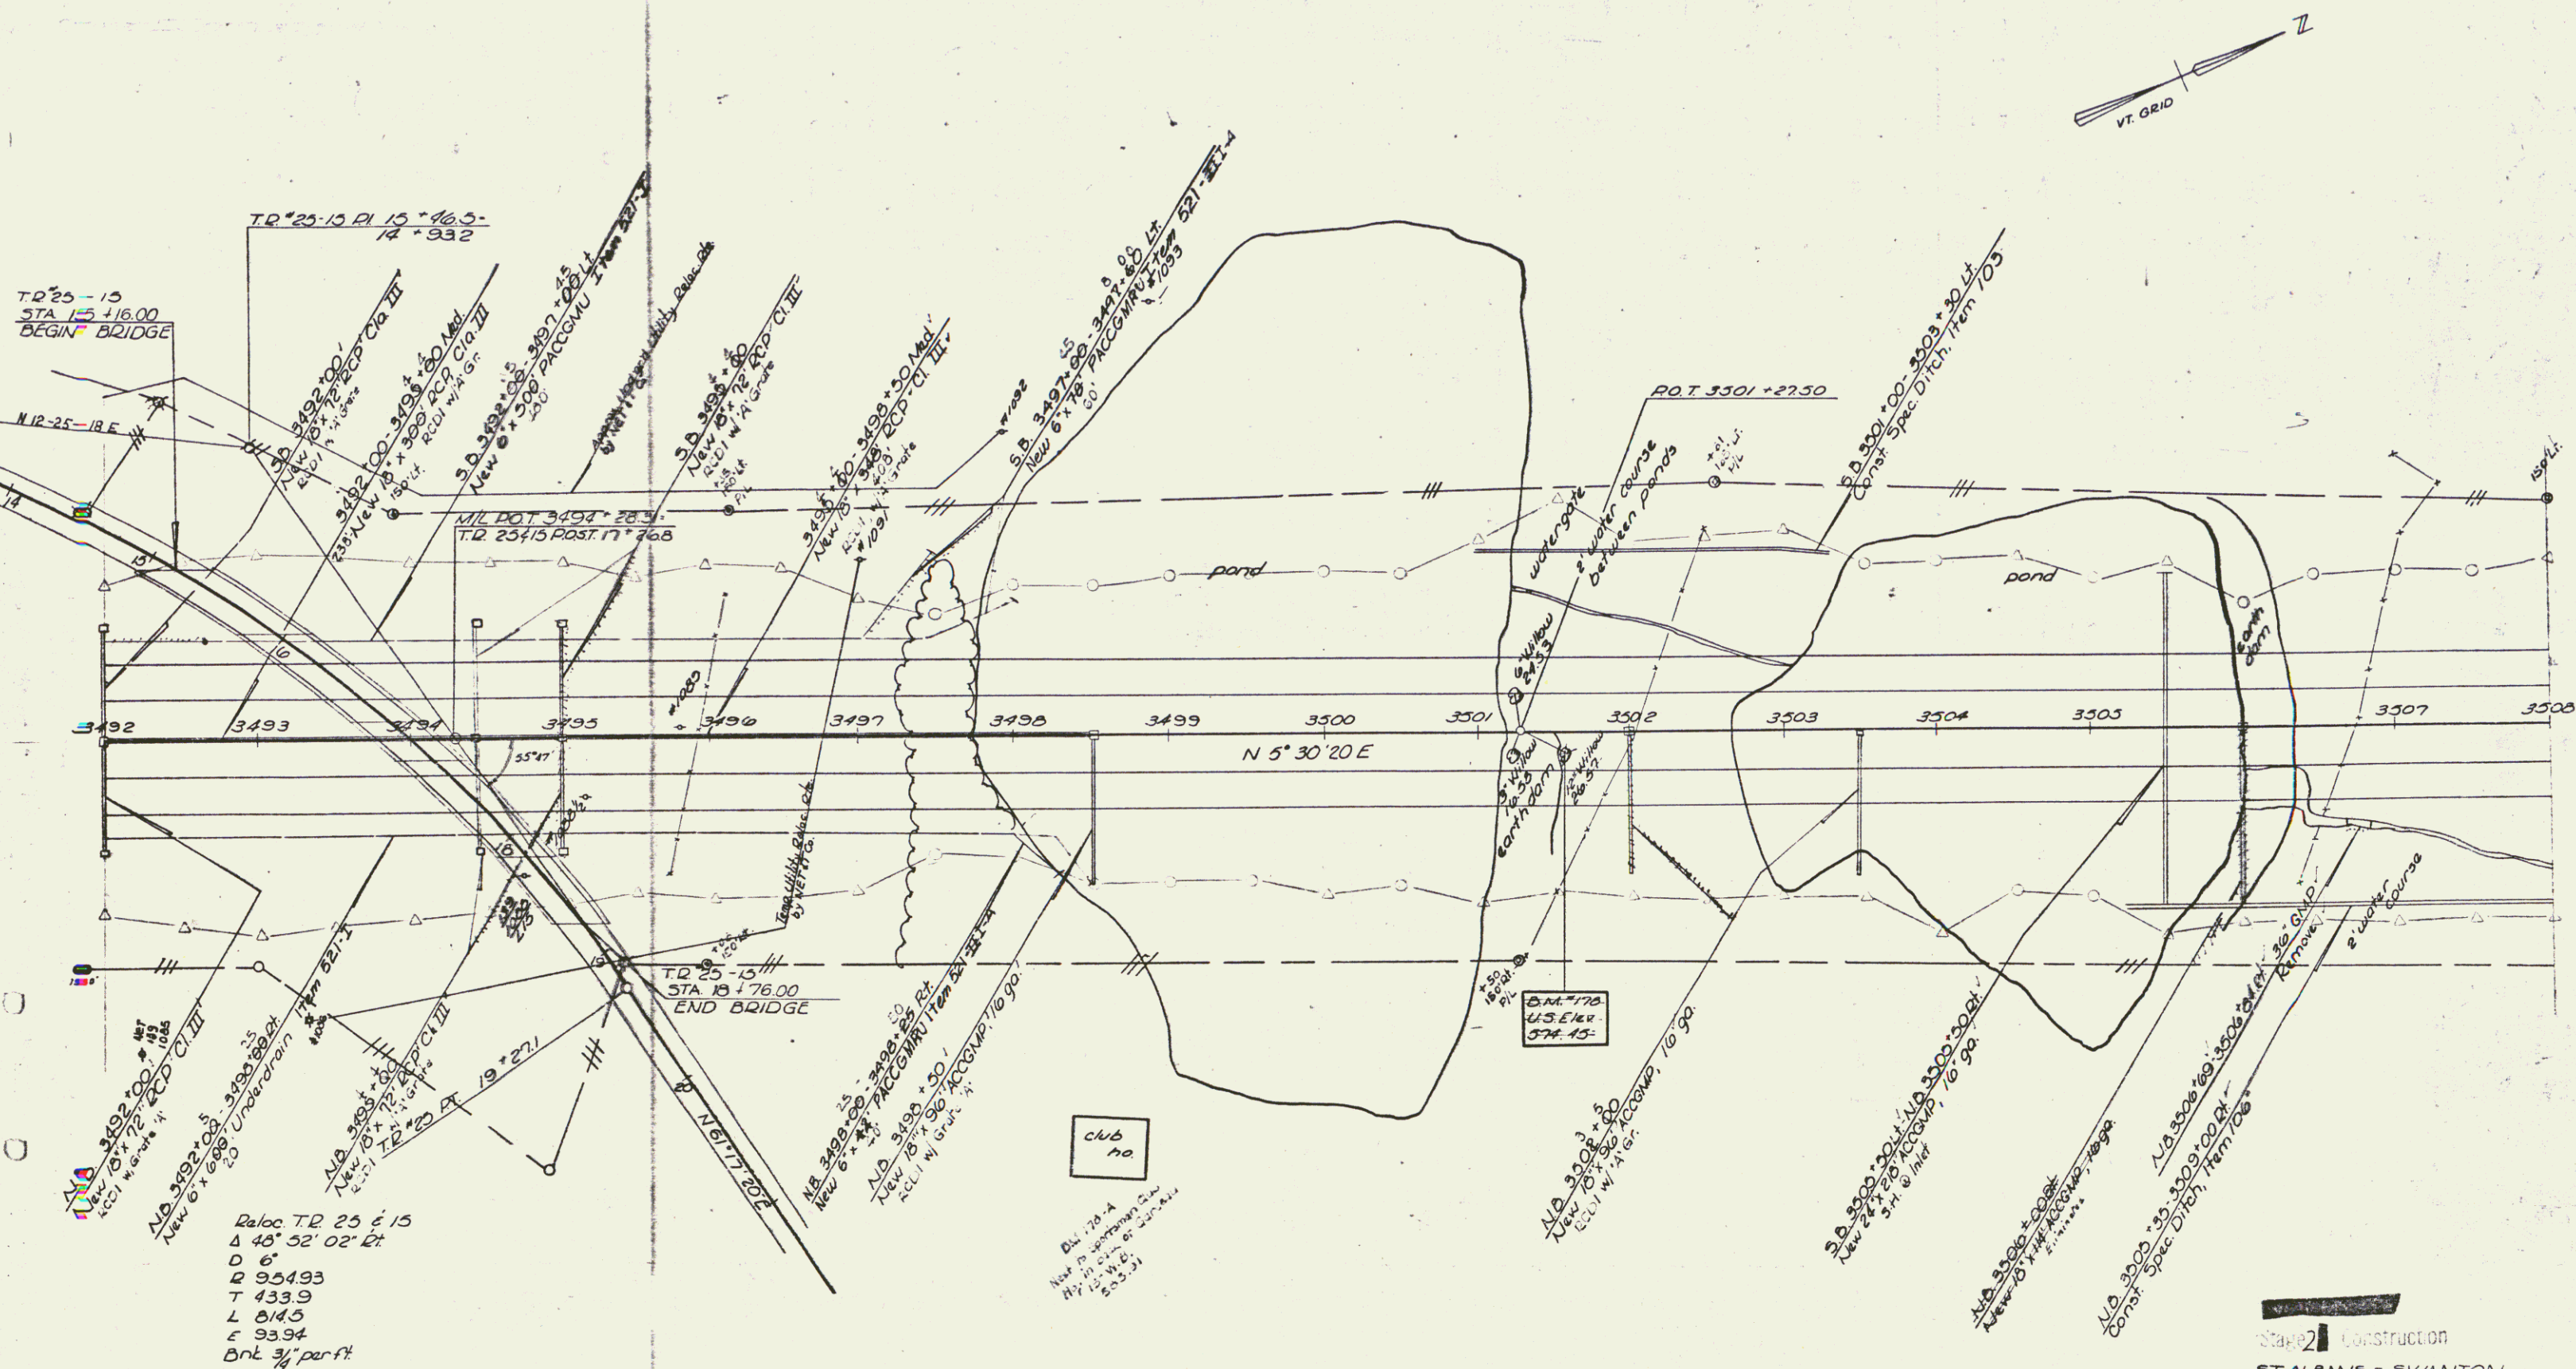

CONTROL OF ACCESS IS
COMPLETE ON THIS SHEET

STAGE 2 Construction
ST. ALBANS - SWANTON
I 89 - 3494
Sheet 34 of 53

PLAN	SURVIVED	DATE
NOTE DONE	PLANTED/TRACE	1-5/63
NO	ALIGN: CHECKED	5/16/63
	ROW: CHECKED	
	3/2/63	
	1. CLARK	


* STAGE II CONSTRUCTION ITEM

* BITUMINOUS CONE SURFACE
FOR GUTTERS & TRAFFIC
ISLANDS ITEM 554 -
3508 + 75 - 3509 * 00 Med.
3511 + 21 - 3511 * 46 Med.
3513 + 75 - 3514 * 00 Med.
3519 + 75 - 3520 * 00 Med.

BJ. 4 179
24"E 577' L.P.
E. 578.72

PROPERTY LINE FENCE
ITEM 583-II, MOD.
3508 + 00' - 3524 + 00' 4"
3508 + 00' - 3524 + 00' 0"

	<u>STA.</u>	<u>LOC.</u>	<u>OFFSET</u>	<u>DESCRIPT.</u>
BL	3509+00	RT.	1'700'	SPRING BOX
BL	3510+00	RT.	1'700'	SPRING BOX
BL	3511+00	RT.	1'700'	SPRING BOX
BL	3512+00	RT.	1'300'	SPRING BOX
BL	3514+00	RT.	1'200'	WELL
BL	3518+00	RT.	1'700'	SPRING BOX
BL	3519+00	RT.	1'700'	SPRING BOX
BL	3520+00	RT.	1'600'	SPRING BOX
BL	3522+00	RT.	1'900'	SPRING BOX

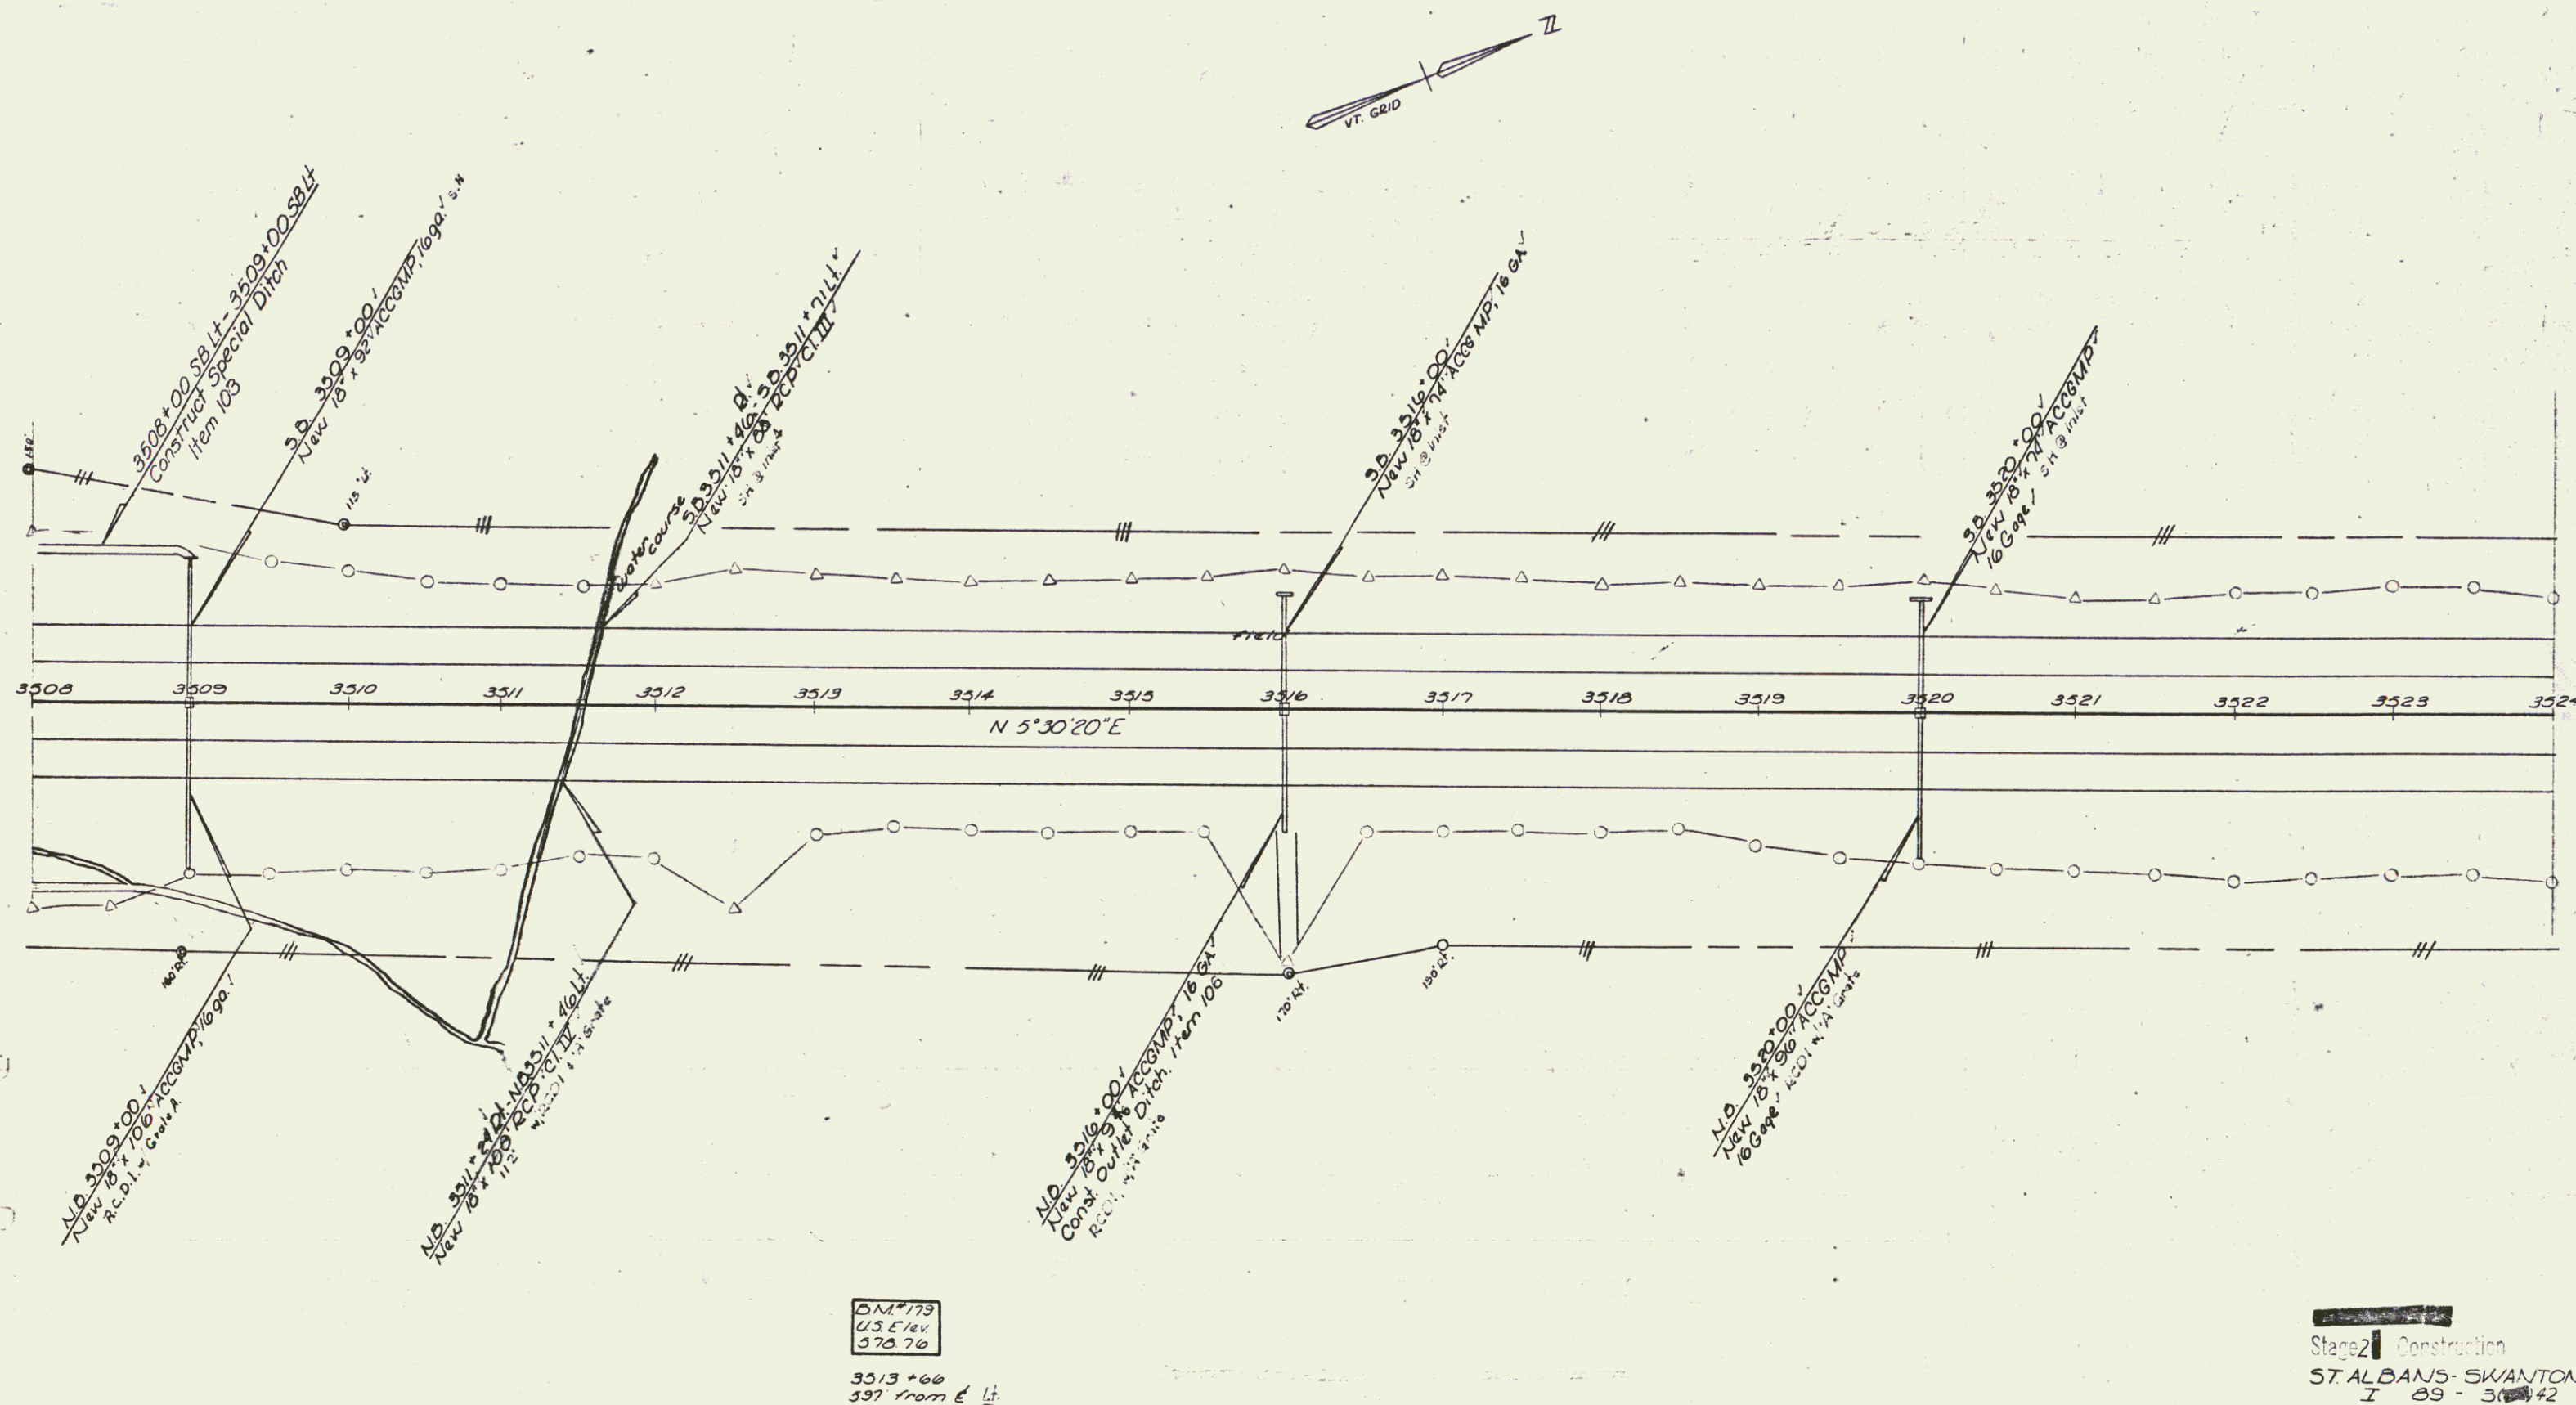

Stage 2 Construction
ST. ALBANS - SWANTON
I 89 - 3(4)42

CONTROL OF ACCESS COMPLETE ON THIS SHEET Sheet 38 of 153

PLAN	REVISIONS	DATE	BY	CHKD
1	1	10/1/89	J. Albano	J. Albano
2	2	10/1/89	J. Albano	J. Albano
3	3	10/1/89	J. Albano	J. Albano
4	4	10/1/89	J. Albano	J. Albano
5	5	10/1/89	J. Albano	J. Albano
6	6	10/1/89	J. Albano	J. Albano
7	7	10/1/89	J. Albano	J. Albano
8	8	10/1/89	J. Albano	J. Albano
9	9	10/1/89	J. Albano	J. Albano
10	10	10/1/89	J. Albano	J. Albano


CONSTRUCT U TURN
@ B.L. 3525+05

* STAGE II CONSTRUCTION ITEM

* BITUM CONC SURFACE FOR
GUTTERS & TRAFFIC ISLANDS
ITEM 503-II, MOD
3525+20-3525+51 Med
3525+75-3529+00 Med
3532+75-3533+00 Med
3536+75-3537+00 Med

PROPERTY LINE FENCE
ITEM 503-II, MOD
3524+00-3540+00 1/2" x 1/2"

STA.	LOC.	OFFSET	DESCRIPT.
BL 3532+00	LT.	1500'	DUG SPRING
BL 3534+00	RT.	1500'	FARM POND
BL 3535+00	RT.	1500'	DUG SPRING
BL 3536+00	RT.	1400'	DUG WELL
BL 3540+00	LT.	600'	DUG WELL

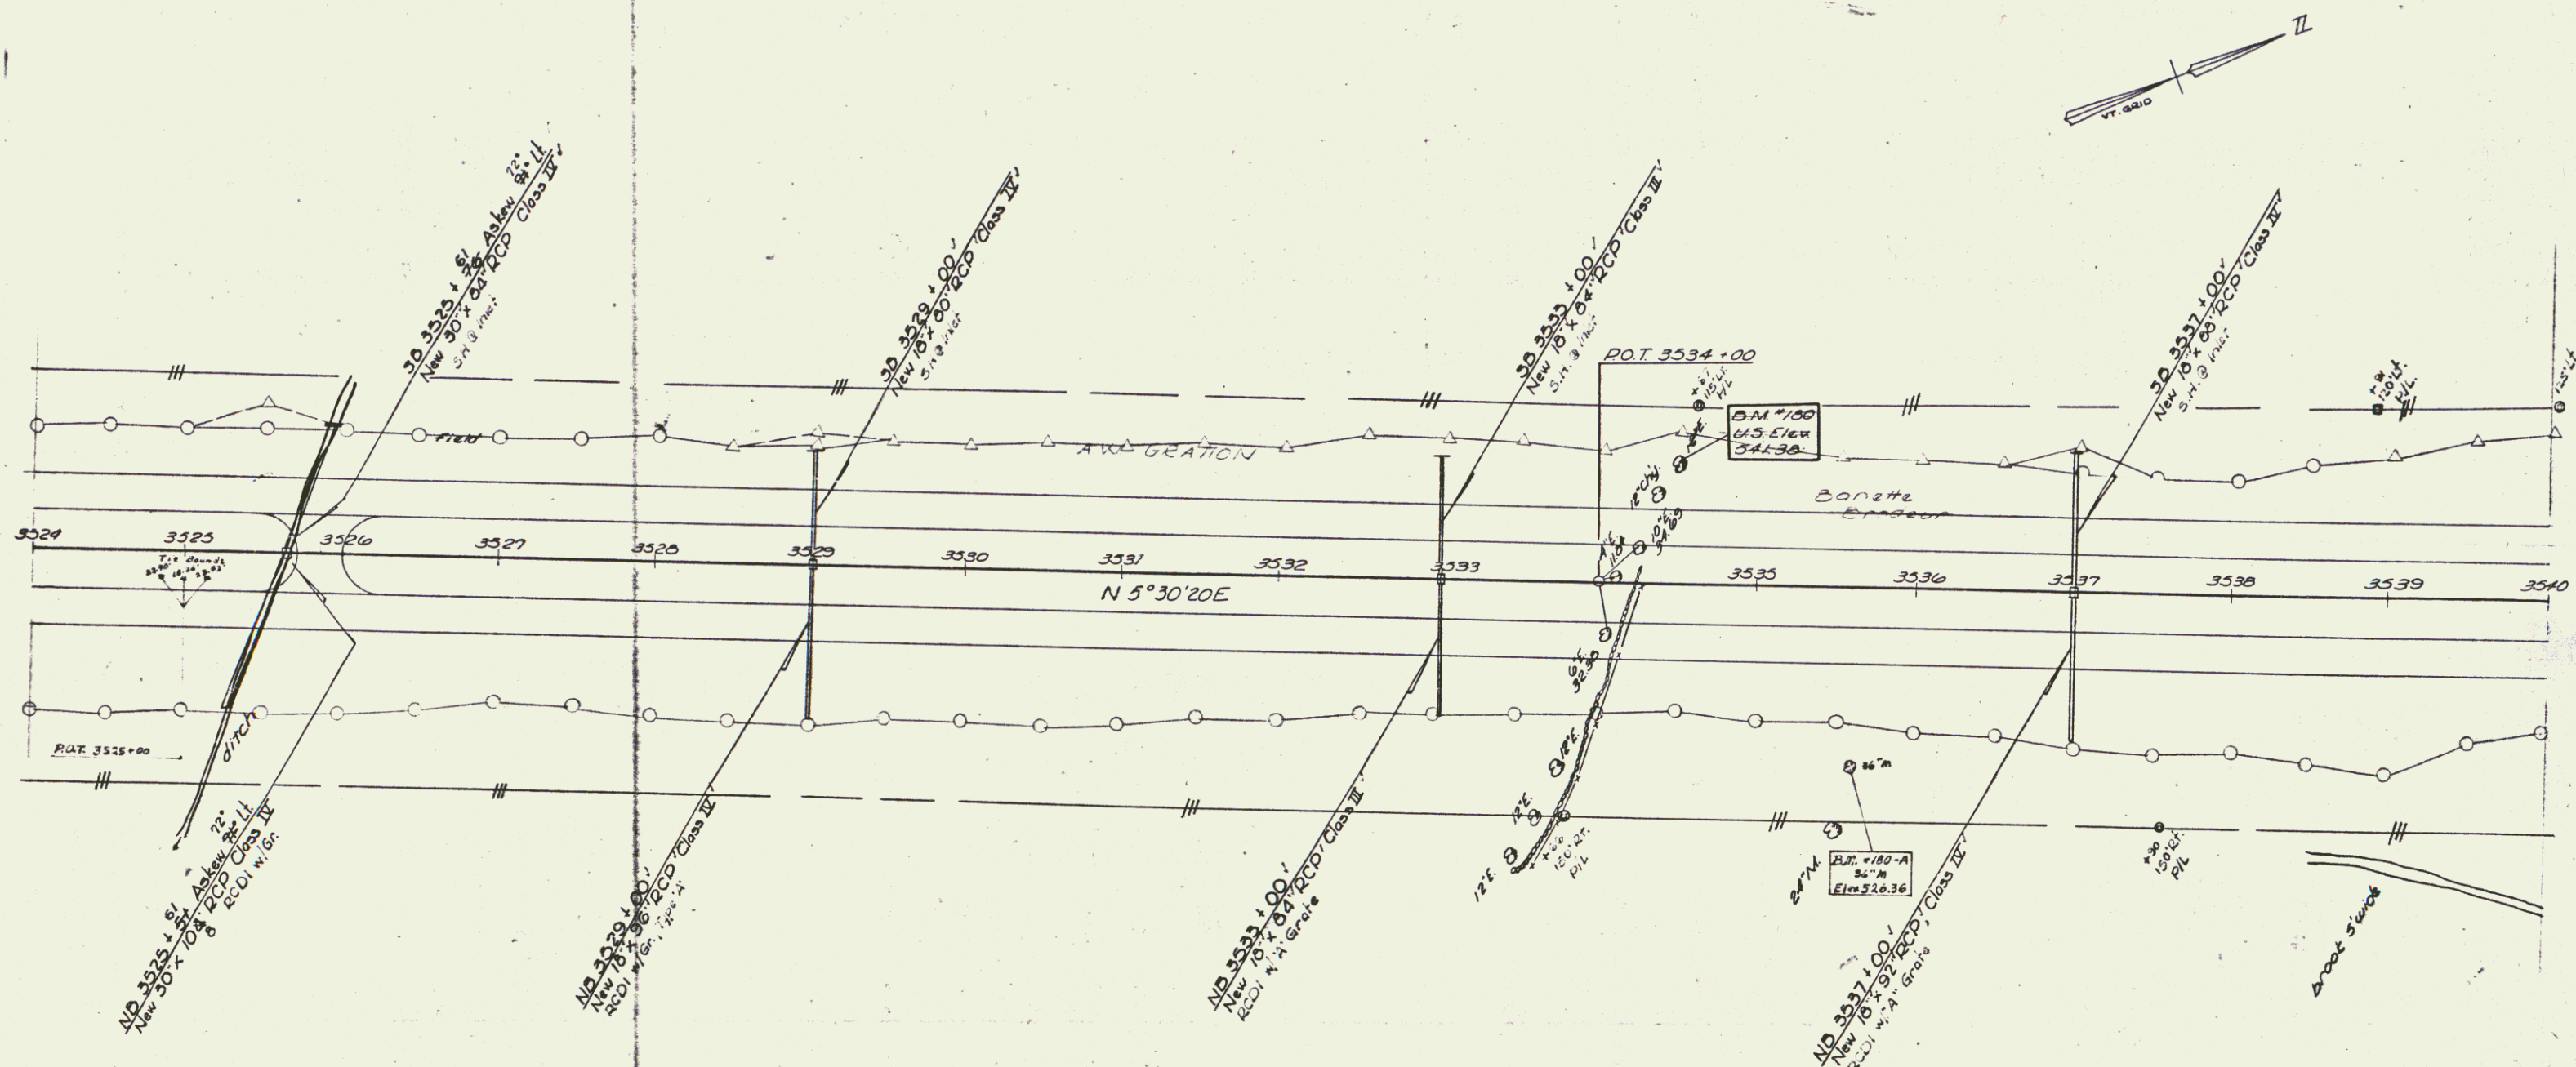

Control of Access is complete on this sheet

Stage II Construction
ST. ALBANS-SWANTON
I 89 - S (1/2) 42
Sheet 42 of 153

PLAN
 DRAWING
 NO. 42
 DATE 10/1/42
 BY J. C. SWANSON
 CHECKED BY J. C. SWANSON
 APPROVED BY J. C. SWANSON

THREE CADLE GUARD RAIL
 W/ STEEL POSTS ITEM 542
 VT 105 5'46" 5'86" LT.
 5'37" 5'77" LT.
 5'61" 12'00" LT.
 8'49" 12'00" LT.

DRILLING AND BLASTING OF
 SOLID ROCK SUBGRADE ITEM 115
 S.B. 3542+50-3546+50

CONSTRUCT DRIVE @
 3+02.5 RT. 3'00" RT.
 4+13 LT.
 3+00 RT.

TREATED TIMBER CURB
 ITEM 550
 VT 105 8'68" 9'01" LT.
 8'48" 9'01" LT.
 5+45 - 5+56 LT.
 5+36 - 5+77 RT.

* BITUM CONC SURFACE FOR
 GUTTERS AND TRAFFIC ISLANDS
 ITEM 554
 3544+30 - 3544+50 Med.
 3543+75 - 3544+00 Med.
 3547+75 - 3548+00 Med.
 3547+75 - 3548+00 S.B. LT.
 3547+75 - 3548+00 N.B. RT.
 VT 105 9+00 RT.
 9+00 LT.


* STANDARD STEEL BEAM
 GUARD RAIL W/ STEEL
 POSTS ITEM 543-A
 N.B. 3545+75 - 3547+57 LT.
 S.B. 3546+20 - 3548+18 RT.

STA.	LOC.	OFFSET	DESCRIPT.
BL 3540+00	LT.	600'	DUG WELL
BL 3540+50	LT.	1400'	DUG WELL
BL 3541+00	LT.	1500'	DUG SPRING
BL 3541+50	LT.	1200'	DUG WELL
BL 3542+00	LT.	900'	DUG WELL
BL 3542+00	LT.	1150'	DUG WELL
BL 3542+00	RT.	2000'	DUG WELL
BL 3542+50	LT.	800'	DRILLED WELL
BL 3542+50	LT.	950'	DRILLED WELL
BL 3543+00	LT.	700'	DUG WELL
BL 3543+00	LT.	750'	DUG WELL
BL 3544+00	LT.	600'	DUG WELL
BL 3544+00	LT.	650'	DUG WELL
BL 3545+00	RT.	700'	DUG WELL
BL 3545+00	RT.	1700'	DUG WELL
BL 3545+00	LT.	340'	DUG WELL
BL 3546+00	RT.	600'	DUG WELL
BL 3546+00	LT.	1300'	DRILLED WELL
BL 3547+00	LT.	1300'	DUG WELL

PROPERTY LINE FENCE
 W/ STEEL POSTS MOD ITEM 583-II
 3540+00 LT. - 3546+00 LT.
 3547+00 LT. - 3552+00 LT.
 3540+00 RT. - 3546+00 RT.
 3548+00 RT. - 3552+00 RT.

* Stage 2 Construction Item

DEMOLITION & REMOVAL OF BUILDINGS
 ITEM 586
 2-A House @ 3547+50 LT.
 2-B Barn @ 3548+10 LT.
 3 Spr. Ho. @ 3549+50 LT.

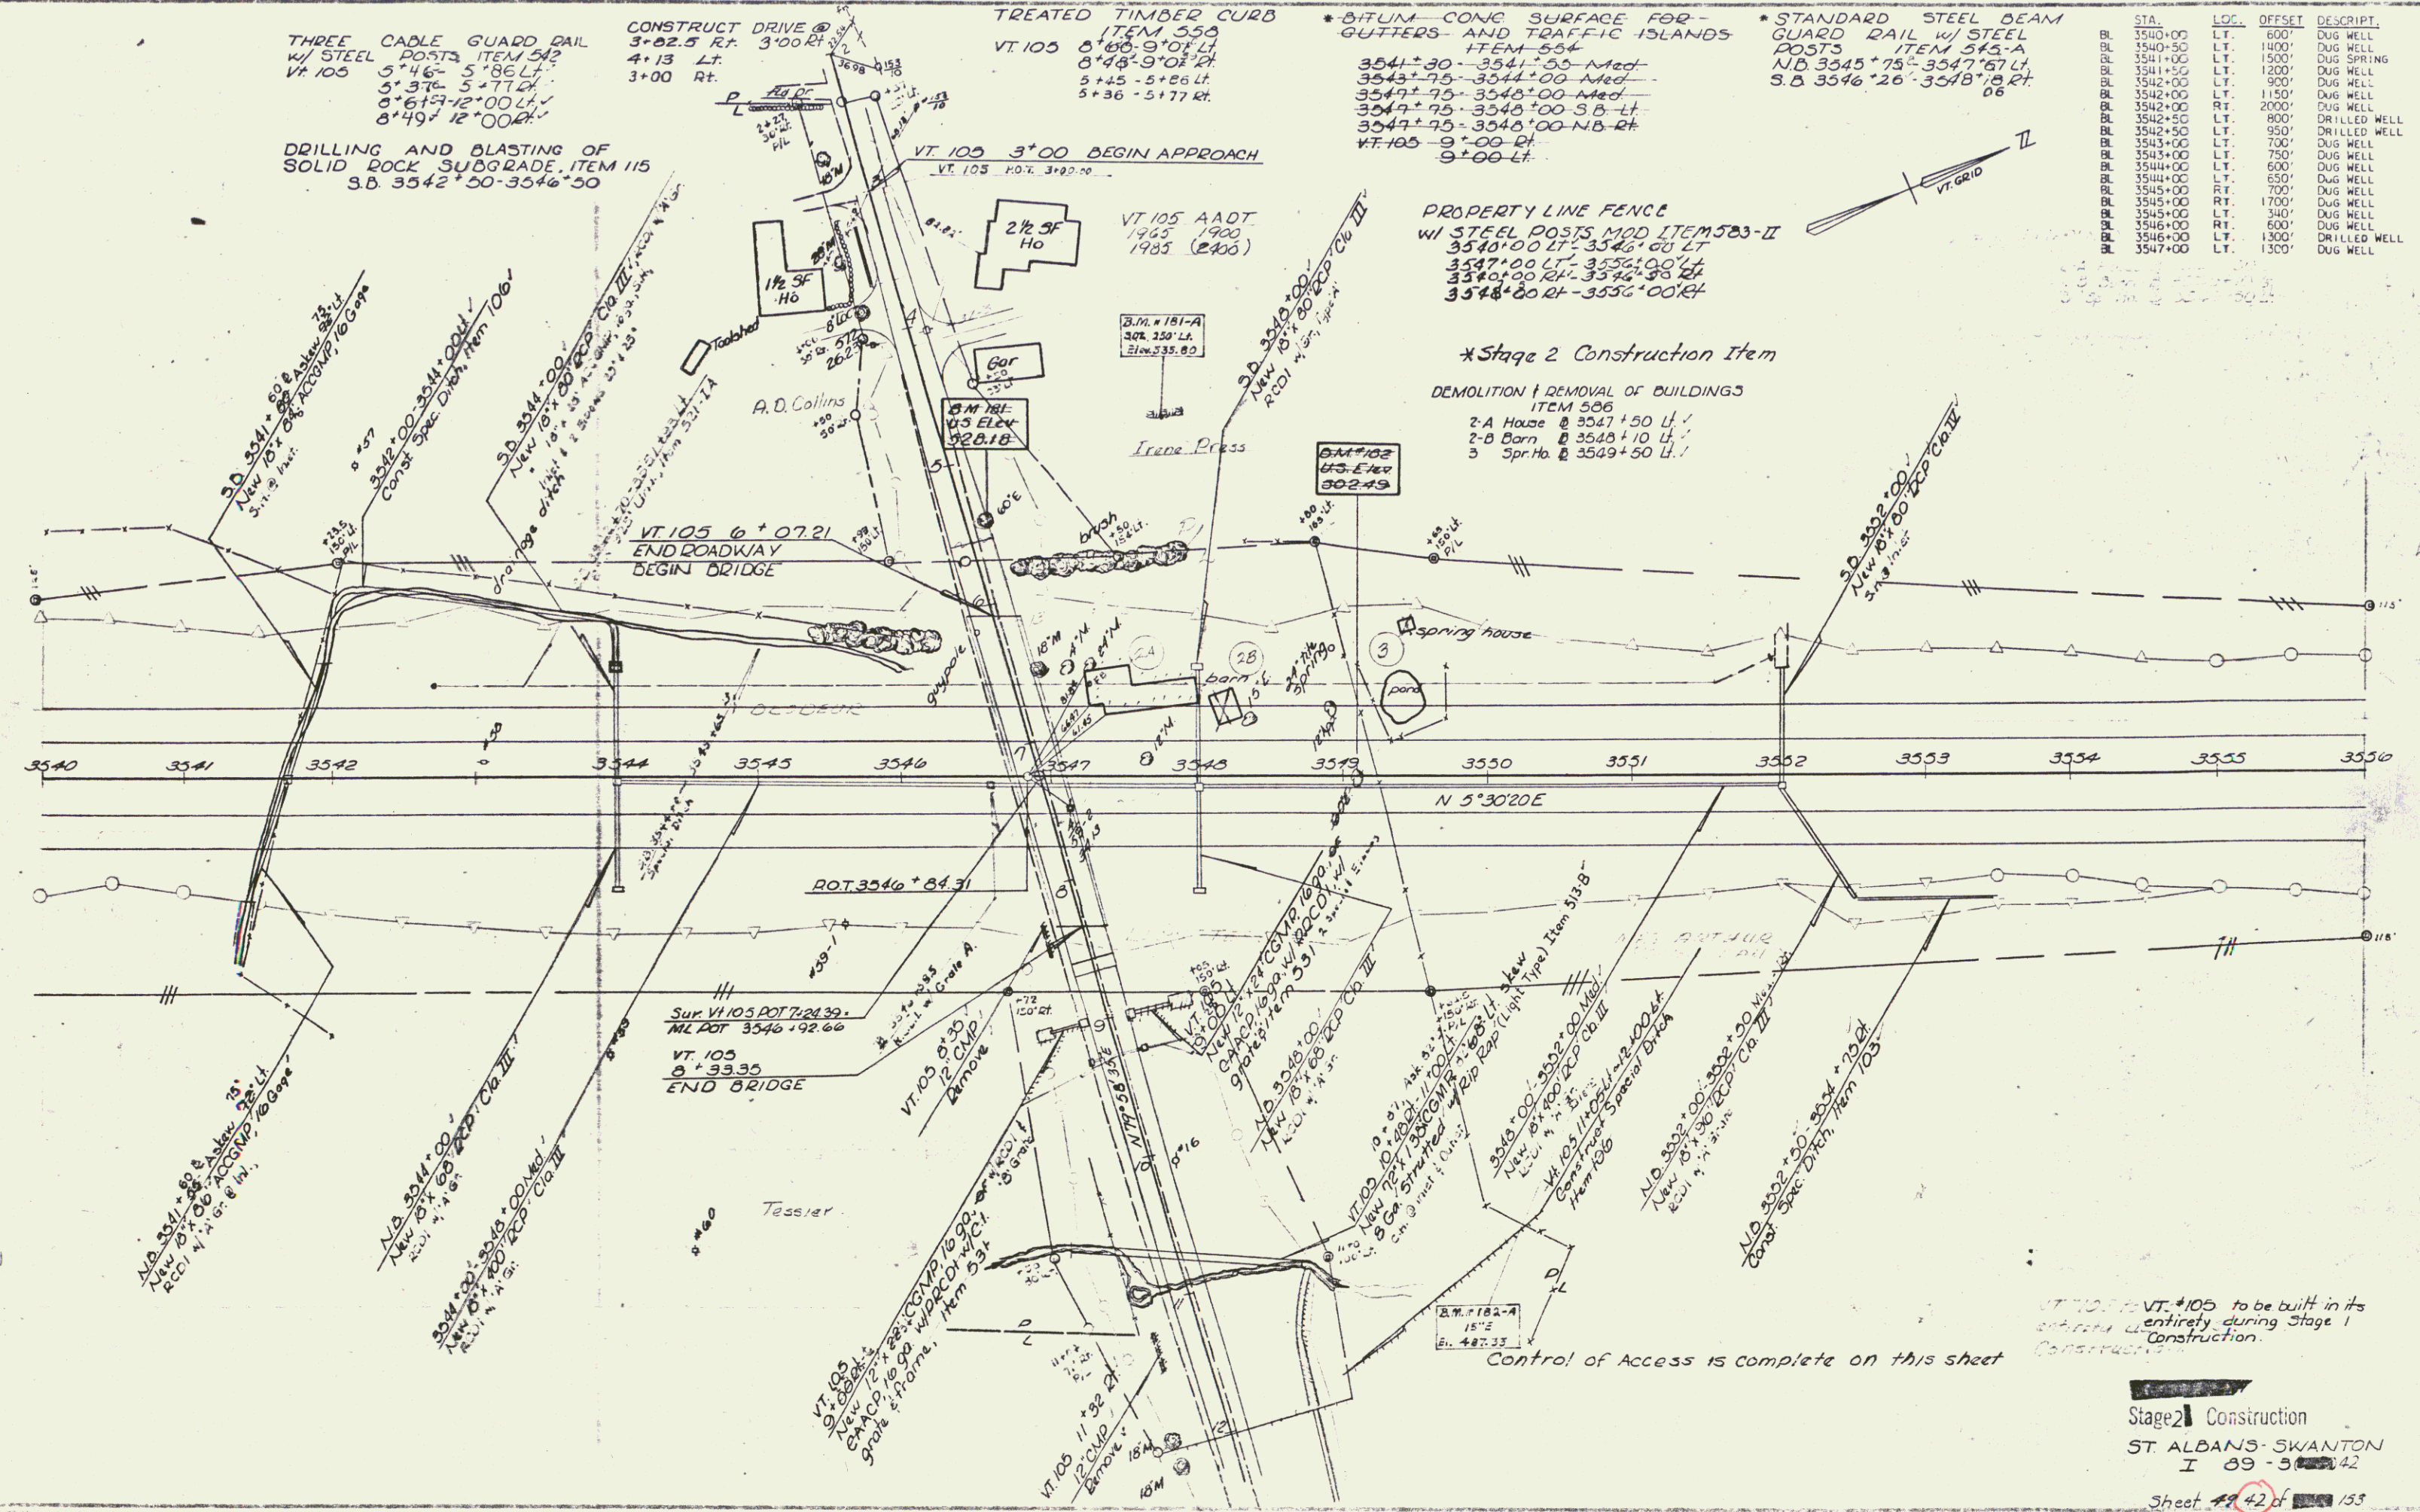

VT 105 to be built in its
 entirety during Stage 1
 Construction.

Control of Access is complete on this sheet

Stage 2 Construction
 ST. ALBANS-SWANTON
 I 89-5042
 Sheet 42 of 153

PLAN	SUBMITTED	DATE
	NOTED	DATE
	NOTED	DATE
	NOTED	DATE


PROFILE	SUBMITTED	DATE
	NOTED	DATE
	NOTED	DATE
	NOTED	DATE

CONSTRUCT DRIVE
13+12 RT

CONSTRUCT DRIVE
13+30 LT
ROW BID ITEM

THREE CABLE GUARD RAIL
w/ STEEL POSTS, ITEM 542
12+00-12+13 LT
12+00-12+25 RT
42

STA.	LOC.	OFFSET	DESCRIPT.
VT. 105 12+75	RT.	125'	DRILLED WELL
VT. 105 12+85	RT.	120'	DUG WELL
VT. 105 13+75	RT.	160'	DUG WELL

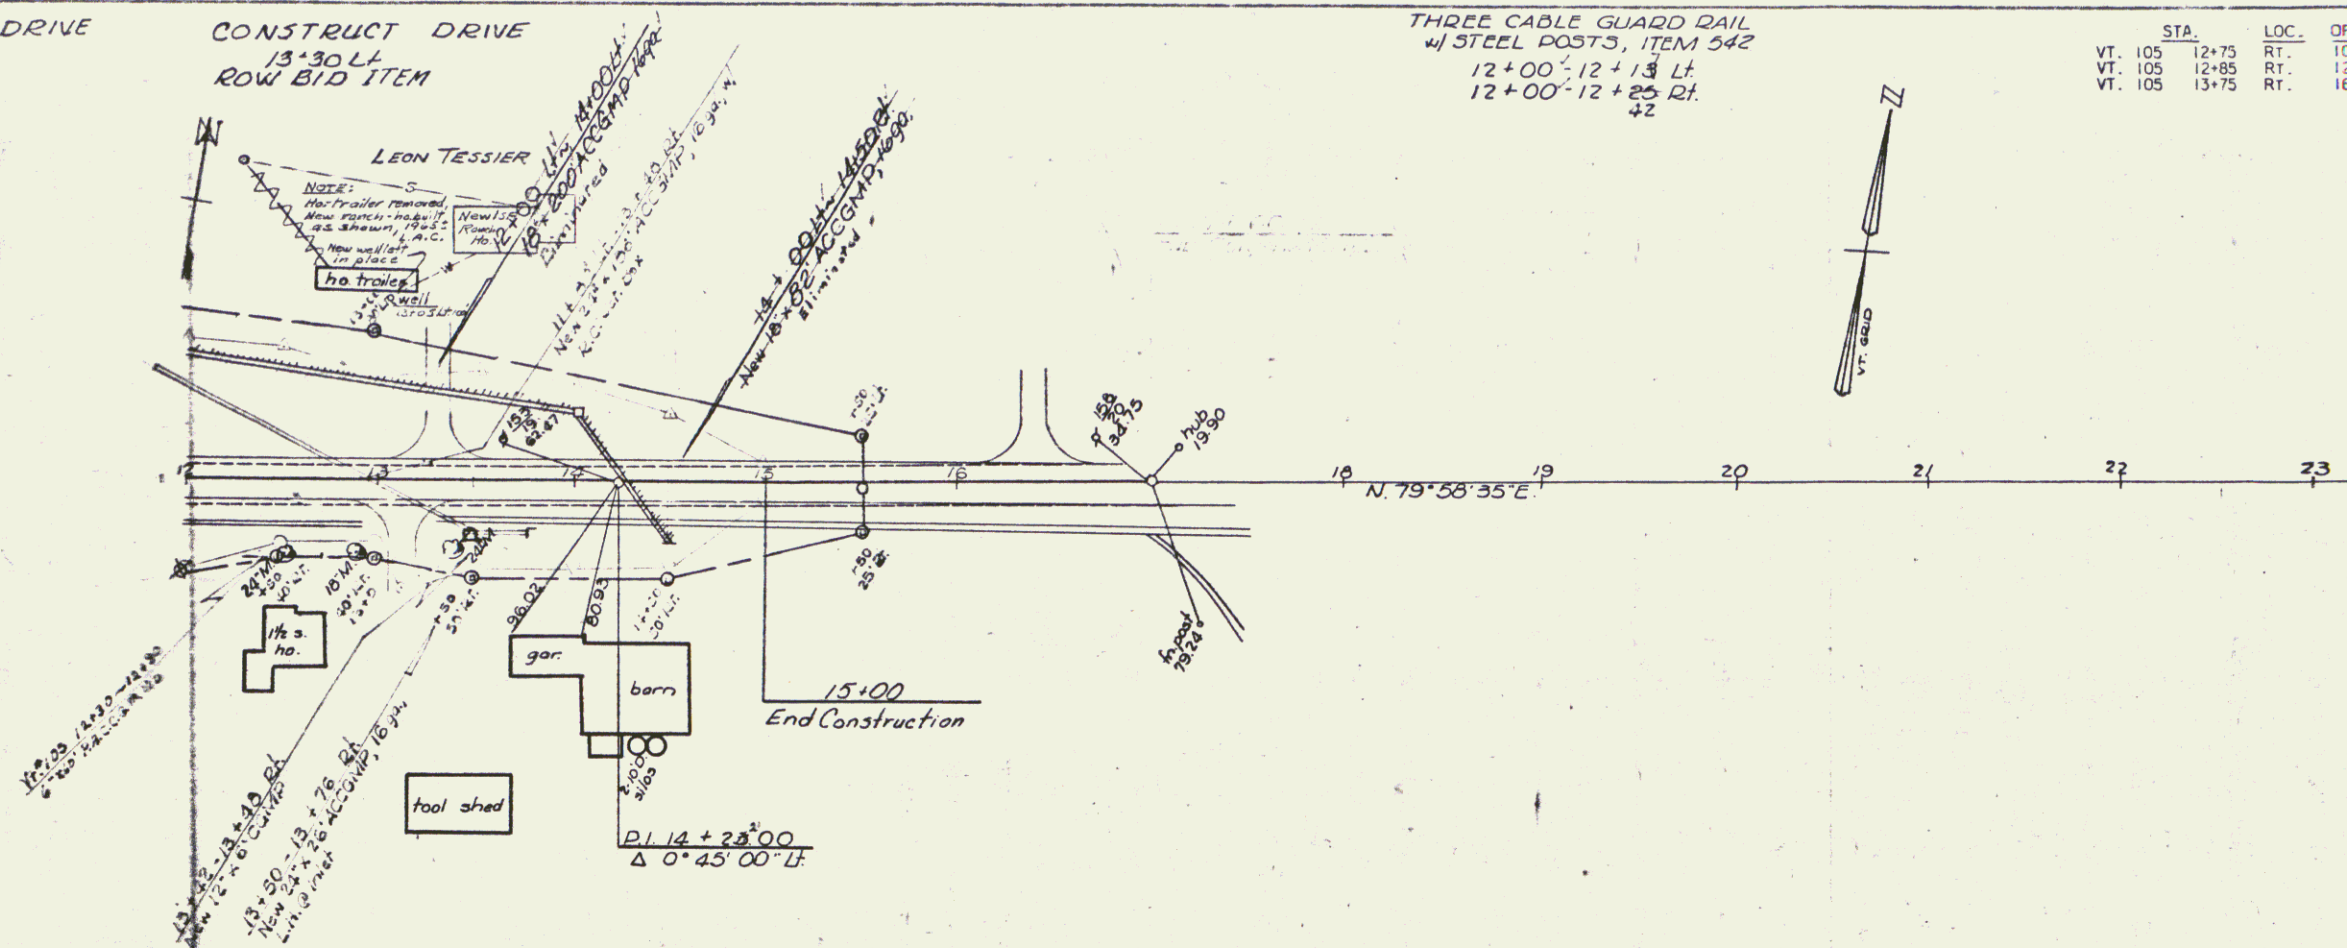

VT 105 to be built in its
entirety during Stage 1
Construction

CONTRACT #1
Stage 1 Construction
VT 105

ST. ALBANS-SWANTON
R 89-3(36)
Sheet 51 of 298


* THREE CABLE GUARD RAIL
W/ LIGHT STEEL POSTS, ITEM 538
NB 3563+74 - 3572+00 R/L

* STAGE II CONSTRUCTION ITEM

* BITUM-CONC. SURFACE
FOR GUTTERS AND TRAFFIC
ISLANDS - ITEM 534
3551+75 - 3552+00 Med
3556+25 - 3556+50 Med
3559+75 - 3560+00 Med
3564+25 - 3564+50 Med
3567+75 - 3568+00 Med
3571+75 - 3572+25 Med

PROPERTY LINE FENCE
ITEM 583 II, MOD
3556+00 - 3572+00 L/R + D/L


PLAN	SECTION	DATE
STANDARD	STANDARD	STANDARD
NOTES	NOTES	NOTES
NO.	NO.	NO.

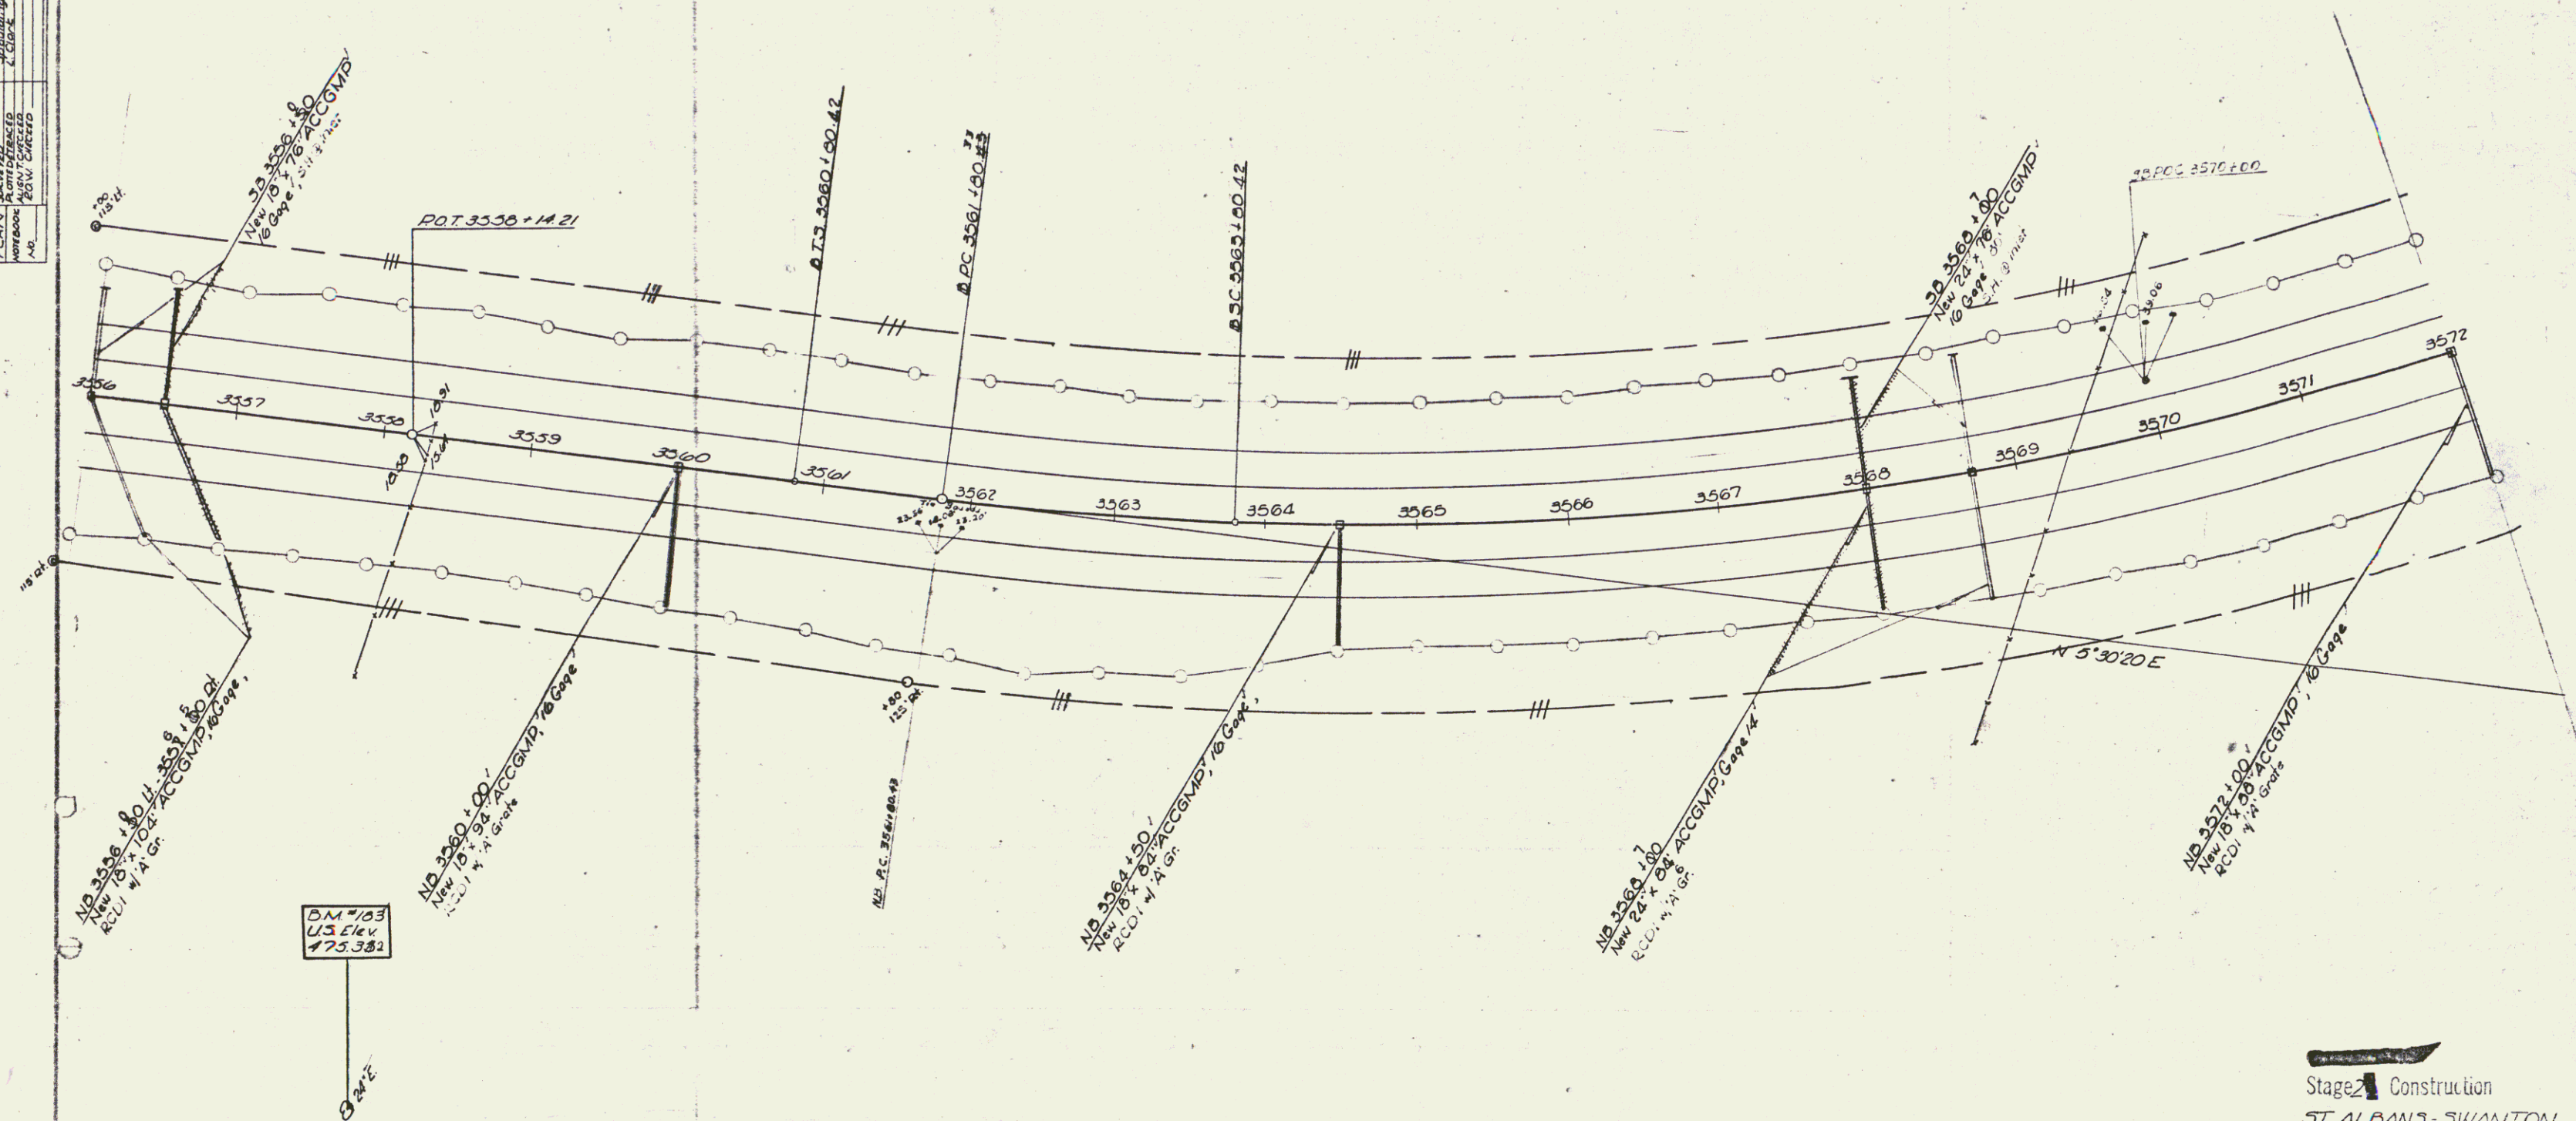

Stage 2 Construction
ST. ALBANS - SWANTON
I 89 - 3 (1) 42
Sheet 44 of 153

61

PLAN
 Surveyed
 1/2" = 100'
 1/4" = 50'
 1/8" = 25'
 1/16" = 12.5'

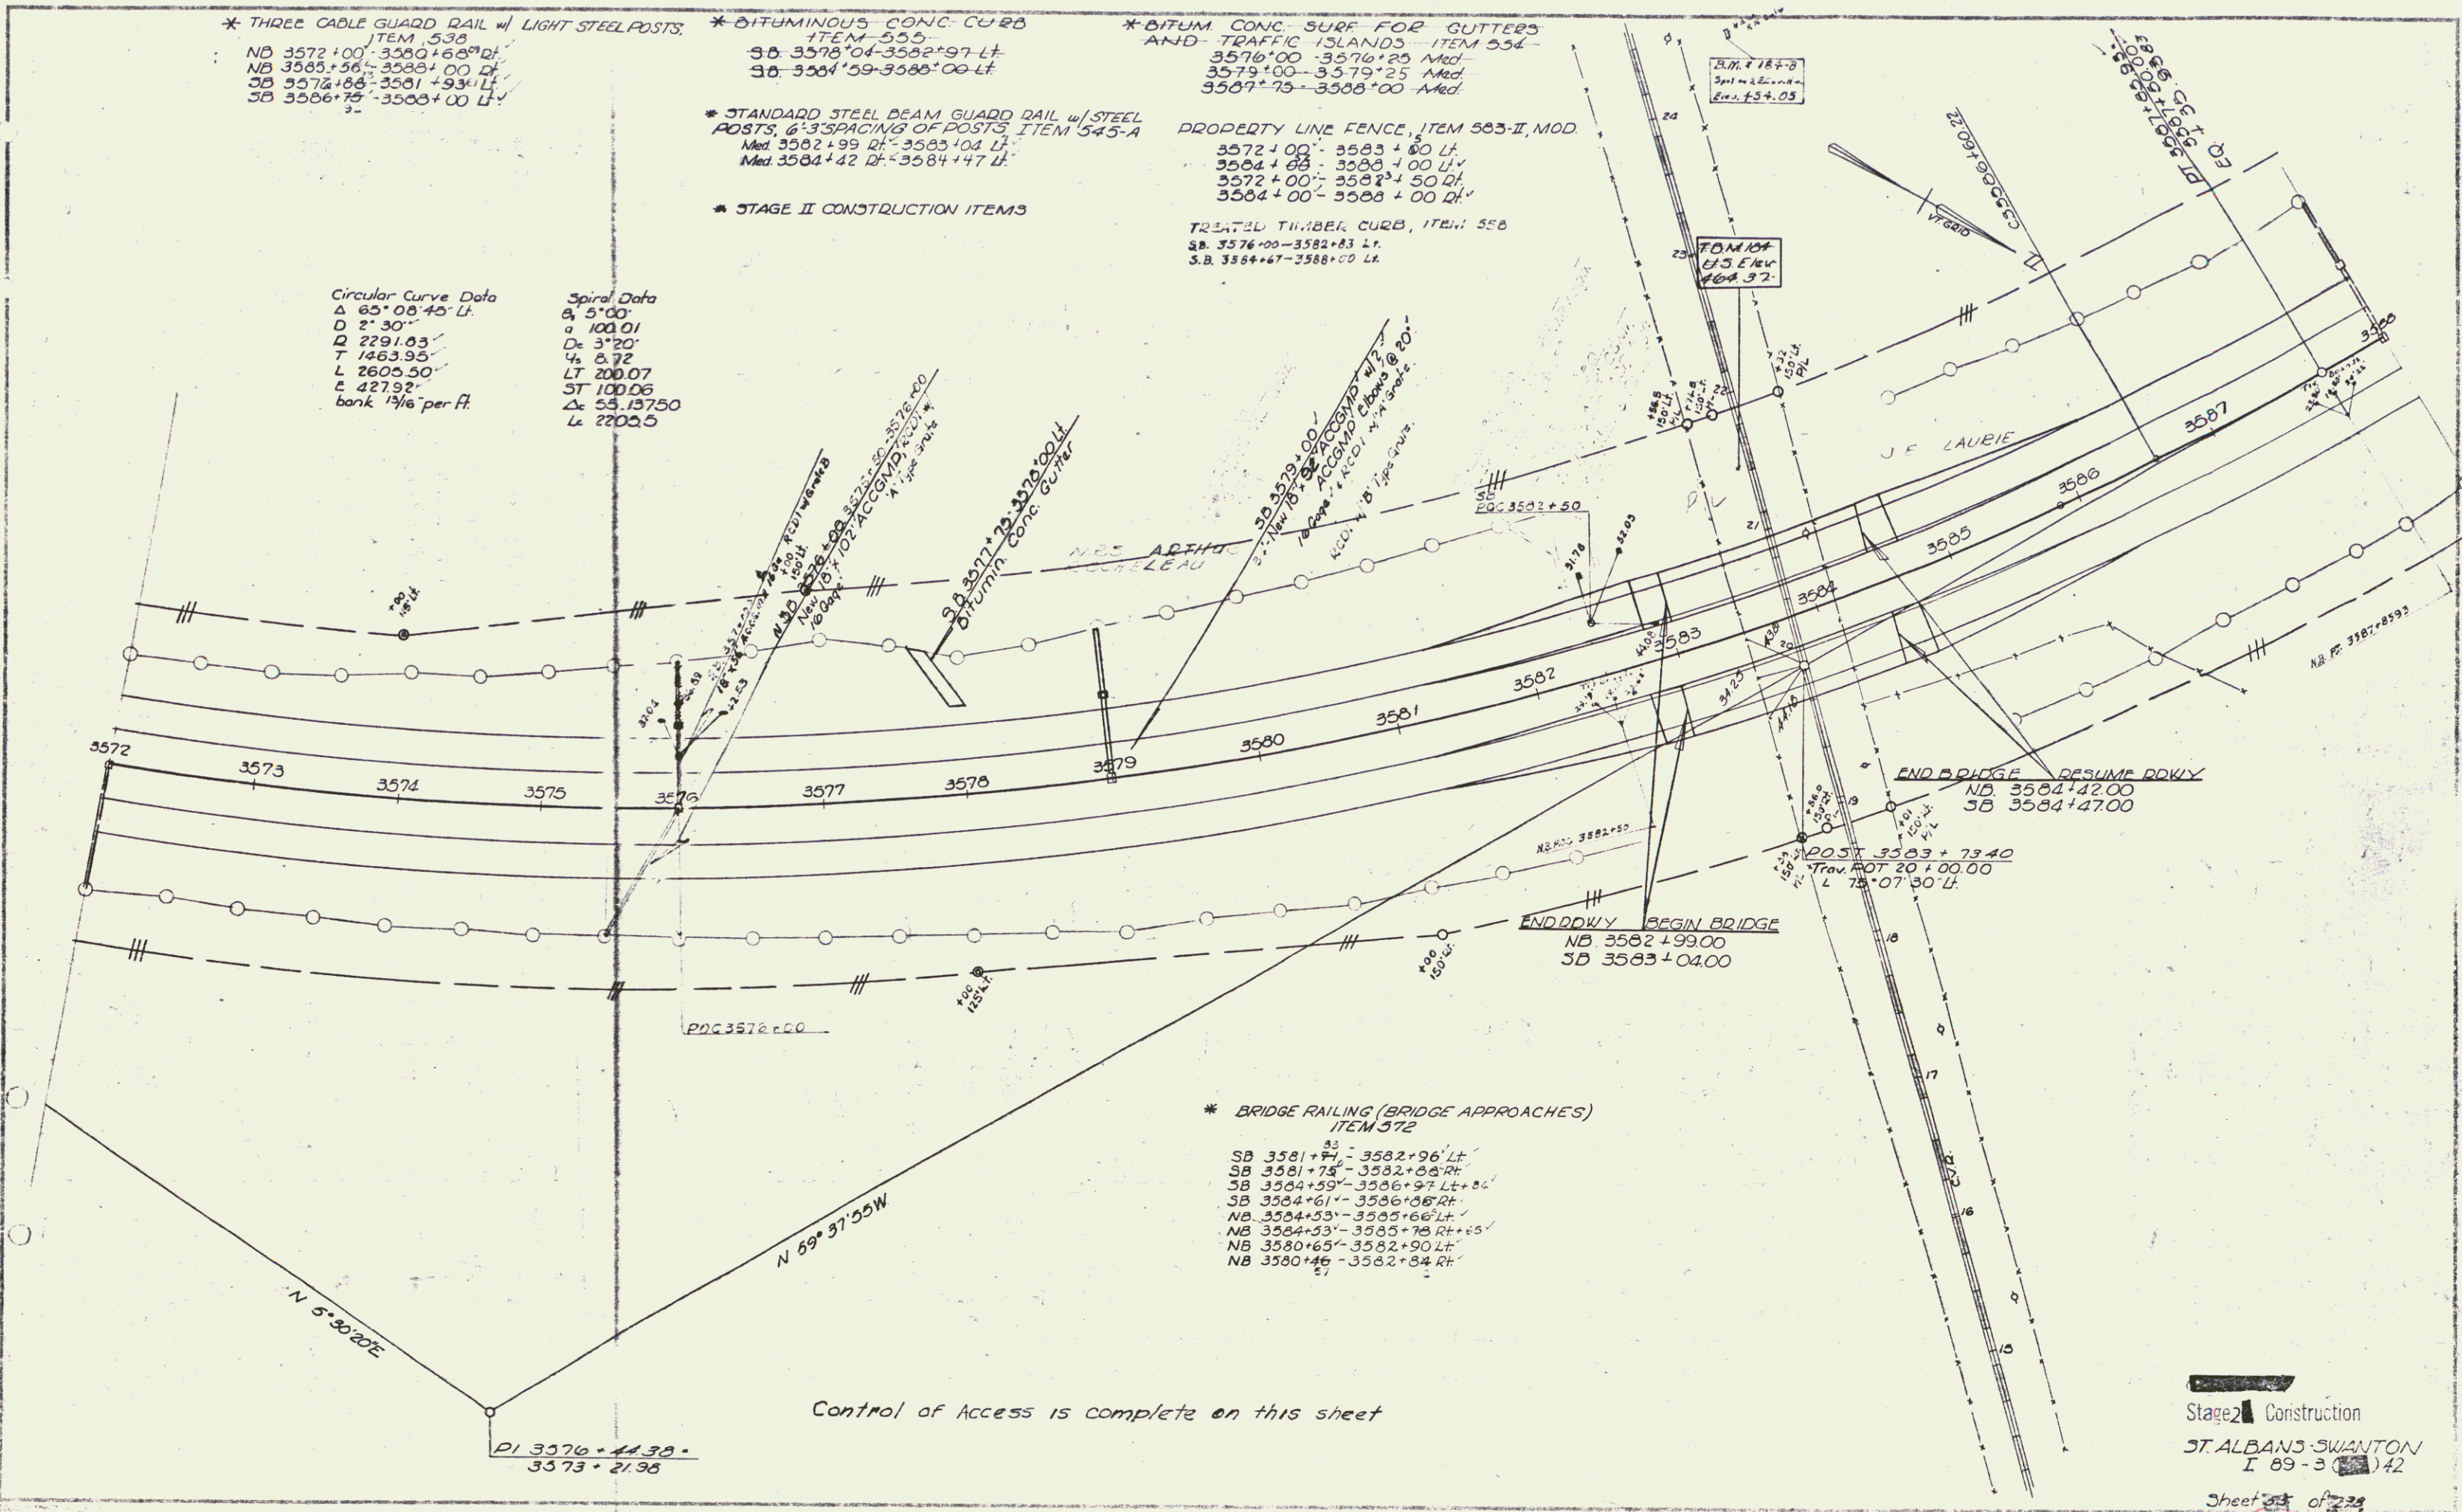

Stage 2 Construction
 ST. ALBANS-SWANTON
 I 89-3 (142)
 Sheet 46 of 48

W/ * THREE CABLE GUARD RAIL
LIGHTSTEEL POSTS, ITEM 538
N.D. 3588 * 00 - 3604 * 00 2/3
S.D. 3588 * 00 - 3603 * 92 LT. ✓
23

~~RIP RAP FOR BANK PROTECTION.~~
~~MOD. FOR CULVERT ENDS, Item 513B~~
~~N.B. 3604 * 00 R.~~

TREATED TIMBER CURB, ITEM 558
SB 3588 + 00 - 3592 + 03


* BITUM. CONC. CURB
-ITEM-555
98-3598*00-3598*0114

PROPERTY LINE FENCE
ITEM 583-II, MOD.
3588 + 00 Lt. ~ 3604 + 00 Lt.
3588 + 00 Rt. ~ 3604 + 00 Rt.

*BITUM CONC SURF FOR
GUTTERS AND TRAFFIC
ISLANDS ITEM 554

3591*75	3592*00	Med
3590*75	3596*00	Med
3599*75	3600*00	Med
3602*92	3603*17	Med
58 3588*00	3592*23	LS

★ STAGE II CONSTRUCTION ITEM

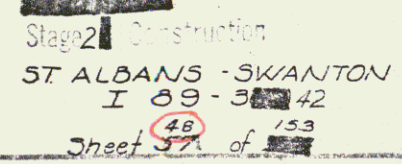

CONTROL OF ACCESS COMPLETE
ON THIS SHEET

* STANDARD STEEL BEAM
GUARD RAIL W/ STEEL
POSTS, ITEM 545-A
N.B. 3617+98 - 3619+52 Rt.
S.B. 3619+38 - 3620+00 Lt.

DRILLING AND BLASTING
SOLID ROCK SUBGRADE
ITEM 115
N.B. 3607+50 - 3609+00
* THREE CABLE GUARD RAIL W/ LIGHT
STEEL POSTS, ITEM 538
N.B. 3604+00 - 3604+49 Rt.


21P-RAP FOR BANK PROTECTION
FOR CULVERT ENDS, Item 513-B
S.B. 3619+30 Lt.
N.B. 3619+00 Rt.
PROPERTY LINE FENCE
ITEM 553, II, MOD.
3604+00 Lt. - 3620+00 Lt.
3604+00 Lt. - 3620+00 Lt.

* BITUM CONC. SURF FOR
GUTTERS AND TRAFFIC
ISLANDS, ITEM 554
3609+75 - 3610+00 Med.
3609+75 - 3610+00 S.B. Lt.
3609+75 - 3610+00 N.B. Rt.
3613+75 - 3614+00 Med.
3617+75 - 3618+00 Med.

STA.	LOC.	OFFSET	DESCRIPT.
BL 3613+00	RT.	600'	FARM POND
BL 3614+00	LT.	2000'	DUG WELL
BL 3618+00	LT.	1500'	DUG SPRING

* STAGE II CONSTRUCTION ITEM


PLAN	REVISION	DATE	BY	CHKD
1	1	10/1/42	J.E. LAURIE	
2	2	10/1/42	J.E. LAURIE	
3	3	10/1/42	J.E. LAURIE	
4	4	10/1/42	J.E. LAURIE	
5	5	10/1/42	J.E. LAURIE	
6	6	10/1/42	J.E. LAURIE	
7	7	10/1/42	J.E. LAURIE	
8	8	10/1/42	J.E. LAURIE	
9	9	10/1/42	J.E. LAURIE	
10	10	10/1/42	J.E. LAURIE	

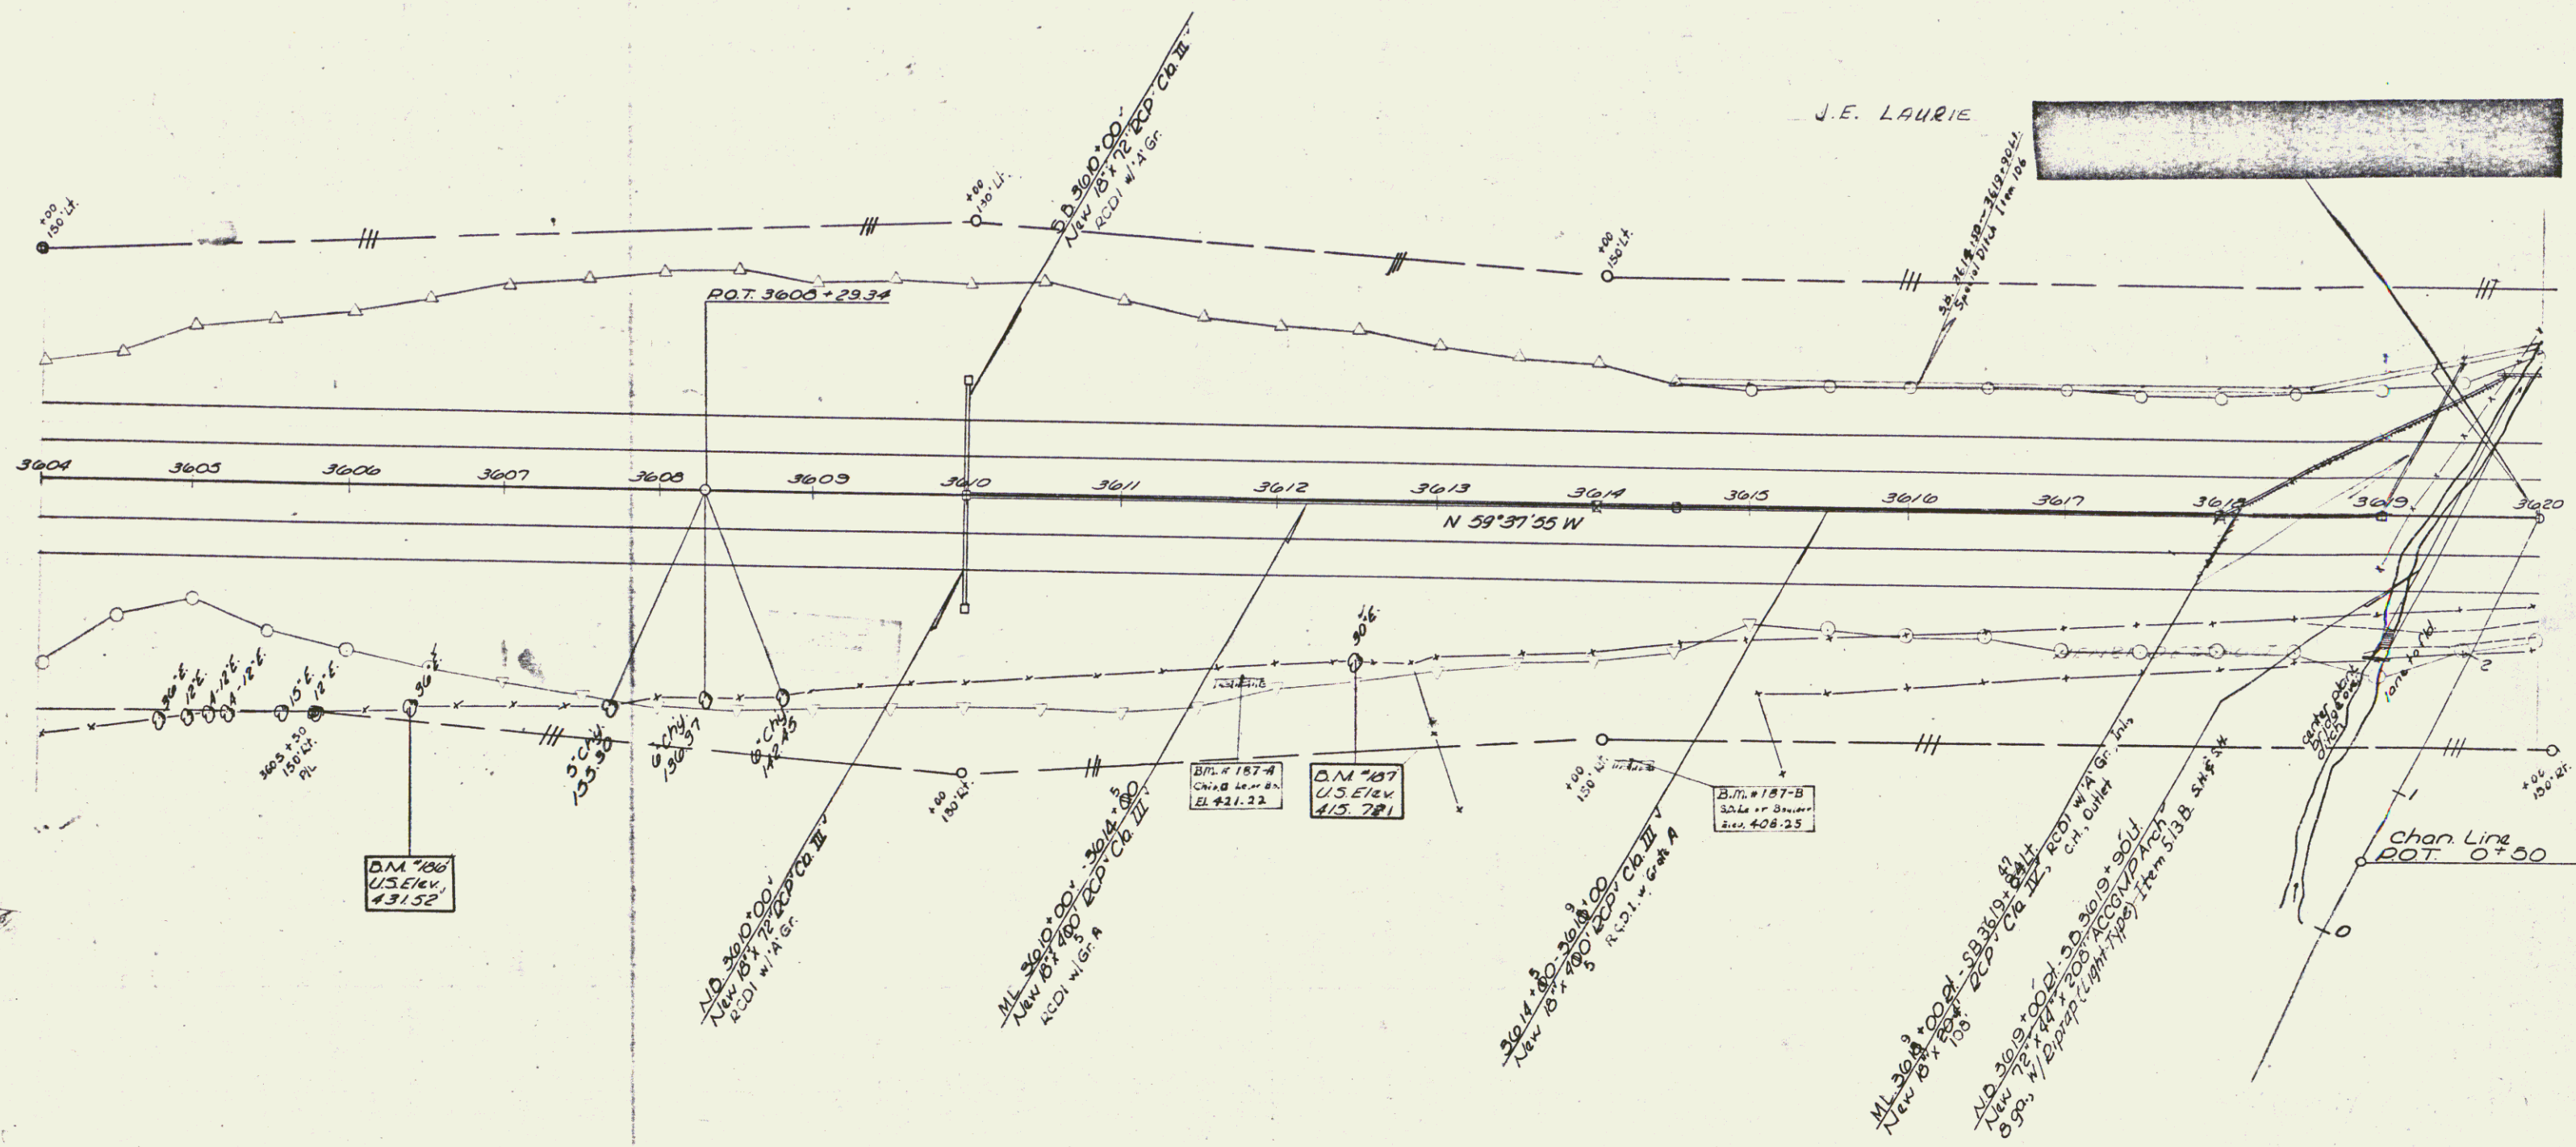

CONTROL OF ACCESS COMPLETE ON THIS SHEET

Stage 2 Construction
STALBANS - SW ANTON
I 89 5/36/42
Sheet 50 of 153


PLAN
Scale
NOT TO SCALE
REVISIONS
NO.

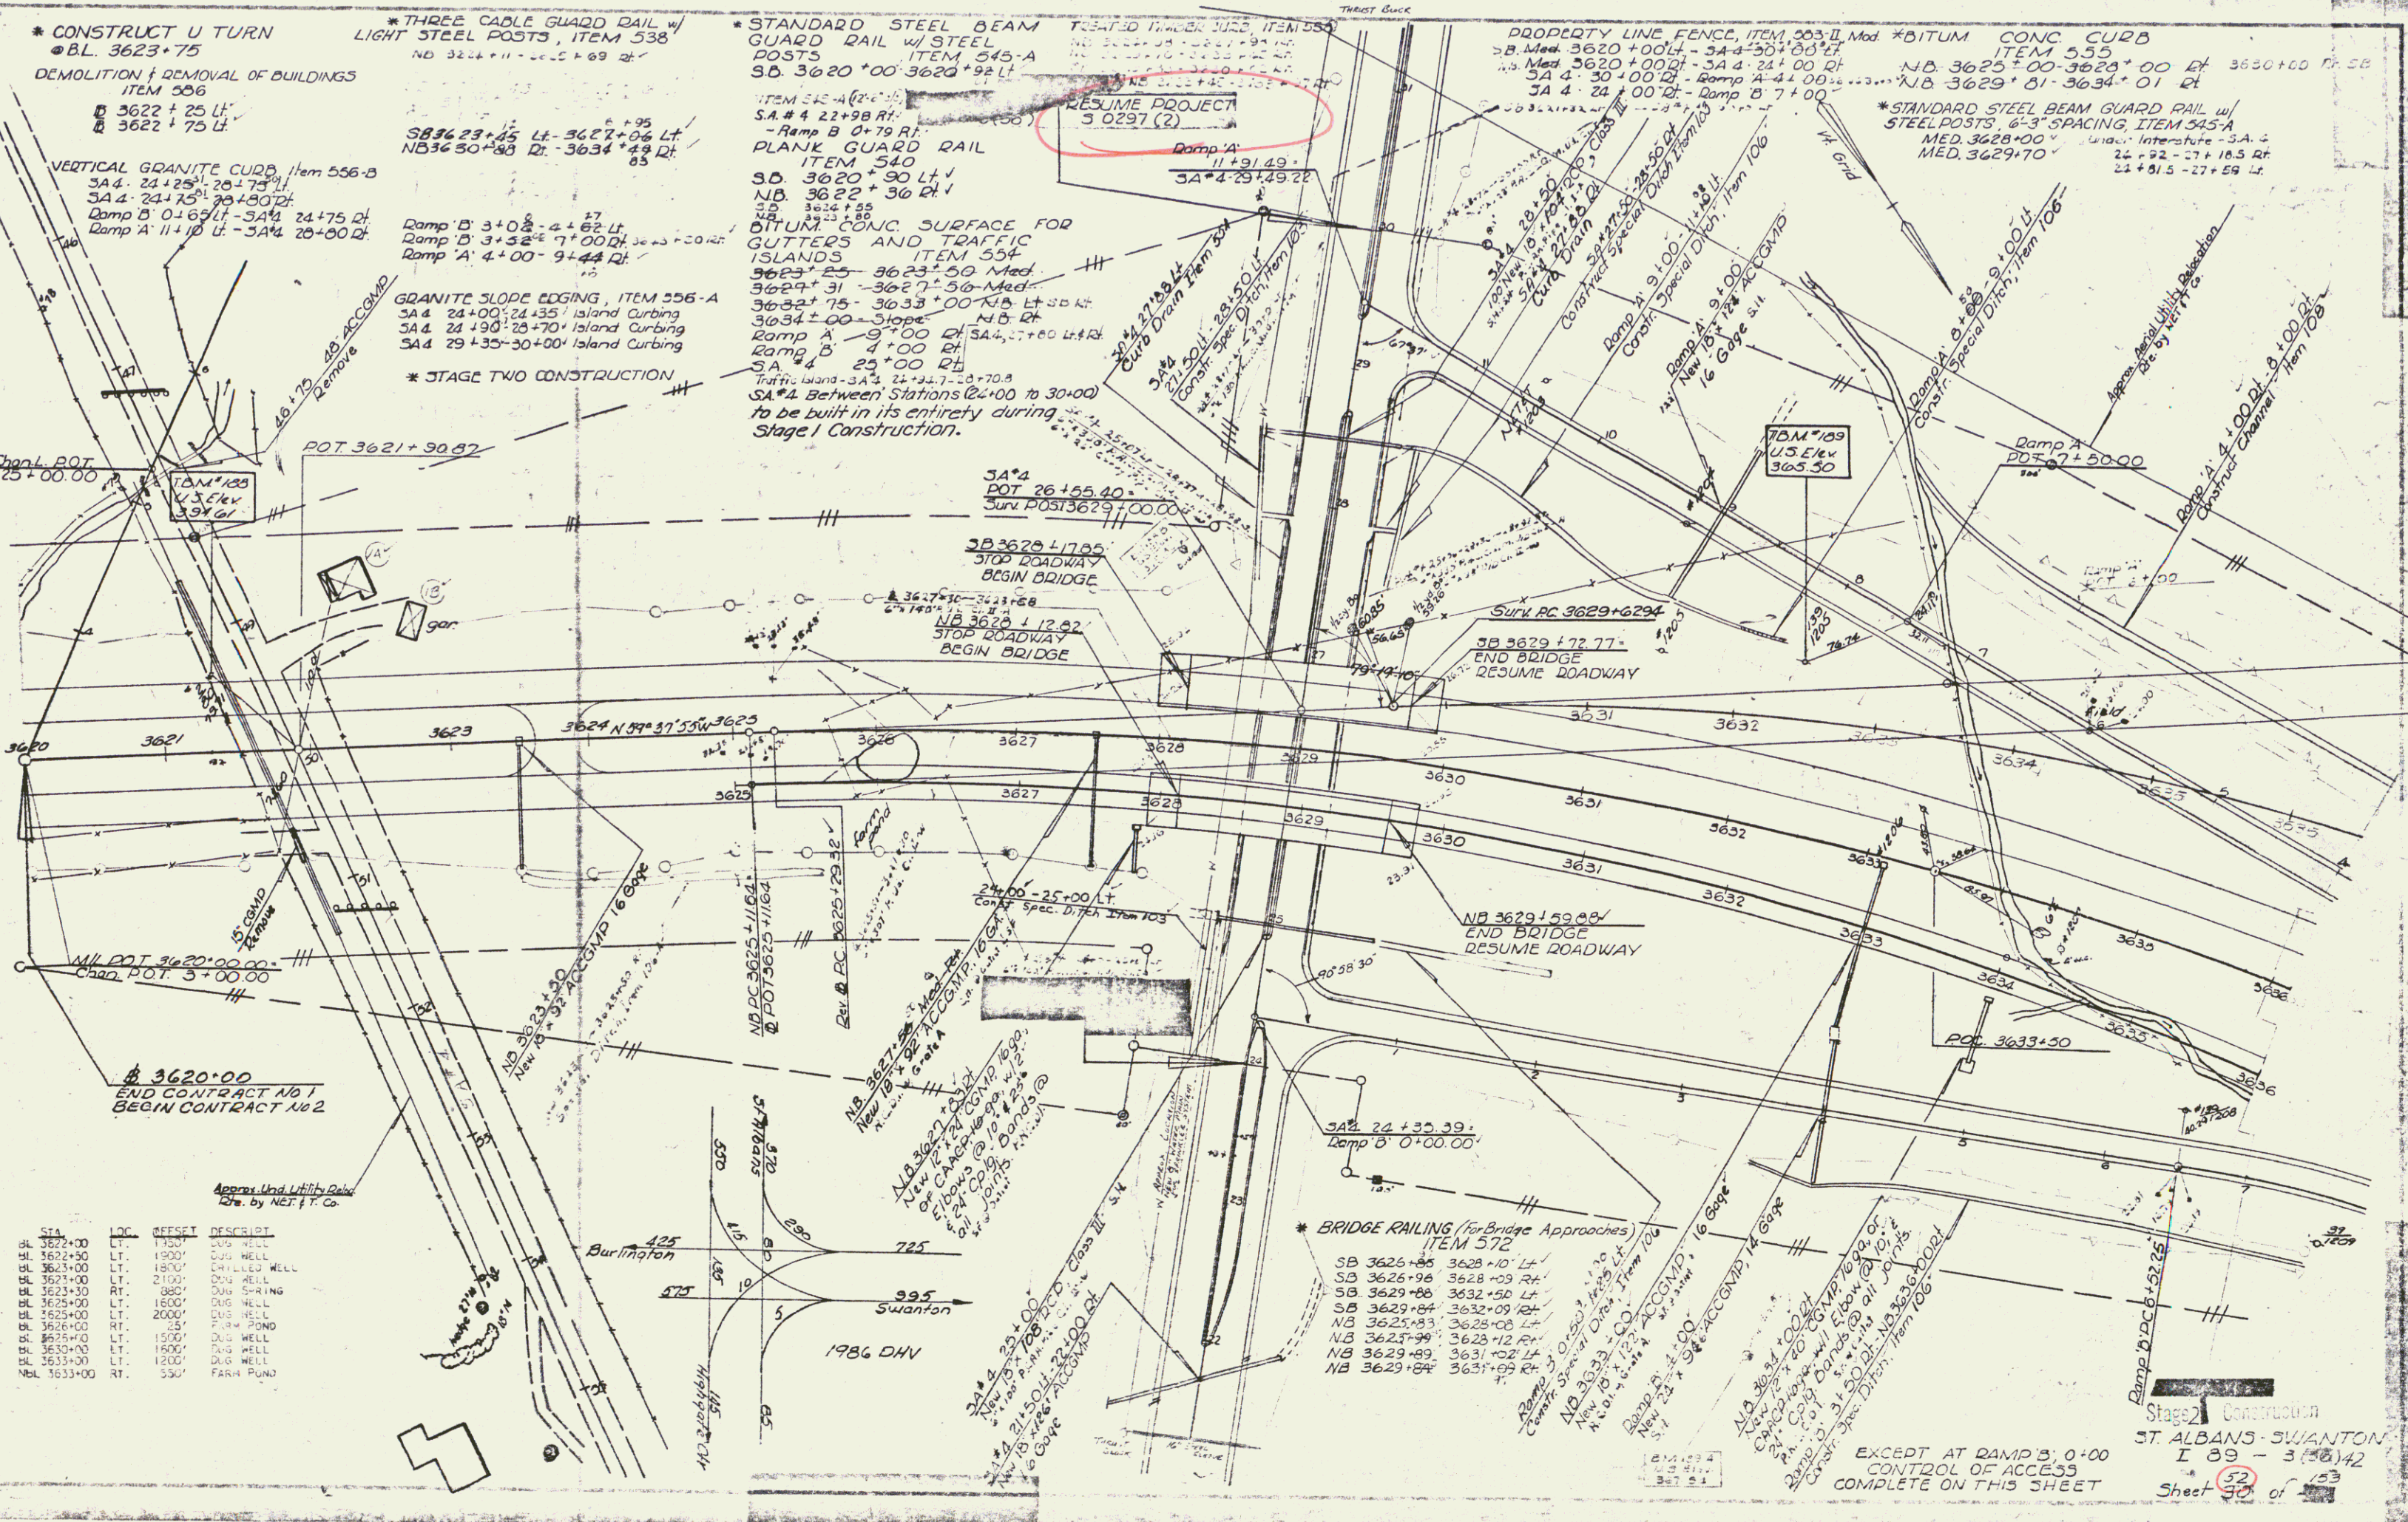

STA.	LOC.	OFFSET	DESCRIPTION
BL 3622+00	LT.	1500'	DUG WELL
BL 3623+00	LT.	1800'	DUG WELL
BL 3624+00	LT.	2100'	DUG WELL
BL 3625+00	LT.	2400'	DUG WELL
BL 3626+00	LT.	2700'	DUG WELL
BL 3627+00	LT.	3000'	DUG WELL
BL 3628+00	LT.	3300'	DUG WELL
BL 3629+00	LT.	3600'	DUG WELL
BL 3630+00	LT.	3900'	DUG WELL
BL 3631+00	LT.	4200'	DUG WELL
BL 3632+00	LT.	4500'	DUG WELL
BL 3633+00	LT.	4800'	DUG WELL
BL 3634+00	LT.	5100'	DUG WELL
BL 3635+00	LT.	5400'	DUG WELL
BL 3636+00	LT.	5700'	DUG WELL

STA.	LOC.	OFFSET	DESCRIPTION
SB 3625+00	RT.	1500'	DUG WELL
SB 3626+00	RT.	1800'	DUG WELL
SB 3627+00	RT.	2100'	DUG WELL
SB 3628+00	RT.	2400'	DUG WELL
SB 3629+00	RT.	2700'	DUG WELL
SB 3630+00	RT.	3000'	DUG WELL
SB 3631+00	RT.	3300'	DUG WELL
SB 3632+00	RT.	3600'	DUG WELL
SB 3633+00	RT.	3900'	DUG WELL
SB 3634+00	RT.	4200'	DUG WELL
SB 3635+00	RT.	4500'	DUG WELL
SB 3636+00	RT.	4800'	DUG WELL

ST. ALBANS - SWANTON
I 89 - 3 (36) 42
Sheet 30 of 153

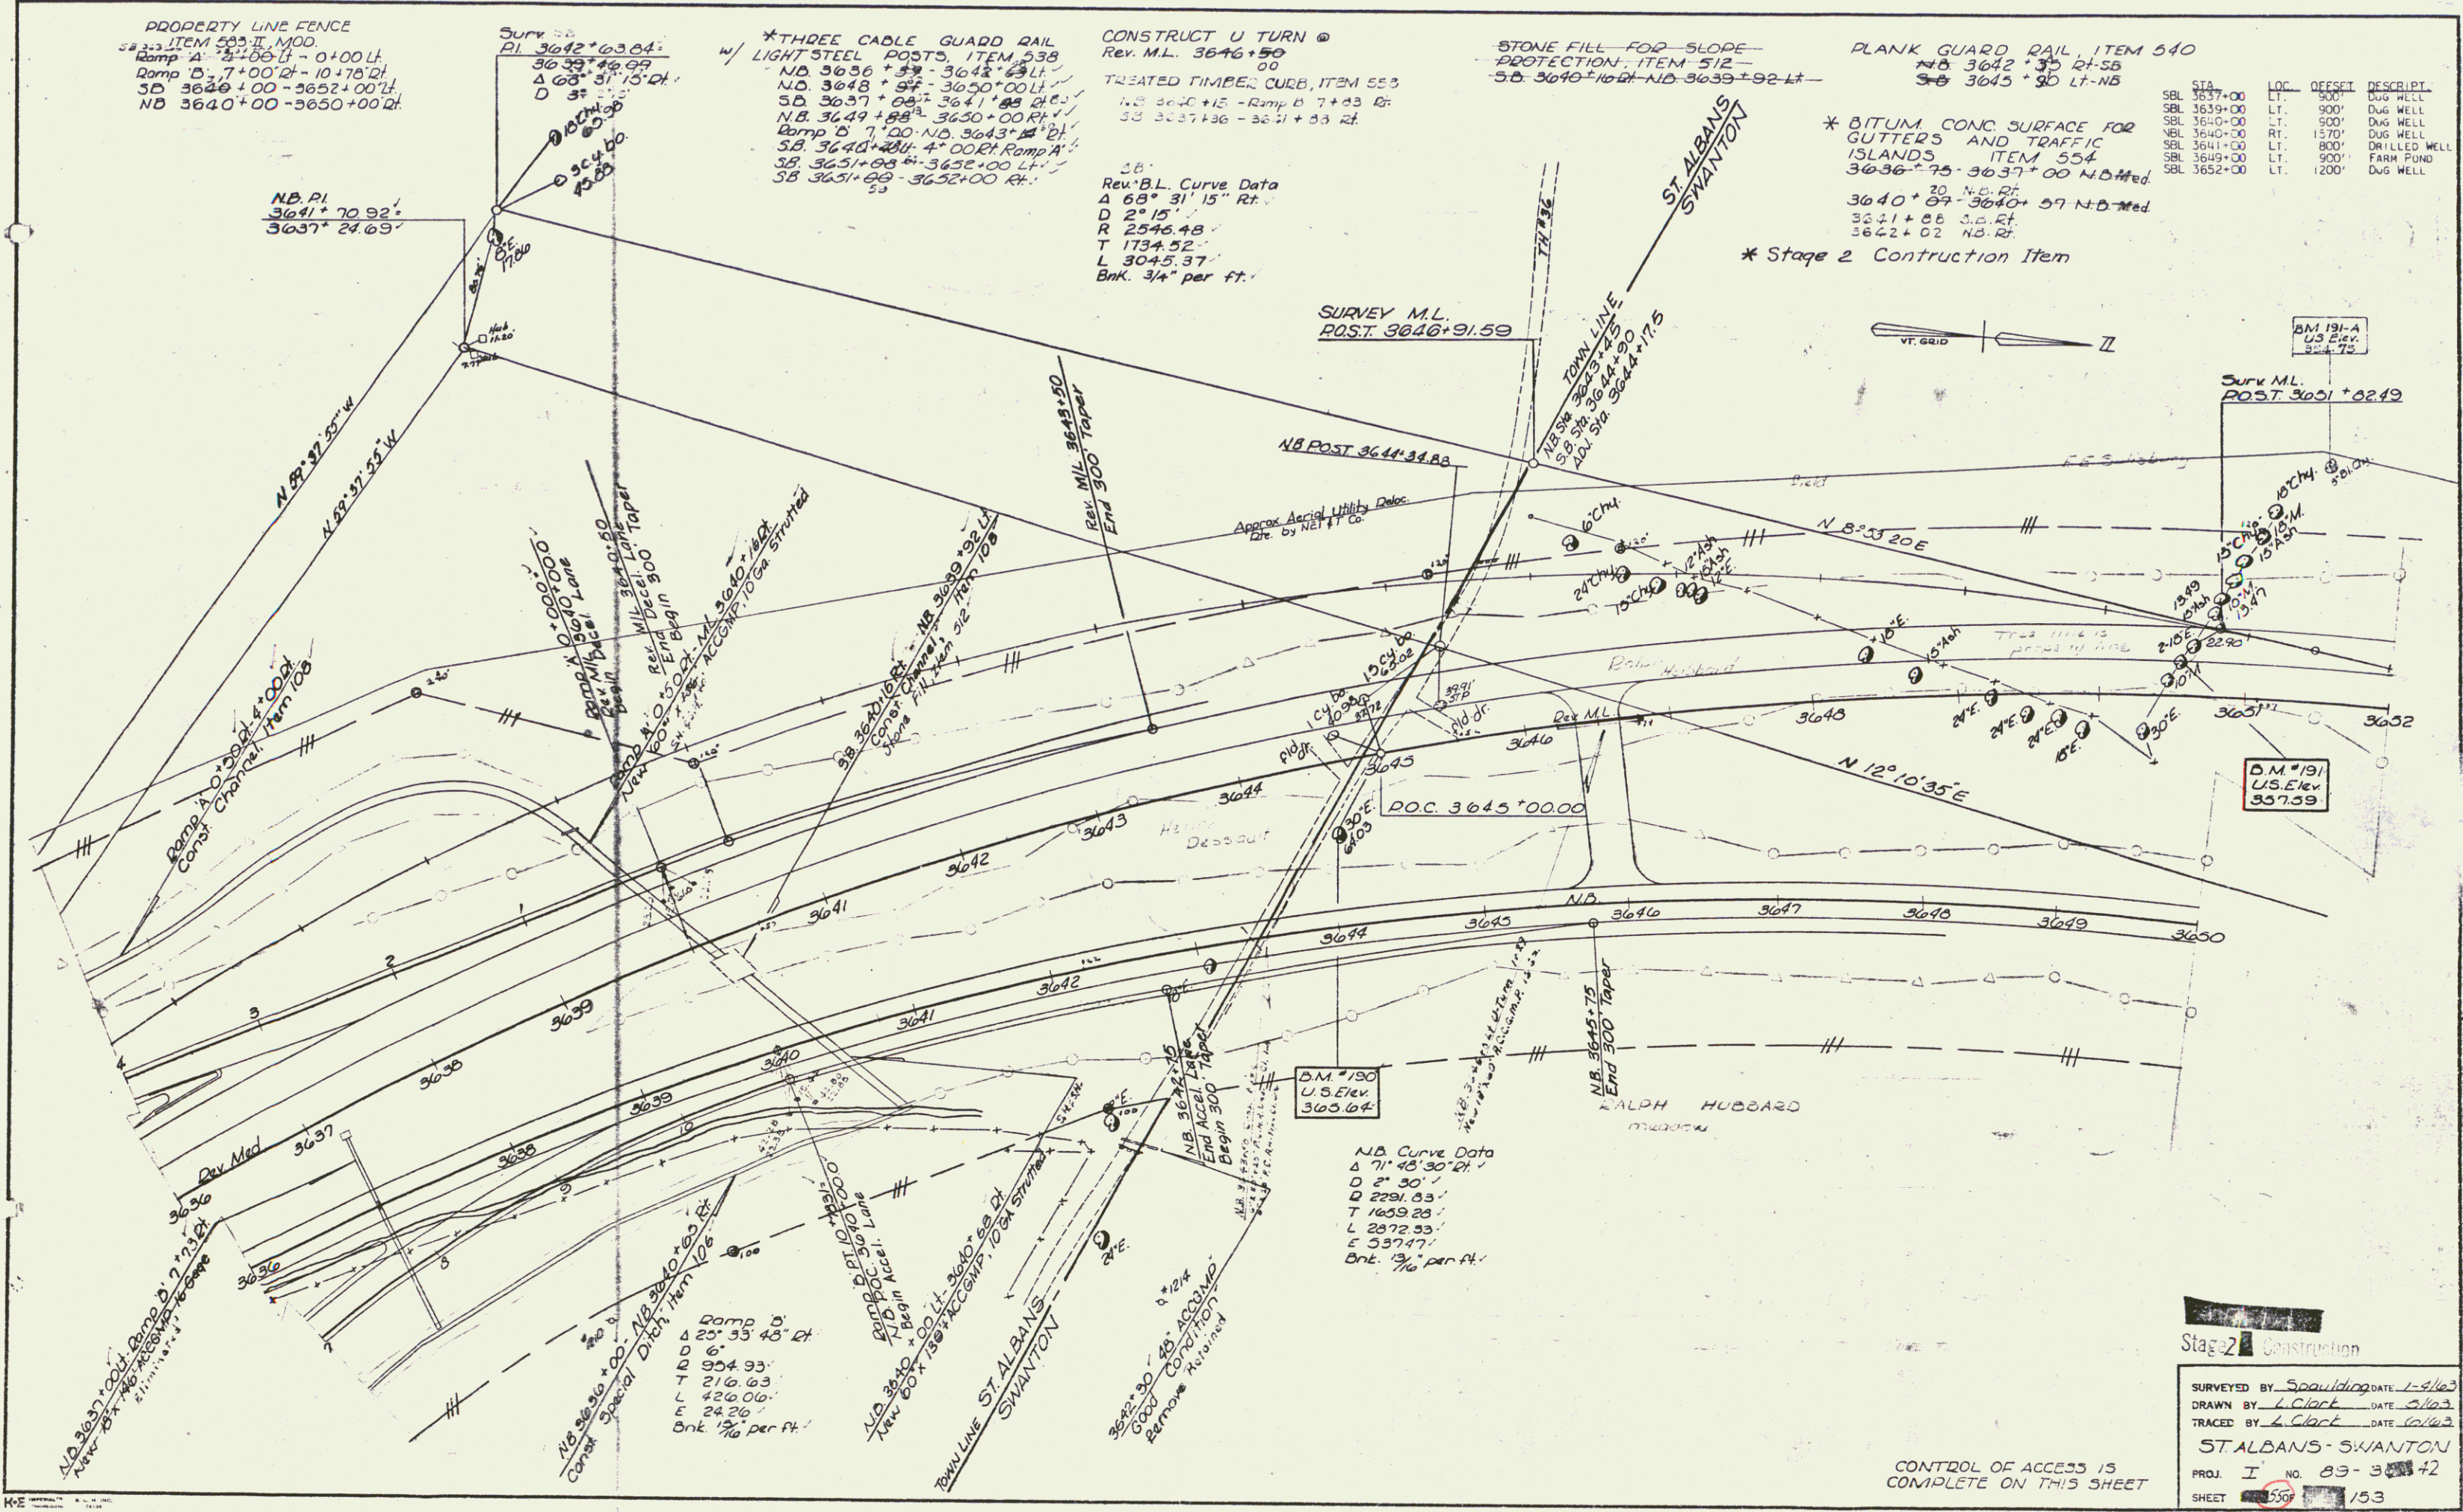

STA.	LOC.	OFFSET	DESCRIPT.
SBL 3637+00	LT.	900'	DUG WELL
SBL 3639+00	LT.	900'	DUG WELL
SBL 3640+00	LT.	900'	DUG WELL
SBL 3641+00	LT.	1570'	DUG WELL
SBL 3641+00	LT.	800'	DRILLED WELL
SBL 3649+00	LT.	900'	FARM POND
SBL 3652+00	LT.	1200'	DUG WELL

SURV. M.L.	POST. 3651+22.49
D.M. 191-A	U.S. Elev. 357.75

D.M. 191	U.S. Elev. 357.59
----------	-------------------

D.M. 190	U.S. Elev. 365.64
----------	-------------------

Stage 2 Construction

SURVEYED BY Spaulding DATE 1-9-63
DRAWN BY L. Clark DATE 5/63
TRACED BY L. Clark DATE 6/63

ST ALBANS - SWANTON

PROJ. I NO. 83-383-42

SHEET 155 153

CONTROL OF ACCESS IS COMPLETE ON THIS SHEET

Const
67

*THREE CABLE GUARD RAIL
LIGHT STEEL POSTS ITEM 538
SD 3601+00 RT 3603+00 RT 57
NB 3600+00 LT 3603+00 RT 57
NB 3600+00 LT 3603+00 RT 57
SD 3601+00 LT 3603+00 RT 57
SD 3601+00 LT 3603+00 RT 57

MUCK EXCAVATION Item 117
2-BORROW Item 104
SD 3657+25-3659+25


DIP-DAP FOR BANK PROTECTION
MOD FOR CULVERT ENDS Item 513-B
NB 3600+68 RT
SB 3652+03 RT

PROPERTY LINE FENCE ITEM 503-II, MOD
SB 3652+00-3660+00 LT
NB 3650+00-3660+00 RT

STA	LOC	OFFSET	DESCRIPT
SB 3652+00	LT	1200'	DUG WELL
NB 3652+00	RT	1500'	OLD DUG WELL
NB 3654+00	RT	1400'	DRILLED WELL
NB 3658+00	RT	1300'	DUG WELL
SB 3664+00	LT	1900'	DUG WELL
SB 3667+00	LT	1700'	DRILLED WELL

STAGE II CONSTRUCTION ITEM

PLAN
REVISIONS
NOT FOR CONSTRUCTION
NO.

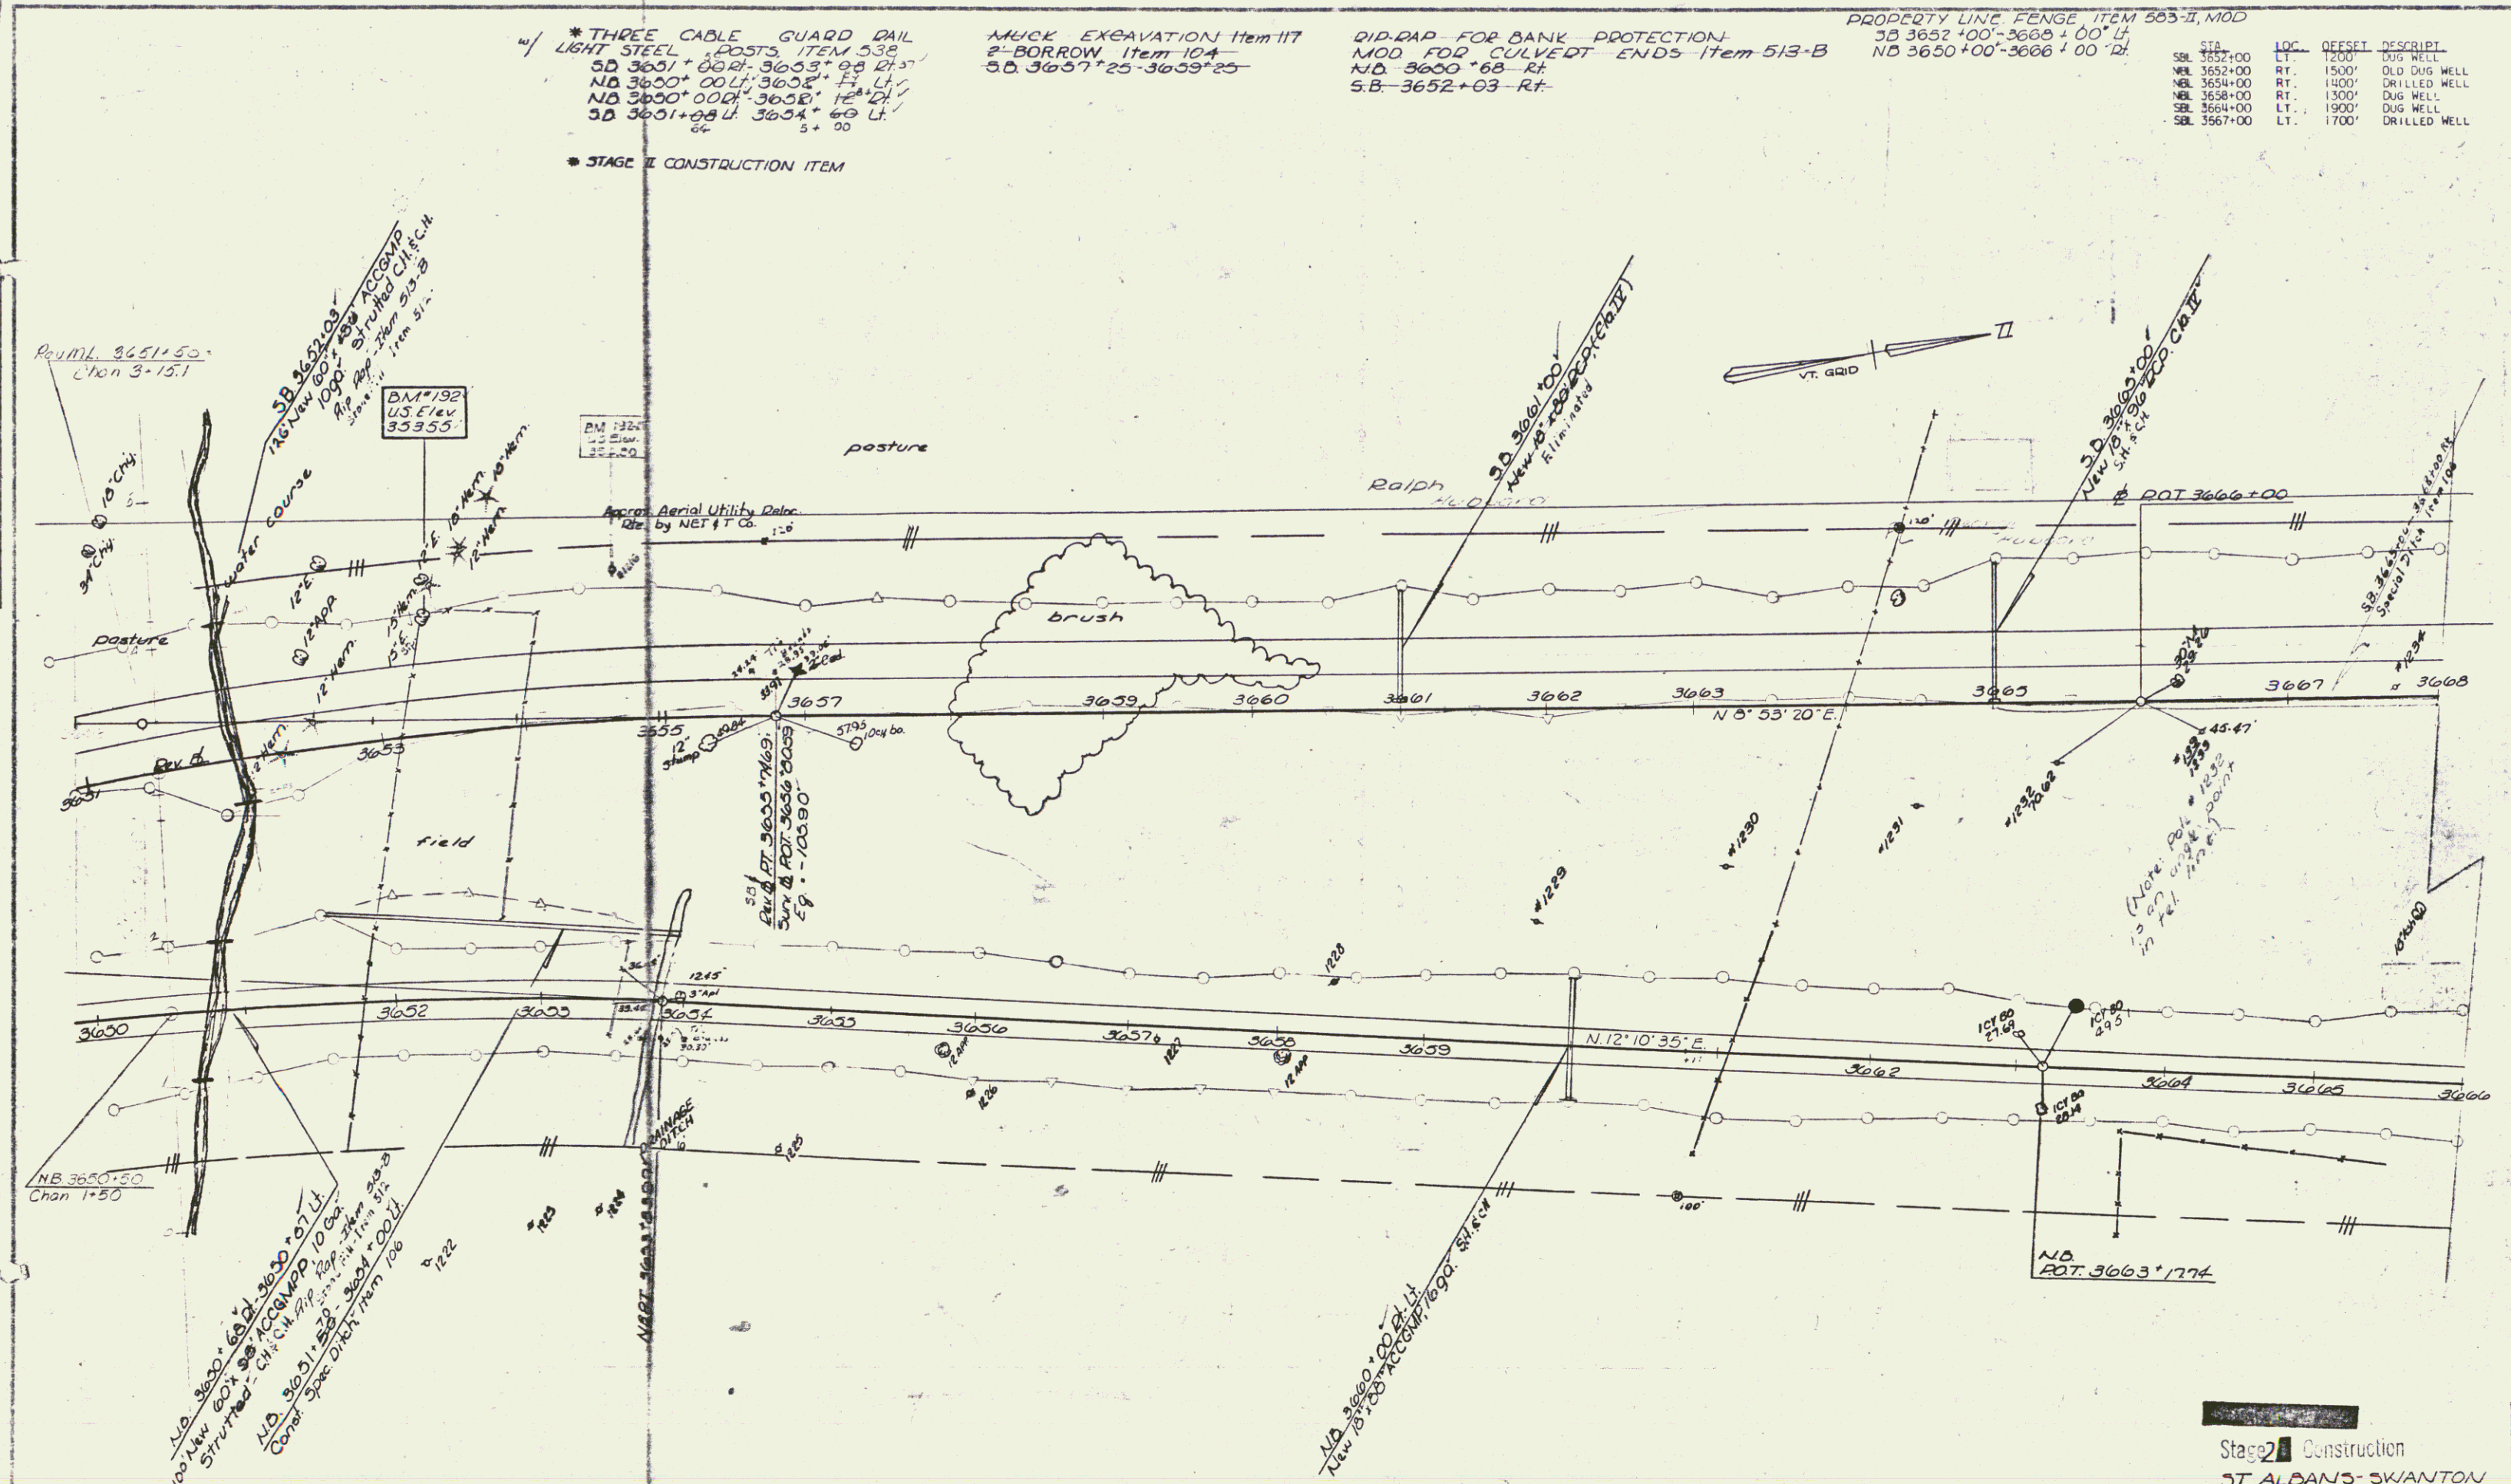

Stage II Construction
ST. ALBANS-SWANTON
I 89-3142
Sheet 57 of 153
Const


DRILLING AND BLASTING
OF SOLID ROCK, ITEM 114
S.D. 3601+75-3603+25

DRILLING & BLASTING OF
SOLID ROCK SUBGRADE
ITEM 115
S.D. 3600+25-3601+25
S.D. 3601+75-3603+25

PROPERTY LINE FENCE, ITEM 503-II
MOD.
S.D. 3660+00-3604+00+LL
NO 3660+00-3602+00+LL
* STAGE II CONSTRUCTION ITEM

STA.	LOC.	OFFSET	DESCRIPT.
NEEL 3673+00	RT.	1500'	DRILLED WELL
NEEL 3673+00	RT.	1400'	OLD DUG WELL
NEEL 3673+00	RT.	1500'	DUG WELL
NEEL 3674+00	LT.	1500'	DRILLED WELL
NEEL 3675+00	RT.	1250'	DUG WELL
NEEL 3675+50	RT.	350'	FARM POND
NEEL 3678+00	LT.	2200'	FARM POND
NEEL 3680+00	RT.	1500'	DUG WELL
NEEL 3681+00	LT.	2000'	DUG WELL
NEEL 3682+00	LT.	2800'	DUG WELL

PLAN	DATE	BY	CHKD
REVISION			
1	10/1/59	J. H. HARRIS	J. H. HARRIS
2	10/1/59	J. H. HARRIS	J. H. HARRIS
3	10/1/59	J. H. HARRIS	J. H. HARRIS
4	10/1/59	J. H. HARRIS	J. H. HARRIS
5	10/1/59	J. H. HARRIS	J. H. HARRIS
6	10/1/59	J. H. HARRIS	J. H. HARRIS
7	10/1/59	J. H. HARRIS	J. H. HARRIS
8	10/1/59	J. H. HARRIS	J. H. HARRIS
9	10/1/59	J. H. HARRIS	J. H. HARRIS
10	10/1/59	J. H. HARRIS	J. H. HARRIS

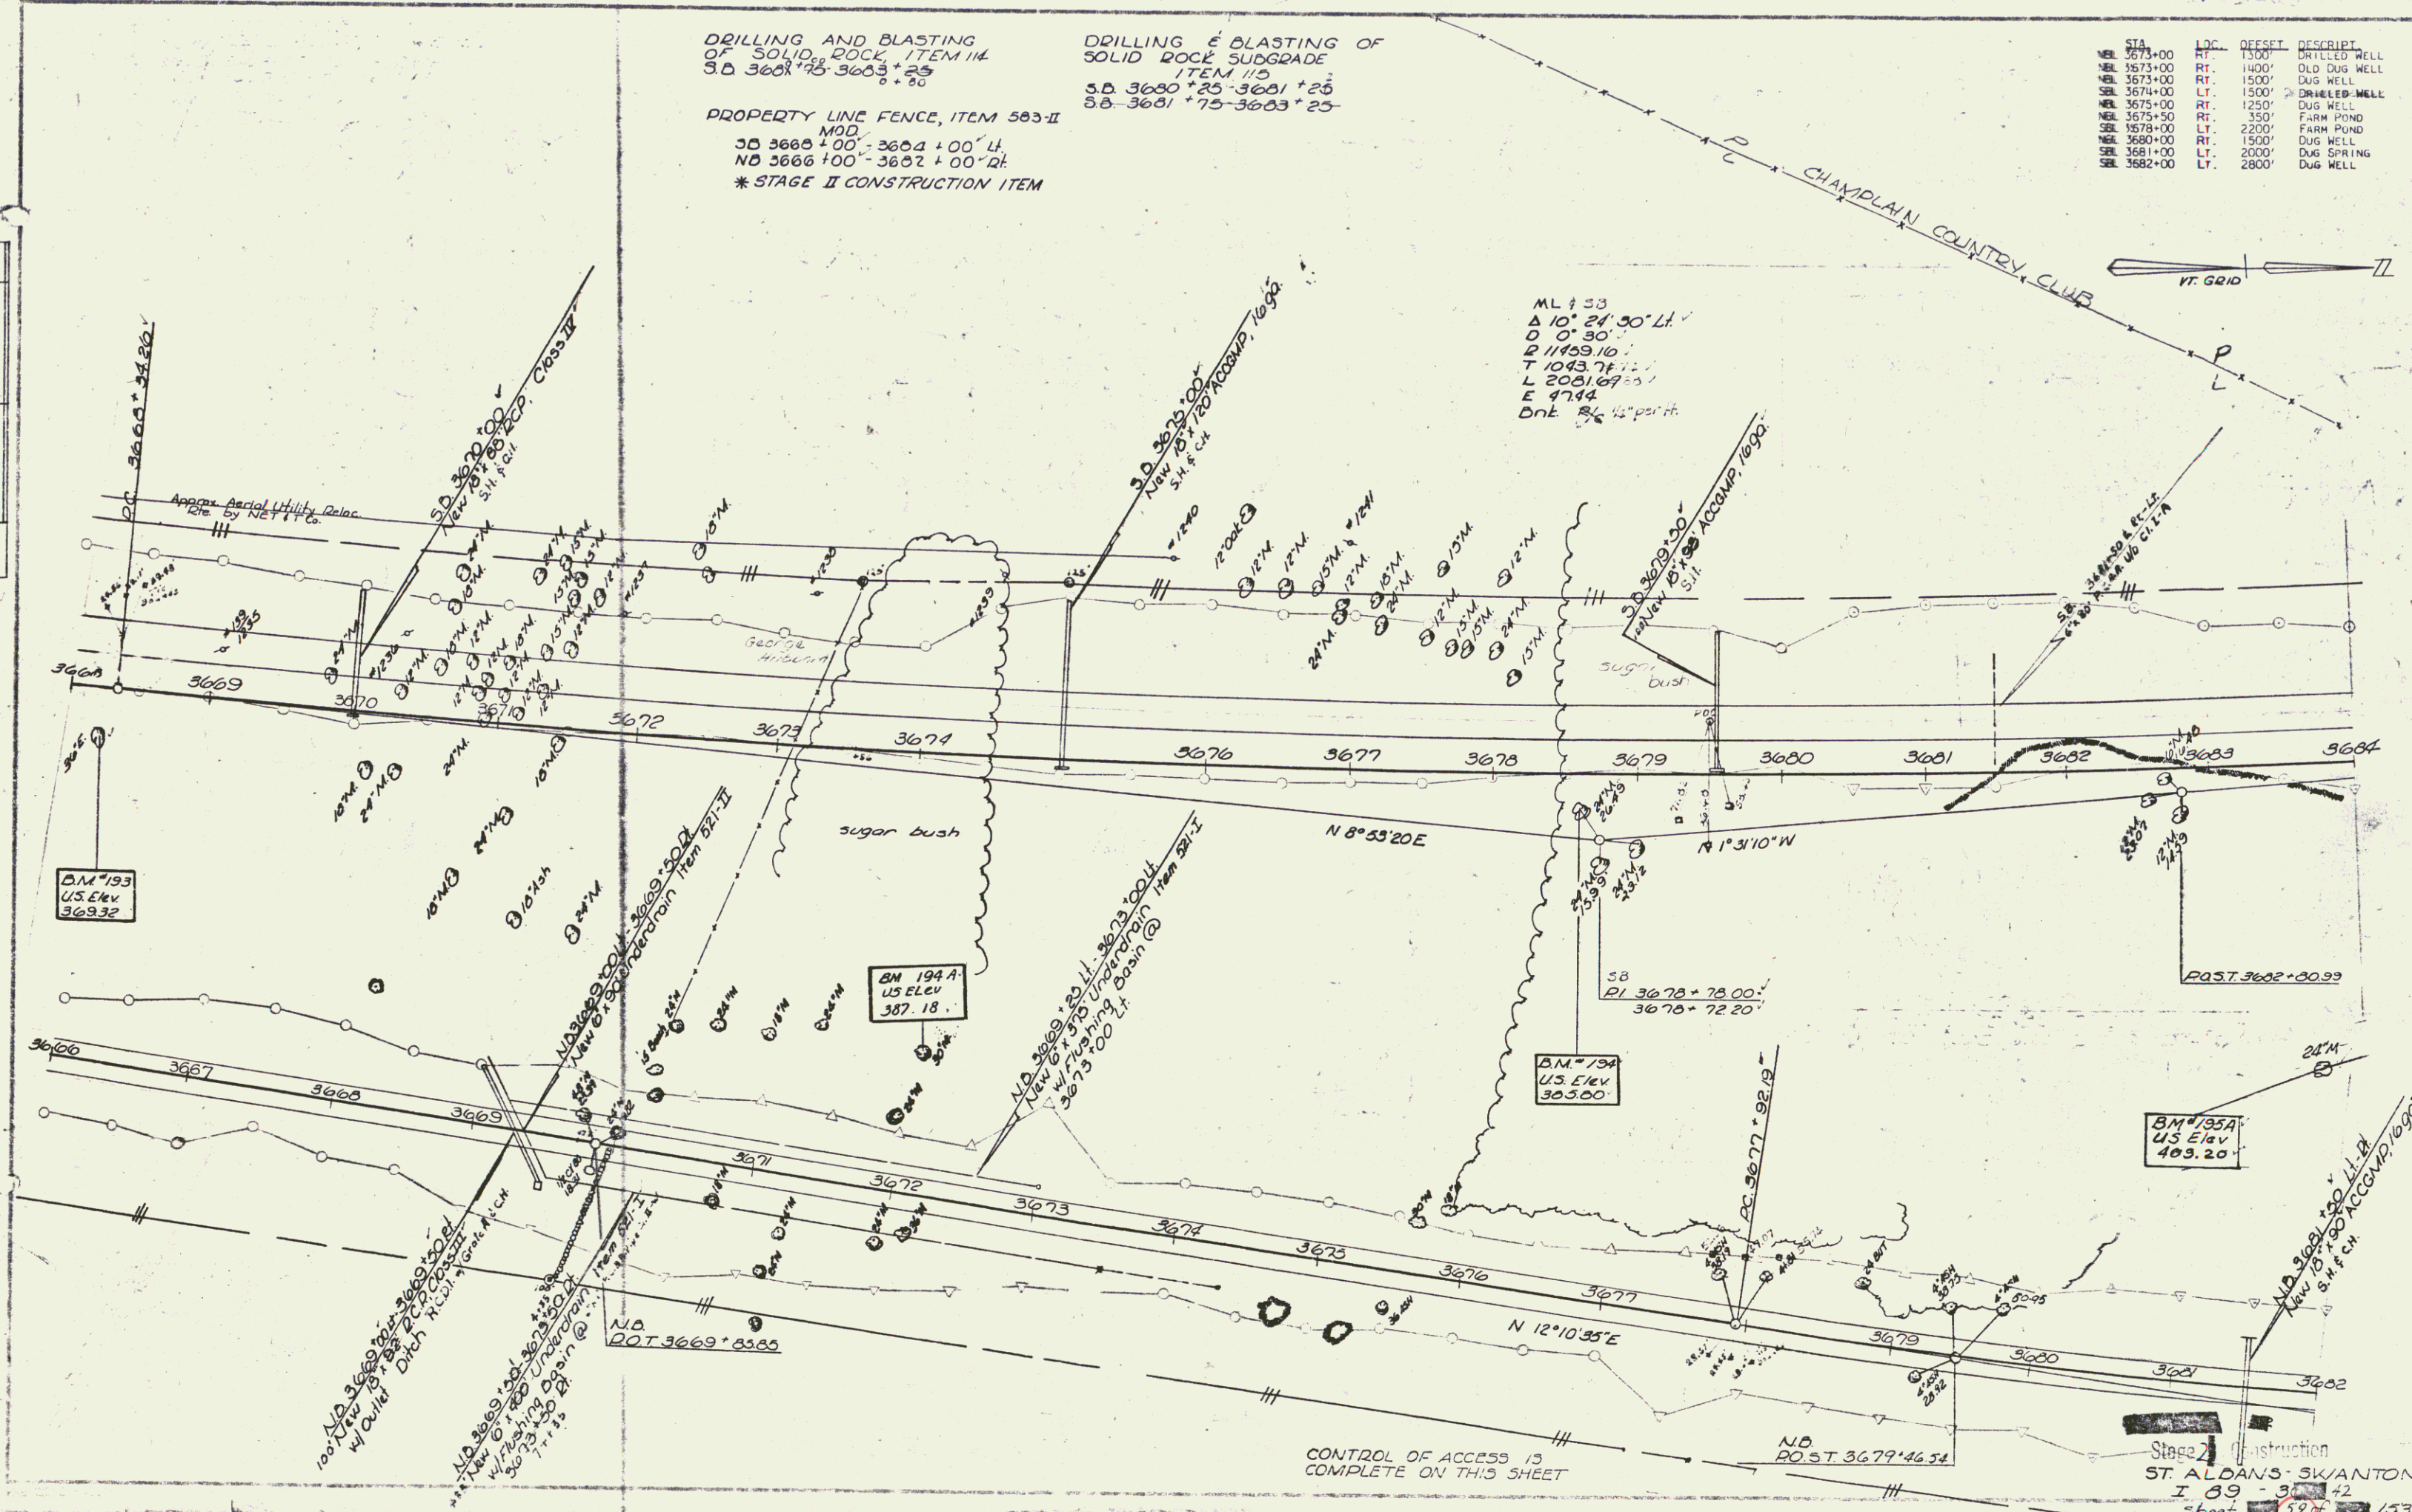

ST. ALDANS-SWANTON
I 09 - 30 42
Sheet 59 of 153

CONST
69


* STAGE II CONSTRUCTION ITEM

PROPERTY LINE FENCE, ITEM 303 II MOD.
ND 3602+00 - 3690+00 RT.
SB 3604+00 - 3700+00 LT.

DRILLING & BLASTING OF SOLID
ROCK SUBGRADE - ITEM 115
SB 3691+25 - 3695+25
NB 3686+00 - 3688+00
NB 3690+25 - 3698+75
SB 3693+00 - 3694+46

DRILLING & BLASTING, ITEM 111
SB 3694+65 - 3694+50
SB 3695+75 - 3696+25

STA.	LOC.	OFFSET	DESCRIPT.
NBL 3685+00	RT.	1600'	FARM POND
NBL 3688+00	RT.	300'	DUG SPRING
NBL 3690+00	RT.	1500'	DUG WELL
NBL 3690+50	RT.	1350'	UNDERG. CIST.
SBL 3691+00	LT.	2800'	FARM POND
SBL 3692+00	LT.	3400'	DUG WELL
SBL 3694+00	LT.	3200'	SPRINGS
SBL 3694+00	LT.	3400'	DUG WELL
NBL 3694+65	LT.	100'	SPRINGS
NBL 3696+00	RT.	700'	FARM POND
NBL 3698+00	RT.	300'	SPRINGS
SBL 3700+00	LT.	3600'	DRILLED WELL

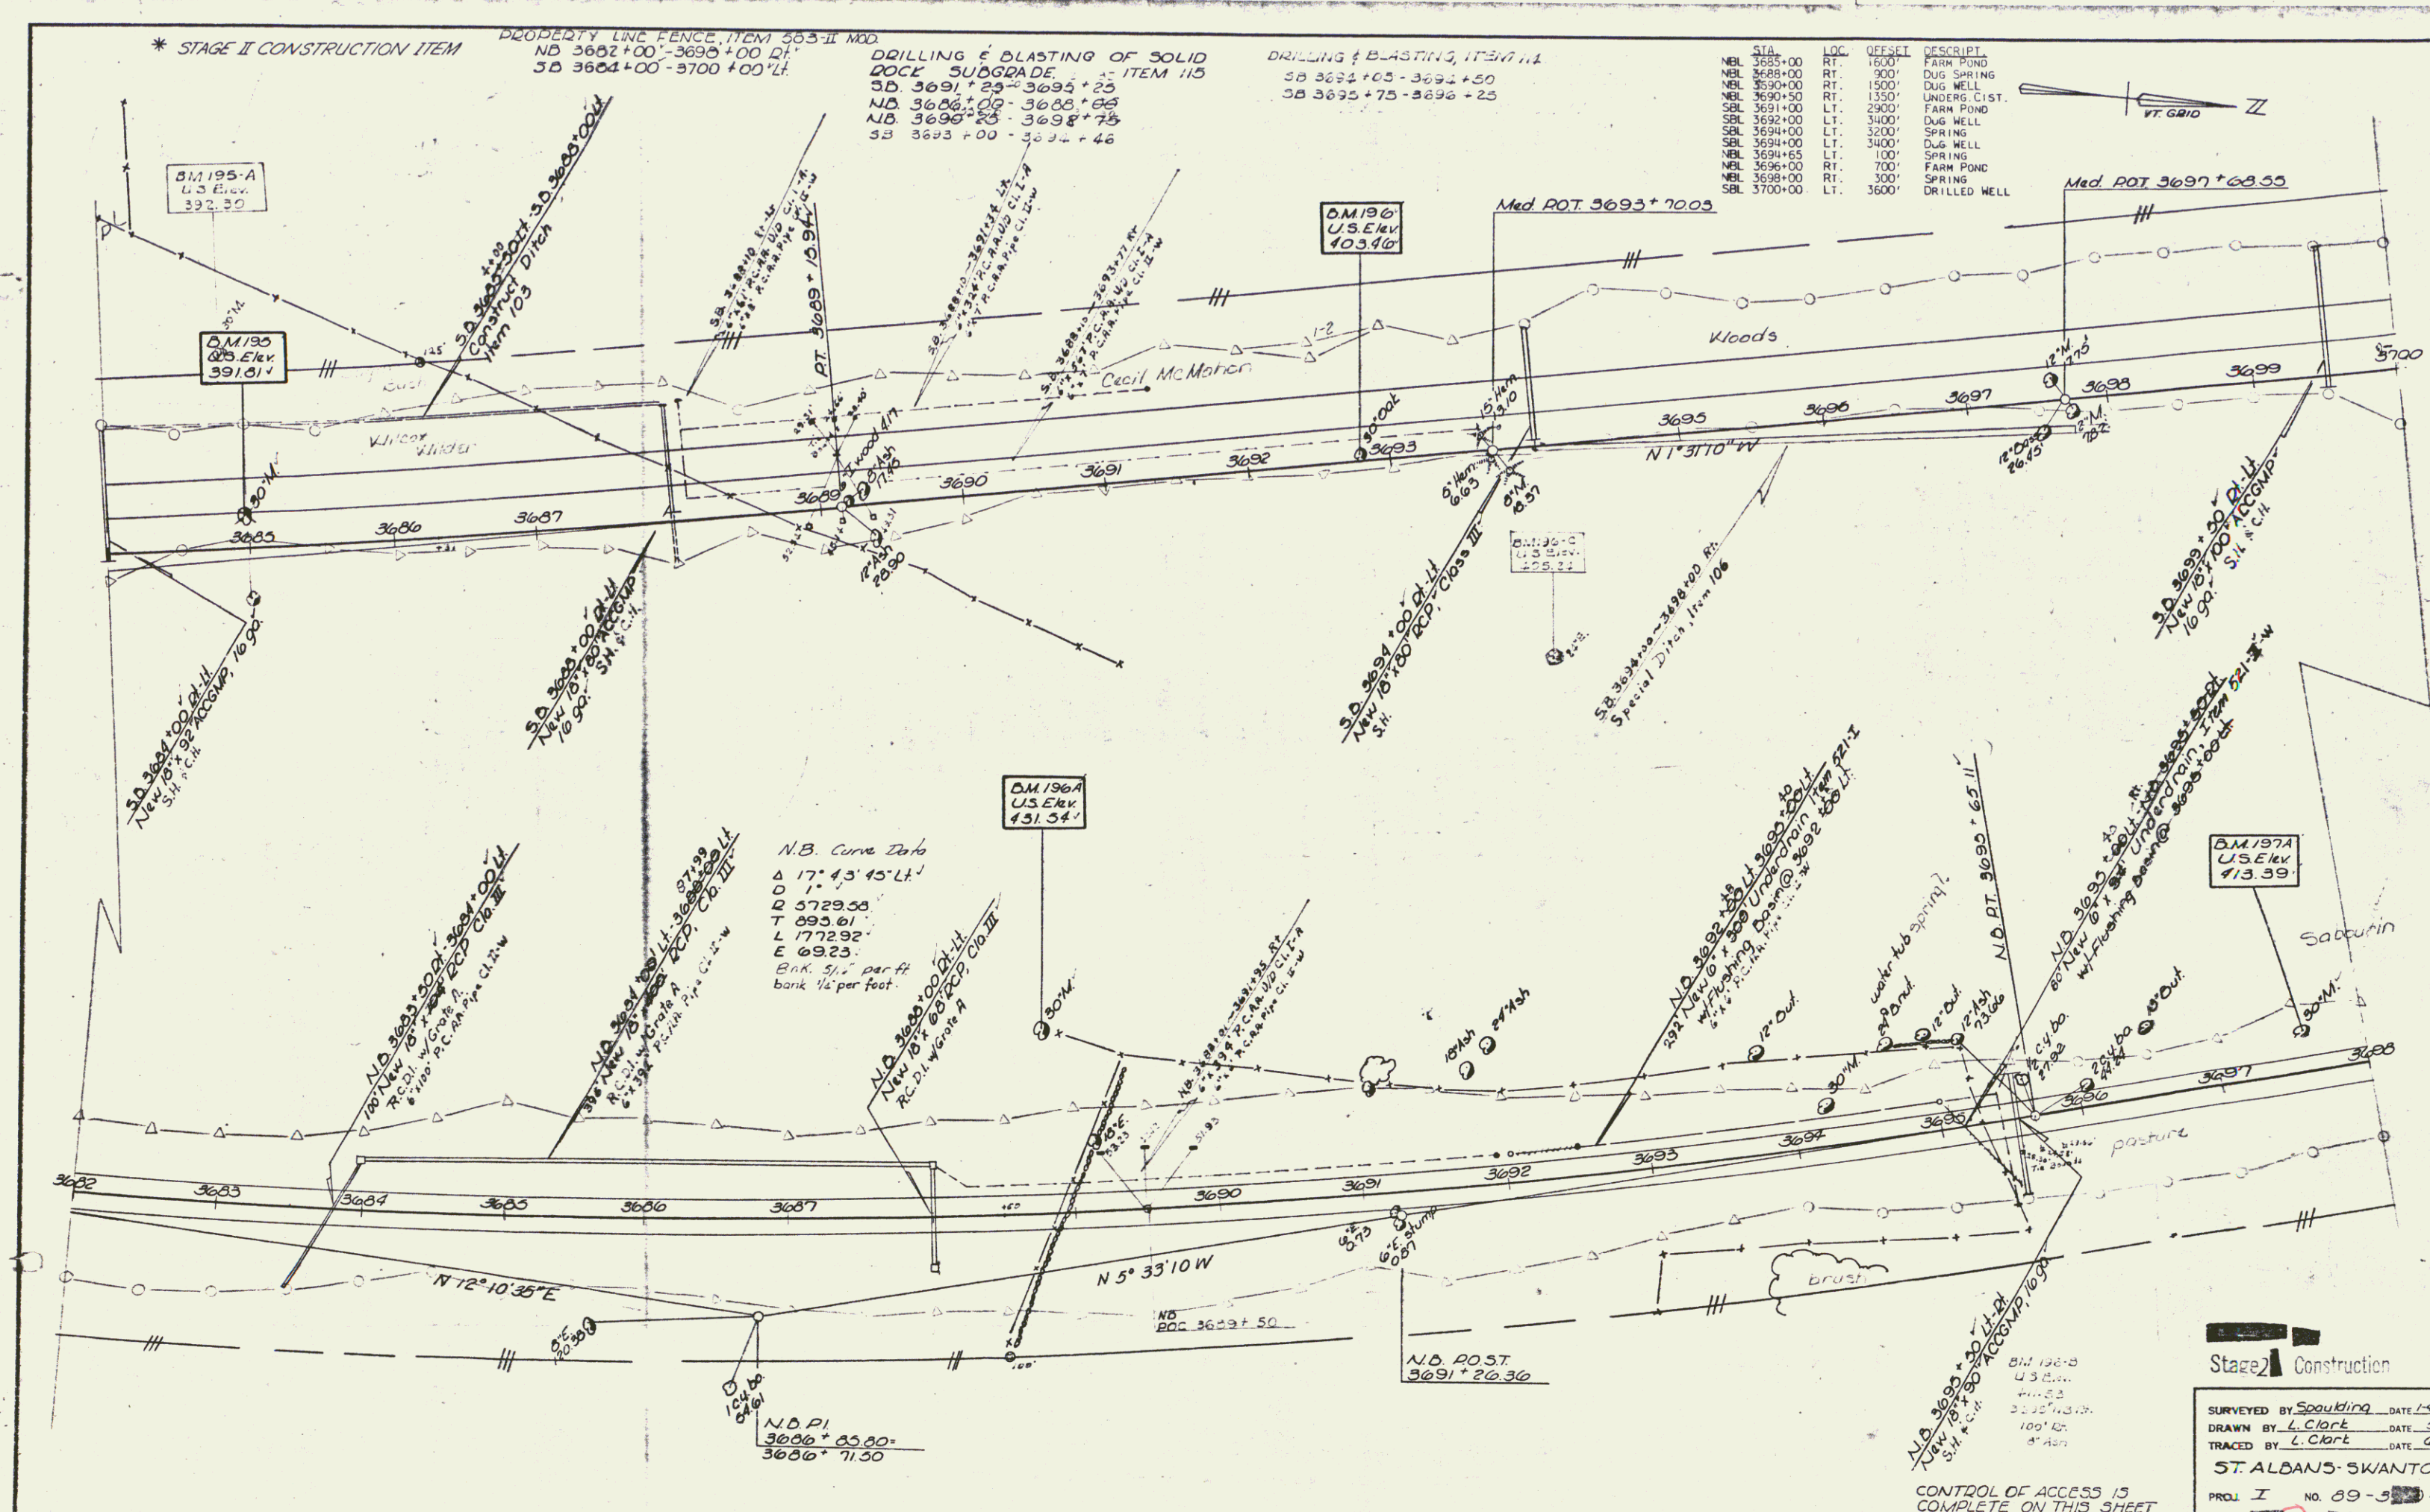

Stage II Construction

SURVEYED BY Spaulding DATE 1/4/63
DRAWN BY L. Clark DATE 5/63
TRACED BY L. Clark DATE 6/63
ST. ALBAN'S SWANTON
PROJ. I NO. 89-542
SHEET 61 OF 153

CONTROL OF ACCESS IS
COMPLETE ON THIS SHEET


CONST
10

DRILLING & BLASTING OF SOLID
ROCK SUBGRADE, ITEM 113
NB 3699+25-3704+25
NB 3706+25-3710+25
NB 3714+25-3718+25

MUCK EXCAVATION, ITEM 114
SB 3706+25-3716+25
NB 3704+25-3707+25

PROPERTY LINE FENCE, ITEM 503-II, MOD.
NB 3695+00-3714+00 PL
SB 3700+00-3716+00 PL
DRILLING & BLASTING, ITEM 114
NB 3712+00

STA	LOC	OFFSET	DESCRIPT
NBL 3698+00	RT	100'	SPRING
SBL 3700+00	LT	3600'	DRILLED WELL
SBL 3702+00	LT	3400'	NATURAL POND
NBL 3705+00	RT	1600'	DRILLED WELL
NBL 3706+25	RT	120'	DUG SPRING
SBL 3708+00	LT	4000'	DRILLED WELL
NBL 3709+00	RT	1000'	DUG WATER TUBE
SBL 3709+00	LT	600'	FARM POND
NBL 3710+00	RT	2300'	SPRING
SBL 3710+00	LT	700'	SPRING

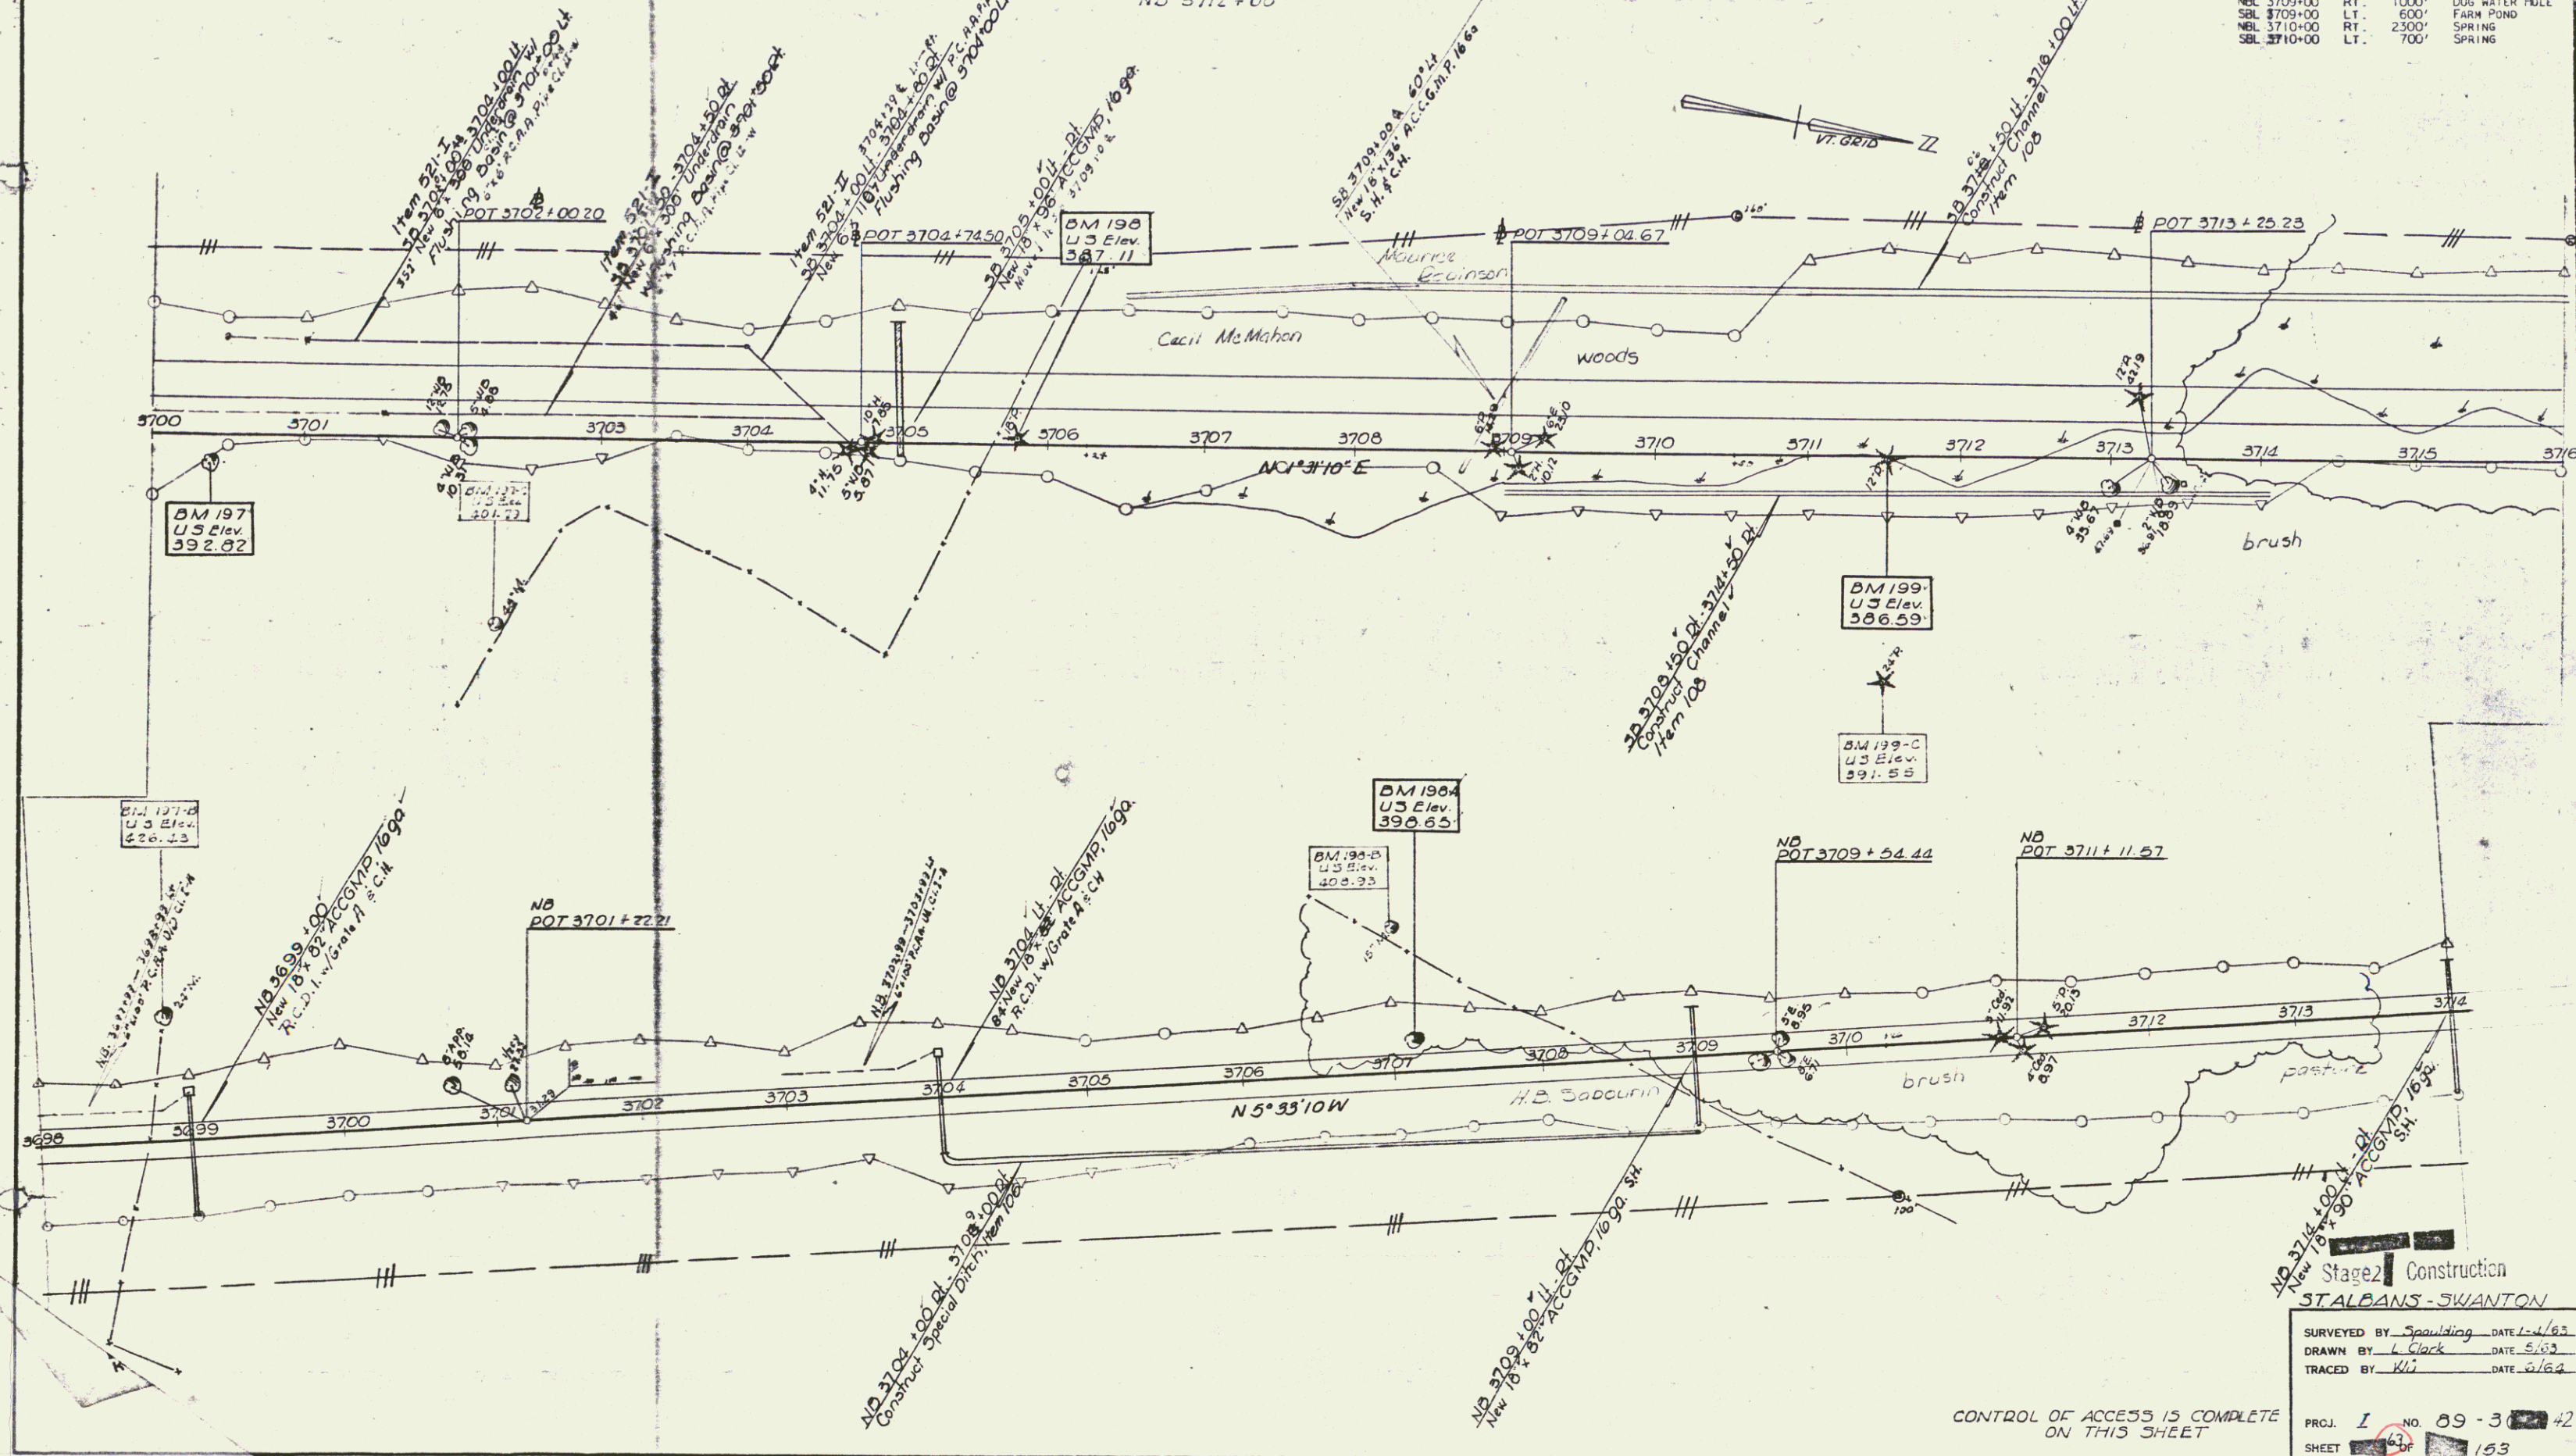

* THREE CABLE GUARD RAIL w/ LIGHT
STEEL POSTS, ITEM 538
NB 3715+98-3723+100 LT.
NB 3717+52-3722+64 LT.

* BIT CONC SURF FOR
GUTTERS AND TRAFFIC
ISLANDS, ITEM 554
3725+75-3726+00 SB LT.
3725+75-3726+00 SB LT.
3725+75-3729+00 SB LT.
3725+75-3729+00 SB LT.

BLANK GUARD RAIL w/
PRESERVATIVE TREATMENT
ITEM 540
NB 3723+80 LT.
SB 3724+55 LT.

* STAGE II CONSTRUCTION ITEM

DRILLING & BLASTING OF SOLID
ROCK SUBGRADE,
ITEM 115
NB 3724+25-3733+00
SB 3724+80-3732+00
NB 3714+25-3716+25


* STANDARD STEEL BEAM GUARD-RAIL
w/STEEL POSTS, Item 545-A

MUCK EXCAVATION, ITEM 117
SB 3716+00-3721+00
NB 3717+75-3723+75

PROPERTY LINE FENCE, ITEM 505-II, MOD
NB 3714+00-3730+00 LT.
SB 3716+00-3732+00 LT.

STA	LOC	OFFSET	DESCRIPT
NEL 3715+00	RT.	1500'	DUG WELL
NEL 3715+50	RT.	210'	DUG WELL
NEL 3716+00	RT.	230'	DUG WATER POOL
NEL 3717+00	LT.	35'	FARM POND
NEL 3720+00	RT.	1500'	SPRING
NEL 3720+00	RT.	1300'	DRILLED WELL
NEL 3725+00	LT.	3700'	DRILLED WELL
NEL 3726+70	RT.	1400'	FARM POND
NEL 3727+25	RT.	175'	DUG WELL
NEL 3730+00	LT.	1300'	DUG WELL
NEL 3730+00	LT.	3600'	DUG SPRING
NEL 3731+00	LT.	1400'	DUG WELL
NEL 3731+00	LT.	2000'	DUG WELL
NEL 3731+00	LT.	3500'	DUG SPRING
NEL 3731+00	LT.	3600'	DUG SPRING
NEL 3731+00	LT.	3900'	DUG WELL
NEL 3731+50	LT.	3550'	DUG SPRING
NEL 3732+00	LT.	1600'	DRILLED WELL
NEL 3732+00	LT.	1630'	DUG WELL
NEL 3732+00	LT.	3500'	DUG SPRING

233

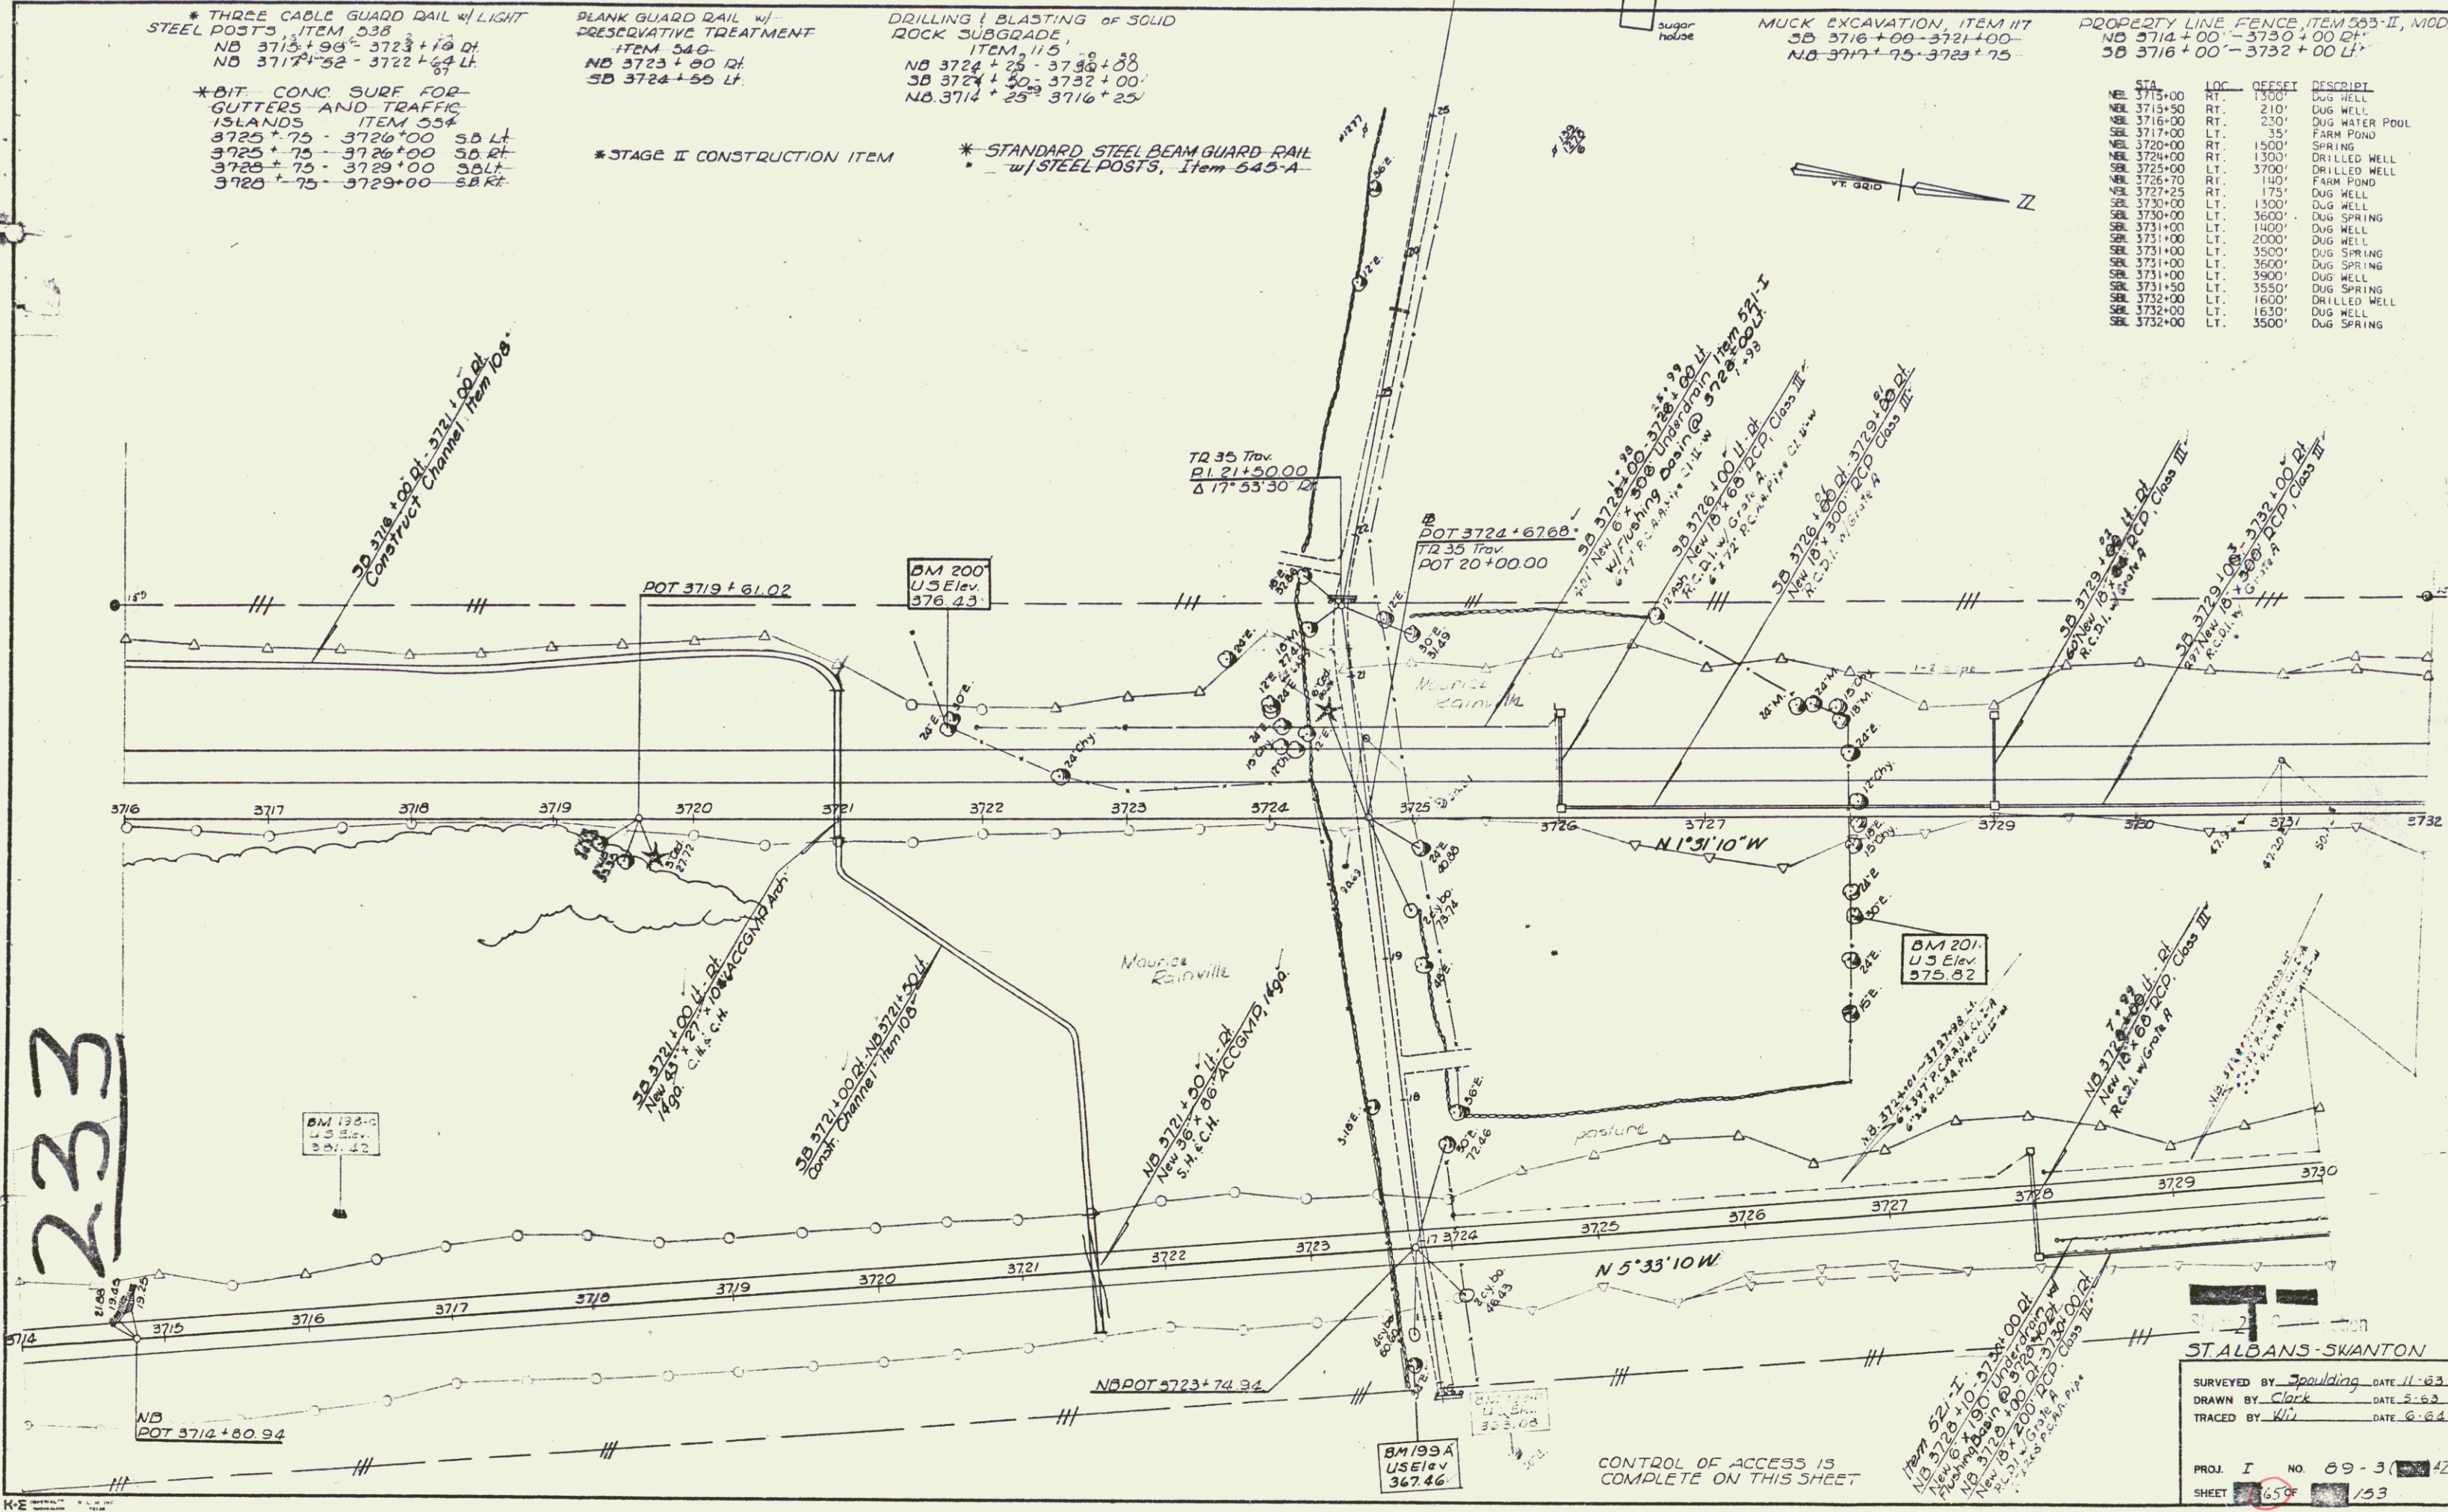

STALBANS-SKANTON

SURVEYED BY Spaulding DATE 11-63
DRAWN BY Clark DATE 5-64
TRACED BY WJ DATE 6-64

PROJ. I NO. 89-3 42
SHEET 65 OF 153

const
72

* THREE CABLE GUARD RAIL
LIGHT STEEL POSTS ITEM 338
S.D. 3744+44.1-3748+00 L.H.
N.B. 3741+45.1-3746+00 L.H.
N.B. 3742+45.1-3746+00 L.H.
S.D. 3744+49-3748+00 L.H.
3+11 7+29
* STAGE II CONSTRUCTION ITEM

DRILLING & BLASTING OF
SOLID ROCK SUBGRADE
ITEM 115

N.B. 3730+00-3742+25
S.D. 3732+00-3741+00 L.H.
ITEM 114


S.B. 3741+60-3745+00
N.B. 3742+21-3742+67

PROPERTY LINE FENCE, ITEM 303 II, MOD
S.B. 3732+00-3748+00 L.H.
N.B. 3730+00-3746+00 R.H.

* BITUM CONC SURF FOR
GUTTERS AND TRAFFIC
ISLANDS ITEM 554
3-732+75-3733+00 S.B.L.
3-732+75-3733+00 S.B.L.
3-736+75-3737+00 S.B.L.
3-736+75-3737+00 S.B.L.
3-739+75-3740+00 S.B.L.
3-739+75-3740+00 S.B.L.
3-740+50-3740+75 S.B.R.

MASS EXCAVATION
ITEM 117
N.B. 3742+75-3748+00
S.B. 3744+75-3748+00

STA	LOC	OFFSET	DESCRIPT
S.B. 3732+00	LT.	3500'	DUG SPRING
S.B. 3732+00	LT.	1800'	DRILLED WELL
S.B. 3732+00	LT.	1630'	OLD DUG WELL
S.B. 3734+00	LT.	1400'	FARM POND
S.B. 3735+00	LT.	3700'	COLLECTION BOX
N.B. 3737+00	RT.	1800'	DRILLED WELL
N.B. 3737+00	RT.	2100'	DRILLED WELL
N.B. 3738+00	RT.	1200'	NAT. FARM POND
N.B. 3738+00	RT.	1500'	FARM POND
N.B. 3741+00	LT.	3900'	DRILLED WELL
N.B. 3741+00	LT.	2300'	DRILLED WELL
S.B. 3746+00	LT.	3700'	DUG WELL

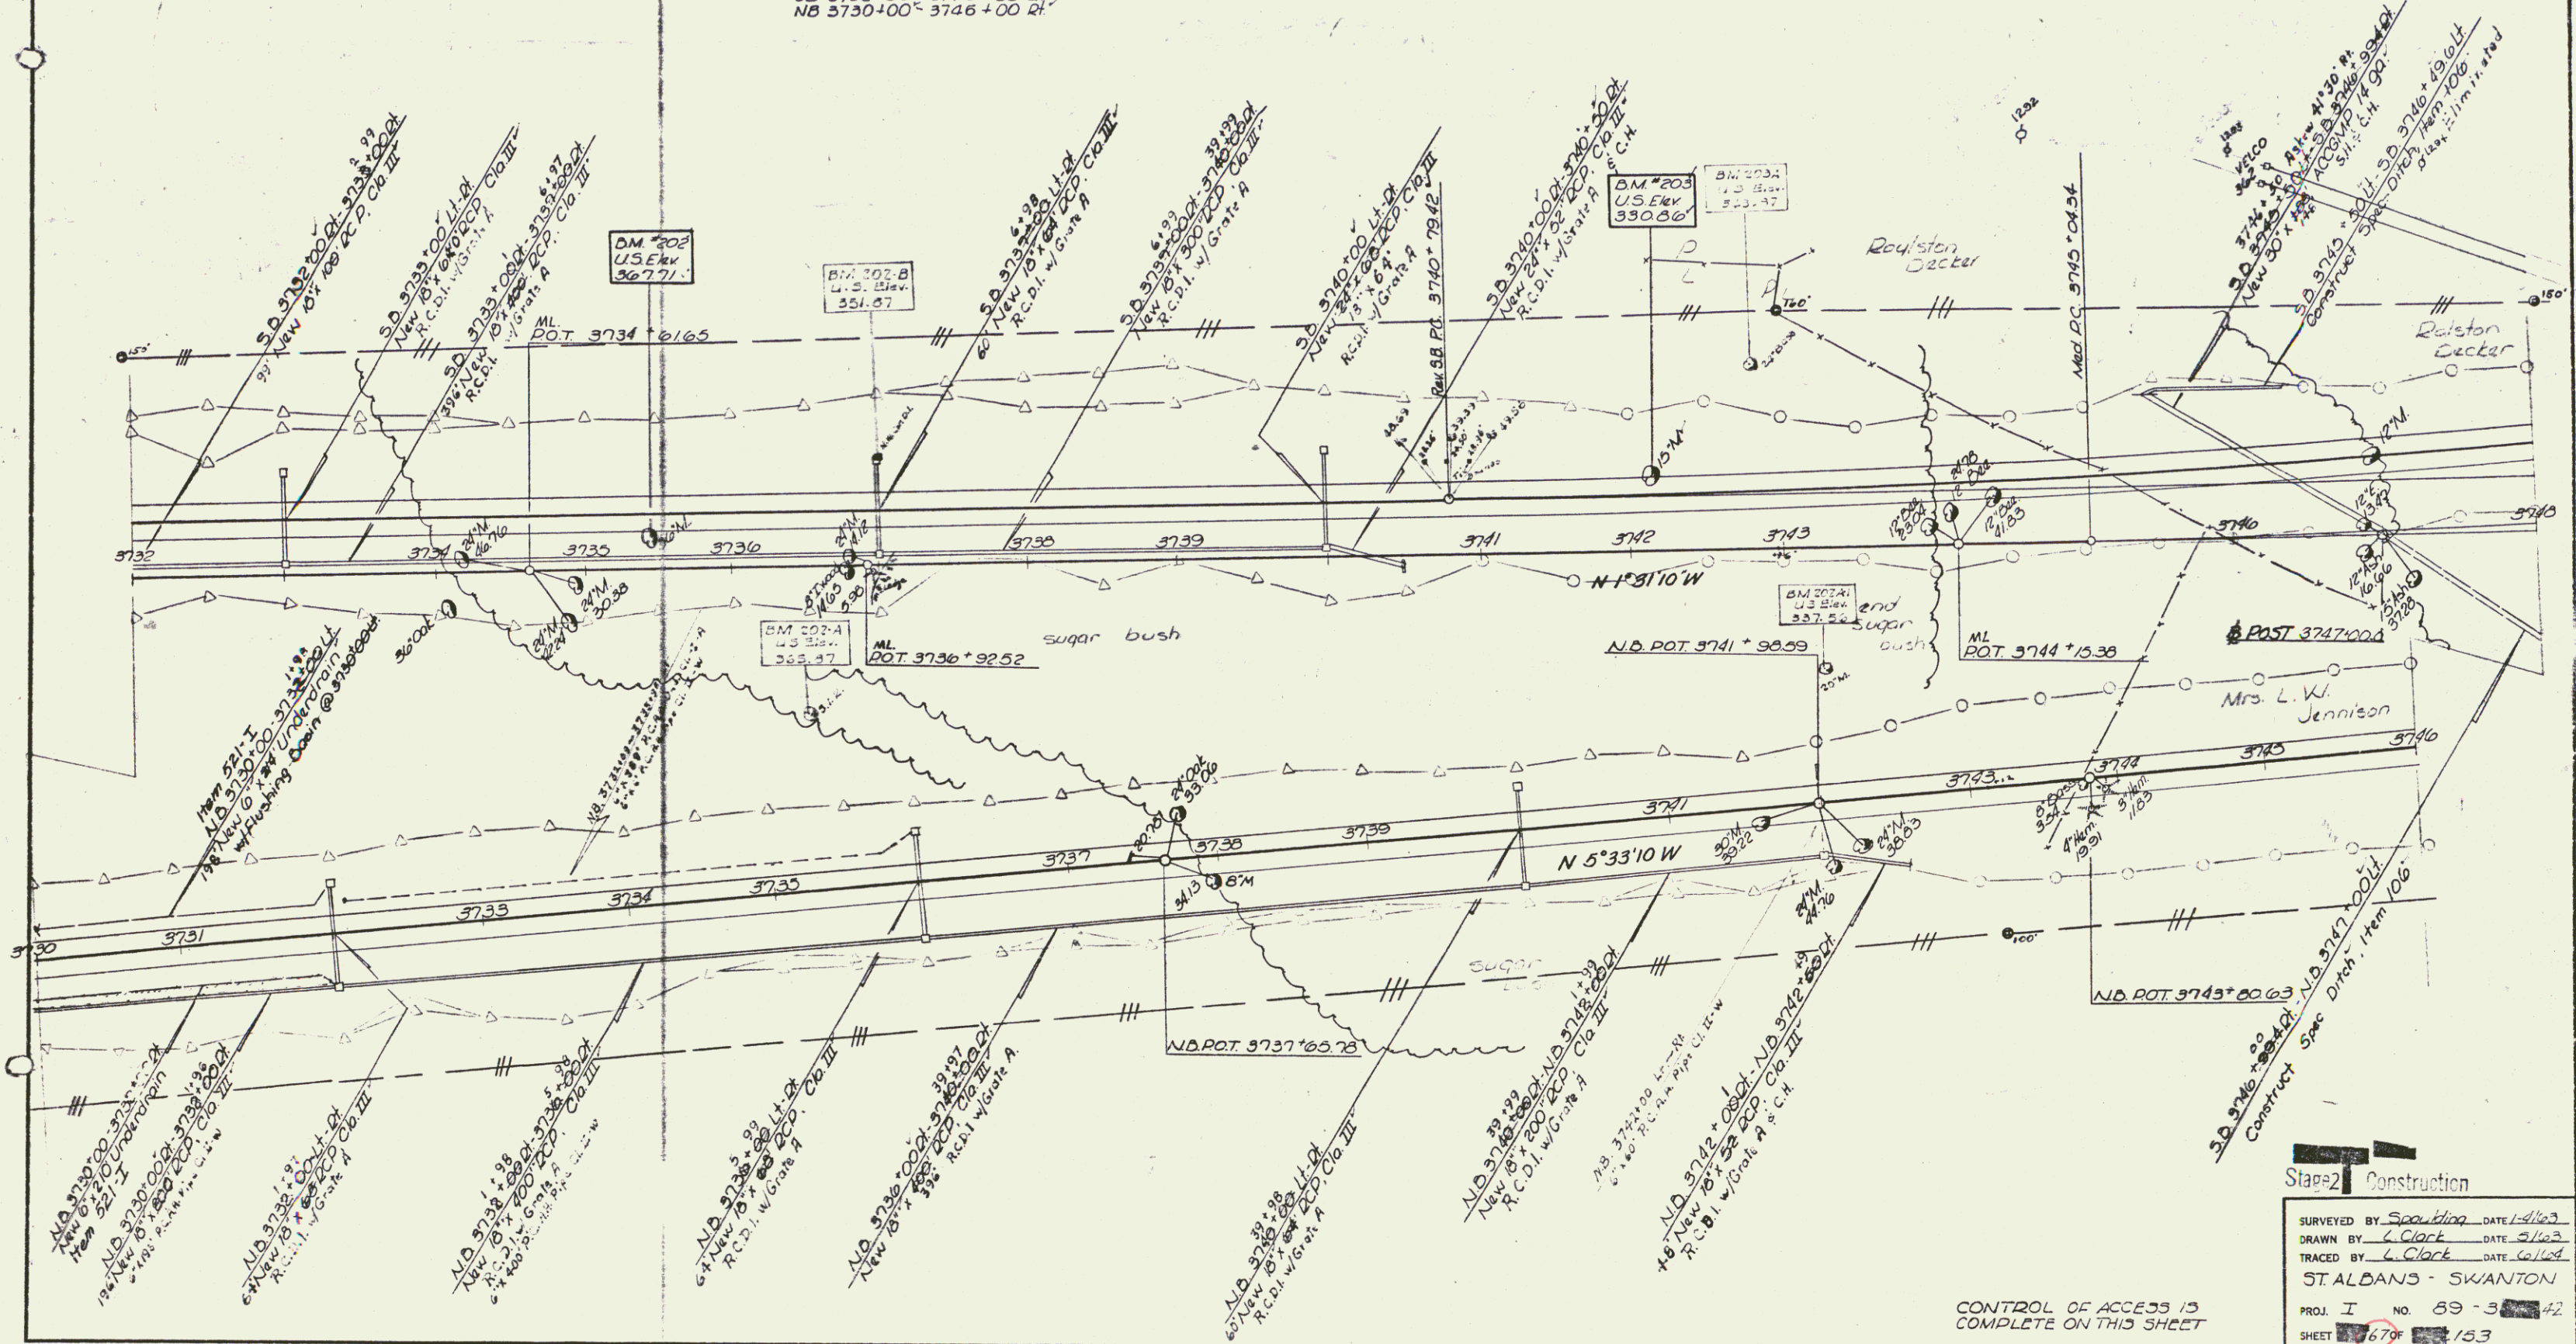

* THREE CABLE GUARD RAIL
W/STEEL POSTS, ITEM 535
JD 3748+00-3749+00
NB 3746+00-3752+00
NB 3746+00-3754+00
SB 3746+00-3748+00

QUADRA FOR BANK PROTECTION MOD.
FOR CULVERT ENDS, ITEM 513-B
NB 3746+00

STONE FILL FOR SLOPE PROTECTION
ITEM 512
NB 3755+00-3764+00
DRILLING & BLASTING, ITEM 111
NB 3751+42-3751+54


DRILLING & BLASTING OF SOLID
ROCK SUBGRADE
ITEM 112
SB 3750+75-3752+75
JD 3764+75-3764+00
NB 3758+40-3764+40

MUCK - EXCAVATION
ITEM 117
NB 3748+00-3750+25
SB 3748+00-3750+25

* DENOTES STAGE II CONSTRUCTION ITEM

PROPERTY LINE FENCE, ITEM 583-II, MOD.
JD 3740+00-3764+00
NB 3746+00-3764+00

STA	LOC	OFFSET	DESCRIPT.
NBL 3748+00	RT.	2800'	DUG WELL
NBL 3750+00	LT.	2400'	FARM POND
NBL 3755+50	LT.	850'	SPRING SHALE AREA
NBL 3755+75	RT.	40'	FARM POND
NBL 3756+20	RT.	25'	FARM POND
NBL 3756+50	LT.	2050'	SPRING SHALE
NBL 3757+00	LT.	1000'	DUG SPRING
NBL 3758+00	RT.	3200'	DRILLED WELL
NBL 3759+00	RT.	3400'	DUG WELL
NBL 3762+00	LT.	3800'	SPRING

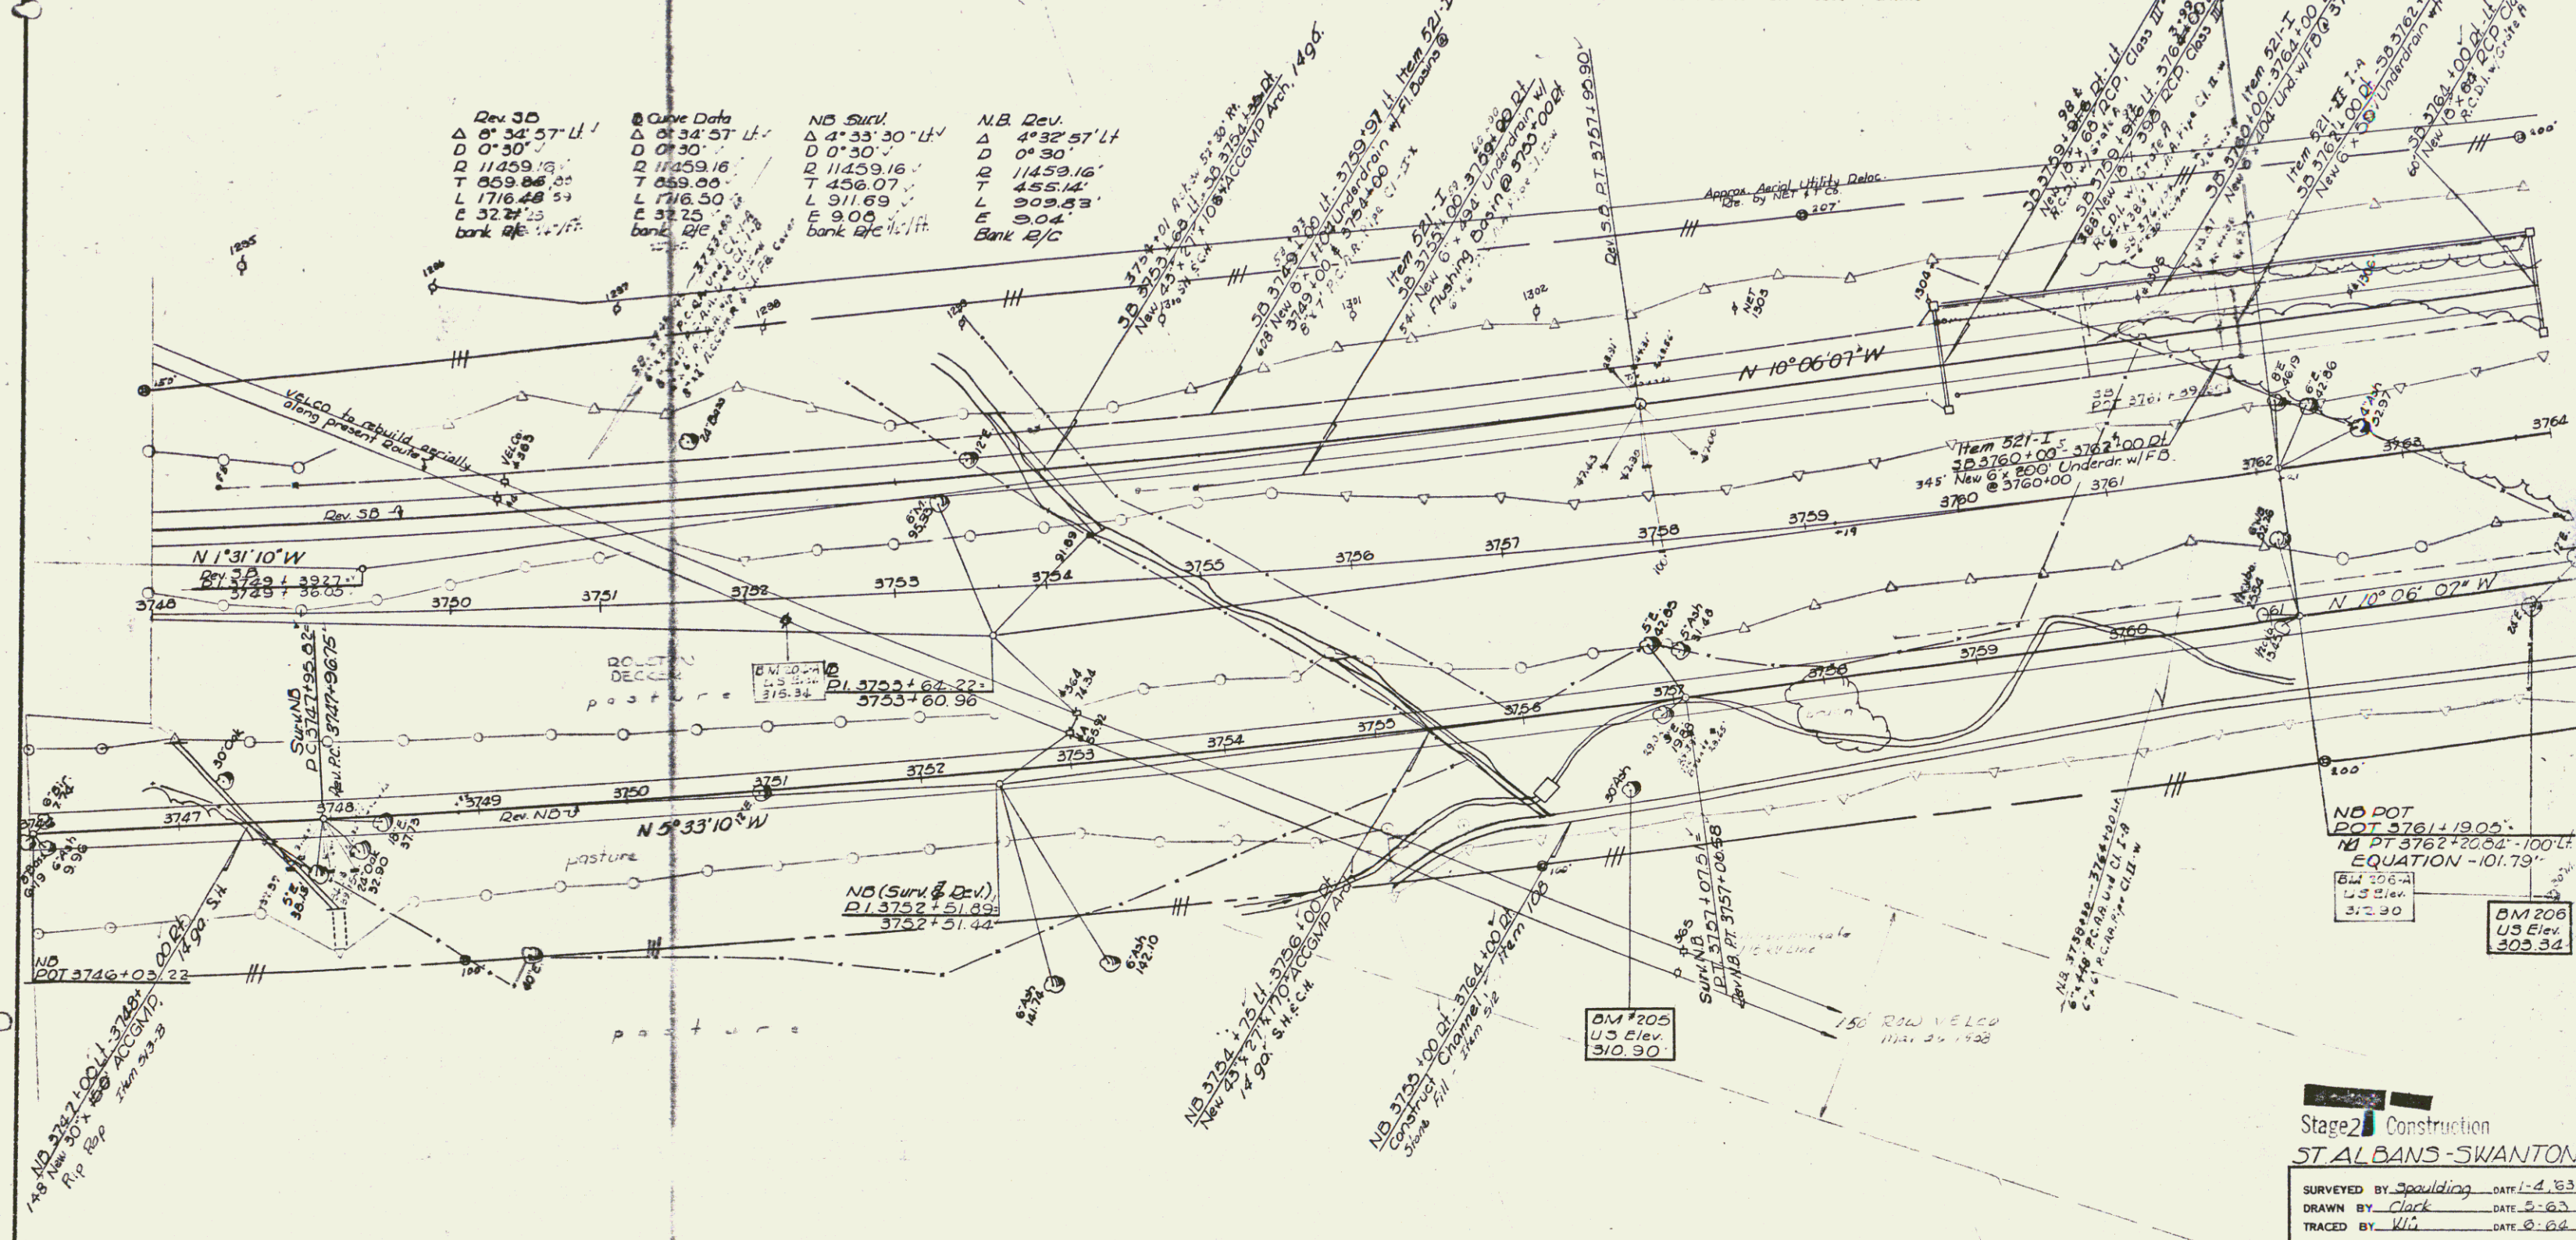

Stage 2 Construction
ST ALBANS - SWANTON
SURVEYED BY Spaulding DATE 1-4-83
DRAWN BY Clark DATE 2-63
TRACED BY WJ DATE 8-66
PROJ. I NO. 89-3-142
SHEET 699 153

CONTROL OF ACCESS IS
COMPLETE ON THIS SHEET

PLAN
ST. ALBANS - SWANTON
I 89 - 3 42
SHEET 133 OF 153

* THREE CABLE GUARD RAIL
LIGHT STEEL POSTS, ITEM 538
S.D. 3789+89 - 3796+00 L.F.
S.D. 3795+89 - 3796+00 L.F.

STONE FILL FOR SLOPE
PROTECTION, ITEM 512
N.D. 3793+50 L.F. - S.D. 3793+50 L.F.
S.D. 3795+89 - 3796+00 L.F.


PLANK GUARD RAIL w/
PRESERVATIVE TREATMENT
ITEM 540
D.L. 3780+00 L.F.

* STAGE II CONSTRUCTION ITEM

DRILLING & BLASTING OF
SOLID ROCK SUBGRADE
ITEM 115
N.D. 3780+75 - 3789+25
S.D. 3780+00 - 3786+75
N.B. 3787+40 - 3788+72

PROPERTY LINE FENCE, ITEM 583-II, MOD.
N.D. 153 3780+00 - 3796+00 L.F. & D.

STA.	LOC.	OFFSET	DESCRIPT.
SBL 3782+00	LT.	1750'	FARM POND
SBL 3783+00	LT.	1400'	DUG SPRING
SBL 3784+50	LT.	1350'	DUG SPRING
SBL 3784+50	LT.	2200'	FARM POND
SBL 3788+00	LT.	600'	DUG SPRING
NBL 3788+00	RT.	375'	FARM POND
SBL 3792+00	LT.	1000'	DUG SPRING

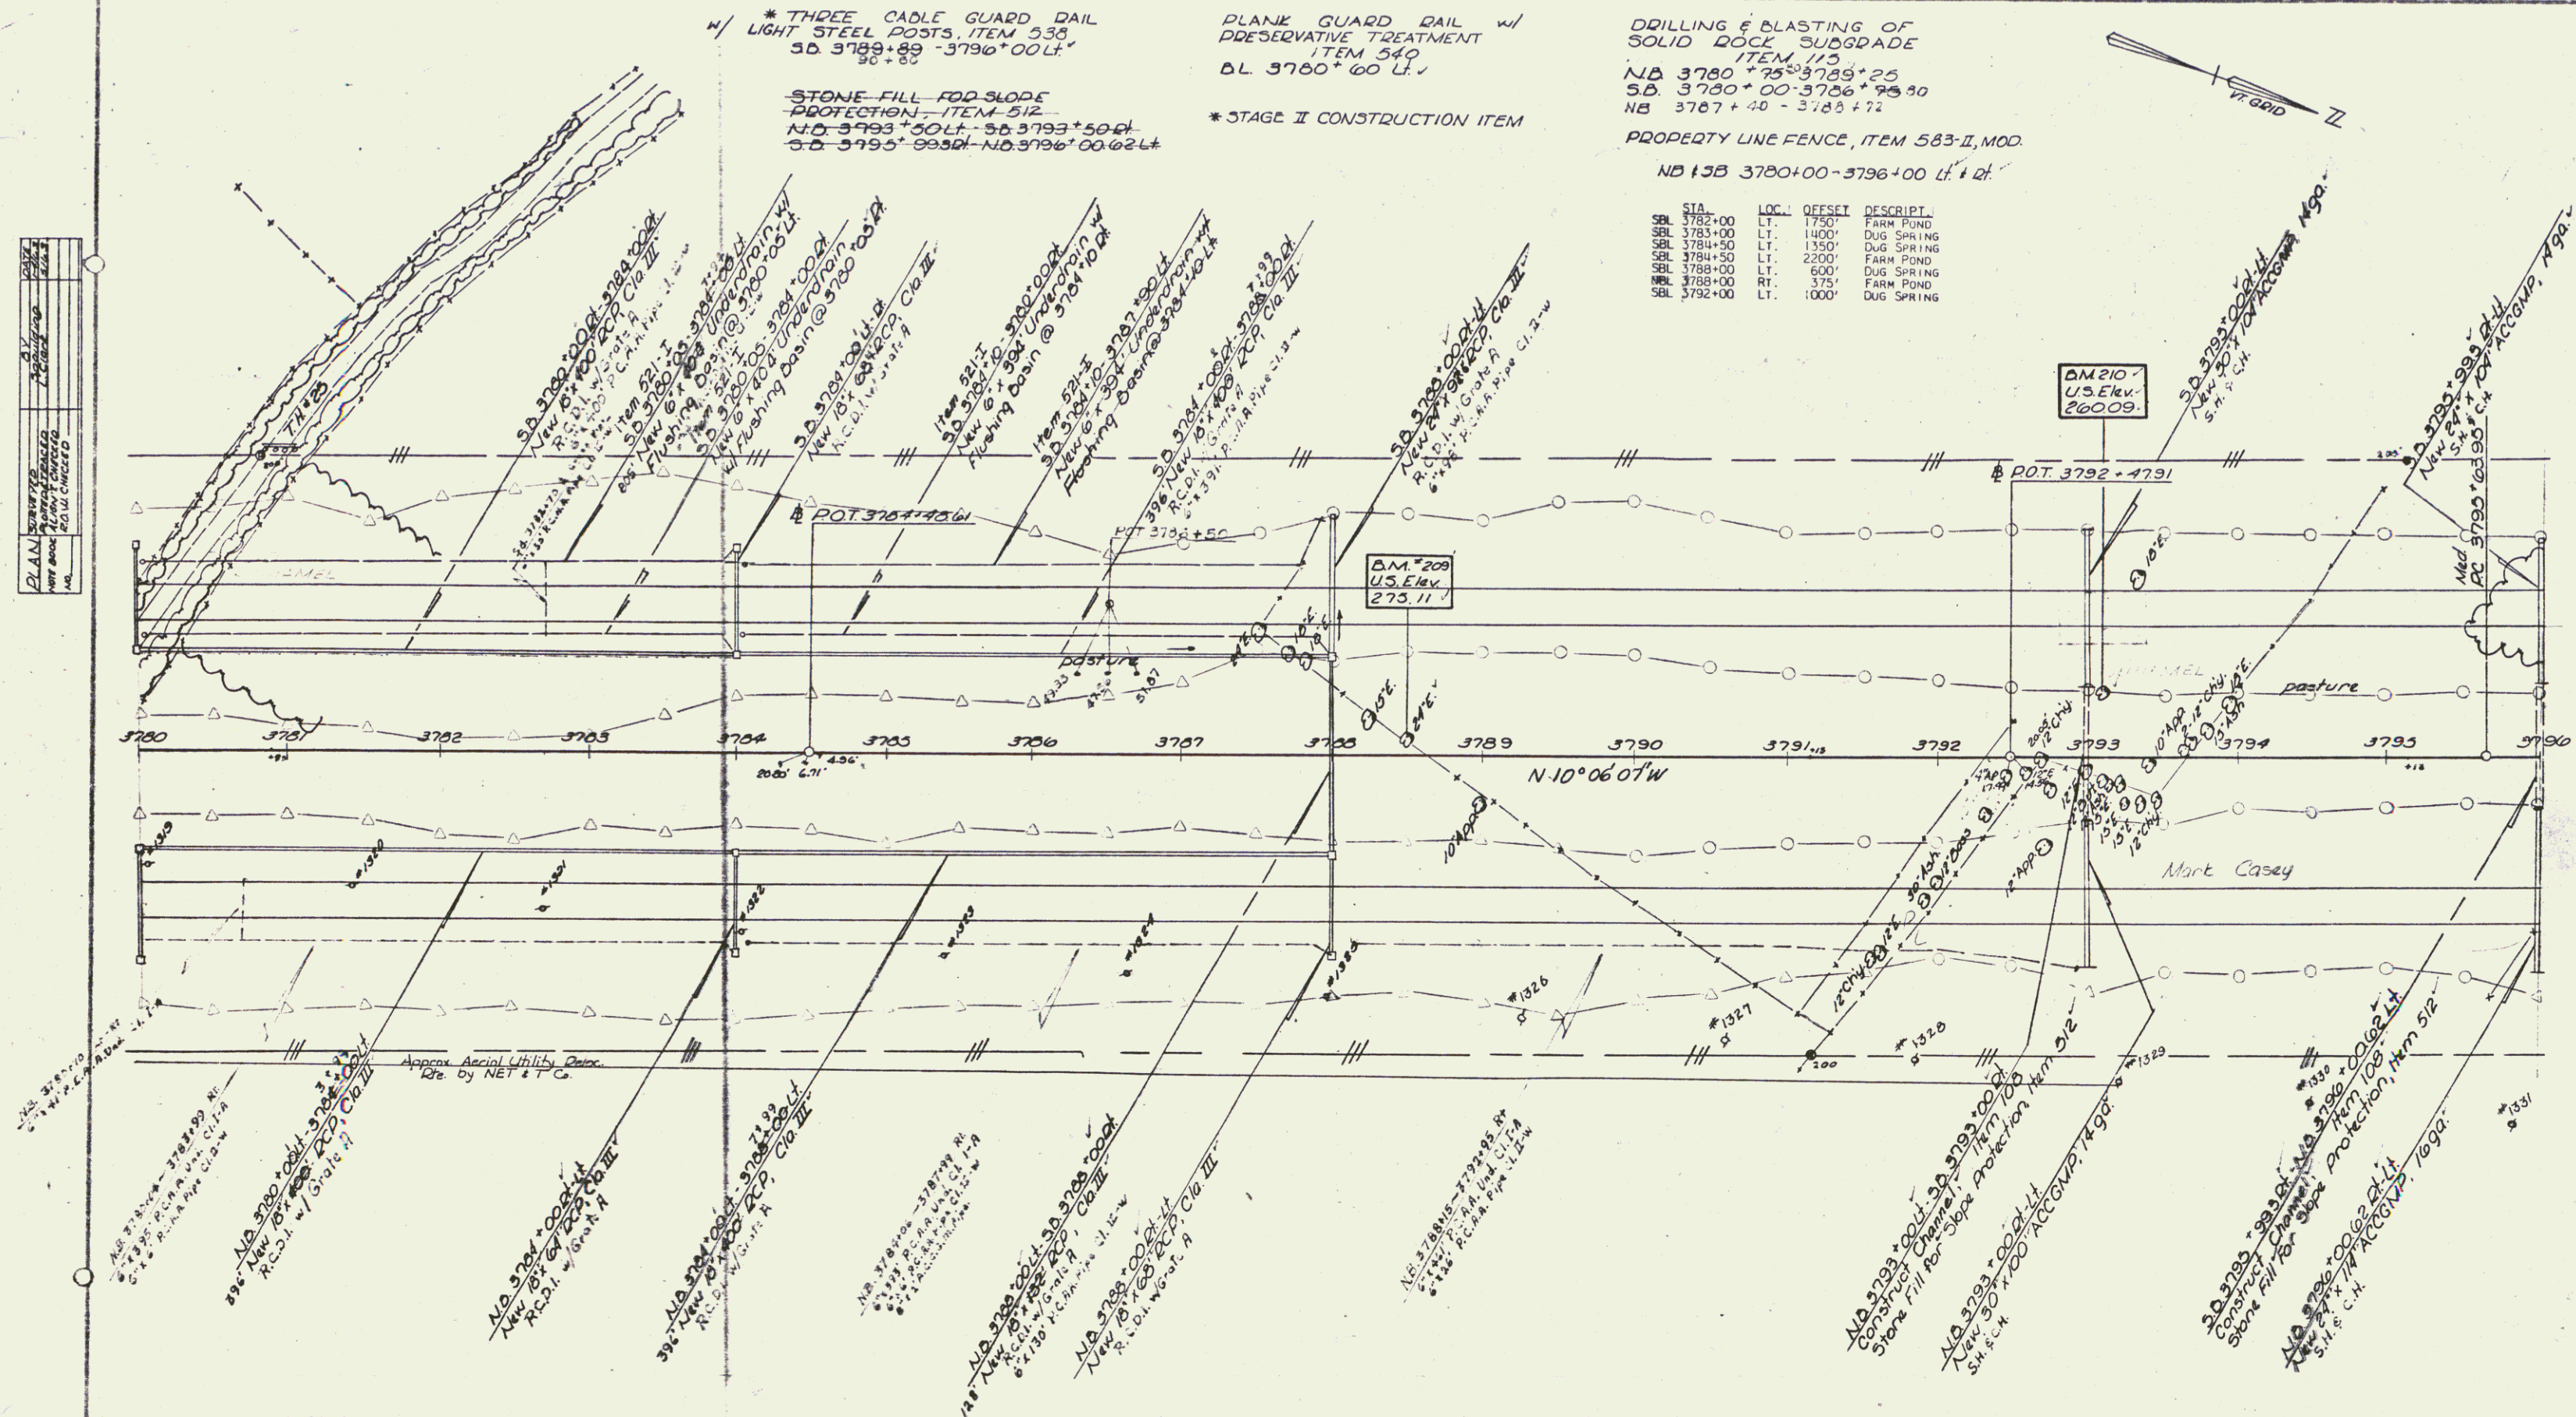

Stage 2 Construction
ST. ALBANS - SWANTON
I 89 - 3 42

CONTROL OF ACCESS IS
COMPLETE ON THIS SHEET

SHEET 133 OF 153

Const.

76


* THREE CABLE GUARD RAIL w/
LIGHT STEEL POSTS ITEM 538
N.B. 3799+27.41 - 3804+23.41
S.D. 3796+00.11 - 3797+09.11
* STAGE II CONSTRUCTION ITEM

DRILLING & BLASTING OF SOLID ROCK SUBGRADE
ITEM 555
38 3806+30 - 3812+00
N.B. 3811+50 - 3812+00

* BITUM CONC CURB
ITEM 553
N.B. 3800+59 - 3803+46.4

PROPERTY LINE FENCE, ITEM 563-II, MOD
N.B. 38 3796+00 - 3812+00 U.I. 121

STA	LOC	OFFSET	DESCRIPT
SBL 3795+50	LT	1200'	DRILLED WELL
SBL 3802+00	LT	650'	DUG SPRING
SBL 3802+00	RT	25'	FARM POND
SBL 3805+00	LT	300'	DRILLED WELL
SBL 3805+50	LT	930'	DUG WELL

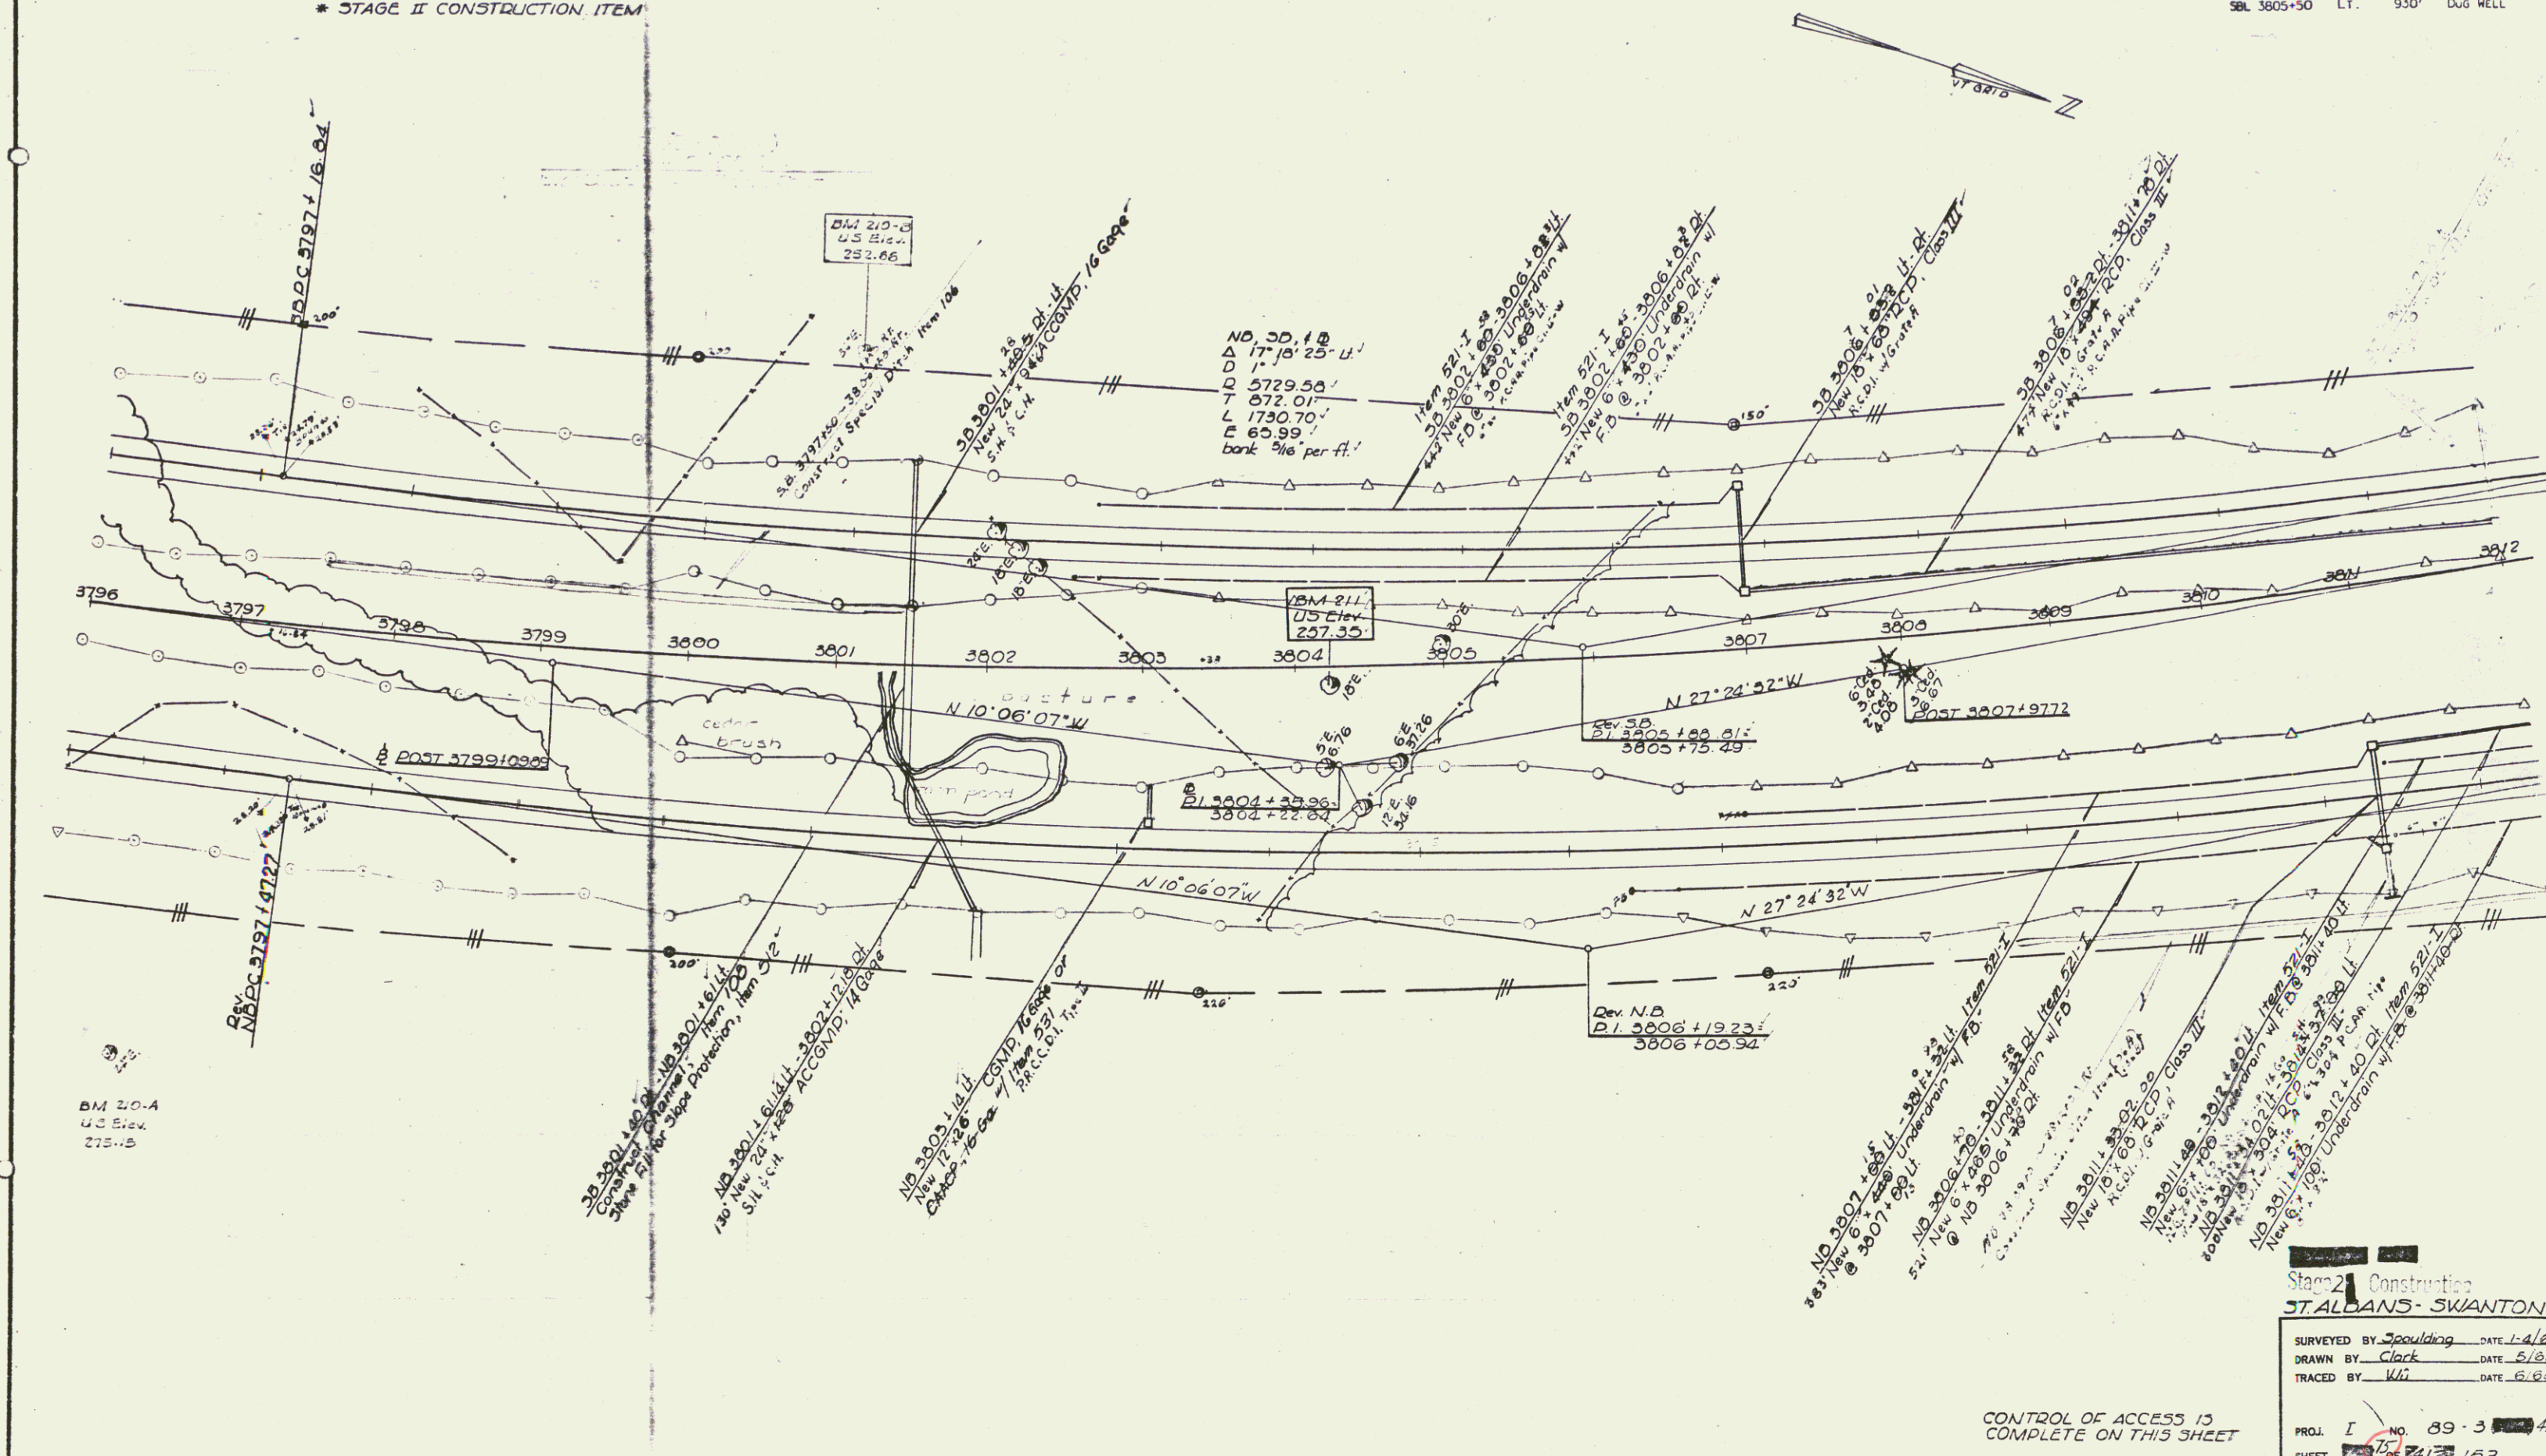

Stage II Construction
STALBANS - SWANTON

SURVEYED BY Spaulding DATE 1-4-63
DRAWN BY Clark DATE 6-63
TRACED BY WJ DATE 6-63



CONTROL OF ACCESS IS
COMPLETE ON THIS SHEET

PROJ. I NO. 89-3-42
SHEET 153

Const
77

PLAN	DATE
DESIGNED	BY
CHECKED	BY
IN CHARGE	BY
NO.	

PROFILE	DATE
DESIGNED	BY
CHECKED	BY
IN CHARGE	BY
NO.	

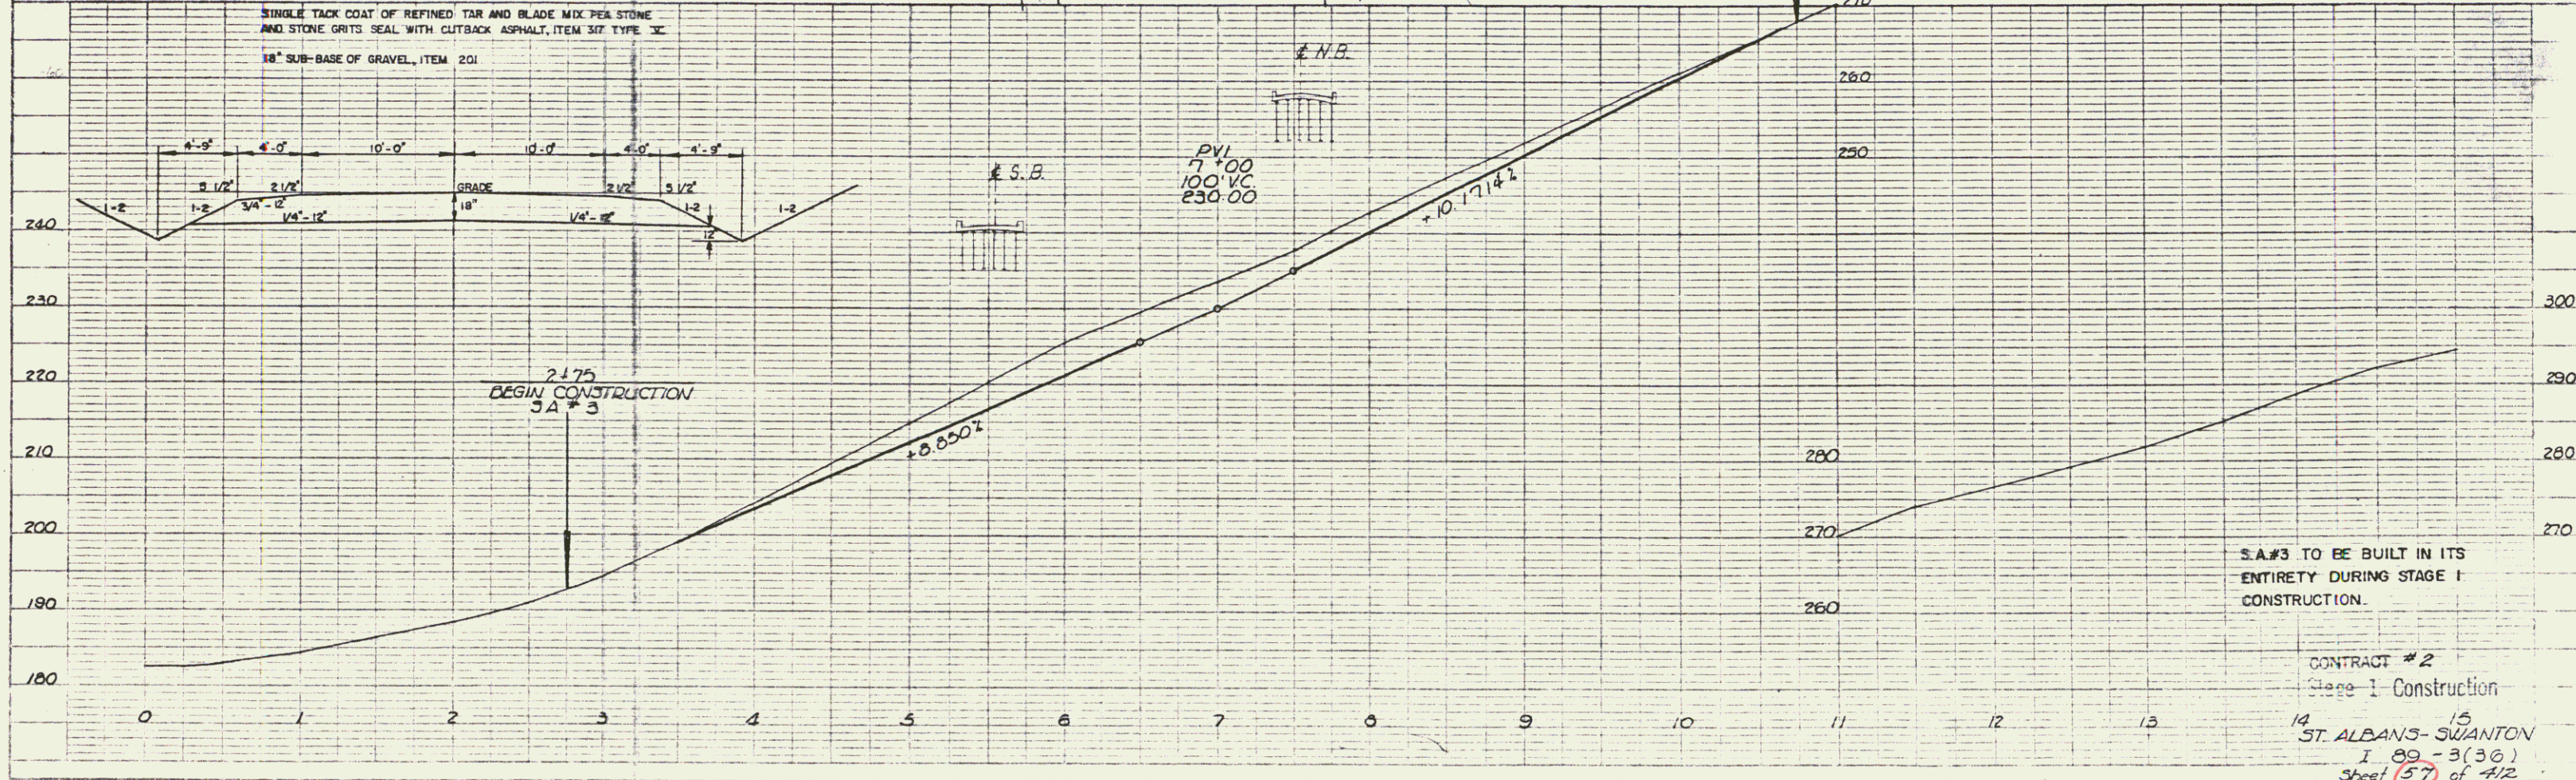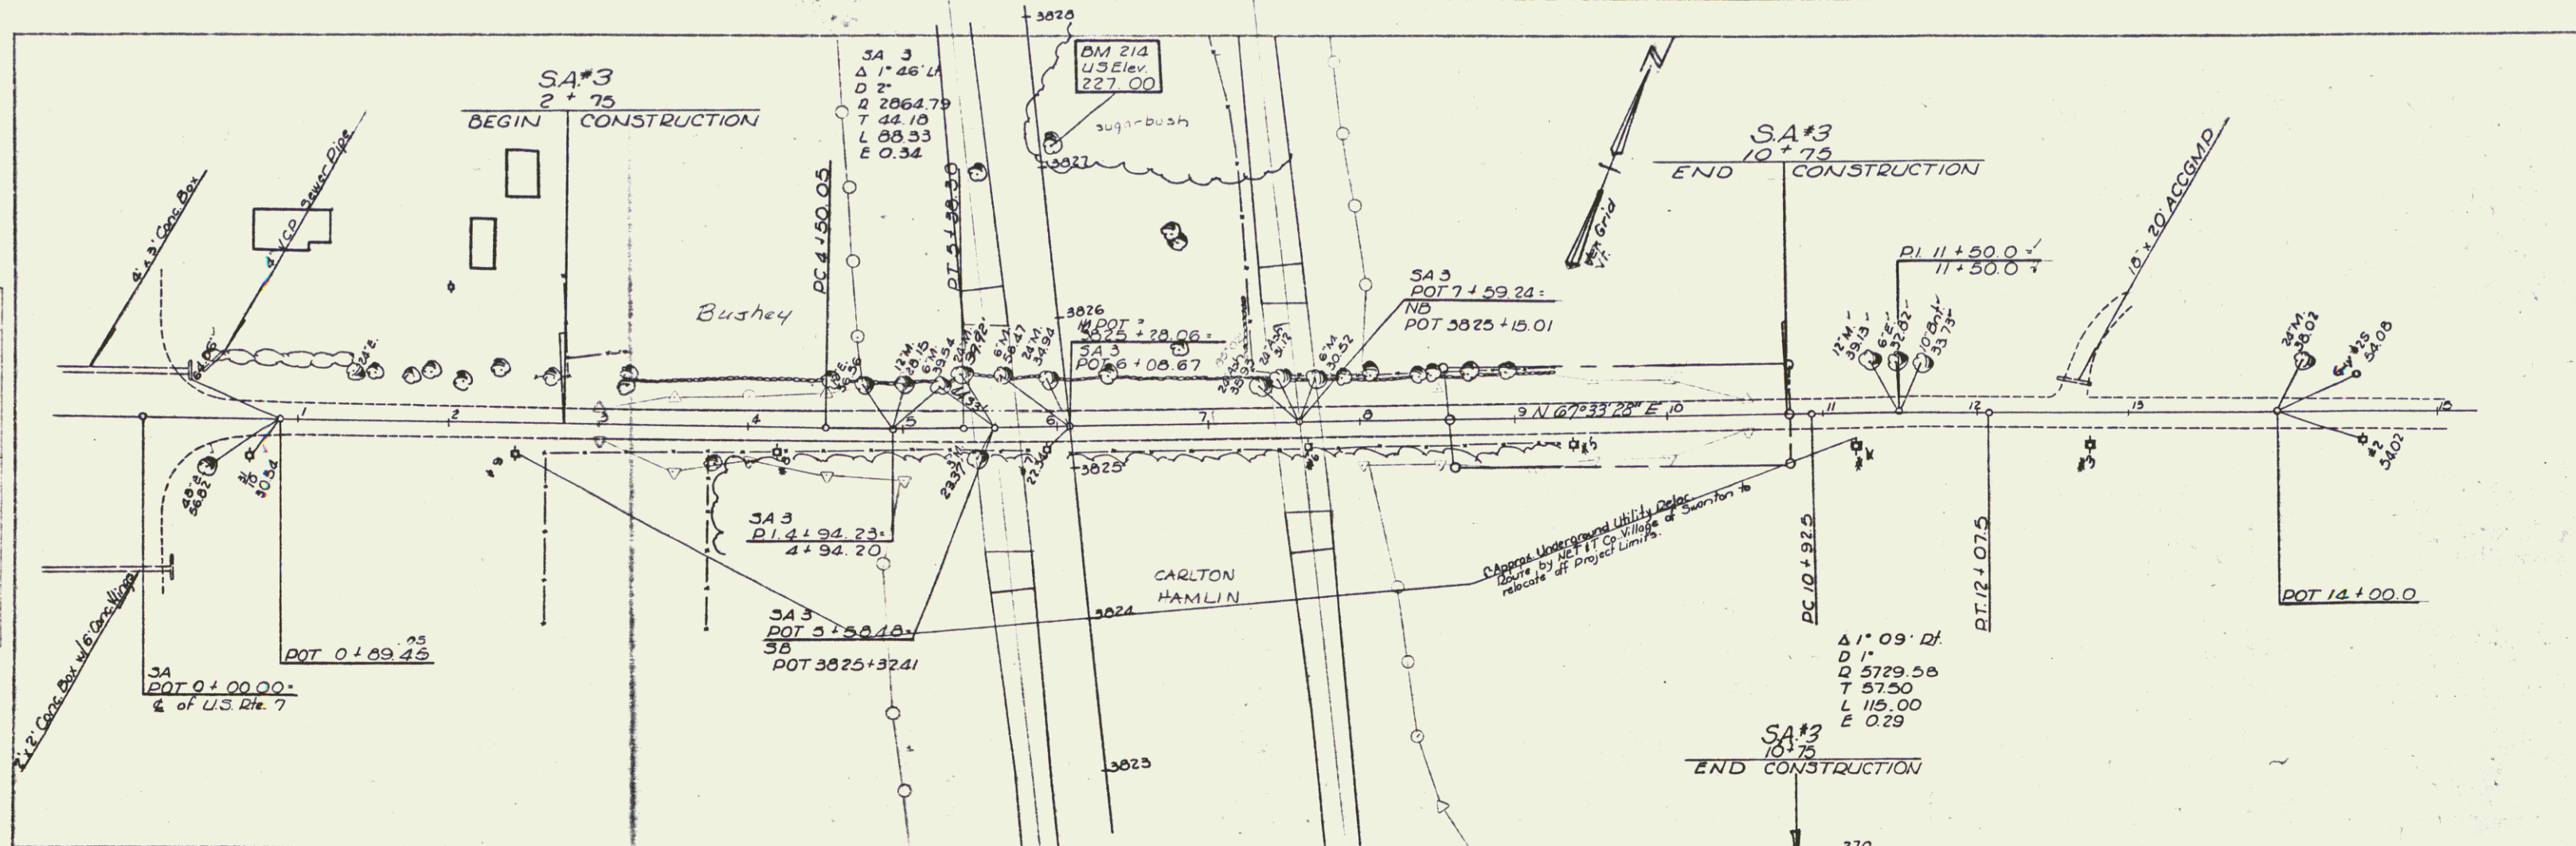

* THREE CABLE GUARD RAIL WITH LIGHT STEEL POSTS, ITEM 538

SB 3015 + 63.4 - 3023 + 32.4
 SB 3026 + 27.4 - 3028 + 00.4
 SB 3015 + 34.4 - 3023 + 4.4

NB 3015 + 84.4 - 3022 + 29.4
 NB 3026 + 96.4 - 3028 + 00.4
 NB 3017 + 59.4 - 3022 + 34.4
 NB 3026 + 83.4 - 3028 + 00.4

* STAGE II CONSTRUCTION ITEM

CONTROL OF ACCESS IS COMPLETE ON THIS SHEET

DRILLING & BLASTING OF SOLID ROCK SUBGRADE, Item 115

SB 3012 + 00 - 3013 + 50
 NB 3012 + 80 - 3014 + 50

BITUM CONC SURF FOR GUTTERS & TRAFFIC ISLANDS, ITEM 554

3024+00 Slope NB RT

STA	LOC	OFFSET	DESCRIPTION
BL 3012+25	RT	350'	DUG SPRING
BL 3013+80	RT	15'	DUG SPRING
BL 3014+00	RT	1400'	FARM POND
BL 3014+50	LT	15'	DUG SPRING
BL 3014+50	LT	170'	DUG SPRING & COLL. BOX
BL 3015+00	LT	650'	DRILLED WELL
BL 3020+00	RT	1800'	DUG SPRING
BL 3021+50	LT	300'	DUG WELL
BL 3021+50	LT	370'	DUG WELL & COLL. BOX
BL 3022+00	RT	1700'	FARM POND
BL 3022+50	LT	375'	FARM POND
BL 3023+80	LT	650'	DRILLED WELL
BL 3026+90	LT	535'	DRILLED WELL

BRIDGE RAILING (for BRIDGE APPROACHES)

ITEM 572

NB 3022+12 - 3024+50 RT + 25
 NB 3025+80 - 3027+00 RT + 25
 NB 3022+00 - 3024+50 LT + 25
 NB 3025+80 - 3027+00 LT + 25
 SB 3023+84 - 3024+59 LT + 25
 SB 3026+11 - 3028+49 LT + 25
 SB 3026+03 - 3028+44 RT + 25
 SB 3023+39 - 3024+64 RT + 25

TREATED TIMBER

* BITUM CONC CURB ITEM 555

SB 3020+05 - 3020+51 PT
 SB 3020+12 - 3020+51 LT
 NB 3023+99 - 3024+50 PT
 NB 3023+99 - 3024+44 LT

PROPERTY LINE FENCE, ITEM 505-II, MOD

NB 3012+00 PT - 3020+00 LT
 SB 3012+00 LT - 3020+00 LT
 NB 3025+41 - 3025+50 LT

SA #3
 1965 ADT 300


For water 2-1/2 ft
 S: 3025+77 ft - 3025+51 ft
 S: 3025+77 ft - NB 3024+70 ft

STAND FILL for Slope Protection

SA #3 Sta. 9+52 to 1+00 ft
 Sta. 8+62 ft to 9+62 ft


SA #3
 1965 ADT 300

For water 2-1/2 ft
 S: 3025+77 ft - 3025+51 ft
 S: 3025+77 ft - NB 3024+70 ft

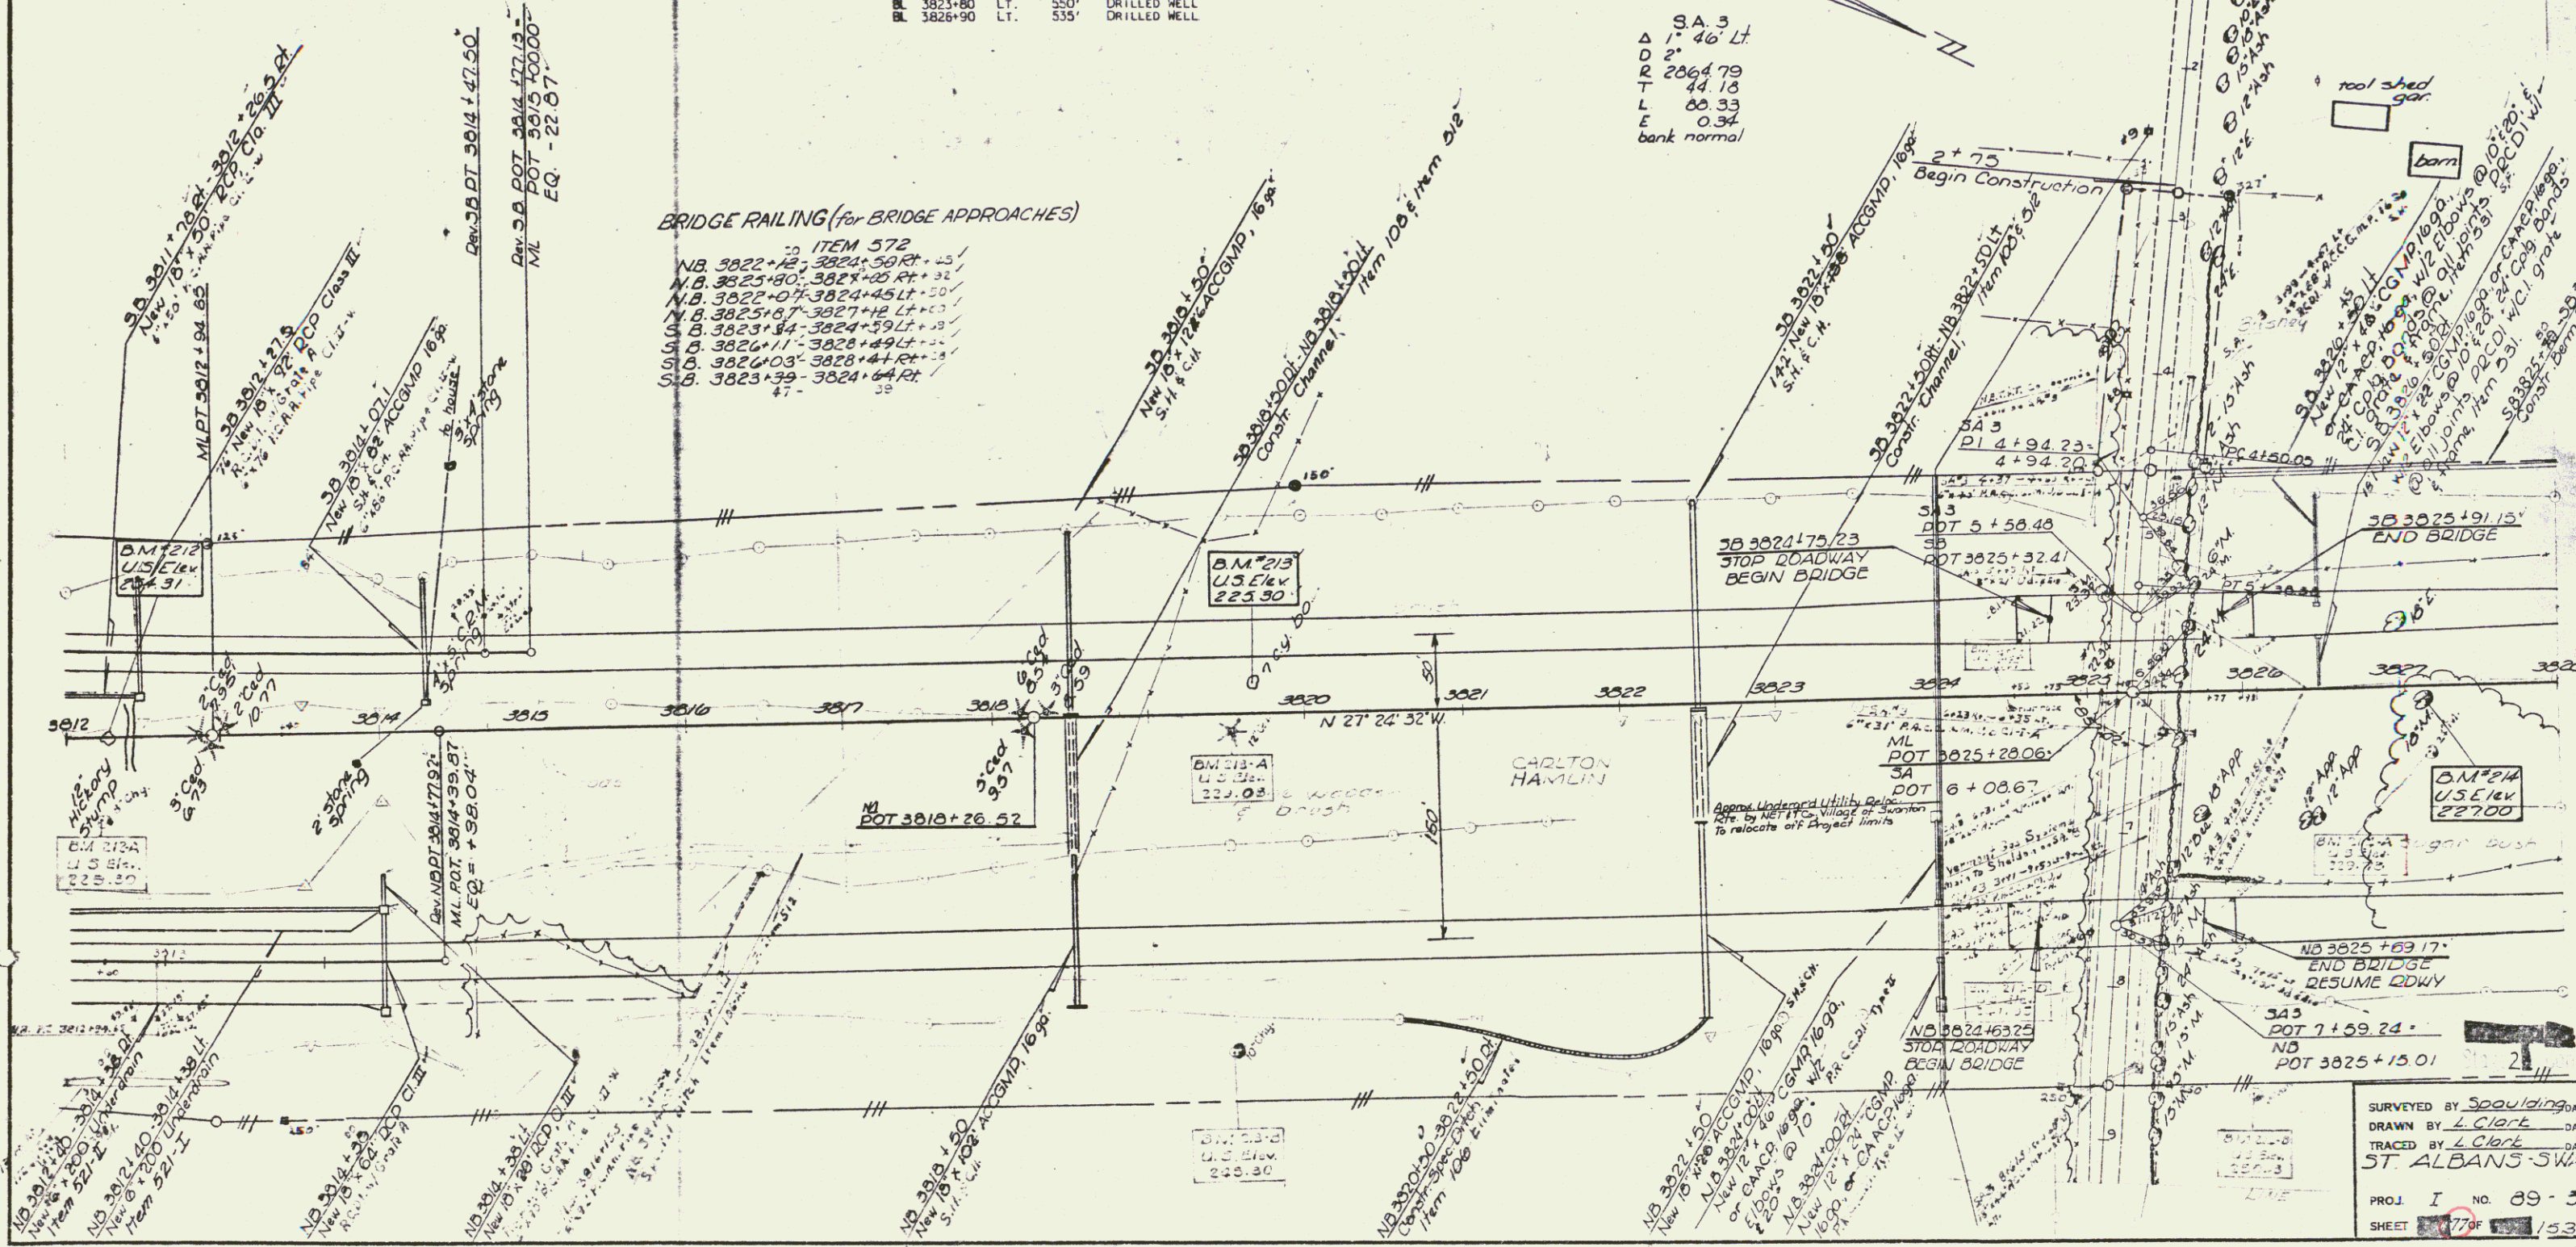

SURVEYED BY Spaulding DATE 1-14-63
 DRAWN BY L. Clerk DATE 3-16-63
 TRACED BY L. Clerk DATE 5-16-63
 ST. ALBANS-SWANTON

PROJ. I NO. 89-3(1)42
 SHEET 77 OF 153

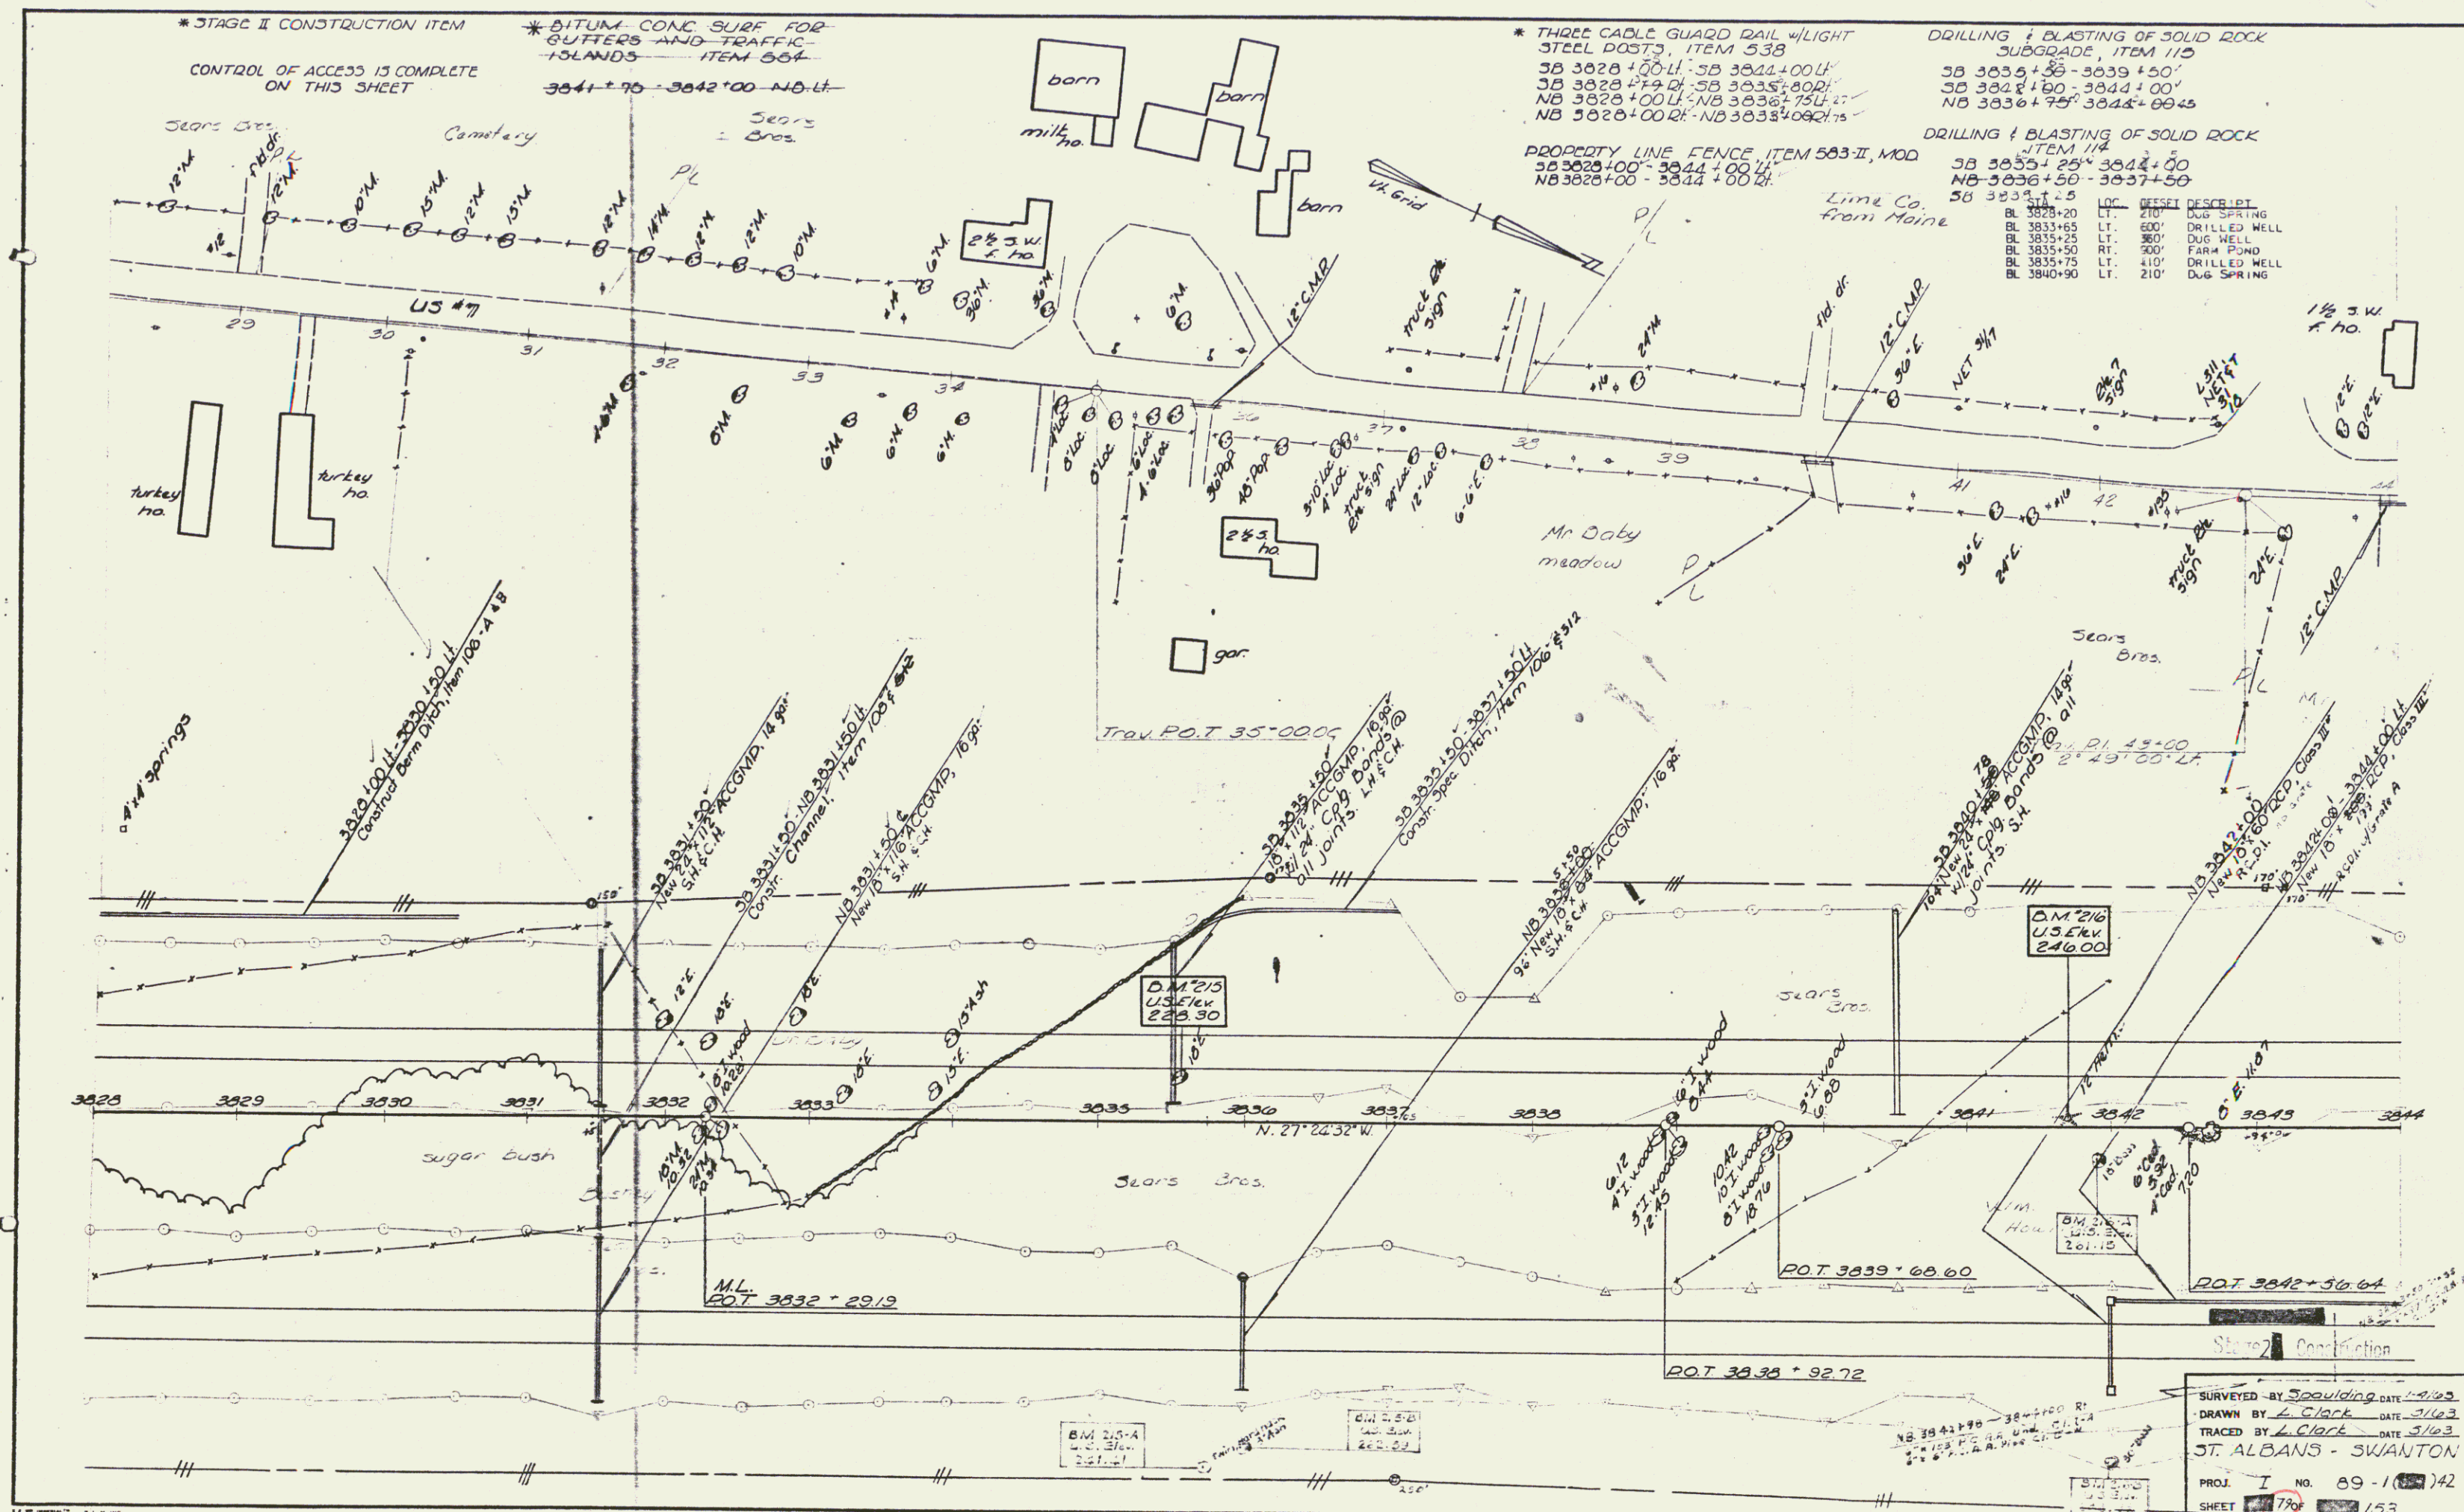

STAGE II Construction

SURVEYED BY Spaulding DATE 4/63
DRAWN BY L. Clark DATE 5/63
TRACED BY L. Clark DATE 5/63
J.T. ALBANS - SWANTON

PROJ. I NO. 89-1(8)42
SHEET 79 of 153

Row 80

