

COUNTY OF WINDHAM

Pin # 99R036

- Yellow = LIMITED ACCESS PURCHASE.
- Orange = NON LIMITED ACCESS PURCHASE.
- Green = AS BUILT RIGHT OF WAY FENCE.

RIGHT-OF-WAY and Construction Plans

RIGHT-OF-WAY DIVISION
TOWN FILE

Interstate PERPETUAL
Route I 91
Town of _____
(To Be Returned To R.O.W. Division)

POOR ORIGINAL COPY


MP 000-399

271.55

STEARNS R. JENKINS

2/15
 5/15
 7/15
 CARLSON
 JR. & A.J.A.
 TRACED
 11/15
 12/15
 1/16
 2/16
 3/16
 4/16
 5/16
 6/16
 7/16
 8/16
 9/16
 10/16
 11/16
 12/16
 1/17
 2/17
 3/17
 4/17
 5/17
 6/17
 7/17
 8/17
 9/17
 10/17
 11/17
 12/17
 1/18
 2/18
 3/18
 4/18
 5/18
 6/18
 7/18
 8/18
 9/18
 10/18
 11/18
 12/18
 1/19
 2/19
 3/19
 4/19
 5/19
 6/19
 7/19
 8/19
 9/19
 10/19
 11/19
 12/19
 1/20
 2/20
 3/20
 4/20
 5/20
 6/20
 7/20
 8/20
 9/20
 10/20
 11/20
 12/20
 1/21
 2/21
 3/21
 4/21
 5/21
 6/21
 7/21
 8/21
 9/21
 10/21
 11/21
 12/21
 1/22
 2/22
 3/22
 4/22
 5/22
 6/22
 7/22
 8/22
 9/22
 10/22
 11/22
 12/22
 1/23
 2/23
 3/23
 4/23
 5/23
 6/23
 7/23
 8/23
 9/23
 10/23
 11/23
 12/23
 1/24
 2/24
 3/24
 4/24
 5/24
 6/24
 7/24
 8/24
 9/24
 10/24
 11/24
 12/24
 1/25
 2/25
 3/25
 4/25
 5/25
 6/25
 7/25
 8/25
 9/25
 10/25
 11/25
 12/25
 1/26
 2/26
 3/26
 4/26
 5/26
 6/26
 7/26
 8/26
 9/26
 10/26
 11/26
 12/26
 1/27
 2/27
 3/27
 4/27
 5/27
 6/27
 7/27
 8/27
 9/27
 10/27
 11/27
 12/27
 1/28
 2/28
 3/28
 4/28
 5/28
 6/28
 7/28
 8/28
 9/28
 10/28
 11/28
 12/28
 1/29
 2/29
 3/29
 4/29
 5/29
 6/29
 7/29
 8/29
 9/29
 10/29
 11/29
 12/29
 1/30
 2/30
 3/30
 4/30
 5/30
 6/30
 7/30
 8/30
 9/30
 10/30
 11/30
 12/30
 1/31
 2/31
 3/31
 4/31
 5/31
 6/31
 7/31
 8/31
 9/31
 10/31
 11/31
 12/31
 1/32
 2/32
 3/32
 4/32
 5/32
 6/32
 7/32
 8/32
 9/32
 10/32
 11/32
 12/32
 1/33
 2/33
 3/33
 4/33
 5/33
 6/33
 7/33
 8/33
 9/33
 10/33
 11/33
 12/33
 1/34
 2/34
 3/34
 4/34
 5/34
 6/34
 7/34
 8/34
 9/34
 10/34
 11/34
 12/34
 1/35
 2/35
 3/35
 4/35
 5/35
 6/35
 7/35
 8/35
 9/35
 10/35
 11/35
 12/35
 1/36
 2/36
 3/36
 4/36
 5/36
 6/36
 7/36
 8/36
 9/36
 10/36
 11/36
 12/36
 1/37
 2/37
 3/37
 4/37
 5/37
 6/37
 7/37
 8/37
 9/37
 10/37
 11/37
 12/37
 1/38
 2/38
 3/38
 4/38
 5/38
 6/38
 7/38
 8/38
 9/38
 10/38
 11/38
 12/38
 1/39
 2/39
 3/39
 4/39
 5/39
 6/39
 7/39
 8/39
 9/39
 10/39
 11/39
 12/39
 1/40
 2/40
 3/40
 4/40
 5/40
 6/40
 7/40
 8/40
 9/40
 10/40
 11/40
 12/40
 1/41
 2/41
 3/41
 4/41
 5/41
 6/41
 7/41
 8/41
 9/41
 10/41
 11/41
 12/41
 1/42
 2/42
 3/42
 4/42
 5/42
 6/42
 7/42
 8/42
 9/42
 10/42
 11/42
 12/42
 1/43
 2/43
 3/43
 4/43
 5/43
 6/43
 7/43
 8/43
 9/43
 10/43
 11/43
 12/43
 1/44
 2/44
 3/44
 4/44
 5/44
 6/44
 7/44
 8/44
 9/44
 10/44
 11/44
 12/44
 1/45
 2/45
 3/45
 4/45
 5/45
 6/45
 7/45
 8/45
 9/45
 10/45
 11/45
 12/45
 1/46
 2/46
 3/46
 4/46
 5/46
 6/46
 7/46
 8/46
 9/46
 10/46
 11/46
 12/46
 1/47
 2/47
 3/47
 4/47
 5/47
 6/47
 7/47
 8/47
 9/47
 10/47
 11/47
 12/47
 1/48
 2/48
 3/48
 4/48
 5/48
 6/48
 7/48
 8/48
 9/48
 10/48
 11/48
 12/48
 1/49
 2/49
 3/49
 4/49
 5/49
 6/49
 7/49
 8/49
 9/49
 10/49
 11/49
 12/49
 1/50
 2/50
 3/50
 4/50
 5/50
 6/50
 7/50
 8/50
 9/50
 10/50
 11/50
 12/50
 1/51
 2/51
 3/51
 4/51
 5/51
 6/51
 7/51
 8/51
 9/51
 10/51
 11/51
 12/51
 1/52
 2/52
 3/52
 4/52
 5/52
 6/52
 7/52
 8/52
 9/52
 10/52
 11/52
 12/52
 1/53
 2/53
 3/53
 4/53
 5/53
 6/53
 7/53
 8/53
 9/53
 10/53
 11/53
 12/53
 1/54
 2/54
 3/54
 4/54
 5/54
 6/54
 7/54
 8/54
 9/54
 10/54
 11/54
 12/54
 1/55
 2/55
 3/55
 4/55
 5/55
 6/55
 7/55
 8/55
 9/55
 10/55
 11/55
 12/55
 1/56
 2/56
 3/56
 4/56
 5/56
 6/56
 7/56
 8/56
 9/56
 10/56
 11/56
 12/56
 1/57
 2/57
 3/57
 4/57
 5/57
 6/57
 7/57
 8/57
 9/57
 10/57
 11/57
 12/57
 1/58
 2/58
 3/58
 4/58
 5/58
 6/58
 7/58
 8/58
 9/58
 10/58
 11/58
 12/58
 1/59
 2/59
 3/59
 4/59
 5/59
 6/59
 7/59
 8/59
 9/59
 10/59
 11/59
 12/59
 1/60
 2/60
 3/60
 4/60
 5/60
 6/60
 7/60
 8/60
 9/60
 10/60
 11/60
 12/60
 1/61
 2/61
 3/61
 4/61
 5/61
 6/61
 7/61
 8/61
 9/61
 10/61
 11/61
 12/61
 1/62
 2/62
 3/62
 4/62
 5/62
 6/62
 7/62
 8/62
 9/62
 10/62
 11/62
 12/62
 1/63
 2/63
 3/63
 4/63
 5/63
 6/63
 7/63
 8/63
 9/63
 10/63
 11/63
 12/63
 1/64
 2/64
 3/64
 4/64
 5/64
 6/64
 7/64
 8/64
 9/64
 10/64
 11/64
 12/64
 1/65
 2/65
 3/65
 4/65
 5/65
 6/65
 7/65
 8/65
 9/65
 10/65
 11/65
 12/65
 1/66
 2/66
 3/66
 4/66
 5/66
 6/66
 7/66
 8/66
 9/66
 10/66
 11/66
 12/66
 1/67
 2/67
 3/67
 4/67
 5/67
 6/67
 7/67
 8/67
 9/67
 10/67
 11/67
 12/67
 1/68
 2/68
 3/68
 4/68
 5/68
 6/68
 7/68
 8/68
 9/68
 10/68
 11/68
 12/68
 1/69
 2/69
 3/69
 4/69
 5/69
 6/69
 7/69
 8/69
 9/69
 10/69
 11/69
 12/69
 1/70
 2/70
 3/70
 4/70
 5/70
 6/70
 7/70
 8/70
 9/70
 10/70
 11/70
 12/70
 1/71
 2/71
 3/71
 4/71
 5/71
 6/71
 7/71
 8/71
 9/71
 10/71
 11/71
 12/71
 1/72
 2/72
 3/72
 4/72
 5/72
 6/72
 7/72
 8/72
 9/72
 10/72
 11/72
 12/72
 1/73
 2/73
 3/73
 4/73
 5/73
 6/73
 7/73
 8/73
 9/73
 10/73
 11/73
 12/73
 1/74
 2/74
 3/74
 4/74
 5/74
 6/74
 7/74
 8/74
 9/74
 10/74
 11/74
 12/74
 1/75
 2/75
 3/75
 4/75
 5/75
 6/75
 7/75
 8/75
 9/75
 10/75
 11/75
 12/75
 1/76
 2/76
 3/76
 4/76
 5/76
 6/76
 7/76
 8/76
 9/76
 10/76
 11/76
 12/76
 1/77
 2/77
 3/77
 4/77
 5/77
 6/77
 7/77
 8/77
 9/77
 10/77
 11/77
 12/77
 1/78
 2/78
 3/78
 4/78
 5/78
 6/78
 7/78
 8/78
 9/78
 10/78
 11/78
 12/78
 1/79
 2/79
 3/79
 4/79
 5/79
 6/79
 7/79
 8/79
 9/79
 10/79
 11/79
 12/79
 1/80
 2/80
 3/80
 4/80
 5/80
 6/80
 7/80
 8/80
 9/80
 10/80
 11/80
 12/80
 1/81
 2/81
 3/81
 4/81
 5/81
 6/81
 7/81
 8/81
 9/81
 10/81
 11/81
 12/81
 1/82
 2/82
 3/82
 4/82
 5/82
 6/82
 7/82
 8/82
 9/82
 10/82
 11/82
 12/82
 1/83
 2/83
 3/83
 4/83
 5/83
 6/83
 7/83
 8/83
 9/83
 10/83
 11/83
 12/83
 1/84
 2/84
 3/84
 4/84
 5/84
 6/84
 7/84
 8/84
 9/84
 10/84
 11/84
 12/84
 1/85
 2/85
 3/85
 4/85
 5/85
 6/85
 7/85
 8/85
 9/85
 10/85
 11/85
 12/85
 1/86
 2/86
 3/86
 4/86
 5/86
 6/86
 7/86
 8/86
 9/86
 10/86
 11/86
 12/86
 1/87
 2/87
 3/87
 4/87
 5/87
 6/87
 7/87
 8/87
 9/87
 10/87
 11/87
 12/87
 1/88
 2/88
 3/88
 4/88
 5/88
 6/88
 7/88
 8/88
 9/88
 10/88
 11/88
 12/88
 1/89
 2/89
 3/89
 4/89
 5/89
 6/89
 7/89
 8/89
 9/89
 10/89
 11/89
 12/89
 1/90
 2/90
 3/90
 4/90
 5/90
 6/90
 7/90
 8/90
 9/90
 10/90
 11/90
 12/90
 1/91
 2/91
 3/91
 4/91
 5/91
 6/91
 7/91
 8/91
 9/91
 10/91
 11/91
 12/91
 1/92
 2/92
 3/92
 4/92
 5/92
 6/92
 7/92
 8/92
 9/92
 10/92
 11/92
 12/92
 1/93
 2/93
 3/93
 4/93
 5/93
 6/93
 7/93
 8/93
 9/93
 10/93
 11/93
 12/93
 1/94
 2/94
 3/94
 4/94
 5/94
 6/94
 7/94
 8/94
 9/94
 10/94
 11/94
 12/94
 1/95
 2/95
 3/95
 4/95
 5/95
 6/95
 7/95
 8/95
 9/95
 10/95
 11/95
 12/95
 1/96
 2/96
 3/96
 4/96
 5/96
 6/96
 7/96
 8/96
 9/96
 10/96
 11/96
 12/96
 1/97
 2/97
 3/97
 4/97
 5/97
 6/97
 7/97
 8/97
 9/97
 10/97
 11/97
 12/97
 1/98
 2/98
 3/98
 4/98
 5/98
 6/98
 7/98
 8/98
 9/98
 10/98
 11/98
 12/98
 1/99
 2/99
 3/99
 4/99
 5/99
 6/99
 7/99
 8/99
 9/99
 10/99
 11/99
 12/99
 1/100
 2/100
 3/100
 4/100
 5/100
 6/100
 7/100
 8/100
 9/100
 10/100
 11/100
 12/100
 1/101
 2/101
 3/101
 4/101
 5/101
 6/101
 7/101
 8/101
 9/101
 10/101
 11/101
 12/101
 1/102
 2/102
 3/102
 4/102
 5/102
 6/102
 7/102
 8/102
 9/102
 10/102
 11/102
 12/102
 1/103
 2/103
 3/103
 4/103
 5/103
 6/103
 7/103
 8/103
 9/103
 10/103
 11/103
 12/103
 1/104
 2/104
 3/104
 4/104
 5/104
 6/104
 7/104
 8/104
 9/104
 10/104
 11/104
 12/104
 1/105
 2/105
 3/105
 4/105
 5/105
 6/105
 7/105
 8/105
 9/105
 10/105
 11/105
 12/105
 1/106
 2/106
 3/106
 4/106
 5/106
 6/106
 7/106
 8/106
 9/106
 10/106
 11/106
 12/106
 1/107
 2/107
 3/107
 4/107
 5/107
 6/107
 7/107
 8/107
 9/107
 10/107
 11/107
 12/107
 1/108
 2/108
 3/108
 4/108
 5/108
 6/108
 7/108
 8/108
 9/108
 10/108
 11/108
 12/108
 1/109
 2/109
 3/109
 4/109
 5/109
 6/109
 7/109
 8/109
 9/109
 10/109
 11/109
 12/109
 1/110
 2/110
 3/110
 4/110
 5/110
 6/110
 7/110
 8/110
 9/110
 10/110
 11/110
 12/110
 1/111
 2/111
 3/111
 4/111
 5/111
 6/111
 7/111
 8/111
 9/111
 10/111
 11/111
 12/111
 1/112
 2/112
 3/112
 4/112
 5/112
 6/112
 7/112
 8/112
 9/112
 10/112
 11/112
 12/112
 1/113
 2/113
 3/113
 4/113
 5/113
 6/113
 7/113
 8/113
 9/113
 10/113
 11/113
 12/113
 1/114
 2/114
 3/114
 4/114
 5/114
 6/114
 7/114
 8/114
 9/114
 10/114
 11/114
 12/114
 1/115
 2/115
 3/115
 4/115
 5/115
 6/115
 7/115
 8/115
 9/115
 10/115
 11/115
 12/115
 1/116
 2/116
 3/116
 4/116
 5/116
 6/116
 7/116
 8/116
 9/116
 10/116
 11/116
 12/116
 1/117
 2/117
 3/117
 4/117
 5/117
 6/117
 7/117
 8/117
 9/117
 10/117
 11/117
 12/117
 1/118
 2/118
 3/118
 4/118
 5/118
 6/118
 7/118
 8/118
 9/118
 10/118
 11/118
 12/118
 1/119
 2/119
 3/119
 4/119
 5/119
 6/119
 7/119
 8/119
 9/119
 10/119
 11/119
 12/119
 1/120
 2/120
 3/120
 4/120
 5/120
 6/120
 7/120
 8/120
 9/120
 10/120
 11/120
 12/120
 1/121
 2/121
 3/121
 4/121
 5/121
 6/121
 7/121
 8/121
 9/121
 10/121
 11/121
 12/121
 1/122
 2/122
 3/122
 4/122
 5/122
 6/122
 7/122
 8/122
 9/122
 10/122
 11/122
 12/122
 1/123
 2/123
 3/123
 4/123
 5/123
 6/123
 7/123
 8/123
 9/123
 10/123
 11/123
 12/123
 1/

ACQUIRED FROM ALFRED W. & ANNA K. SMITH
BY CONDEMNATION 9-25-1956 RECORDED IN
BK. 33 PGS. 349-365 ON 10-19-1956

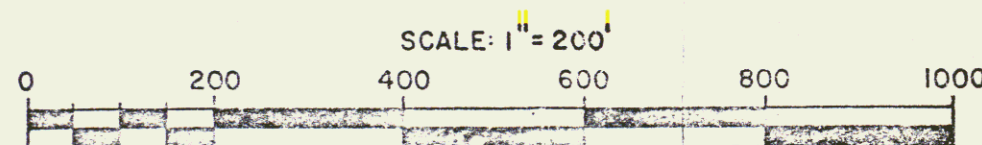

STATE OF VERMONT
AGENCY OF TRANSPORTATION

TOWN OF GUILFORD

PROJECT FI-IN-001-1


APPROX. SCALE = 200'

DATE 1/11/80

DRAWN BY B.A.M.

REV. 4/1/80

18A

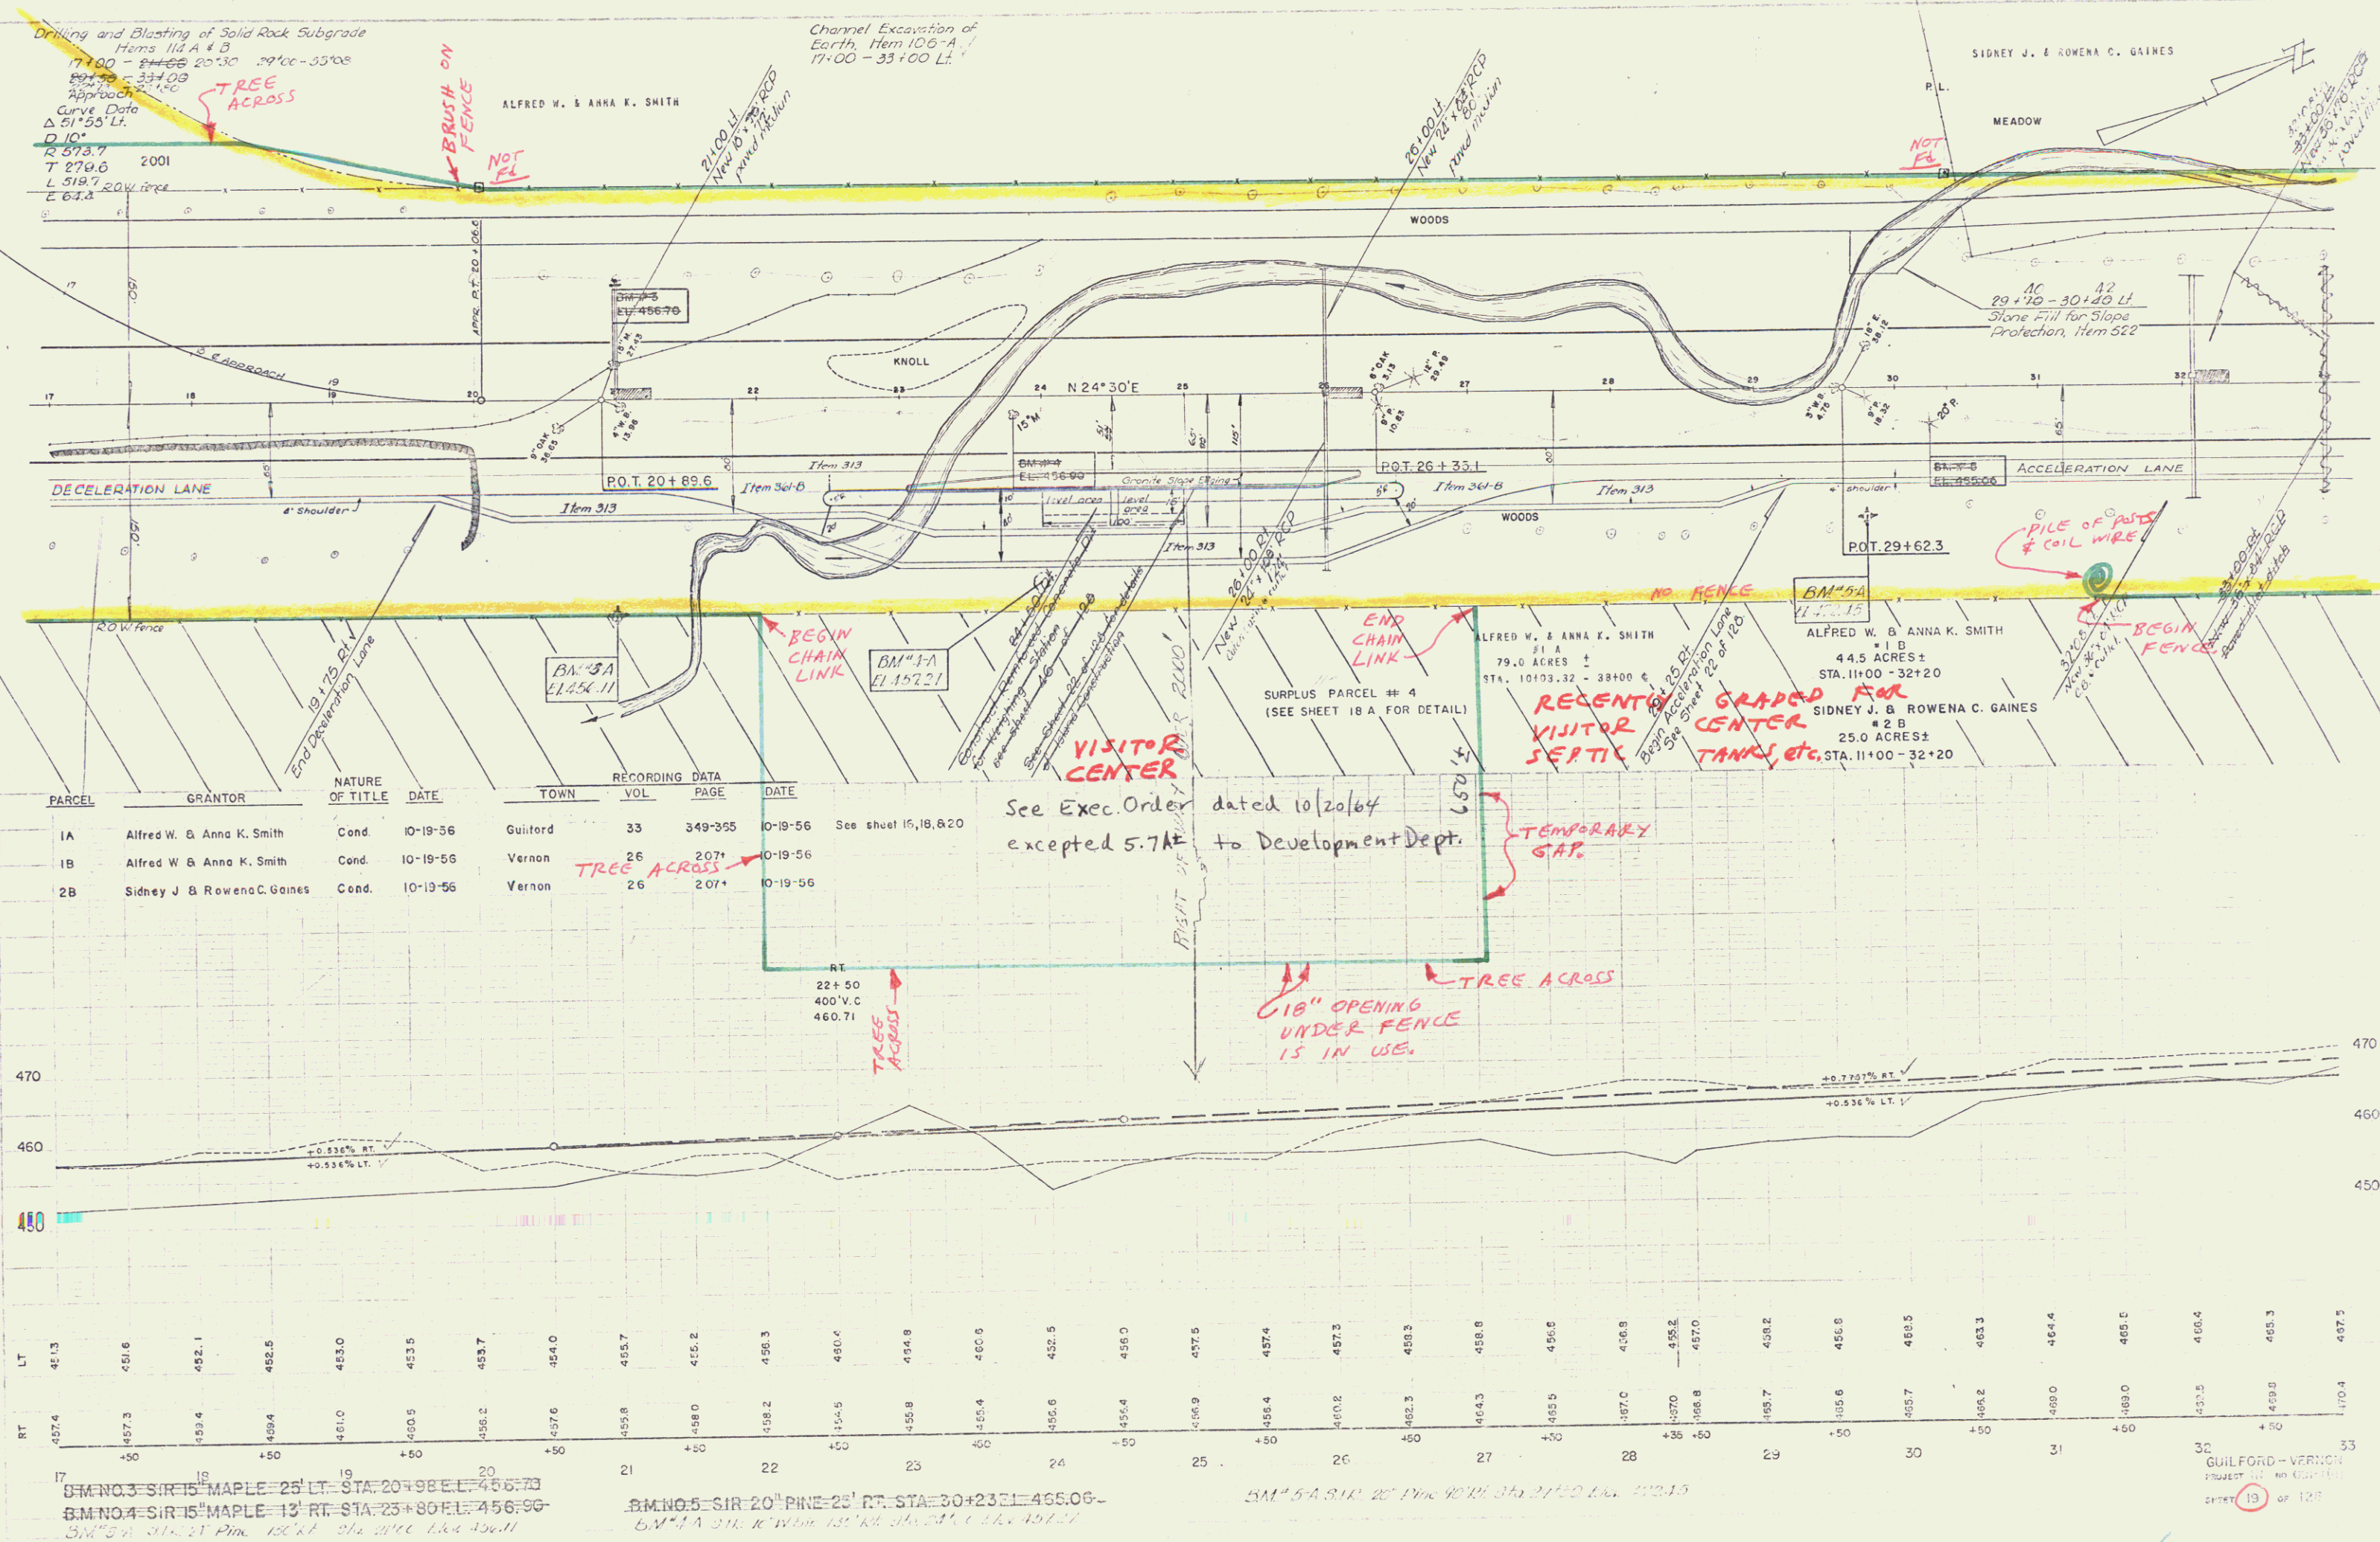

RIGHT-OF-WAY DIVISION
TOWN FILE

PERPETUAL

Towns: Guilford + Vernon

(To Be Returned To R. R. Division)




Exec. Order State Hwy. Bd. to Dept of Fish & Game 10/20/64 JAN 3 1992
SP4, 5, 6, 7, 8, 9 & 10
Recorded in Vernon 11/5/64 BK 29 Pg 429-431
in Guilford 10/23/64 BK 37 Pg 295-296


POOR ORIGINAL COPY

8 (19B)

490
 3750
 7/50
 CARLSON
 A & J
 TRACED
 DATE
 NO.

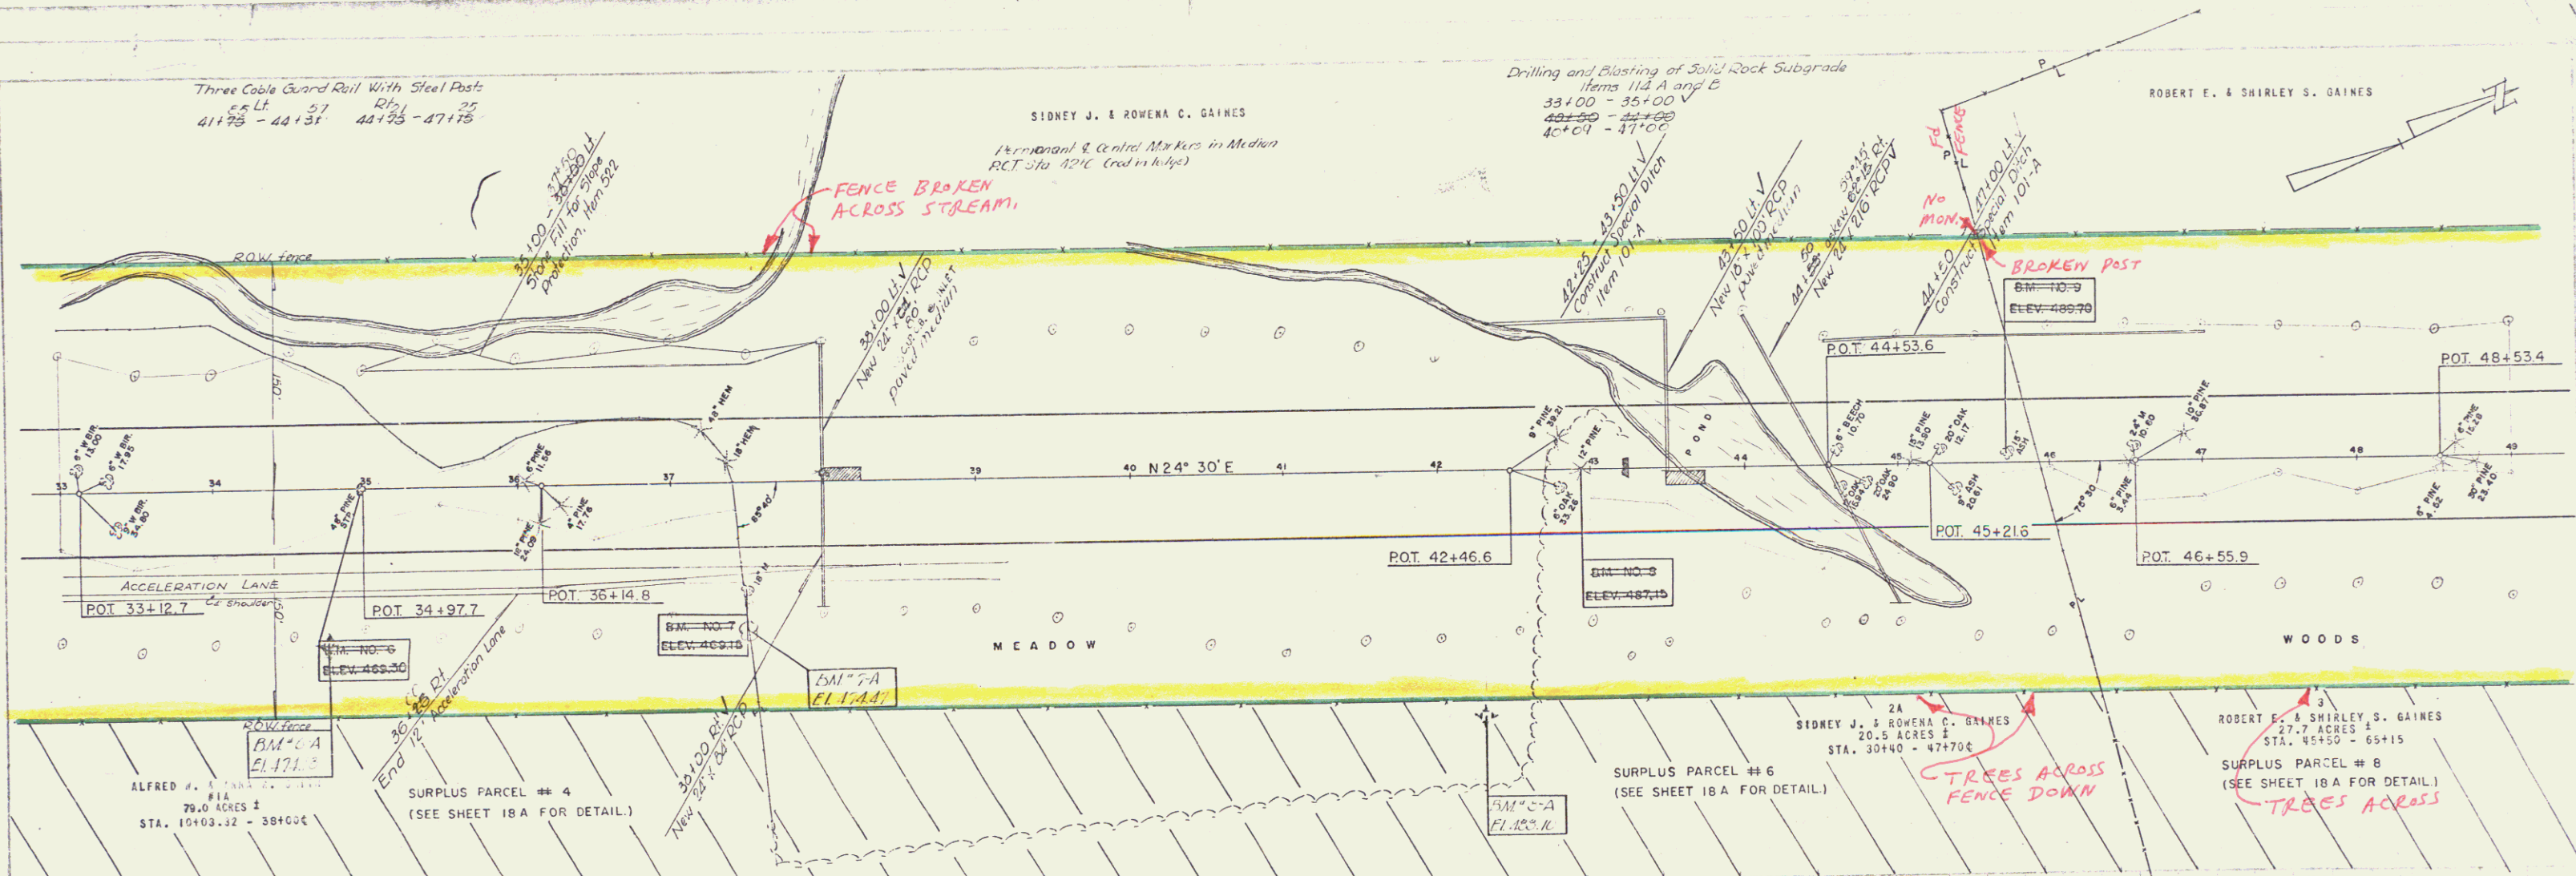


PARCEL	GRANTOR	NATURE OF TITLE	DATE	TOWN	VOL.	PAGE	DATE
2A	Sidney J. & Rowena C. Gaines	Cond.	10-19-56	Guilford	33	349-365	10-19-56 See sheet 19
3	Robert E. & Shirley S. Gaines	W.D.	4-22-57	Guilford	33	426	5-1-57 See sheet 21, 22

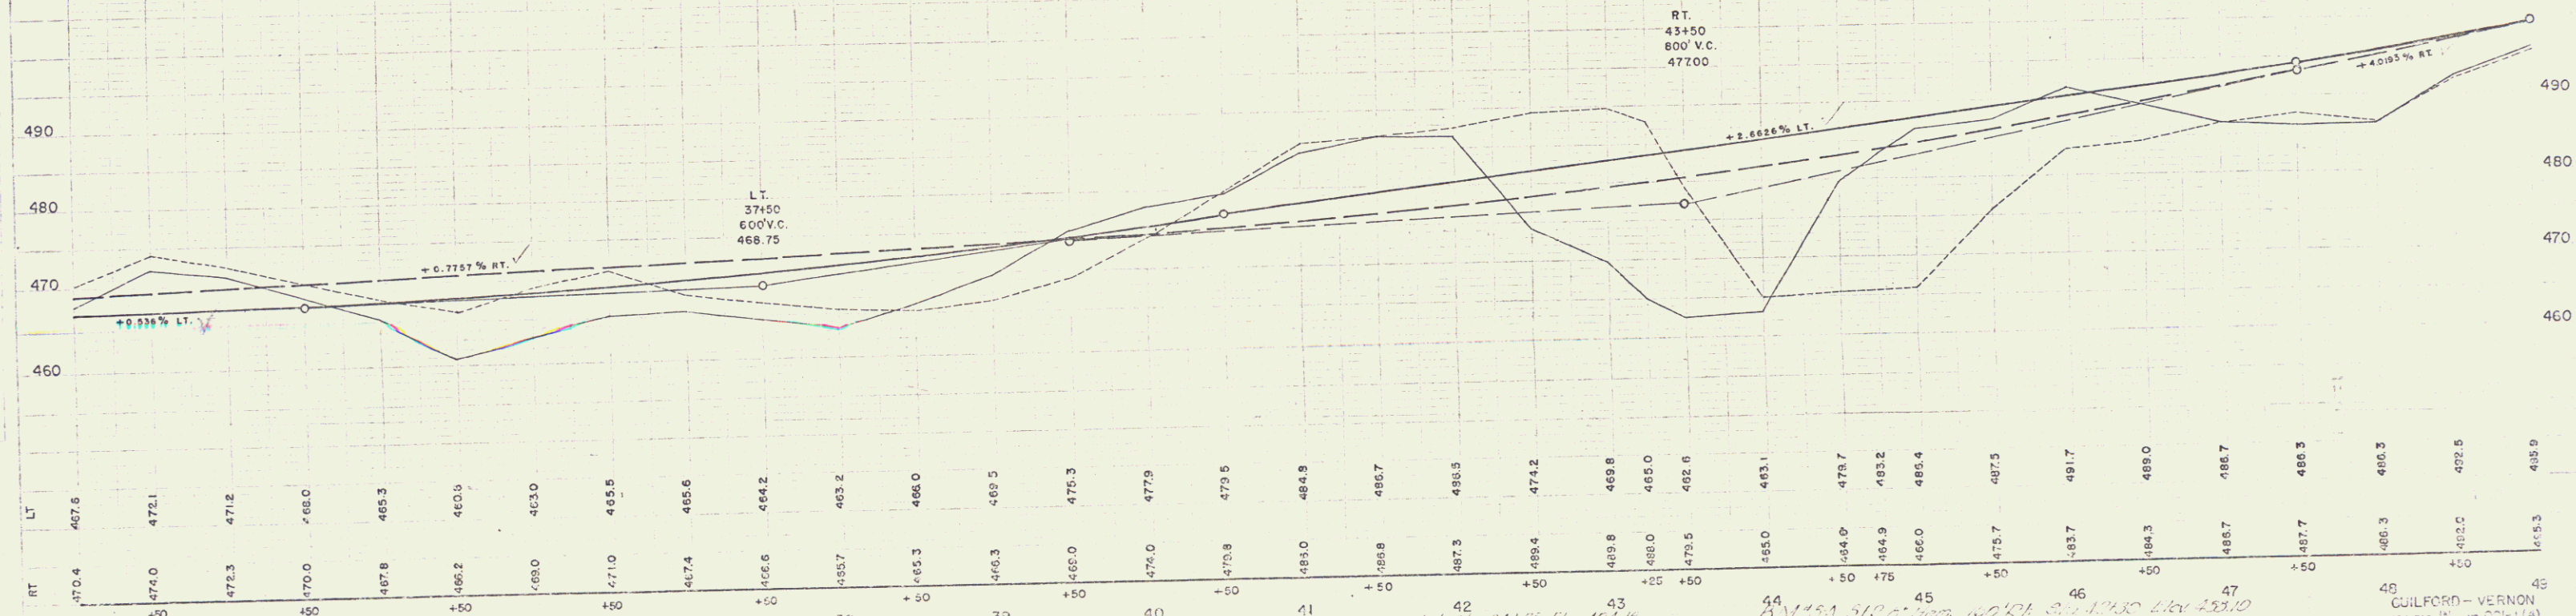

BM NO. 6 - SIR 40 PINE STUMP ON E STA 34+97 EL 469.50
 BM NO. 7 - SIR 18 MAPLE 68 FT. STA 37+40 EL 469.10
 BM NO. 8 - SIR 12 PINE 05 LT STA 42+93 EL 487.15
 BM NO. 9 - SIR 15 ASH 61 LT STA 45+30 EL 489.70
 BM NO. 10 - SIR 15 ASH 61 LT STA 45+30 EL 489.70
 BM NO. 11 - SIR 15 ASH 61 LT STA 45+30 EL 489.70
 BM NO. 100 - SIR 15 ASH 61 LT STA 45+30 EL 489.70

PLAN
 DATE 3/15/75
 DRAWN BY J.A.B.
 CHECKED BY J.A.B.
 NO. 1

NOTE: BOOK GRASS CHECKED
 NO. 1
 STRUCTURE STATION CHECKED

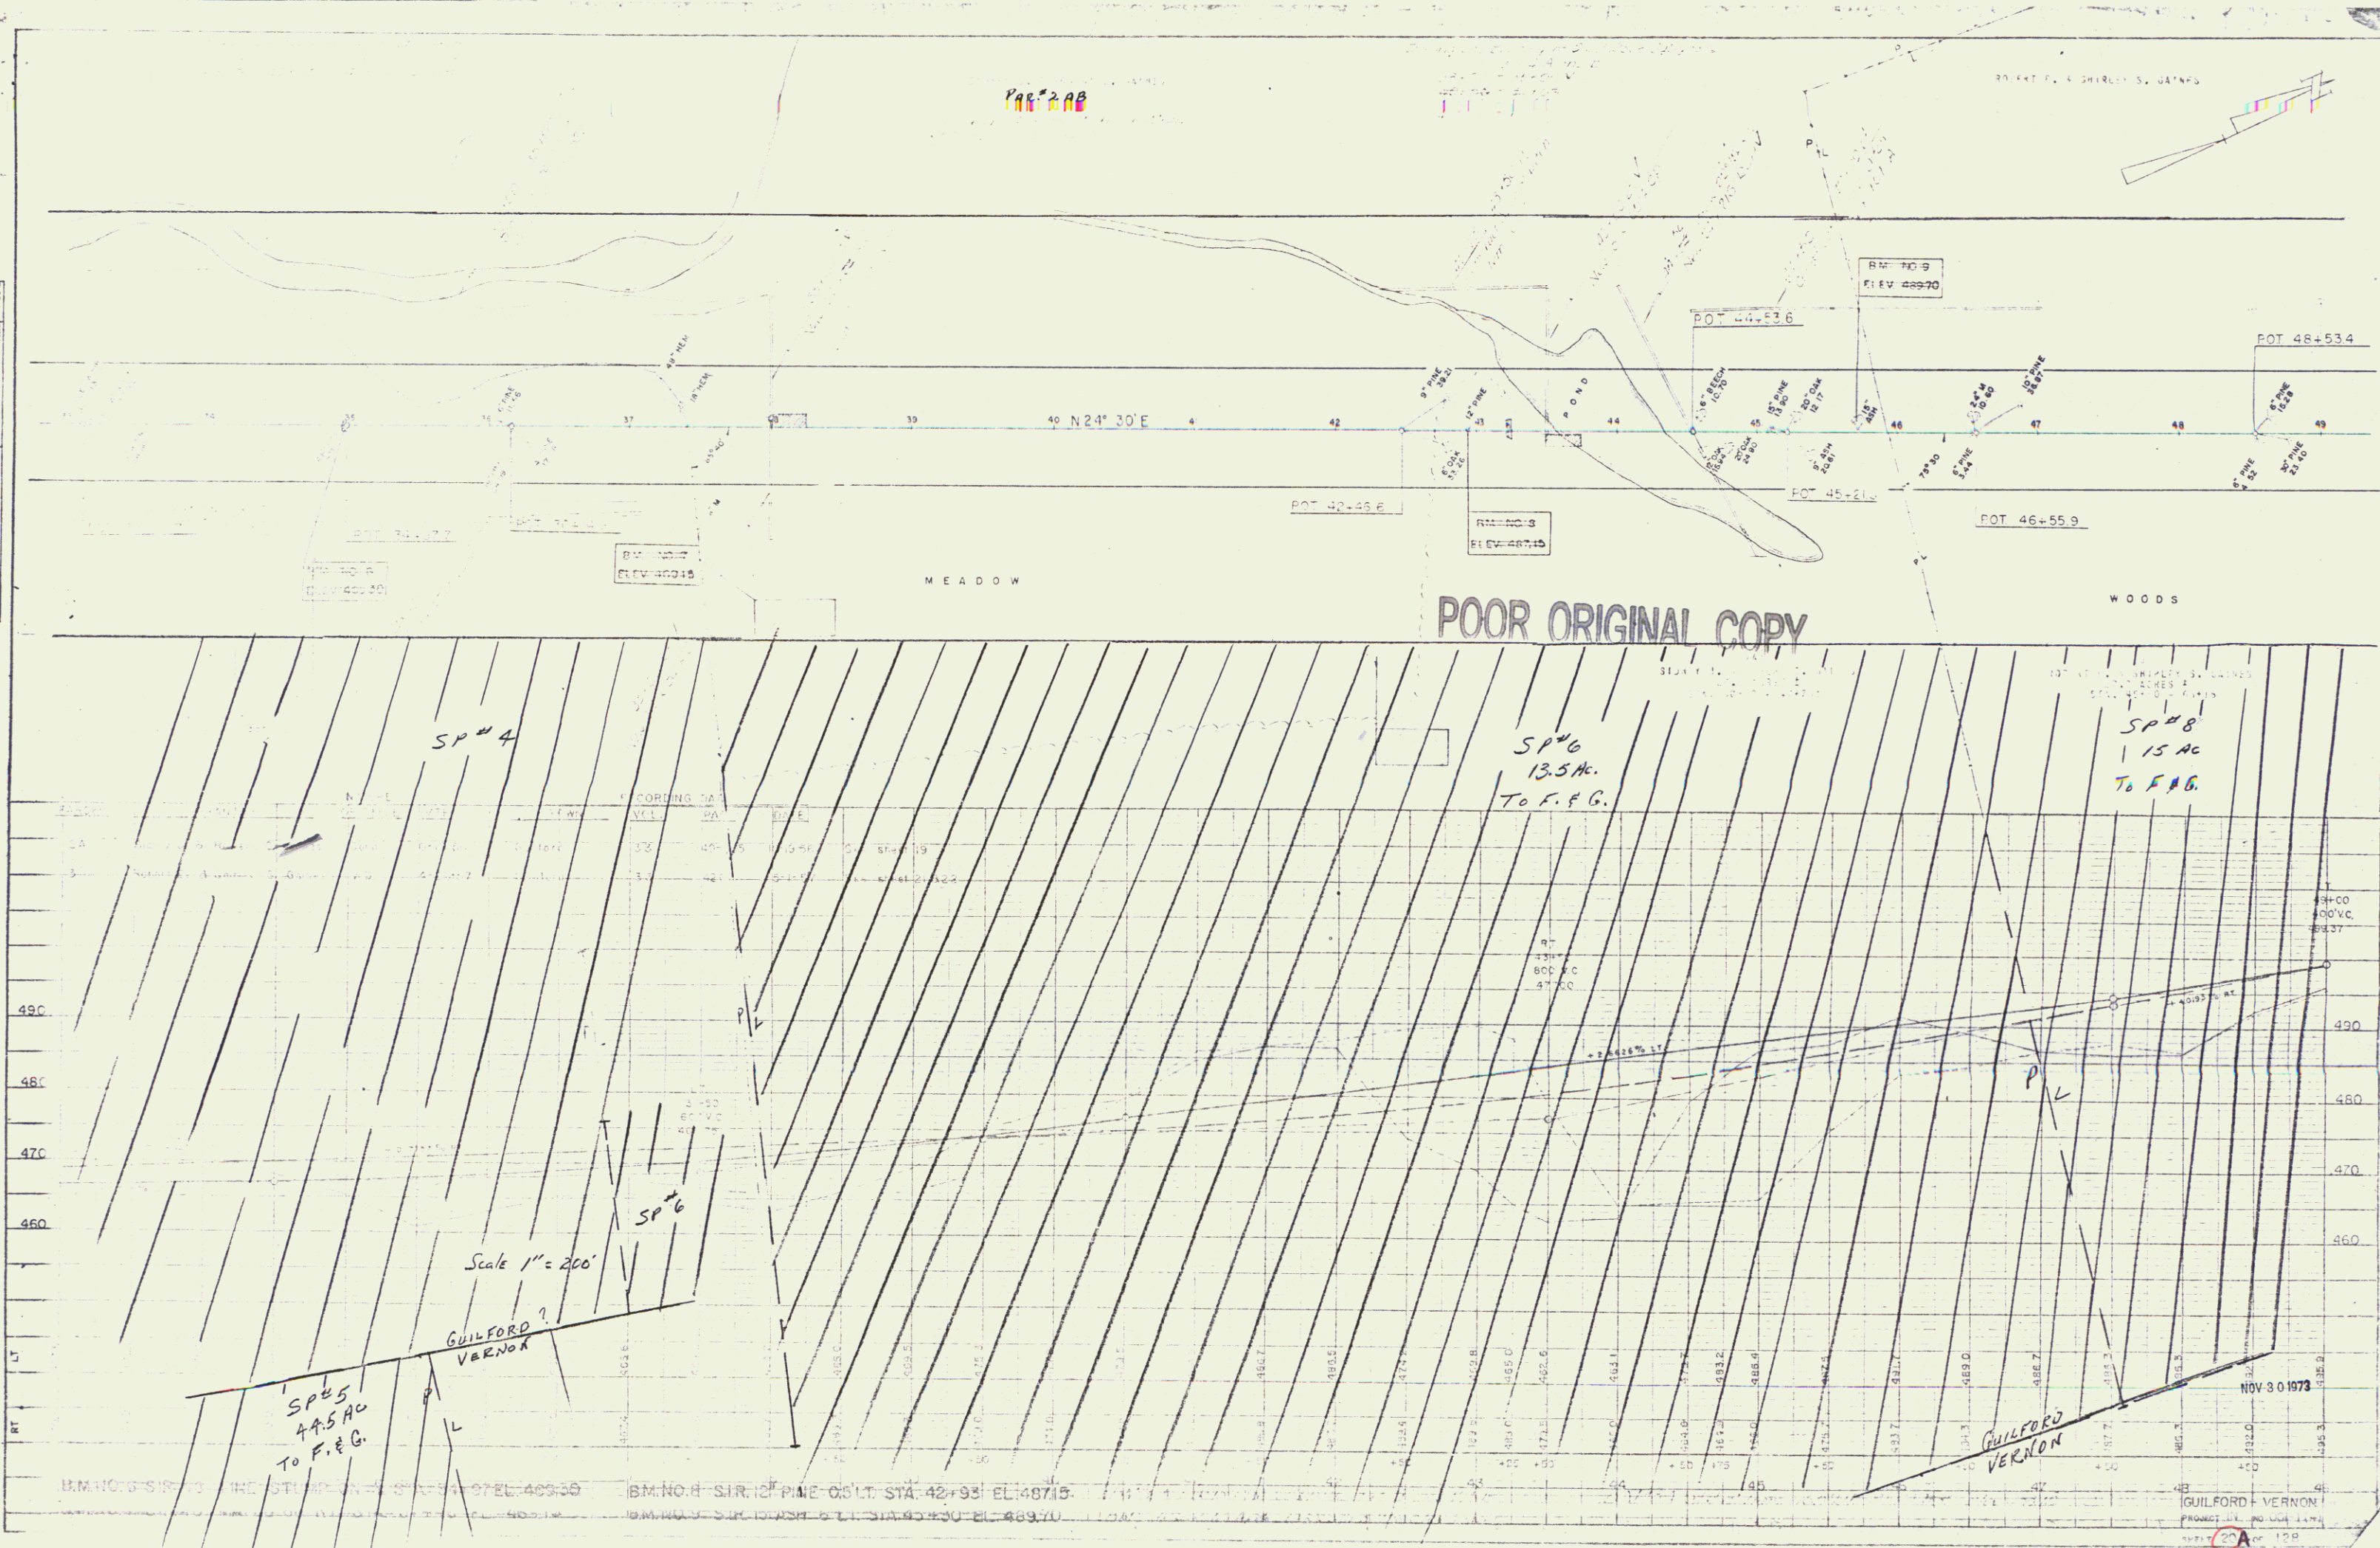

NOV 30 1973
 GUILFORD VERNON
 PROJECT NO. 1000 2474
 SHEET 20A OF 100

RIGHT-OF-WAY DIVISION
TOWN FILE
PERPETUAL

Town of _____
(To Be Returned To R.O.W. Division)





Exec. Order State Hwy. Bd. to Dept of Fish & Game 10/20/64
Sp4, 5, 6, 7, 8, 9 & 10
Recorded in Vernon 11/5/64 BK 29 Pg 429-431
In Guilford 10/23/64 BK 37 Pg 295-296

POOR ORIGINAL COPY


JAN 3 1992

11 (20B)



PLAN
 DATE 10/10/95
 DRAWN BY J. A. JR.
 CHECKED BY J. A. JR.
 TRACED BY J. A. JR.

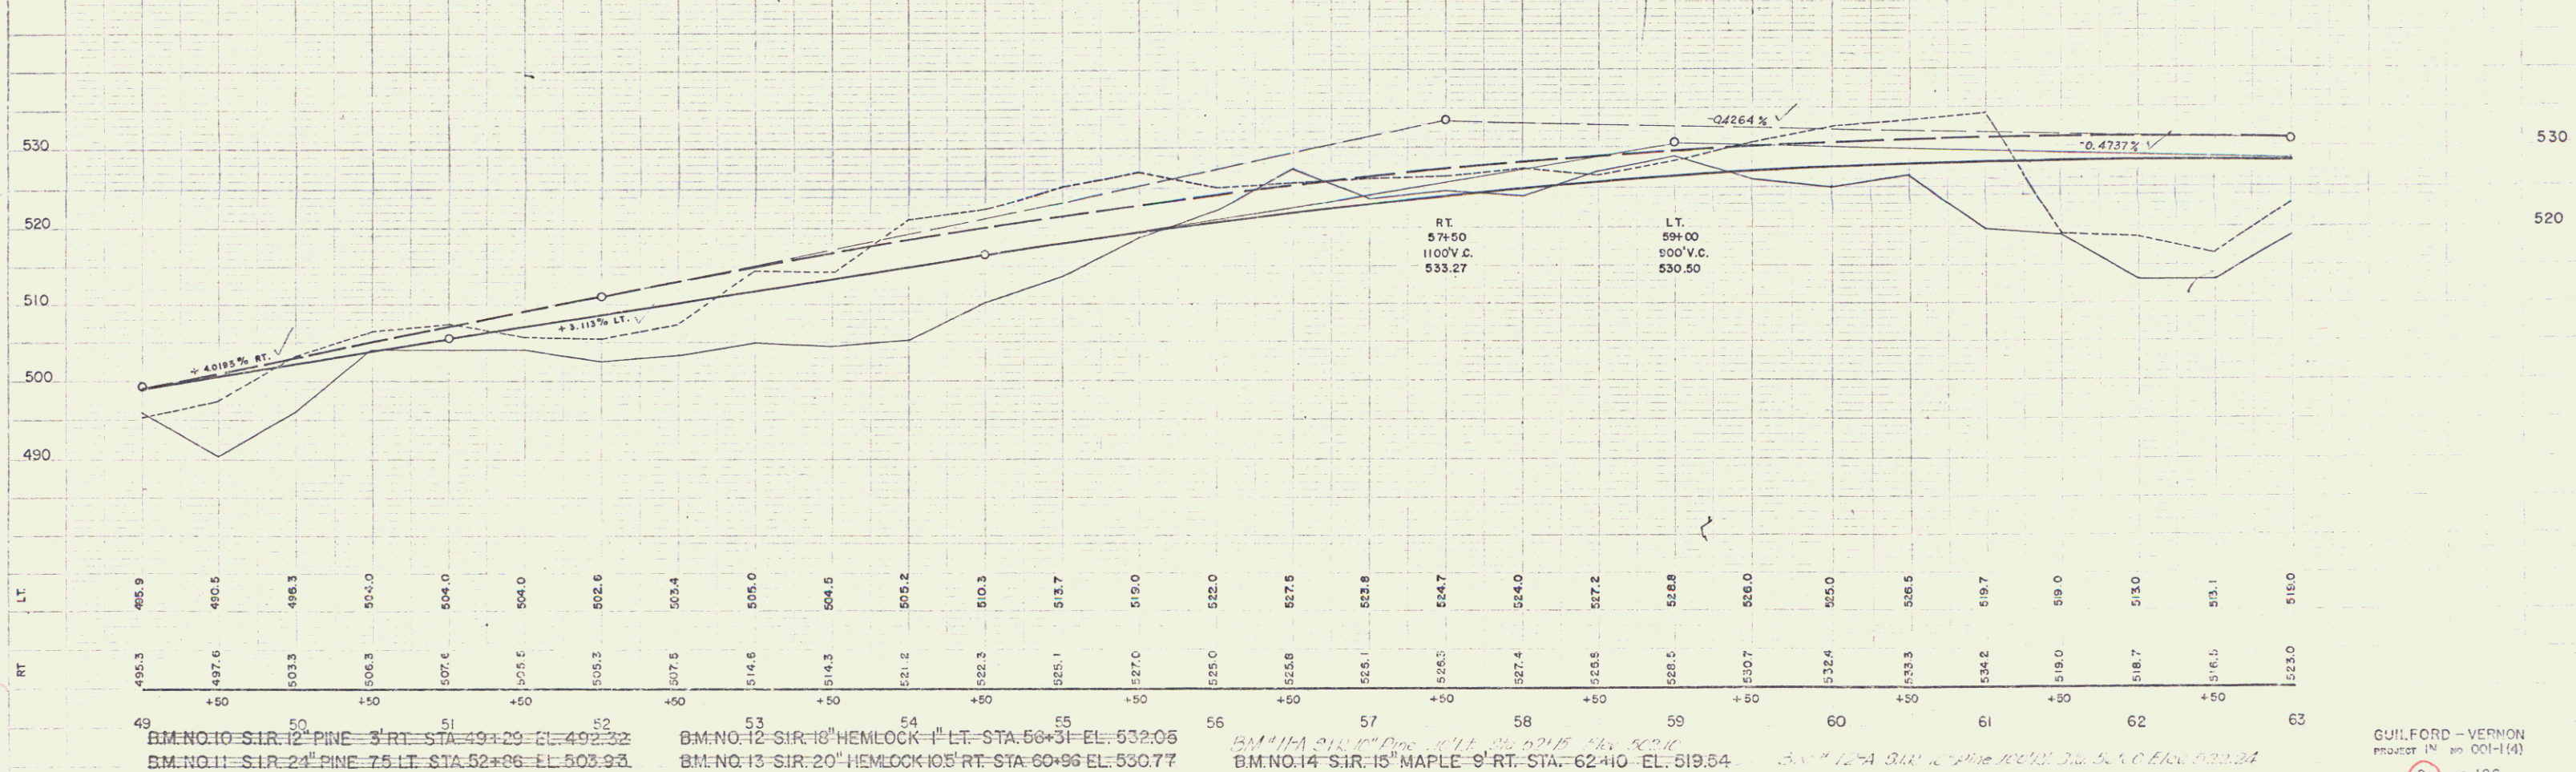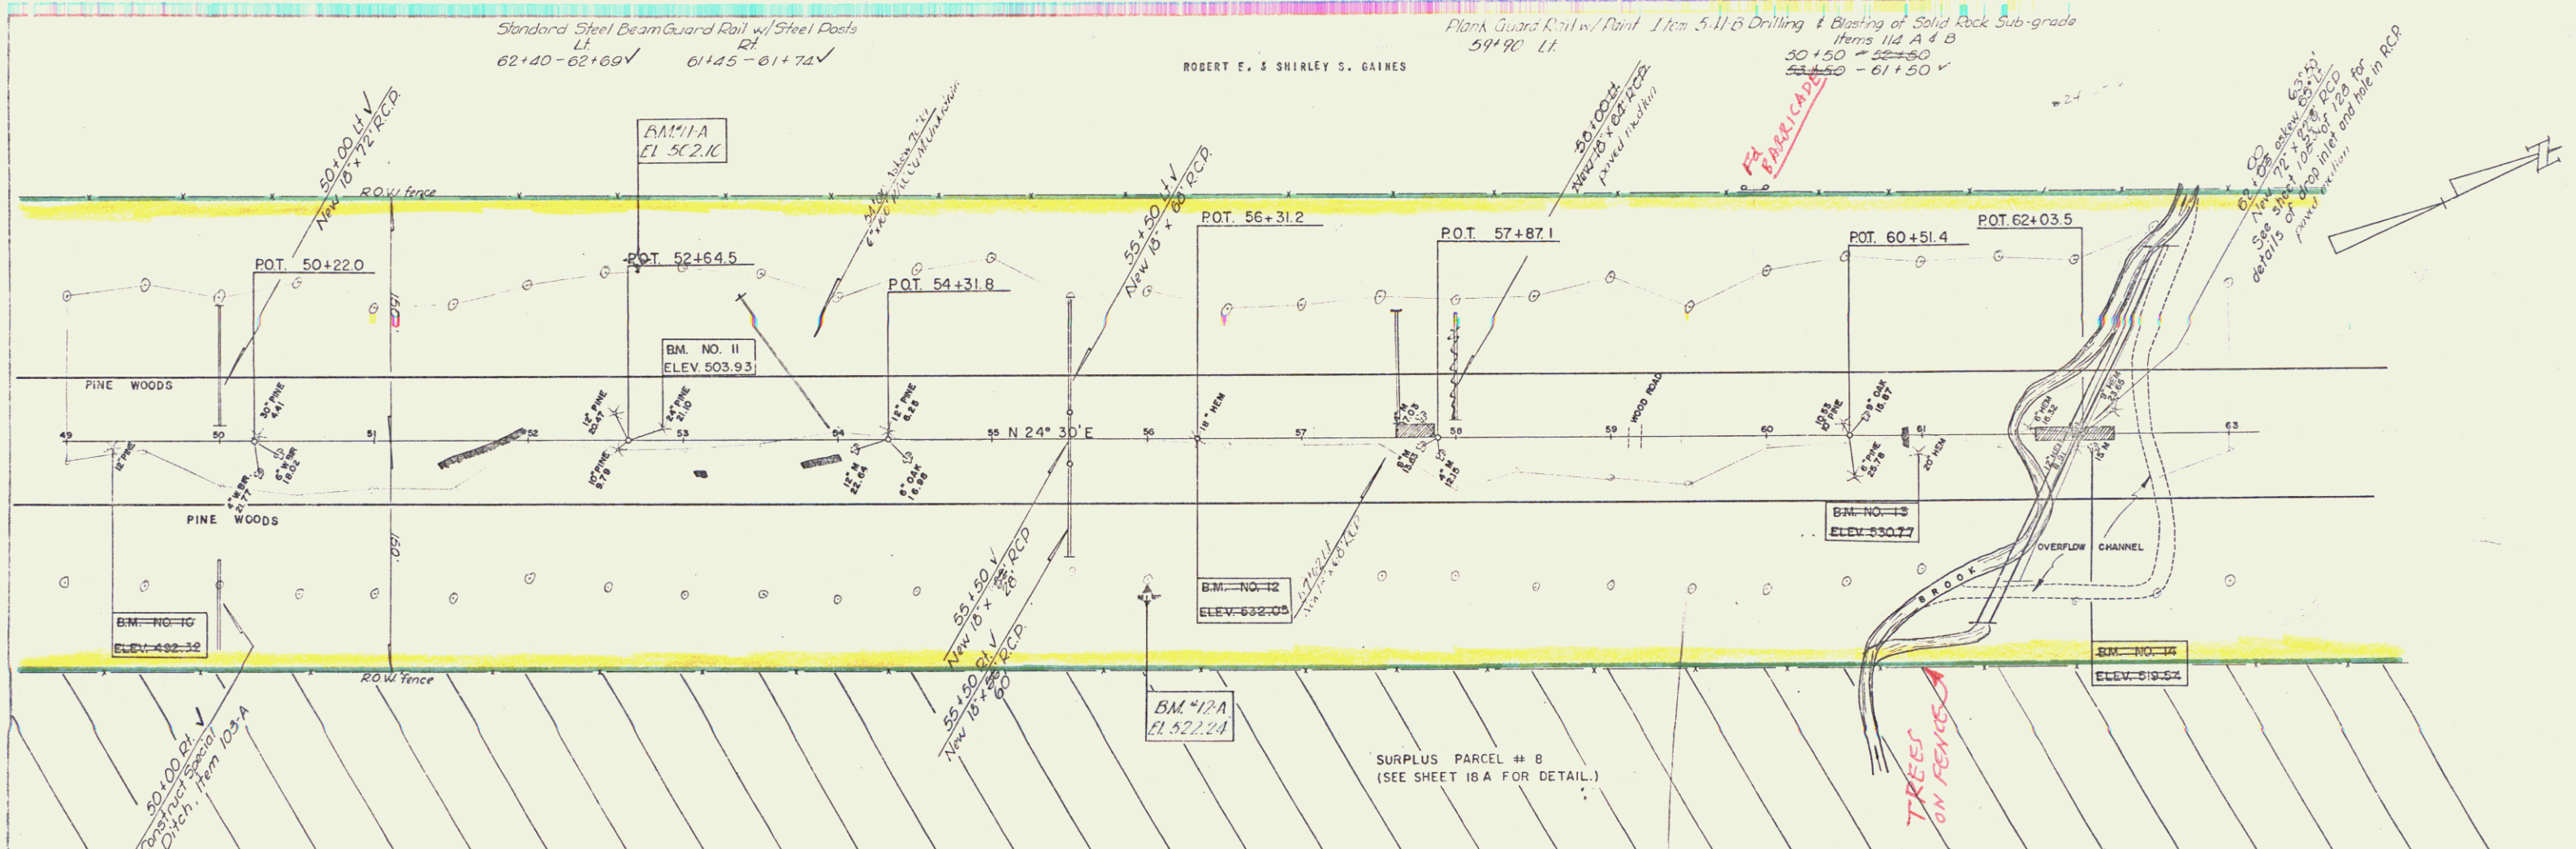

BM NO. 10 - S.I.R. 12 - PINE 3' RT. STA. 49+29 - EL. 492.32
 BM NO. 11 - S.I.R. 24 - PINE 75' LT. STA. 52+36 - EL. 503.93
 BM NO. 12 - S.I.R. 18 - HEMLOCK 1' LT. STA. 56+31 - EL. 532.05
 BM NO. 13 - S.I.R. 20 - HEMLOCK 105' RT. STA. 60+96 - EL. 530.77
 BM NO. 14 - S.I.R. 15 - MAPLE 9' RT. STA. 62+10 - EL. 519.54

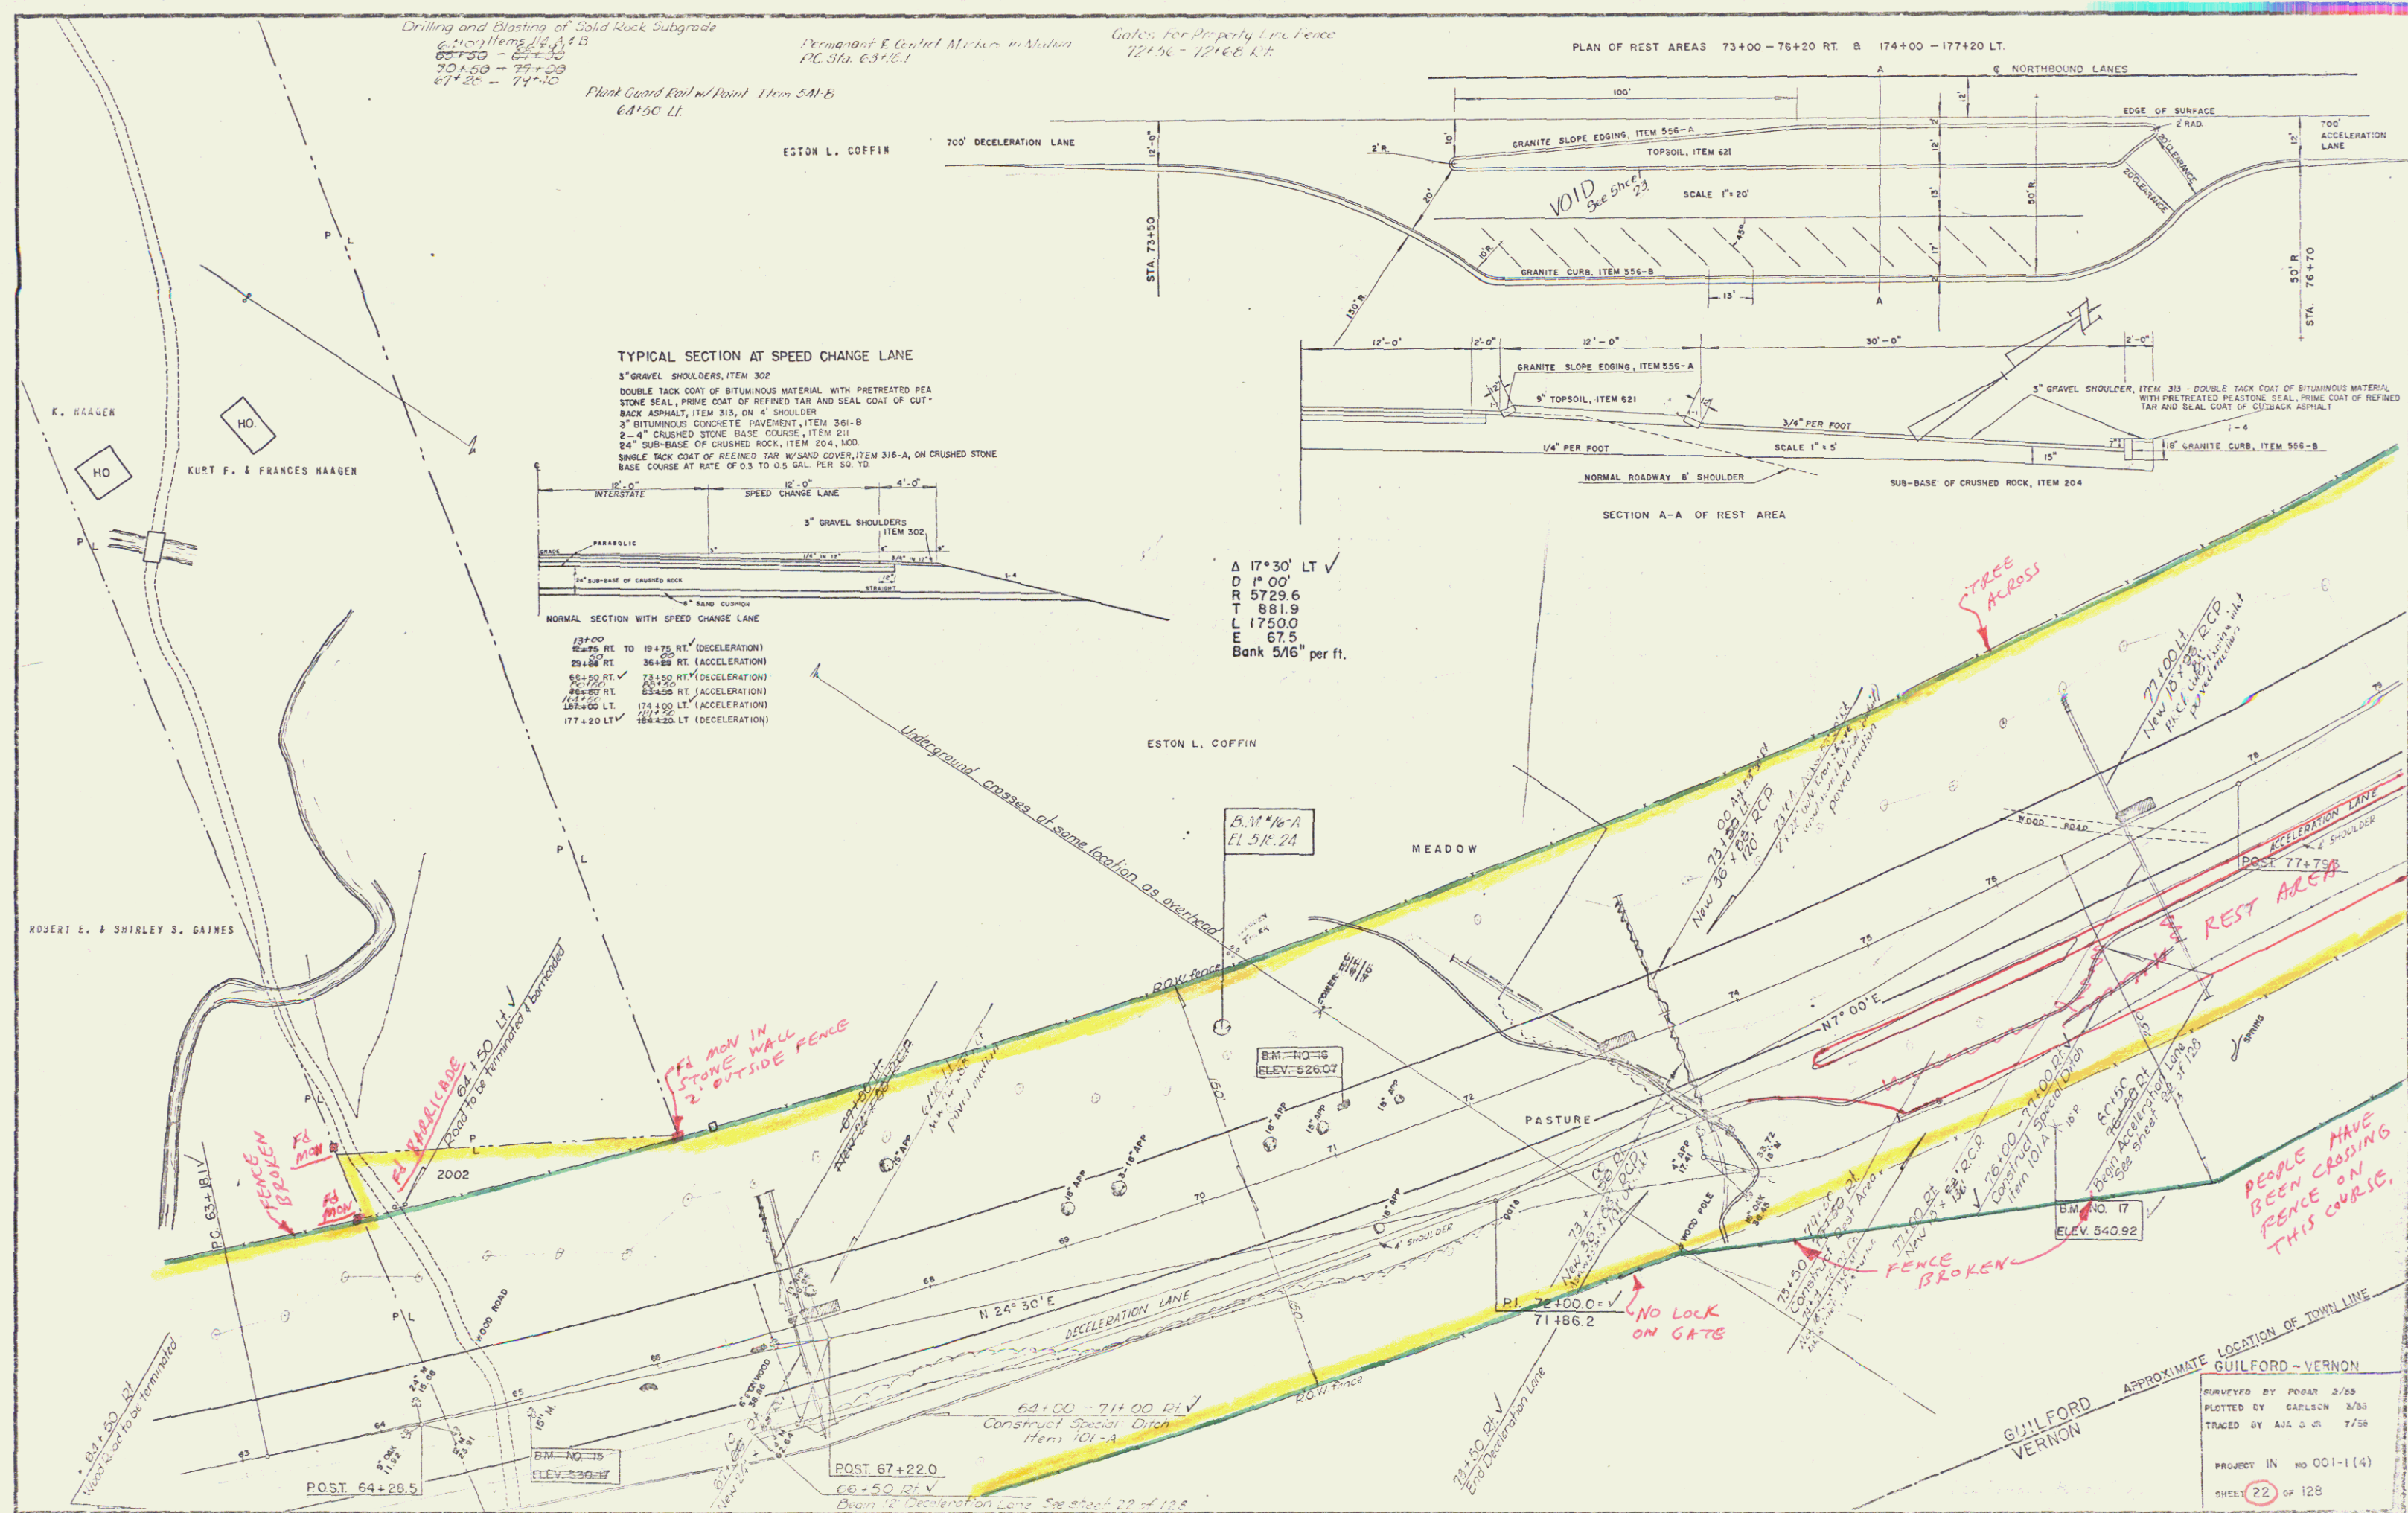

PLAN
 7/58
 A & B
 1/2" = 100'

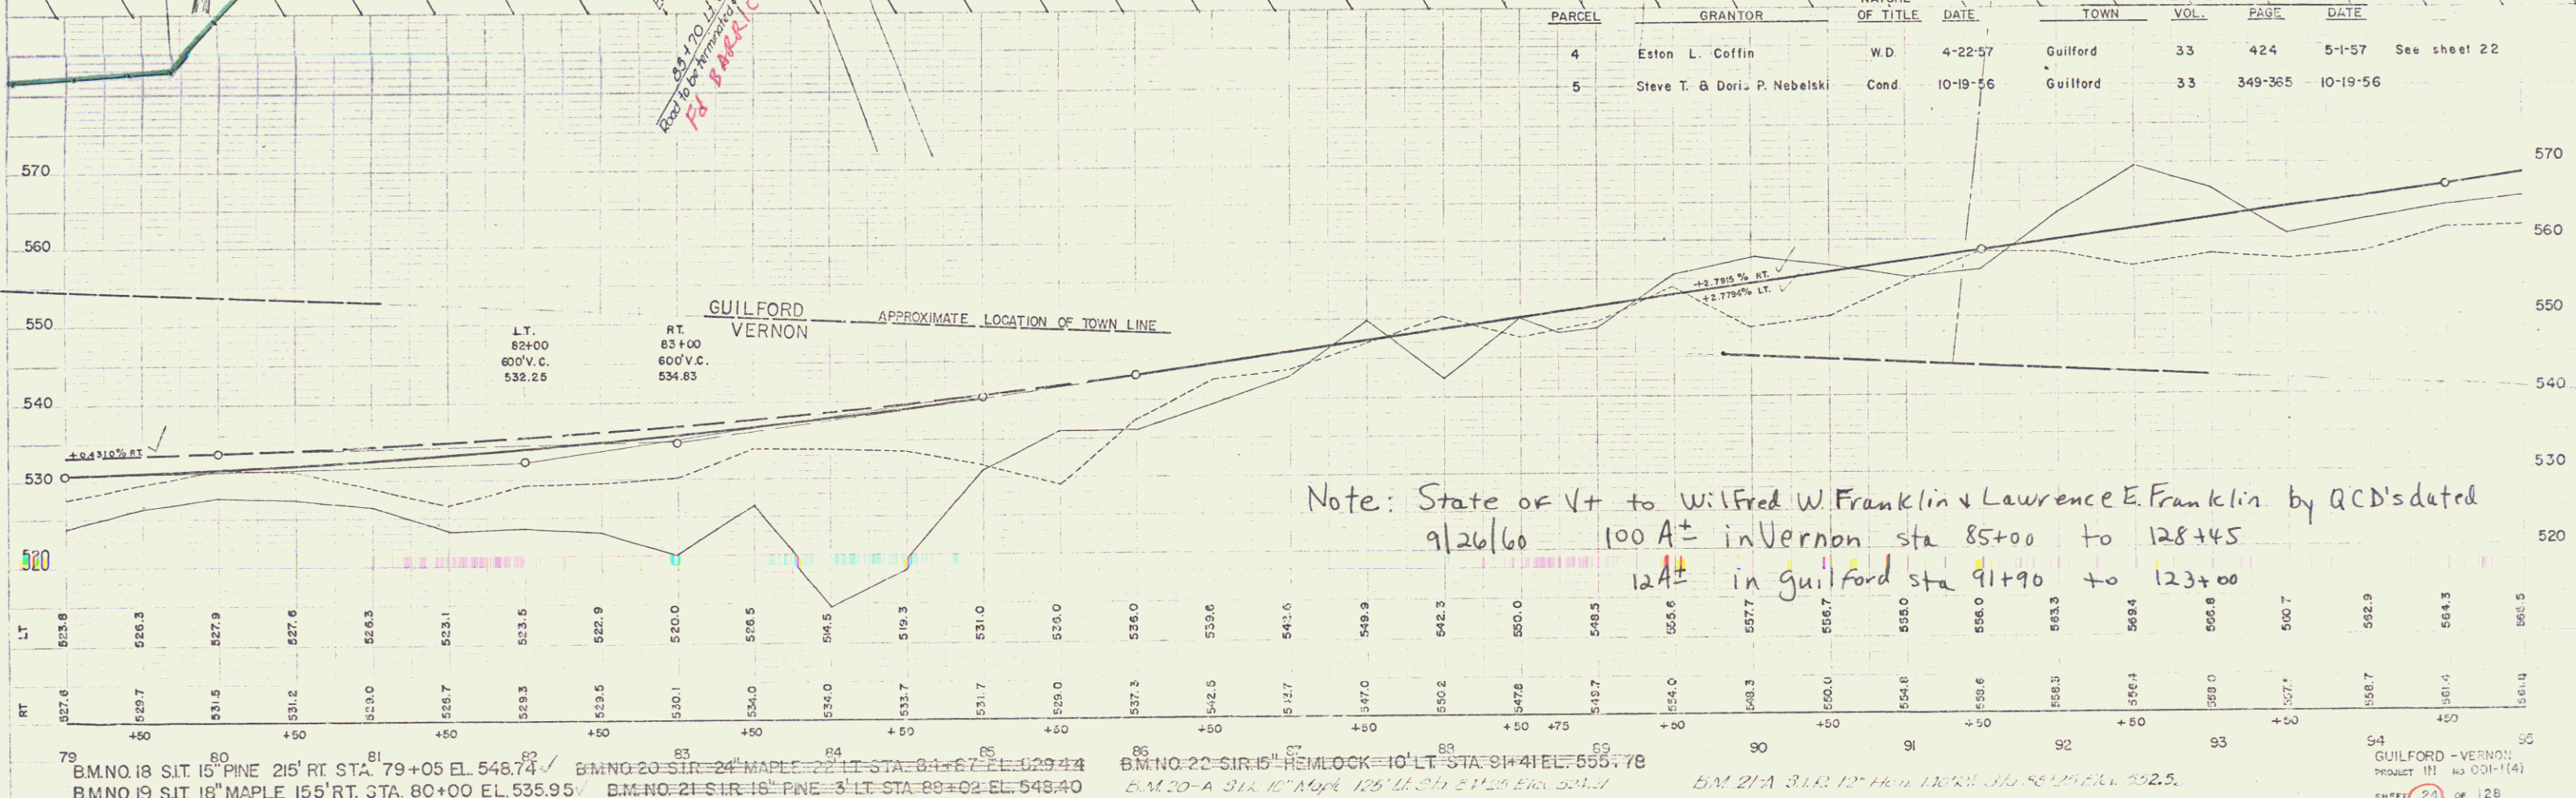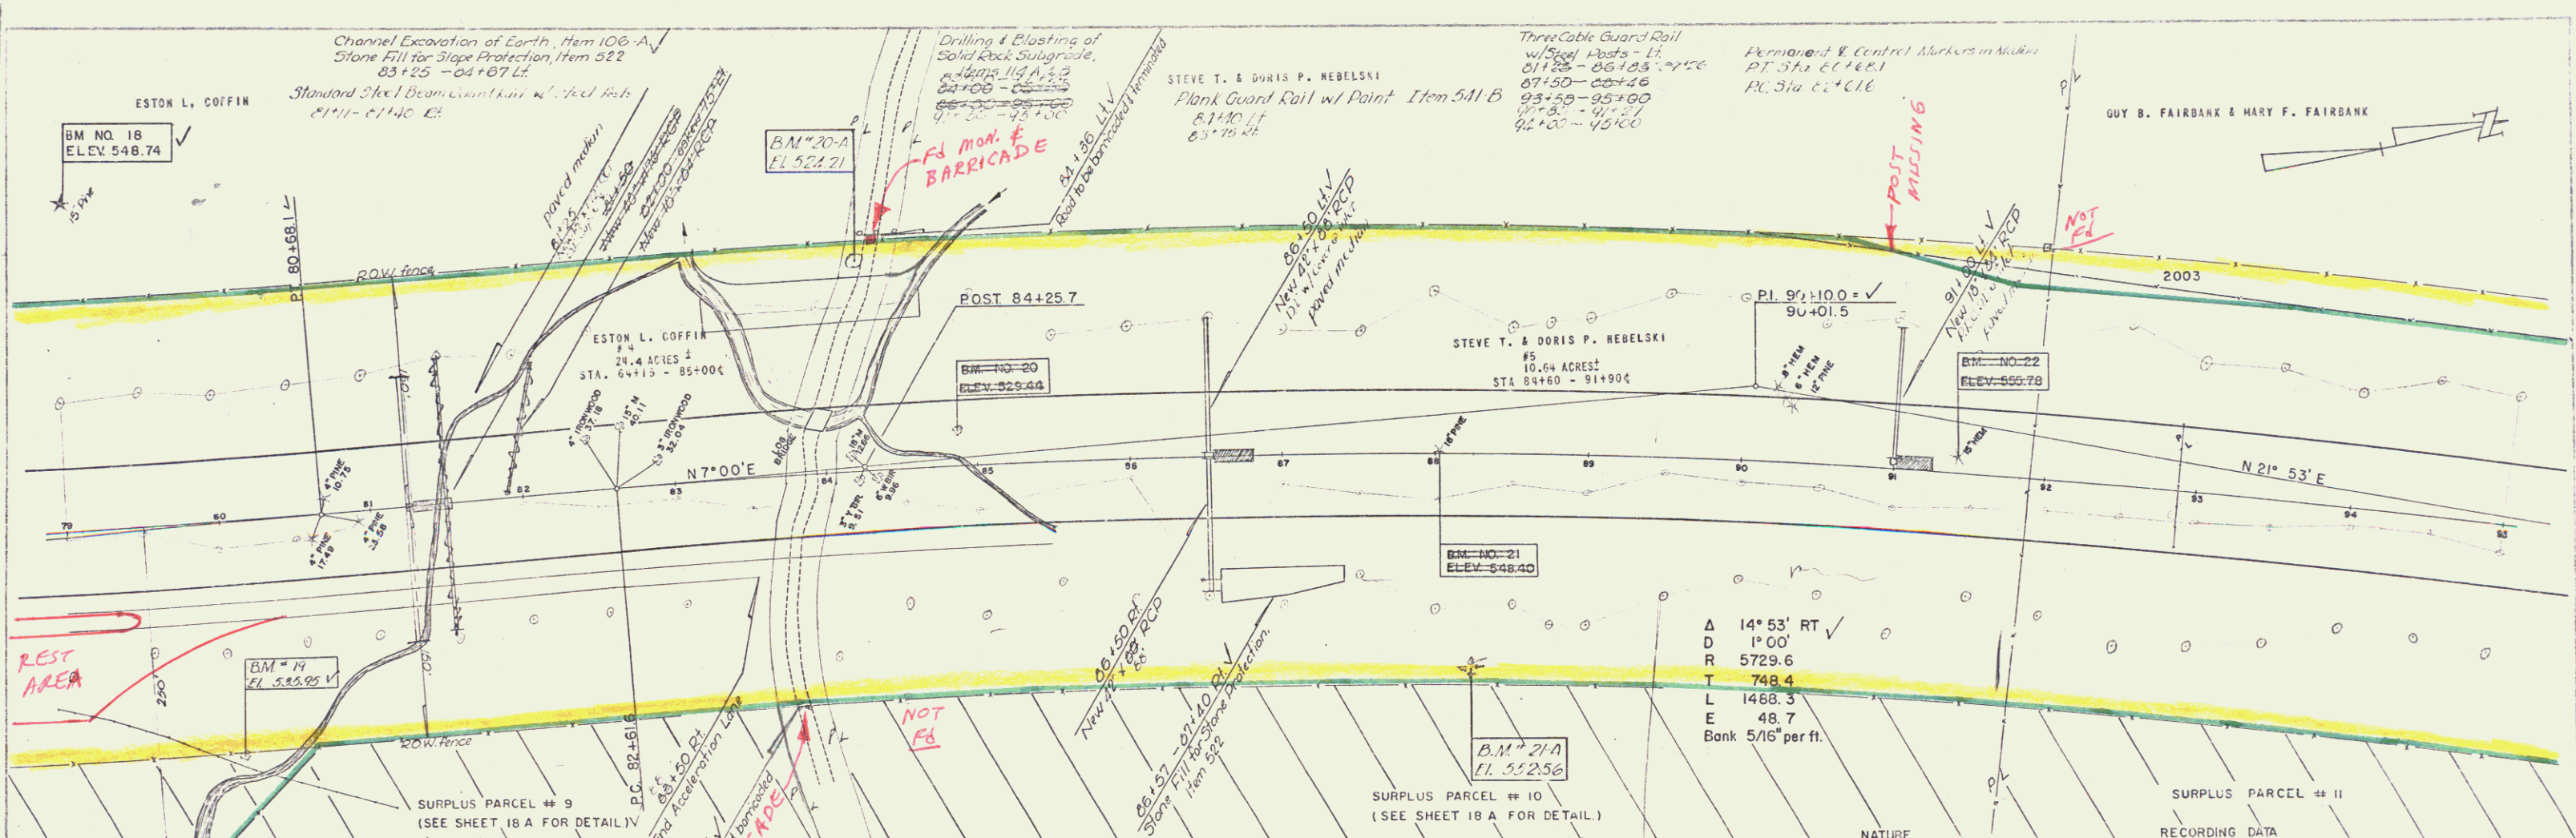

Note: State of VT to Wilfred W. Franklin & Lawrence E. Franklin by QCD's dated 9/26/60 100 A± in Vernon sta 85+00 to 128+45 12 A± in Guilford sta 91+90 to 123+00

PARCEL	GRANTOR	NATURE OF TITLE	DATE	TOWN	RECORDING DATA	DATE
4	Eston L. Coffin	W.D.	4-22-57	Guilford	33 424	5-1-57 See sheet 22
5	Steve T. & Doris P. Nebelski	Cond	10-19-56	Guilford	33 349-365	10-19-56

79 BM.NO.18 S.I.T. 15° PINE 215' RT STA. 79+05 EL. 548.74
 80 BM.NO.19 S.I.T. 18° MAPLE 155' RT STA. 80+00 EL. 535.95
 81 BM.NO.20 S.I.T. 24° MAPLE 221' RT STA. 81+15 EL. 529.44
 82 BM.NO.21 S.I.T. 16° PINE 311' LT STA. 82+02 EL. 548.40
 83 BM.NO.22 S.I.T. 15° HEMLOCK 101' LT STA. 83+41 EL. 556.78
 84 BM.NO.23 S.I.T. 10° MAPLE 125' LT STA. 84+29 EL. 562.54
 85 BM.NO.24 S.I.T. 12° HEMLOCK 310' LT STA. 85+29 EL. 562.54

16

BM NO. 18
ELEV 548.74

POST 84+25.7

BM NO. 20
ELEV 529.44



PI 90+10.0
90+01.5

BM NO. 22
ELEV 555.78

BM NO. 21
ELEV 548.40

Δ 14° 53' RT
D 1° 00'
R 5729.6
T 748.4


POOR ORIGINAL COPY

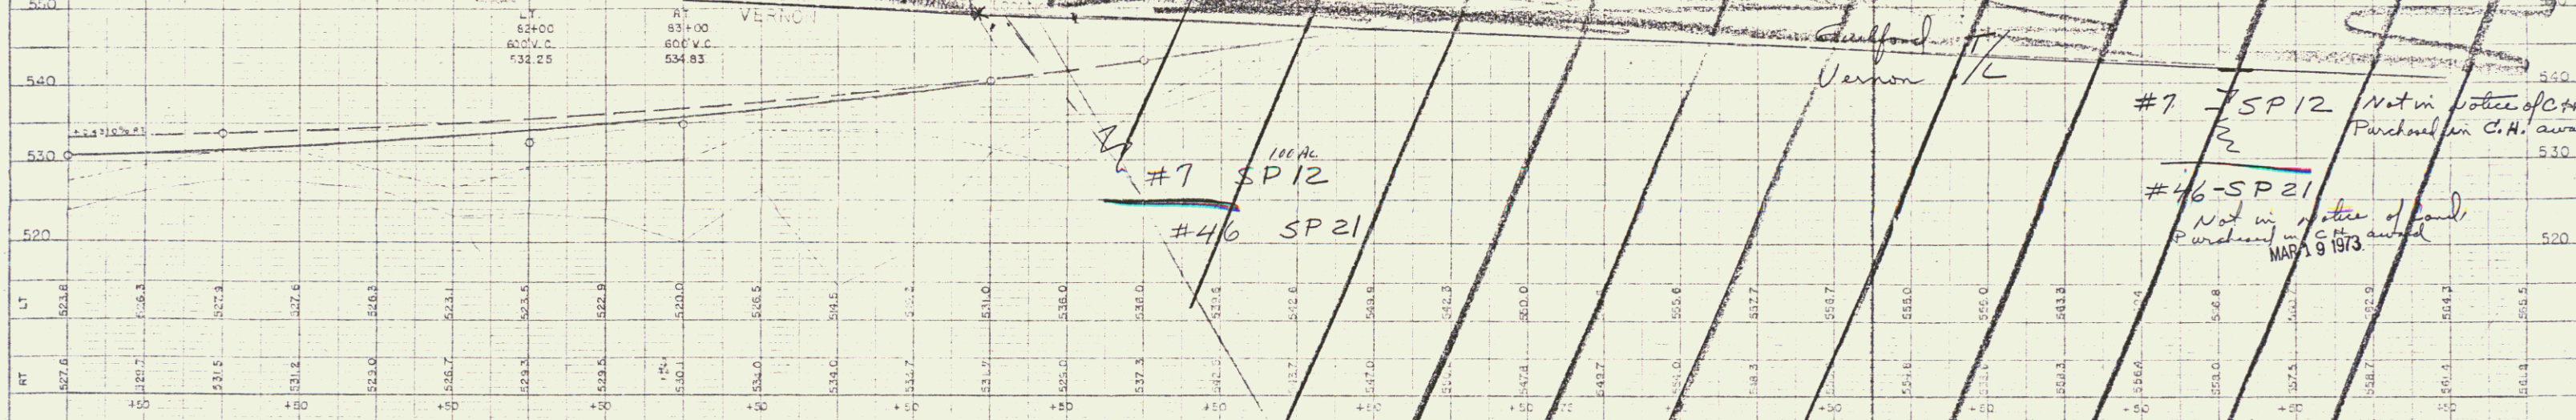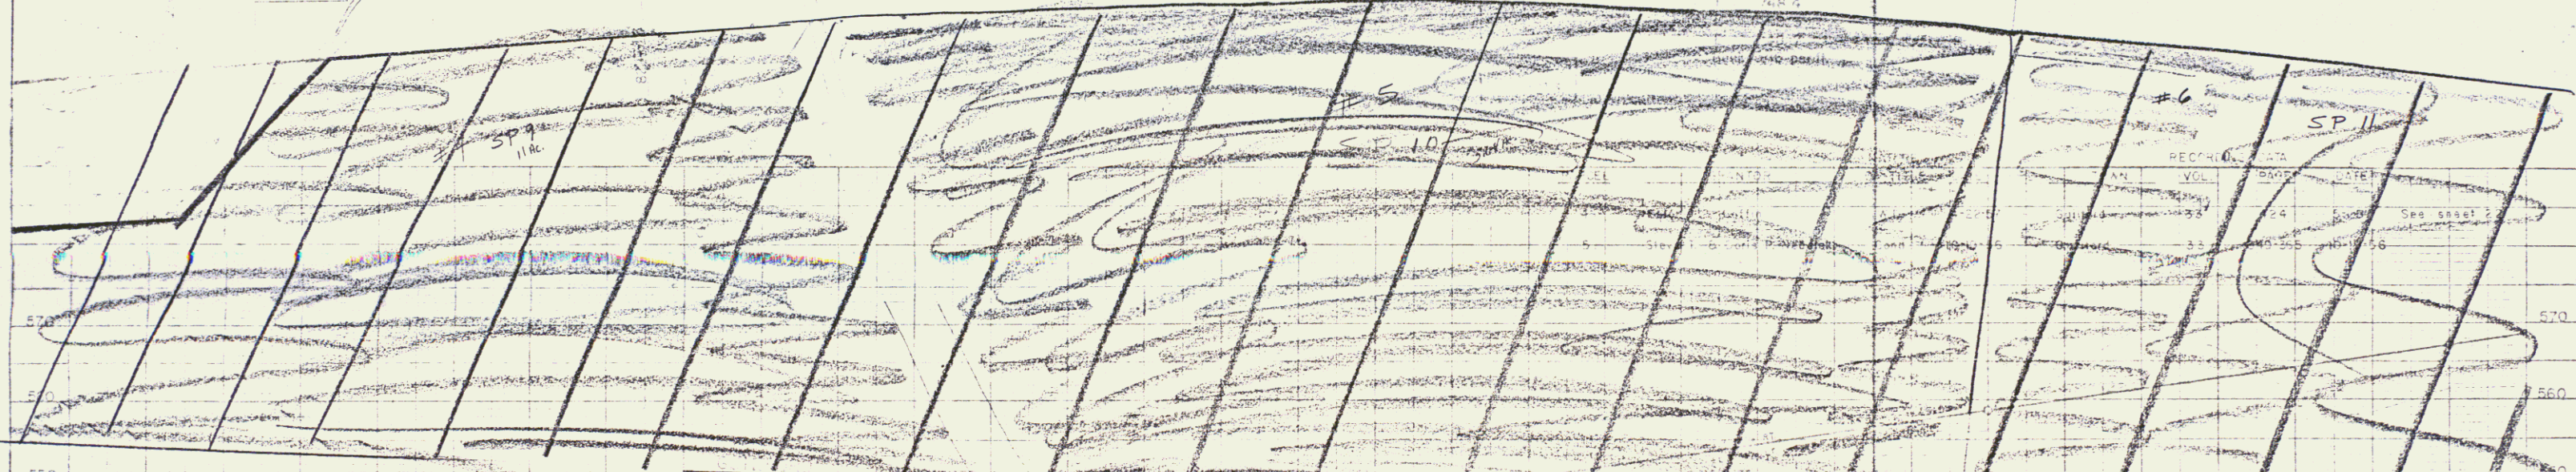

BM NO. 18 SIT 15' PINE 215 RT STA 79+05 EL 548.74
BM NO. 19 SIT 18' MAPLE 155 RT STA 80+00 EL 535.95
BM NO. 20 SIT 24' MAPLE 201 LT STA 94+82 EL 529.44
BM NO. 21 SIT 19' PINE 13 LT STA 88+02 EL 540.40
BM NO. 22 SIT 1' HEMLOCK 1 LT STA 91+01 EL 555.78

#7 SP12
#46 SP21

#7 SP12 Not in notice of C.H.
Purchased in C.H. award
#46 SP21 Not in notice of C.H.
Purchased in C.H. award
MAY 9 1973

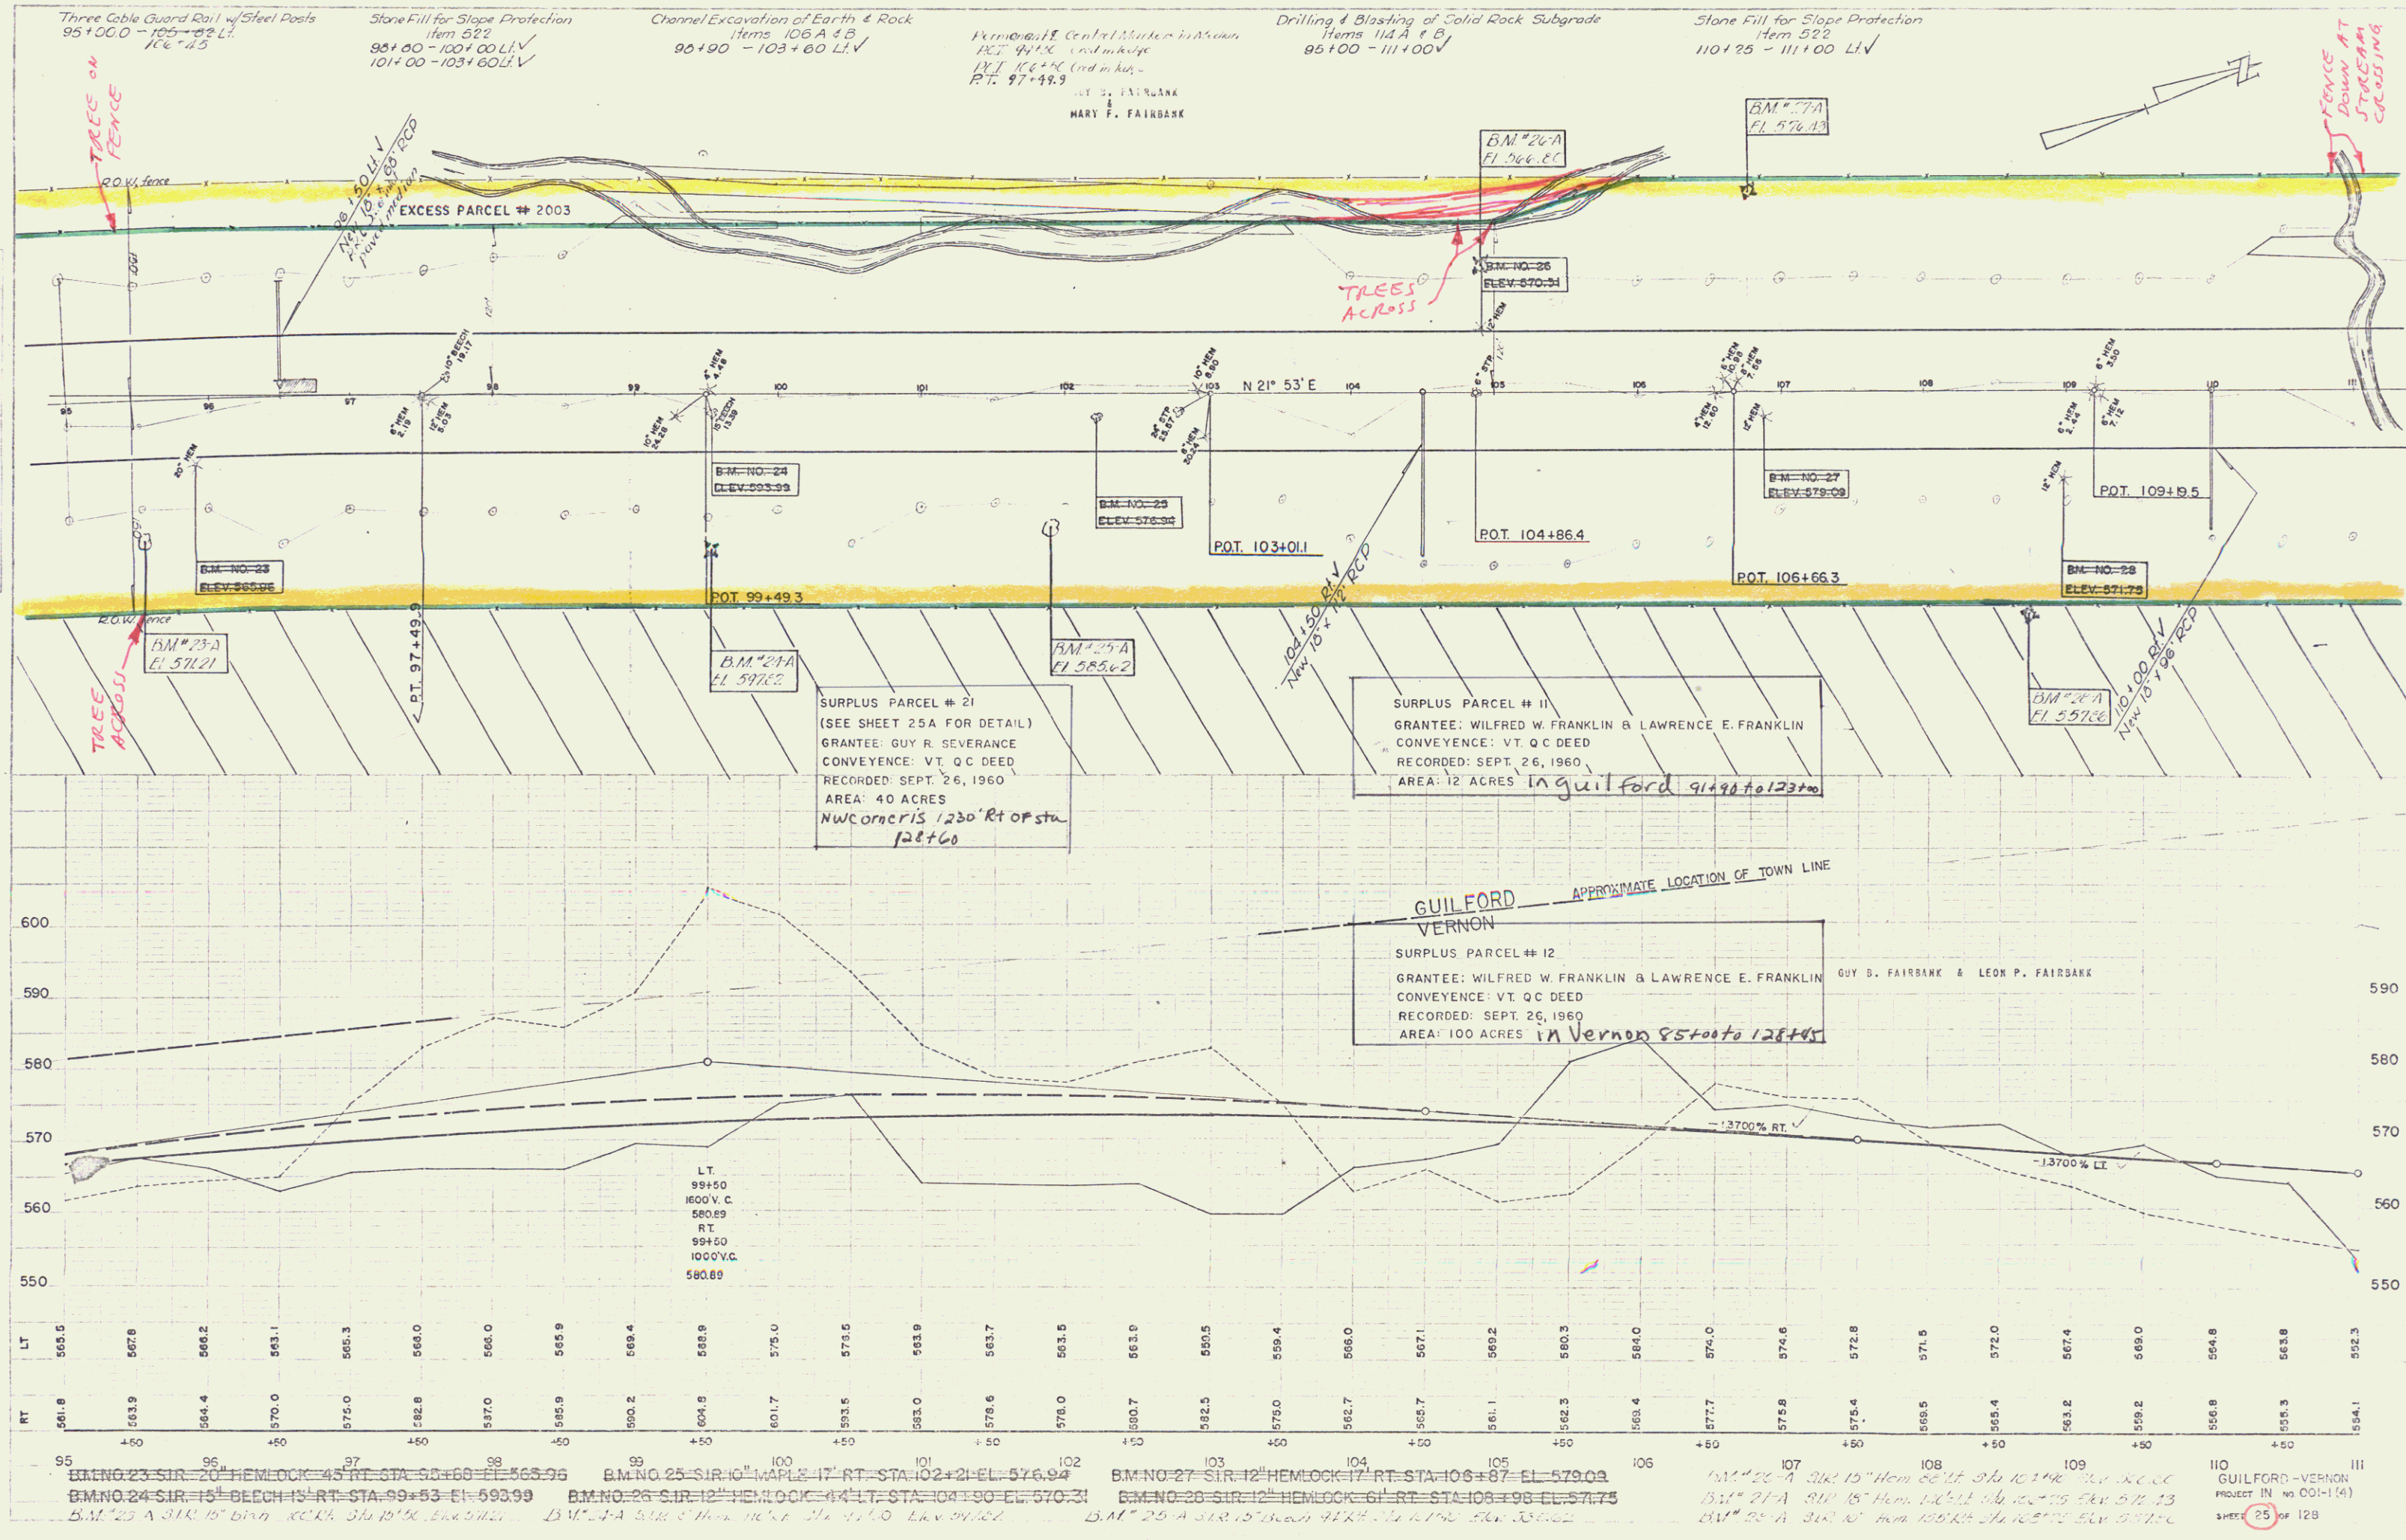

PLAN


NO.	DATE	BY	CHKD.	APP'D.
1	3/15	...	...	...

NOTES

NO.	DATE	BY	CHKD.	APP'D.
1	3/15	...	...	...

TRAVERSE

STATION	ANGLE	DISTANCE	BEARING
95+00	...	...	...

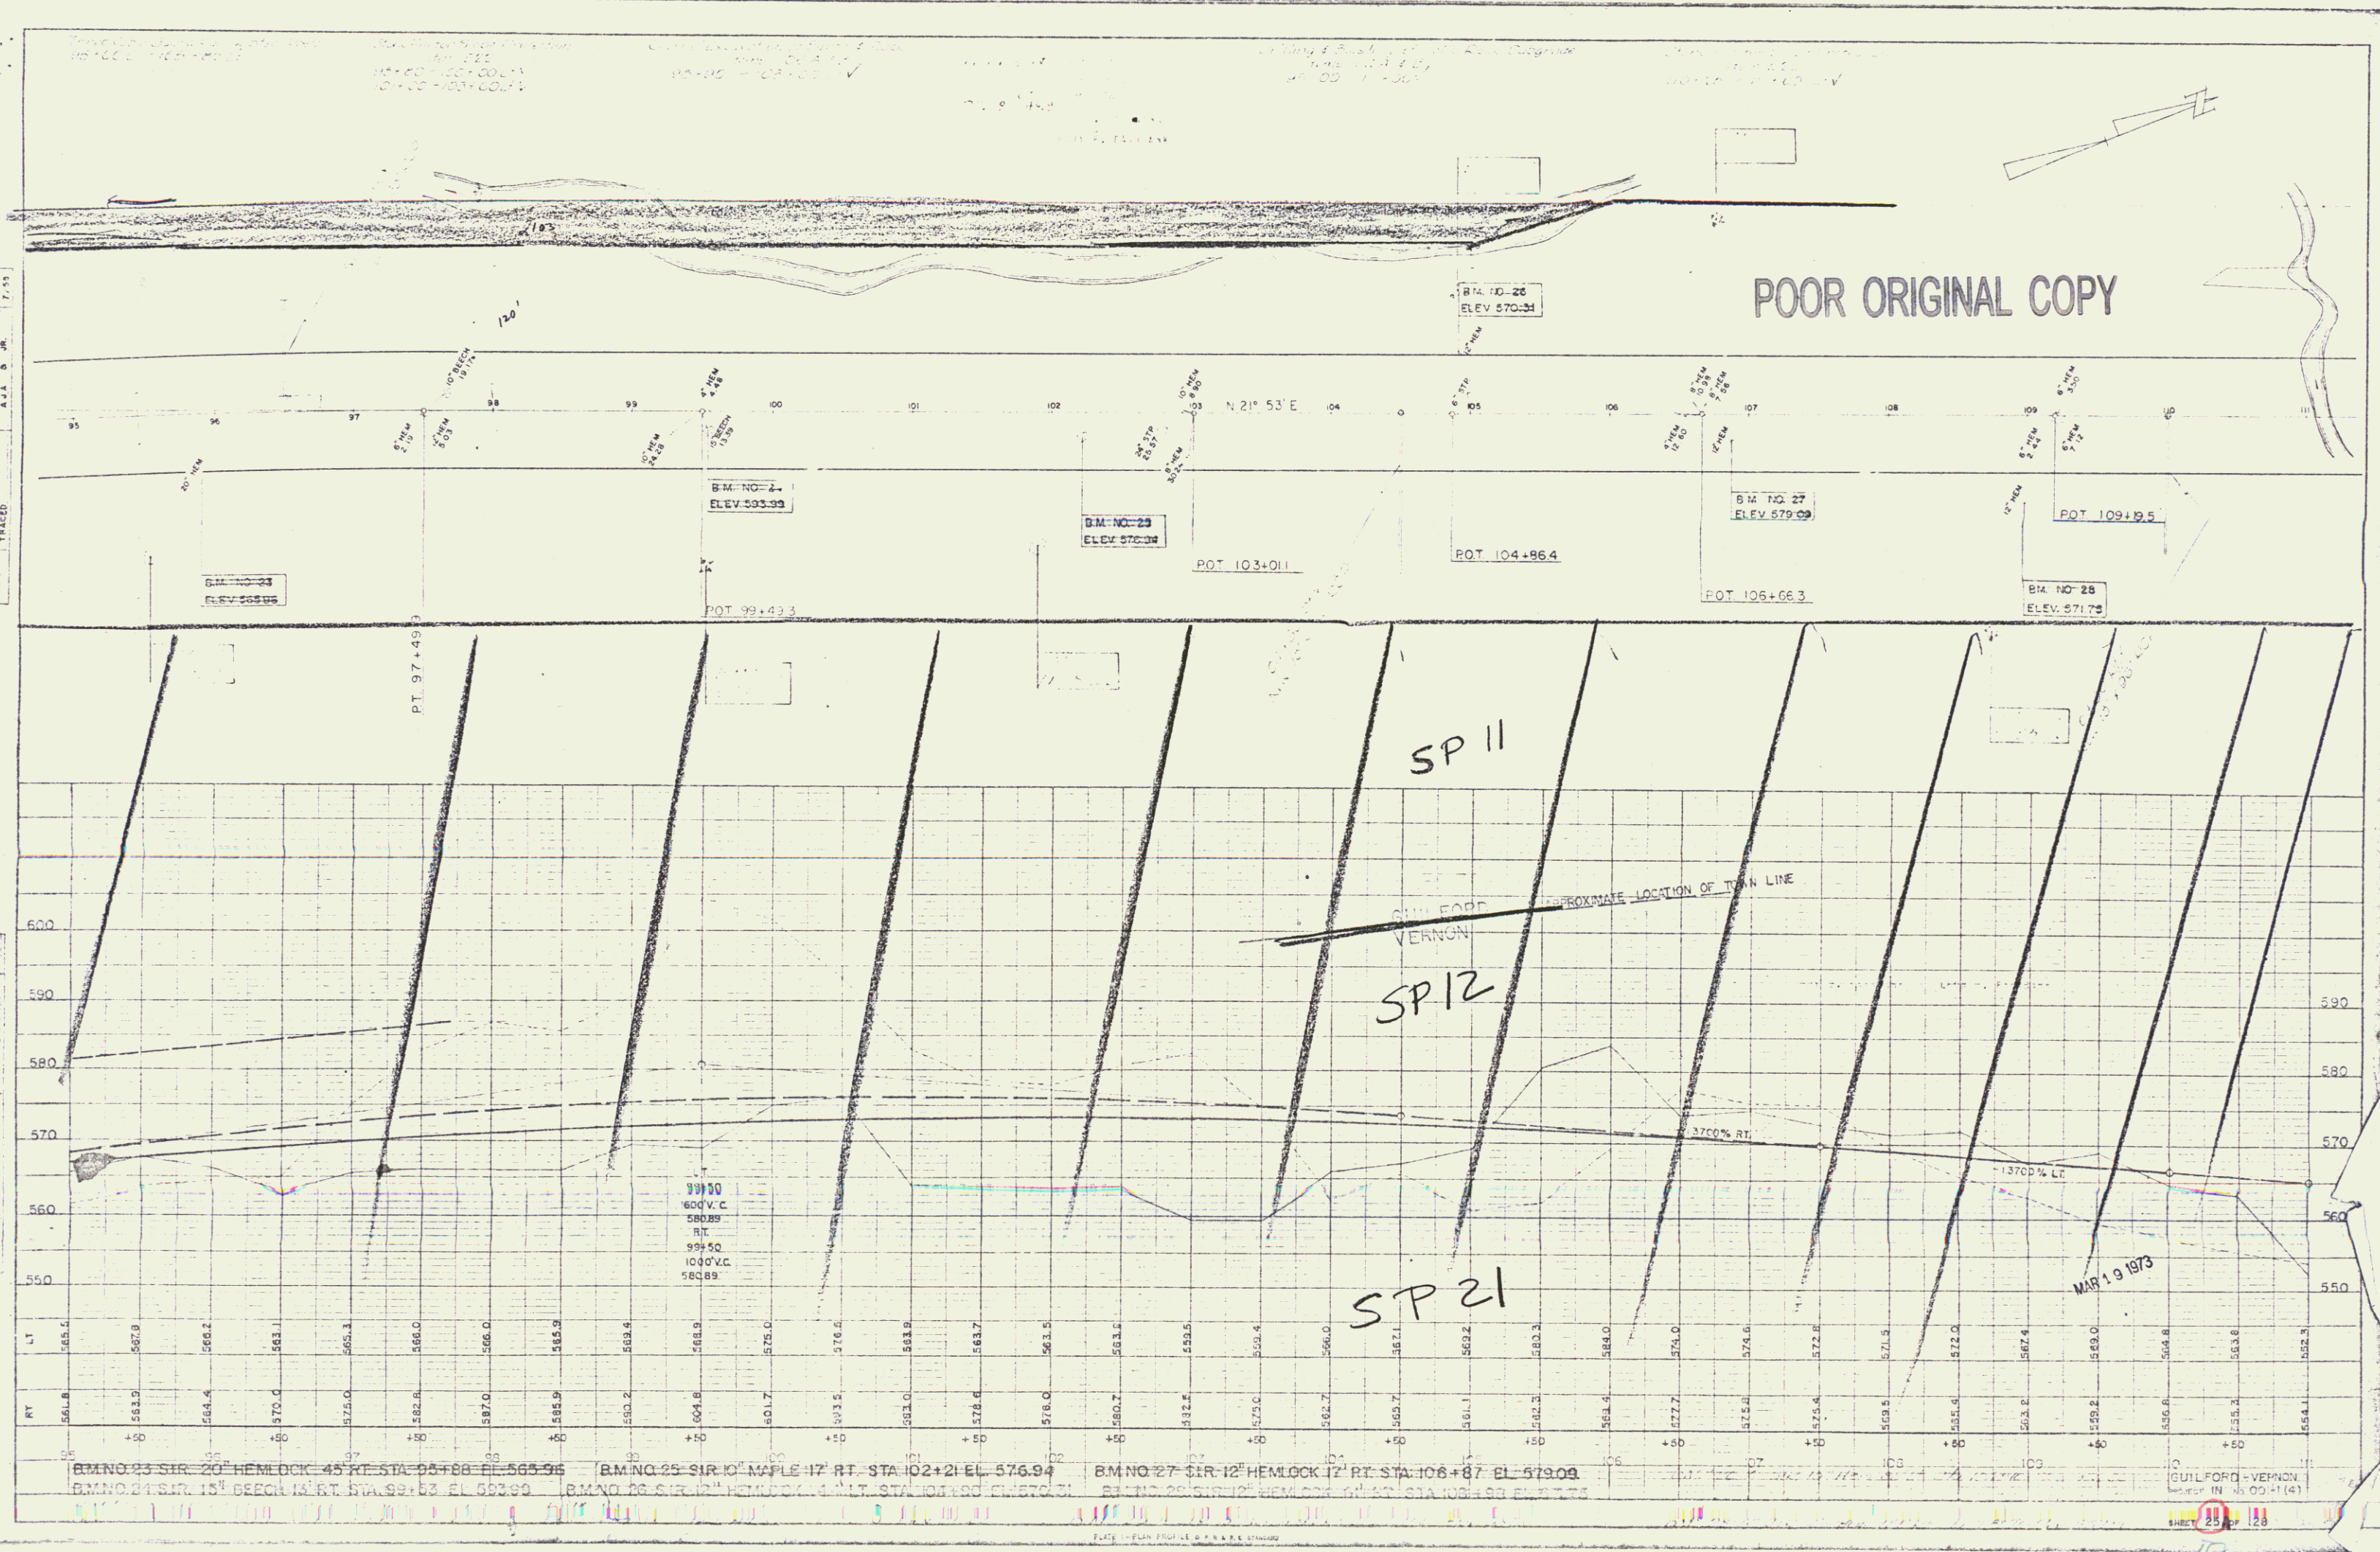

POOR ORIGINAL COPY

SP 11

SP 12

SP 21


MAR 19 1973

PLAN
SCALE
DATE
BY
CHECKED
TRACED
A.J.A. 8/8/73

BM NO. 23 SIR 20 HEMLOCK 45 RT STA 95+88 EL 565.95
BM NO. 24 SIR 18 GEECH N RT STA 99+53 EL 583.99
BM NO. 25 SIR 10 MAPLE 17 RT STA 102+21 EL 576.94
BM NO. 26 SIR 12 HEMLOCK 17 RT STA 106+87 EL 579.09
GUILFORD-VERNON
IN 100-1 (4)

RIGHT-OF-WAY DIVISION
TOWN FILE
PERPETUAL

Town of _____
(To Be Returned To L.R.R. Division)

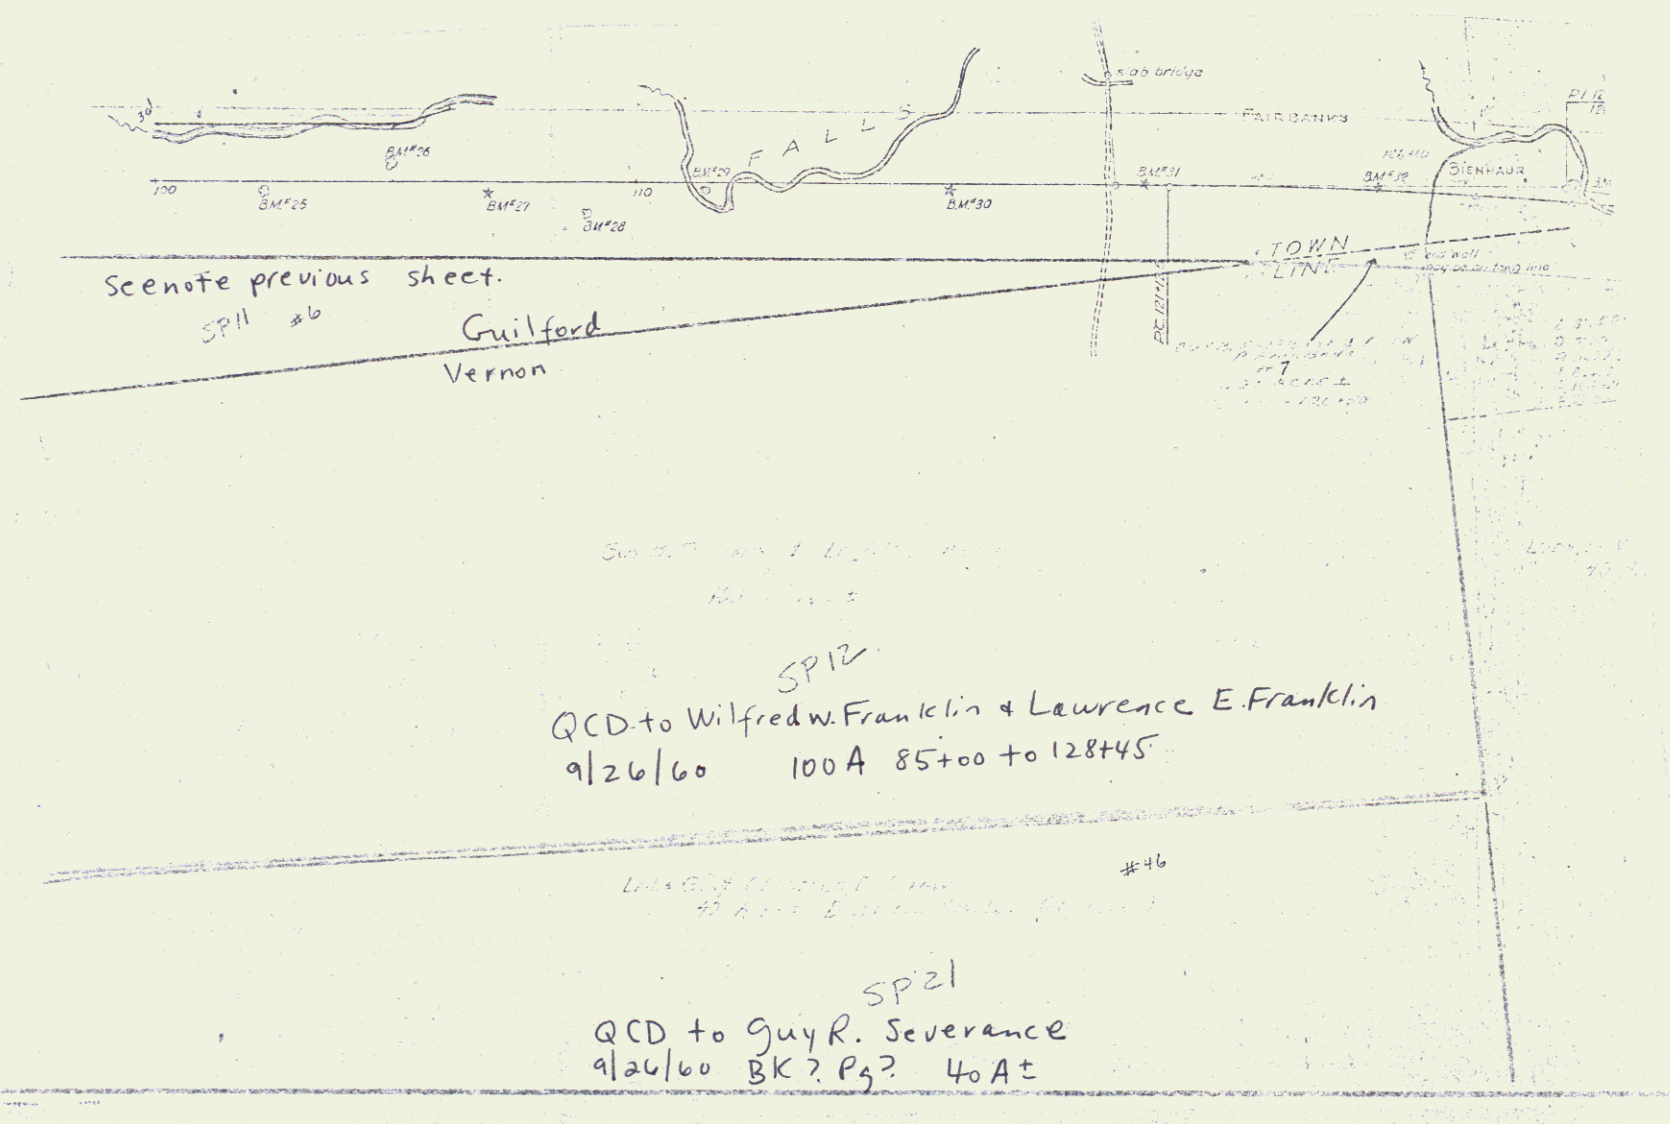


JAN 3 1992

POOR ORIGINAL COPY

Stone Fill for Slope Protection, Item 522
111+00 - 112+00 Lt.
115' 15"

Channel Excavation of Earth & Rock, Items 106 A & B
111+00 - 115+75 ✓

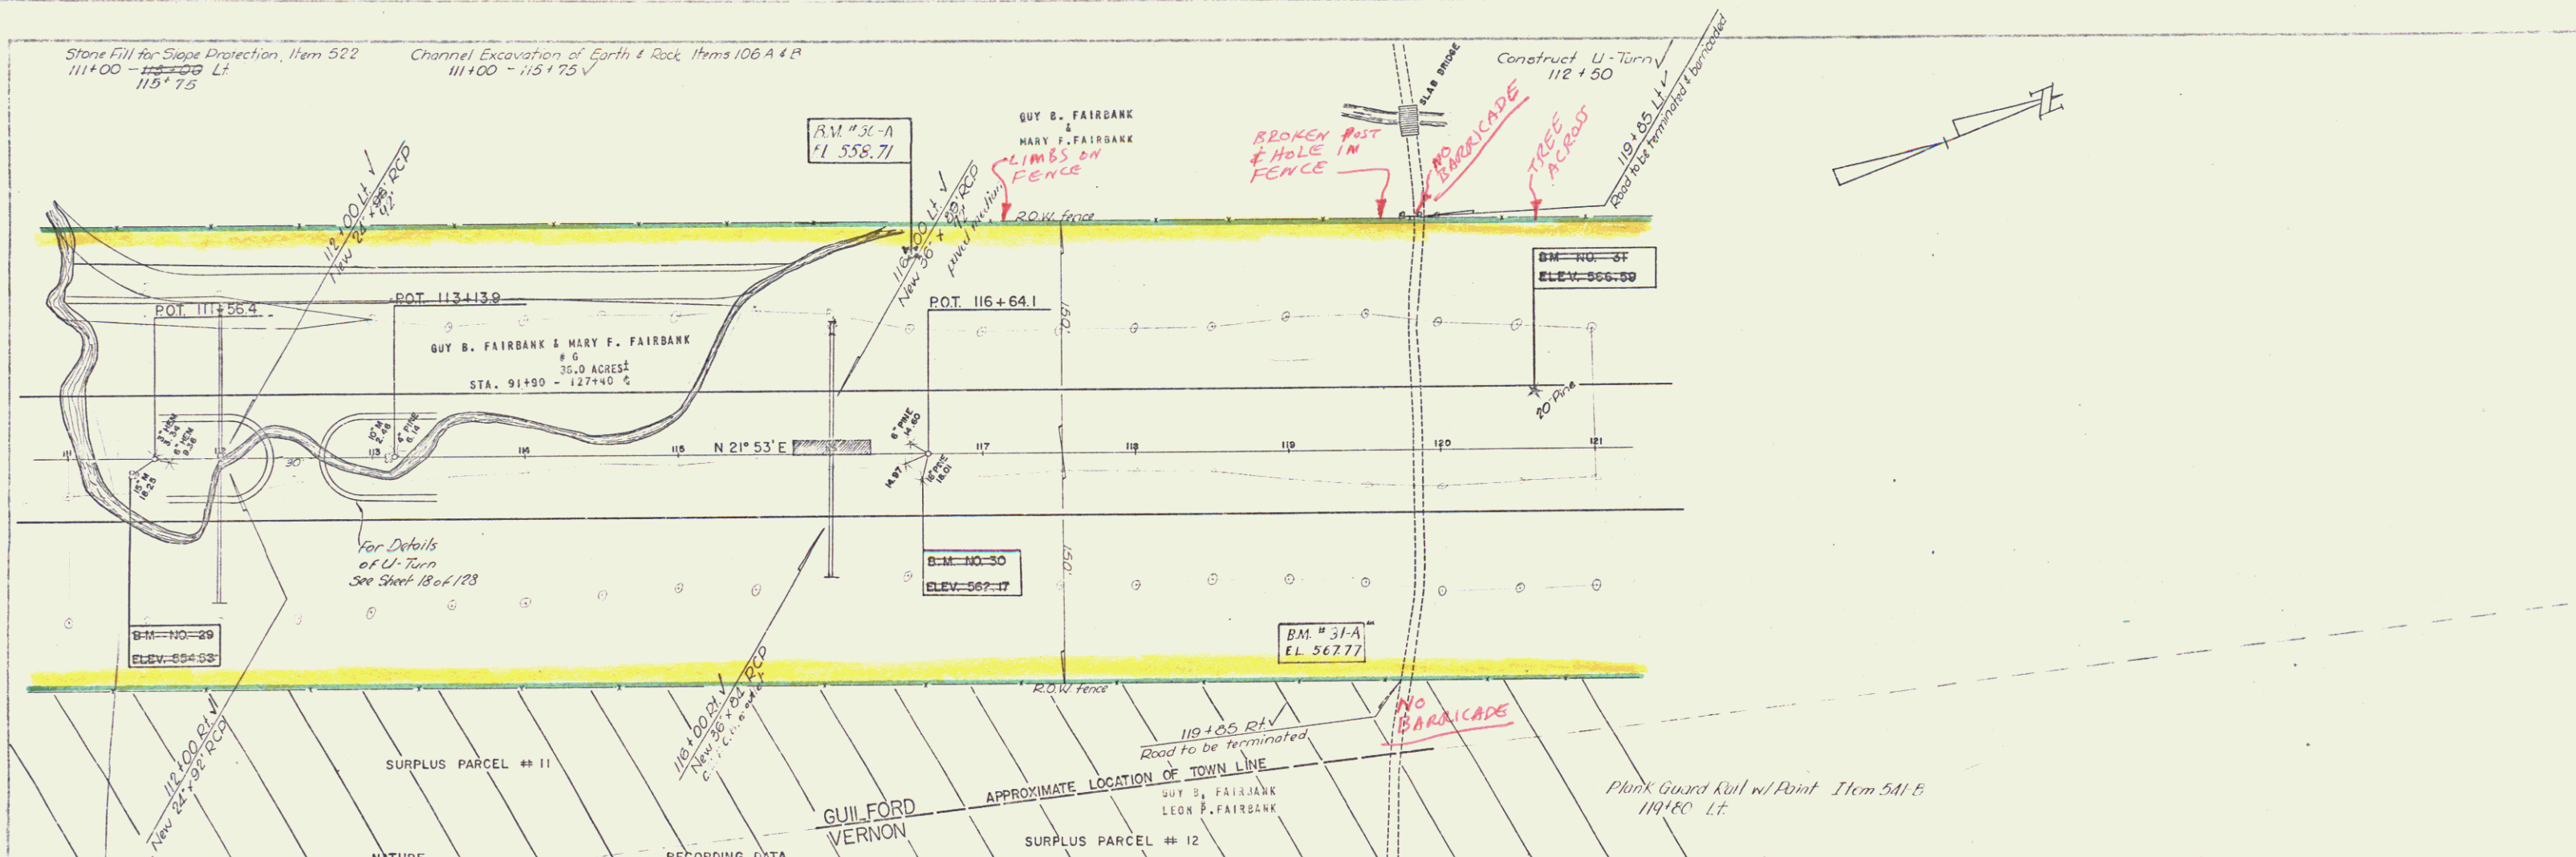


PARCEL	GRANTOR	NATURE OF TITLE	DATE	TOWN	VOL.	PAGE	DATE
6	Guy B. Fairbank & Mary F. Fairbank	Cond.	10-19-56	Guilford	33	349-365	10-19-56 See sheet 24, 25, & 27

LT.	RT.	STATION	ELEVATION
562.3	564.1	111+00	563.08
563.3	563.7	112+50	563.08
563.7	564.4	113+00	563.08
564.4	564.5	114+00	563.08
564.5	565.0	115+00	563.08
565.0	565.6	116+00	563.08
565.6	566.2	117+00	563.08
566.2	566.7	118+00	563.08
566.7	567.1	119+00	563.08
567.1	567.6	120+00	563.08
567.6	568.1	121+00	563.08
568.1	568.6	122+00	563.08
568.6	569.1	123+00	563.08
569.1	569.6	124+00	563.08
569.6	570.1	125+00	563.08
570.1	570.6	126+00	563.08
570.6	571.1	127+00	563.08
571.1	571.6	128+00	563.08
571.6	572.1	129+00	563.08
572.1	572.6	130+00	563.08
572.6	573.1	131+00	563.08
573.1	573.6	132+00	563.08
573.6	574.1	133+00	563.08
574.1	574.6	134+00	563.08
574.6	575.1	135+00	563.08
575.1	575.6	136+00	563.08
575.6	576.1	137+00	563.08
576.1	576.6	138+00	563.08
576.6	577.1	139+00	563.08
577.1	577.6	140+00	563.08
577.6	578.1	141+00	563.08
578.1	578.6	142+00	563.08
578.6	579.1	143+00	563.08
579.1	579.6	144+00	563.08
579.6	580.1	145+00	563.08

NOTE: STATE OF VT. to Wilfred W. Franklin & Lawrence E. Franklin by QCO's dated 9/26/60 100 A± in Vernon sta 85+00 to 128+45
12 A± in Guilford sta 91+90 to 123+00

PLAN
SURVEYED
NOTE BOOK
ELEVATION CHECKED
7/59
A.A. B. JR.
TRACED

DATE
BY
PROJECT
NO.

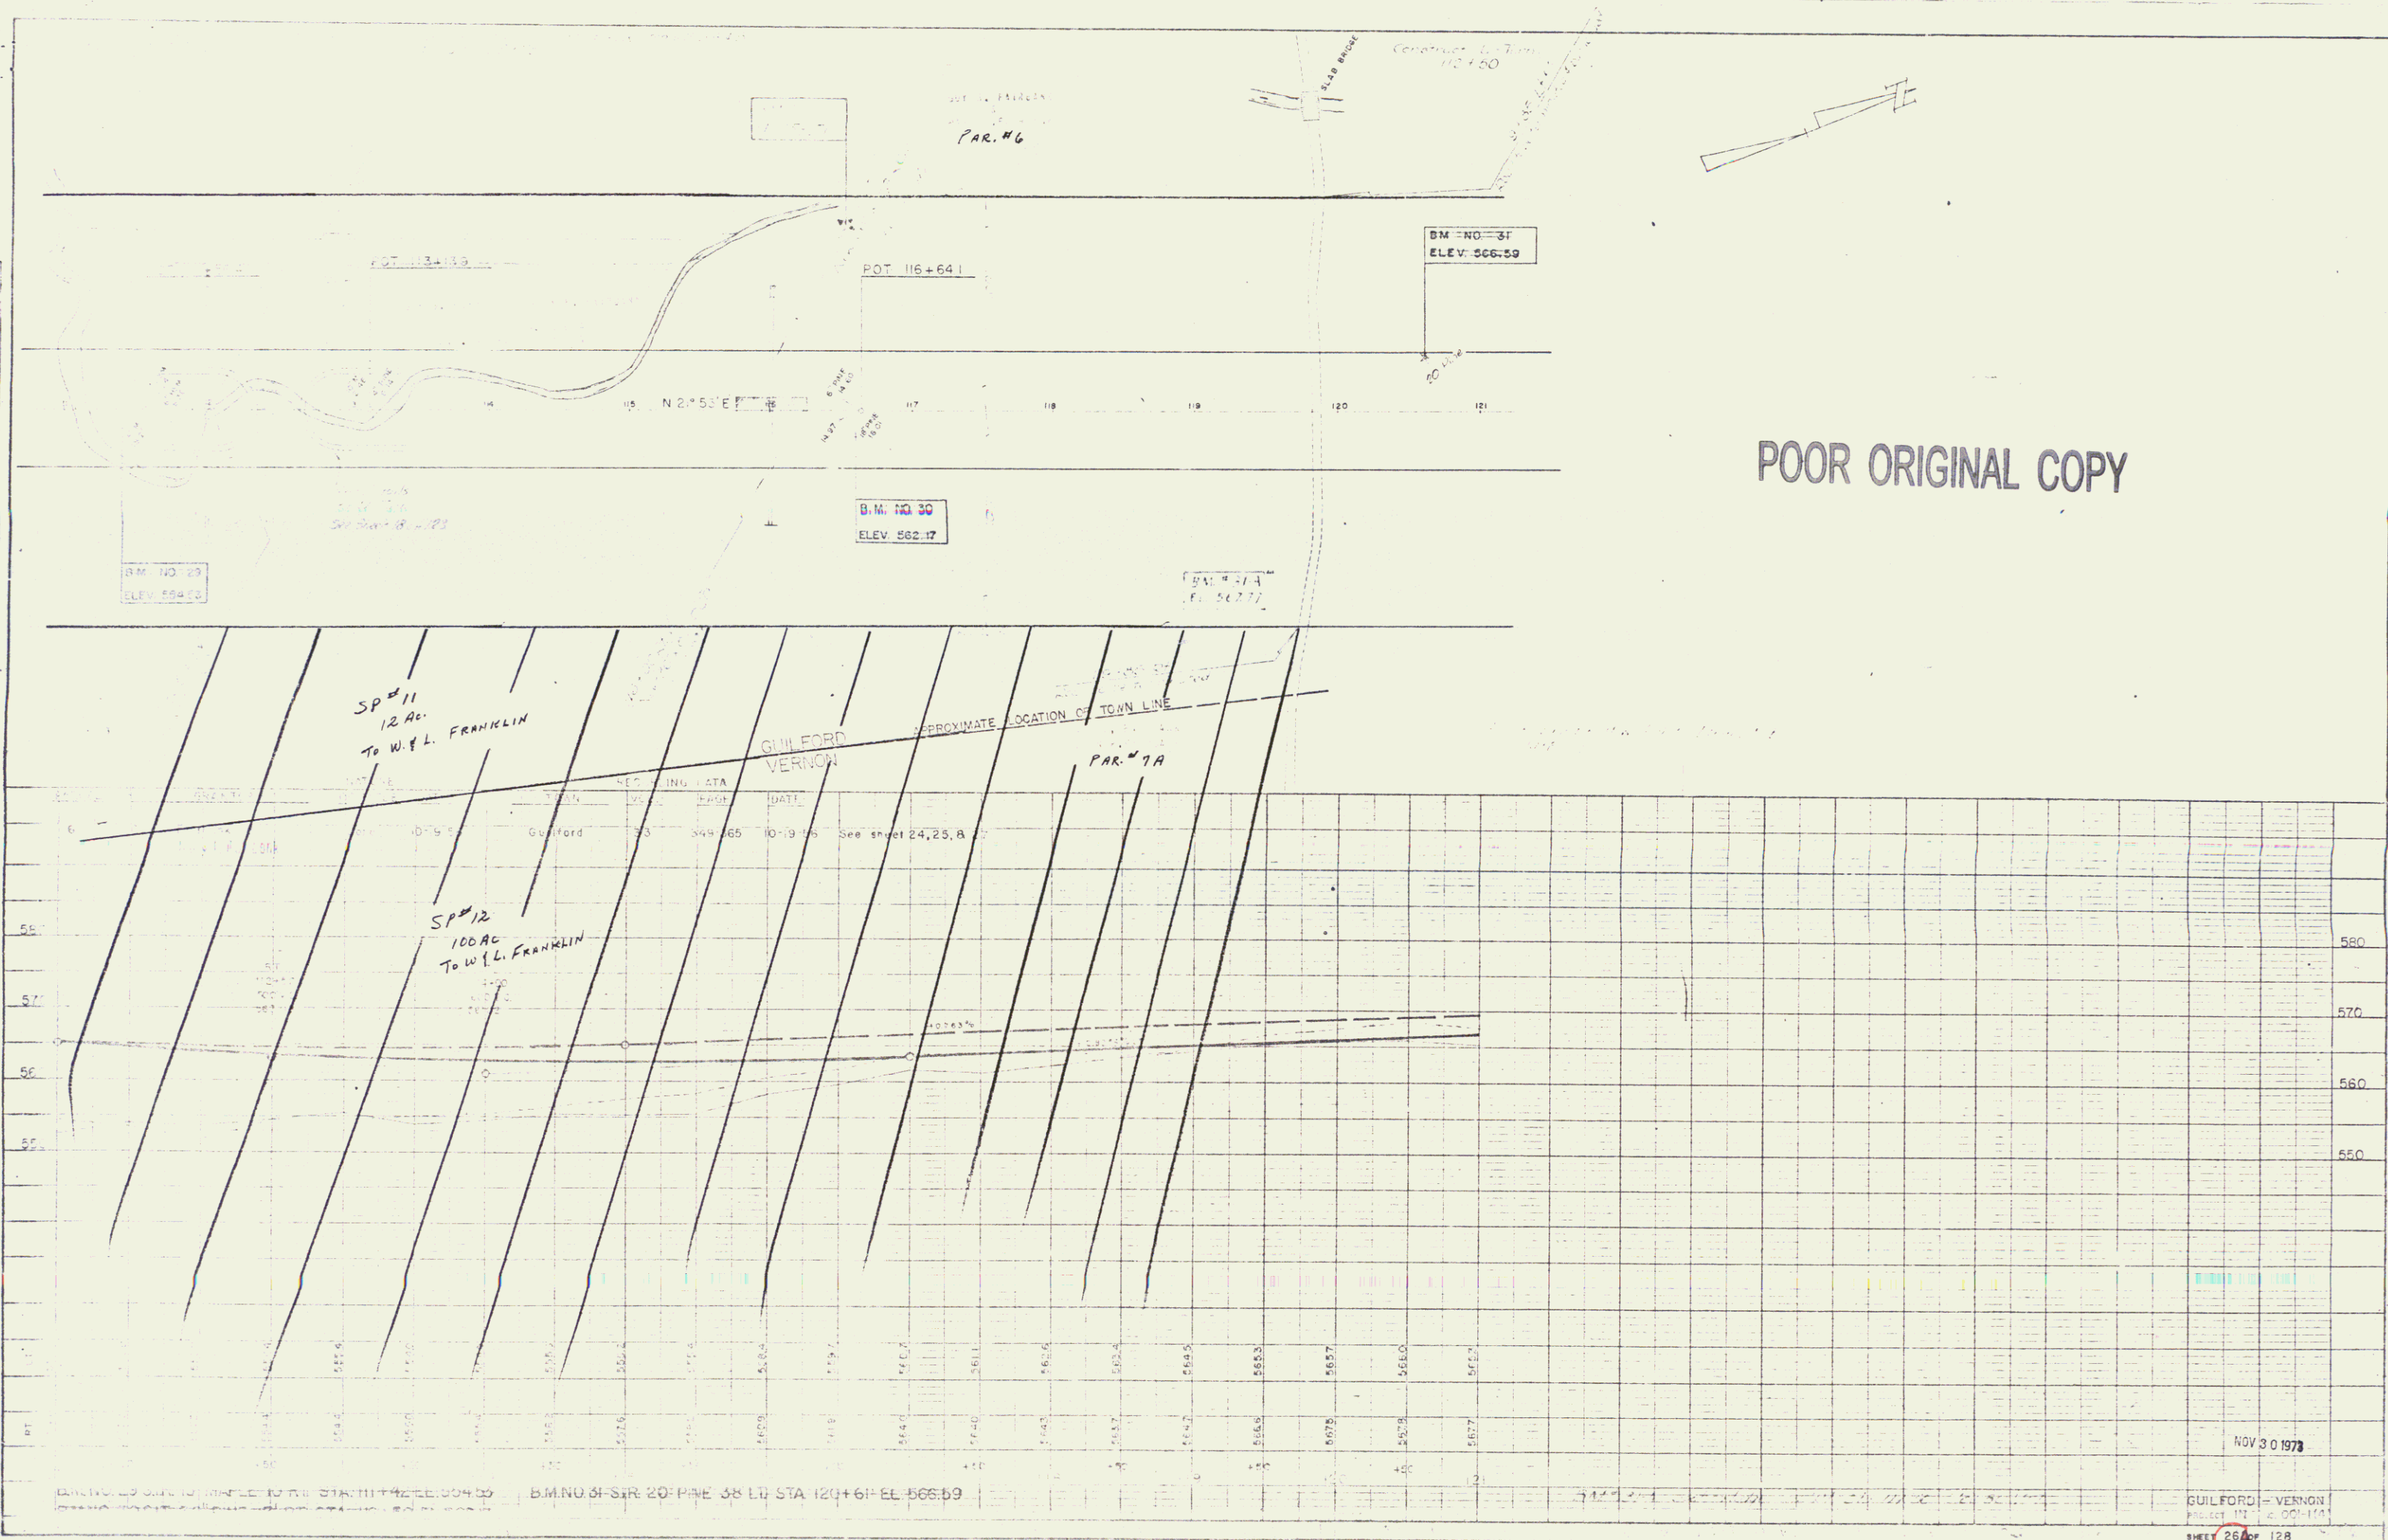


POOR ORIGINAL COPY

NOV 30 1978
GUILFORD - VERNON
SHEET 26 OF 128


PLAN	SURVEYED	BY	7/1966
NOTE BOOK	PLOTTED	P. J. A. R.	
NO.	ALIGNMENT CHECKED	CARLSON	
	RT. OF WAY CHECKED		
	TRACED	A. J. A. R.	

SAMPLED	BY	DATE
PLOTTED		
GRADES CHECKED		
B M NOTED		
STRUCTURE NOTATION CHKO		

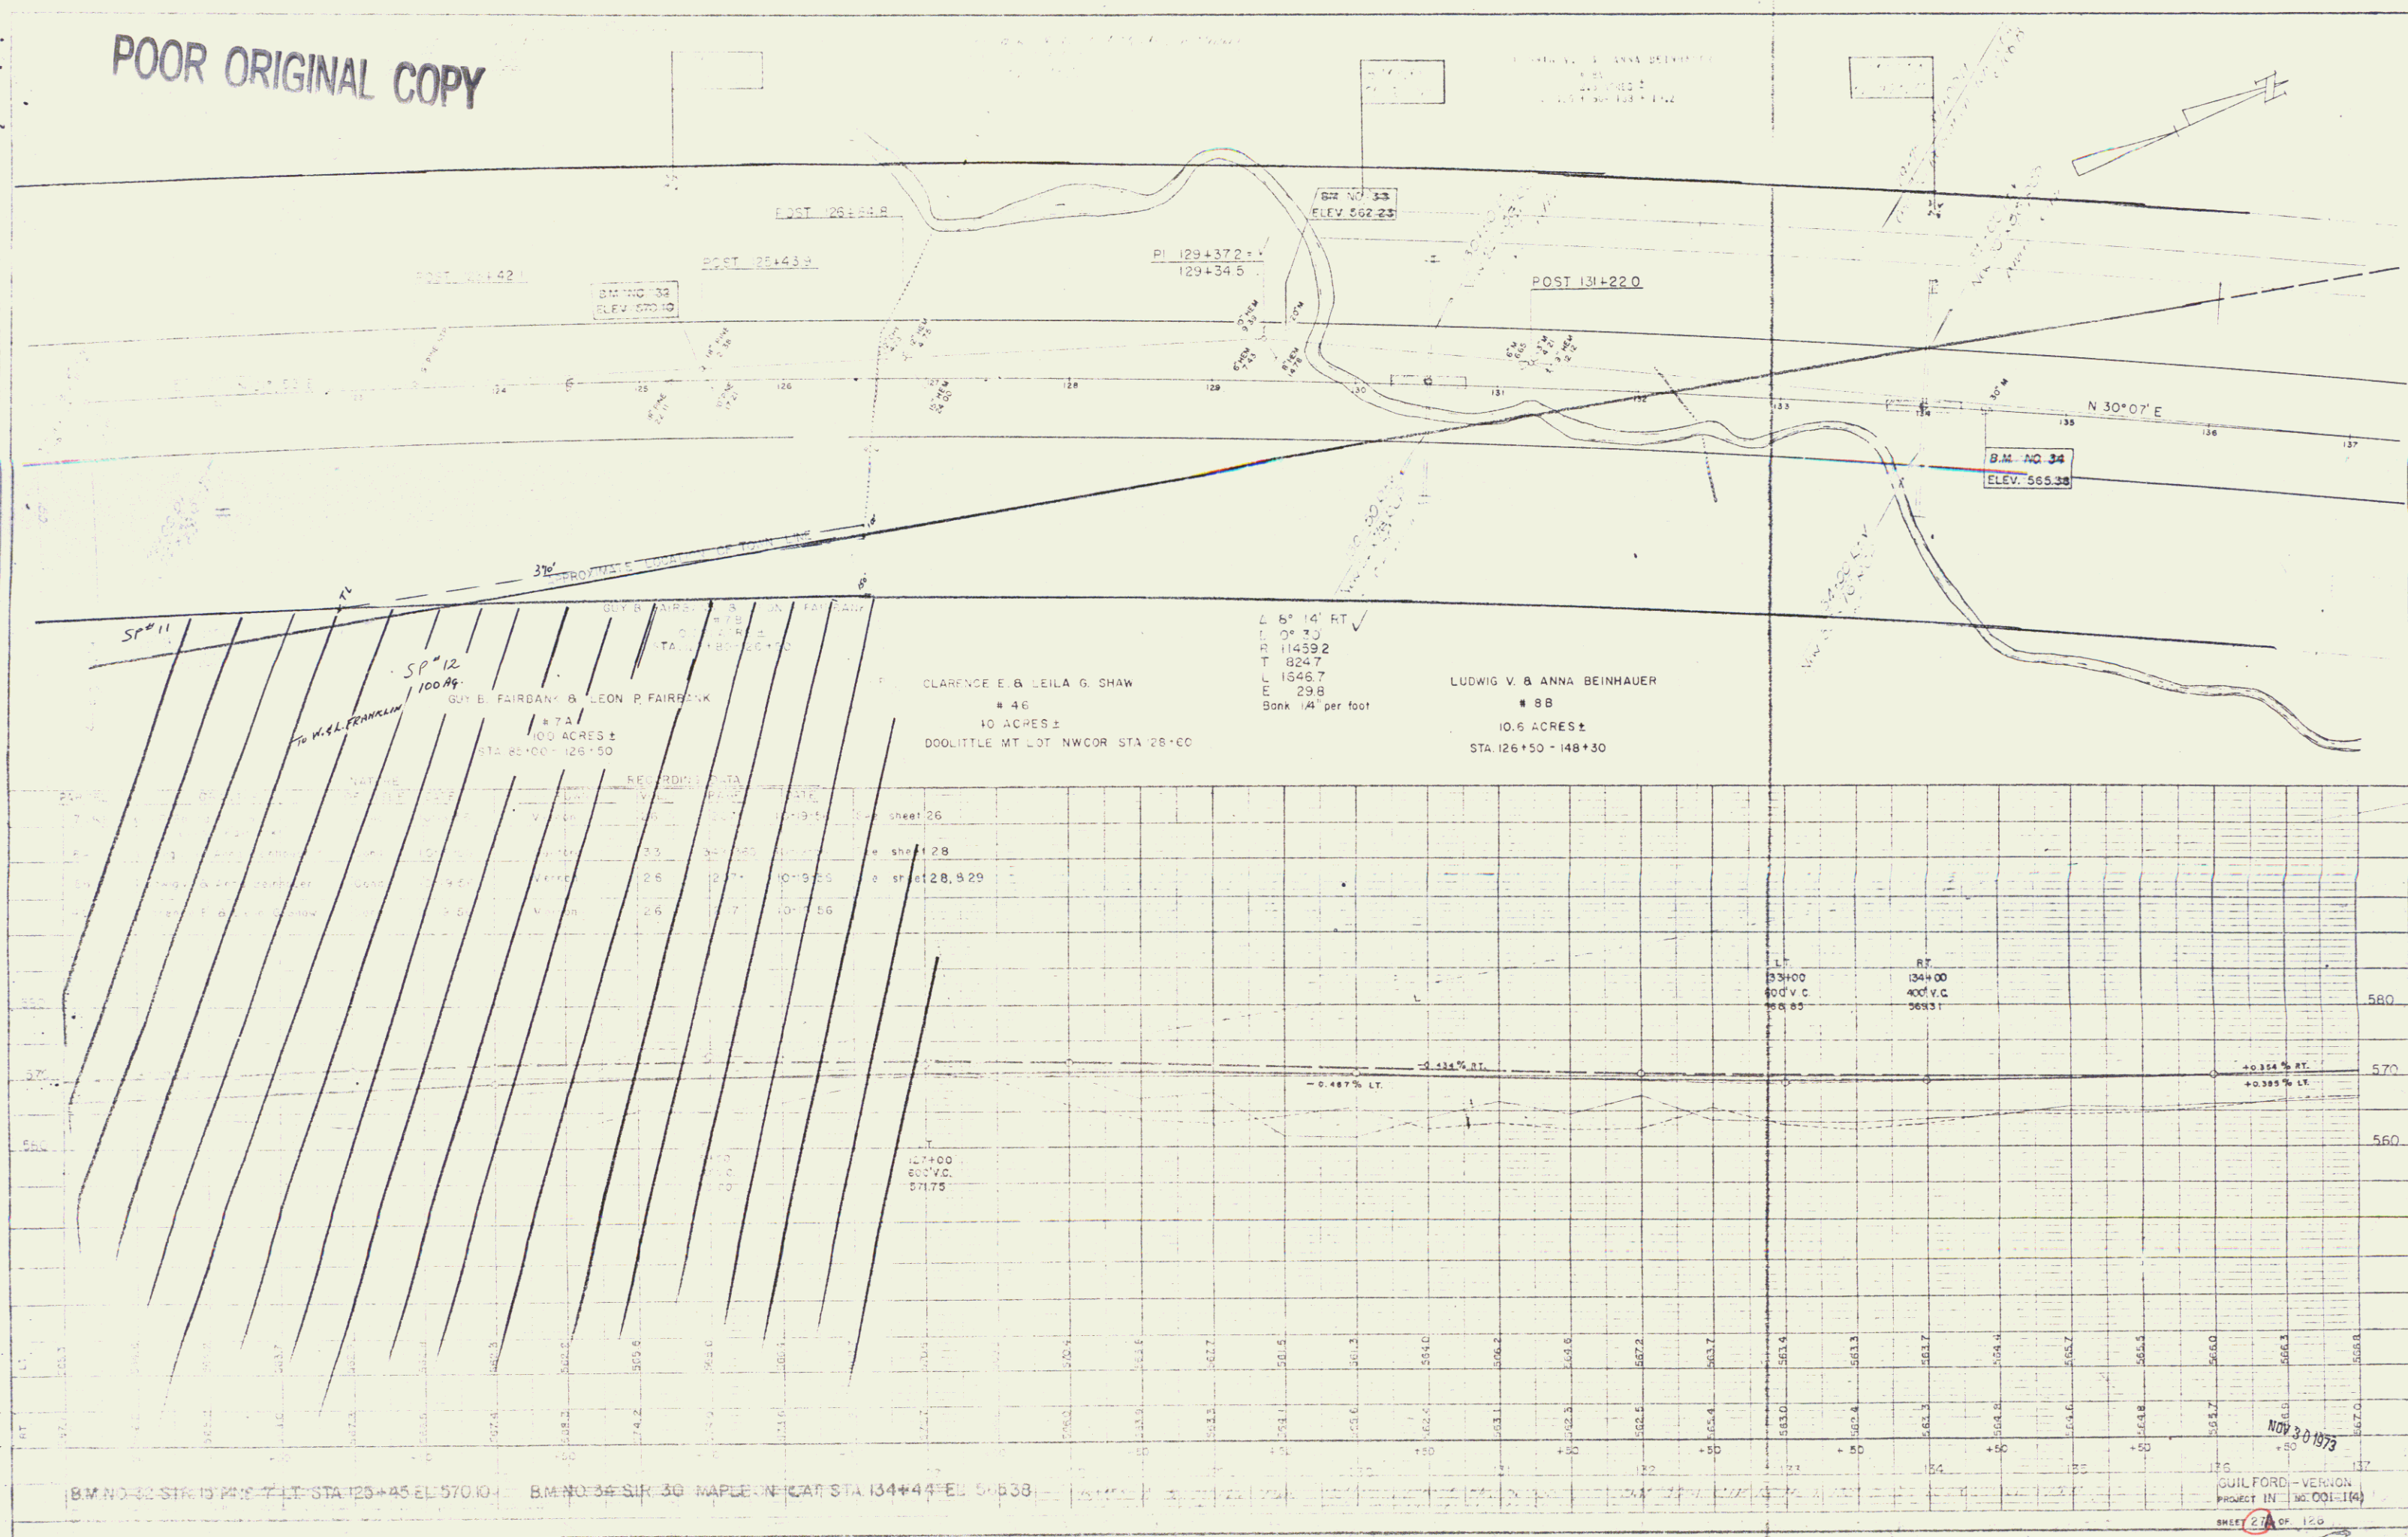

24

PLAN
 3/85
 3/85
 7/85
 MOSES
 CARLSON
 A.S. G. JR.
 TRACED

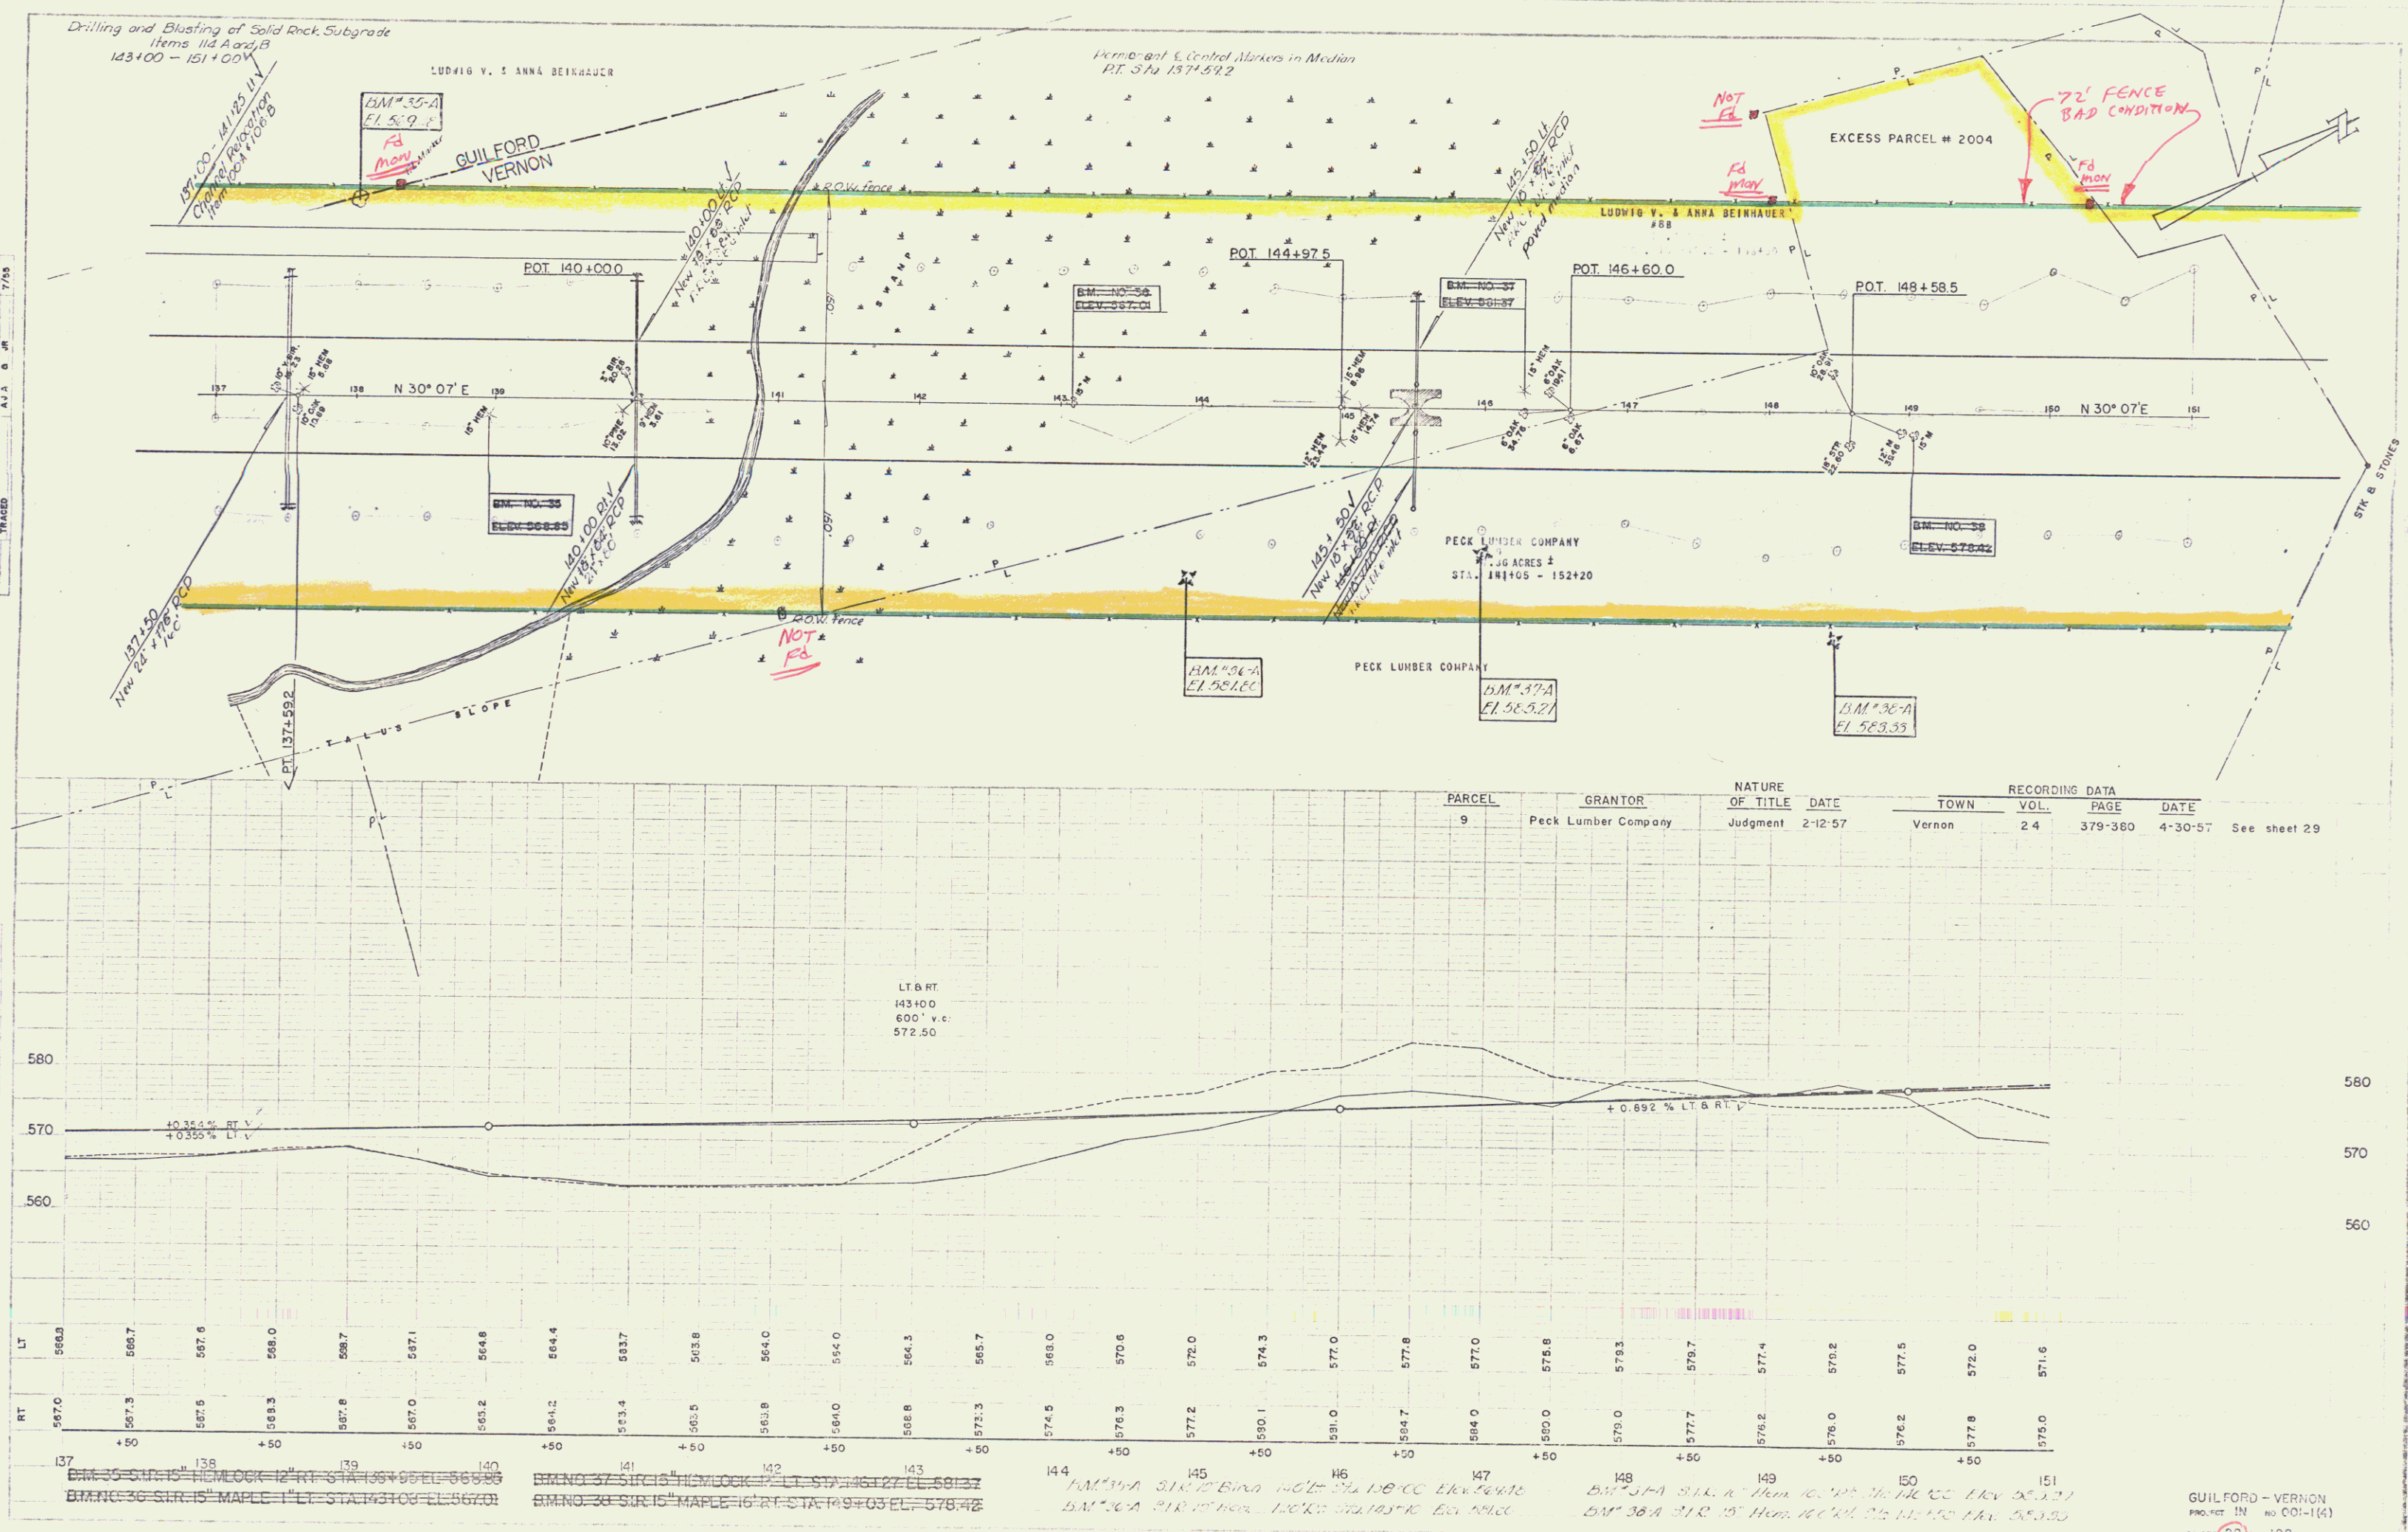

LUDWIG V. BEINHAEUER

Three Cable Guard Rail w/ Steel Posts
151+10 - 155+20 L.T.
15

Drilling and Blasting of Solid Rock Subgrade
Items 14A & B
159+00 - 165+50
121'00" - 15'15"
R.C. 151+49.6
R.T. 163+49.6



Element & Control Markers in Median
R.C. 151+49.6
R.T. 163+49.6

LUDWIG V. BEINHAEUER & JOHN K. HORSTMAN

Standard Steel Beam Guard Rail
w/ Steel Posts
151+36 - 151+65 R.T. ✓

A 12° 00' LT
D 1°
R 5729.6 ✓
T 602.2
L 1200.0
31.7
Bank 5/16" per ft.


PECK LUMBER CO.
DISCHARGING COFFEE
COLORED WATER
MAY 30, 1974
F.D. MON
BM NO. 39
ELEV. 570.39
POST 153+14.2
MEADOW
MEADOW
WOOD ROAD
156+50 R.T.
New 10' x 20' Road
BM NO. 41
ELEV. 583.50
BM NO. 42
ELEV. 580.78
BM NO. 43
ELEV. 584.19
Plank Guard Rail w/ Point Item 54.5
155+55 - 6' LT

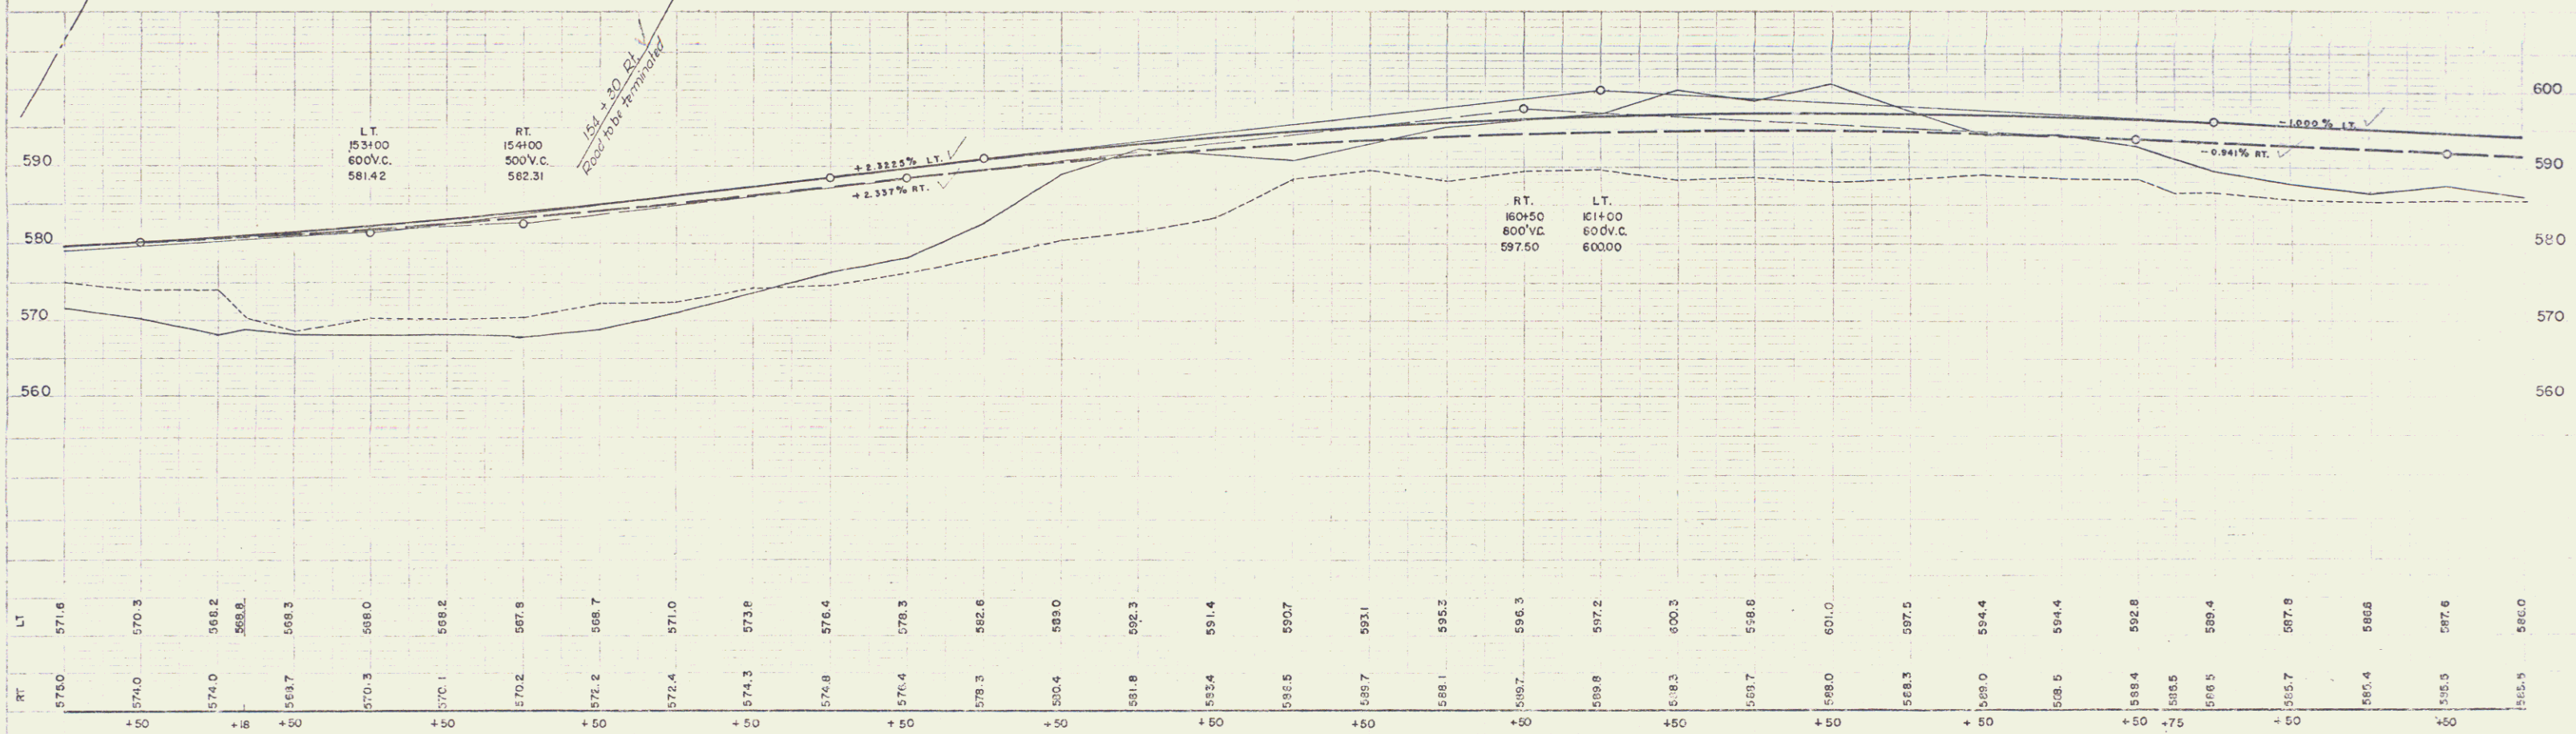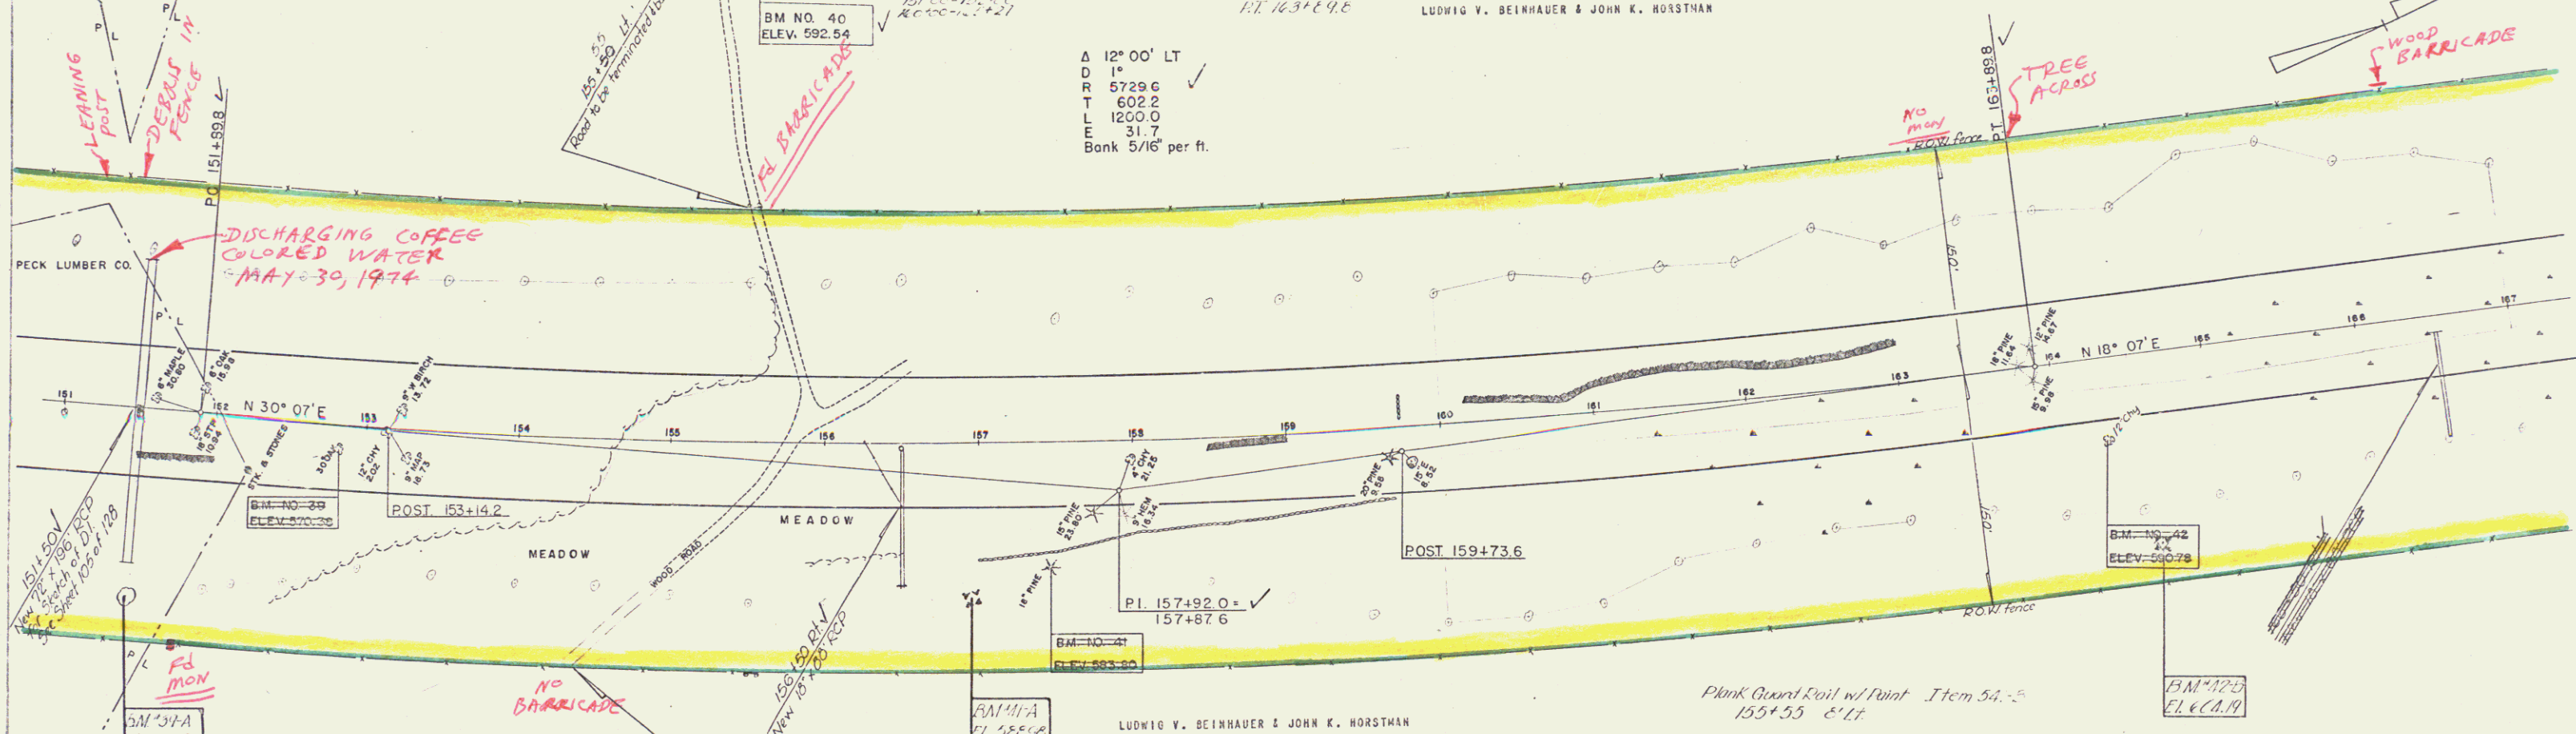


BM NO. 39 SLR. 50' C&K 15' RT STA 152+01 EL 570.39
BM NO. 40 SLR. 18' PINE 50' EAST OF OLD MILL SITE STA 155+50 EL 592.54 ✓
BM NO. 41 SLR. 13' PINE 60' RT STA 157+43 EL 583.80
BM NO. 42 SLR. 12' CHERRY 53' RT STA 164+31 EL 590.78
BM NO. 43 SLR. 15' C&K 15' RT STA 165+00 EL 584.19

156 GUILFORD - VERNON
PROJECT IN NO. 031-1(4)
SHEET 29 OF 128

PLAN
 2/75
 3/75
 7/85
 A.J.A. & J.R.
 TRACED

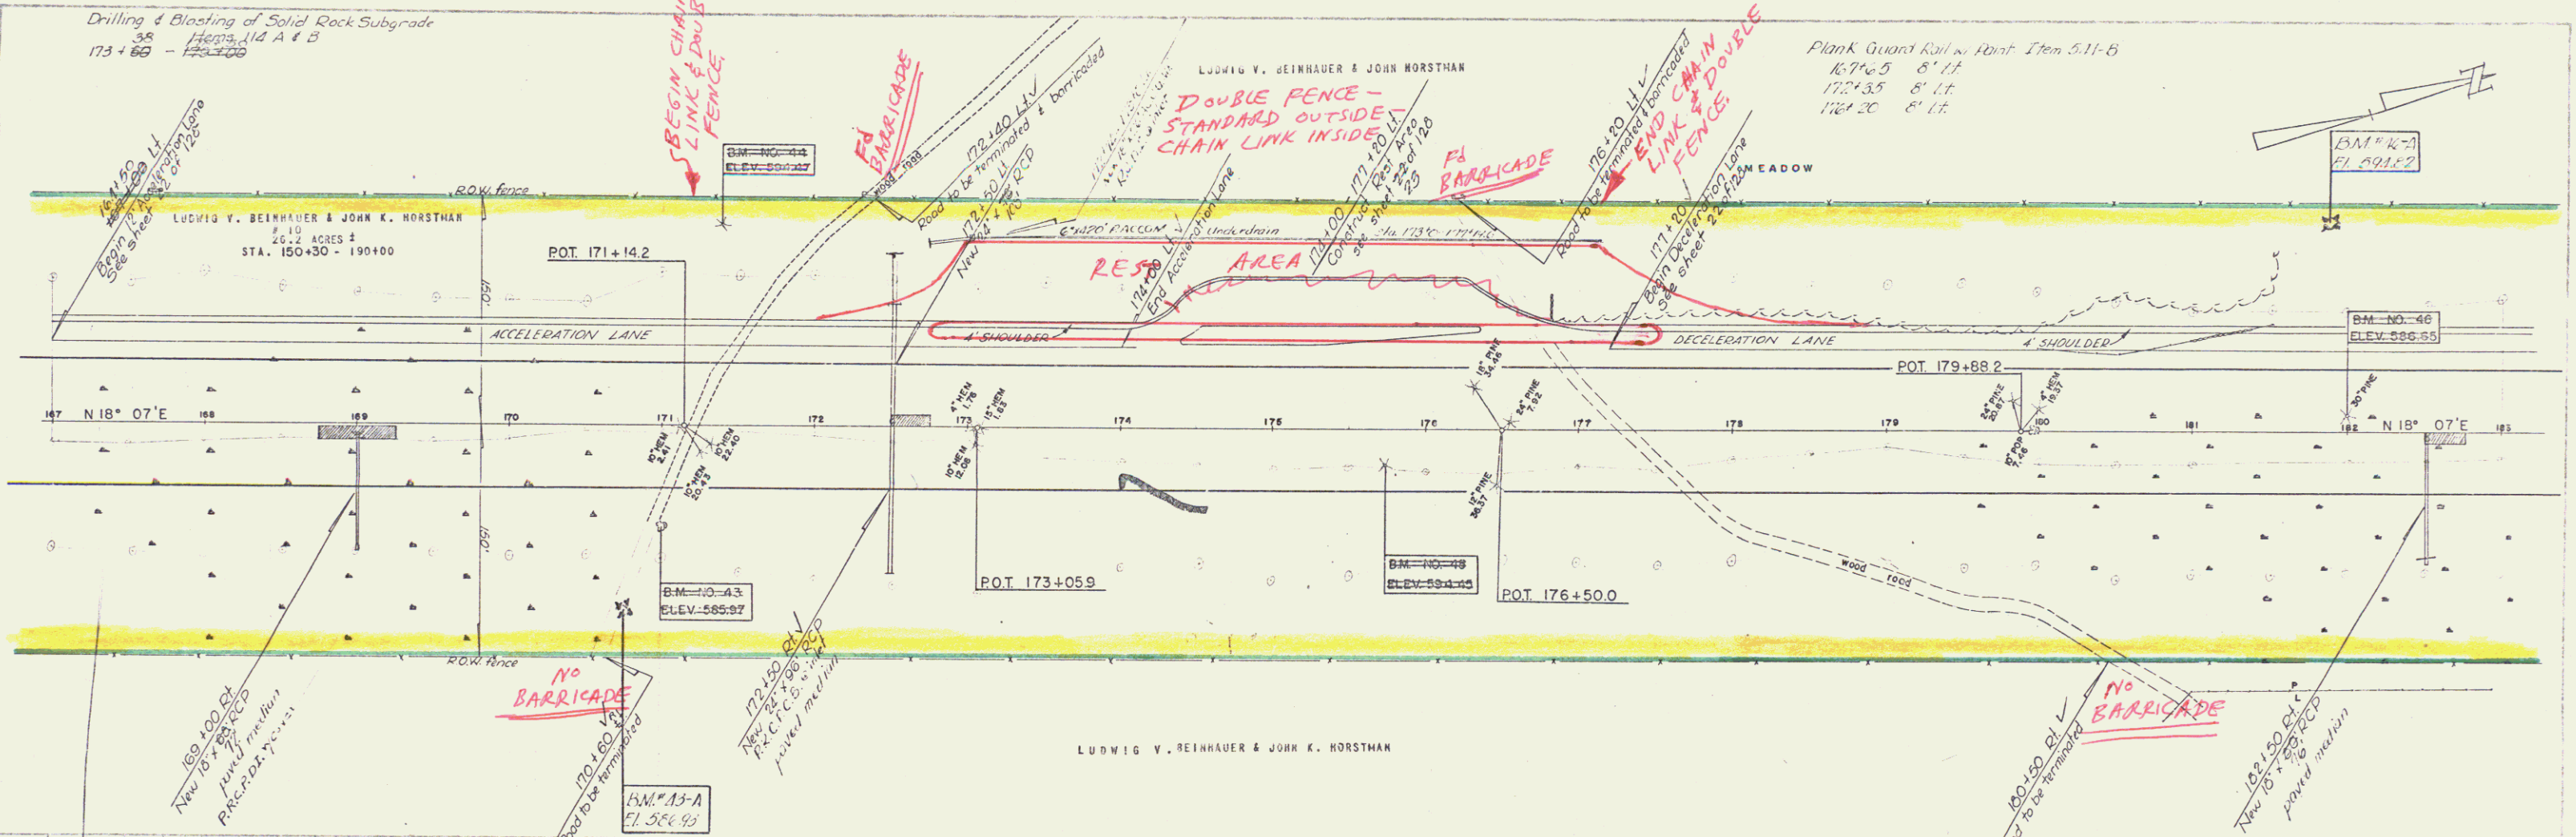

PARCEL	GRANTOR	NATURE OF TITLE	DATE	TOWN	VOL.	PAGE	DATE
10	Ludwig V. Reinbauer & John K. Horstman	Cond.	10-19-56	Vernon	26	207+	10-19-56

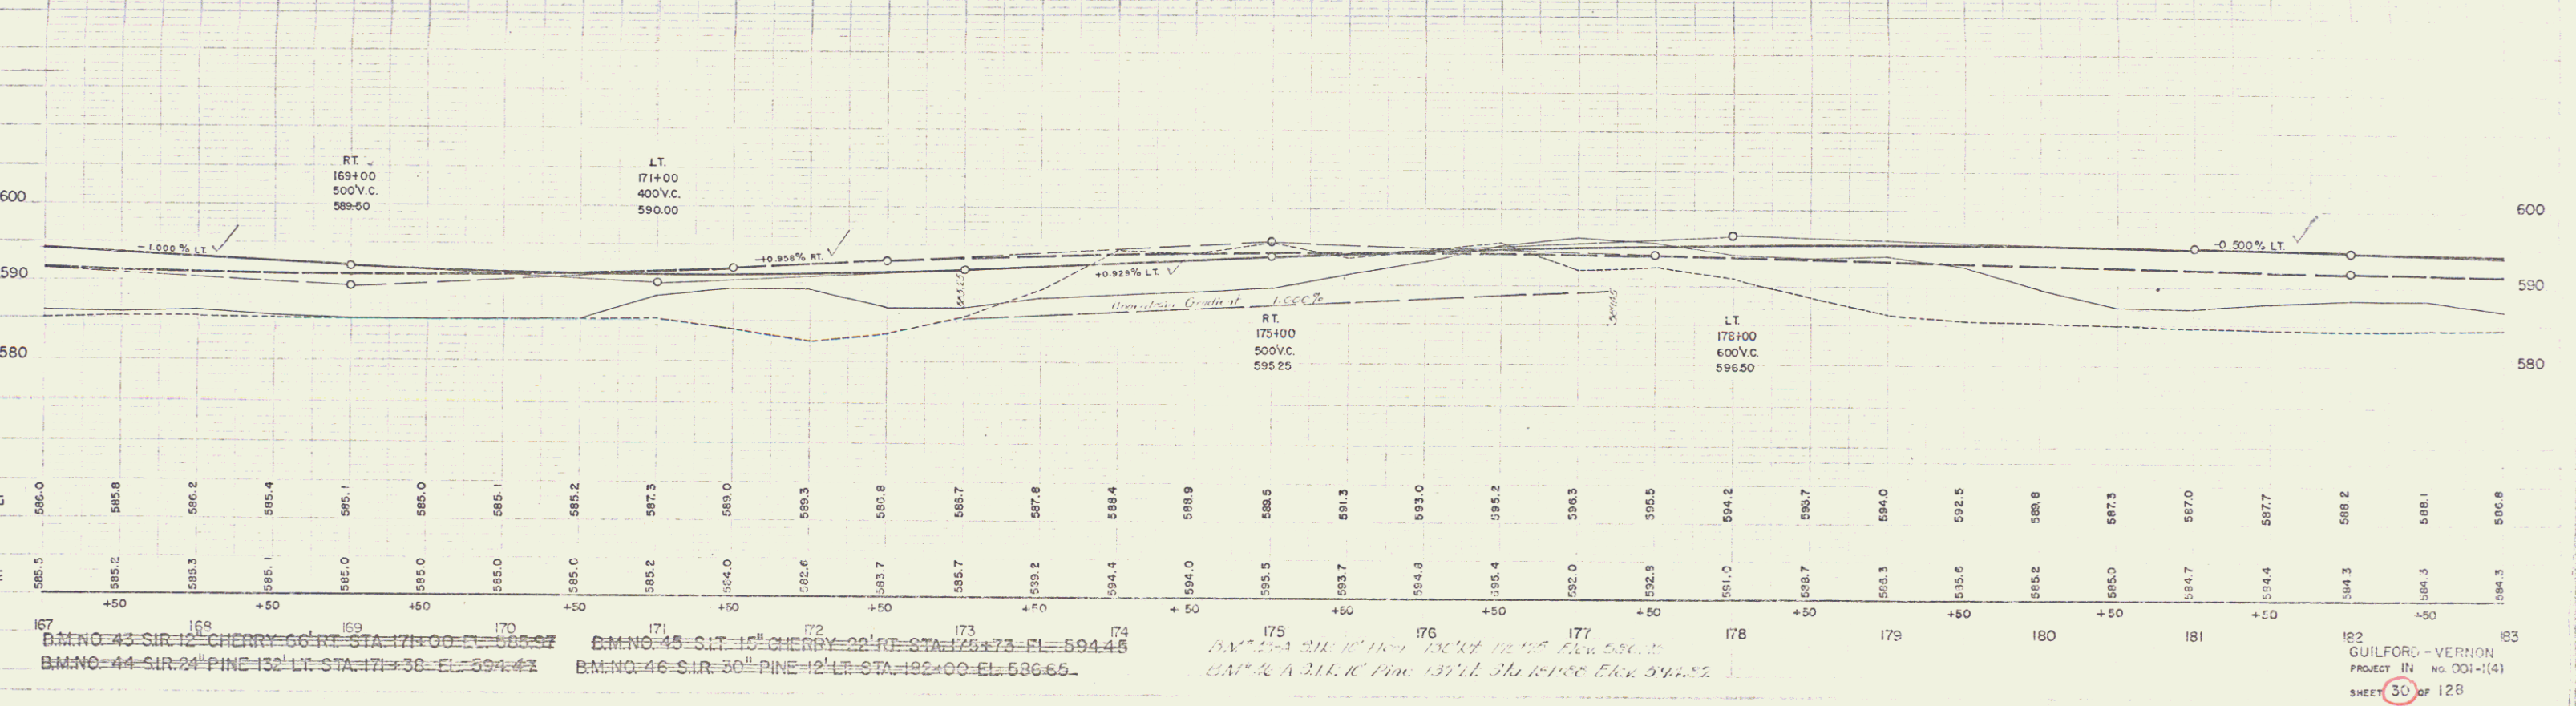

B.M. NO. 43 - S.R. 12 - CHERRY - C.C. RT - STA. 171+00 - EL. 585.97
 B.M. NO. 44 - S.R. 24 - PINE - 132' LT - STA. 171+38 - EL. 594.41
 B.M. NO. 45 - S.R. 10 - CHERRY - 22' RT - STA. 175+73 - EL. 594.48
 B.M. NO. 46 - S.R. 30 - PINE - 12' LT - STA. 182+00 - EL. 596.65
 B.M. NO. 47 - S.R. 10 - CHERRY - 22' RT - STA. 175+73 - EL. 594.48
 B.M. NO. 48 - S.R. 30 - PINE - 12' LT - STA. 182+00 - EL. 596.65
 B.M. NO. 49 - S.R. 10 - CHERRY - 22' RT - STA. 175+73 - EL. 594.48
 B.M. NO. 50 - S.R. 30 - PINE - 12' LT - STA. 182+00 - EL. 596.65

1/2" = 100'
 1/4" = 200'
 1/8" = 400'
 1/16" = 800'
 1/5444517870735015415413993718908291383072" = 272225893536750770770699685945414569153600'
 1/10889035741470030830827987437816582766144" = 544451787073501541541399371890829138307200'
 1/21778071482940061661655974875633165532288" = 1088903574147003083082798743781658276614400'
 1/43556142965880123323311949751266331064576" = 2177807148294006166165597487563316553228800'
 1/3064991081731777716716694054300618367111377454800830464" = 153249554086588885

