


INDEX OF SHEETS

1	TITLE PAGE
2	TYPICAL SECTIONS OF IMPROVEMENT - 3" MINIMUM CONCRETE PAVEMENT, ITEM 381-B
3	QUANTITY SHEET - ITEMS
4	QUANTITY SHEET - DRAINAGE
5-6	GRADE SHEETS
7-10	EARTHWORK SHEETS
11-16	PLAN AND PROFILE SHEETS
17	STANDARD STRUCTURE SHEET RS 56-1 BANKING TABLES
18	STANDARD STRUCTURE SHEET RS 56-2 DROP INLETS
19	STANDARD STRUCTURE SHEET RS 56-3 MARKERS
20	STANDARD STRUCTURE SHEET RS 56-4 DRAINAGE
21	STANDARD STRUCTURE SHEET RS 56-5 TYPICAL SLOPE GRADING
22	STANDARD STRUCTURE SHEET RS 56-6 DRILLING AND BLASTING OF SOLID ROCK SUBGRADE
23	STANDARD STRUCTURE SHEET RS 56-7 THREE CABLE GUARD RAIL
24	STANDARD STRUCTURE SHEET RS 56-8 BARRICADES, SIGNS AND LIGHTS
25	STANDARD STRUCTURE SHEET RS 56-9 STEEL BEAM GUARD RAIL
26	STANDARD STRUCTURE SHEET RS 56-10 PRECAST REINFORCED CONCRETE PIPE DROP INLETS AND CATCH BASINS
27	STANDARD STRUCTURE SHEET RS 56-11 PROPERTY LINE FENCE
28	STANDARD BRIDGE SHEET BR 20-15 PLAN AND ELEVATION
29	BRIDGE SHEET-UNDERPASS AT 222+37 DETAILS OF ABUTMENT #1
30	BRIDGE SHEET-UNDERPASS AT 222+37 DETAILS OF ABUTMENT #2
31	BRIDGE SHEET-UNDERPASS AT 222+37 DETAILS OF PIER #1
32	BRIDGE SHEET-UNDERPASS AT 222+37 DETAILS OF PIER #2
33	BRIDGE SHEET-UNDERPASS AT 222+37 DETAILS OF PIER #3
34	BRIDGE SHEET-UNDERPASS AT 222+37 DETAILS OF SPAN #1
35	BRIDGE SHEET-UNDERPASS AT 222+37 DETAILS OF SPAN #2 AND #3
36	BRIDGE SHEET-UNDERPASS AT 222+37 DETAILS OF SPAN #4
37	BRIDGE SHEET-UNDERPASS AT 222+37 DETAILS OF END POSTS AND RAILING
38	BRIDGE SHEET-UNDERPASS AT 222+37 REINFORCING STEEL SCHEDULE
39	BRIDGE SHEET-OVERPASS AT 286+50 PLAN AND ELEVATION
40	BRIDGE SHEET-OVERPASS AT 286+50 SUPERSTRUCTURE
41	BRIDGE SHEET-OVERPASS AT 286+50 SUPERSTRUCTURE DETAILS
42	BRIDGE SHEET-OVERPASS AT 286+50 END POSTS DETAILS (SOUTH BOUND)
43	BRIDGE SHEET-OVERPASS AT 286+50 DETAILS OF ABUTMENTS #1 AND #2
44	BRIDGE SHEET-OVERPASS AT 286+50 REINFORCING STEEL SCHEDULE
45	SUMMARY OF TRAFFIC SIGNS AND GENERAL NOTES
46	TRAFFIC SIGN LOCATION PLAN
47	EXTRUDED ALUMINUM PANEL GUIDE SIGNS - ASSEMBLY AND CONSTRUCTION DETAILS
48	TRAFFIC SIGN DESIGN AND INSTALLATION DETAILS
49	TRAFFIC SIGN DESIGN AND INSTALLATION DETAILS
50	CROSS SECTIONS FOR ROUTE 5 (263+50 - 285+50 LEFT)
51-52	CROSS SECTIONS OVERPASS 222+37
53-54	CROSS SECTIONS OVERPASS 286+50

STATE OF VERMONT
DEPARTMENT OF HIGHWAYS
PROPOSED IMPROVEMENT
INTERSTATE PROJECT
TOWNS OF VERNON - GUILFORD
COUNTY OF WINDHAM
BERNARDSTON, MASS.-BRATTLEBORO, VT. ROAD
Interstate Route I 91 Pin # 99R037

BEGINNING AT A POINT 3.989 MILES NORTH OF THE MASSACHUSETTS - VERMONT
STATE LINE AND EXTENDING NORTHERLY 1.890 MILES.
LENGTH OF ROADWAY 9077.9 FEET = 1.871 MILES.
LENGTH OF BRIDGE 99.0 FEET = 0.019 MILES.
LENGTH OF PROJECT 9,076.9 FEET = 1.890 MILES.
DESIGN DESIGNATION
ADT (1955) 2200
ADT (1975) 6640
DHW (1975) 1000
D 58%
T 75%

LIMITED ACCESS PURCHASE,
NON LIMITED ACCESS PURCHASE,
AS BUILT RIGHT OF WAY FENCE.

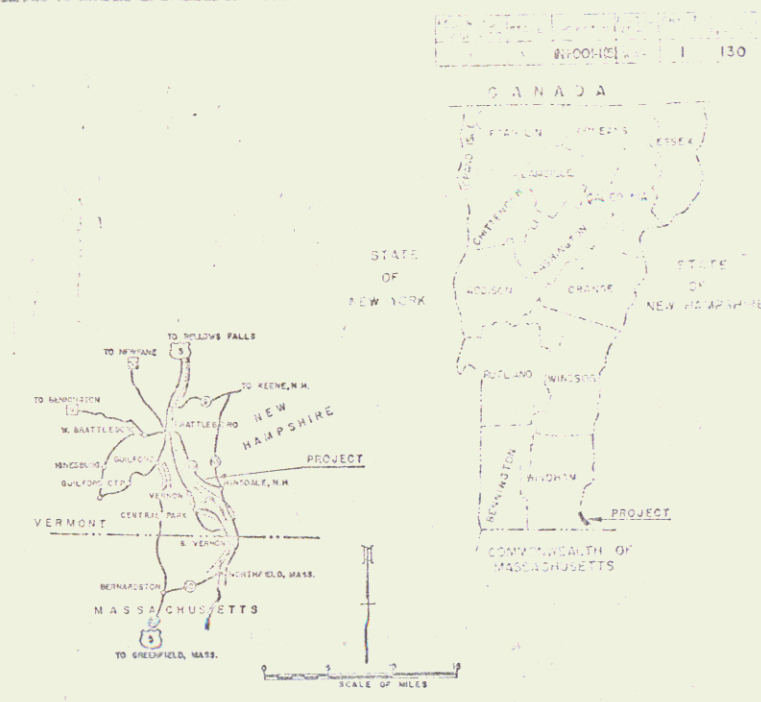

RIGHT-OF-WAY
and Construction Plans



CONVENTIONAL

COUNTY LINE	
TOWN LINE	
STATE LINE	
STATE WALK	
UNFENCED PROPERTY	
GRADE RAIL	
TRAVELLED WAY	
KNOBROAD	
RETAINING WALL	
CENTER LINE	
SURVEY LINE	
OBSCURE	
DRIP INLET	
TRUCKLEY POLE	
WATER POLE	
TELEPHONE POLE	
WIRE	
POST	

GROUND ELEVATION
SATIN 1/2 LINE

SCALES

TITLE	1" = 500'
TYPICAL	1" = 5'
PLAN	1" = 50'
PROFILE	1" = 10'
CROSS-SECTIONS	1" = 5'

POOR ORIGINAL COPY

THREE PLANS ARE SUBMITTED TO THE REVIEWER AS MAY BE REQUIRED BY THE BUREAU OF PUBLIC ROADS. THE REVIEWER IS TO BE CARRIED ON IN ACCORDANCE WITH THE PLANS AND THE STANDARD SPECIFICATIONS FOR HIGHWAY AND BRIDGE CONSTRUCTION. THE REVIEWER IS TO BE CARRIED ON IN ACCORDANCE WITH THE PLANS AND THE STANDARD SPECIFICATIONS FOR HIGHWAY AND BRIDGE CONSTRUCTION. THE REVIEWER IS TO BE CARRIED ON IN ACCORDANCE WITH THE PLANS AND THE STANDARD SPECIFICATIONS FOR HIGHWAY AND BRIDGE CONSTRUCTION.

NOTES: ANY FURTHER INFORMATION CONCERNING THIS PROJECT SHOULD BE REFERRED TO THE BUREAU OF PUBLIC ROADS. THE REVIEWER IS TO BE CARRIED ON IN ACCORDANCE WITH THE PLANS AND THE STANDARD SPECIFICATIONS FOR HIGHWAY AND BRIDGE CONSTRUCTION.

REMARKS OF COMMISSIONER
BUREAU OF PUBLIC ROADS
MP 3.91-5.88

APPROVED	DESIGNED	CHECKED	DATE	APPROVED	DATE	APPROVED	DATE
			APRIL 10, 1957		APRIL 24, 1957		APRIL 24, 1957

Project No. 99-1-101

STEARNS R. JENKINS