
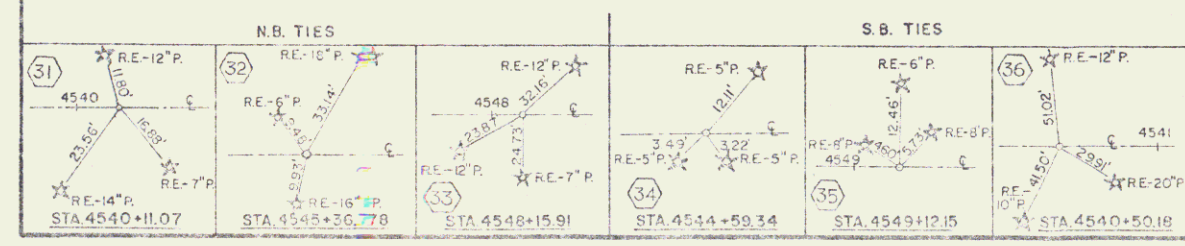



PROPERTY LINE FENCE ITEM 503-II MOD.	DRILLING & BLASTING OF SOLID ROCK SUBGRADE ITEM 115	ADDITIONAL 12" SURBASE OF SAND ITEM 202	* THREE CABLE GUARD RAIL WITH LIGHT STEEL POSTS ITEM 539
NB 4536+00-4550+00 RT SB 4536+00-4550+00 LT	NB 4541+30-4550+188 SB 4541+30-4550+188	NB 4536+00-4541+00 SB 4536+00-4541+00	NB 4540+00-4548+00 RT SB 4540+00-4548+00 LT

CONSTRUCT PROPERTY LINE FENCE, ITEM 503-II, MOD.
PRIOR TO COMMENCEMENT OF OTHER WORK IN THIS AREA.

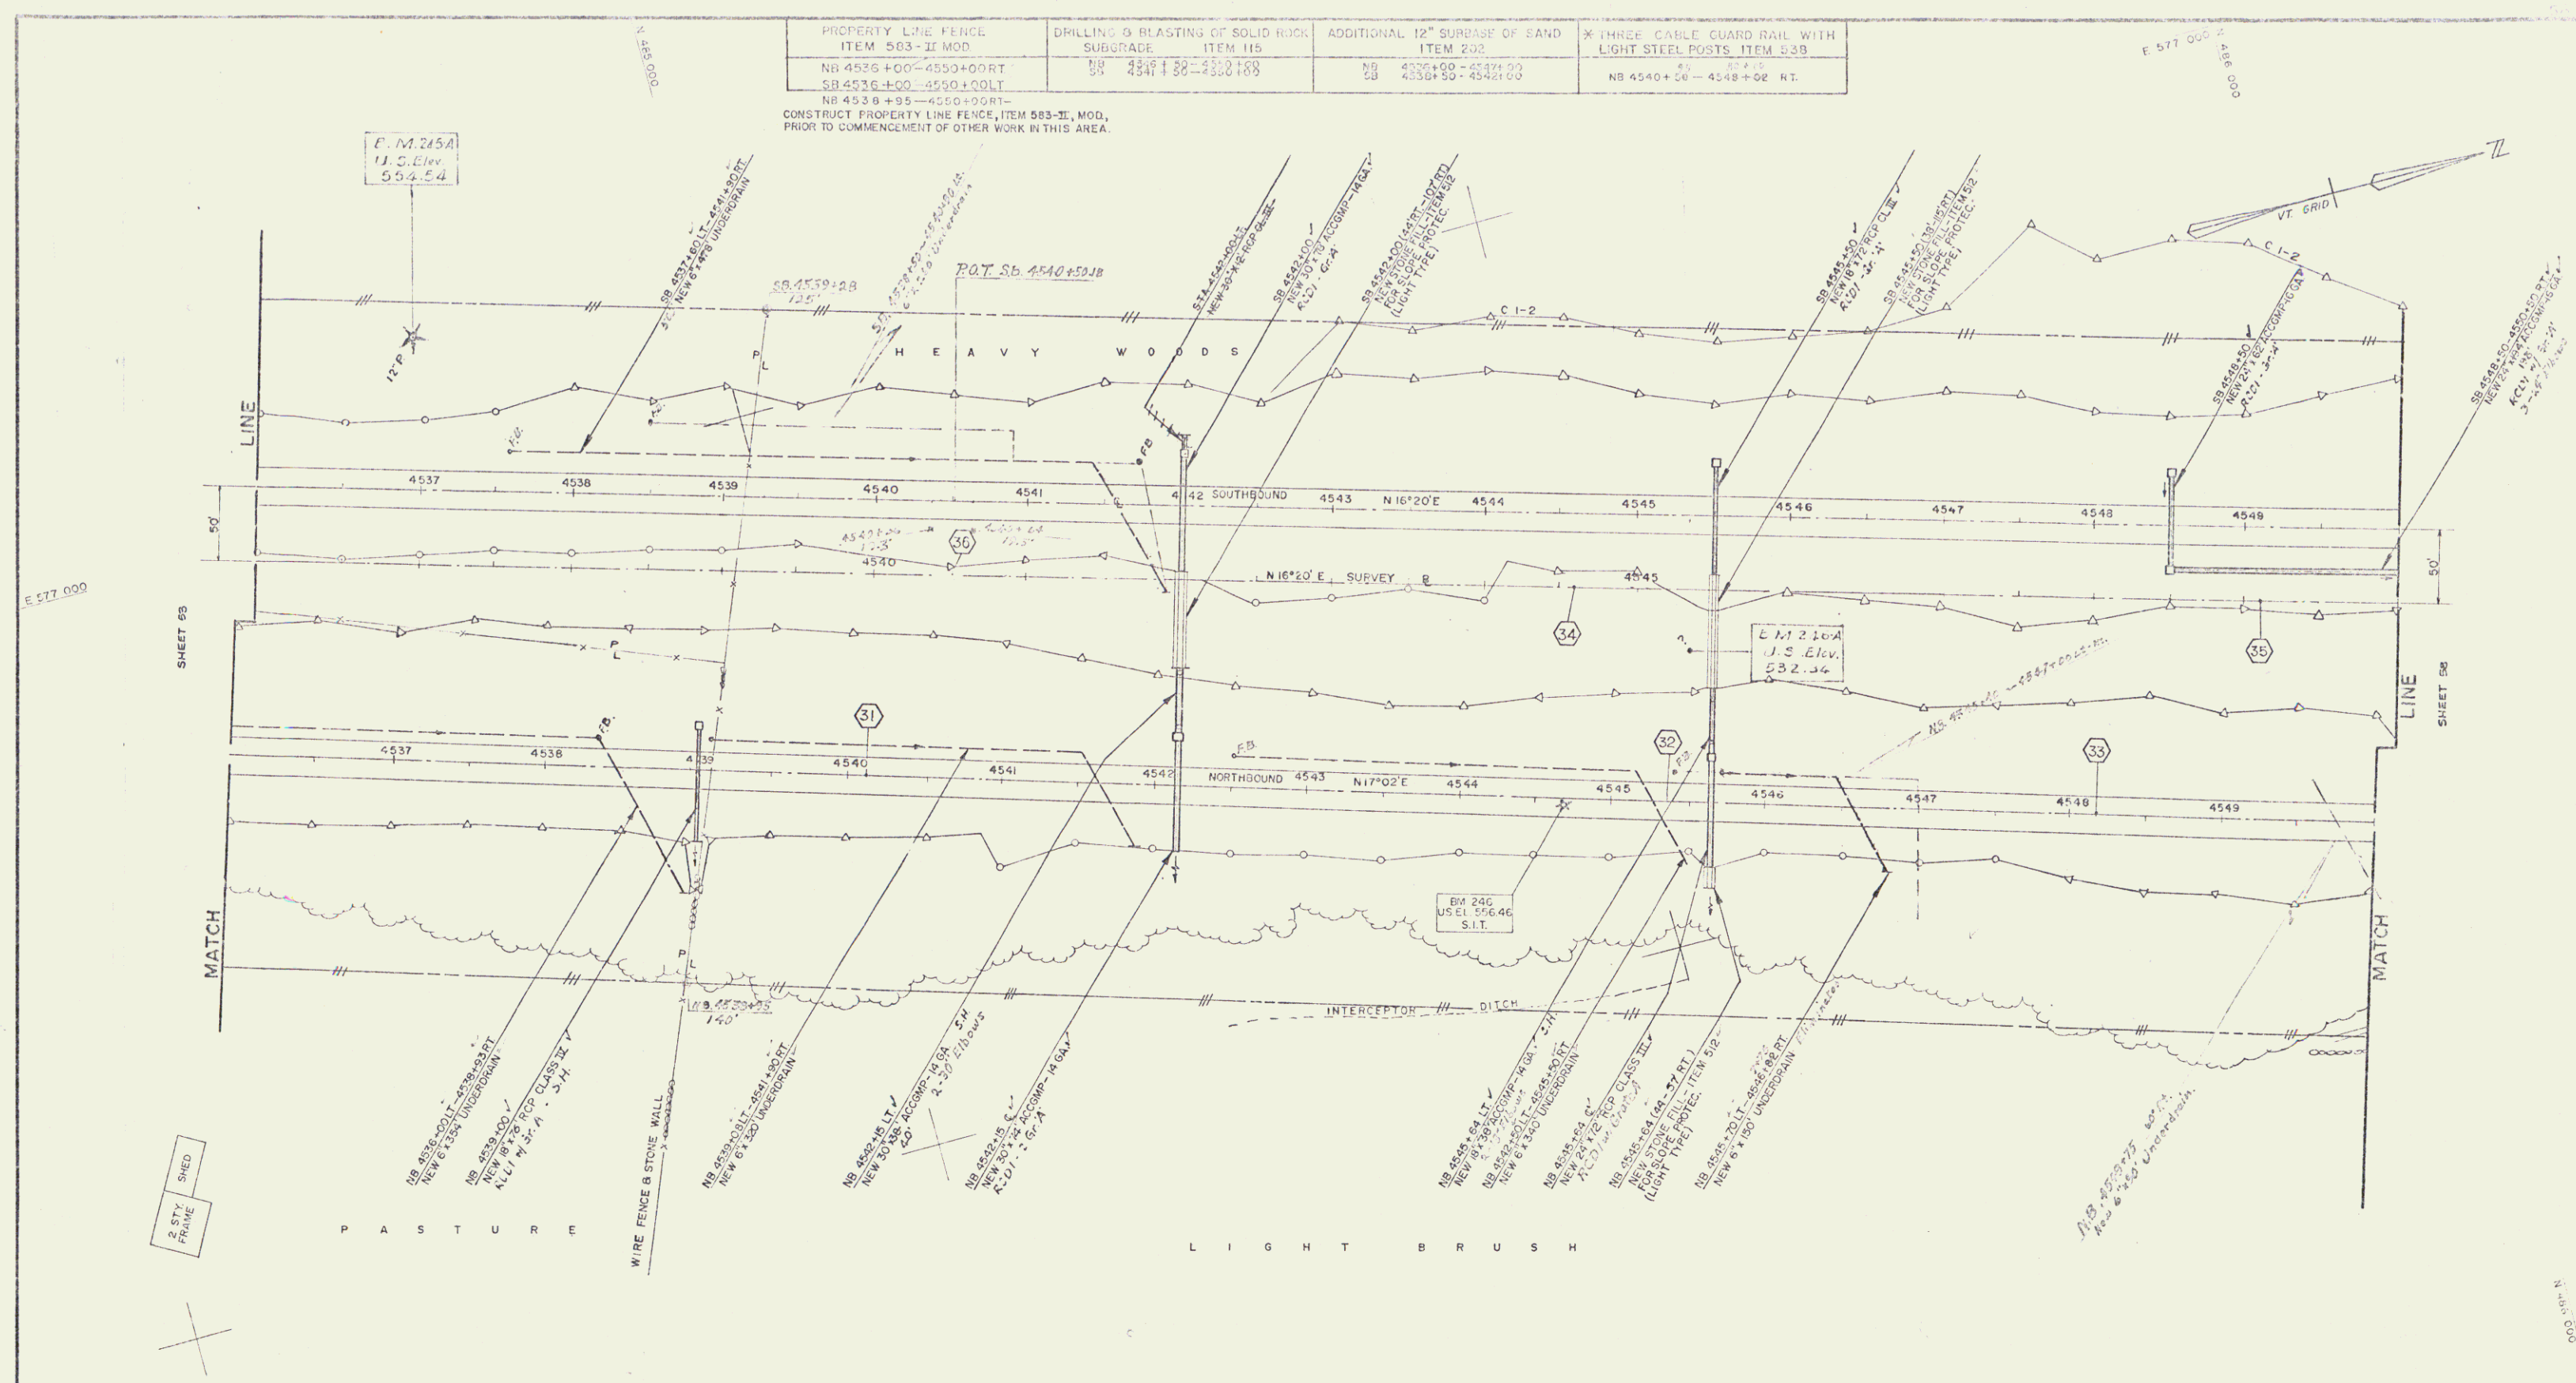

*STAGE 2 CONSTRUCTION

CONTROL OF ACCESS IS
COMPLETE ON THIS SHEET

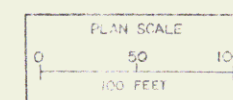

THETFORD-FAIRLEE
CONTRACT _____ STAGE 2 CONSTRUCTION
STA 4536+00 TO STA 4550+00
SURVEYED BY W.S.M. CHECKED BY E.T.
DRAWN BY H.P. IN CHARGE
PROJECT I SH-2 (1) SHEET 56 OF 62
(24) 34 OF 160