


DRILLING & BLASTING OF SOLID ROCK SUBGRADE	ITEM 115	ADDITIONAL 12" SUBBASE OF SAND	ITEM 202	* THREE CABLE GUARD RAIL WITH LT. STEEL POSTS	ITEM 538	PROPERTY LINE FENCE	ITEM 583-II MOD.
SB 4595+00 - 4605+00 LT.		NB 4595+00 - 4605+50		NB 4609+20 - 4610+00 RT.		NB 4595+00 - 4610+00 RT.	
SB 4605+50 - 4610+00 RT.				SB 4601+20 - 4605+02 RT.		SB 4595+00 - 4610+00 LT.	

CONSTRUCT PROPERTY LINE FENCE ITEM 583-II MOD. PRIOR TO COMMENCEMENT OF OTHER WORK IN THIS AREA.

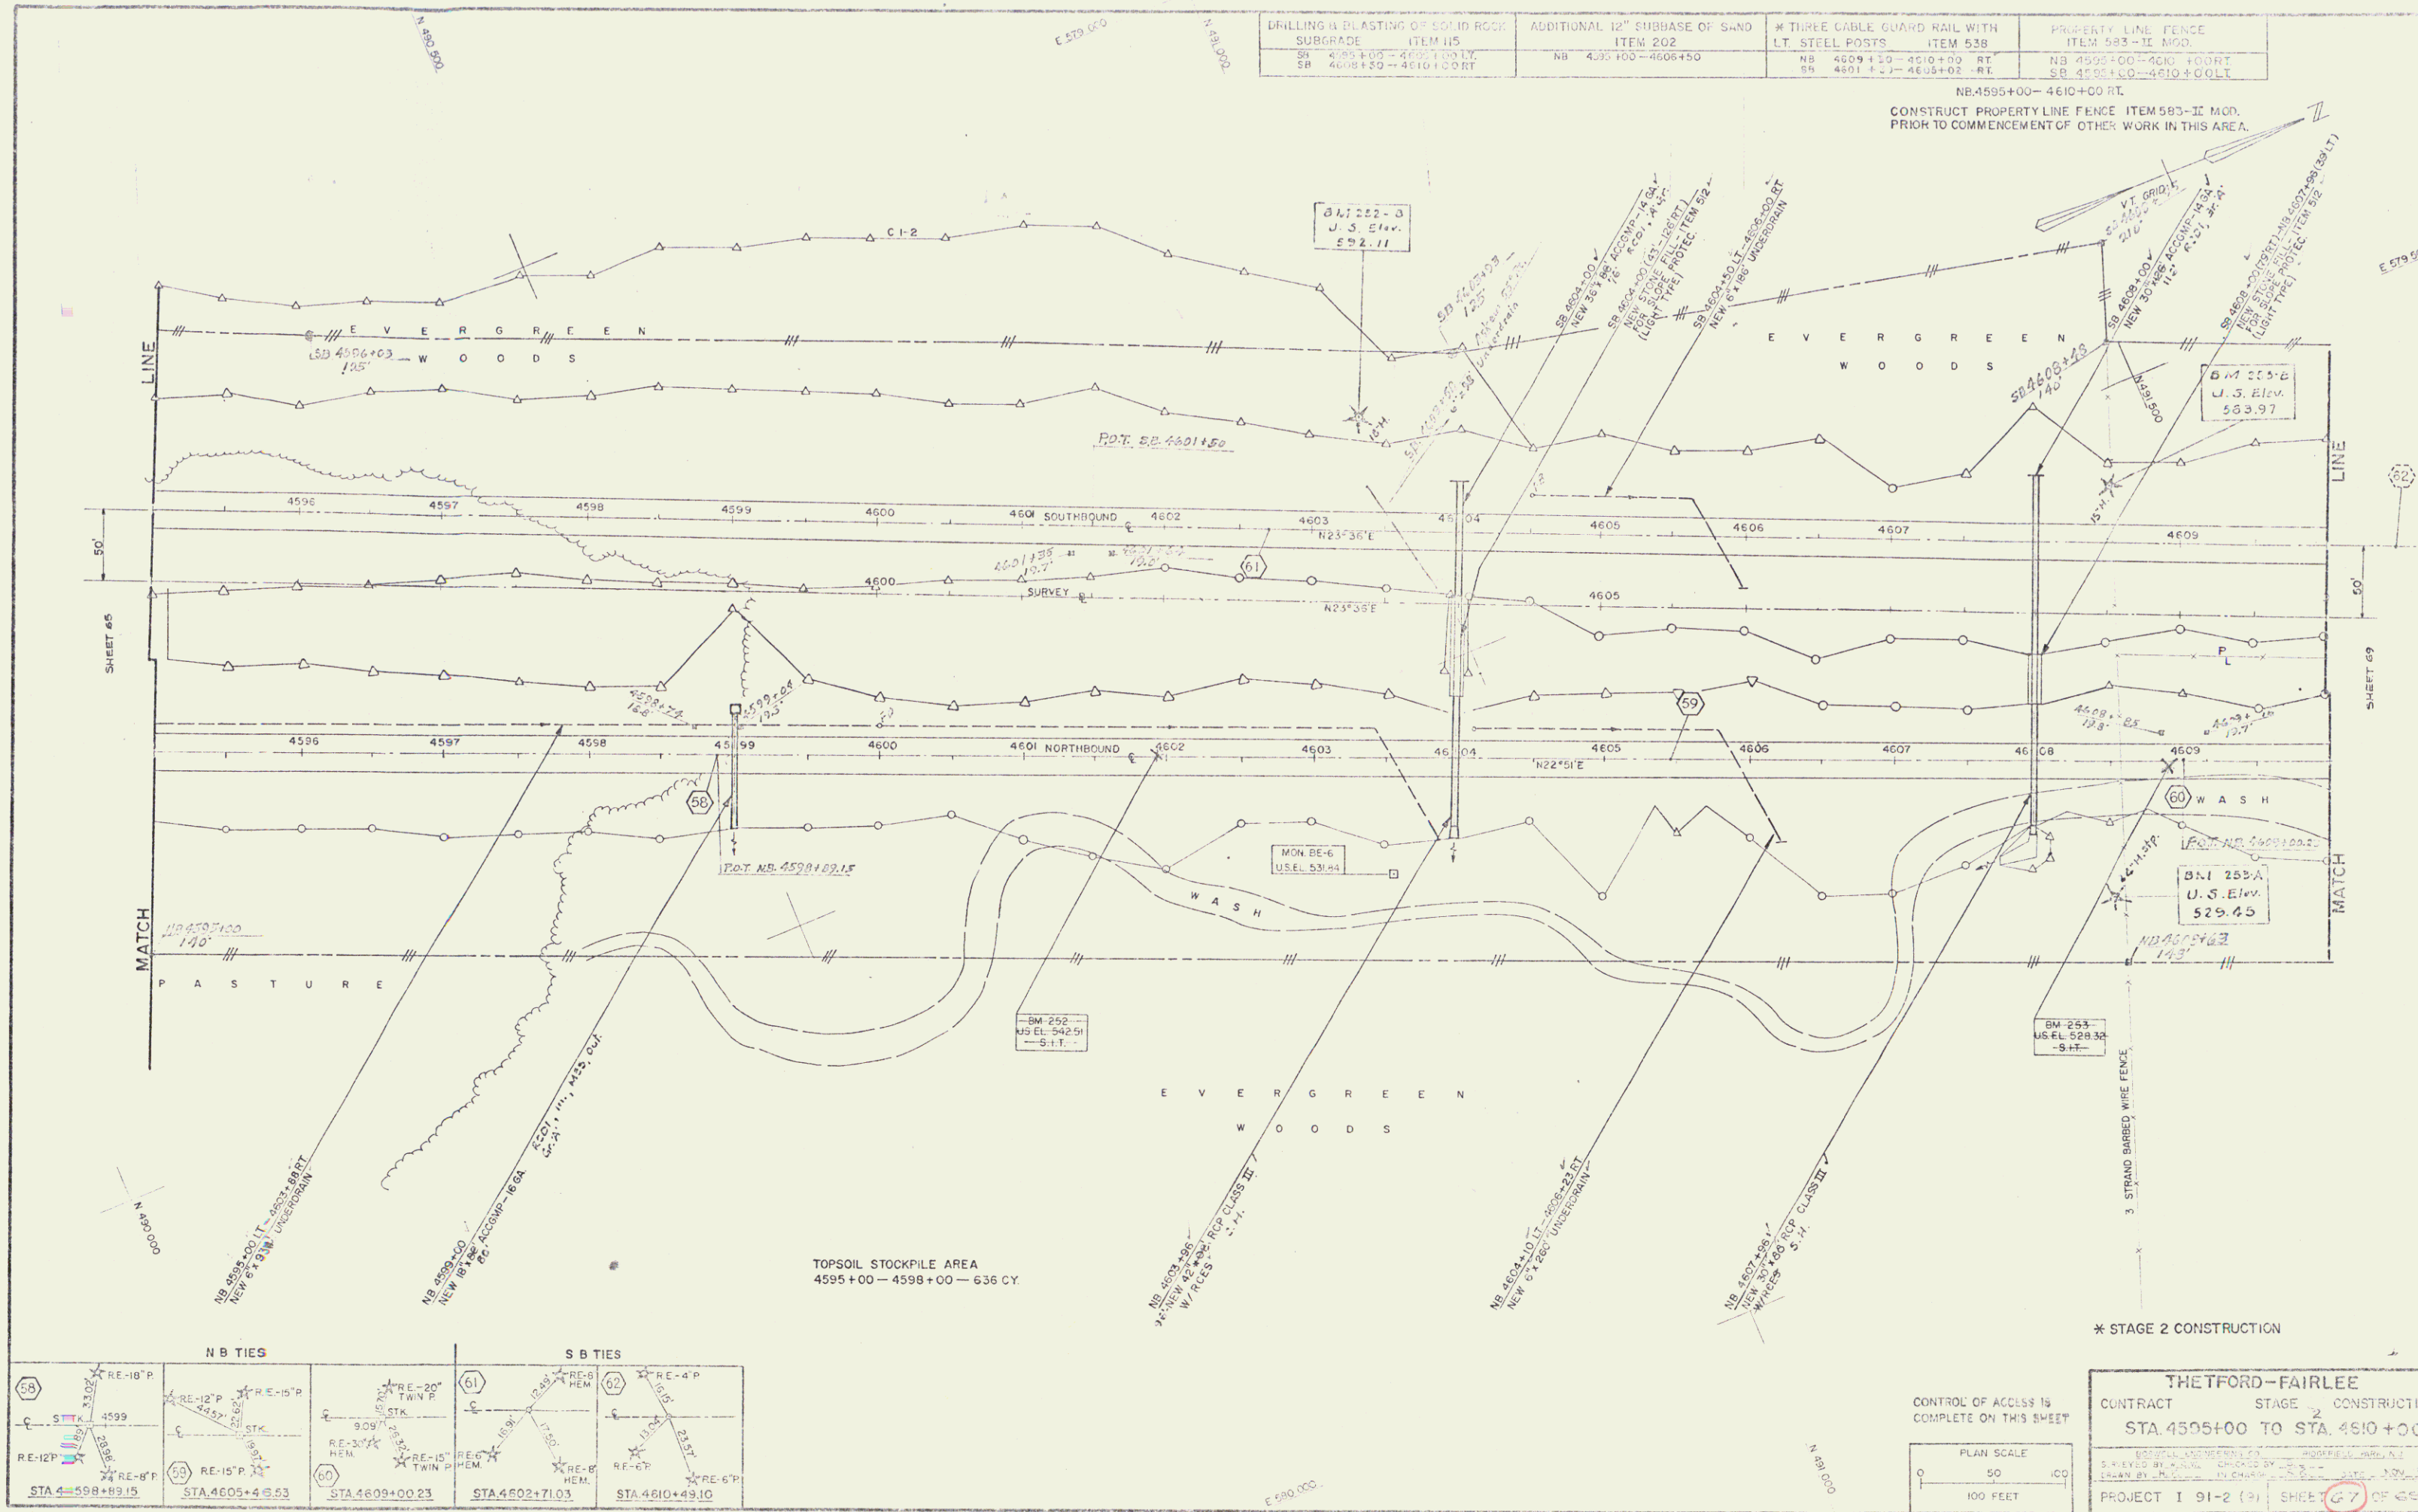

NB TIES		SB TIES	
RE-12P STA 4598+89.15	RE-12P STA 4605+43.53	RE-12P STA 4609+00.23	RE-12P STA 4602+71.03
RE-12P STA 4598+89.15	RE-12P STA 4605+43.53	RE-12P STA 4609+00.23	RE-12P STA 4602+71.03

CONTROL OF ACCESS IS COMPLETE ON THIS SHEET

THETFORD-FAIRLEE

CONTRACT

STAGE 2 CONSTRUCTION

STA 4595+00 TO STA 4610+00

PROJECT I 91-2 (3) SHEET 27 OF 42

42 of 160