


State of Vermont to Harrie H. & Beatrice J. Moore
QCD 12/11/74 BK 44 Pg 448
easement of ingress & egress
in common (25' wide)

Sta 5319+67 to 5338+94
State of VT to Fletcher F. & Margaret M. Gove
BK 44 Pg 345, 7
Same as above from sta. 5330+99 to 5338+94

See note on
previous sheet.

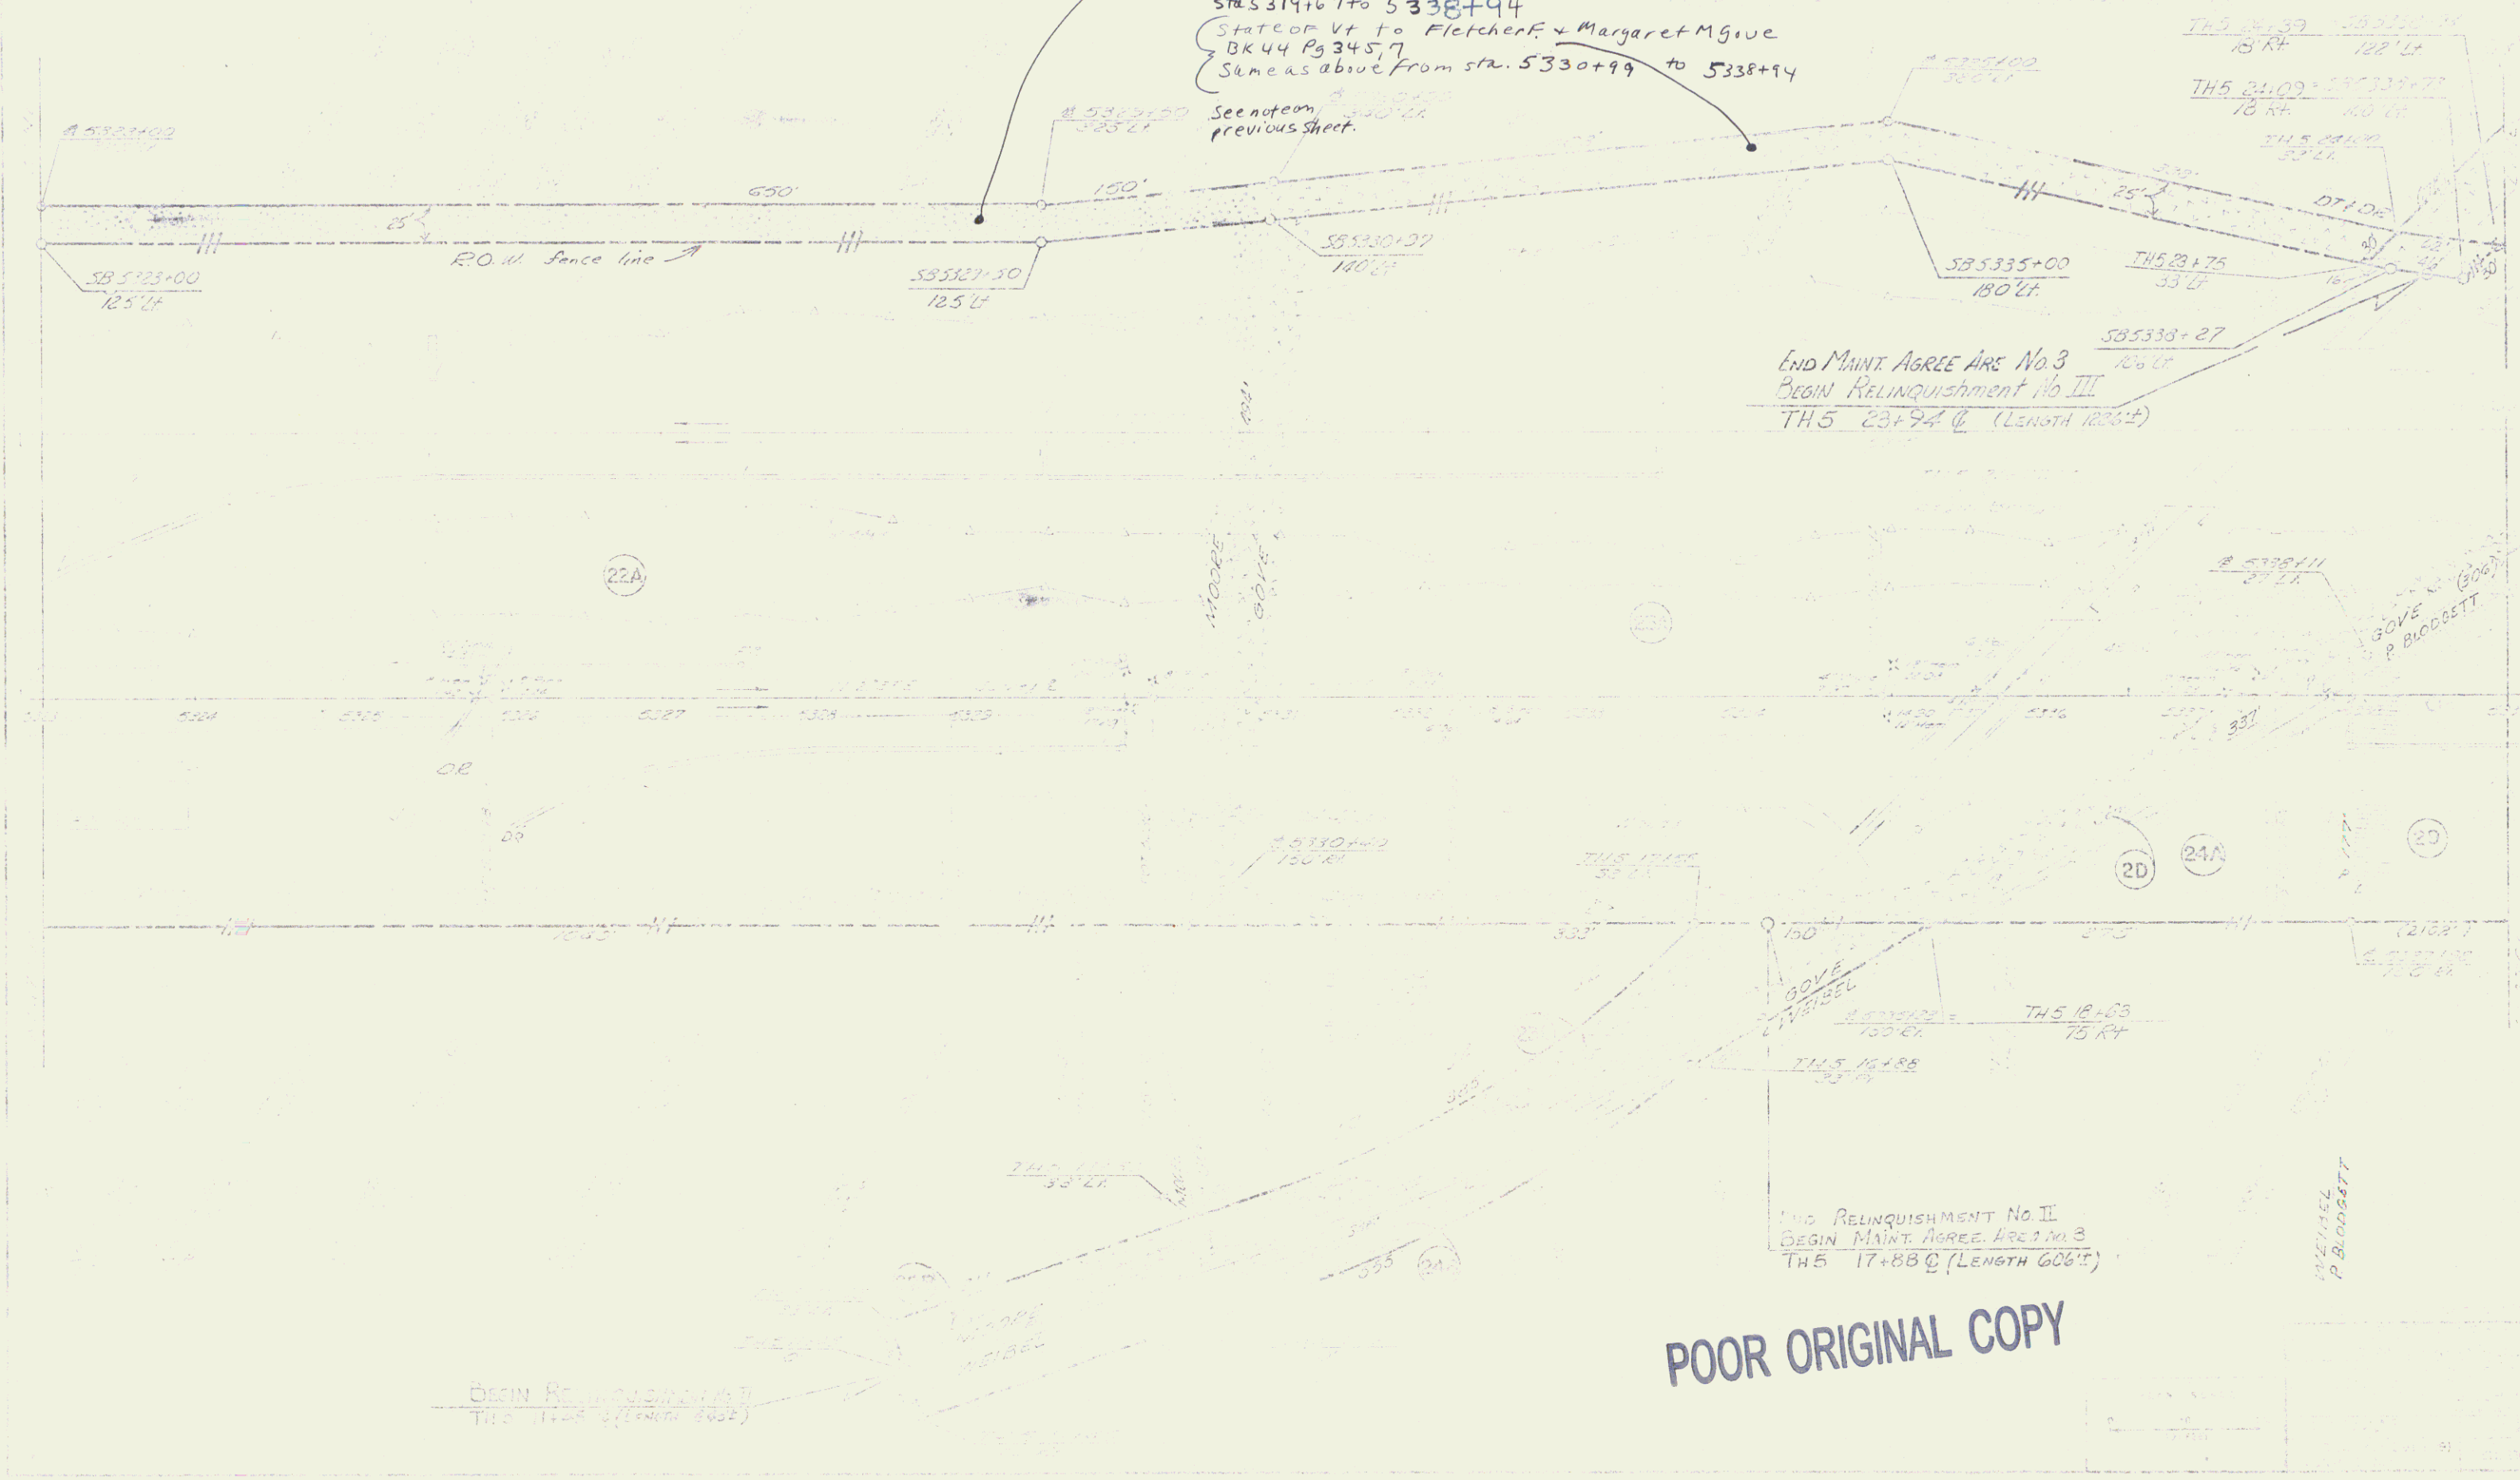

POOR ORIGINAL COPY