


State of VT to Frank N. Brock
QCD 12/11/74 Bk 56 Pg 183,5
Easement of ingress + egress
in Common 5401+17 to 5436+59

State to Putnam W. & Marilyn G. Blodgett
QCD conveying an easement of ingress &
egress over a frontage road, to be used in common
12/11/74 in Book 56 Pages 180-182

see Const Cont 2
Sheets 36 & 36A

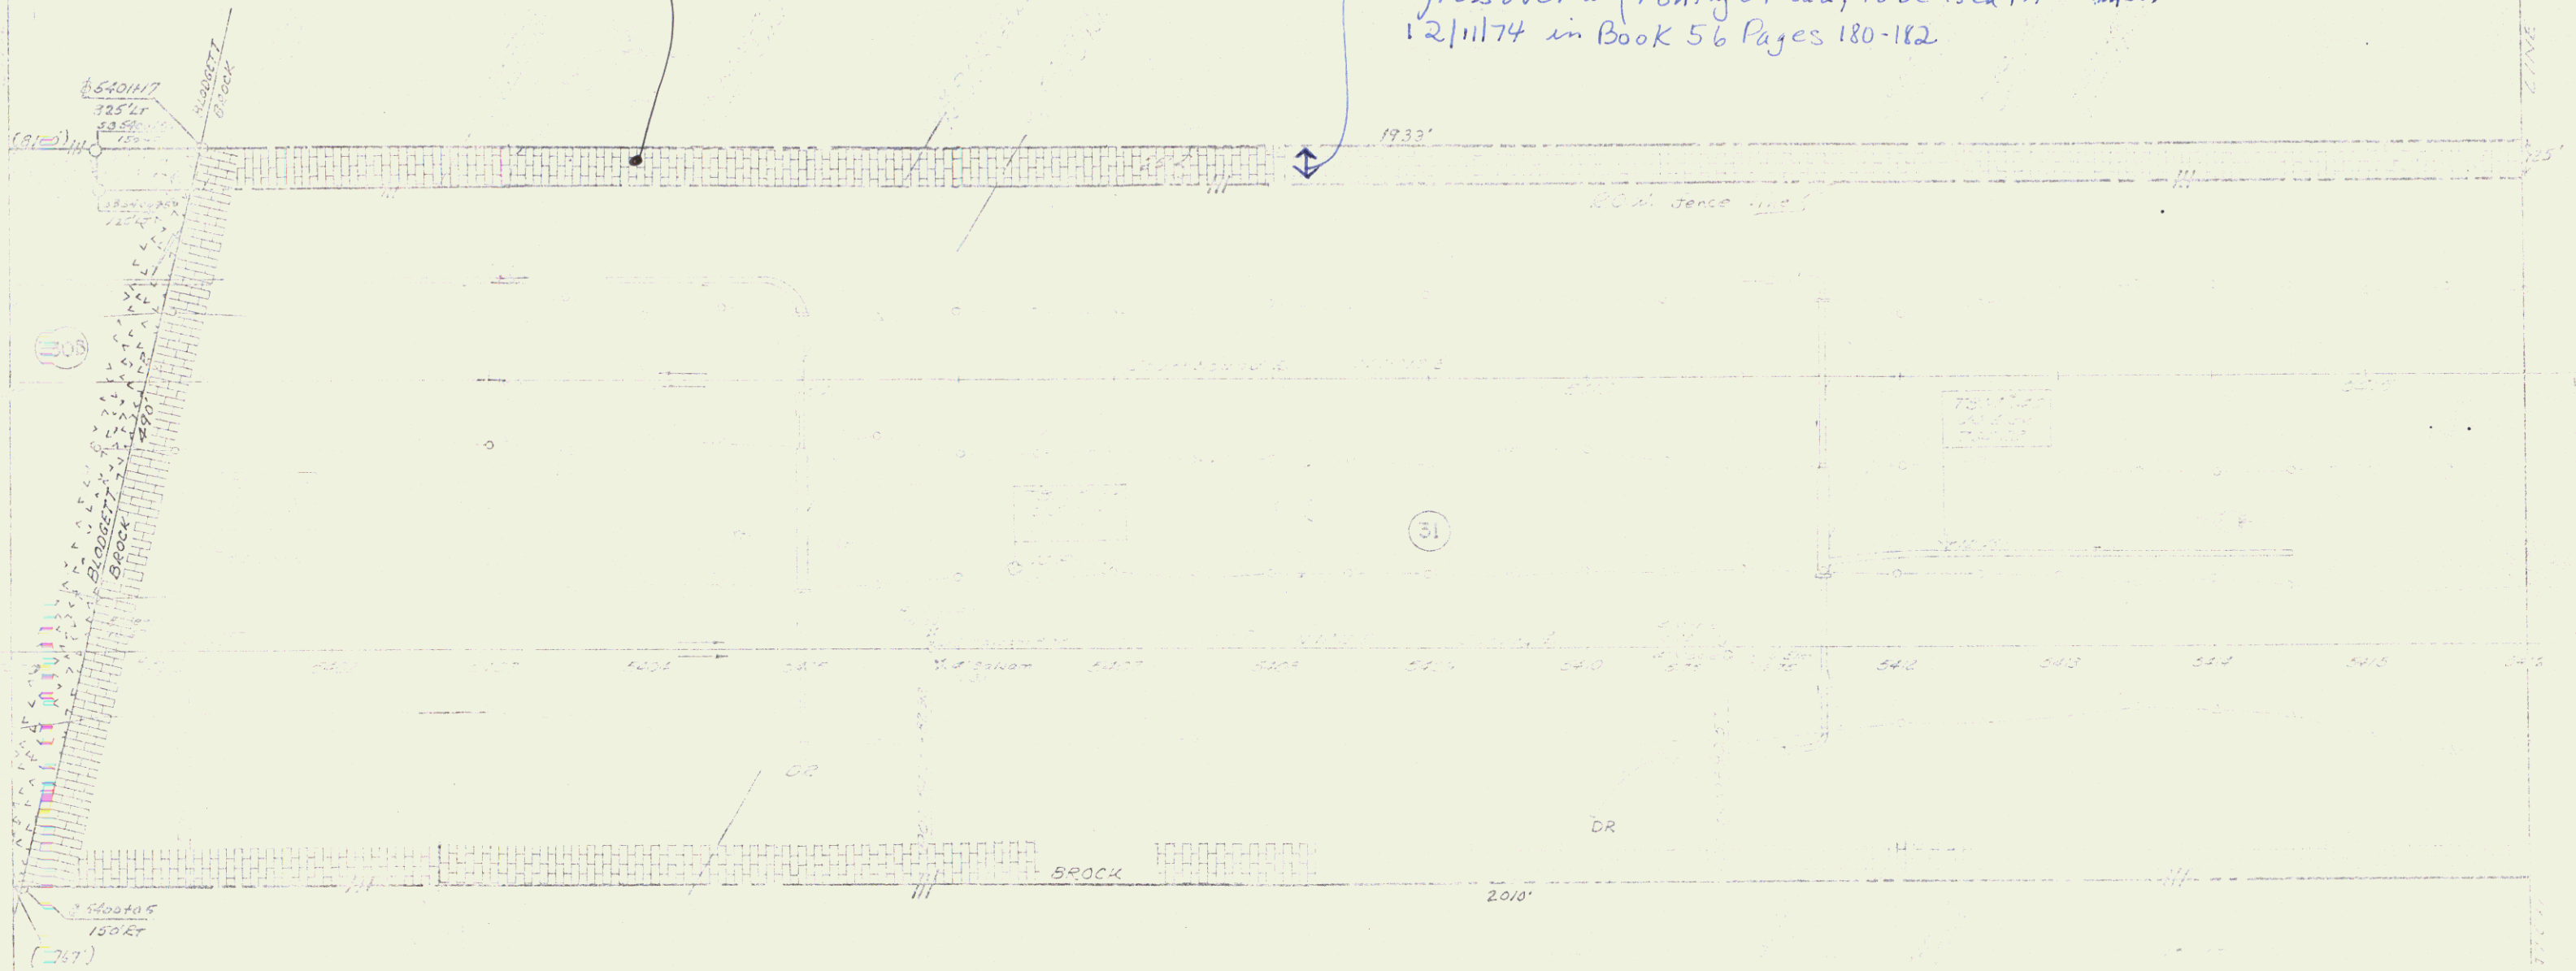

POOR ORIGINAL COPY

57 150

2 Q.C.D

R.O.W

43