


BY JULY 2001
1/18/78 IN BOOK
see sheet 72A
POM 80-1 1/2 7A (S)



FOUR ORIGINAL COPY

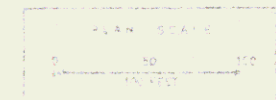

SHEET 72A	
SHELDON-NEWBURY	
72	150