


PLAN
 1" = 100'
 1" = 100'

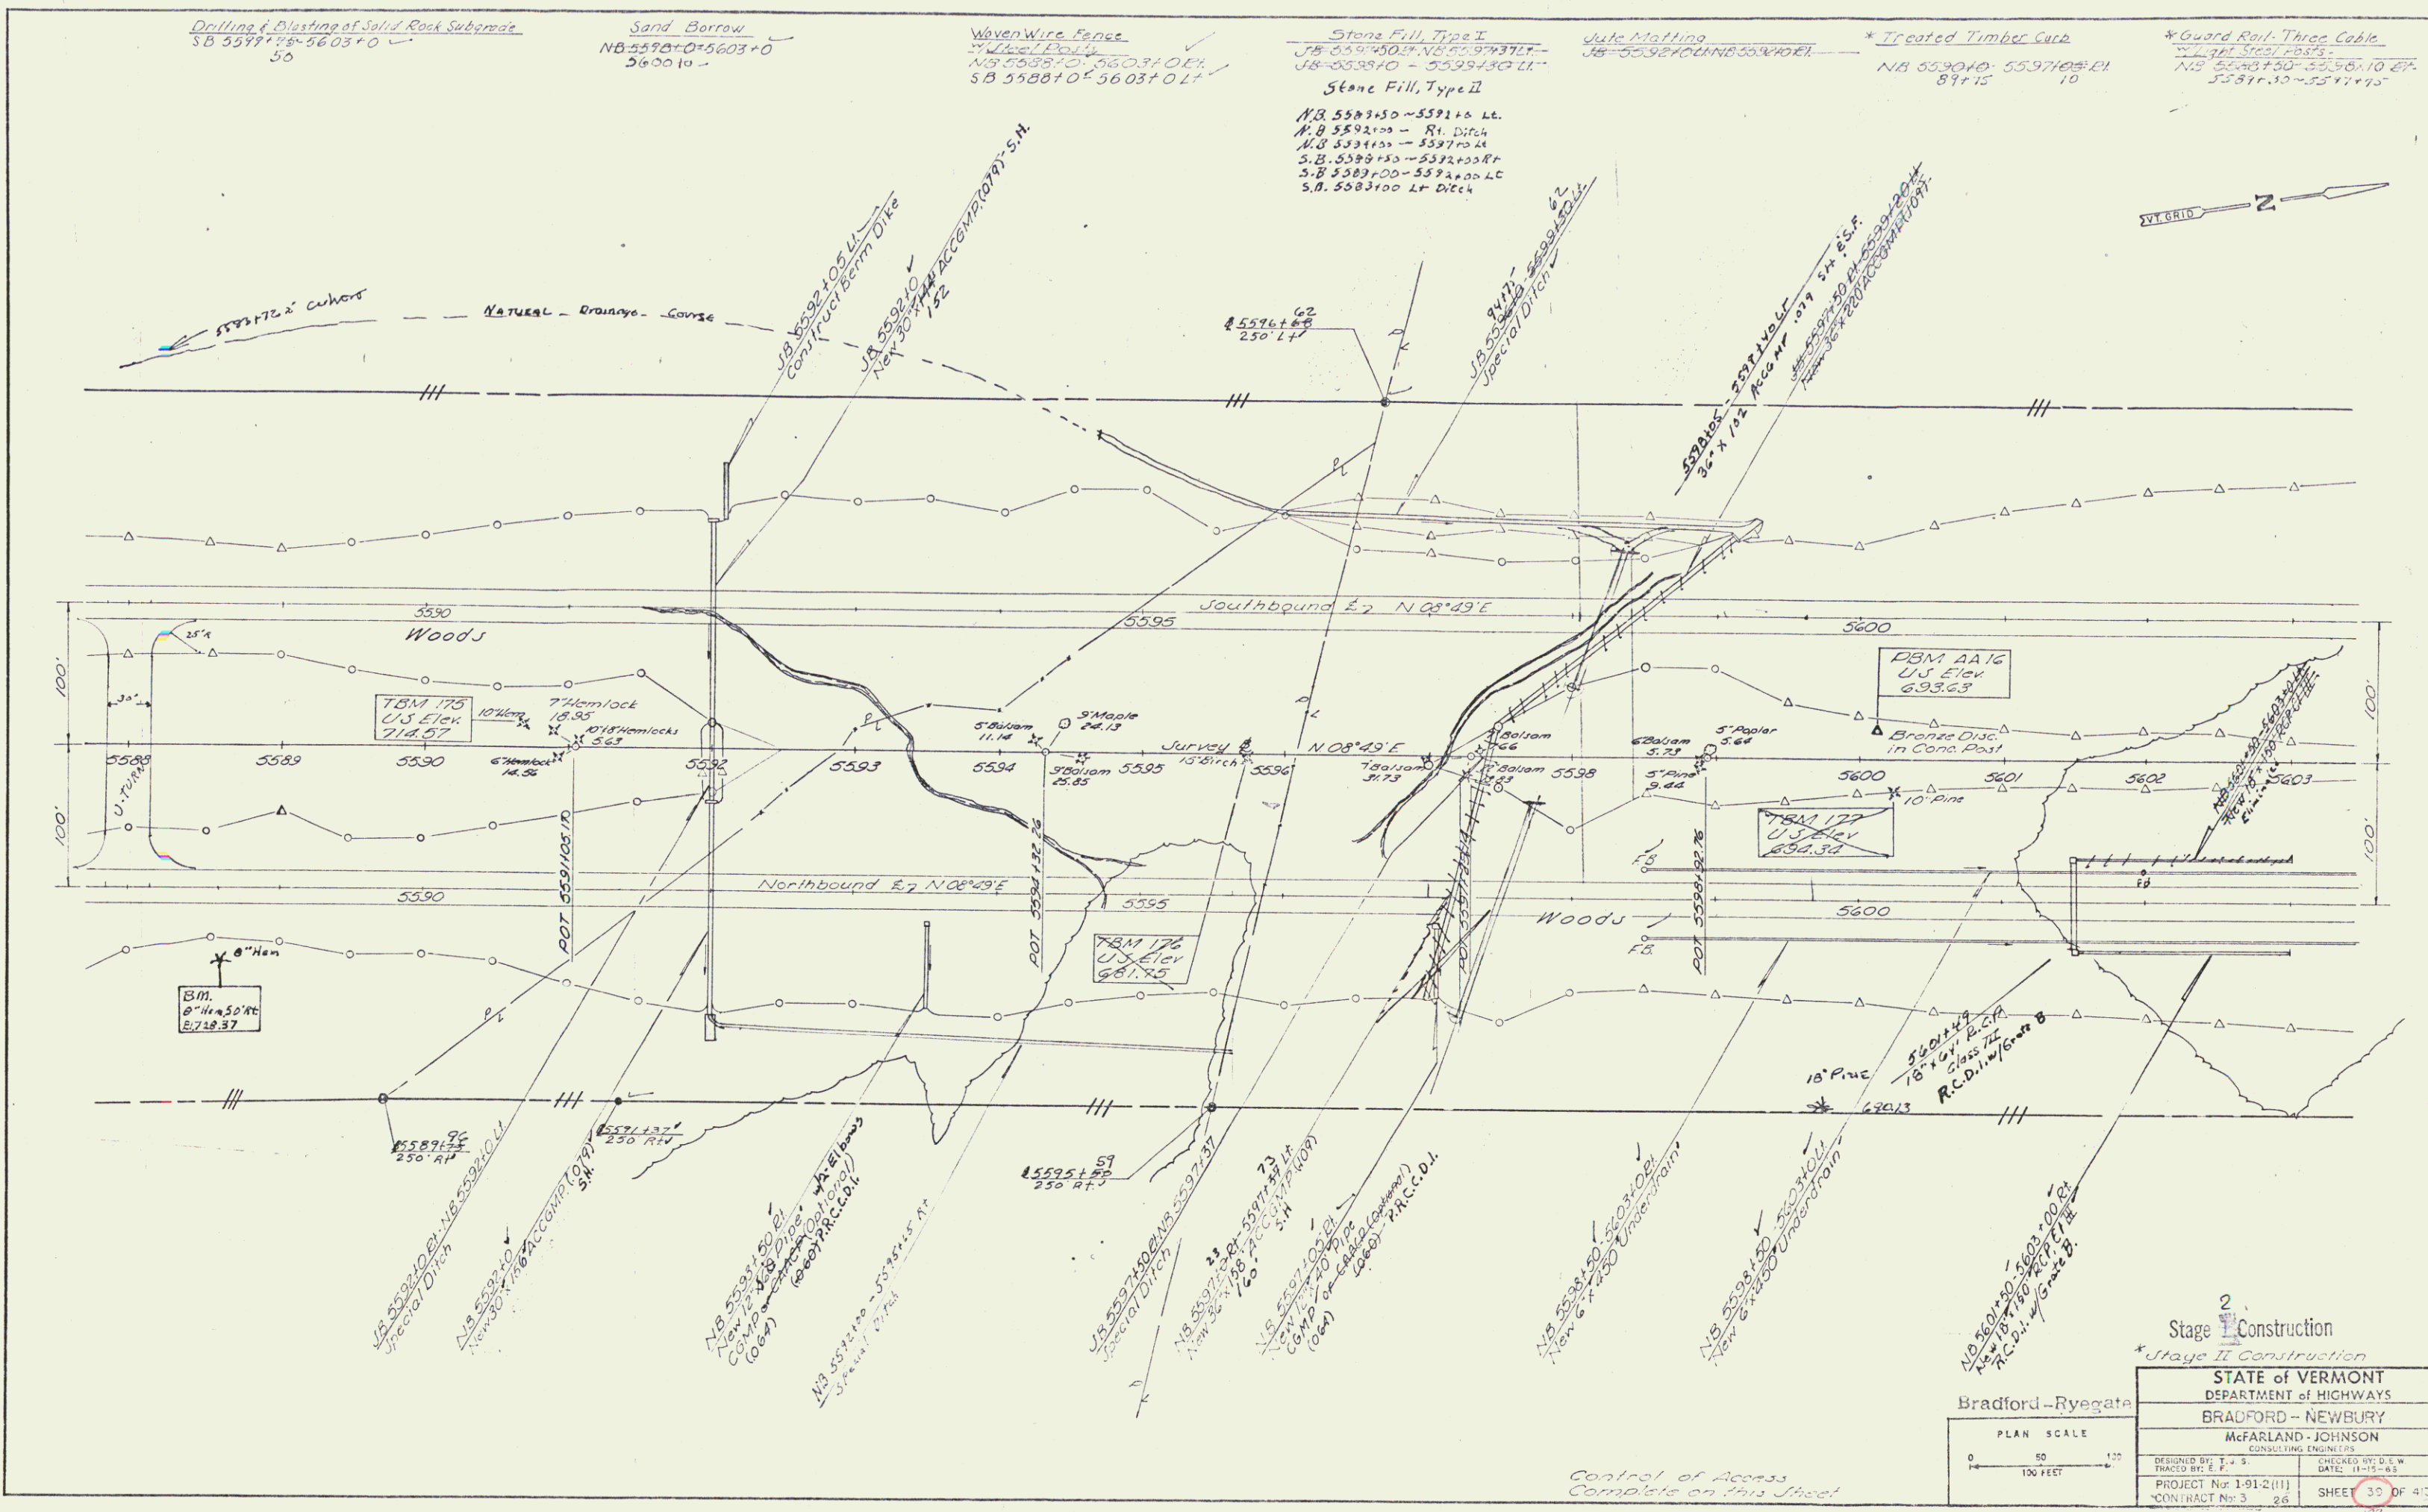

Stage 2 Construction
 * Stage II Construction

STATE OF VERMONT
 DEPARTMENT OF HIGHWAYS
 BRADFORD - NEWBURY
 McFARLAND - JOHNSON
 CONSULTING ENGINEERS

DESIGNED BY: J. J. S.
 CHECKED BY: D. E. W.
 DATE: 11-15-85

PROJECT No: 1-912(11)
 CONTRACT No: 3 26

SHEET 30 OF 43

133 430

Control of Access
 Complete on this sheet

R.O.W/Const. 118