


Curve Data
J.B.
Δ = 03°10'00"
D = 00°15'14"
P = 22918.32'
T = 233.49
L = 1266.67
E = 12.75'
Normal Crown

Drilling & Blasting
S.B. 5693+00-5693+20
N.B. 5693+00-5693+20


Woven Wire Fence
To be Erected Prior to Construction
S.B. 5693+00-5714+00 L.A.

Utility Marking
N.B. 5693+00-5693+20 L.A.
S.B. 5693+00-5693+20 L.A.

PLAN	DATE	BY
NOTES BOOK		
NO. 1		
NO. 2		
NO. 3		
NO. 4		
NO. 5		
NO. 6		
NO. 7		
NO. 8		
NO. 9		
NO. 10		

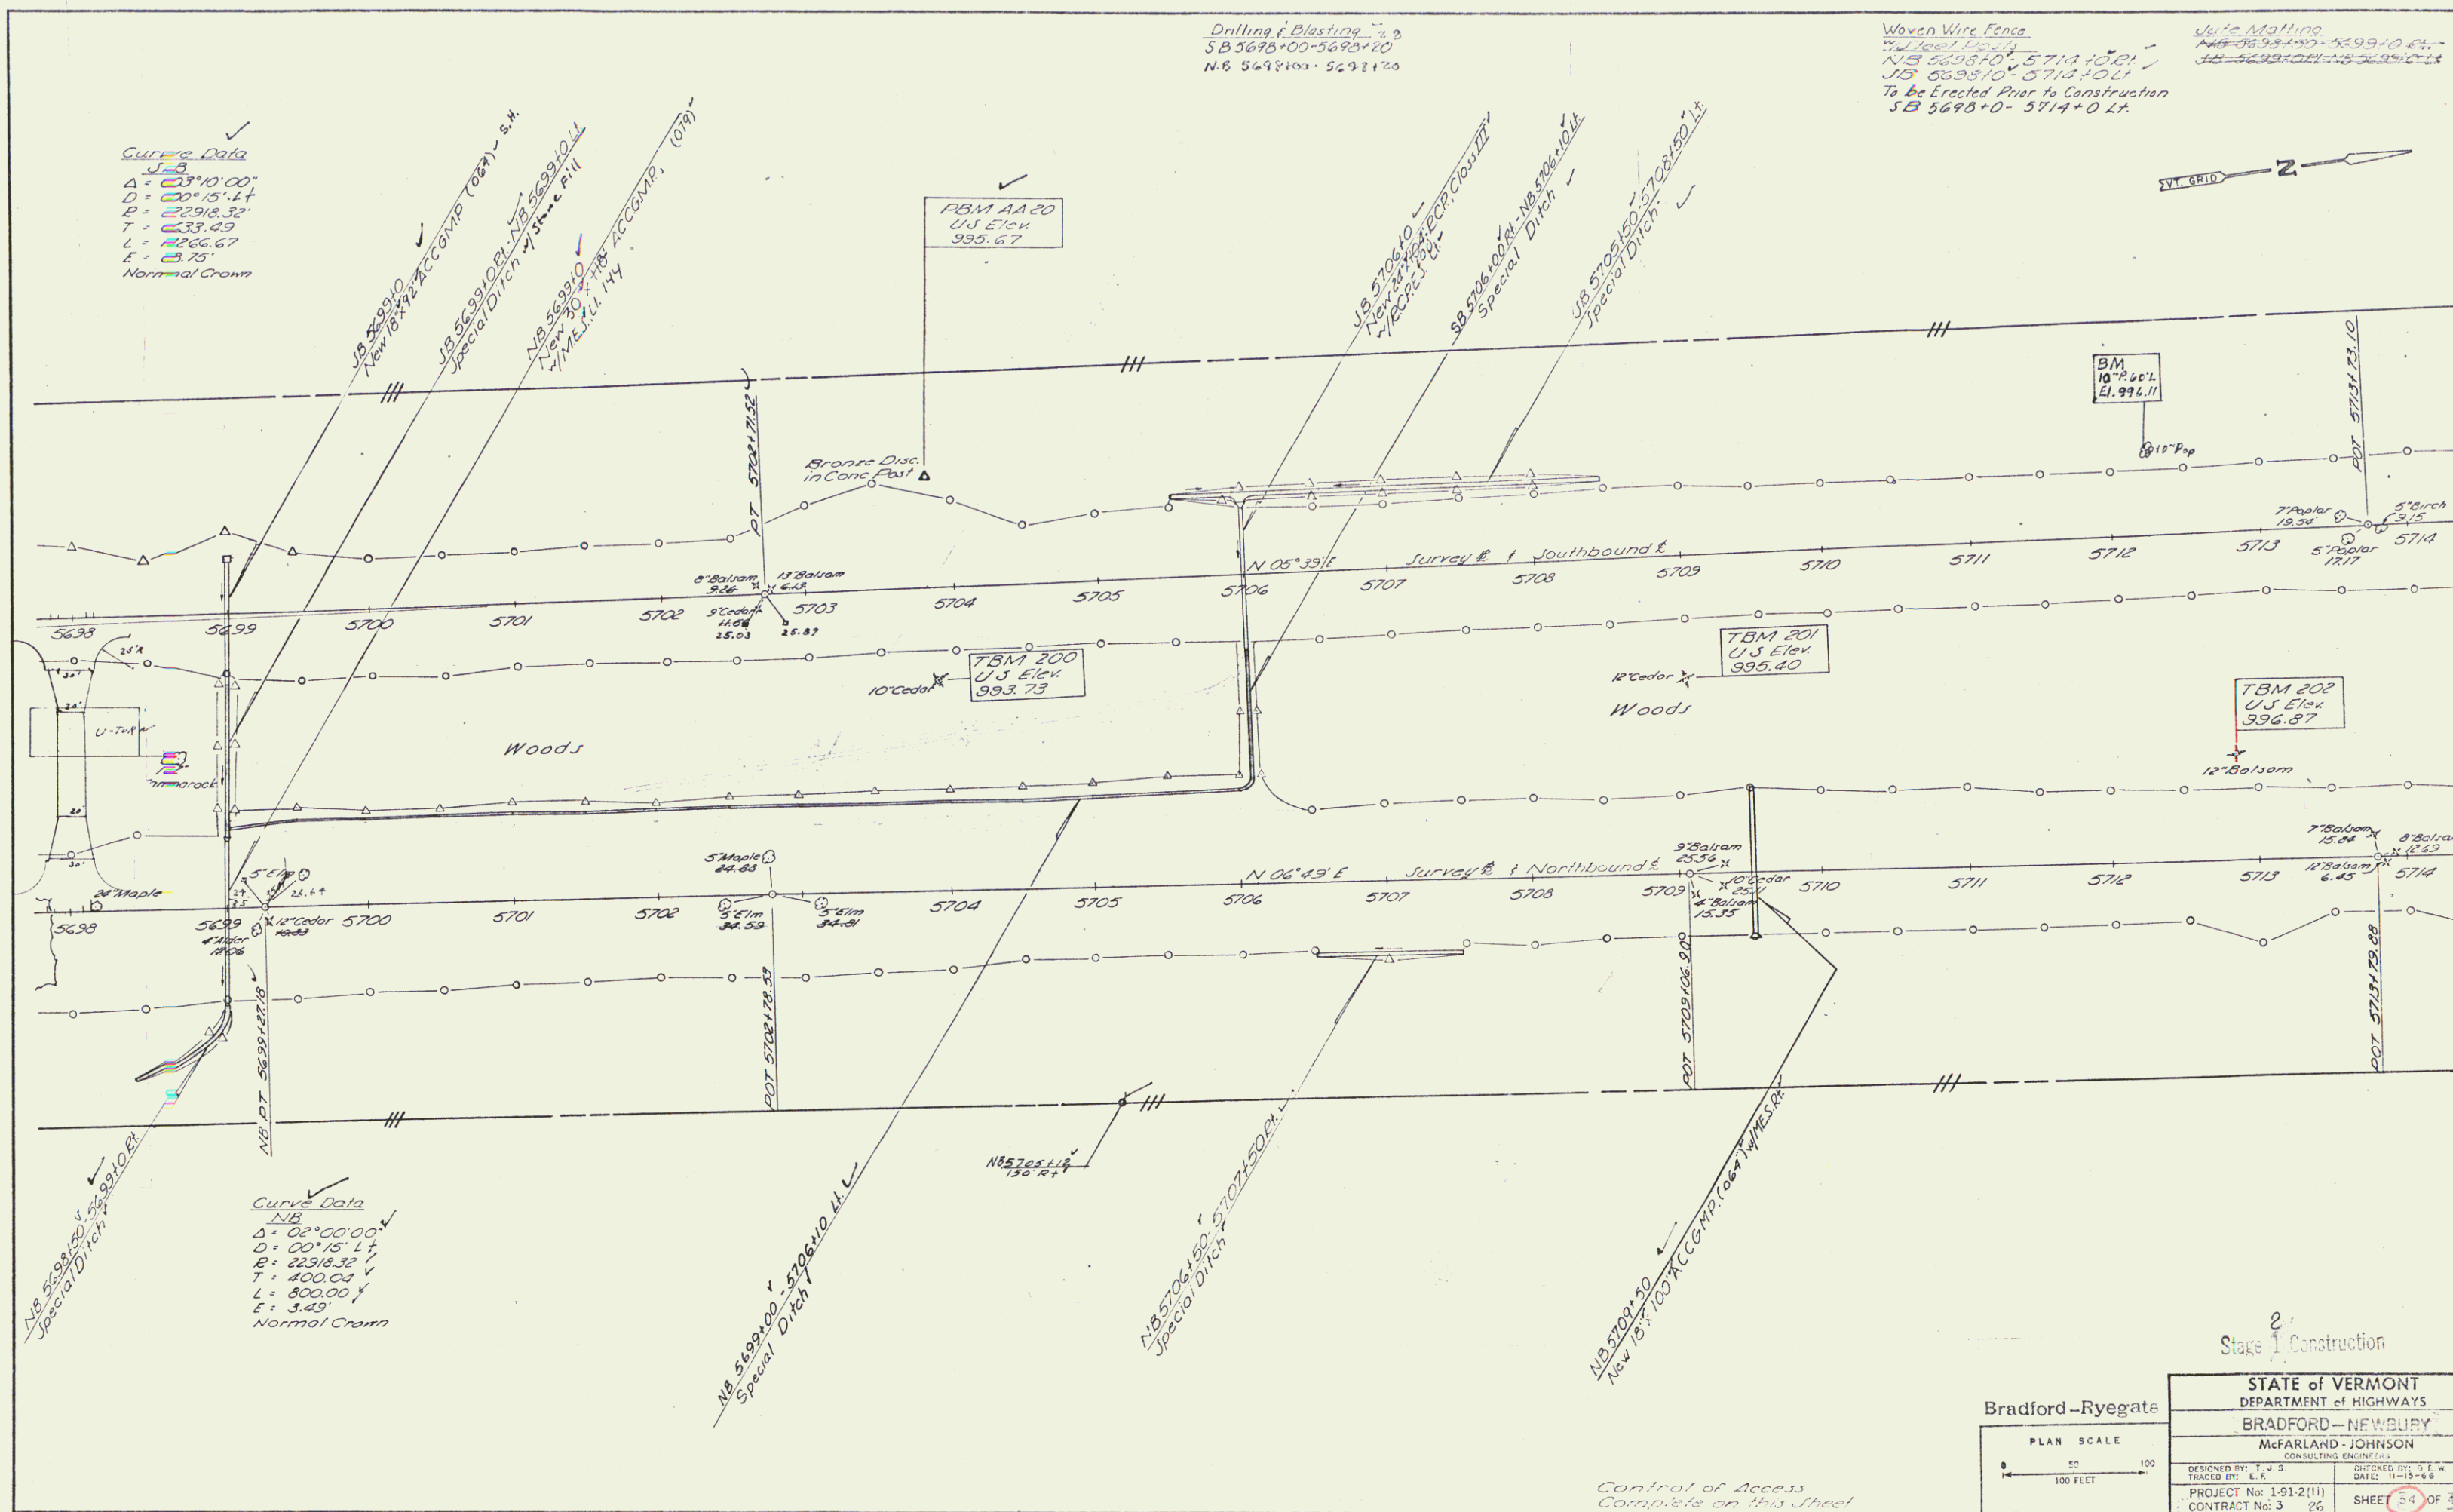

Bradford-Ryegate

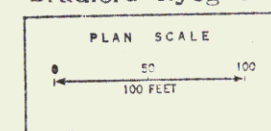

Stage 1 Construction

STATE of VERMONT DEPARTMENT of HIGHWAYS BRADFORD-NEWBURY McFARLAND-JOHNSON CONSULTING ENGINEERS	DESIGNED BY: T. J. S. TRACED BY: E. F. PROJECT No: 1-91-2(11) CONTRACT No: 3	CHECKED BY: D. L. W. DATE: 11-15-66 SHEET 54 OF 213 147 430
---	---	--

R.O.W./const 125