


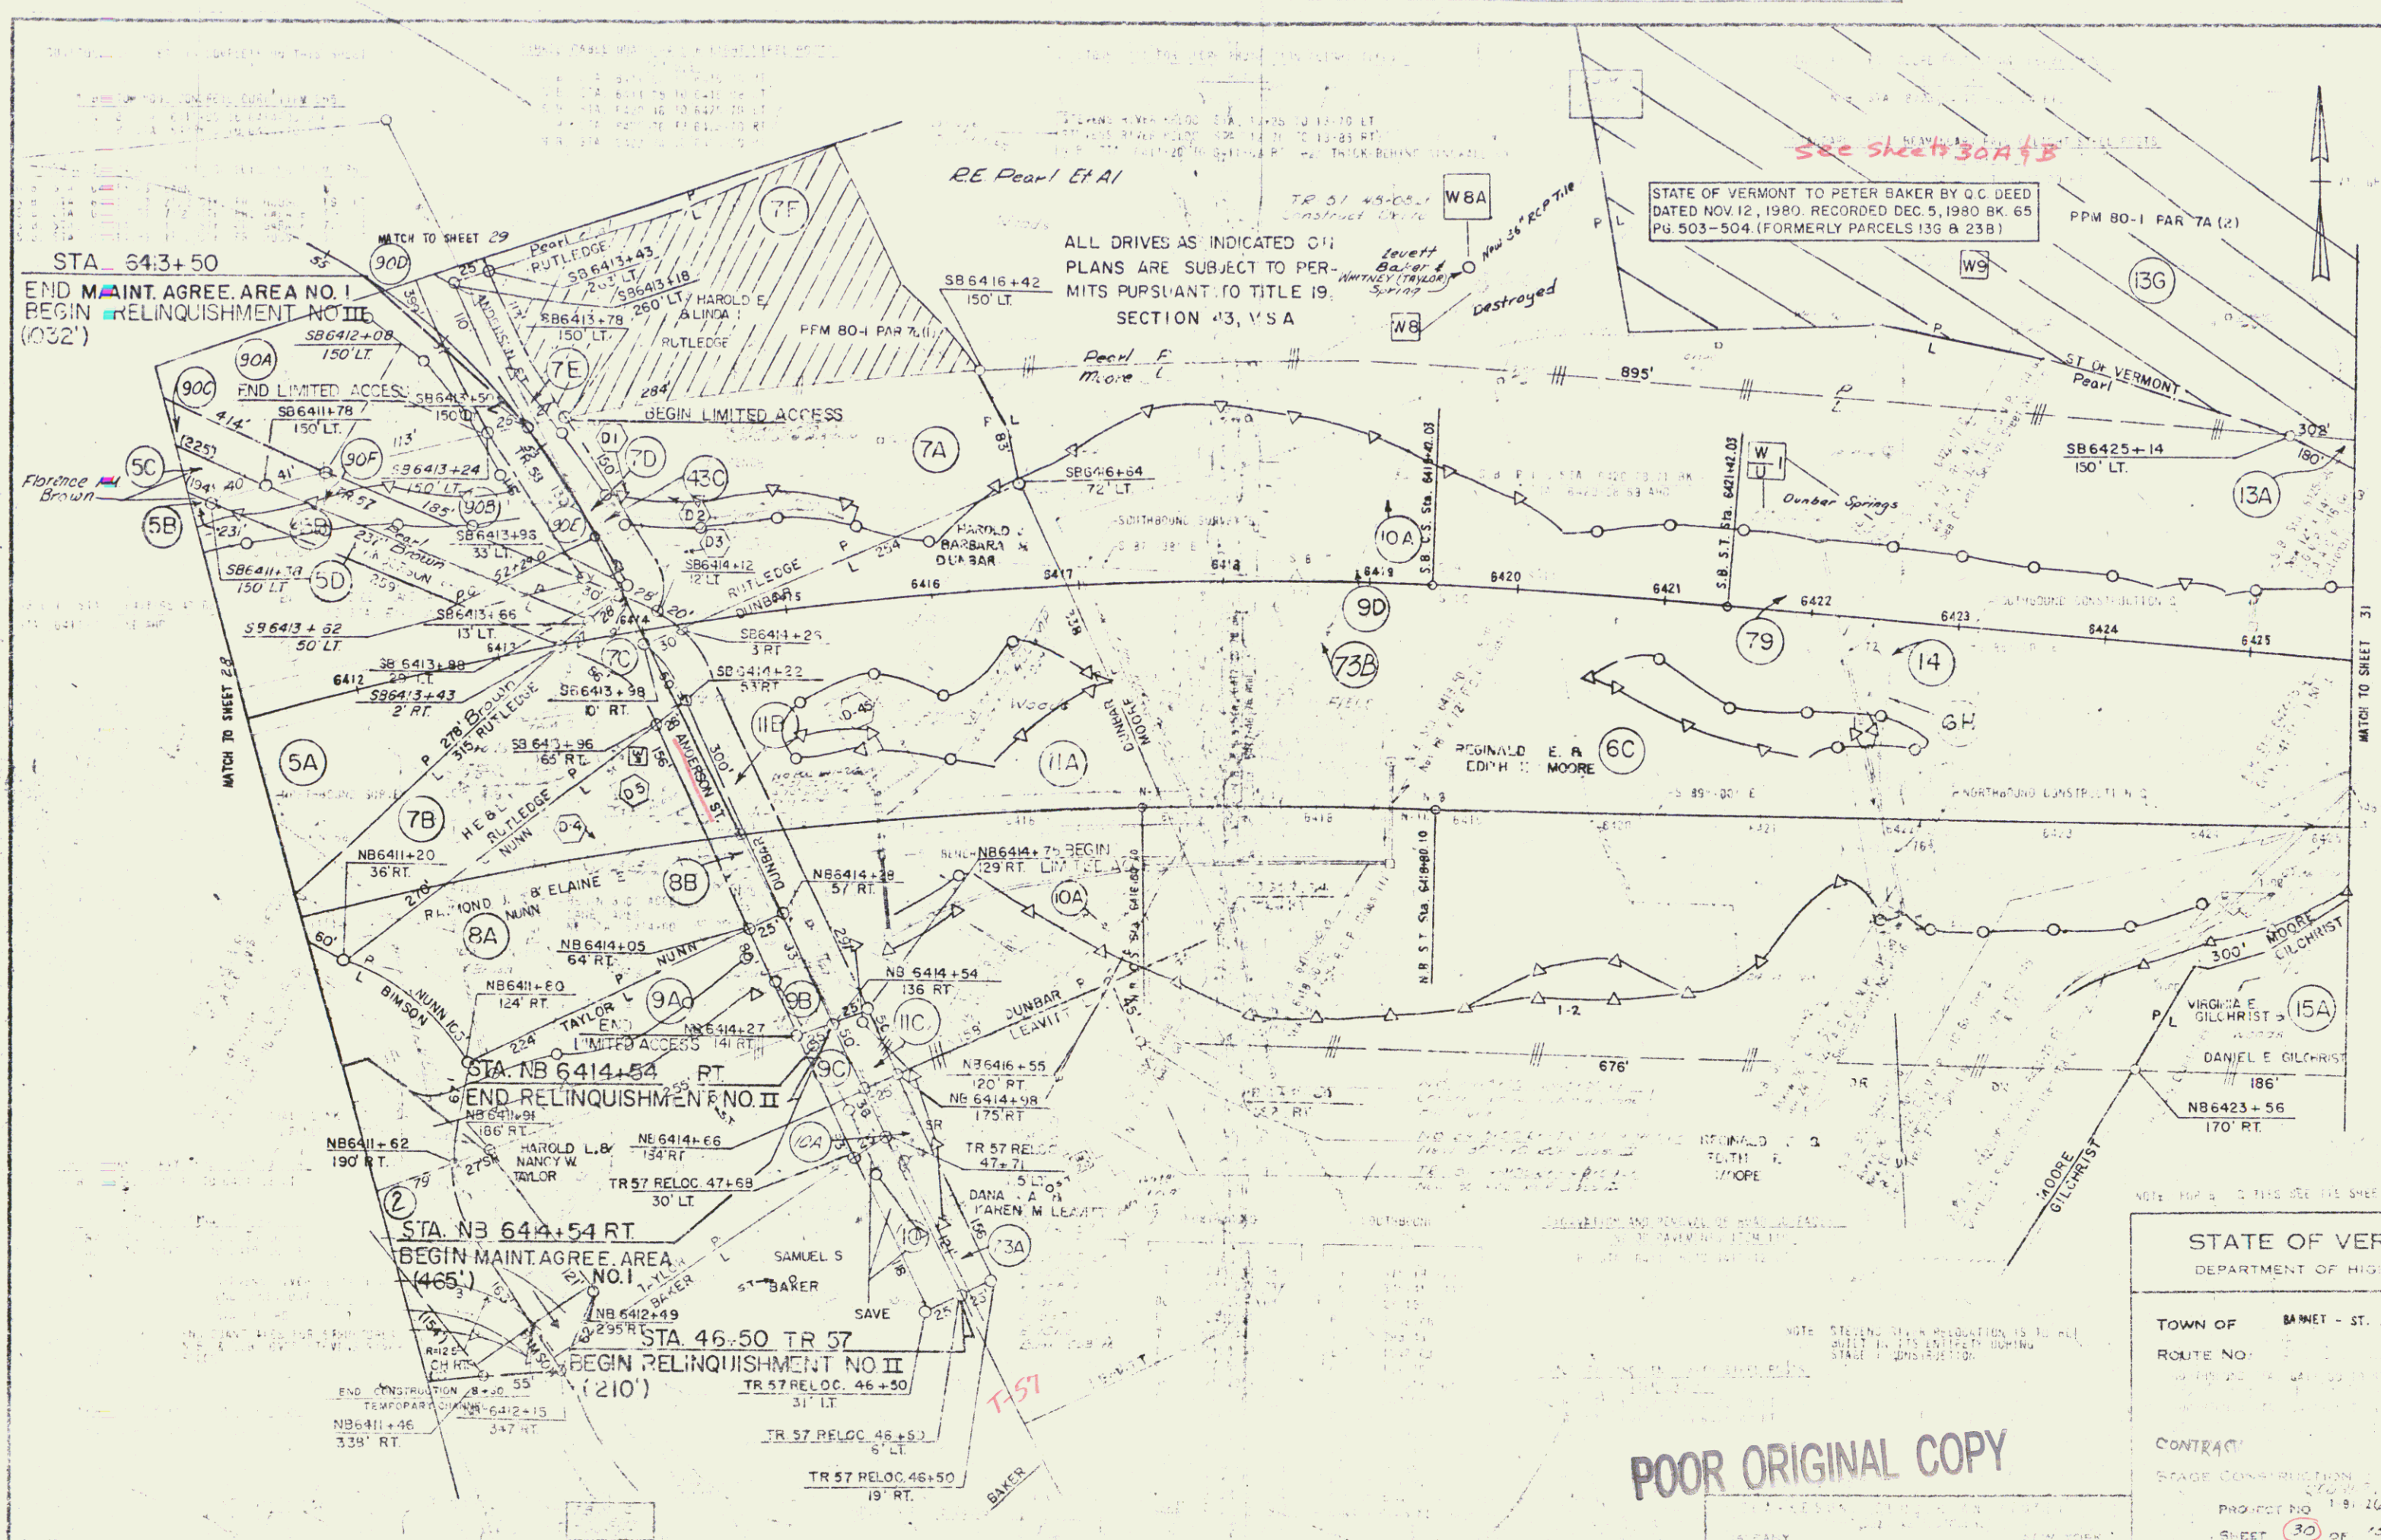

POOR ORIGINAL COPY

STATE OF VERMONT	
DEPARTMENT OF HIGHWAYS	
TOWN OF	BARNET - ST. JOHNSBLAY
ROUTE NO.	57
CONTRACT	
STAGE CONSTRUCTION	
PROJECT NO.	18-1027
SHEET	30 OF 159

4 JAN 10 1984