


Sub-base of Sand
Item 202
SB 1290+50 - 1293+00
NB 1290+50 - 1293+00

Stone Fill for Slope Protection
(LA Type) Item 518
WB 122 20+00 LA - NB 1299+50 20
SB 1290+75 LA - 1291+00 LA

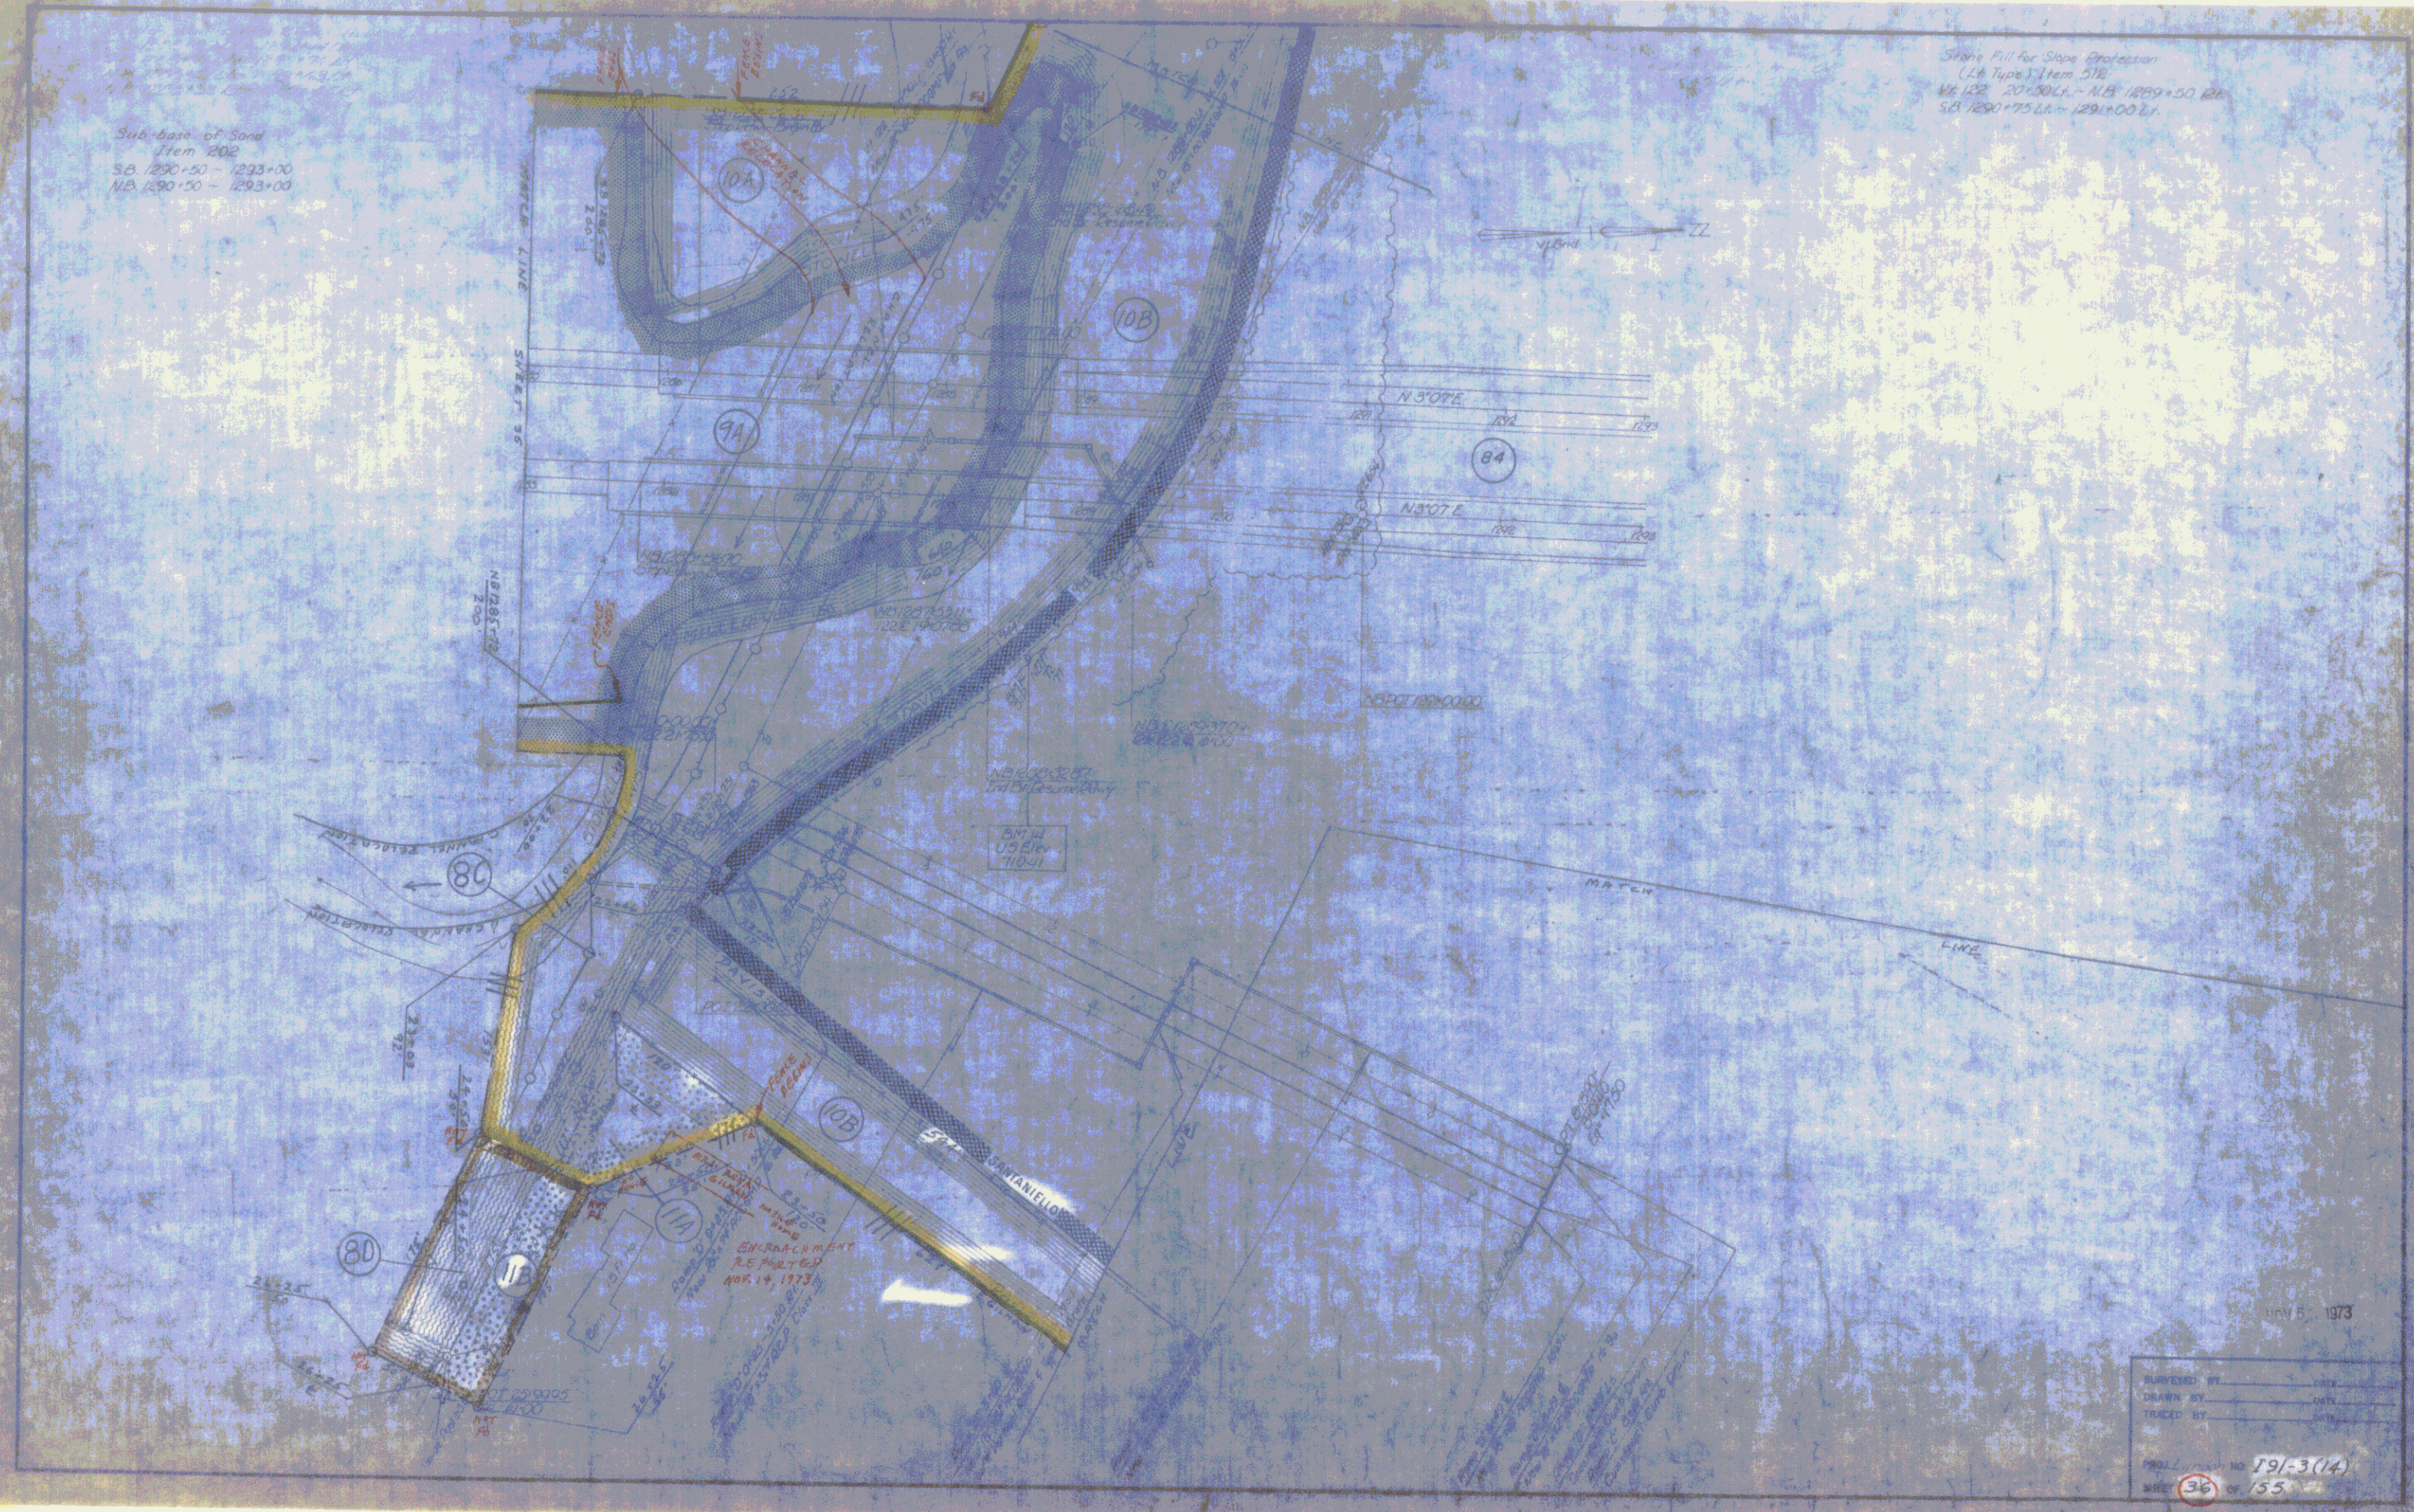

DESIGNED BY	DATE
DRAWN BY	DATE
CHECKED BY	DATE
PROJECT NO.	191-3(14)
SHEET NO.	36 OF 55