


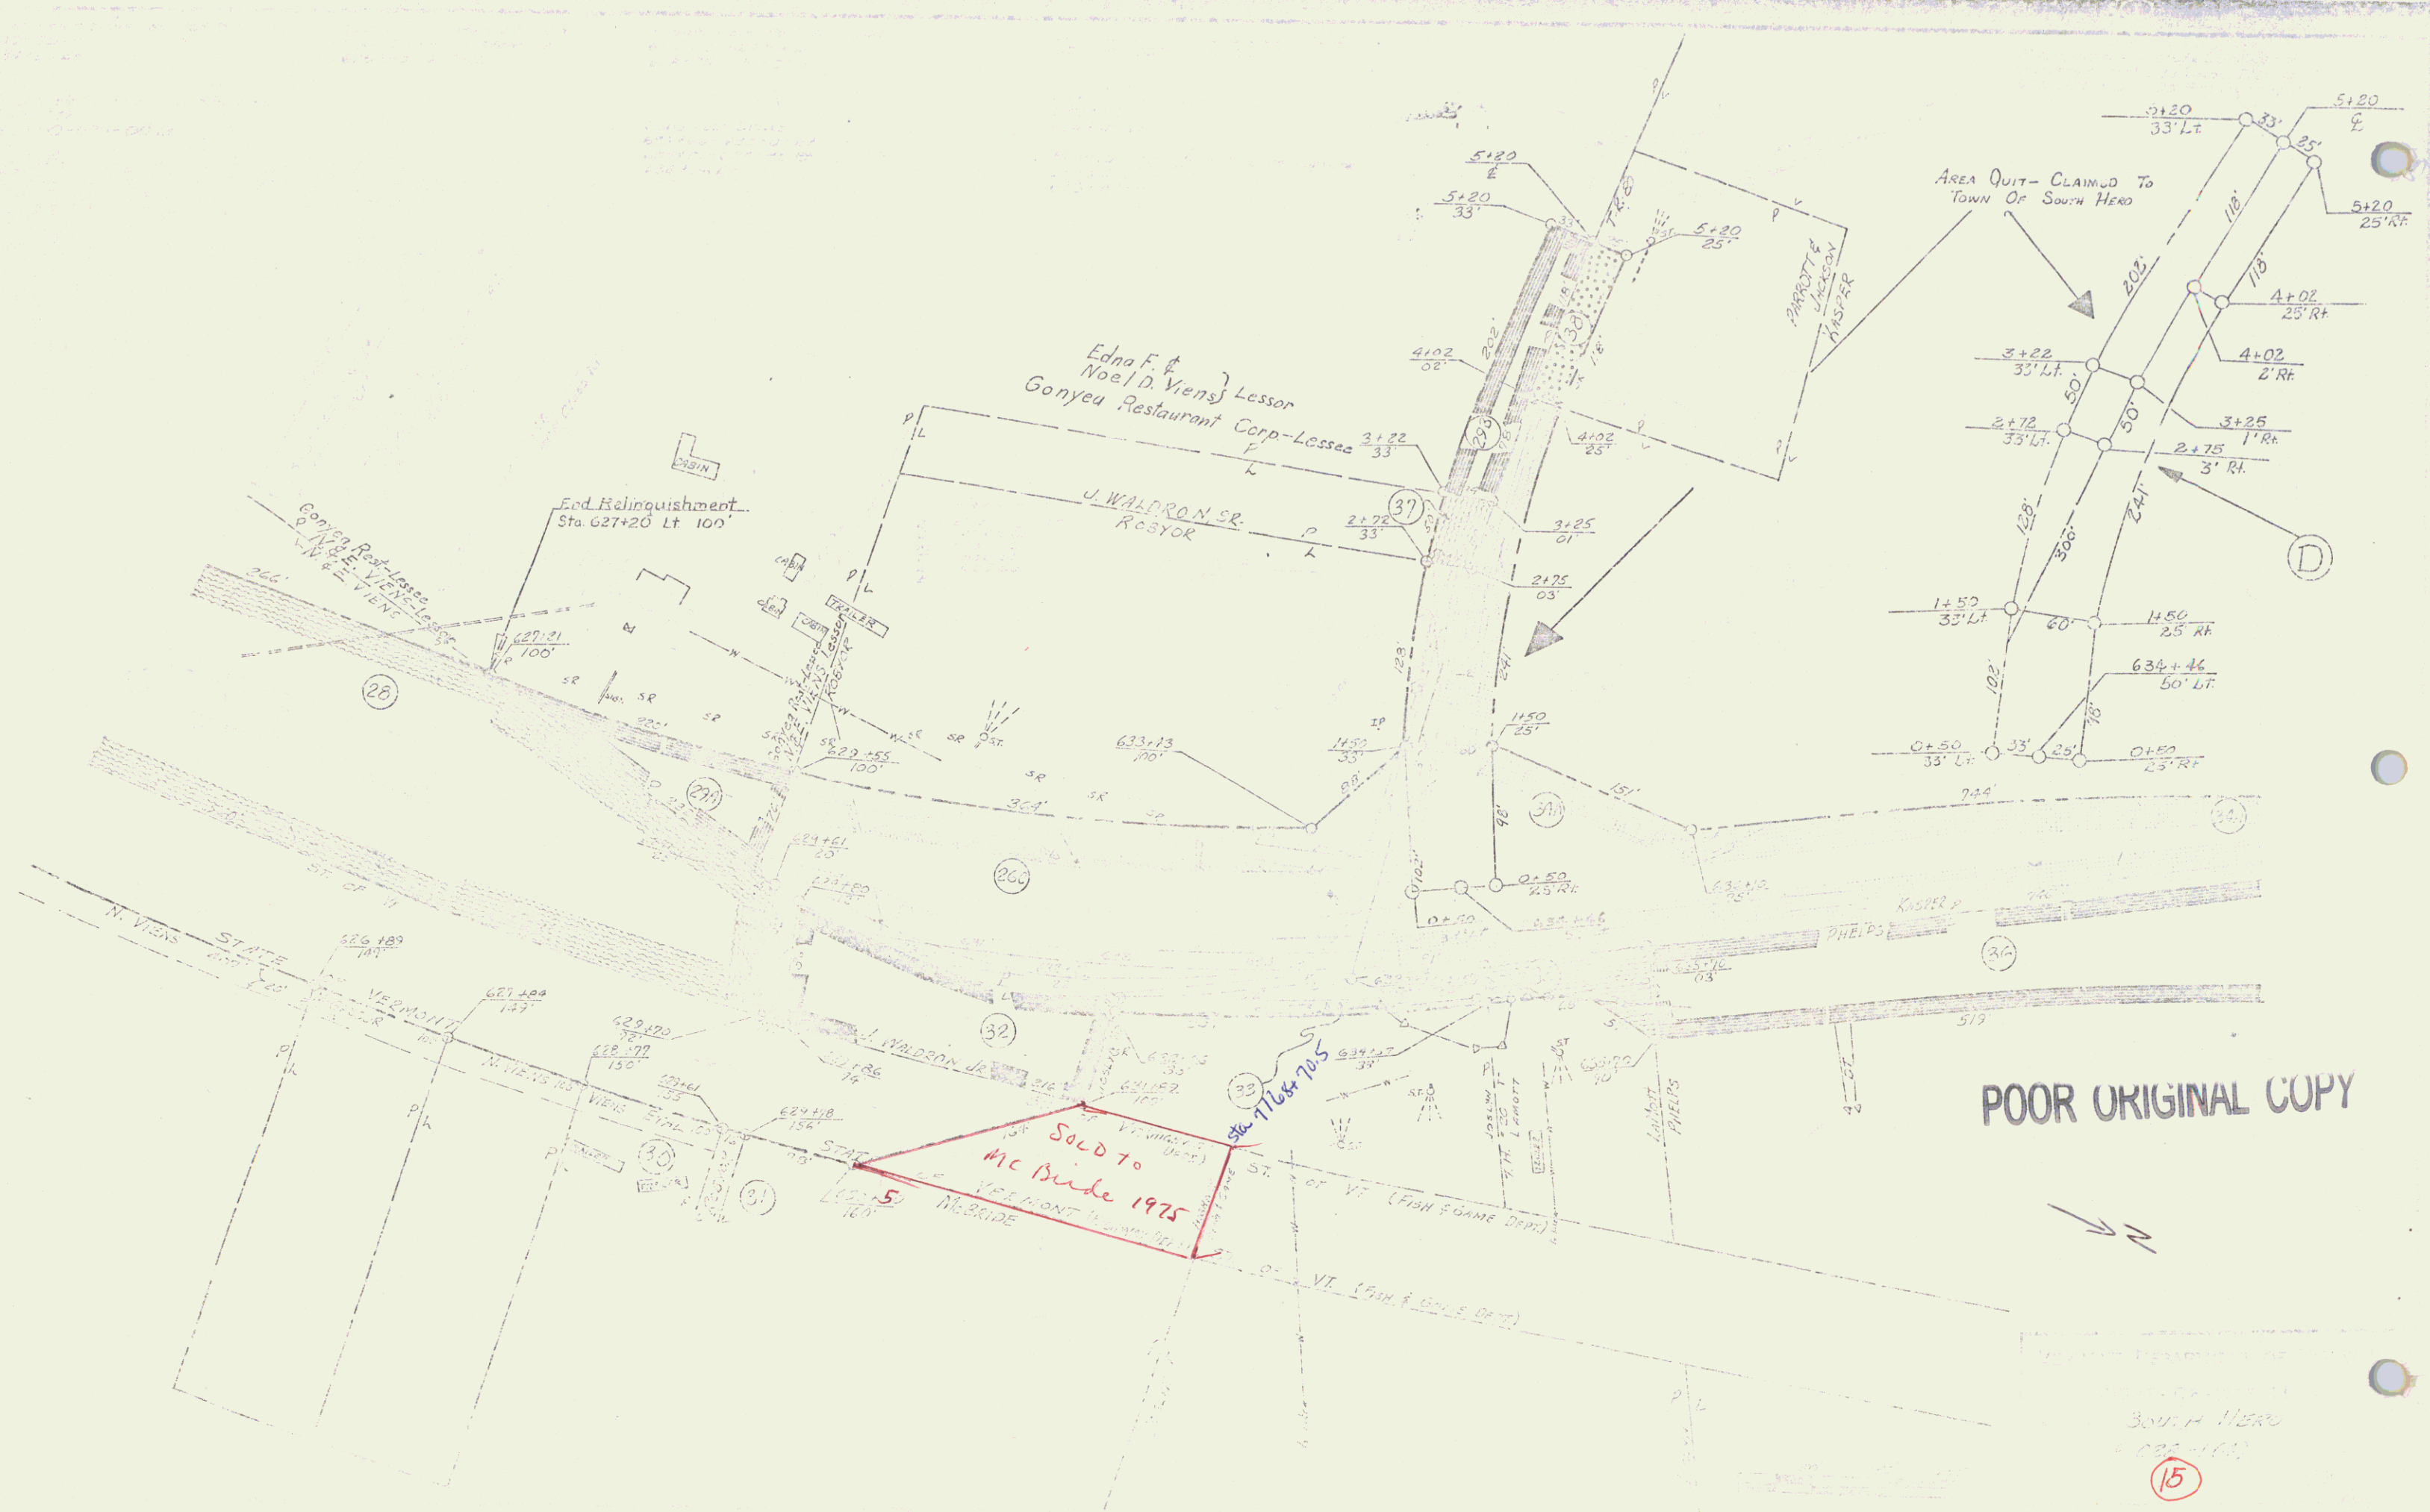

POOR ORIGINAL COPY

15

6