
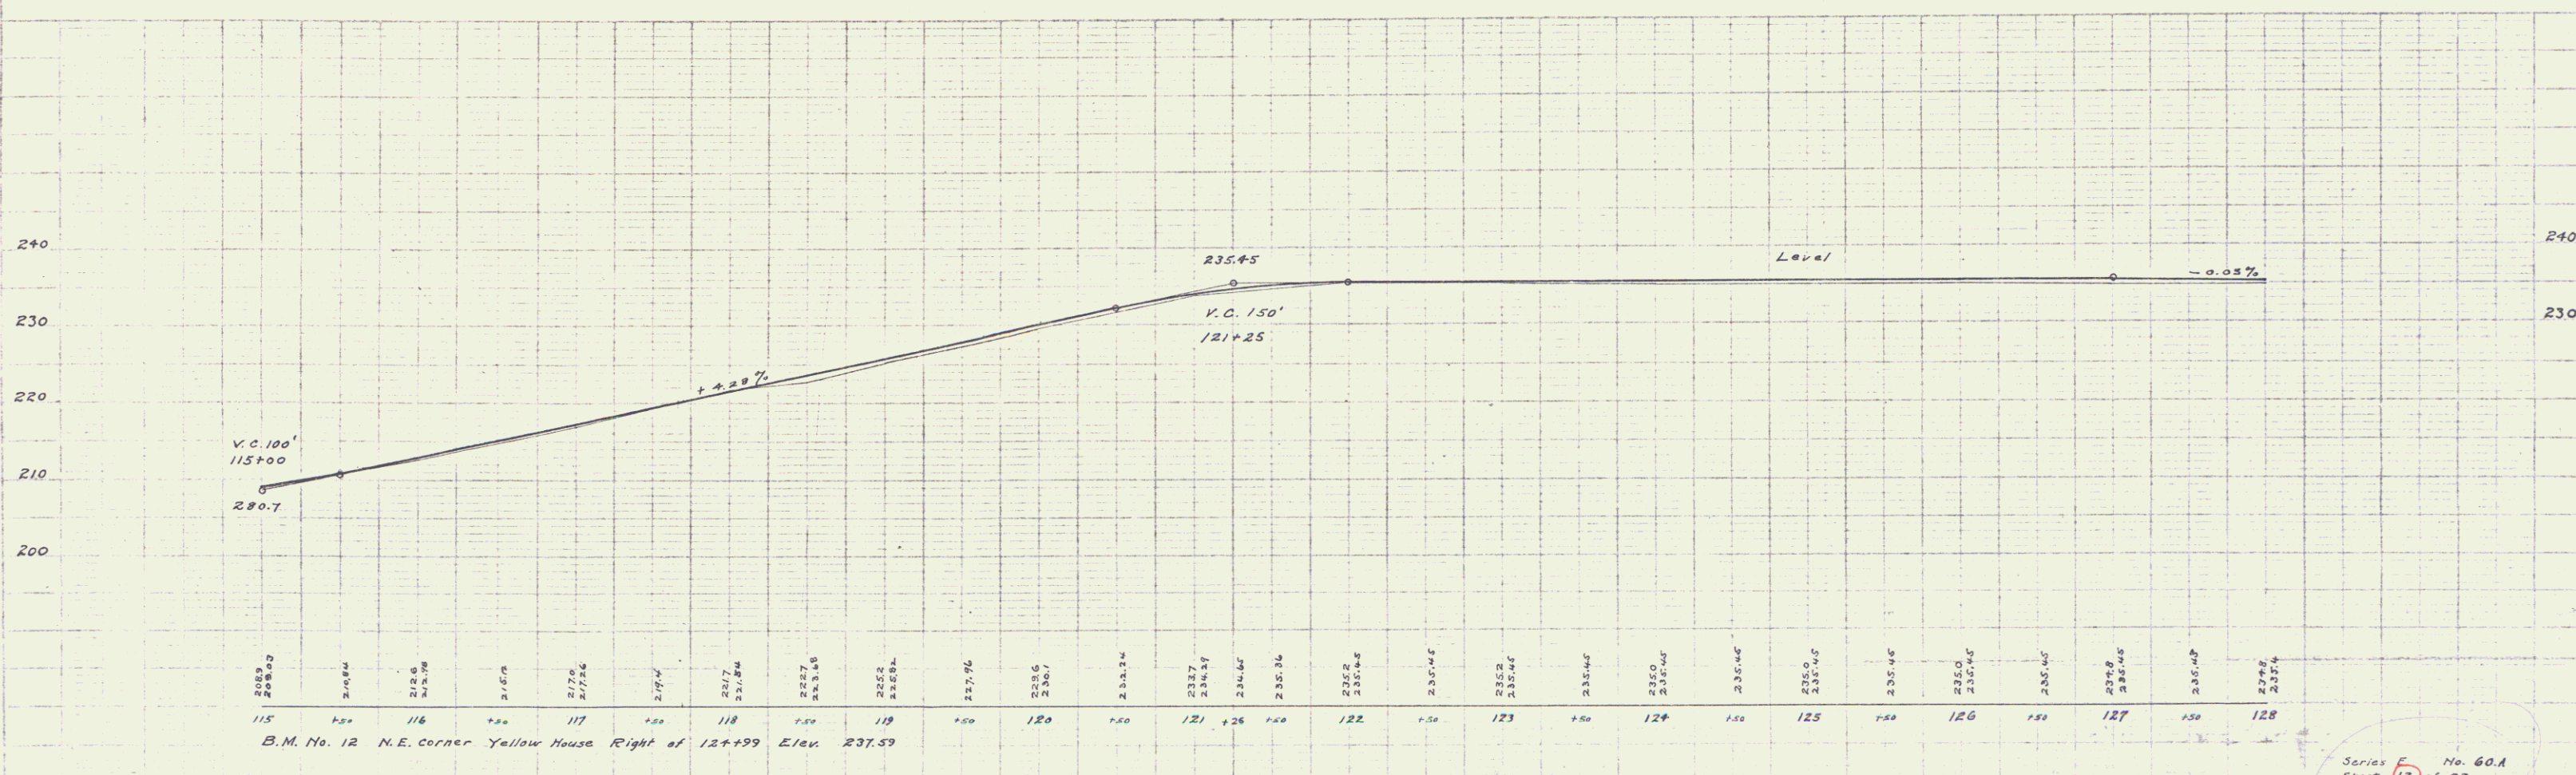


FED. ROAD DIST. NO.	STATE	FISCAL YEAR	SHEET NO.	TOTAL SHEETS
8	VT.	60.1	12	23

822
G. L. Field

822
B. H. Hayward

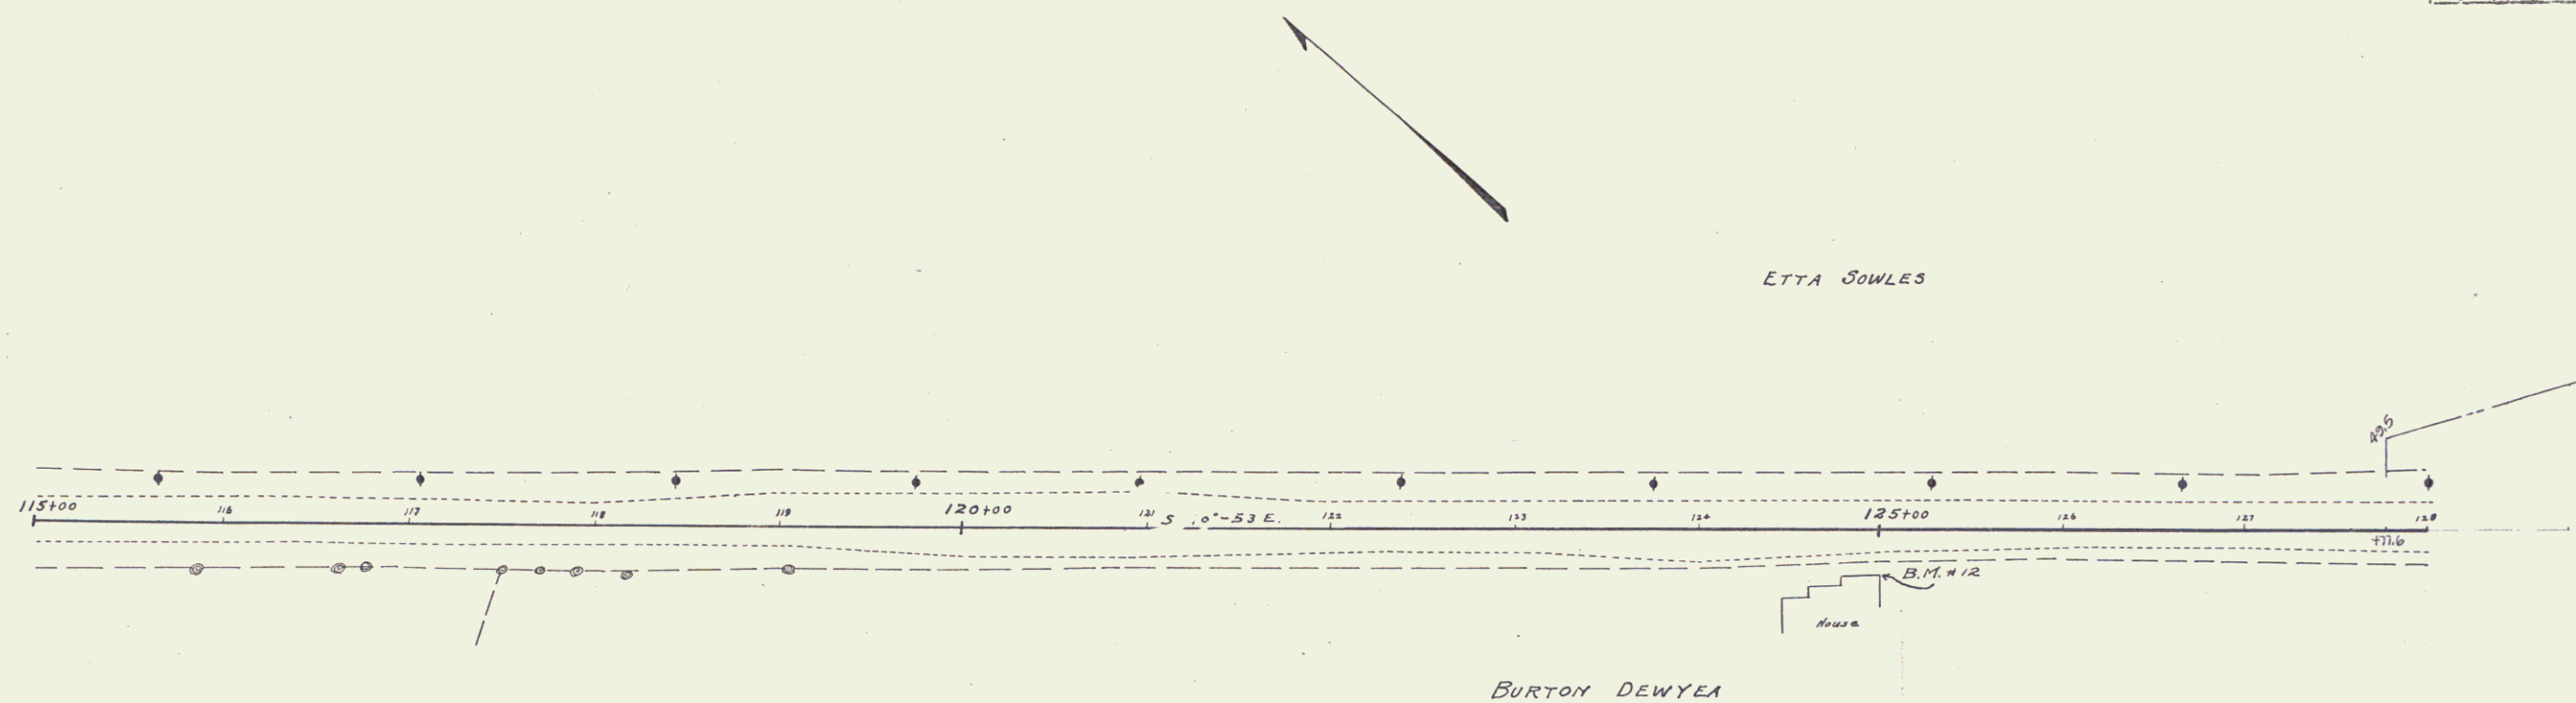

Series E No. 60.1
Sheet 12 of 23