

SHEET NO.	DESCRIPTION
1	TITLE PAGE.
2	TYPICAL CROSS SECTION OF IMPROVEMENT. 8" BITUMINOUS CONCRETE PAVEMENT, ITEM 361-B MOD.
3	QUANTITY SHEET, ITEMS.
4	PLAN AND PROFILE SHEETS.
5	A-61 DRILLING AND BLASTING.
6	B-1 BANKING TABLES.
7	B-5 TYPICAL SLOPE GRADING.
8	B-7 DRAINAGE IN FILL SECTIONS.
9	D-4 UNDERDRAIN FLUSHING BASINS & METAL END SECTIONS.
10	B-12 SIDE ROAD INTERSECTIONS.
11	B-13 DRIVE INTERSECTIONS.
12	D-1 PRECAST R.C.P. DROP INLETS.
13	D-2 C.R.M. HEADWALLS.
14	E-1 BARRICADES, SIGNS AND LIGHTS, ROADWAYS.
15	B-3 THREE CABLE GUARD RAIL WITH STEEL POSTS.
16	B-4 STEEL MARKER POSTS AND PLANK GUARD RAIL.
17	J-1 PROJECT AND BOUNDARY MARKERS.
18	GENERAL PLAN AND ELEVATION MARKERS.
19	ABUTMENT DETAILS, NOS. 1 & 2.
20	WIND WALL DETAILS, ABUTMENTS NOS. 1 & 2.
21	APPROACH SLABS.
22	REINFORCING BAR SCHEDULE.
23	SCB-30-58 (MODIFIED FOR 18-56' SKEW).
24	SB-50-57 DETAILS OF BRIDGE RAILING AND CURB.
25	SB-20-56 (DETAILS A, B, C, D, F, G, H & K).
26	CROSS SECTIONS, ROADWAY.
27	CHANNEL SECTIONS.
28	PRELIMINARY INFORMATION SHEET.

PROJECT NAME & NUMBER TYPE PAVEMENT AREA
MONTPELIER-BERLIN F 028-3(1) BIT. CONC. PAVT. 10,137 S.Y.

RECORD PLANS
MATERIALS

SUBBASE OF SAND, OF GRAVEL, OF CRUSHED ROCK, GRAVEL SHOULDERS
 SAND AND GRAVEL CO. INC. (PLAINFIELD, VT.)
 ASPHALT CEMENT—ESSO—EVERETT, MASSACHUSETTS.
 ASPHALT—MOBIL OIL CO.—E. PROVIDENCE, RHODE ISLAND.
 ASPHALT COATED CORRUGATED GALVANIZED METAL PIPE & CAST IRON JOINTS—CASS WARNER CORP.—VERMONT.
 CONCRETE CLASS B—O & D CONCRETE CO. INC.—MONTPELIER, VERMONT.
 REINFORCING STEEL—REPUBLIC STEEL CORP.—YOUNGSTOWN, OHIO.
 BRIDGE PAINT—REYNOLDS & SON—E. VERMONT.
 GRANITE BRIDGE CURB—ROCK OF AGES CORP.—BARRE, VERMONT.
 THREE CABLE GUARD RAIL & STEEL MARKER POSTS—S.T. GRISWOLD & CO. INC.—ESSEX JCT., VT.
 CONTRACT—J. J. DUFFY—VERMONT.
 CALEDONIA SAND & GRAVEL CO. INC.—ST. JOHNSBURY, VERMONT.
 RECORD ENGINEER—E. C. GLYSSON.
 CONTRACT—J. J. DUFFY—VERMONT.
 DATED—SEPTEMBER 20, 1961.
 ST. J. DUFFY—SEPTEMBER 25, 1961.
 COMPLETED—OCTOBER 10, 1962.
 ACCEPTED—OCTOBER 10, 1962.

STATE OF VERMONT
 DEPARTMENT OF HIGHWAYS
 Proposed Improvement
 FEDERAL AID
 PRIMARY PROJECT

CITY OF MONTPELIER-TOWN OF BERLIN

COUNTY OF WASHINGTON


U.S. ROUTE 2 Pin# 992 115

MONTPELIER-E. MONTPELIER ROAD

BEGINNING AT A POINT 74.7 FEET WEST OF THE
 MONTPELIER CITY-BERLIN TOWN LINE AND EXTENDING
 EASTERLY 3,750.48 FEET.

LENGTH OF ROADWAY 3,651.48 FEET=0.691 MILE
 LENGTH OF BRIDGE 99.0 FEET=0.019 MILE
 LENGTH OF PROJECT 3,750.48 FEET=0.710 MILE

1960 ADT = 1950
 1980 ADT = 2750
 1980 DHV = 365
 D = 64 %
 T = 7.5 %
 V = 60 M.P.H.

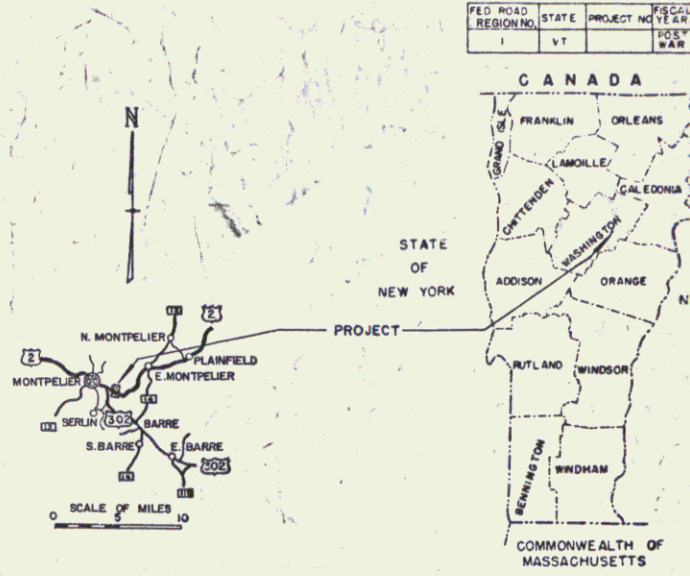

RIGHT-OF-WAY DIVISION
 TOWN FILE
 PERPETUAL
 Town of US
 (To Be Returned To R.O.W. Division)

CONTRACTOR—J. J. DUFFY—VERMONT.
 RECORD ENGINEER—E. C. GLYSSON.
 CONTRACT—J. J. DUFFY—VERMONT.
 DATED—SEPTEMBER 20, 1961.
 ST. J. DUFFY—SEPTEMBER 25, 1961.
 COMPLETED—OCTOBER 10, 1962.
 ACCEPTED—OCTOBER 10, 1962.

GROUND ELEVATION
 GRADE ELEVATION
 CURVE DATA
 DEFLECTION OF ANGLE
 DEGREE OF CURVE
 RADIUS OF CURVE
 TANGENT DISTANCE
 LENGTH OF CURVE
 EXTERNAL DISTANCE
 POINT OF INTERSECTION
 POINT OF CURVE
 POINT OF TANGENT
 POINT ON TANGENT
 POINT ON SUB-TANGENT
 POST



SCALES
 TITLE
 TYPICAL
 PLAN
 PROFILE
 HORIZONTAL
 VERTICAL
 CROSS-SECTIONS


APPROVED E. C. Glysson RECORDARY ENGINEER
 DATE July 19, 1961
 APPROVED W. E. Taylor DISTRICT ENGINEER
 DATE July 21, 1961
 APPROVED E. M. Lane HIGHWAY ENGINEER
 DATE August 8, 1961
 APPROVED A. D. Smith CHIEF ENGINEER
 DATE July 19, 1961
 AUTHORIZED BY ORDER OF THE STATE HIGHWAY BOARD

NOTE: ANY FURTHER INFORMATION OR
 FINAL QUANTITIES, AMOUNTS OR COSTS
 RELATIVE TO THIS PROJECT MAY BE
 EITHER THE FIELD BOOKS OR THE
 FILE.

DEPARTMENT OF COMMUNITY
 BUREAU OF PUBLIC ROADS


APPROVED E. C. Glysson
 DIVISION ENGINEER
 PROJECT F NO 028-3
 SHEET 1 OF 70 SHEETS

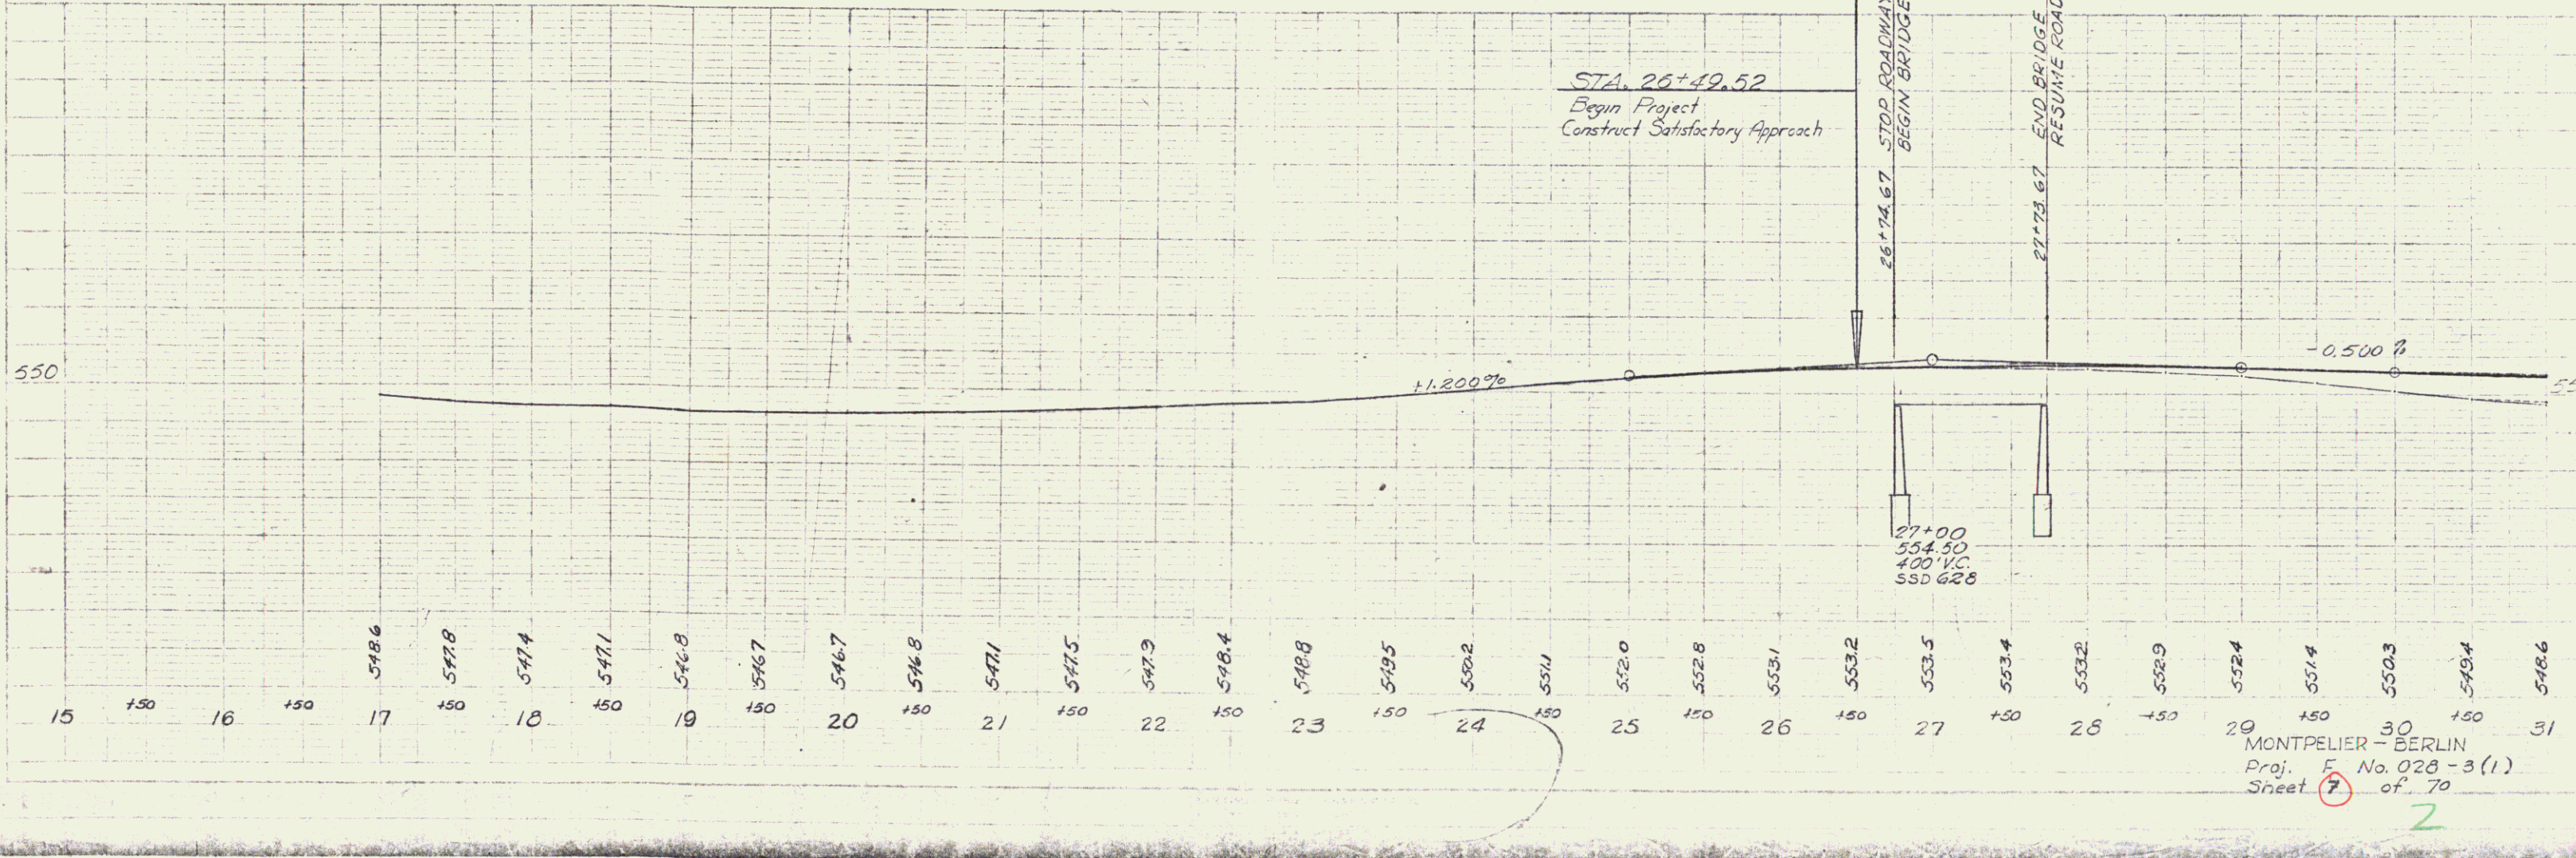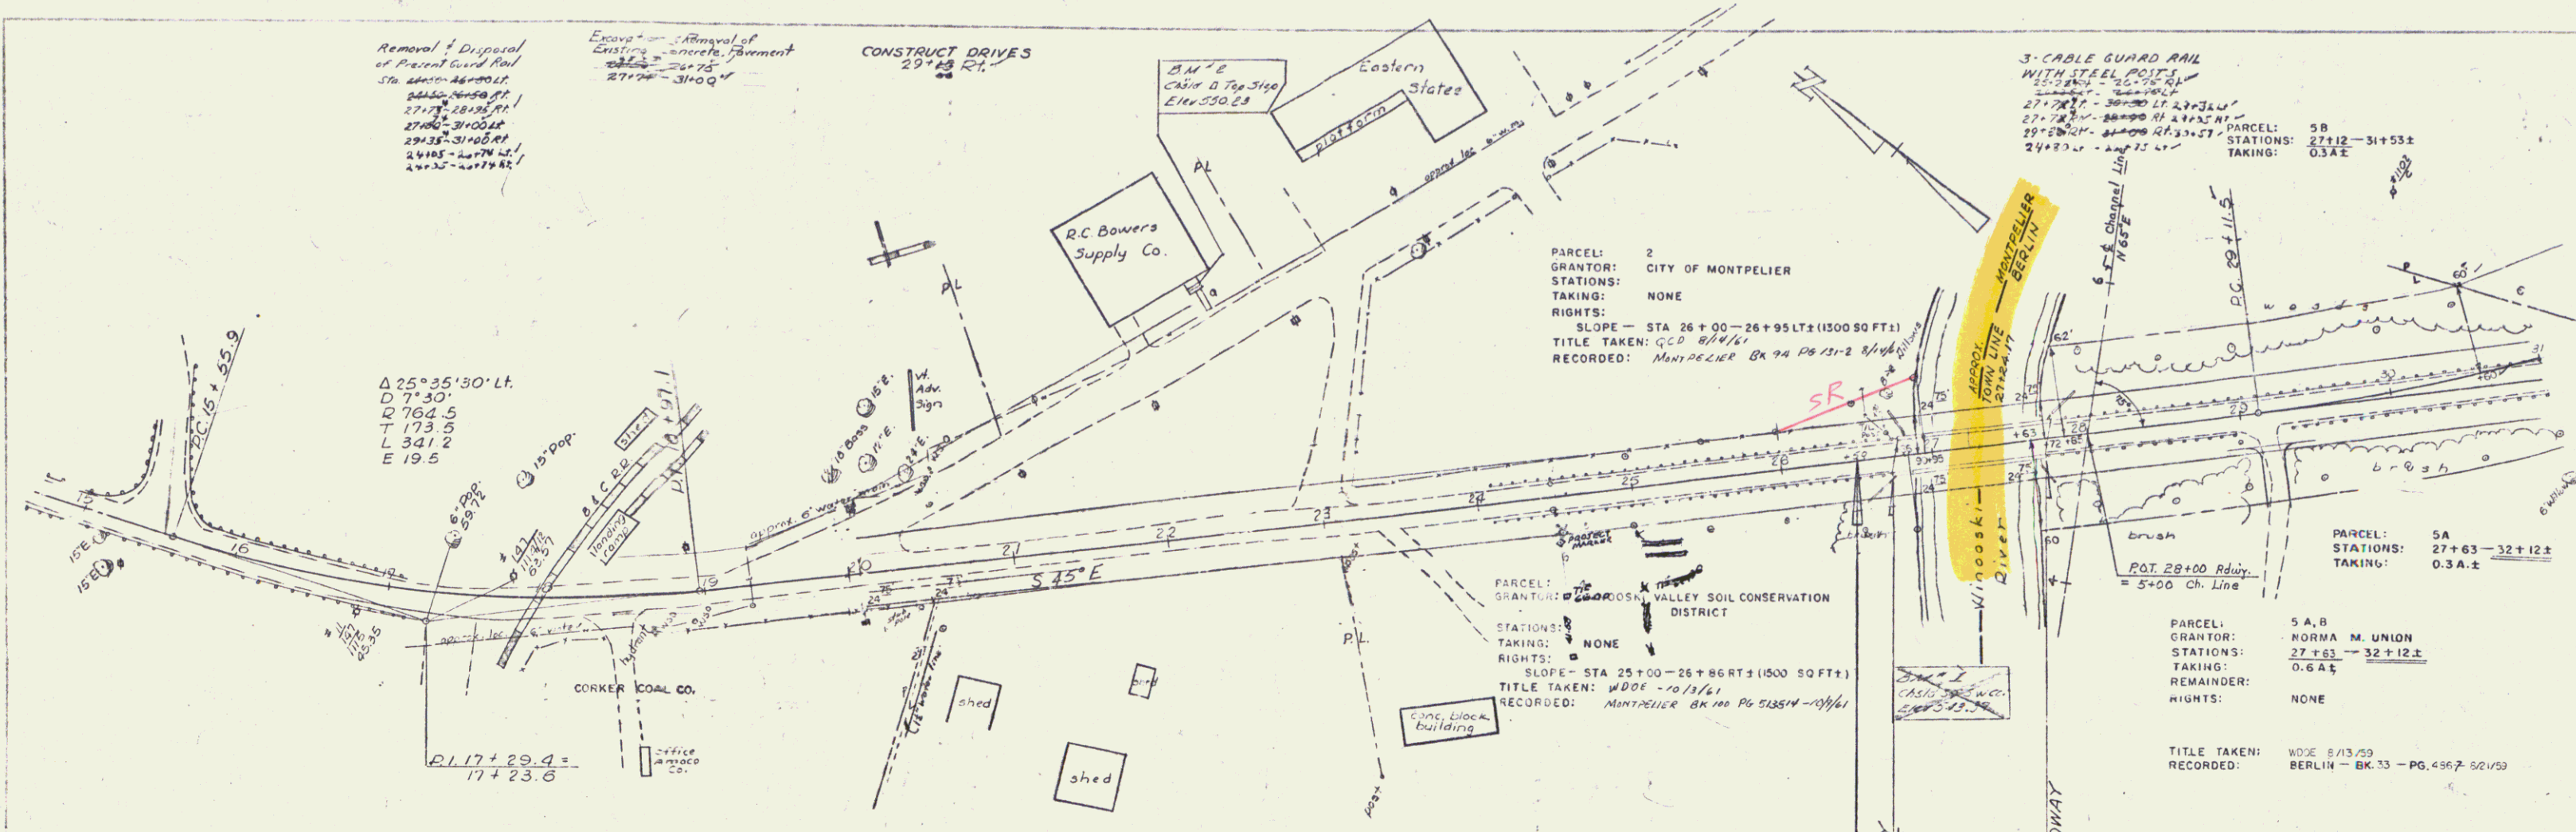


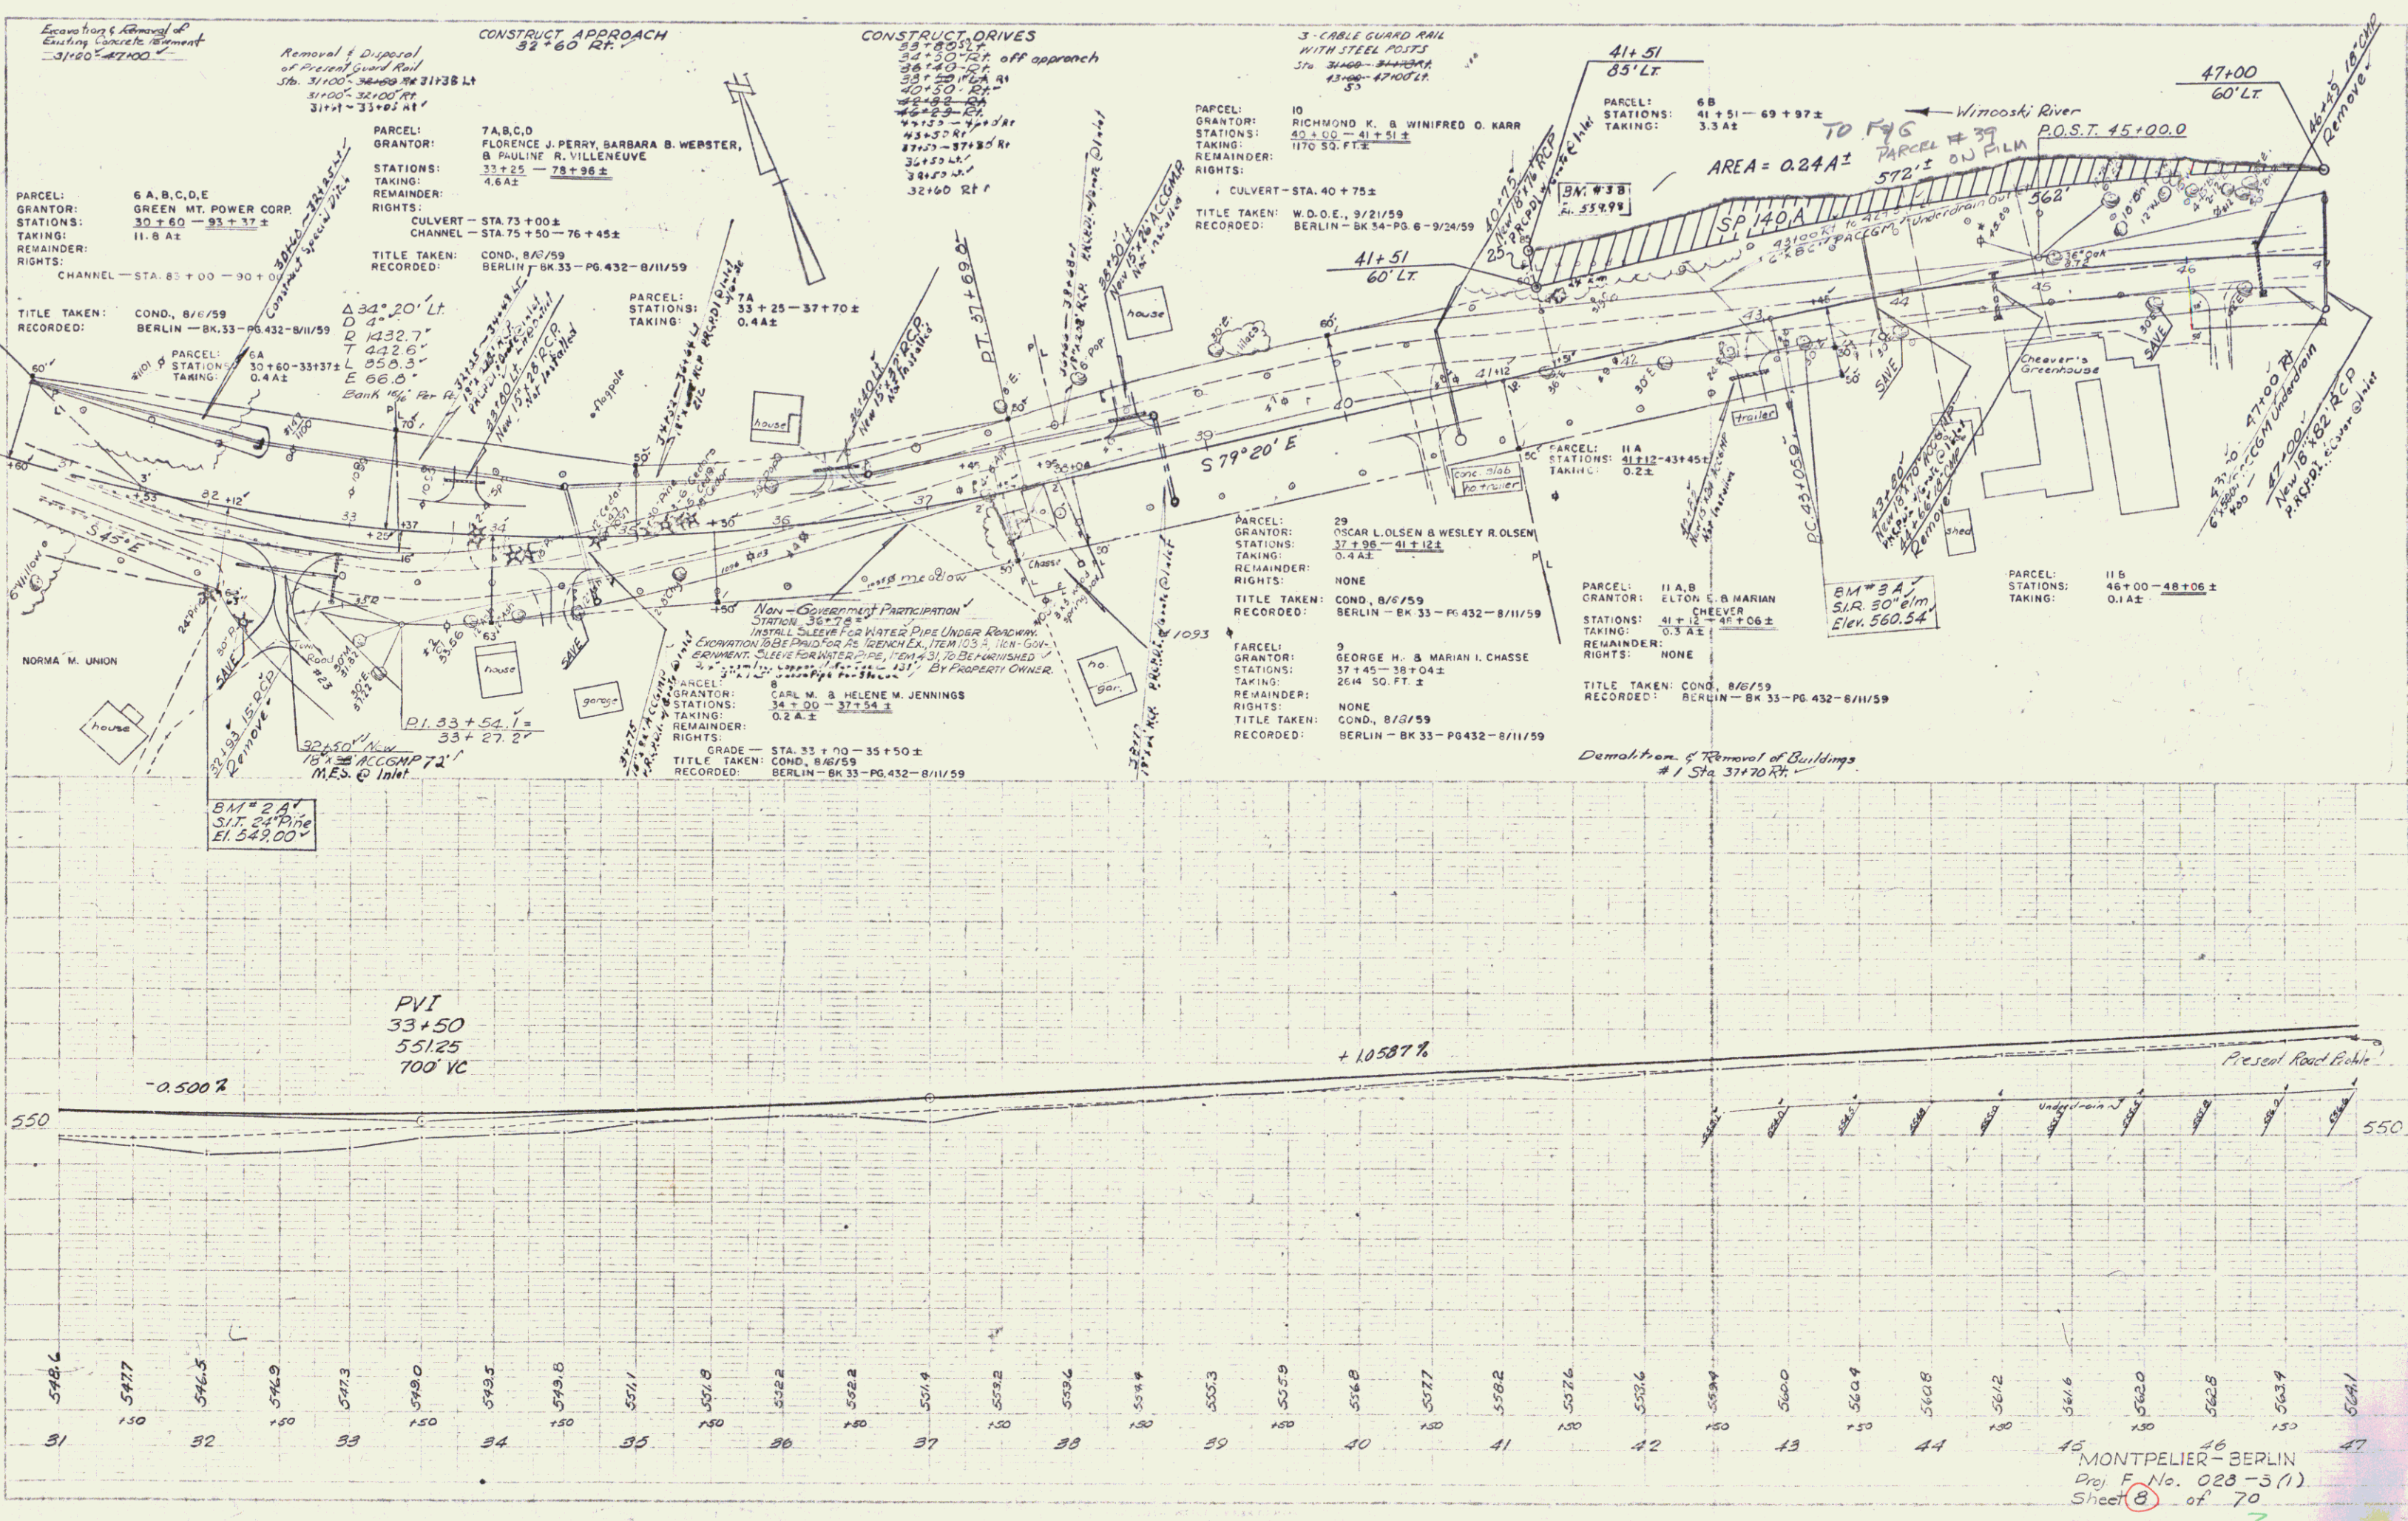

MONTPELIER-BERLIN
Proj. No. 028-3(1)
Sheet 8 of 70

3

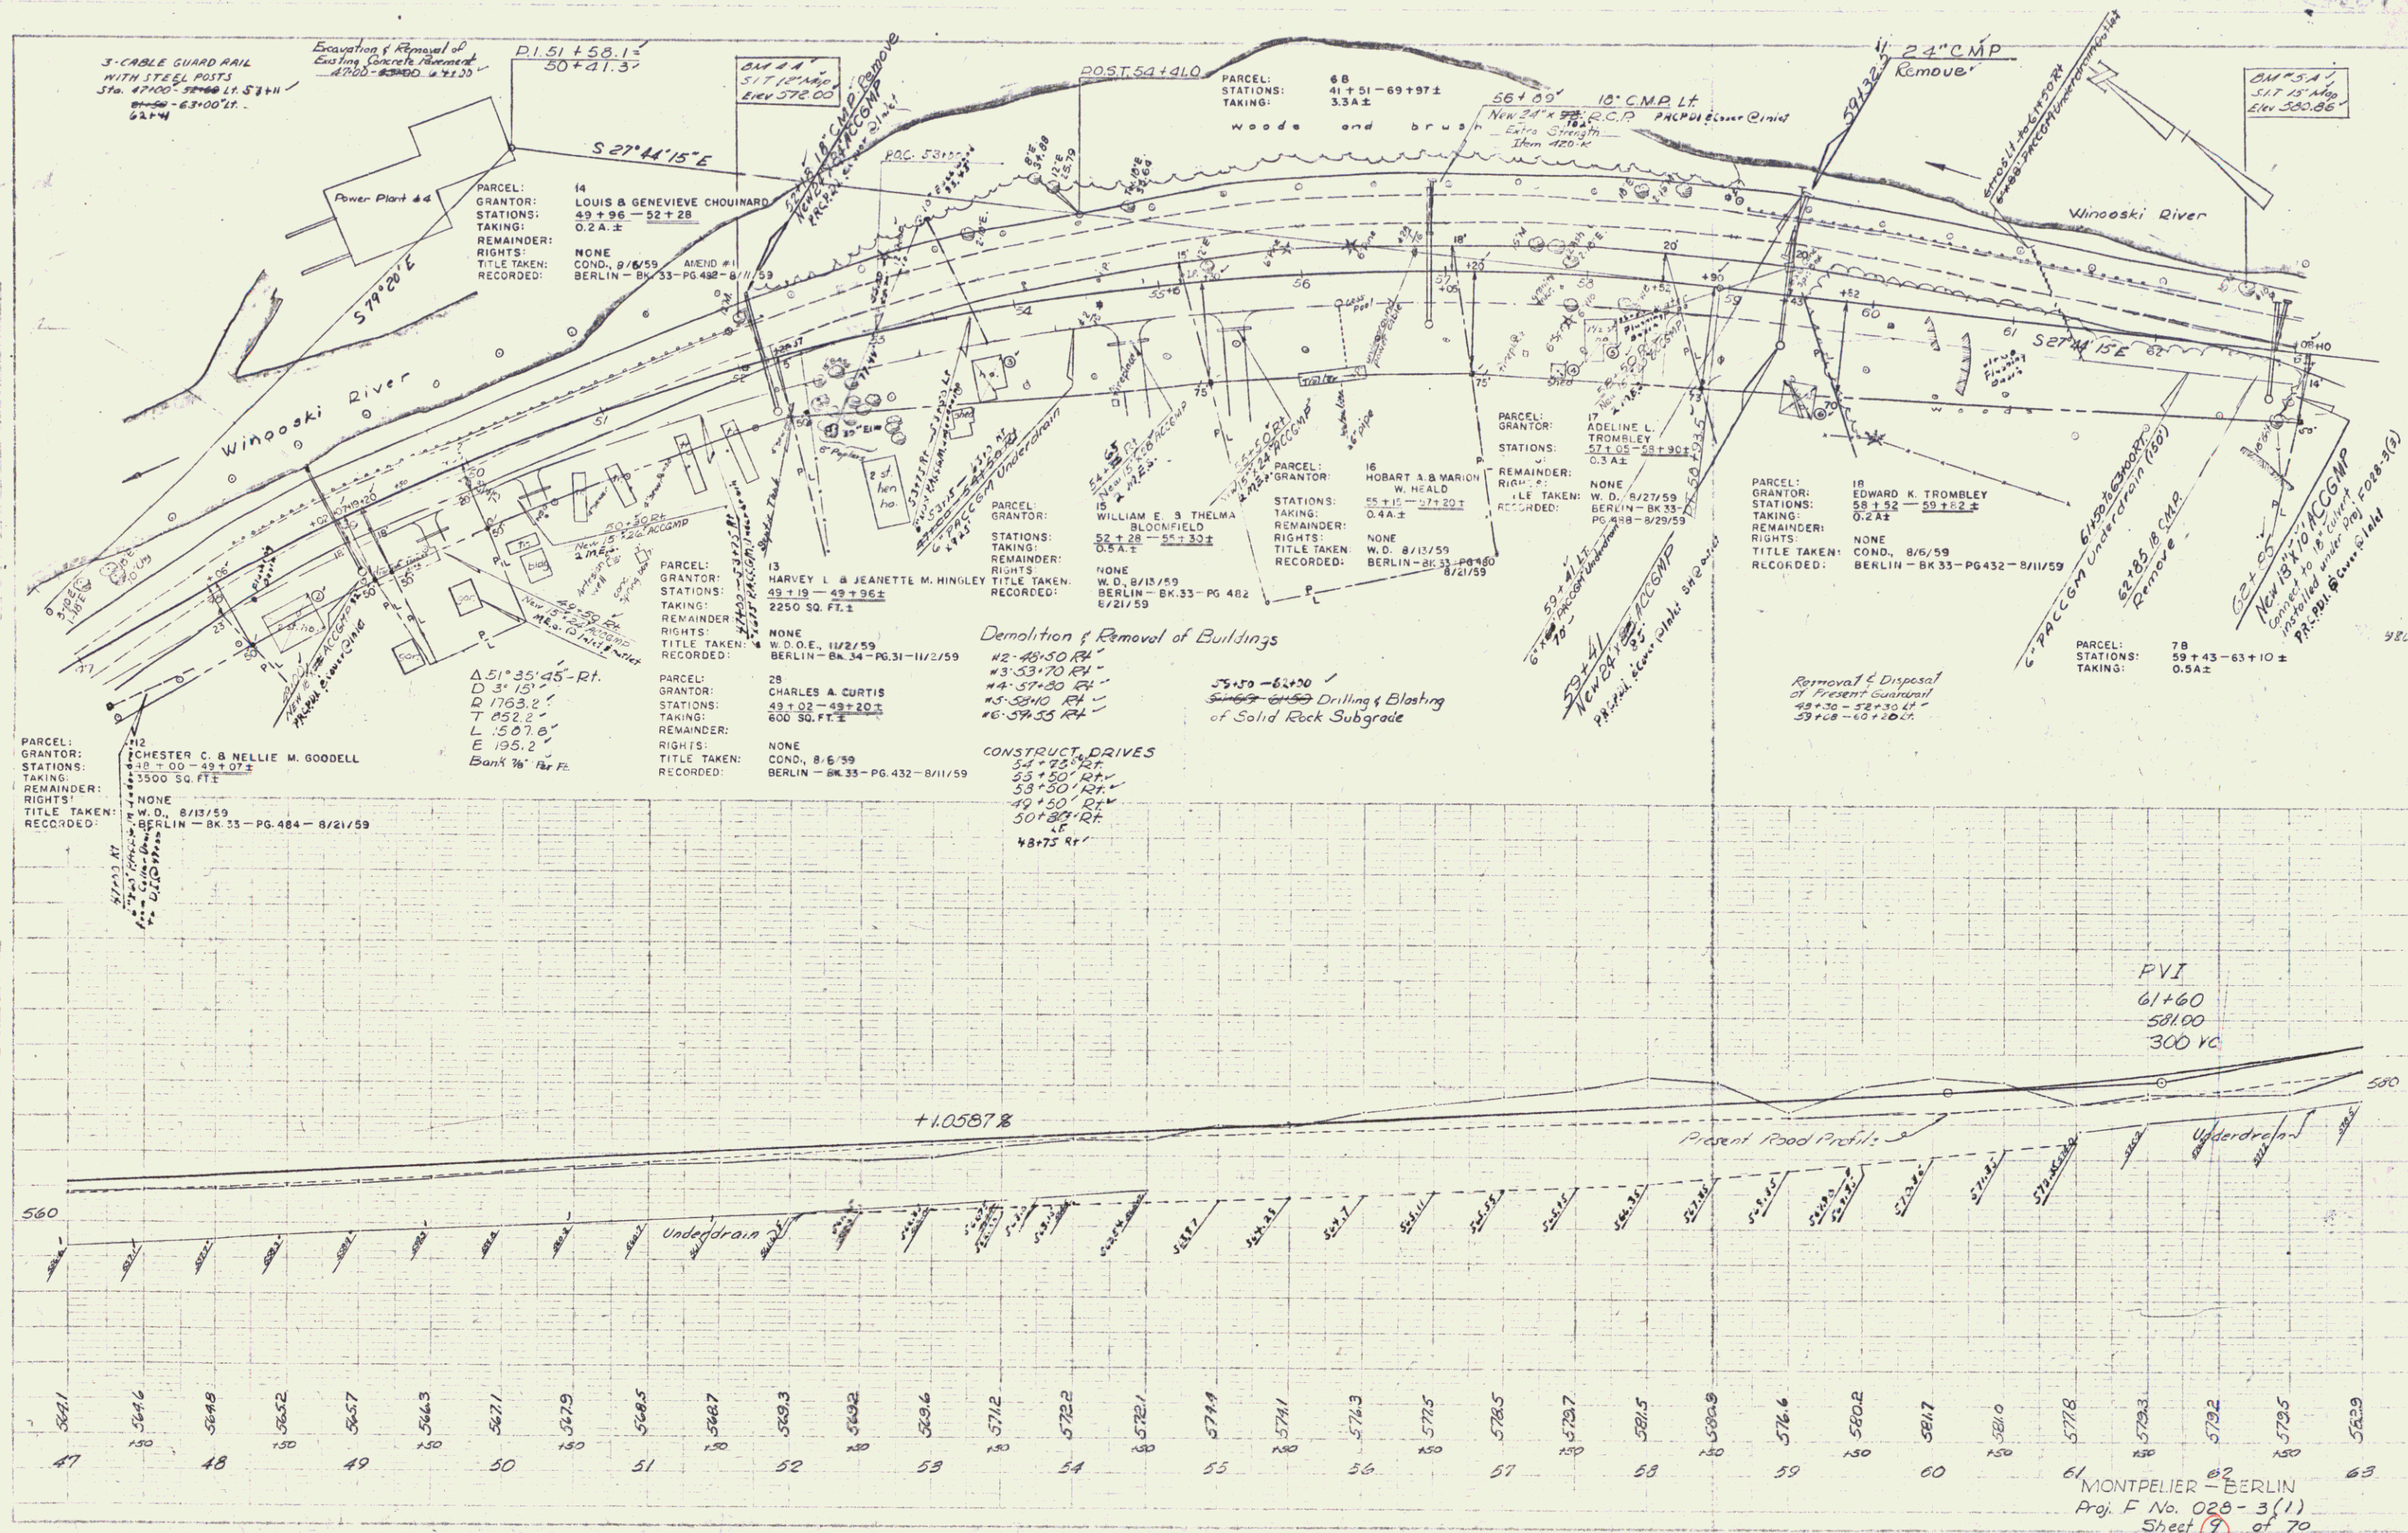

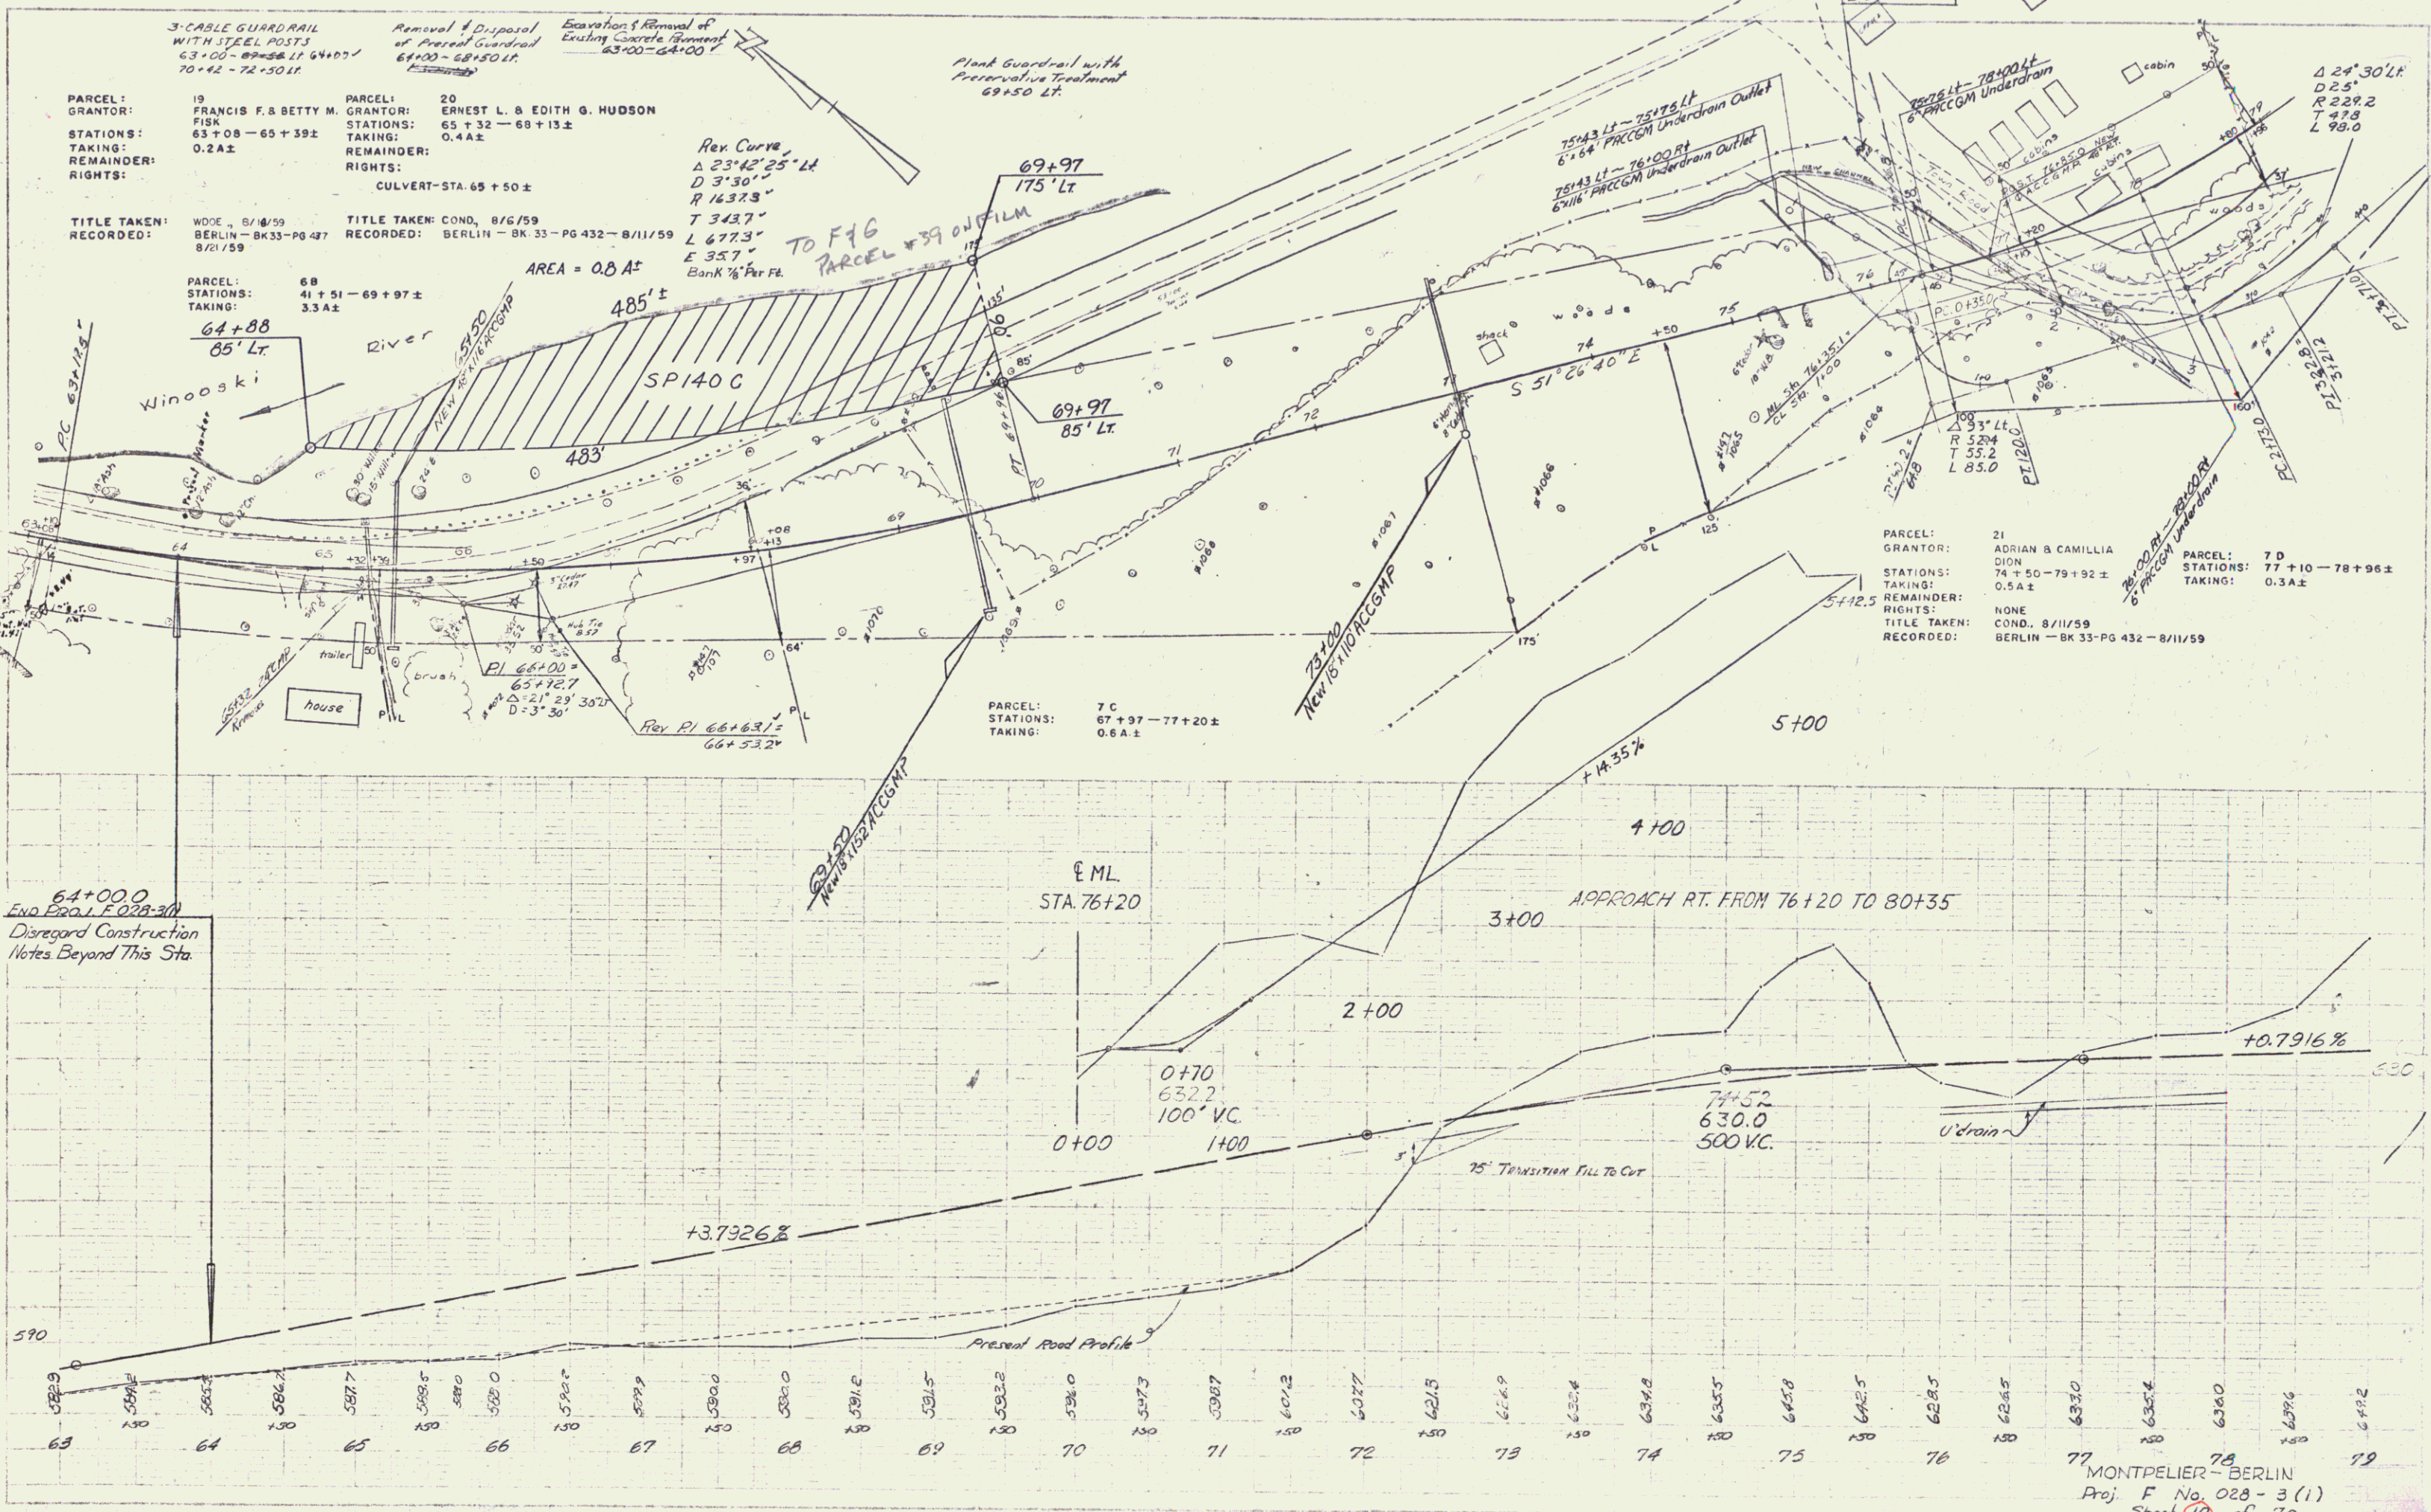

PARCEL: 19
GRANTOR: FRANCIS F. & BETTY M. FISK
STATIONS: 63+00 - 64+00
TAKING: 0.2 A±
REMAINDER:
RIGHTS:

PARCEL: 20
GRANTOR: ERNEST L. & EDITH G. HUDSON
STATIONS: 65+32 - 68+15±
TAKING: 0.4 A±
REMAINDER:
RIGHTS: CULVERT - STA. 65+50±

TITLE TAKEN: WDOE, 8/16/59
RECORDED: BERLIN - BK 33 - PG 437
8/21/59

TITLE TAKEN: COND. 8/6/59
RECORDED: BERLIN - BK 33 - PG 432 - 8/11/59

PARCEL: 68
STATIONS: 41+51 - 69+97±
TAKING: 3.3 A±

AREA = 0.8 A±

64+00.0
END PROJ. F 028-3(1)
Disregard Construction
Notes Beyond This Sta.

PARCEL: 21
GRANTOR: ADRIAN & CAMILLA DION
STATIONS: 74+50 - 79+92±
TAKING: 0.5 A±
REMAINDER:
RIGHTS: NONE
TITLE TAKEN: COND. 8/11/59
RECORDED: BERLIN - BK 33 - PG 432 - 8/11/59

PARCEL: 7 D
STATIONS: 77+10 - 78+96±
TAKING: 0.3 A±