


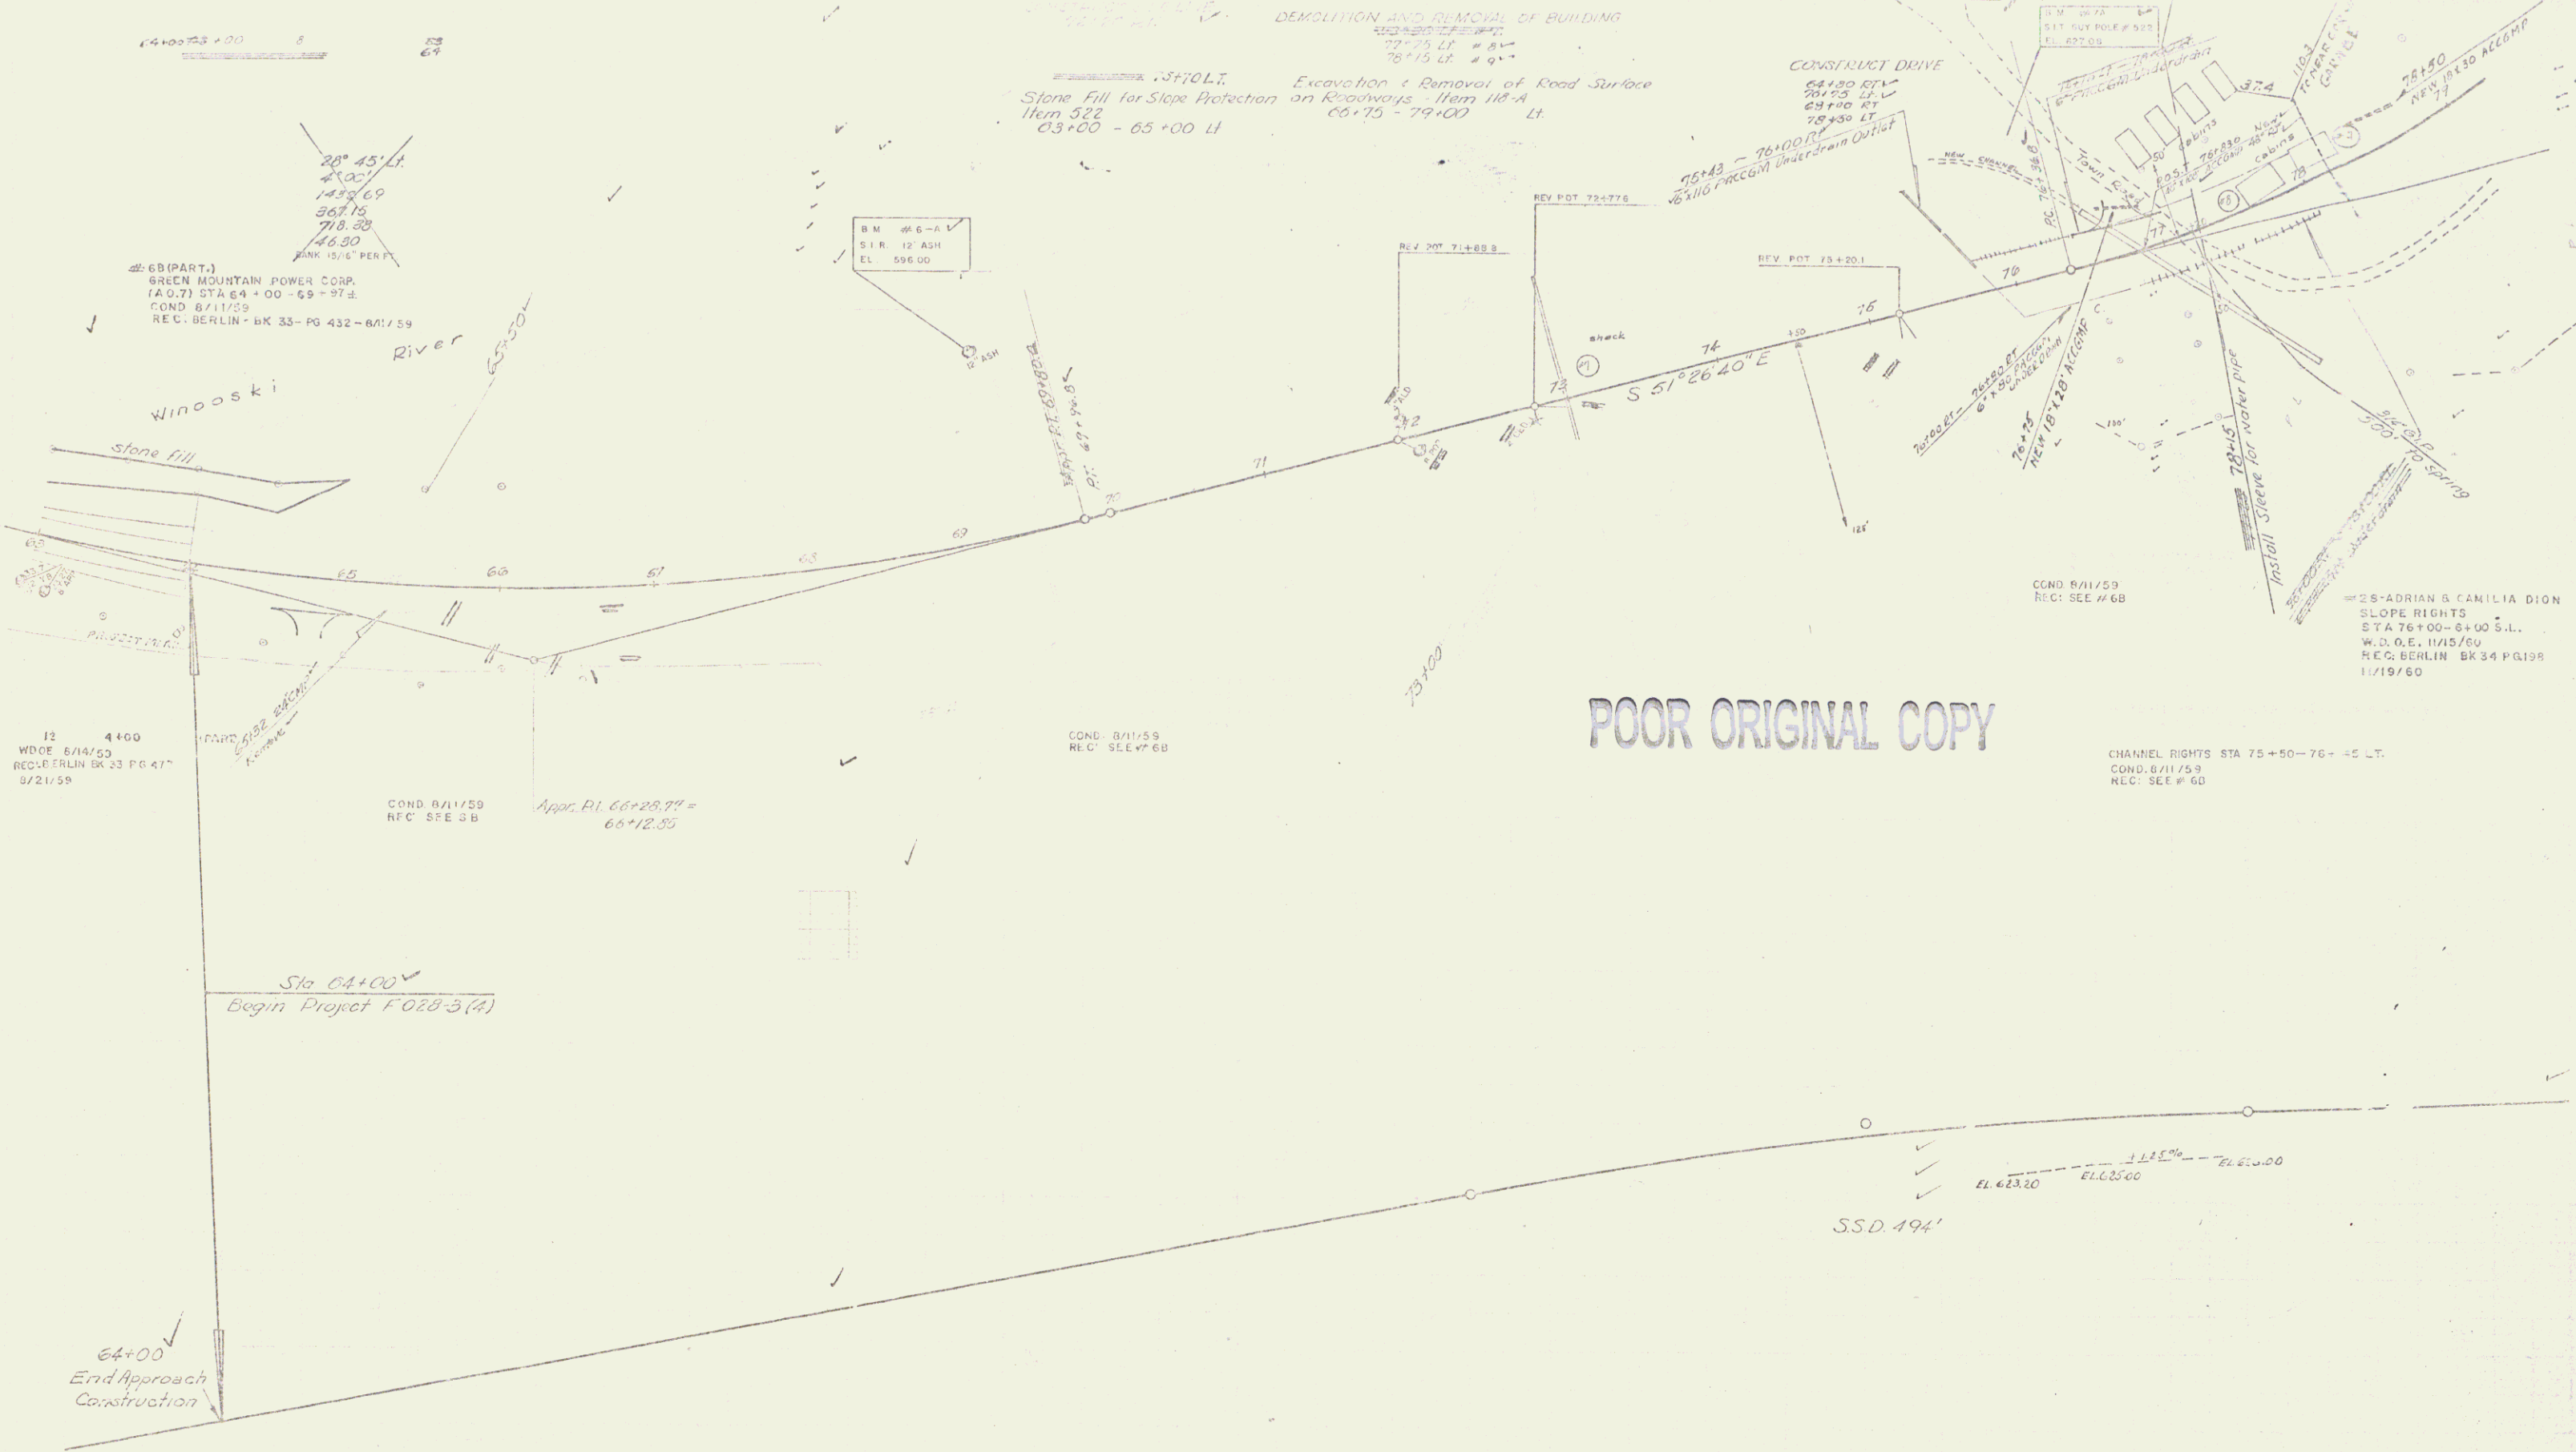

64+00
COND. 8/11/59
REC. SEE # 68

DEMOLITION AND REMOVAL OF BUILDING
Excavation & Removal of Road Surface
Stone Fill for Slope Protection on Roadways Item 110-A
60+75 - 79+00 LT.

CONSTRUCT DRIVE
64+00 LT.
64+00 LT.
64+00 LT.
64+00 LT.

COND. 8/11/59
REC. SEE # 68

MR. ADRIAN B. CAMILIA DION
SLOPE RIGHTS
STA 76+00-8+00 S.L.
W.D.O.E. 11/15/60
REC. BERLIN BK 34 PG 198
11/19/60

CHANNEL RIGHTS STA 75+50-76+45 LT.
COND. 8/11/59
REC. SEE # 60

POOR ORIGINAL COPY

12 4+00
W.D.O.E. 6/14/59
REC. BERLIN BK 33 PG 417
9/21/59

COND. 8/11/59
REC. SEE # 68

Appr. P.I. 66+28.94 =
66+12.35

Sta 64+00
Begin Project F028-3(4)

64+00
End Approach
Construction

SSD. 494'

EL. 623.20 EL. 625.00 EL. 625.00

BERLIN-SEARS-MONTPELIER

10

171

3