

PARCEL NO. 1 DAVID & LESLIE GARNICK 0.13A±
 BEG. STA. 164+00 LT. — END STA. 165+75 LT.
 STA. 166+50 LT. DRIVE (T)
 (REPLACES DRIVE AT STA. 165+55 LT.)
 STA. 161+95 LT. — 163+10 LT. SLOPE (P) 350S.F.±

MP 0313 POOR ORIGINAL COPY
 GARNICKS TO ST. OF VT. 12/12/75 W3 BK 24/439
 Option

DAVID & LESLIE GARNICK


PARCEL NO. 2 LEWIS & HAZEL JONES
 BEG. STA. 164+00 RT. — END STA. 164+20 RT.
 SLOPE (P) 30 S.F.±

JONES TO ST. OF VT BY WDOE 11/18/75
 W3 BK 27/326

PARCEL NO. 3 ARSENE & ODIVINE LA PERLE 0.03A± 1200S.F.
 BEG. STA. 164+45 RT. — END STA. 166+50 RT.
 164+20 RT. — 164+45 RT.
 SLOPE (P) 0.01A± 640S.F.

LA PERLES TO ST. OF VT BY WDOE
 BARN

12/23/75 W3 BK 24/474

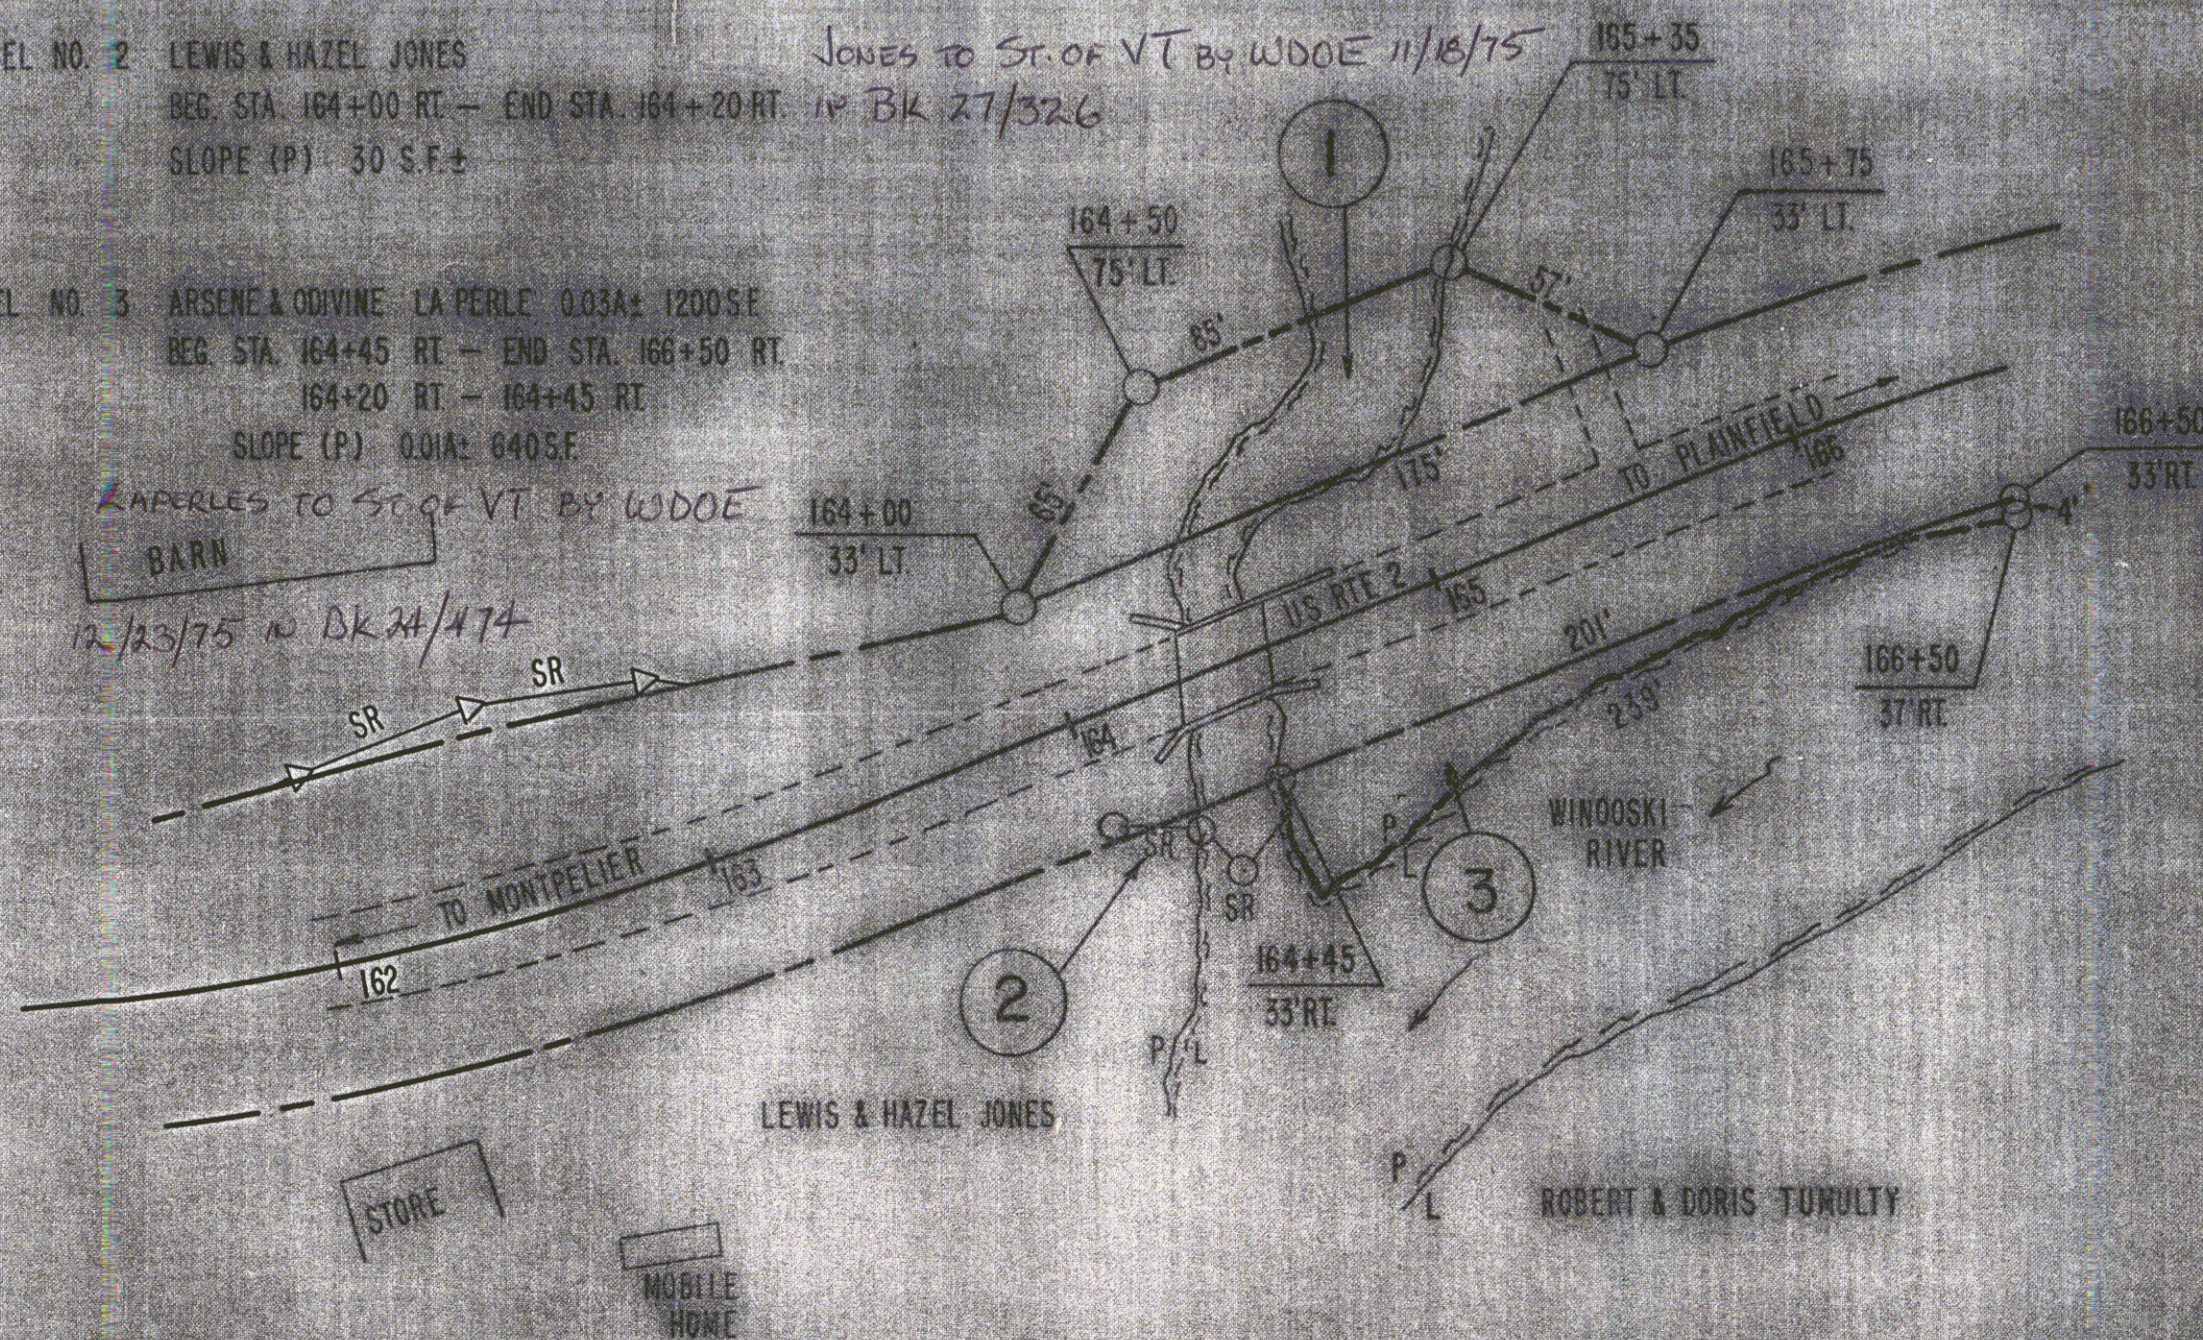

NOTE:
 TECHNAFAX REVISED BECAUSE ORIGINAL ALREADY FILED

SCALE 1" = 50'



STATE OF VERMONT
 DEPT. OF HIGHWAYS

TOWN OF EAST MONTPELIER

US RTE 2 BRIDGE 73
 PROJECT EAST MONTPELIER ROS 028-3(7)
 APPROX. SCALE 1" = 50' DATE 9-3-75 DRAWN BY KDP

REV 10-30-75

2A

3