


NOTE: FOR DETAILS OF INTERSECTION SEE SHEETS 20 AND 21.

Period	Kind of Instrument	Date of Grant	Grantor	Grantee	Recorded	Remarks
July 1	G.C.D.	6-10-31	CHEA Collins	Staff	Box 10	Date 6-11-31


CONCRETE CURB + GUTTER	
STA	RT
423+12	423+70
423+70	423+70
423+70	423+70
CONCRETE GUTTER	
STA	RT
423+12	423+70
423+70	423+70
423+70	423+70
AD. SHEET NO. 97-E 1932 15 45

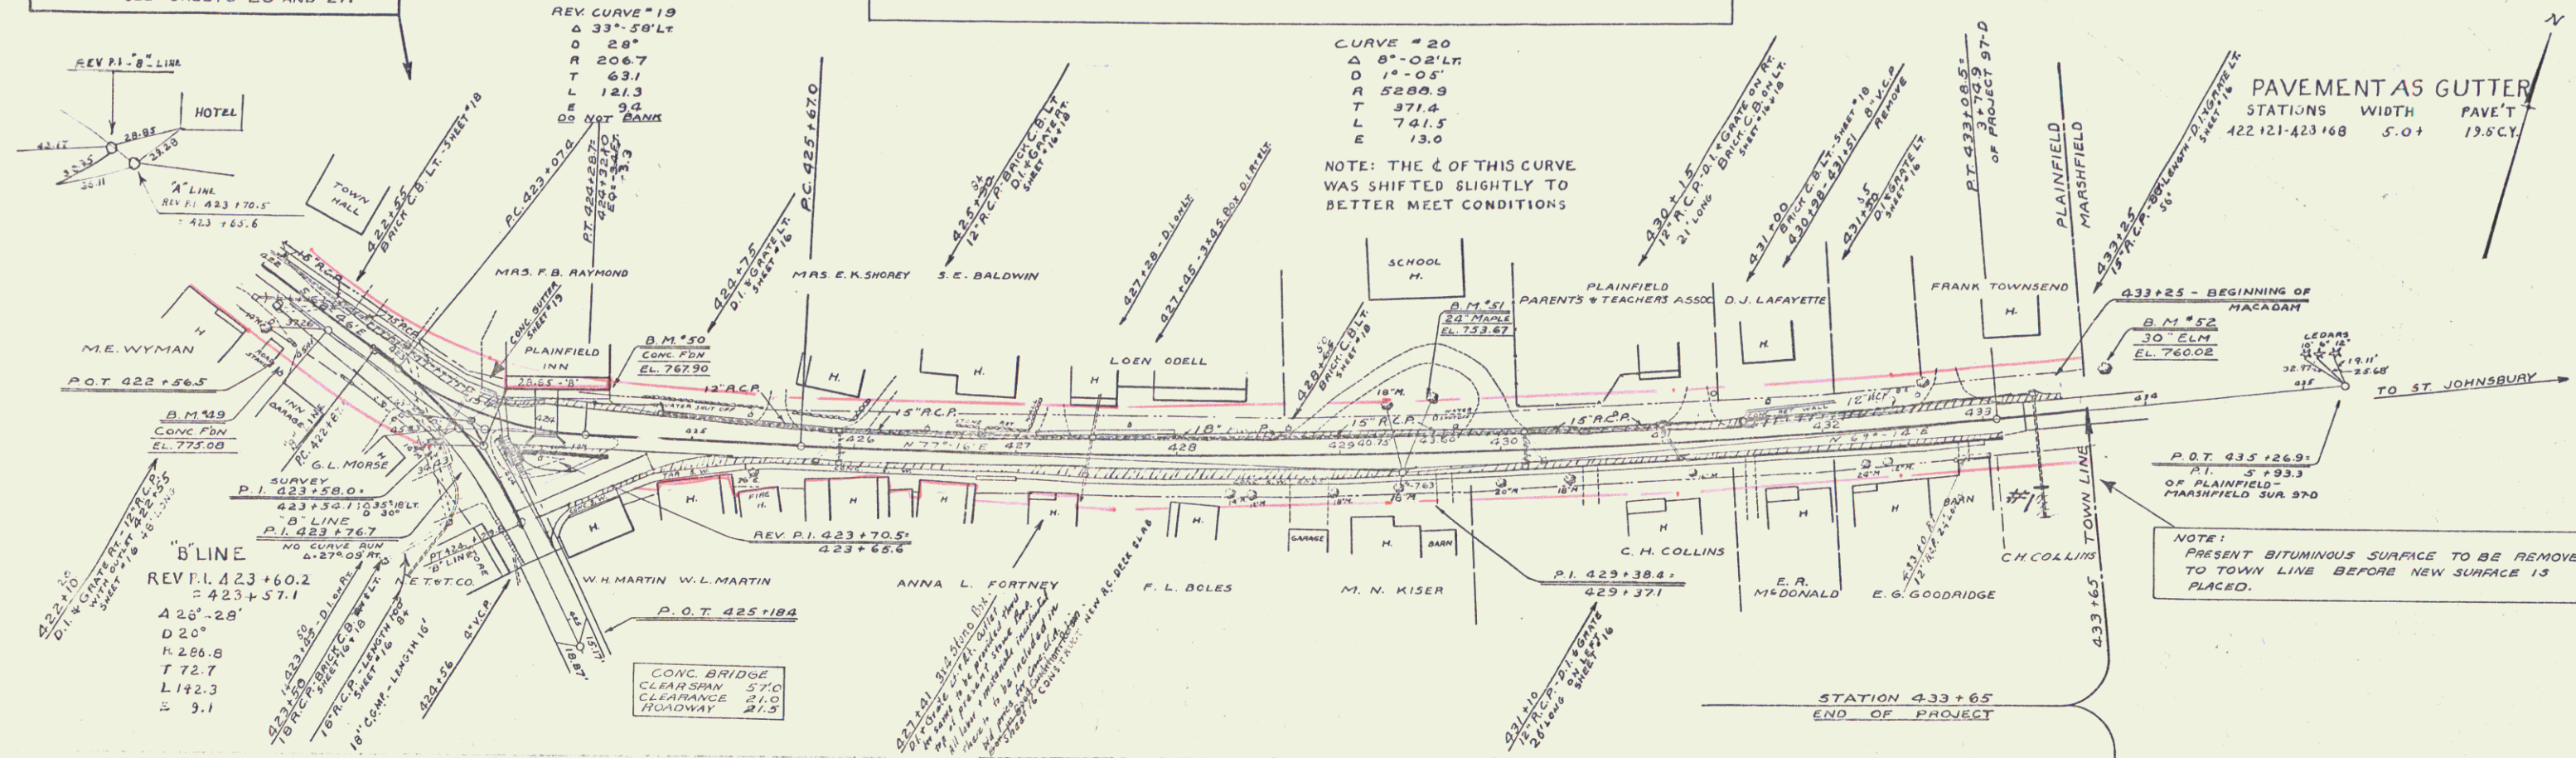

REVISIONS
 10/10/32. Brick Catch Basins at Sta. 423+12 & 423+70 replaced with 21\"/>

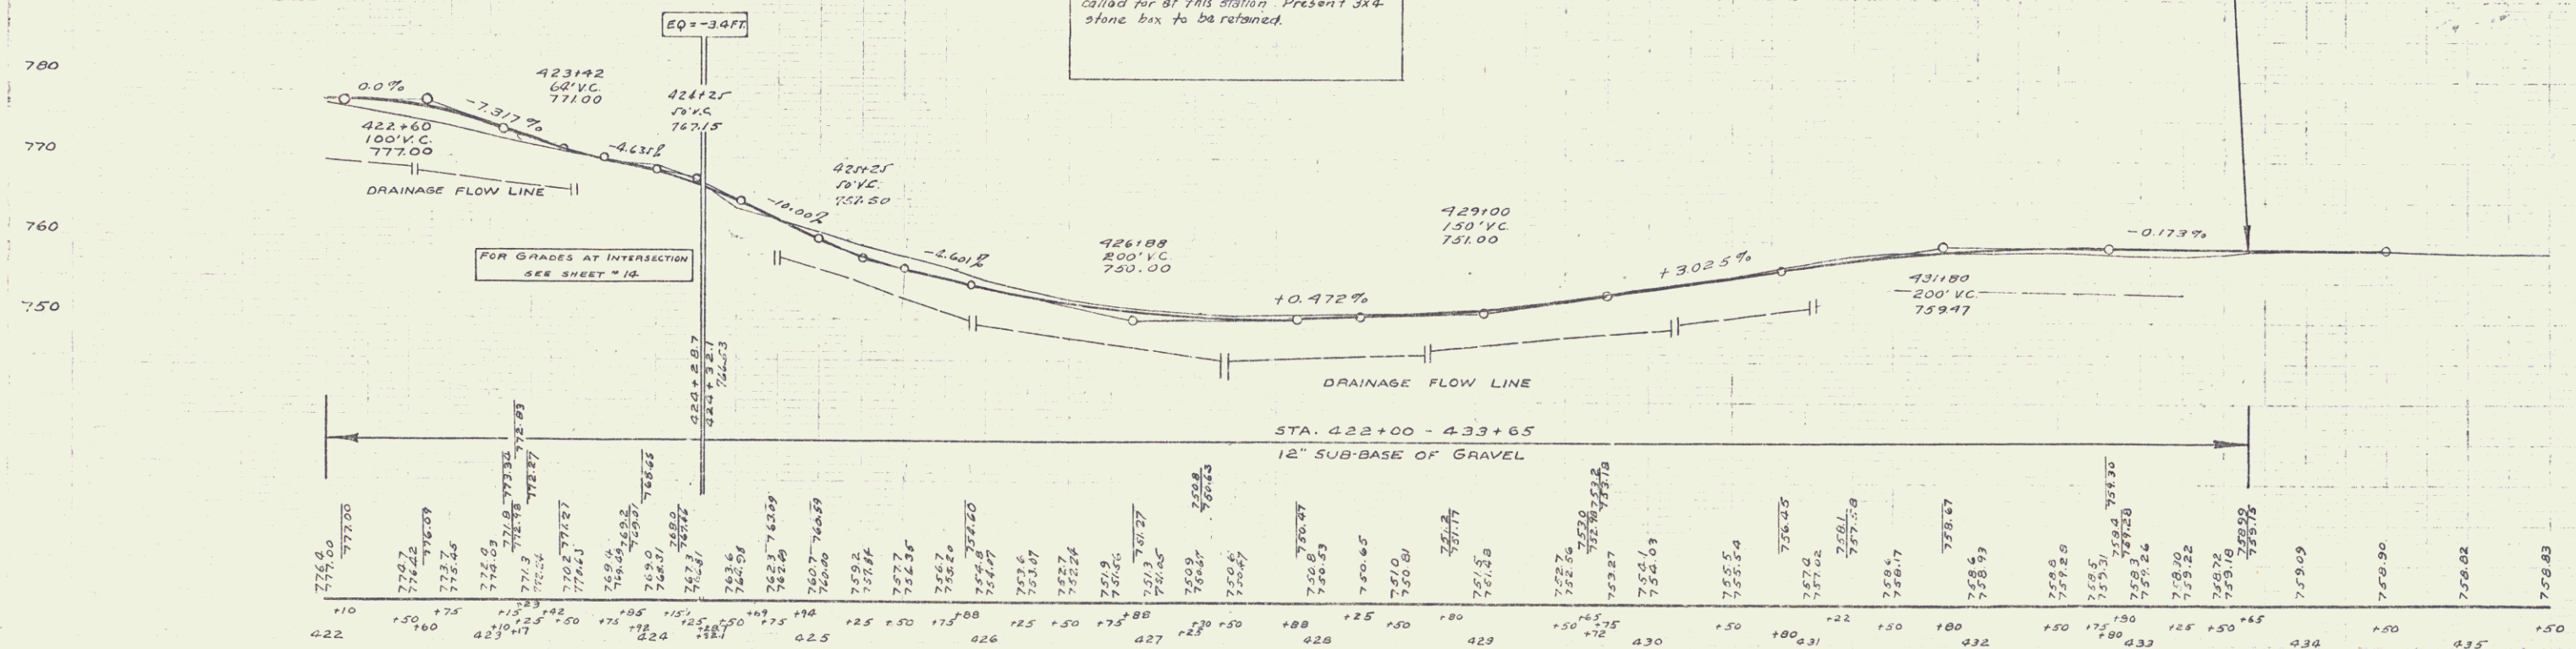

B.M. #49 PAINT SPOT ON GAS PUMP FOUN. 20.5 FT. AT STA. 422+47 ELEV. 775.00
 B.M. #50 PAINT SPOT ON CONC. FOUN. POST AT INN. 20 FT. LT. STA. 426+47 ELEV. 767.50
 B.M. #51 SPIKE IN ROOT 2\"/>

SERIES F - No. 97-E
 SHEET 13 of 45